

Ministère  
des Travaux  
Publics

REINFORCED, MAINTAIN & REPAIR  
CONCRETE & STRUCTURES  
FOR EXISTING STRUCTURES

A. detail no.  
B. location  
C. drawing no.  
date

revision  
date

AS BUILT



Job title  
drawing title  
drawing no.  
drawing date

drawing title  
drawing no.  
drawing date

CROSS SECTIONS  
OF SUPERSTRUCTURE


designed by  
checked by  
approved by

designed by  
checked by  
approved by
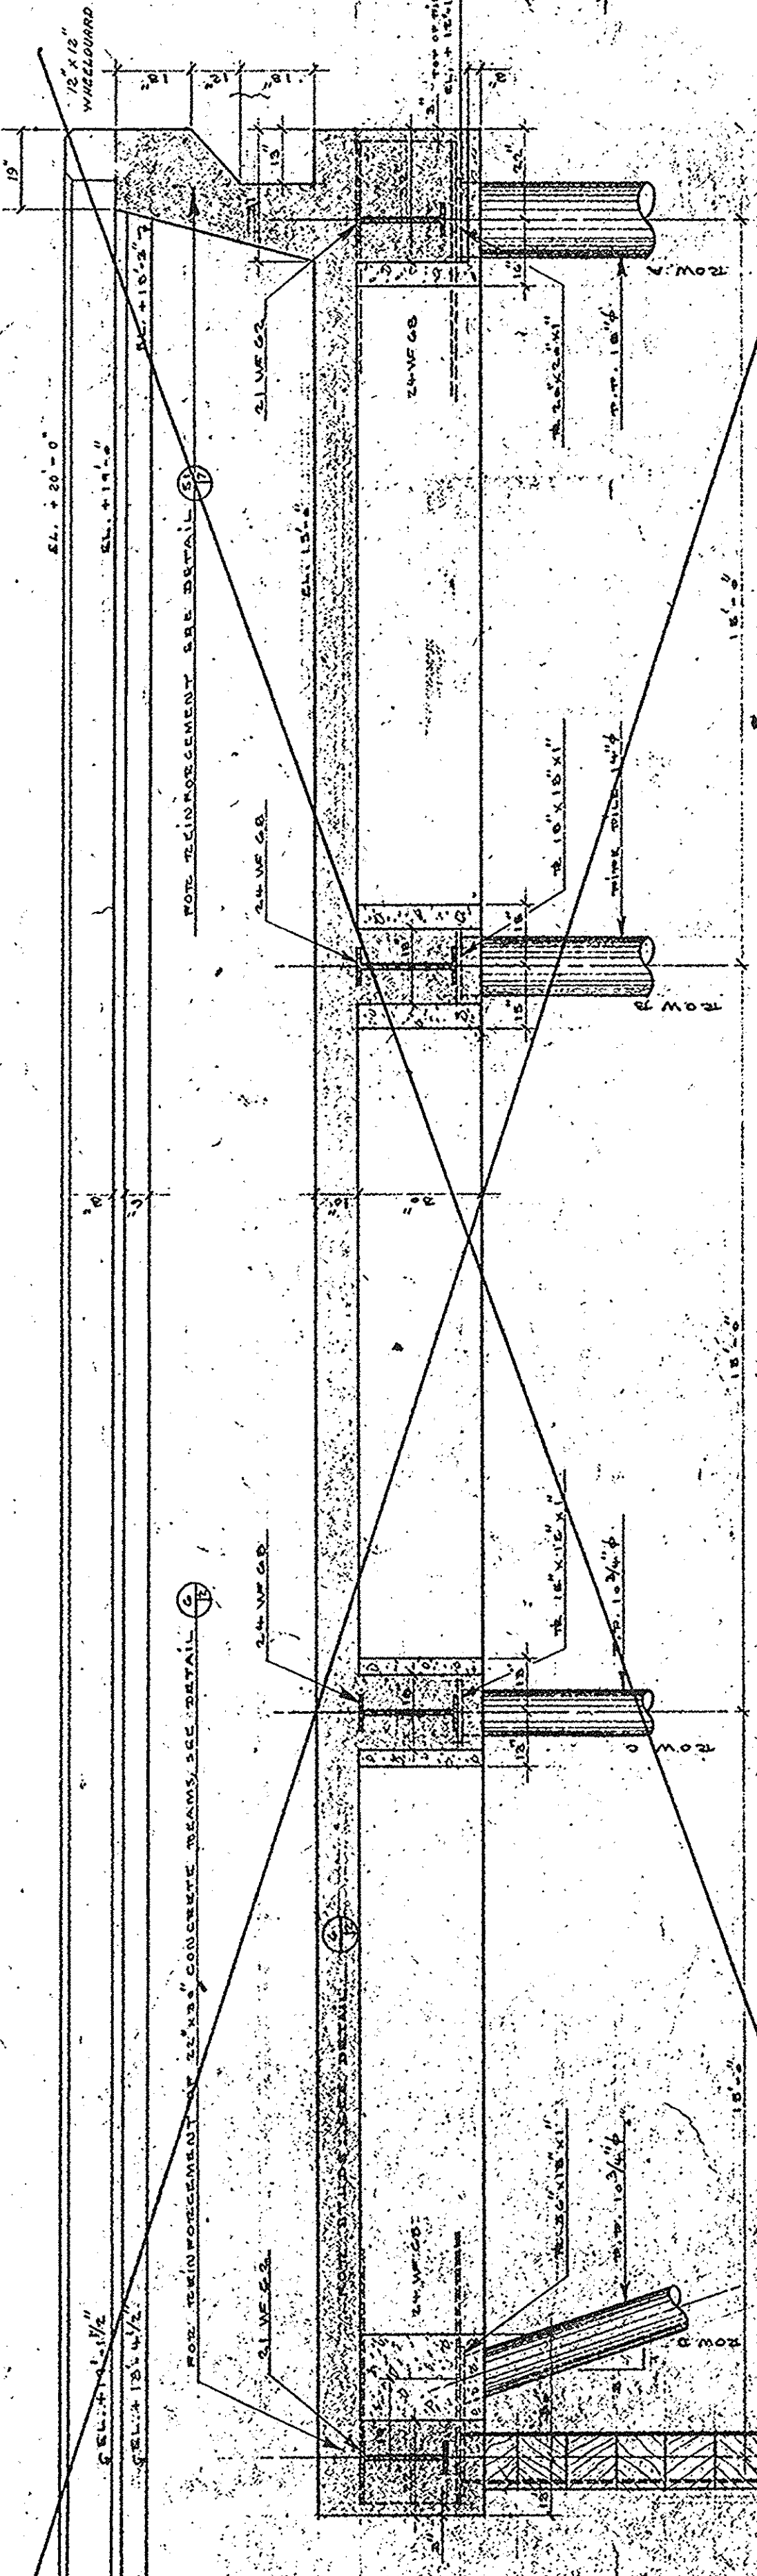


CROSS-SECTION BENTS 4 TO 8, 14 TO 29, 35 TO 42  
SCALE: 1/8" = 1'-0"

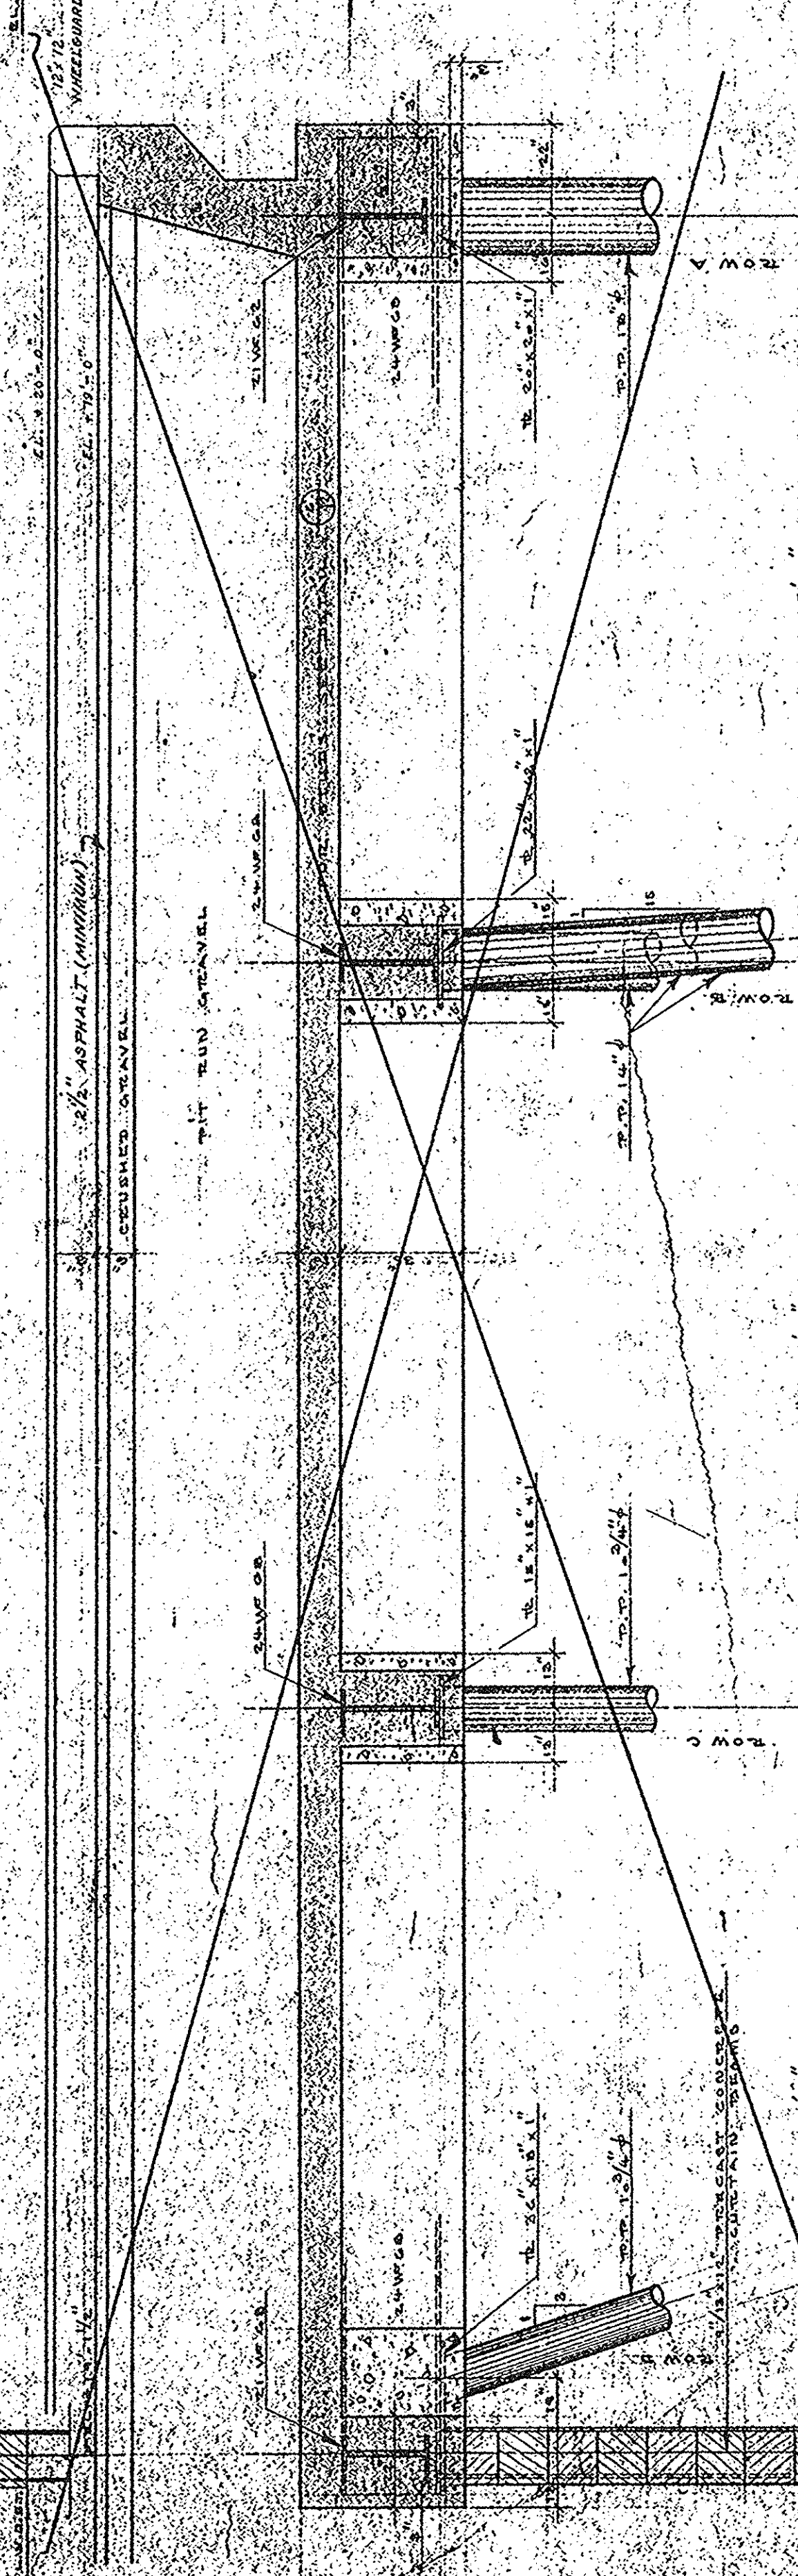


CROSS-SECTION BENTS 9 TO 13, 30 TO 34  
SCALE: 1/8" = 1'-0"

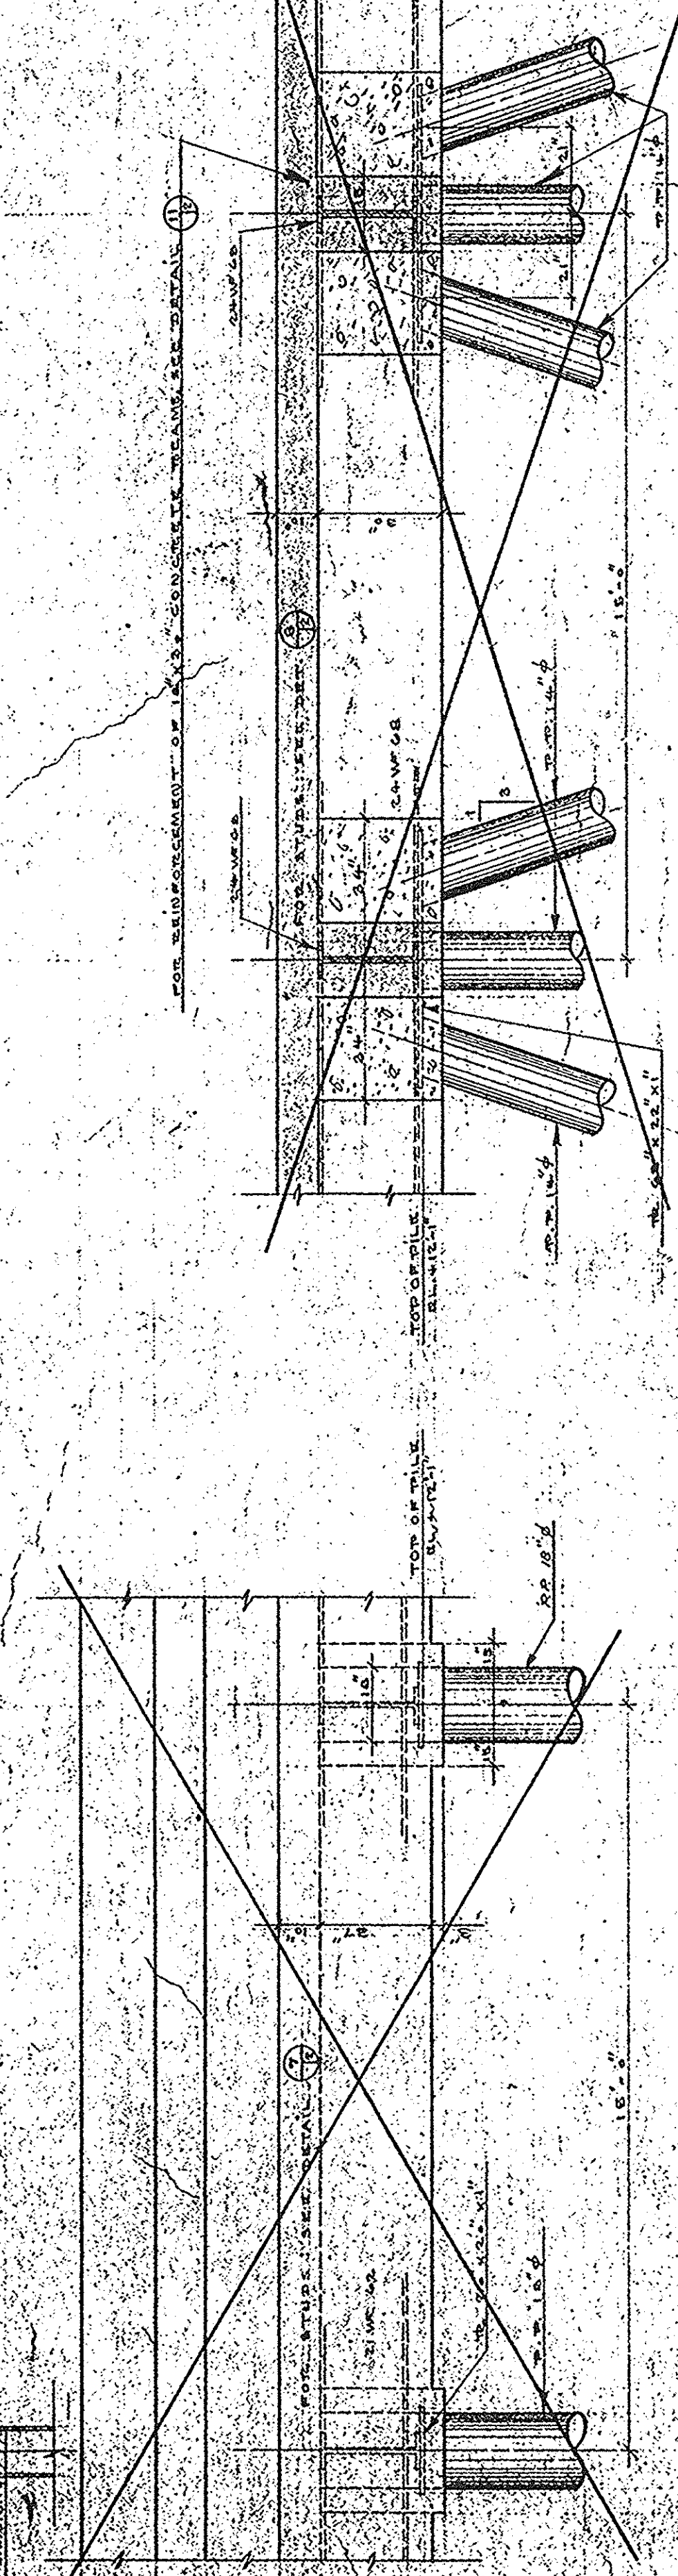

ELEV. ROW A BENTS 17 TO 23, 42  
SCALE: 1/8" = 1'-0"

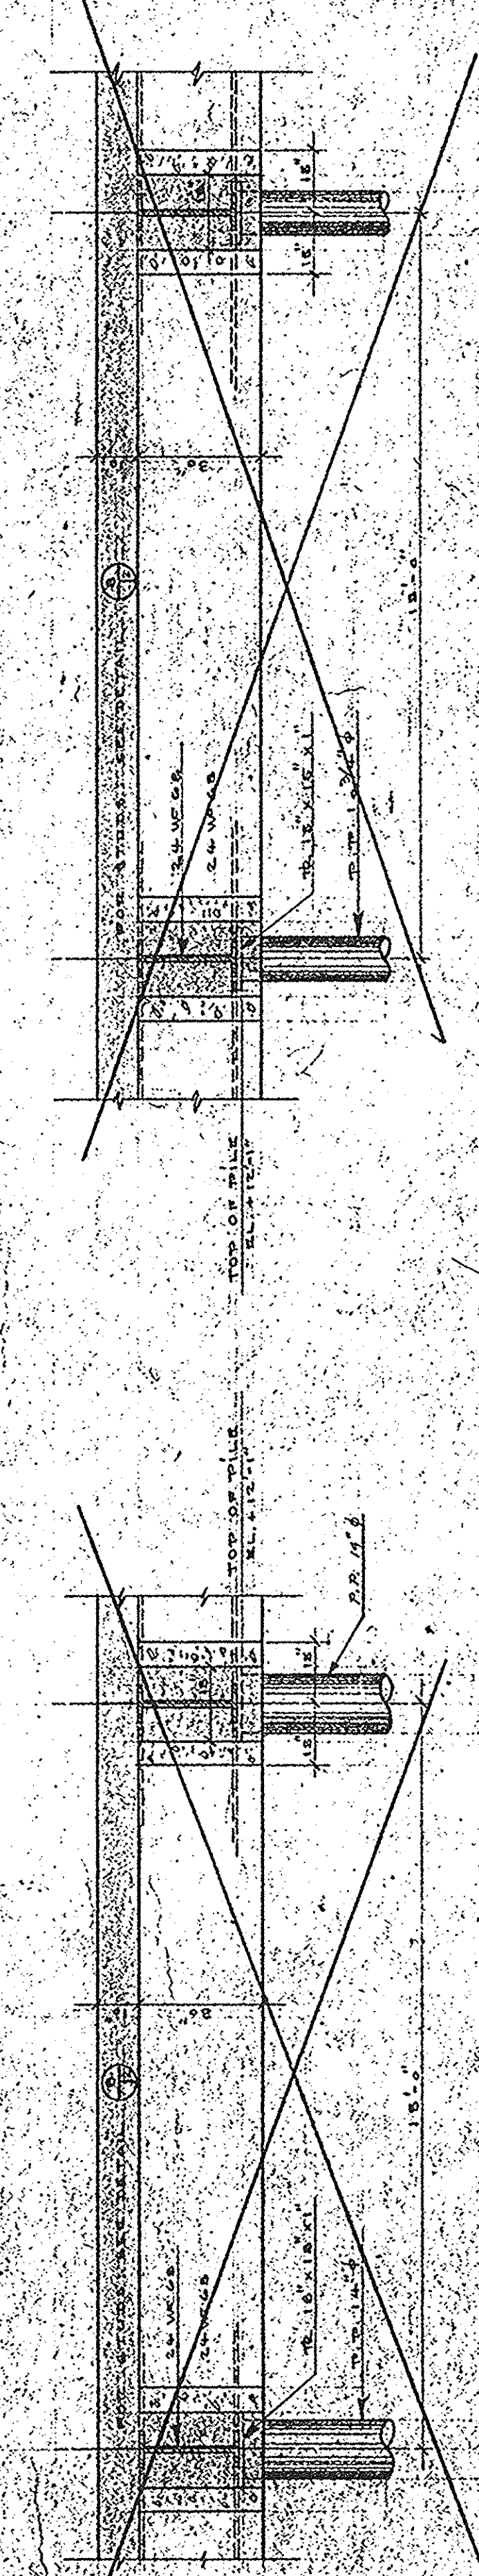


ELEV. ROW B BENTS 24 TO 29, 35 TO 42  
SCALE: 1/8" = 1'-0"

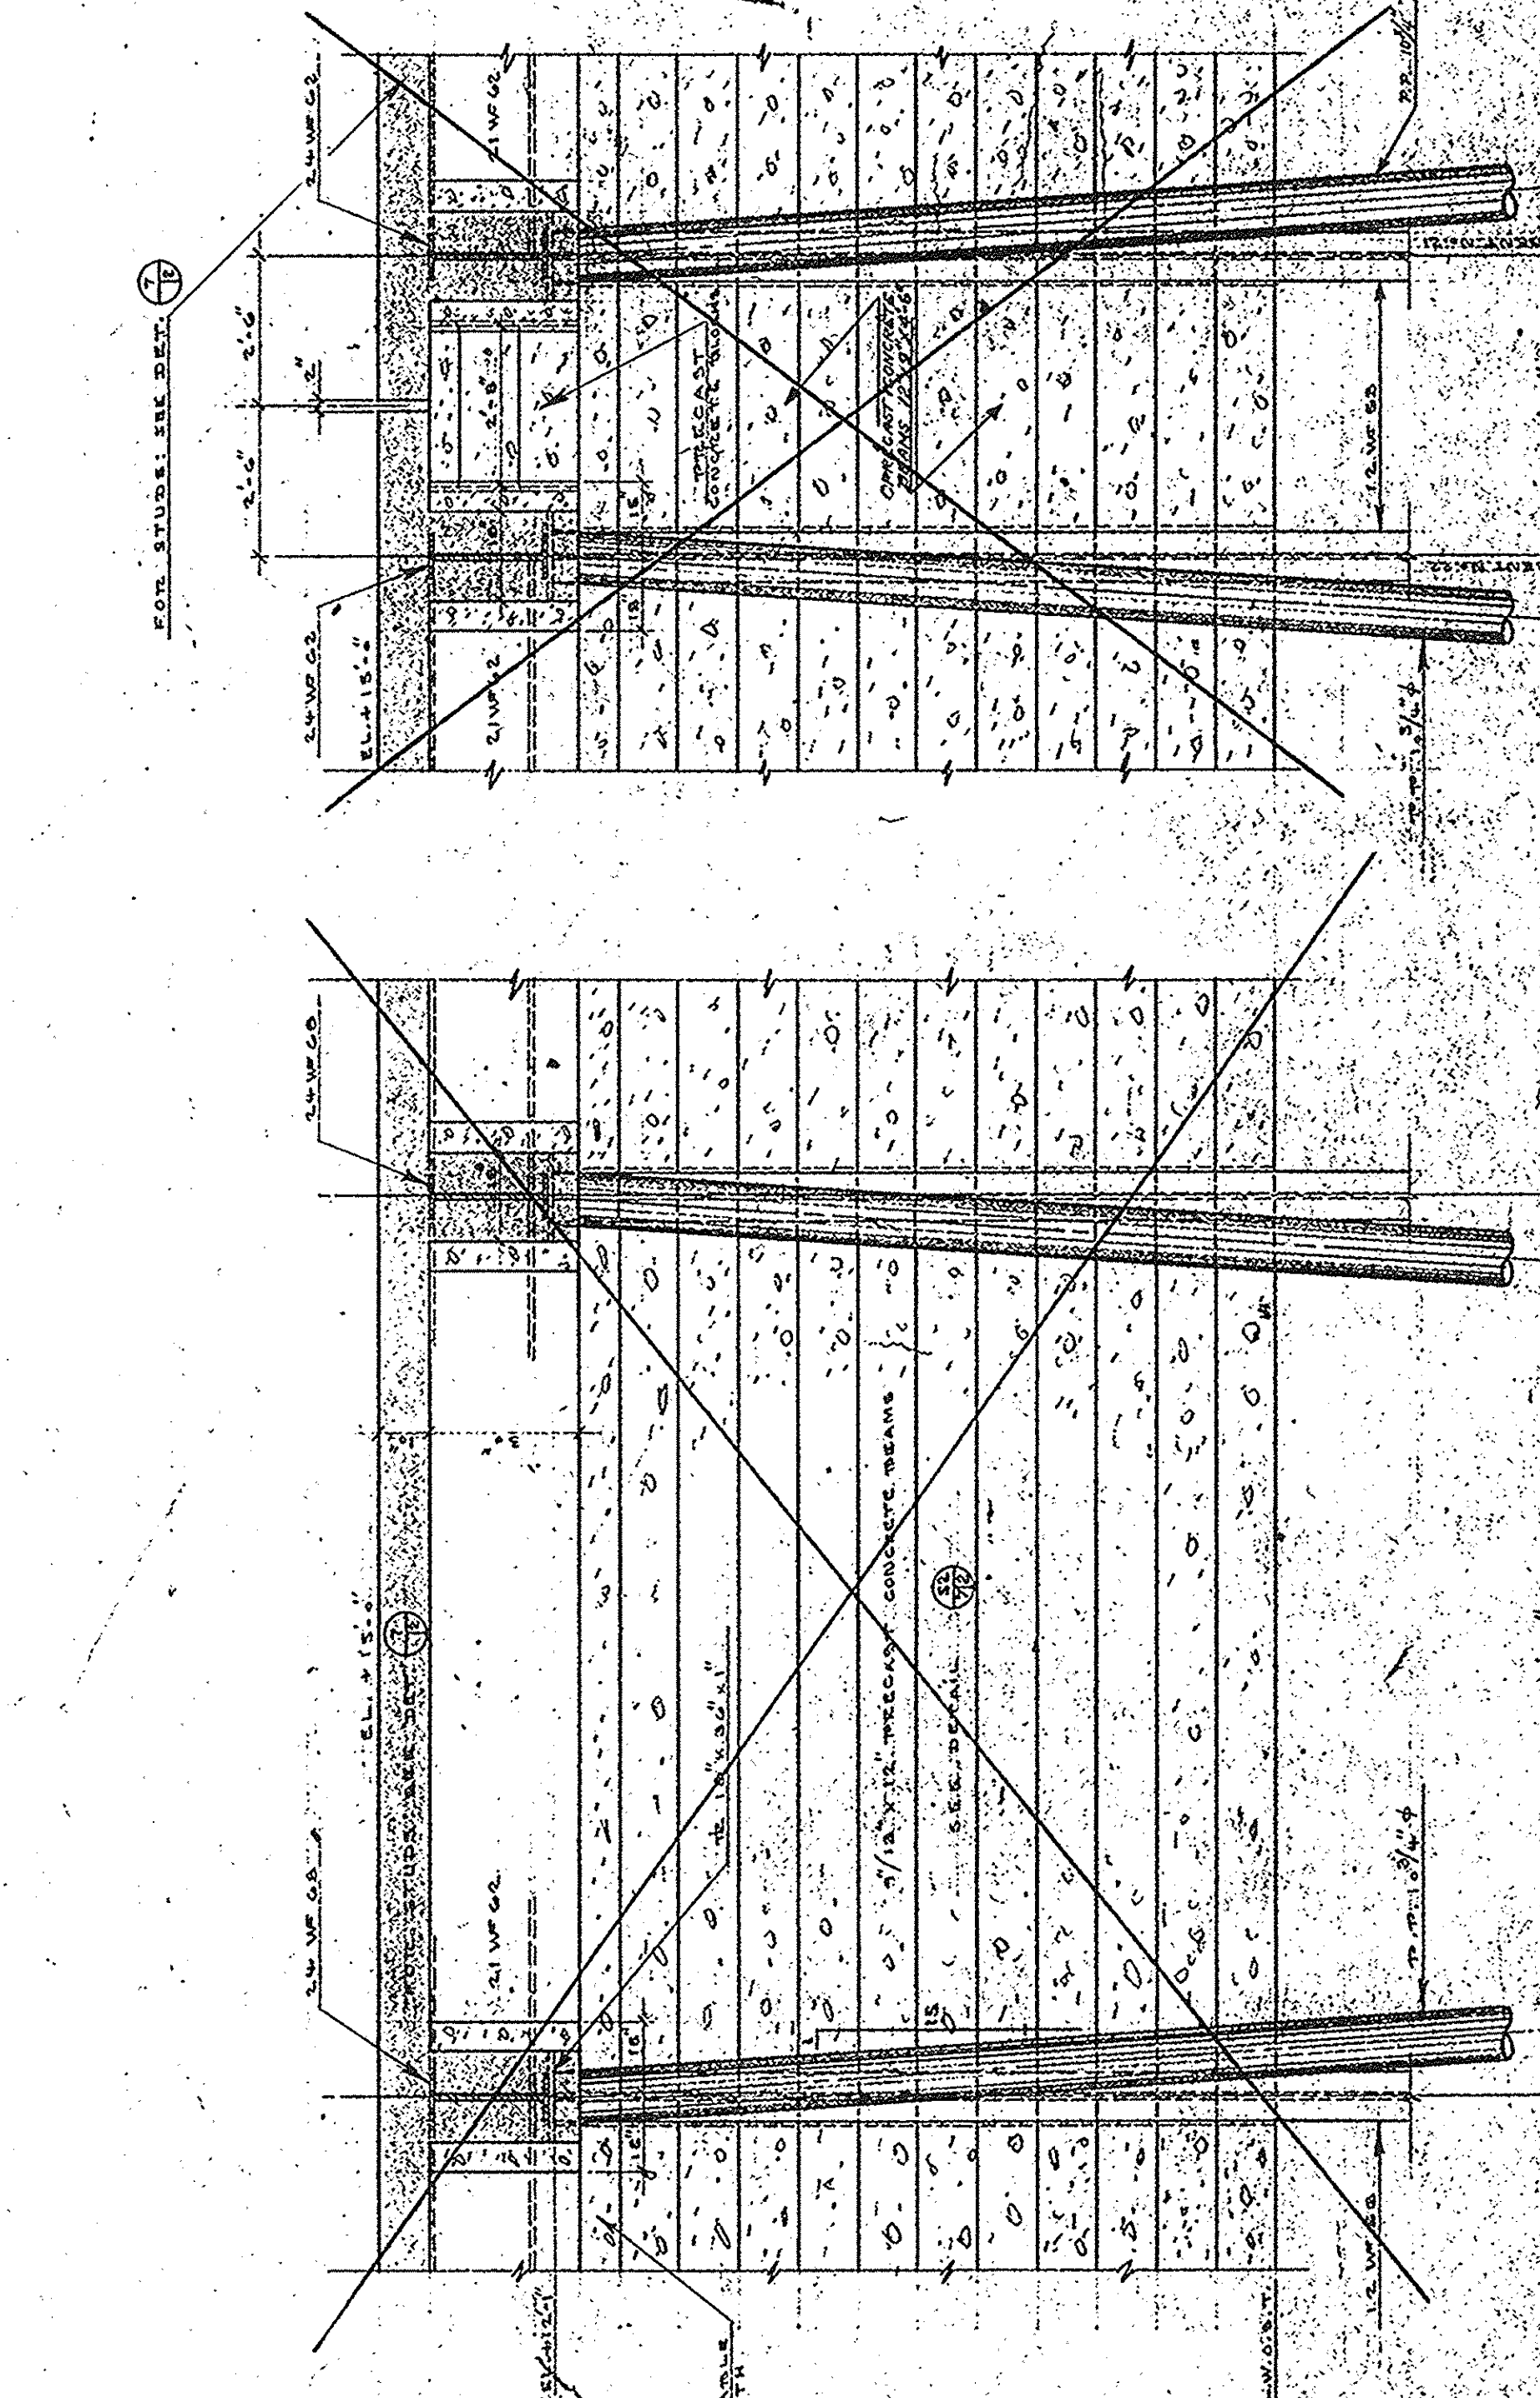


ELEV. ROW D & E BENTS 4 TO 20, 23 TO 42  
SCALE: 1/8" = 1'-0"

See attached revised plans  
sheets 1/3, 2/3 and 3/3.

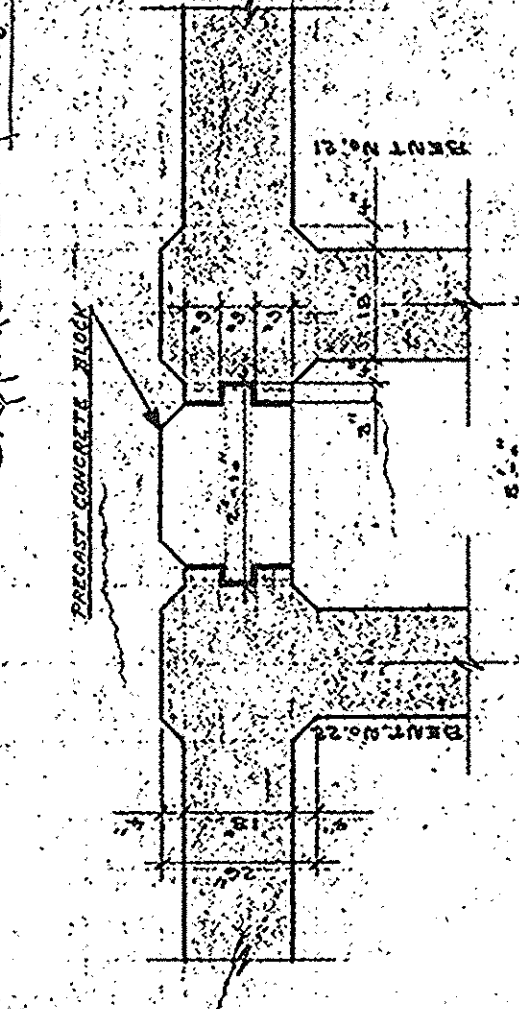

EXPANSION JOINT BETWEEN BENTS 21 & 22  
SCALE: 1/8" = 1'-0"

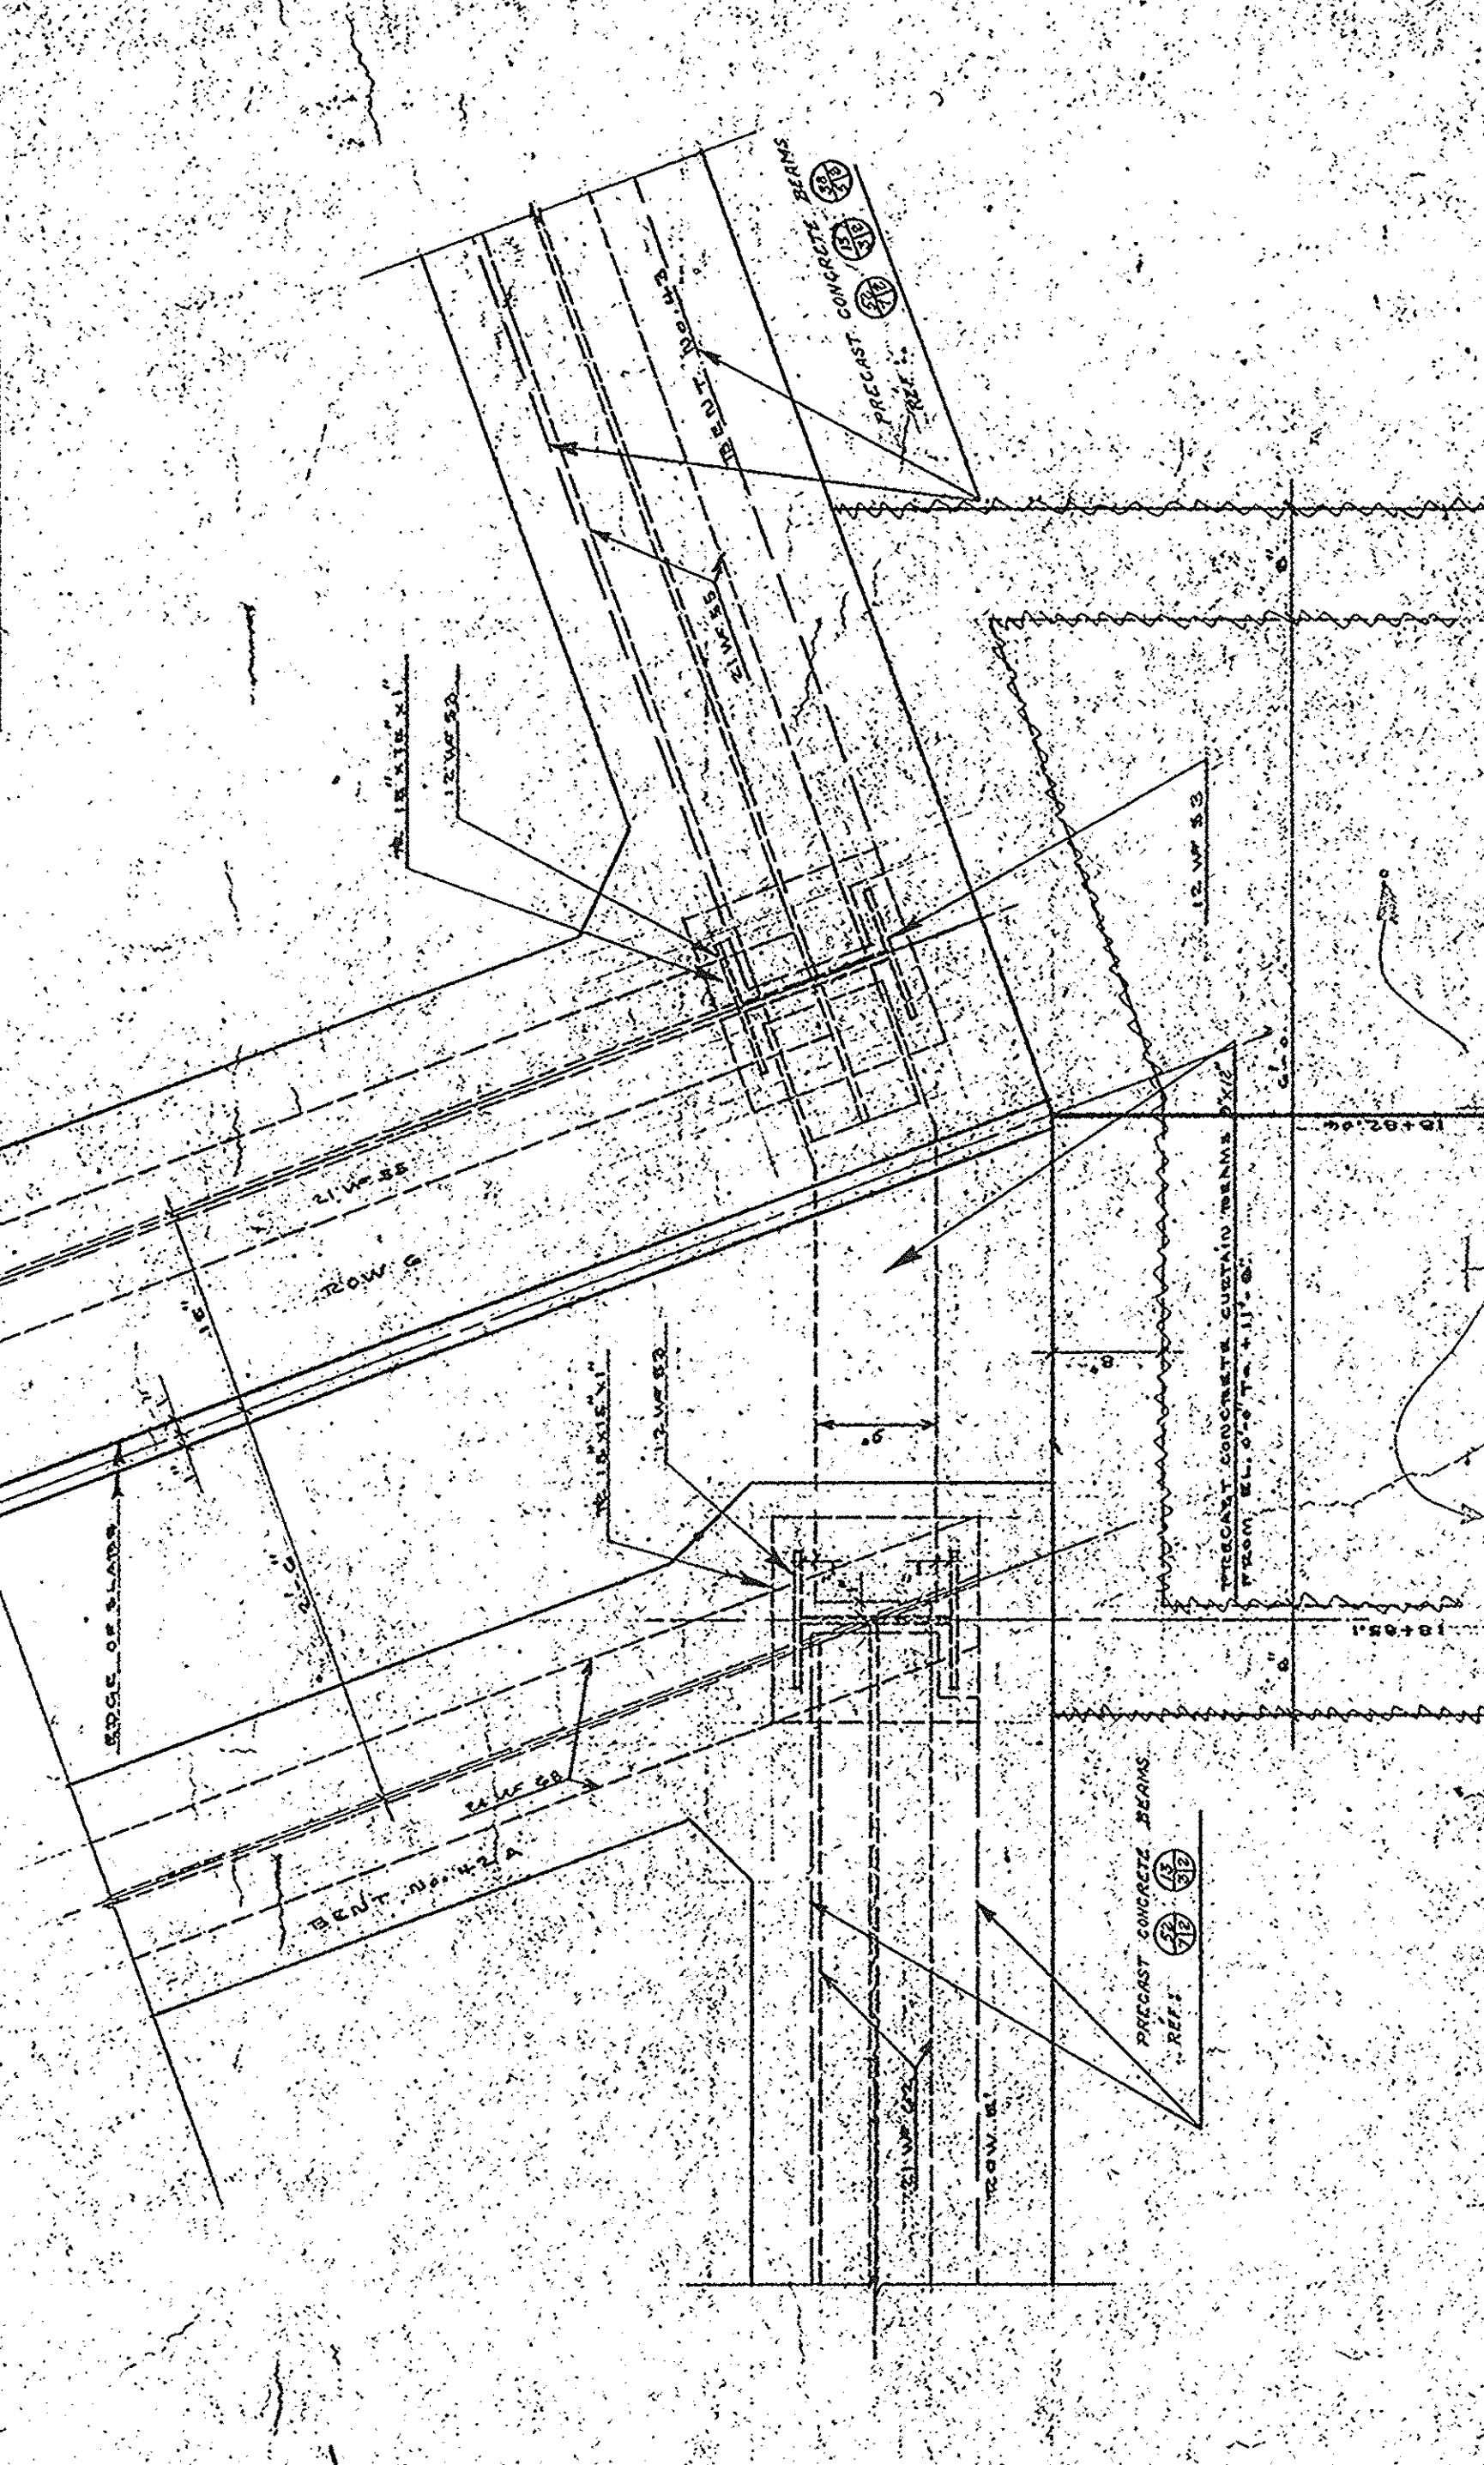

DETAIL OF JOINT AT 19 & 20  
SCALE: 1/8" = 1'-0"