

LEGEND
— COLLAR
— MILLAR

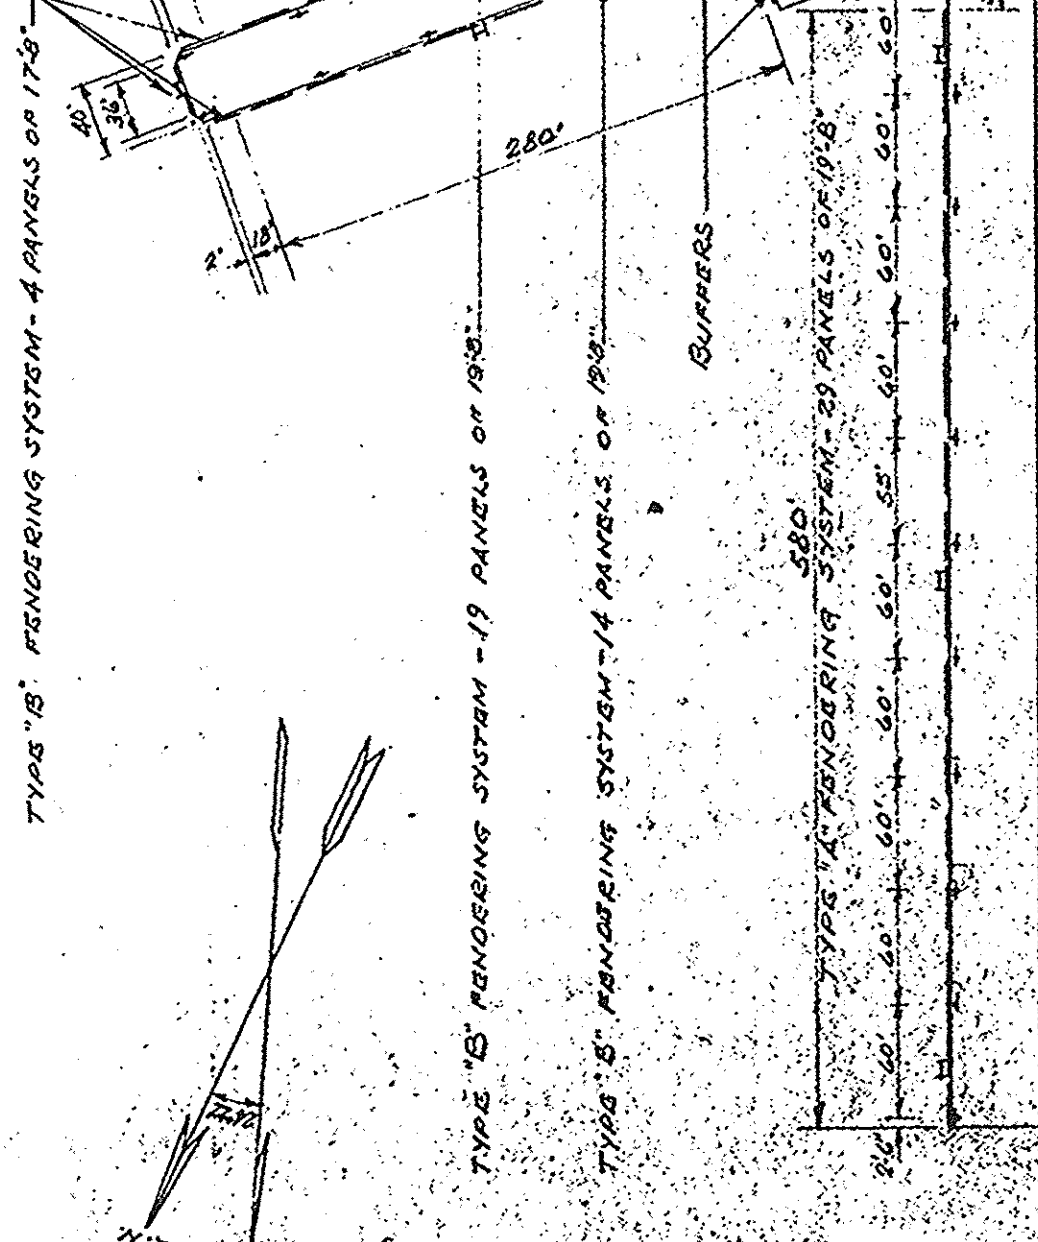


FIGURE 1. FENDERING SYSTEM - 4 PANELS OF 170"

FIGURE 2. FENDERING SYSTEM - 19 PANELS OF 170"

FIGURE 3. FENDERING SYSTEM - 19 PANELS OF 170"

FIGURE 4. FENDERING SYSTEM - 19 PANELS OF 170"

FIGURE 5. FENDERING SYSTEM - 19 PANELS OF 170"

FIGURE 6. FENDERING SYSTEM - 19 PANELS OF 170"

FIGURE 7. FENDERING SYSTEM - 19 PANELS OF 170"

FIGURE 8. FENDERING SYSTEM - 19 PANELS OF 170"

FIGURE 9. FENDERING SYSTEM - 19 PANELS OF 170"

FIGURE 10. FENDERING SYSTEM - 19 PANELS OF 170"

FIGURE 11. FENDERING SYSTEM - 19 PANELS OF 170"

FIGURE 12. FENDERING SYSTEM - 19 PANELS OF 170"

FIGURE 13. FENDERING SYSTEM - 19 PANELS OF 170"

FIGURE 14. FENDERING SYSTEM - 19 PANELS OF 170"

FIGURE 15. FENDERING SYSTEM - 19 PANELS OF 170"

FIGURE 16. FENDERING SYSTEM - 19 PANELS OF 170"

FIGURE 17. FENDERING SYSTEM - 19 PANELS OF 170"

FIGURE 18. FENDERING SYSTEM - 19 PANELS OF 170"

FIGURE 19. FENDERING SYSTEM - 19 PANELS OF 170"

FIGURE 20. FENDERING SYSTEM - 19 PANELS OF 170"

FIGURE 21. FENDERING SYSTEM - 19 PANELS OF 170"

FIGURE 22. FENDERING SYSTEM - 19 PANELS OF 170"

FIGURE 23. FENDERING SYSTEM - 19 PANELS OF 170"

FIGURE 24. FENDERING SYSTEM - 19 PANELS OF 170"

FIGURE 25. FENDERING SYSTEM - 19 PANELS OF 170"

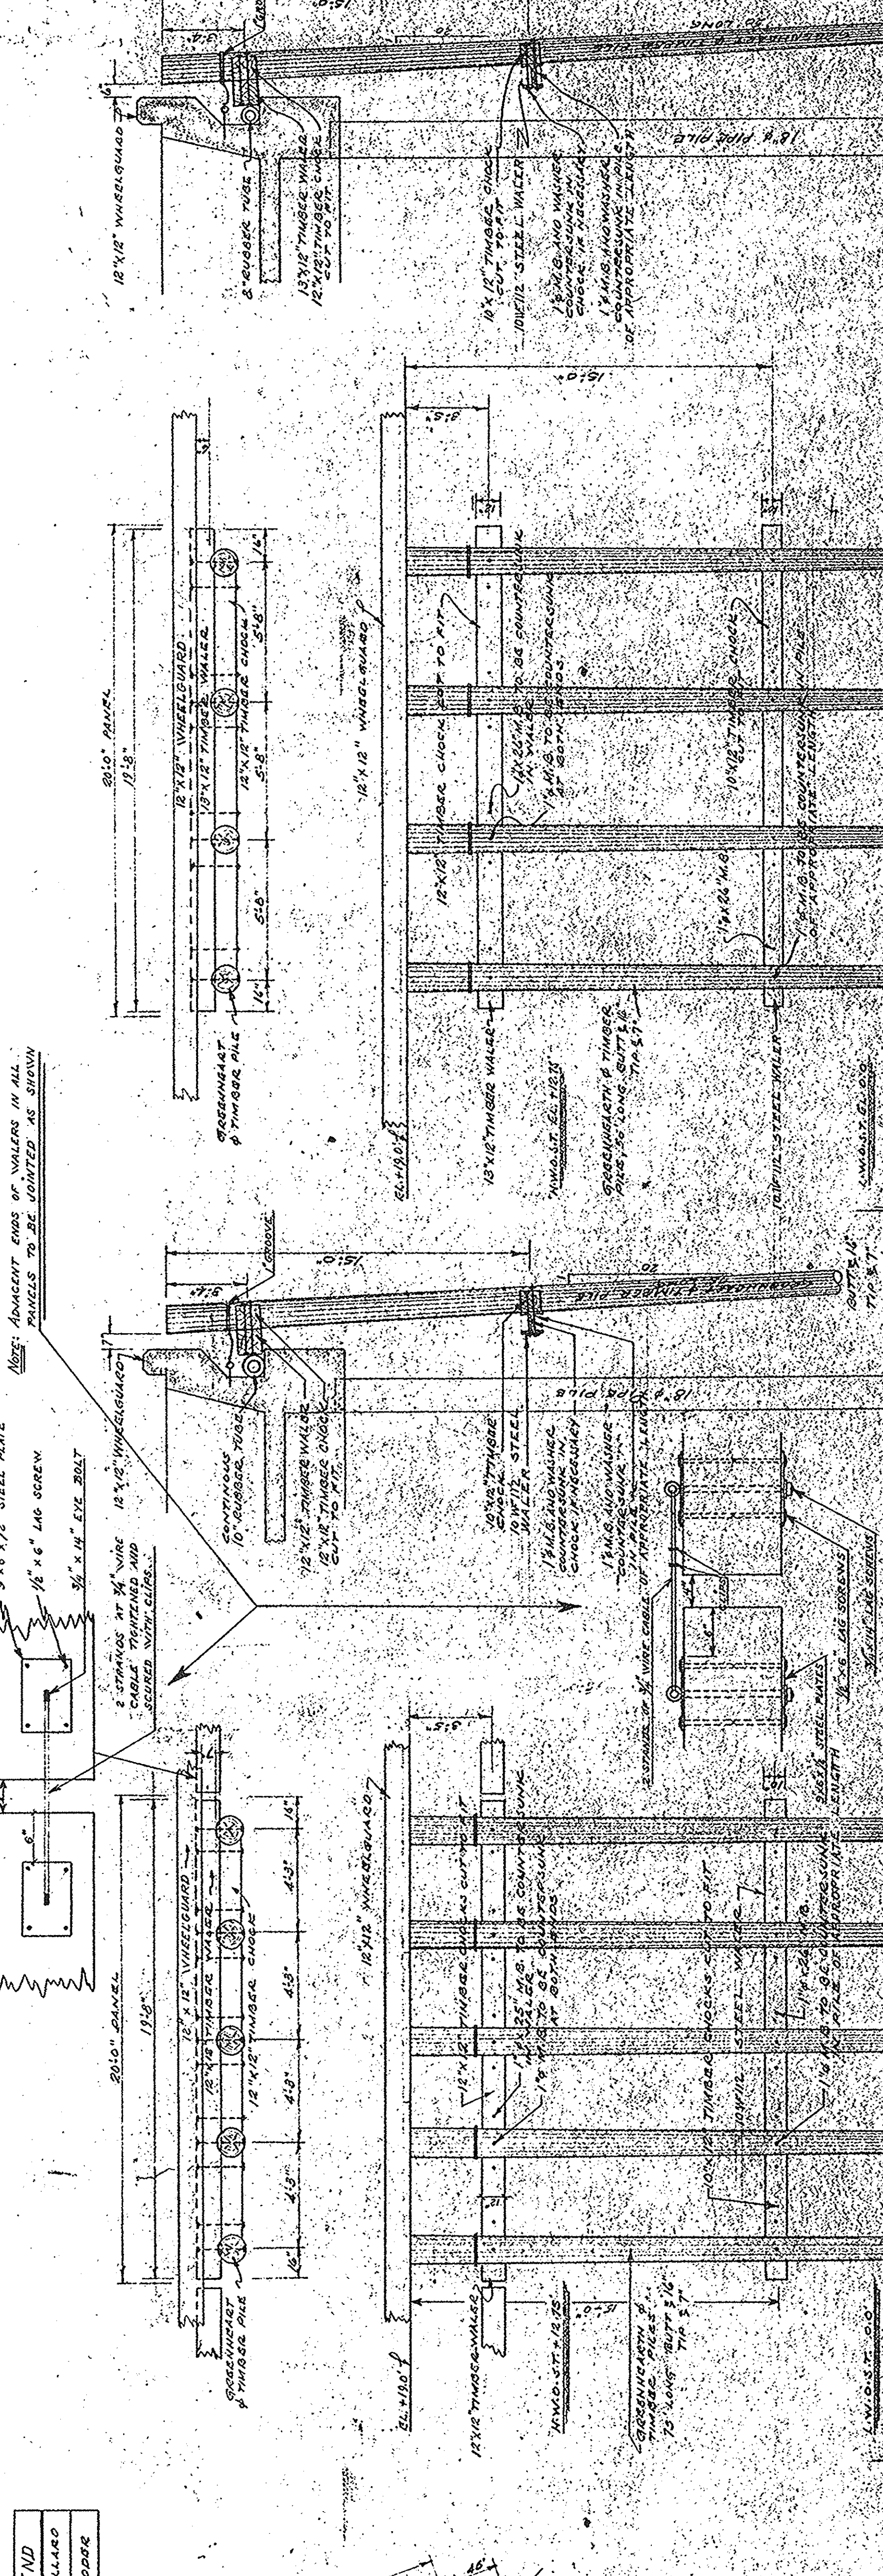


FIGURE 26. FENDERING PANEL TYPE A

FIGURE 27. FENDERING PANEL TYPE B

FIGURE 28. FENDERING PANEL TYPE C

FIGURE 29. FENDERING PANEL TYPE D

FIGURE 30. FENDERING PANEL TYPE E

FIGURE 31. FENDERING PANEL TYPE F

FIGURE 32. FENDERING PANEL TYPE G

FIGURE 33. FENDERING PANEL TYPE H

FIGURE 34. FENDERING PANEL TYPE I

FIGURE 35. FENDERING PANEL TYPE J

FIGURE 36. FENDERING PANEL TYPE K

FIGURE 37. FENDERING PANEL TYPE L

FIGURE 38. FENDERING PANEL TYPE M

FIGURE 39. FENDERING PANEL TYPE N

FIGURE 40. FENDERING PANEL TYPE O

FIGURE 41. FENDERING PANEL TYPE P

FIGURE 42. FENDERING PANEL TYPE Q

FIGURE 43. FENDERING PANEL TYPE R

FIGURE 44. FENDERING PANEL TYPE S

FIGURE 45. FENDERING PANEL TYPE T

FIGURE 46. FENDERING PANEL TYPE U

FIGURE 47. FENDERING PANEL TYPE V



Department of Public Works

Ministère des Travaux publics

AS BUILT

DESIGNED BY: [Signature]

DATE: [Date]

REVISIONS

APPROVED BY: [Signature]

SCALE: 1/4" = 1'-0"

FIGURE 48. FENDERING PANEL TYPE W

FIGURE 49. FENDERING PANEL TYPE X