



Ministère
des Travaux
Publics

REDACTED, MASSARD & THIBEAULT
CONSULTING ENGINEERS
88 CROIX-DE-LOUIS, MONTRÉAL, QUE.

A. detail no.
B. location
C. drawing no.

date
5 SEP 1968

revisions
DATE REV.

NOTE: WATER PIPE INSIDE
TUNNEL IS ISOLATED AND
HEATED. (WORKS DONE
BY P.W.D.)

AS BUILT
NUMÉRISE




Job title:
Title du projet:
MAGNAN, MANCINI & ASSOC., INC.
HAZBOURNE IMPROVEMENTS
PHASE C - "WINDWARD"


Drawing title:
Title du dessin:
SERVICE TUNNEL AND
WATER CONDUITS
LOCATION OF FUTURE
RAILROAD

designed by
checked by
approved by
no. du projet:
C.A. M-17-10


10 of 15

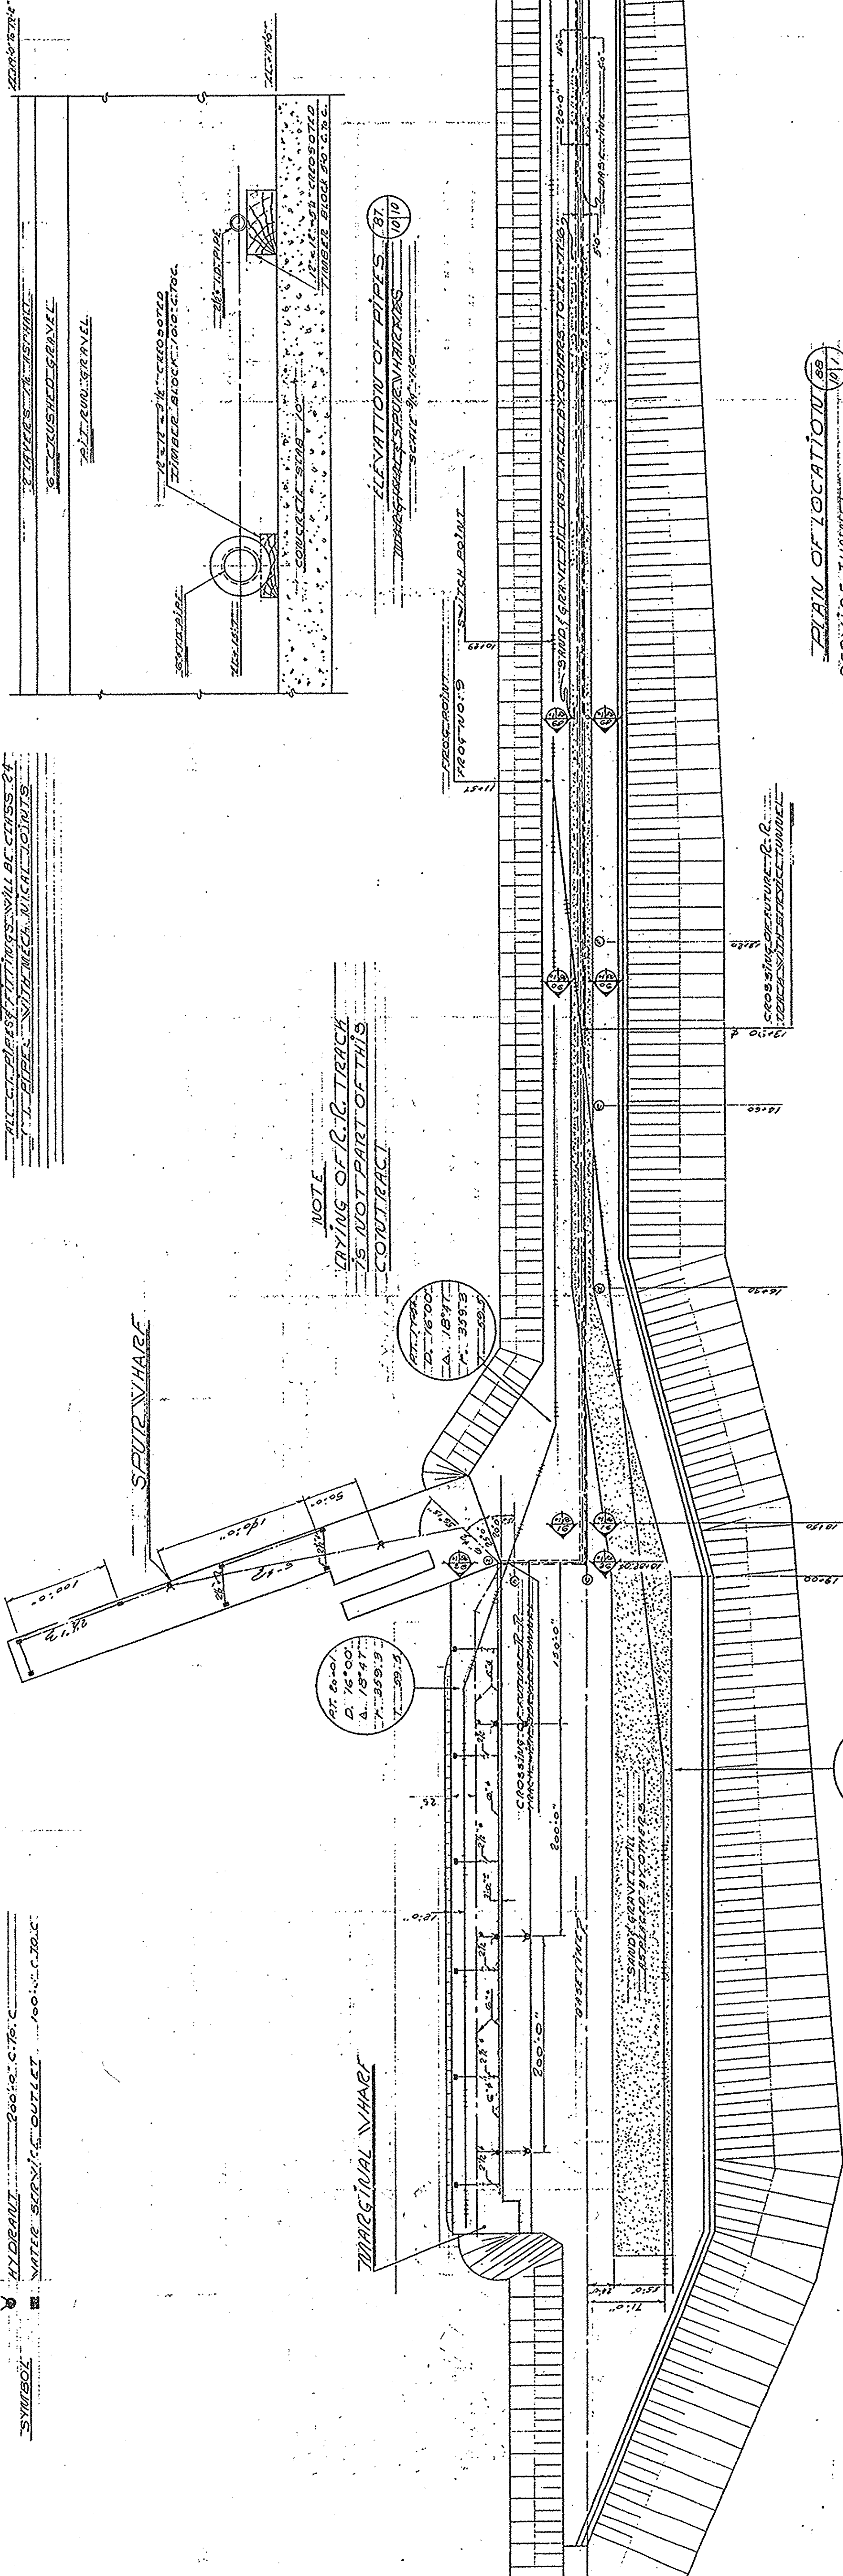


PLAN OF LOCATION
SERVICE TUNNEL
WATER CONDUITS
TUNNEL 100-0-0
SCALE 1"=100-0-0

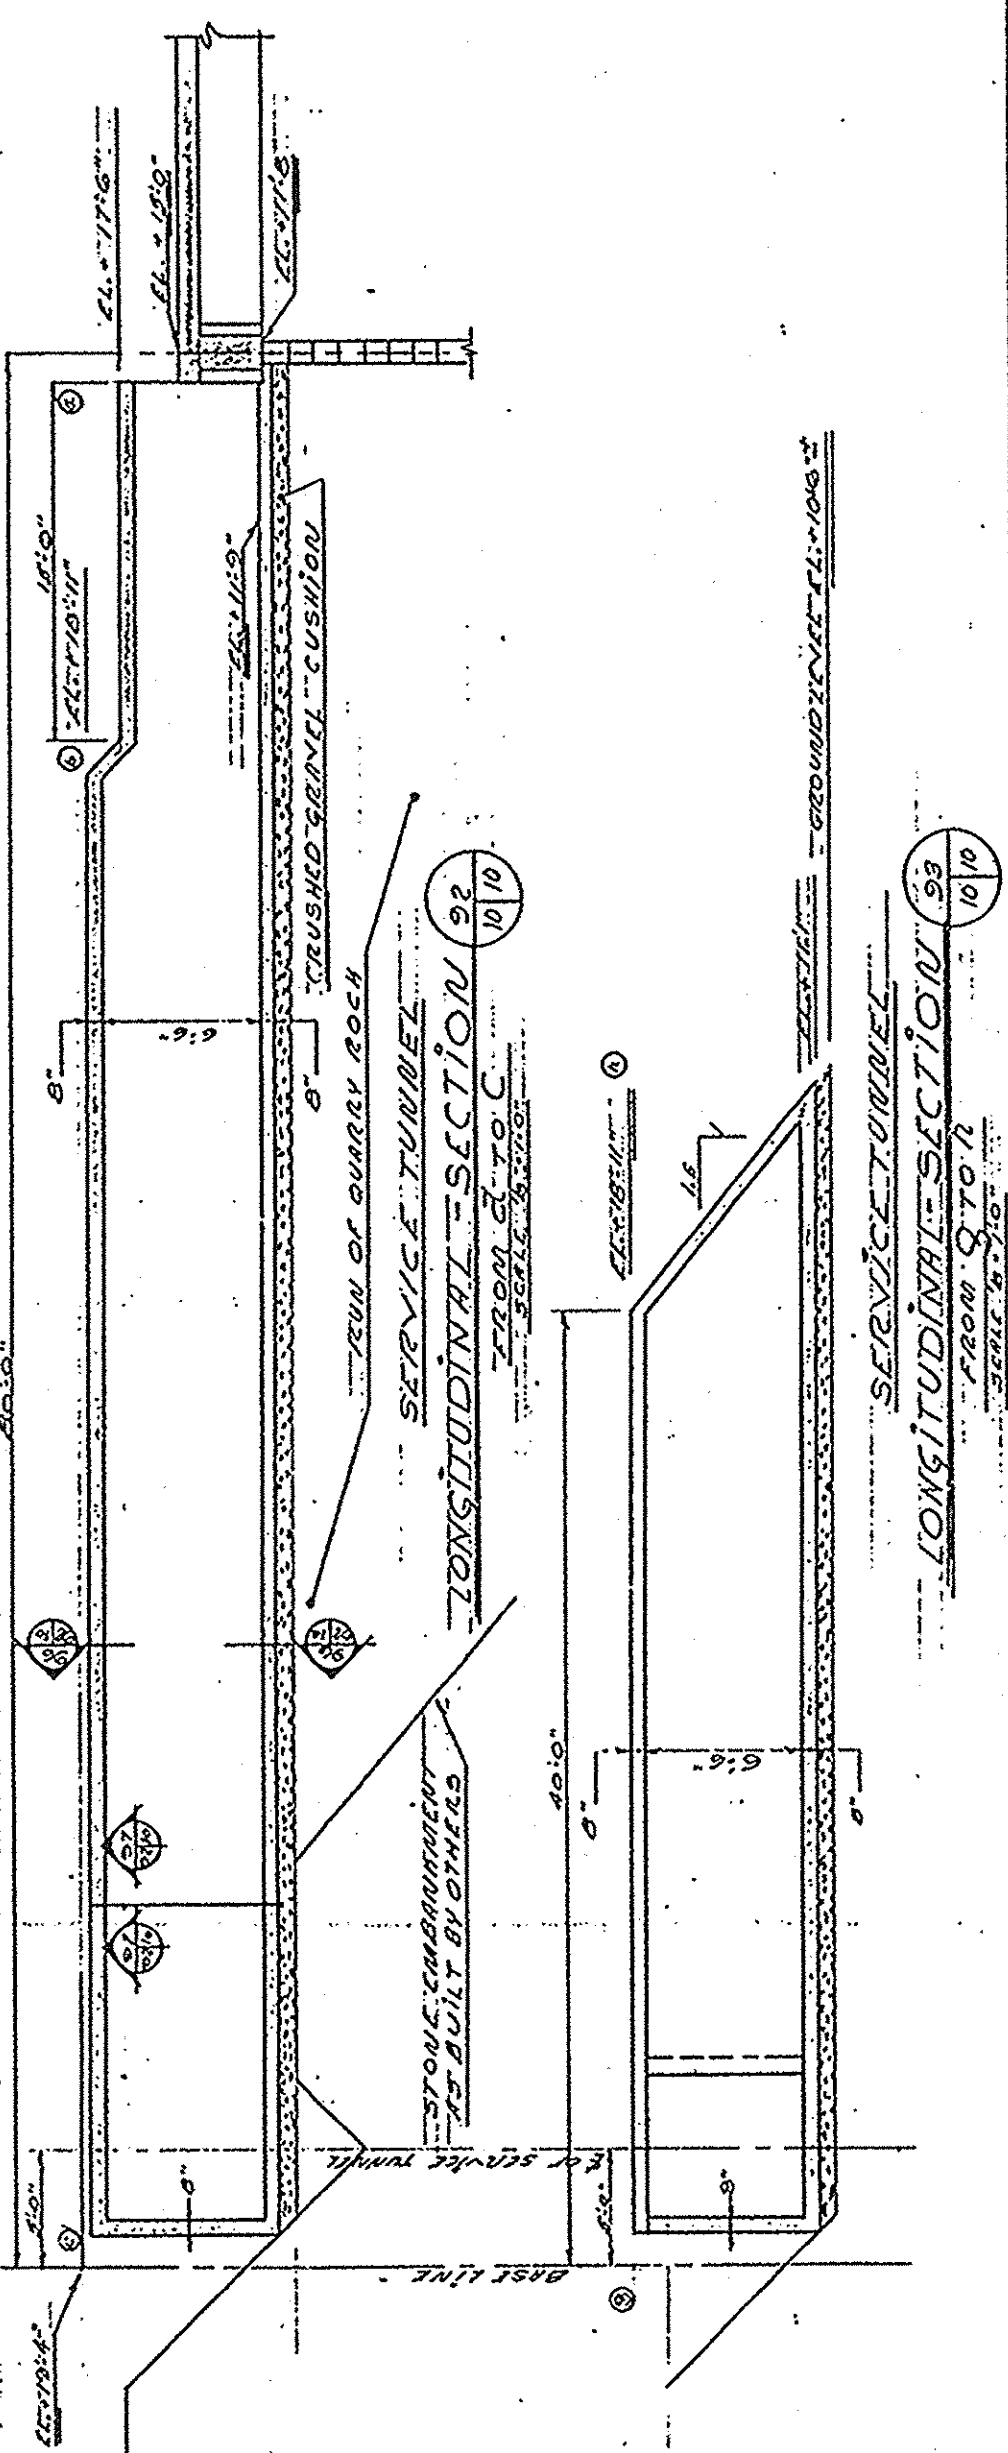


LONGITUDINAL SECTION
SERVICE TUNNEL
FROM 100-0-0 TO 100-100-0
SCALE 1"=100-0-0

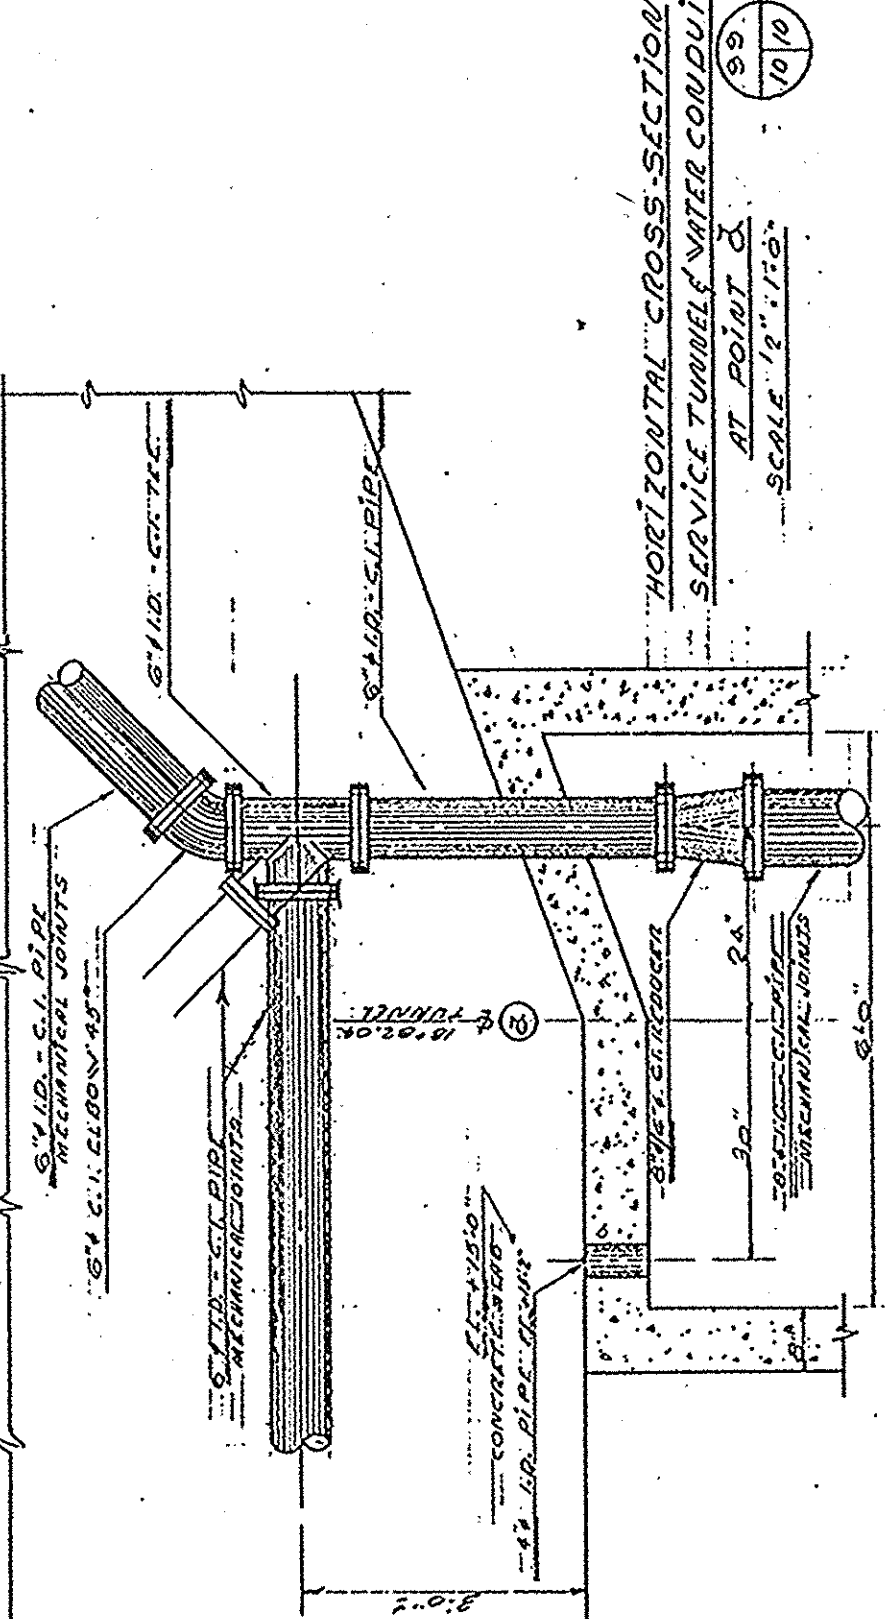


NORTH-SOUTH CROSS SECTION
SERVICE TUNNEL WATER CONDUIT
AT POINT 100-0-0
SCALE 1"=100-0-0

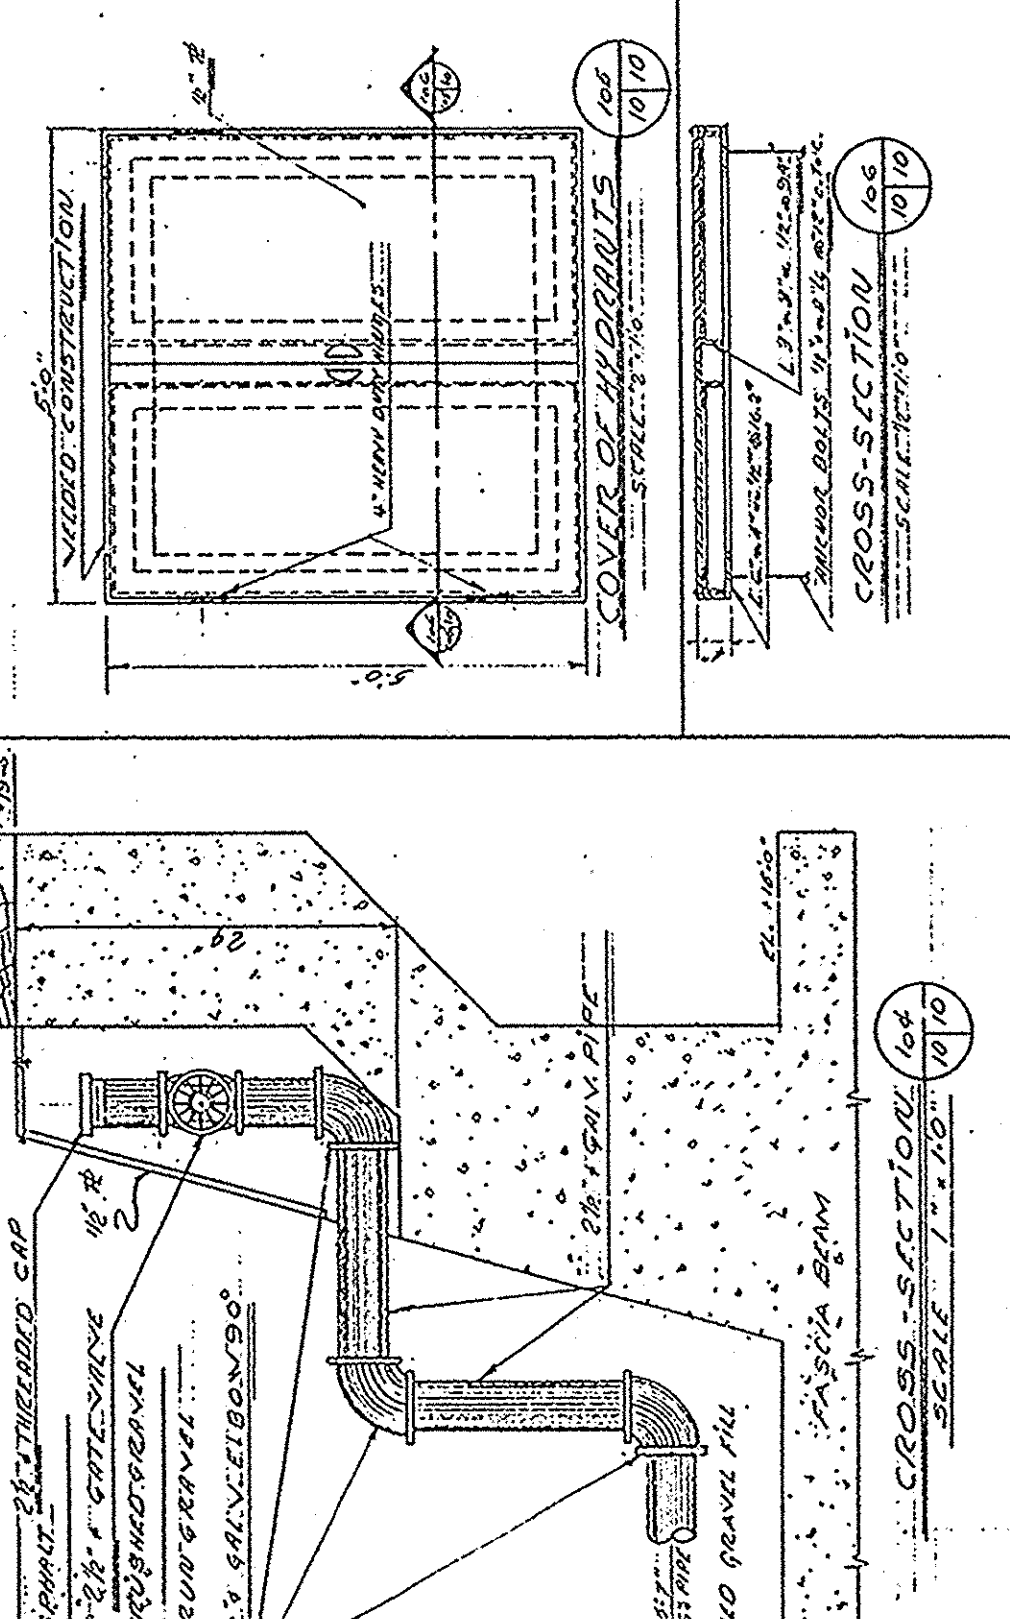


CROSS SECTION
SERVICE TUNNEL
AT POINT 100-0-0
SCALE 1"=100-0-0

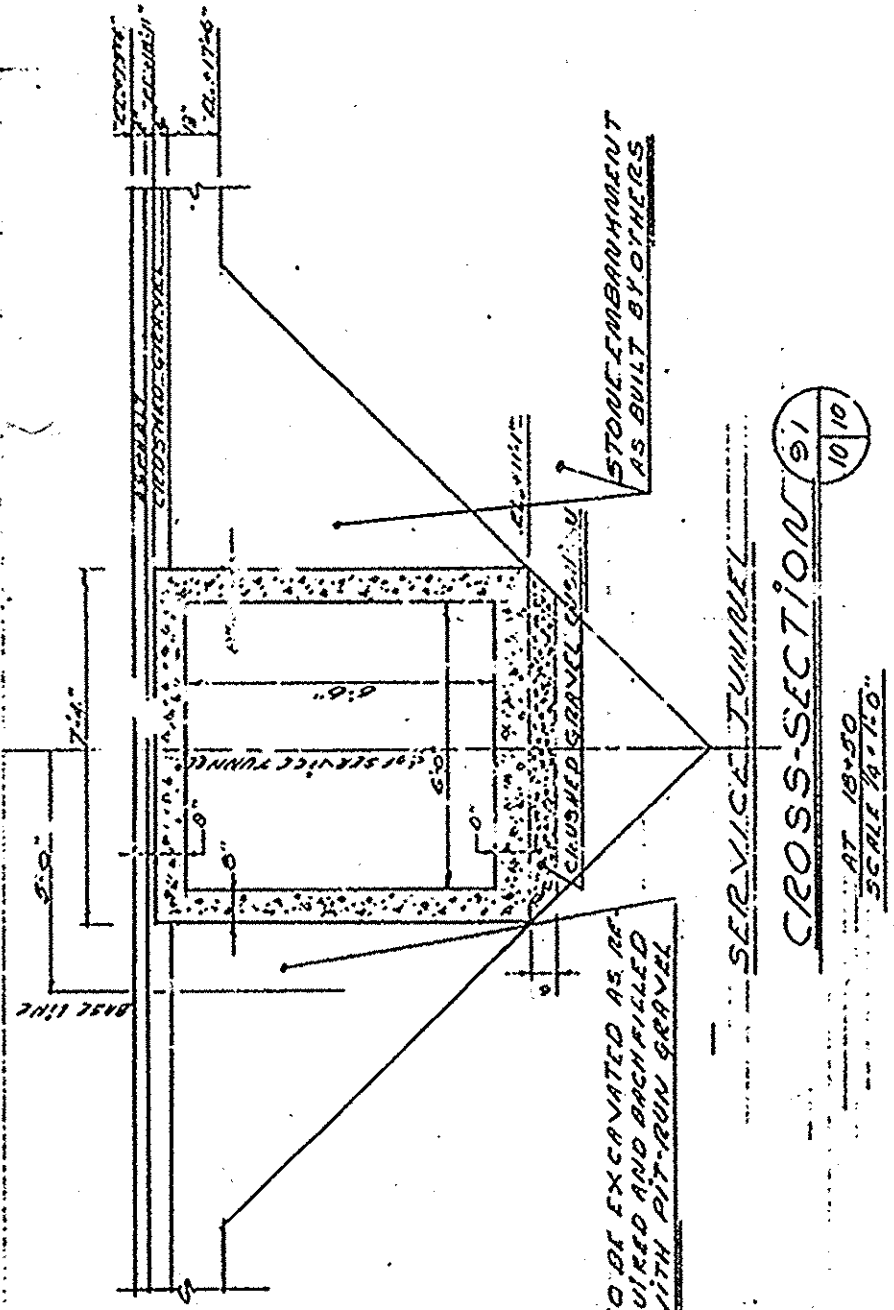


CROSS SECTION
SERVICE TUNNEL
AT POINT 100-0-0
SCALE 1"=100-0-0

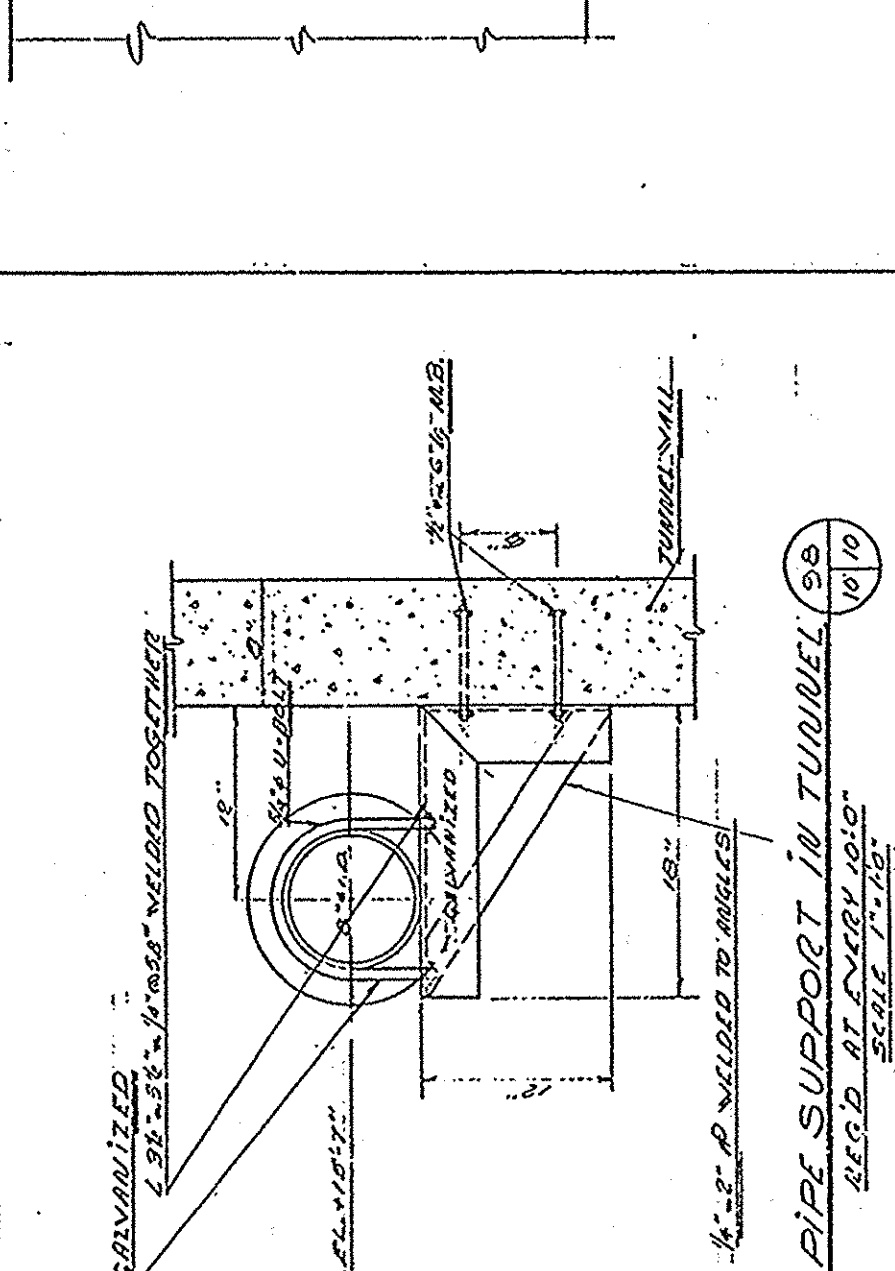


CROSS SECTION
SERVICE TUNNEL
AT POINT 100-0-0
SCALE 1"=100-0-0

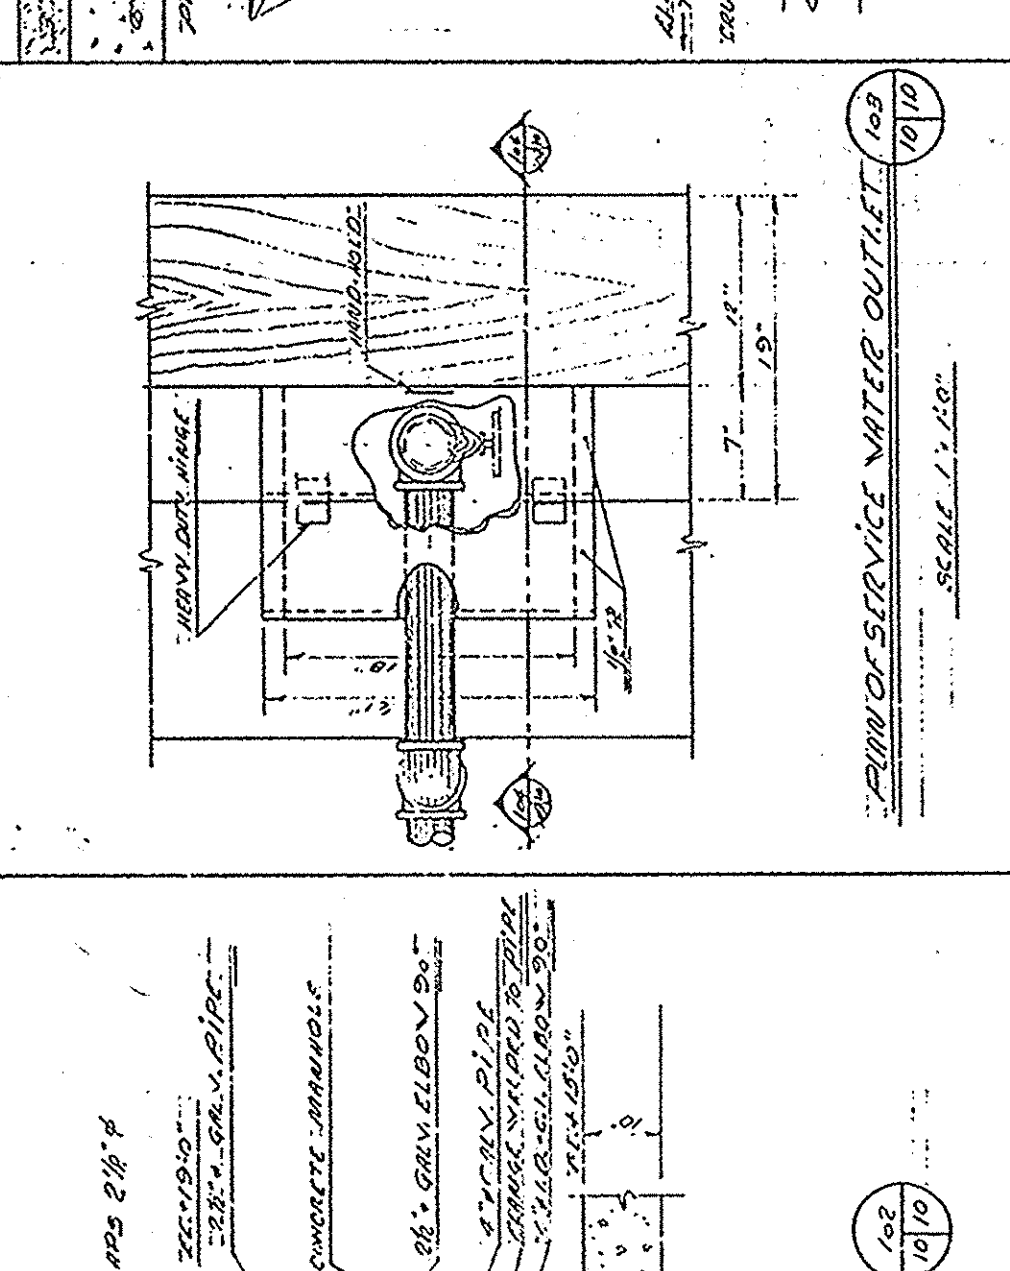


CROSS SECTION
SERVICE TUNNEL
AT POINT 100-0-0
SCALE 1"=100-0-0

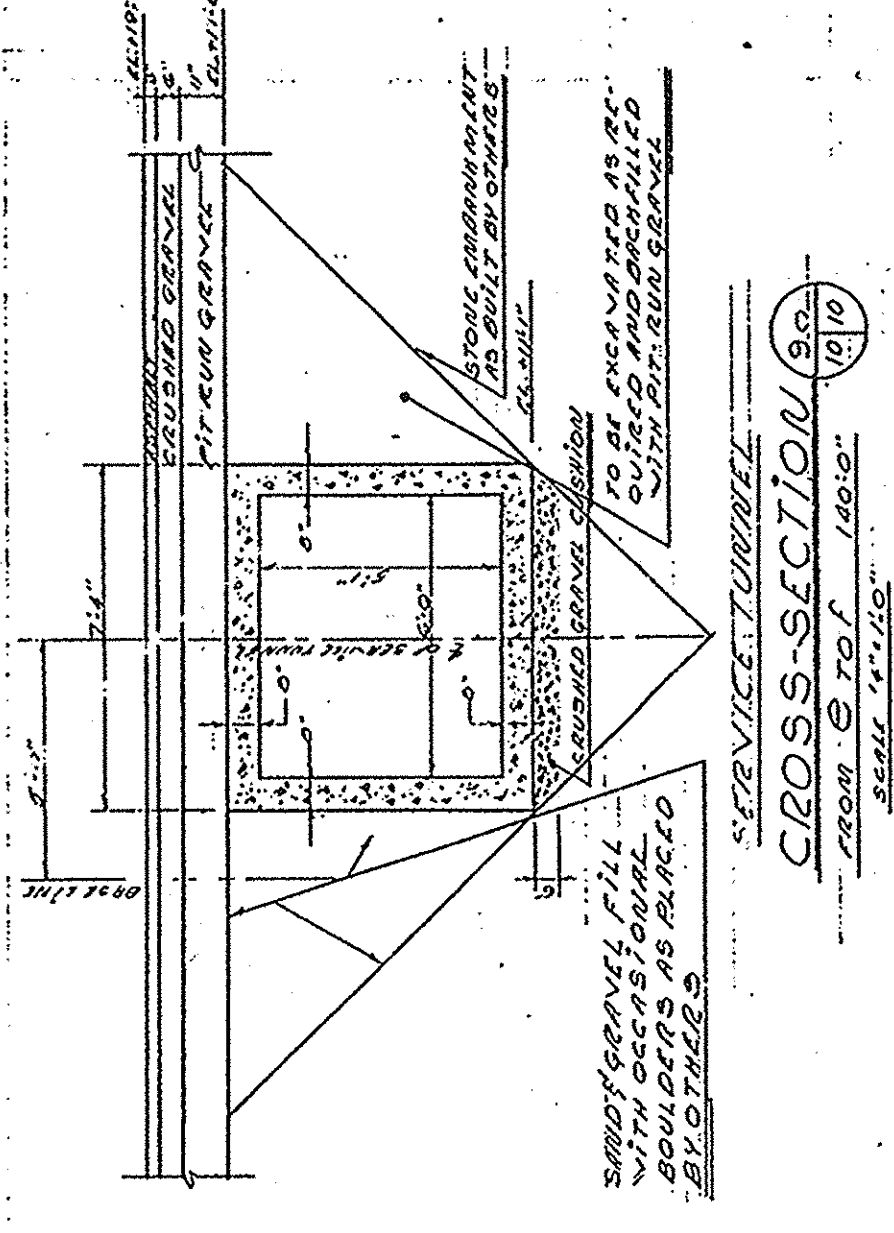


CROSS SECTION
SERVICE TUNNEL
AT POINT 100-0-0
SCALE 1"=100-0-0

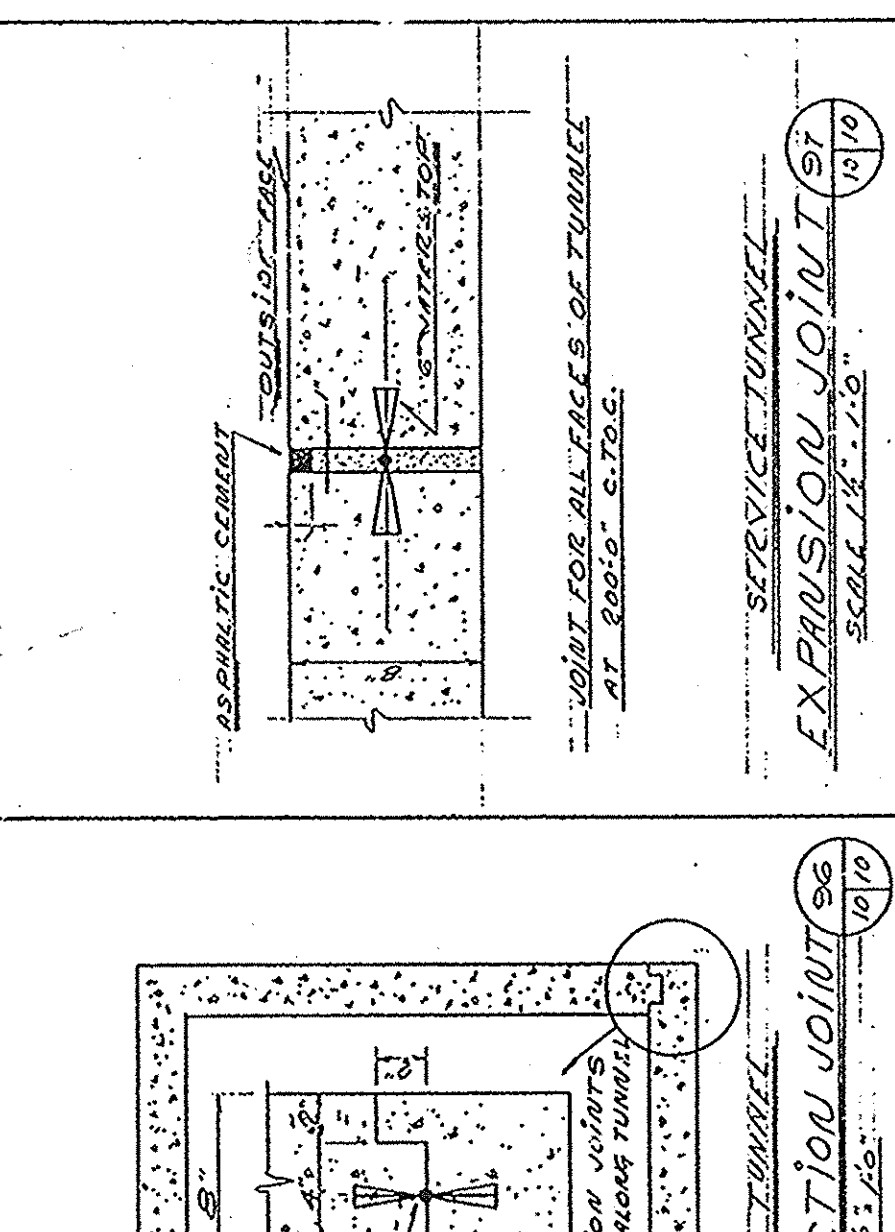


CROSS SECTION
SERVICE TUNNEL
AT POINT 100-0-0
SCALE 1"=100-0-0

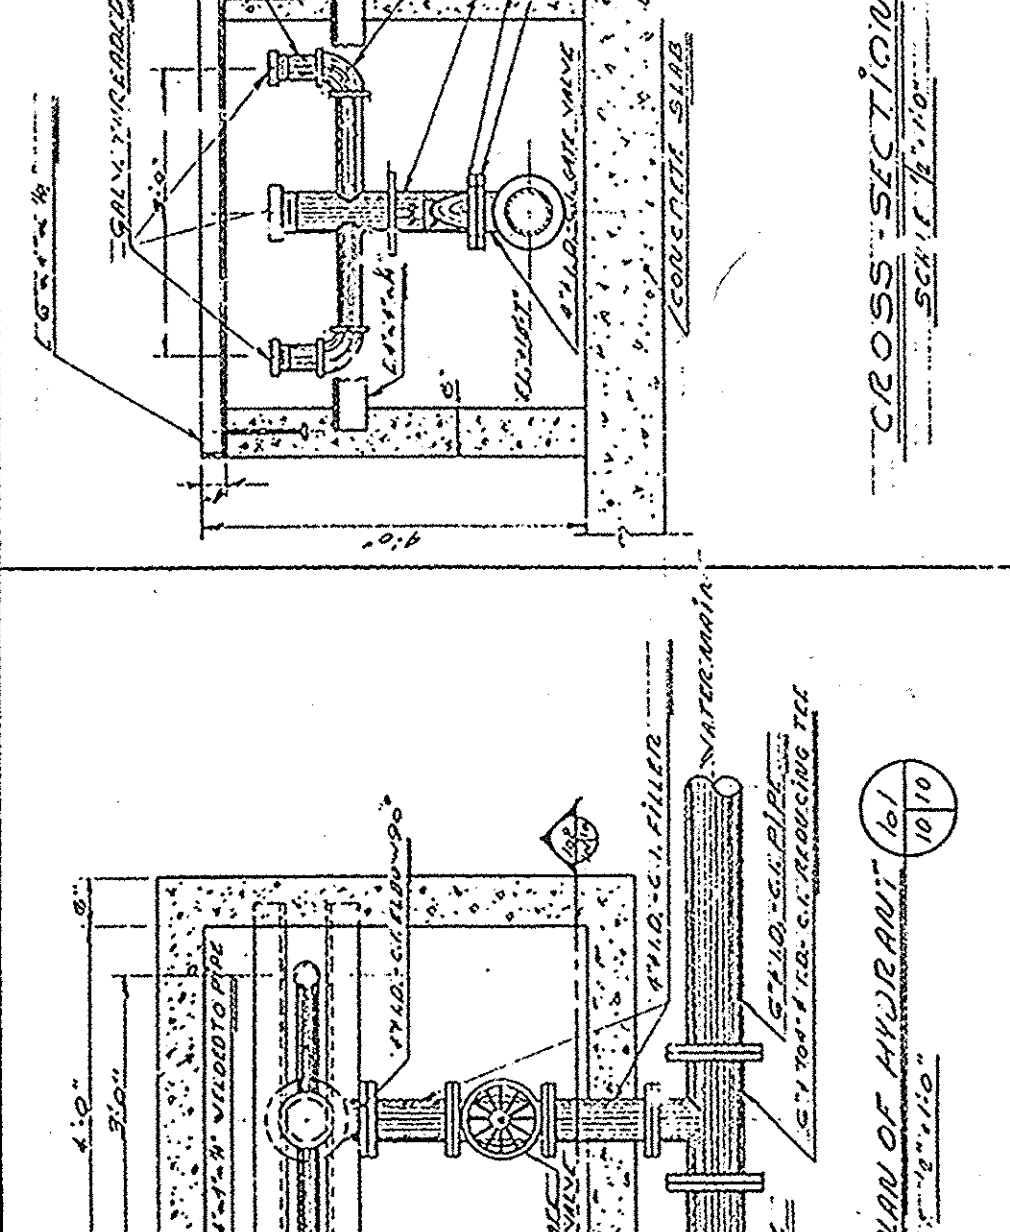


CROSS SECTION
SERVICE TUNNEL
AT POINT 100-0-0
SCALE 1"=100-0-0

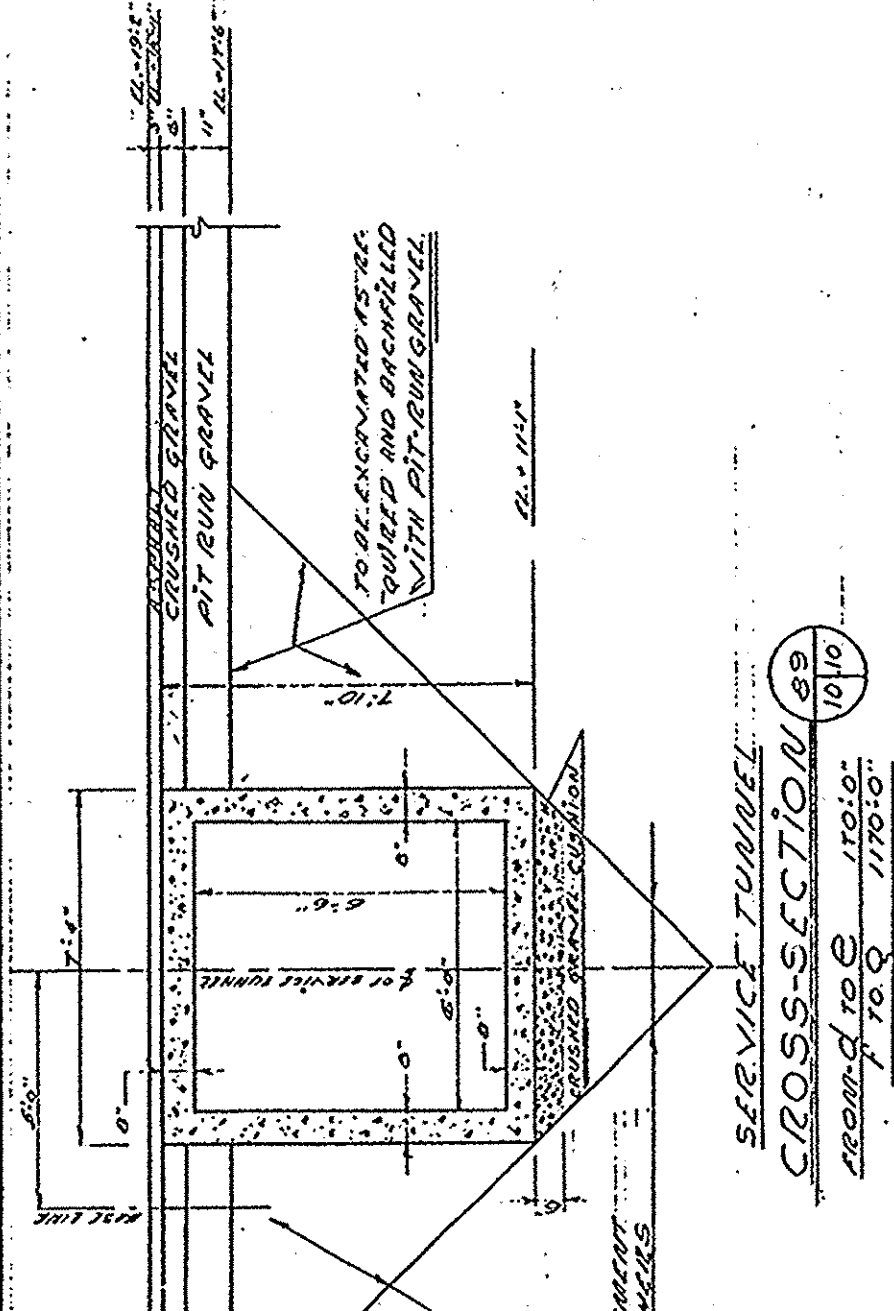


CROSS SECTION
SERVICE TUNNEL
AT POINT 100-0-0
SCALE 1"=100-0-0

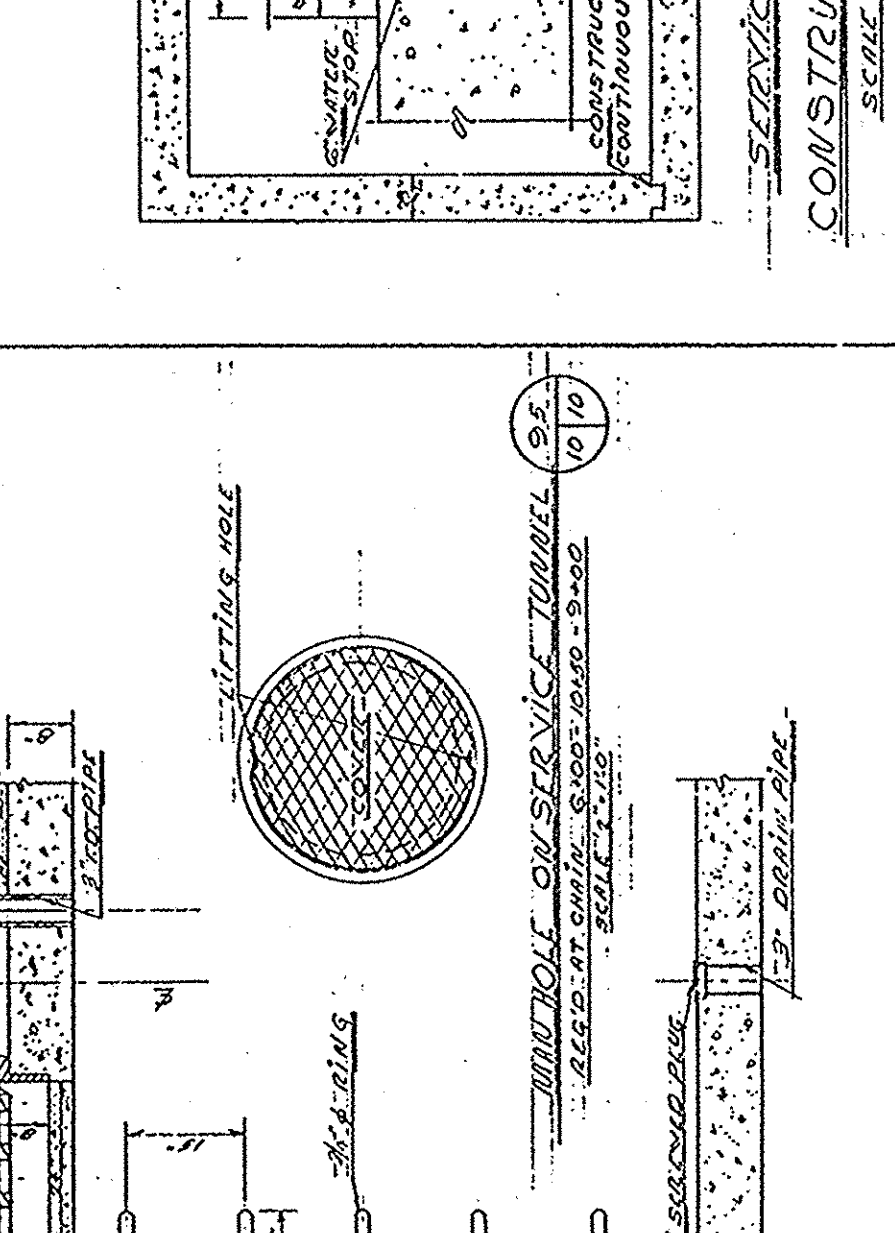


CROSS SECTION
SERVICE TUNNEL
AT POINT 100-0-0
SCALE 1"=100-0-0

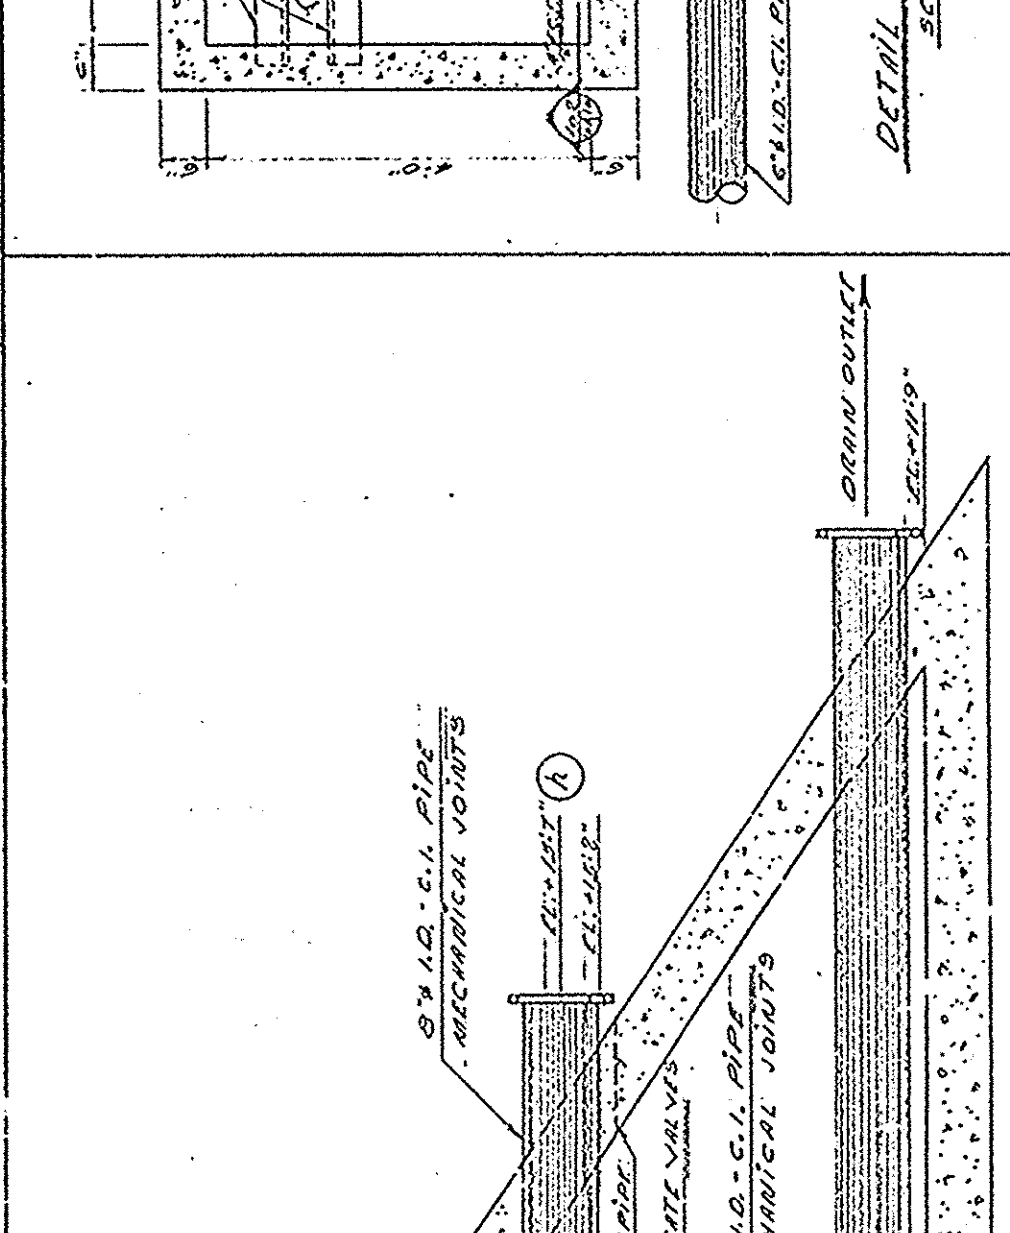


CROSS SECTION
SERVICE TUNNEL
AT POINT 100-0-0
SCALE 1"=100-0-0

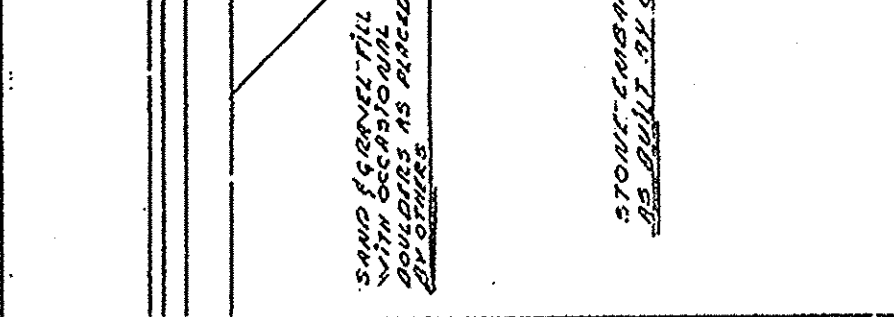

CROSS SECTION
SERVICE TUNNEL
AT POINT 100-0-0
SCALE 1"=100-0-0

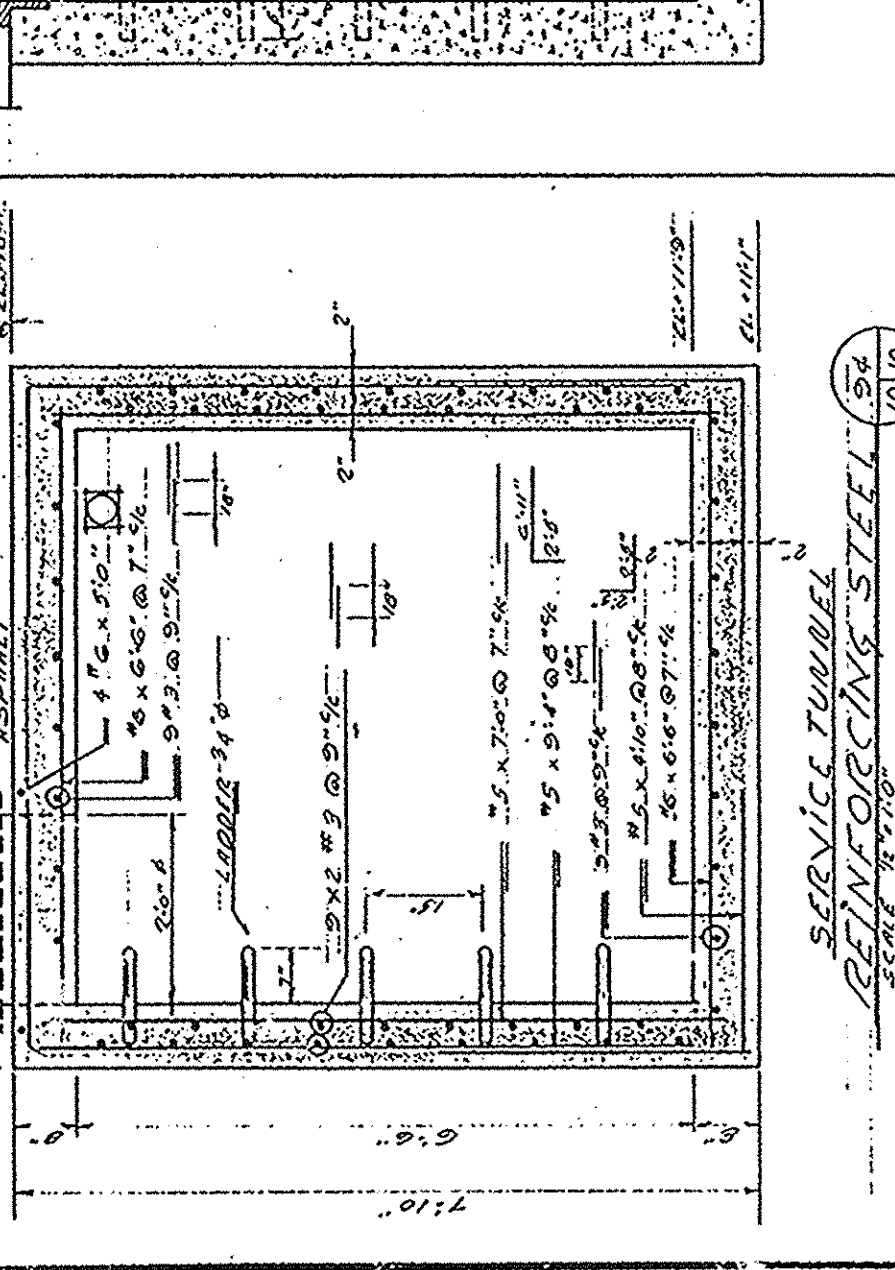

CROSS SECTION
SERVICE TUNNEL
AT POINT 100-0-0
SCALE 1"=100-0-0

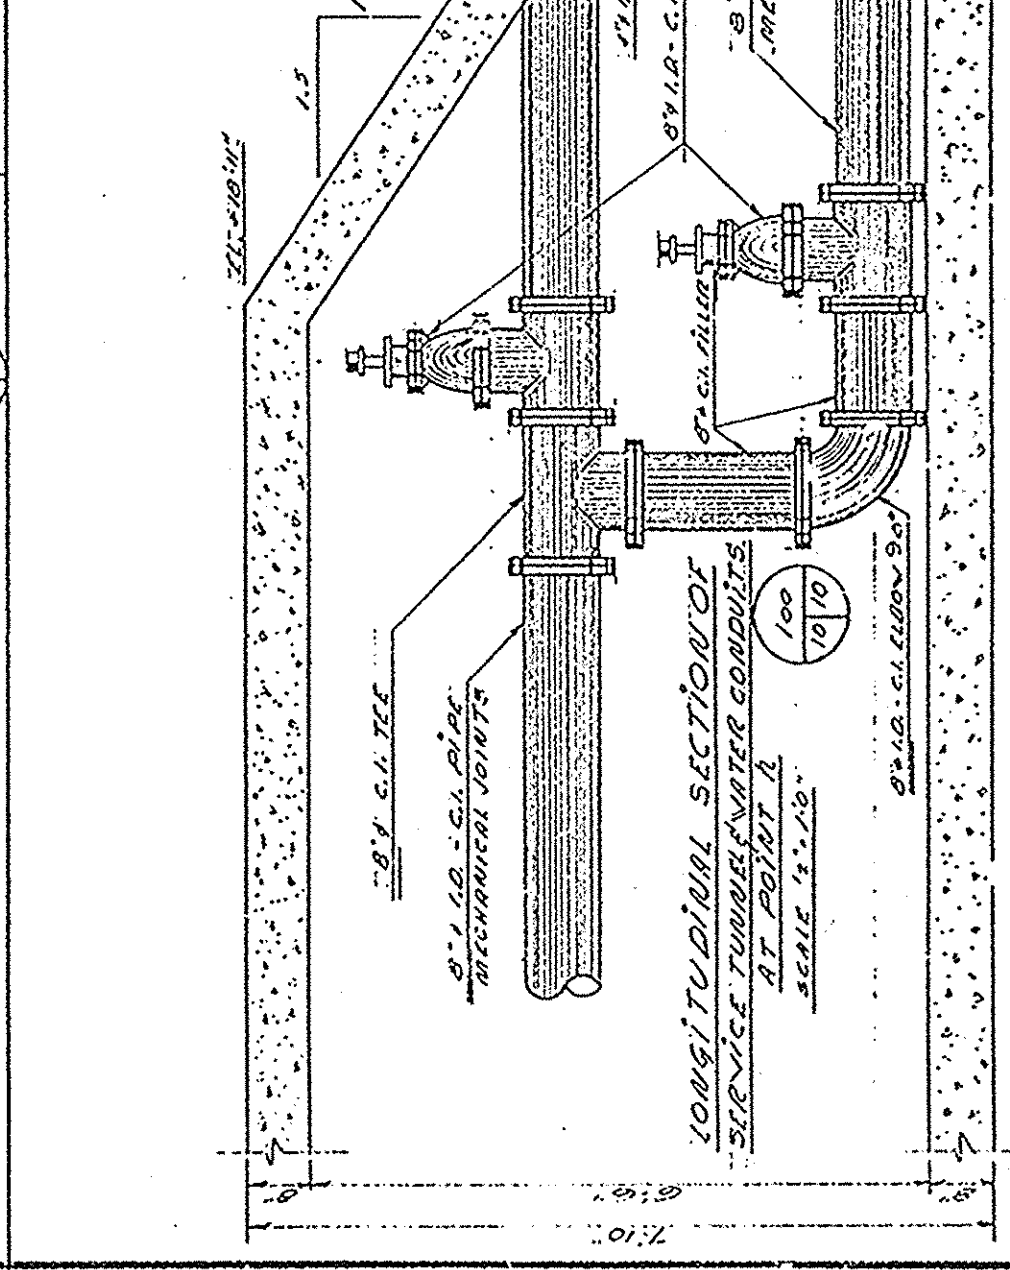

CROSS SECTION
SERVICE TUNNEL
AT POINT 100-0-0
SCALE 1"=100-0-0