



Ministère  
des Travaux  
Publics

Department  
of Public  
Works

MEVARD, MARSHALL & THIBEAULT  
CONSULTING ENGINEERS  
88 QUEEN STREET WEST, TORONTO, CAN.

A. detail no.  
B. location  
C. drawing no.  
D. sheet no.

DATE  
3-25-77, 1988

PROJECT  
GENERAL




















Job title:  
Title du projet:  
MAYNARD, MARSHALL & THIBEAULT  
CONSULTING ENGINEERS  
88 QUEEN STREET WEST, TORONTO, CAN.

Drawing title:  
Title du dessin:

CROSS-SECTIONS  
OF SUPERSTRUCTURE

Designed by:  
Checked by:  
Reviewed by:  
Examined by:  
Approved by:  
Job number:  
Job title:  
Date:  
Scale:  
Sheet no.  
Total sheets

AS BUILT

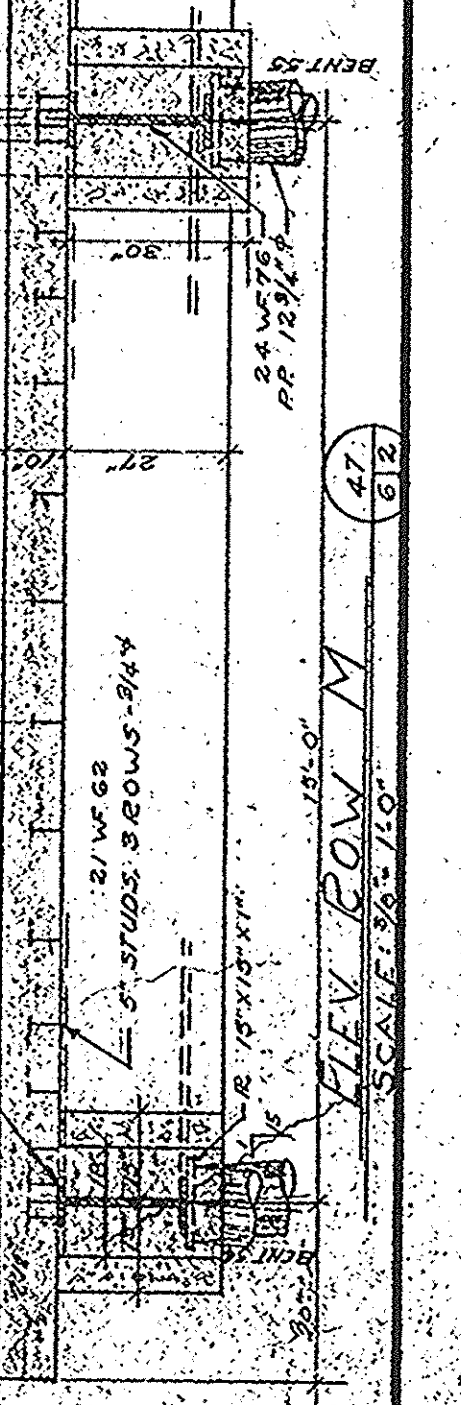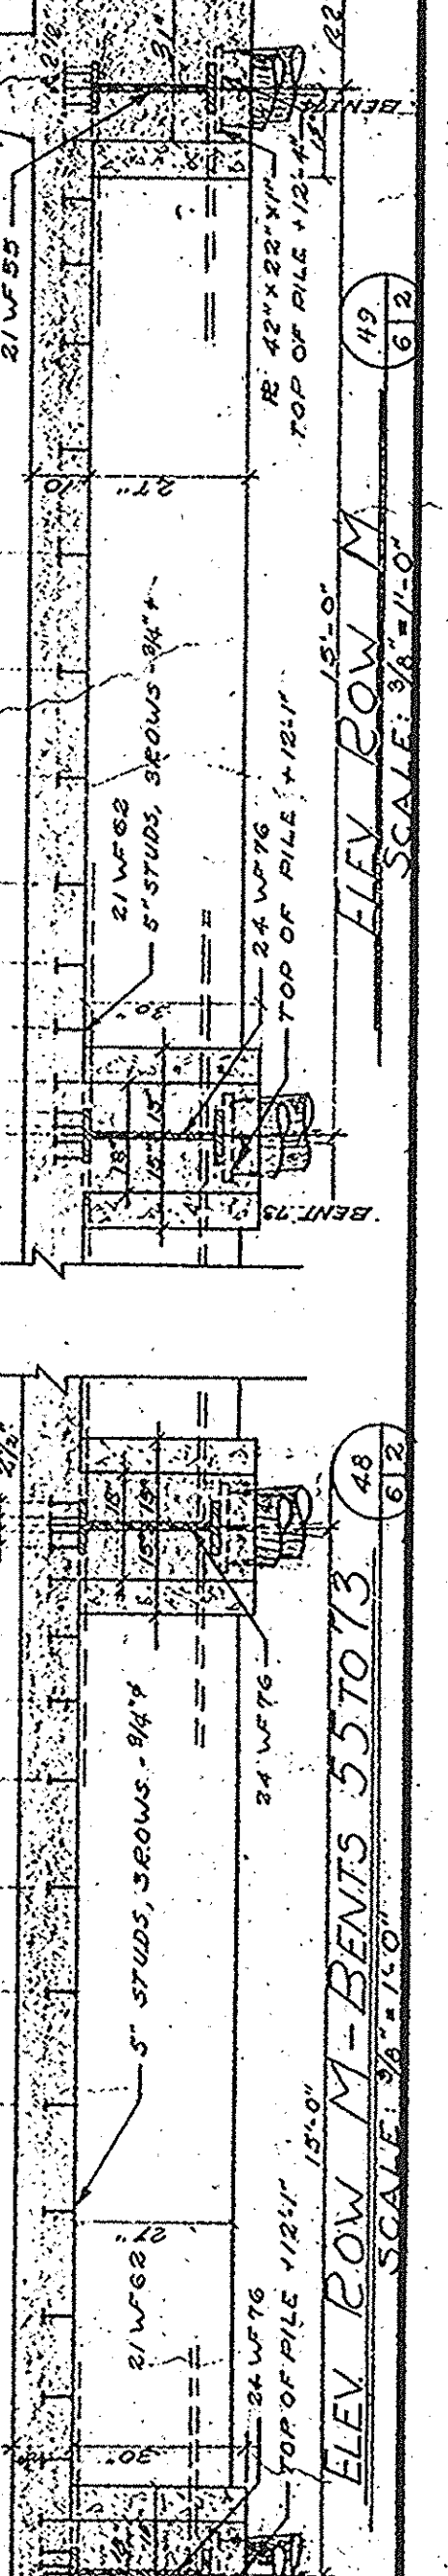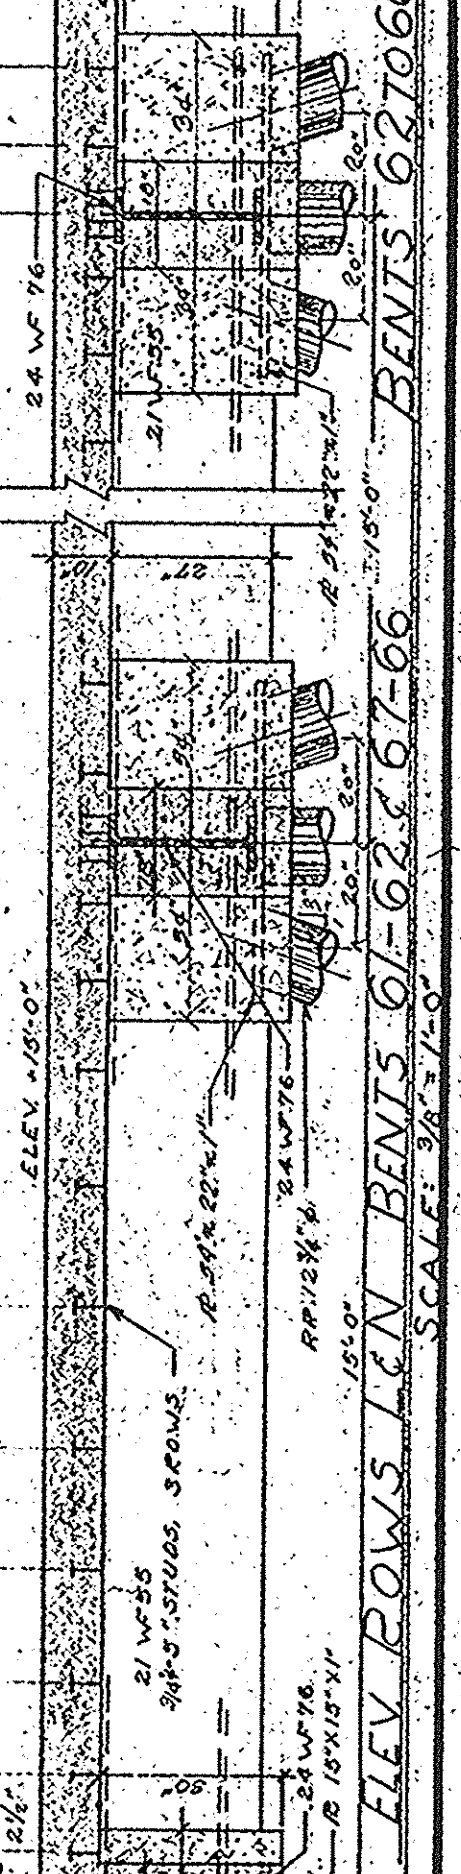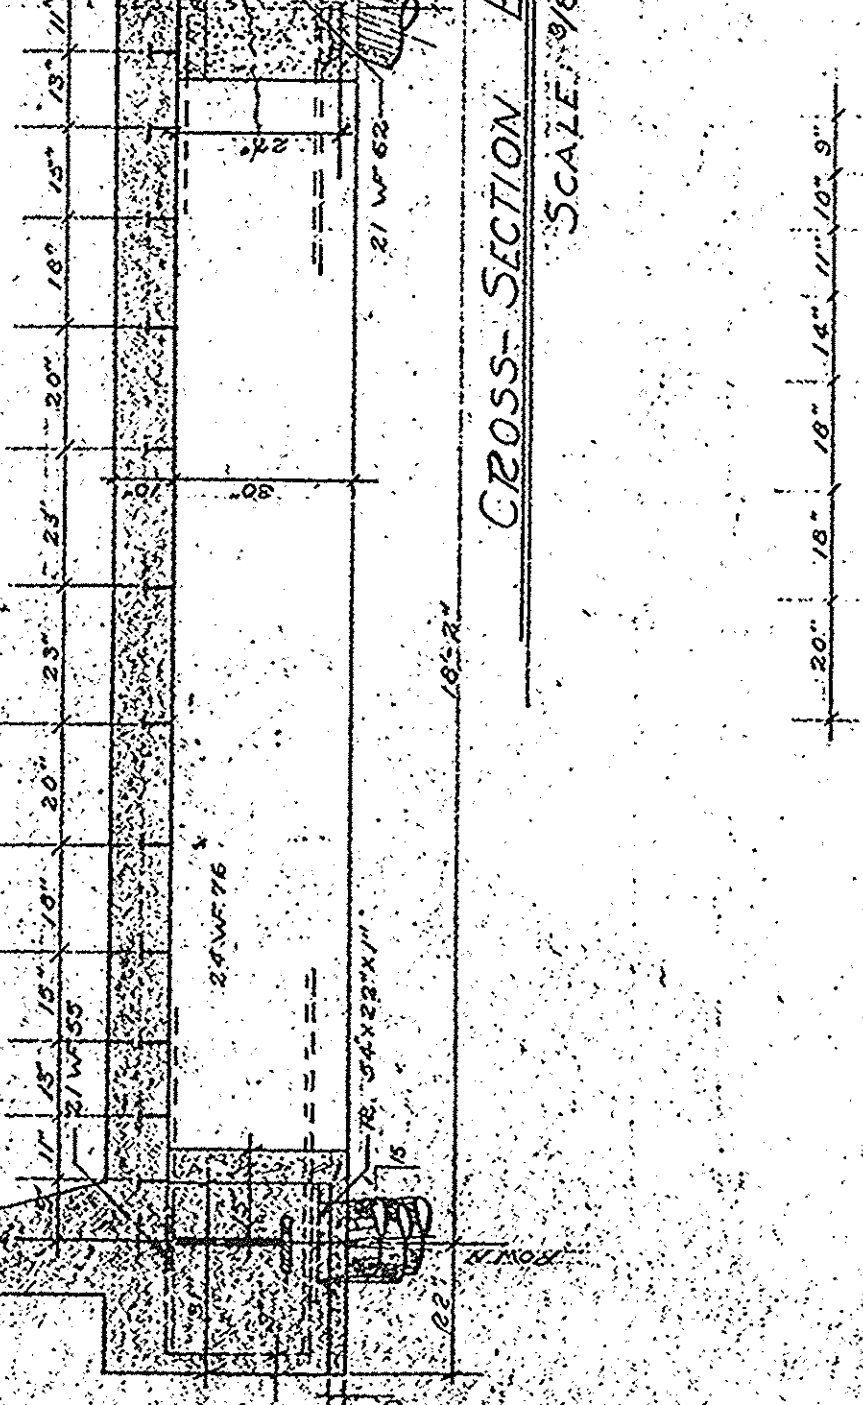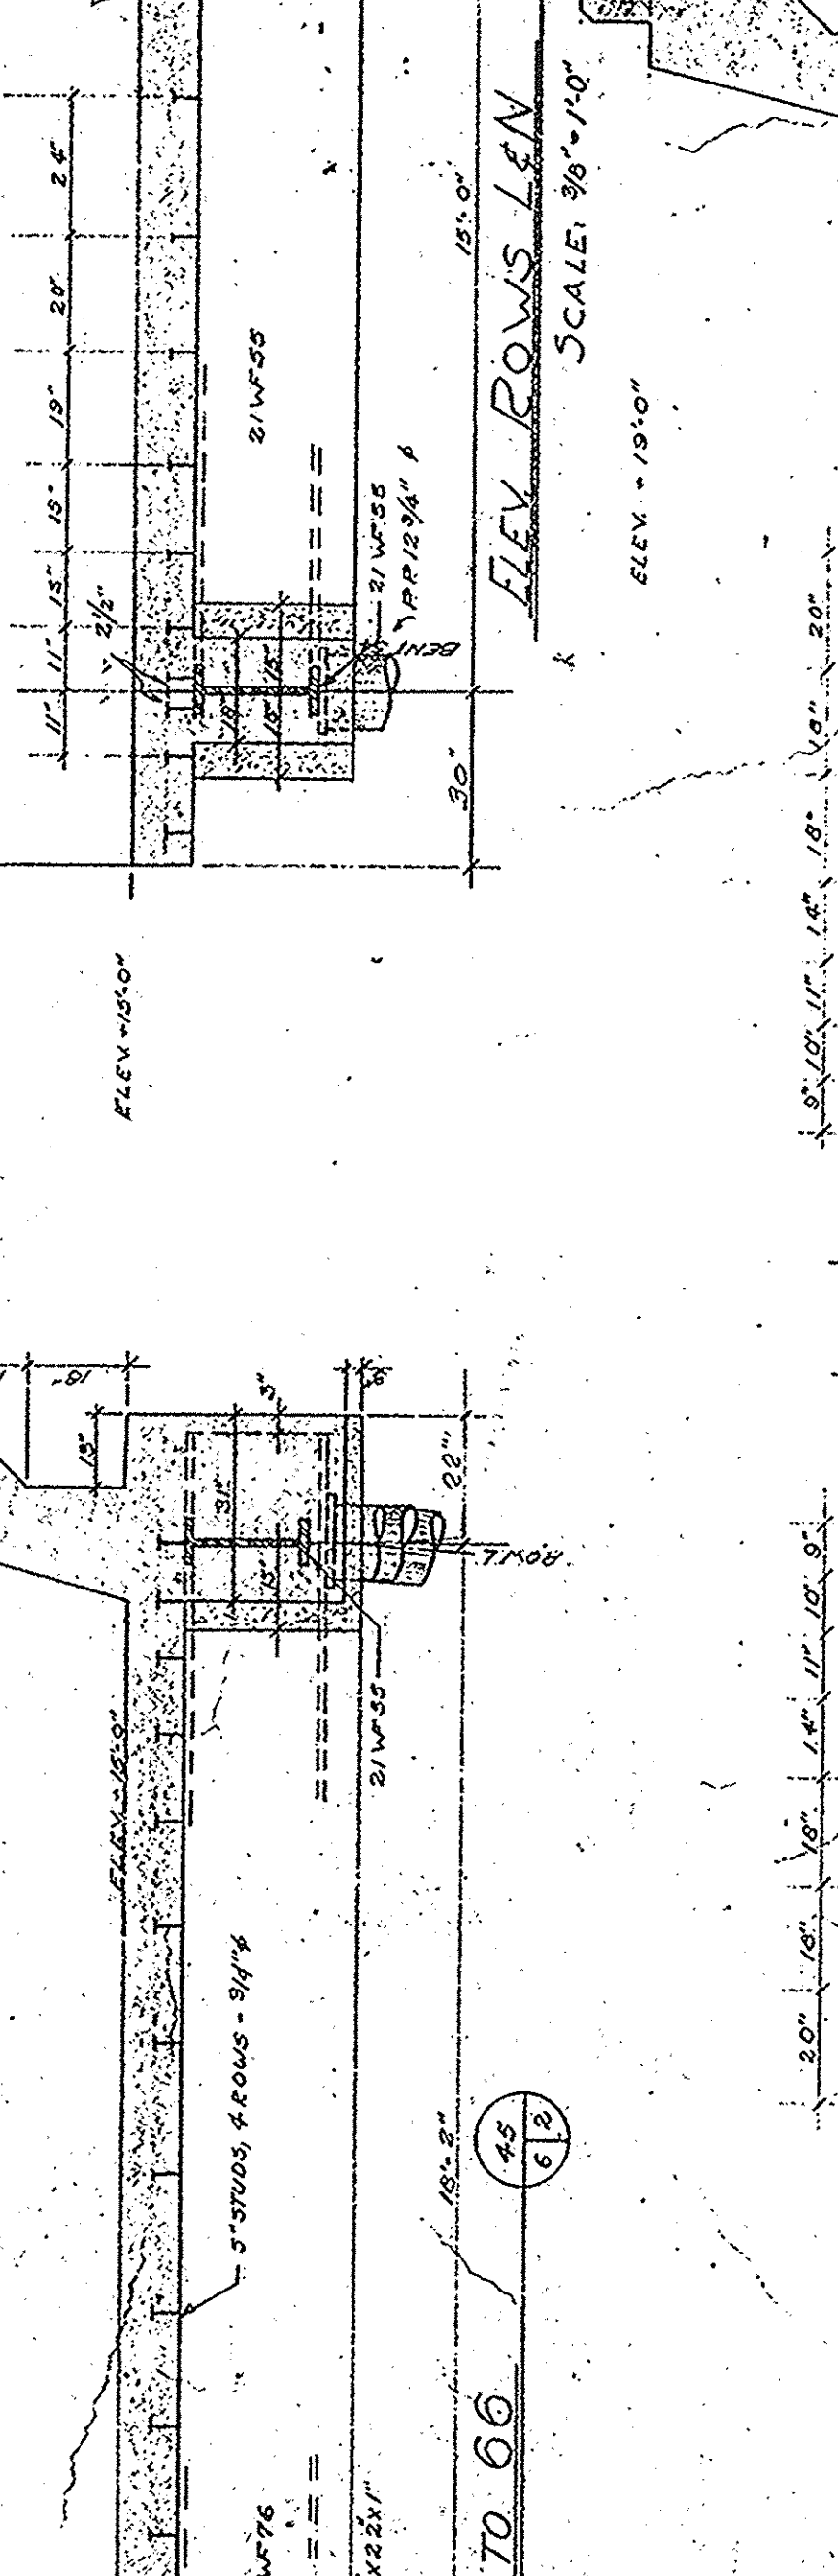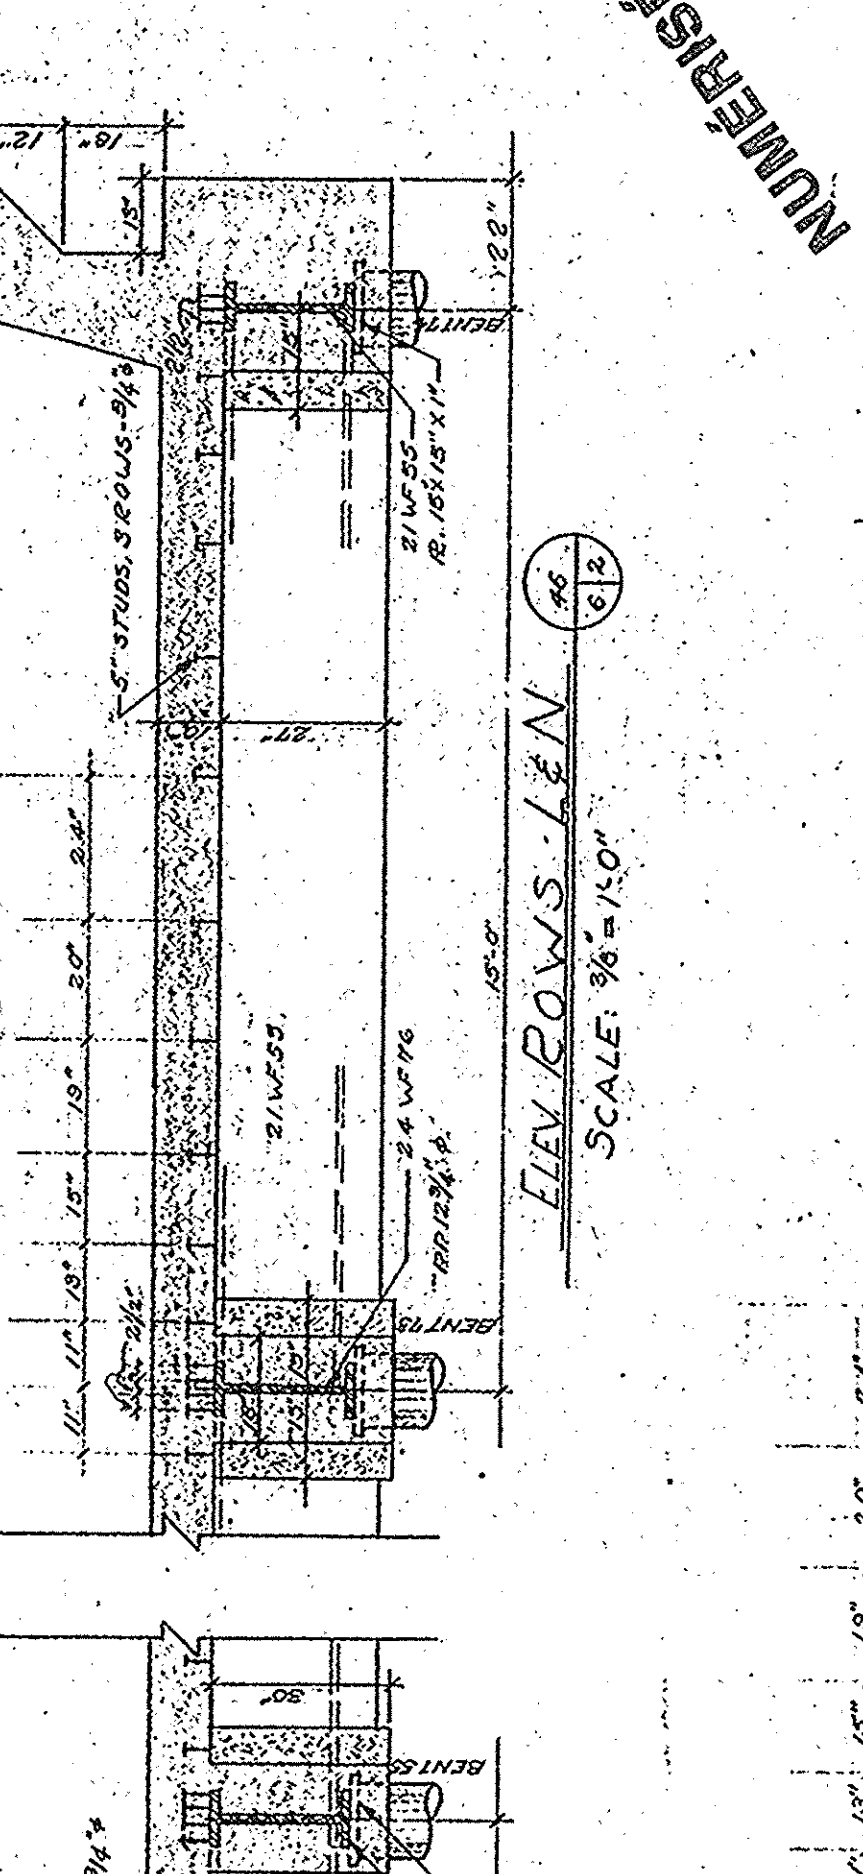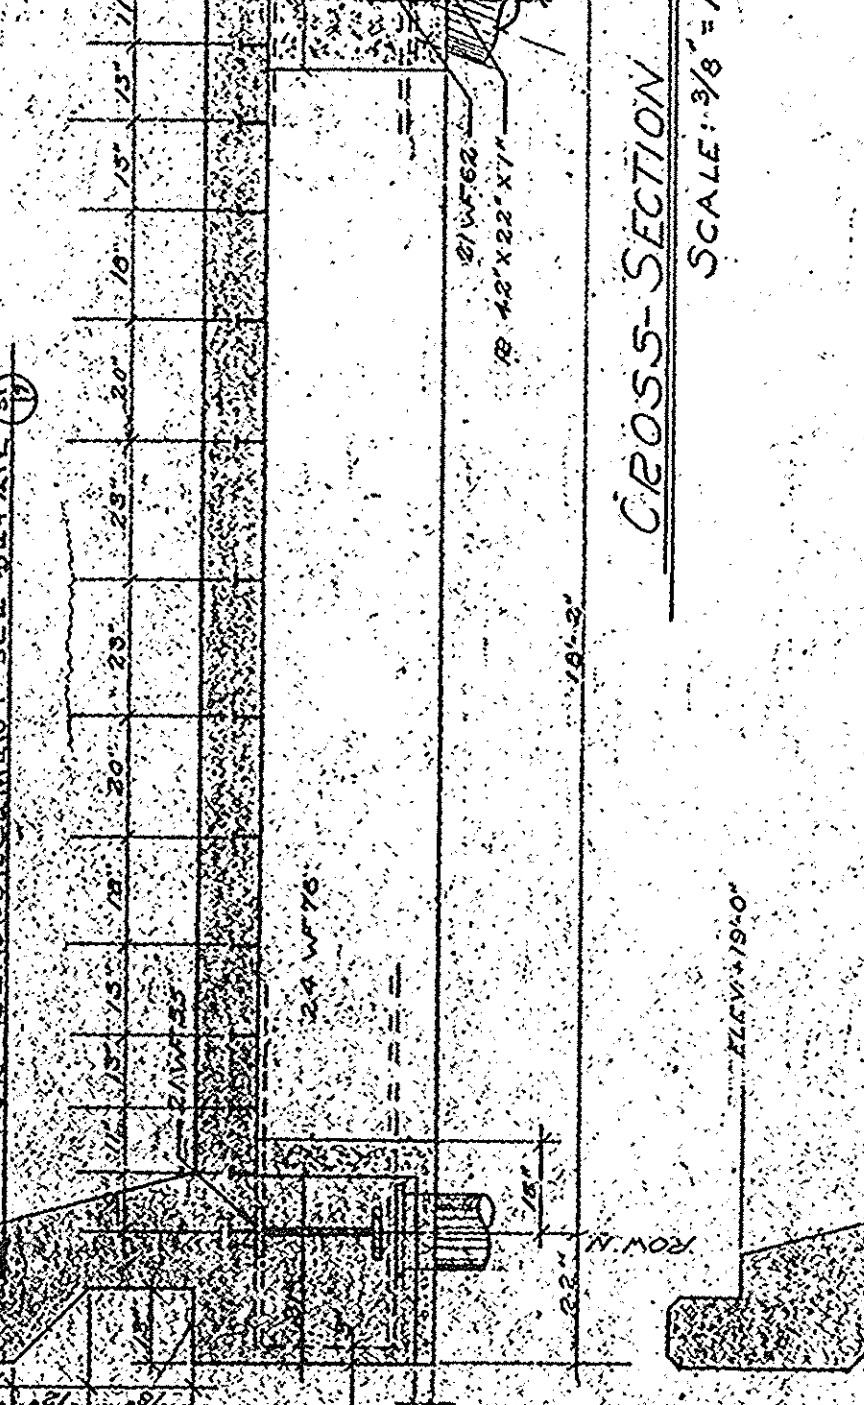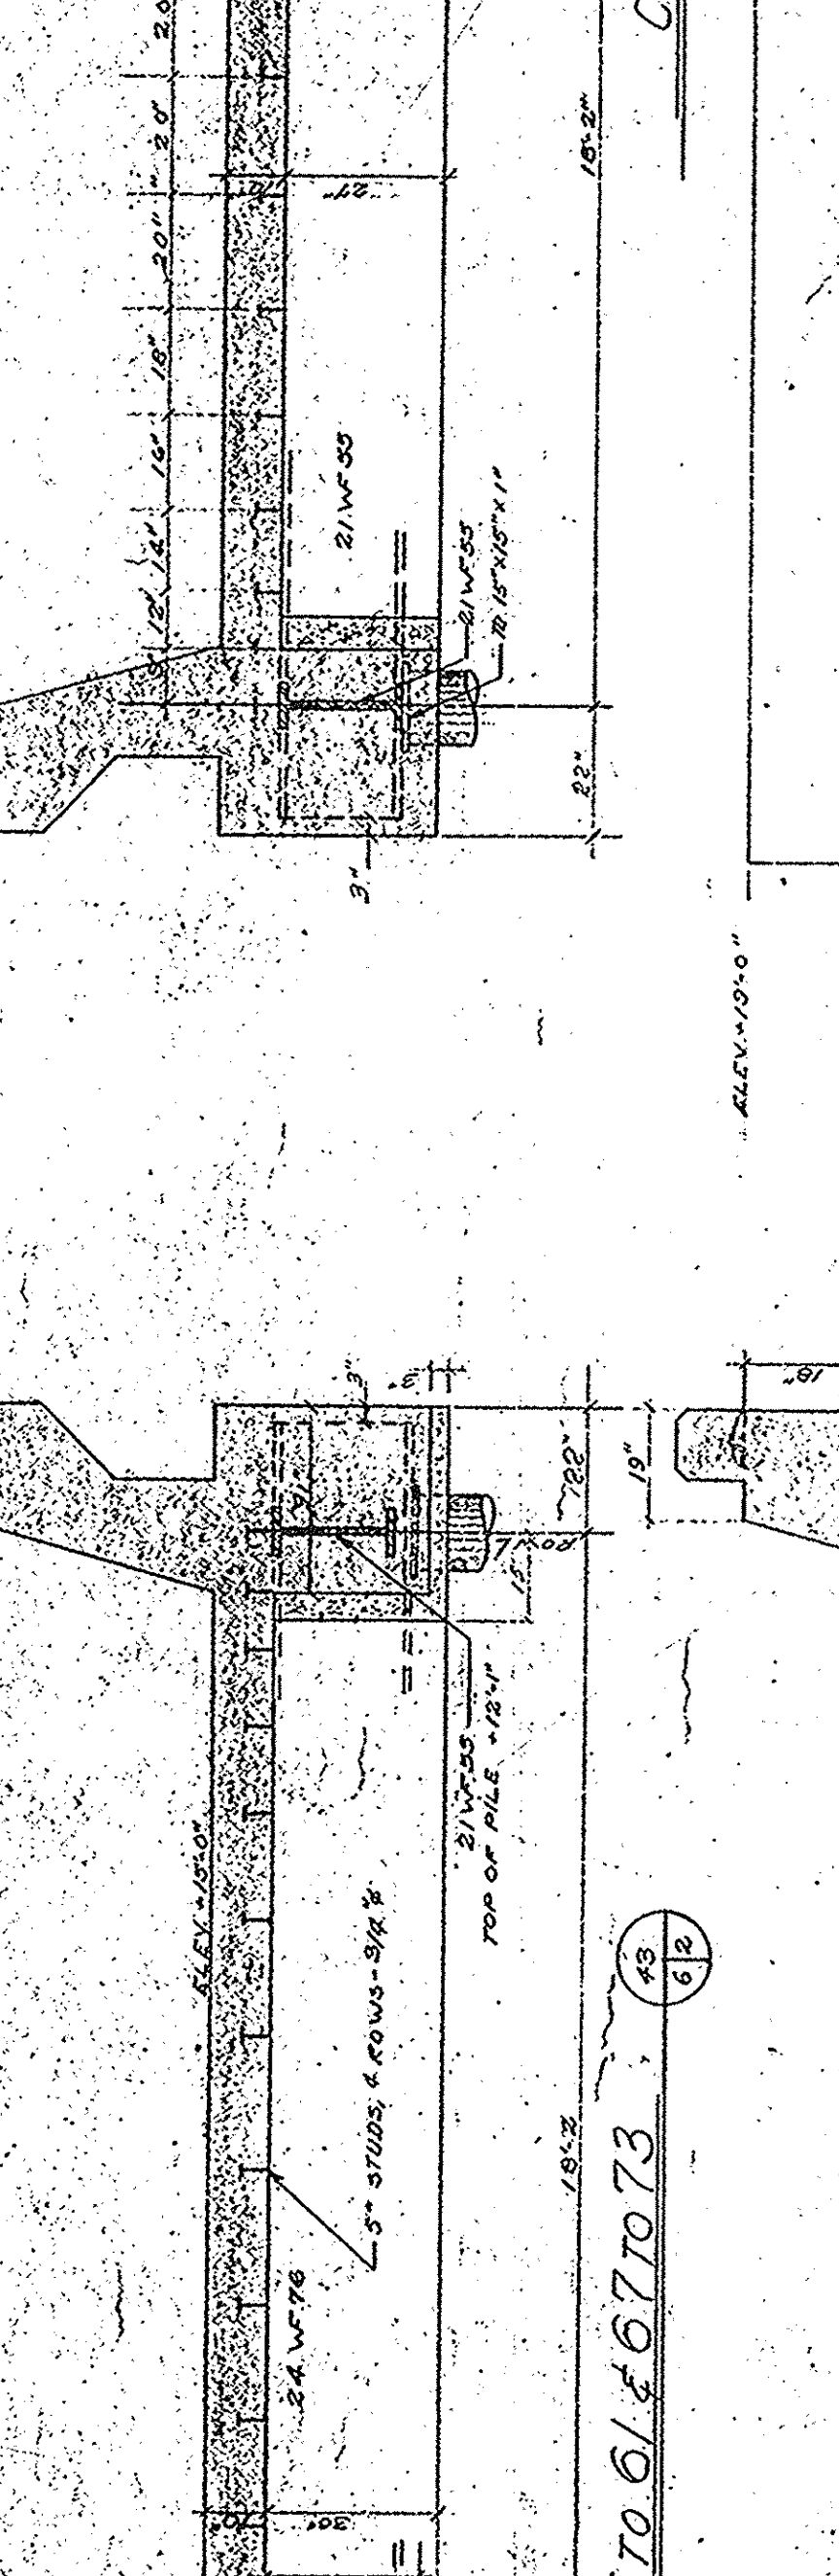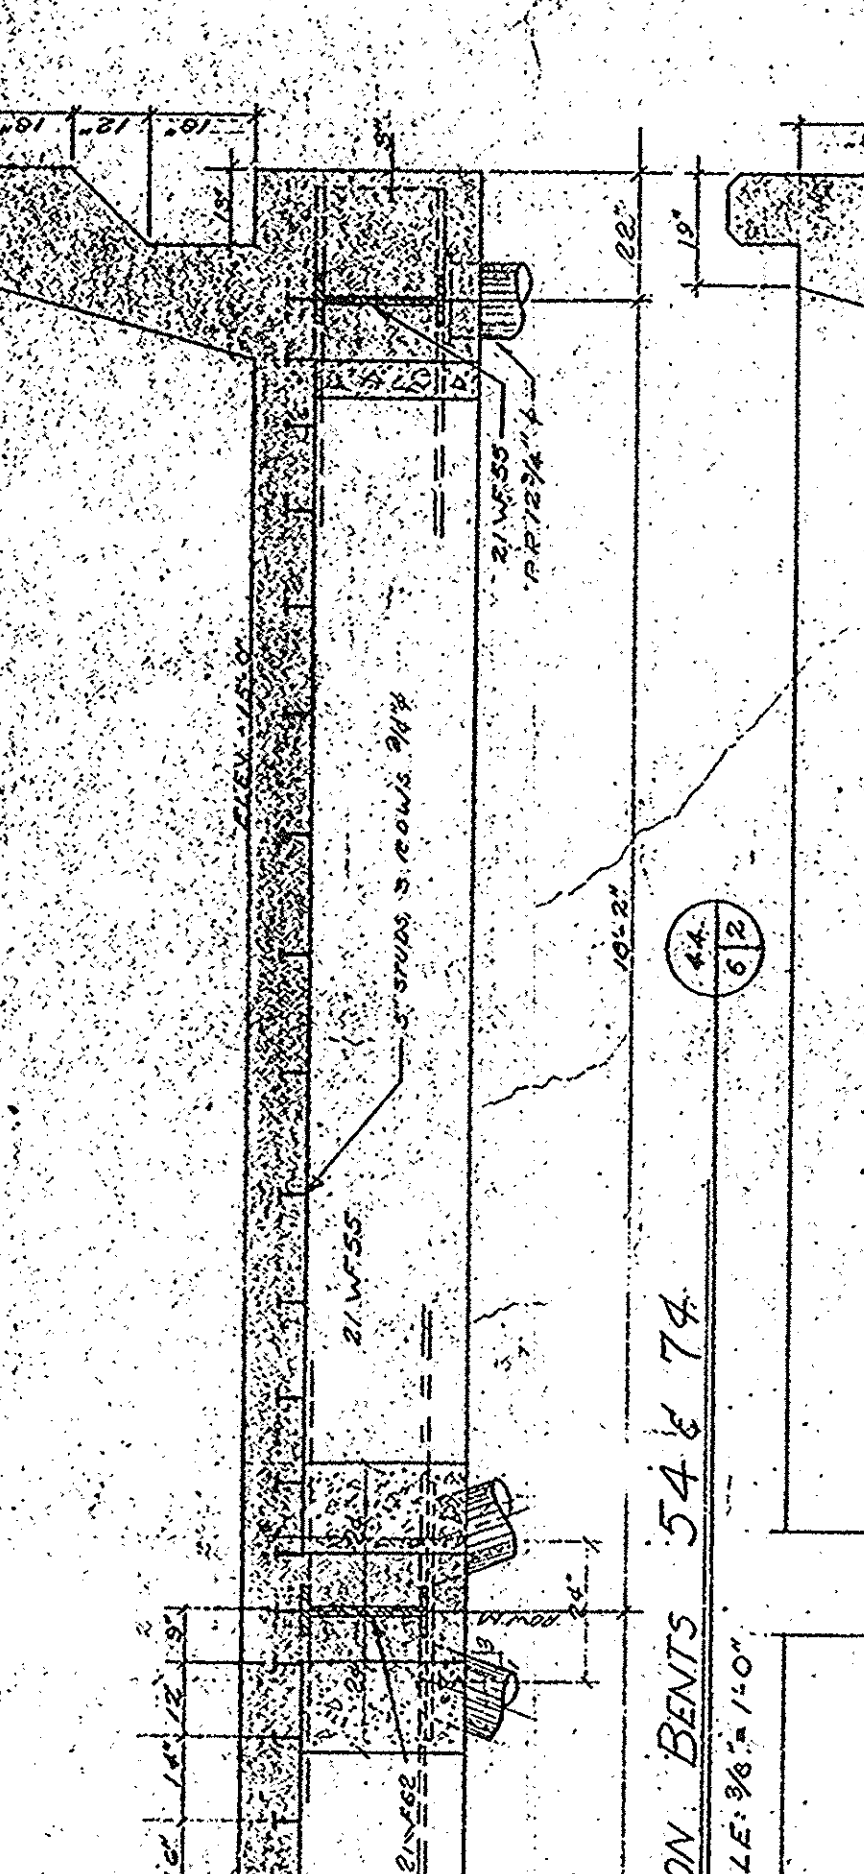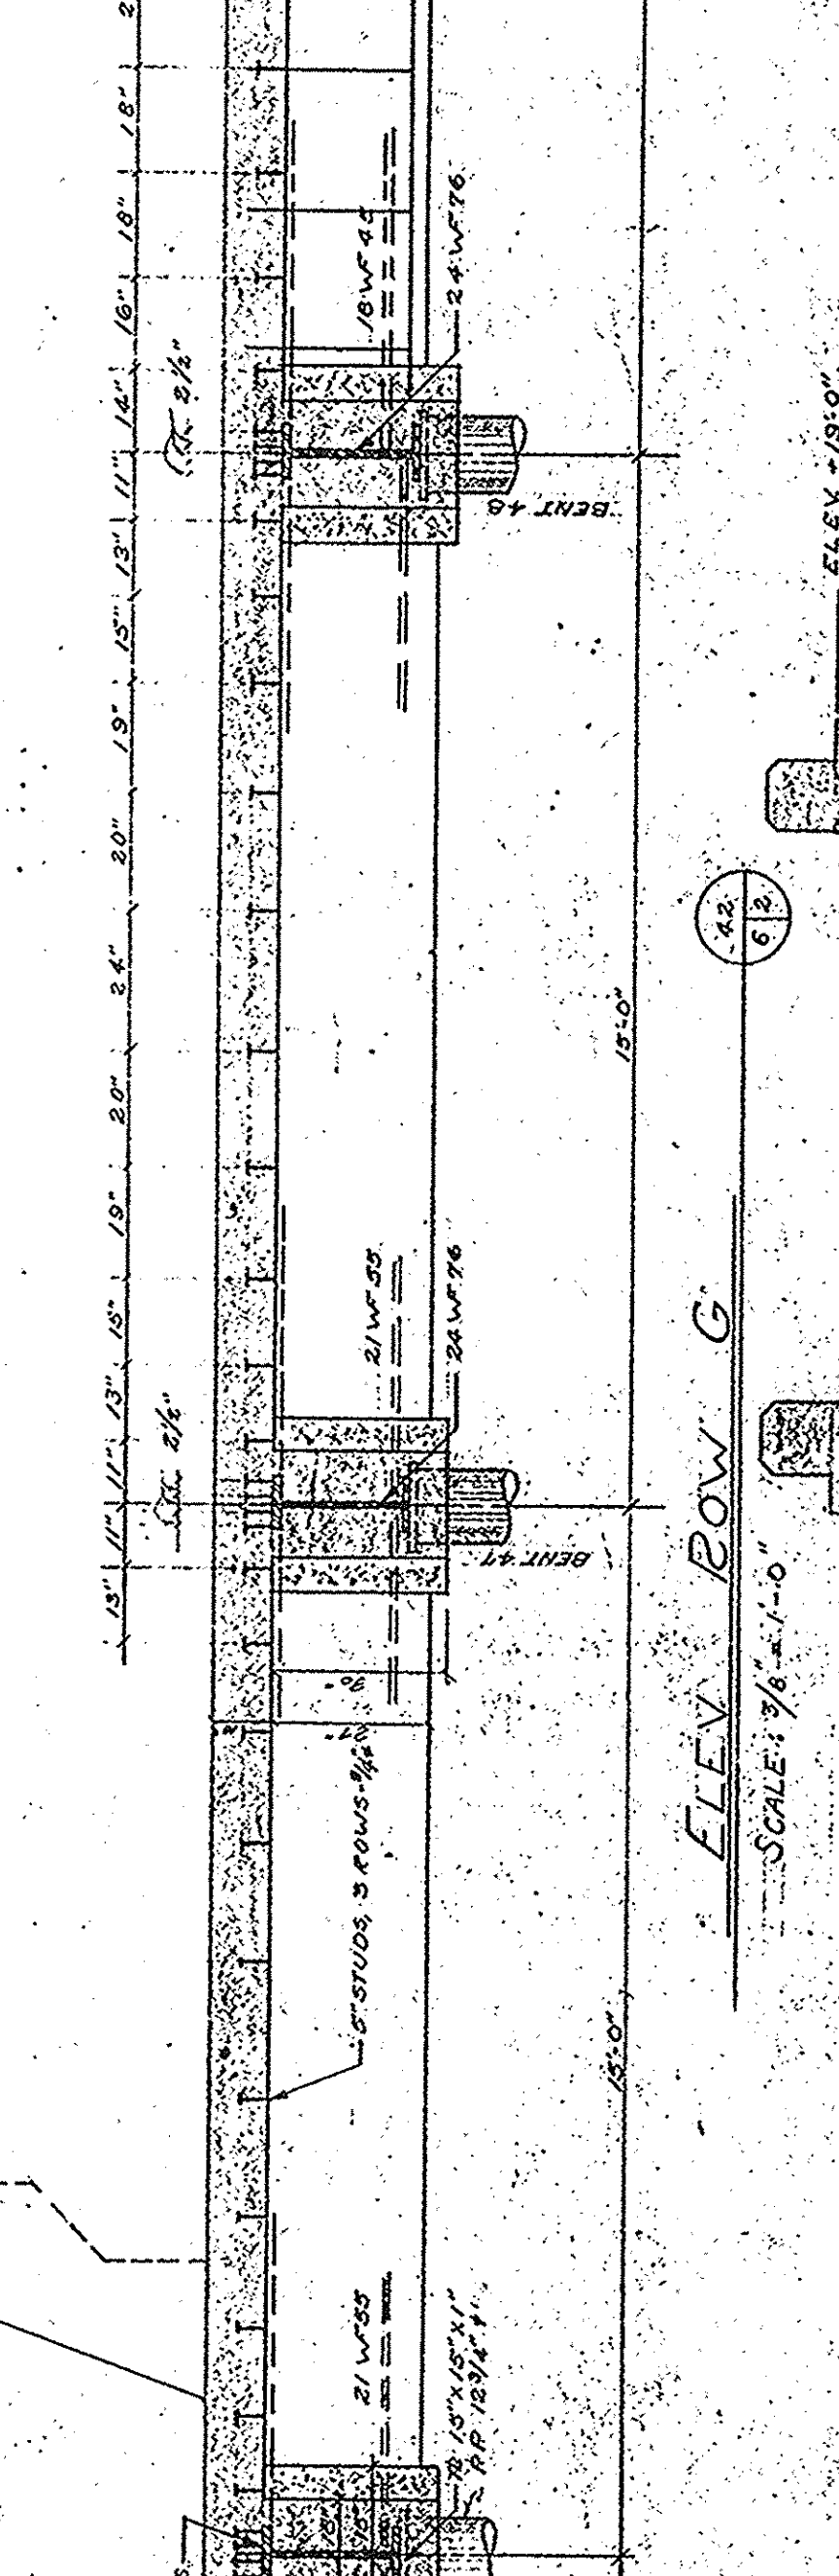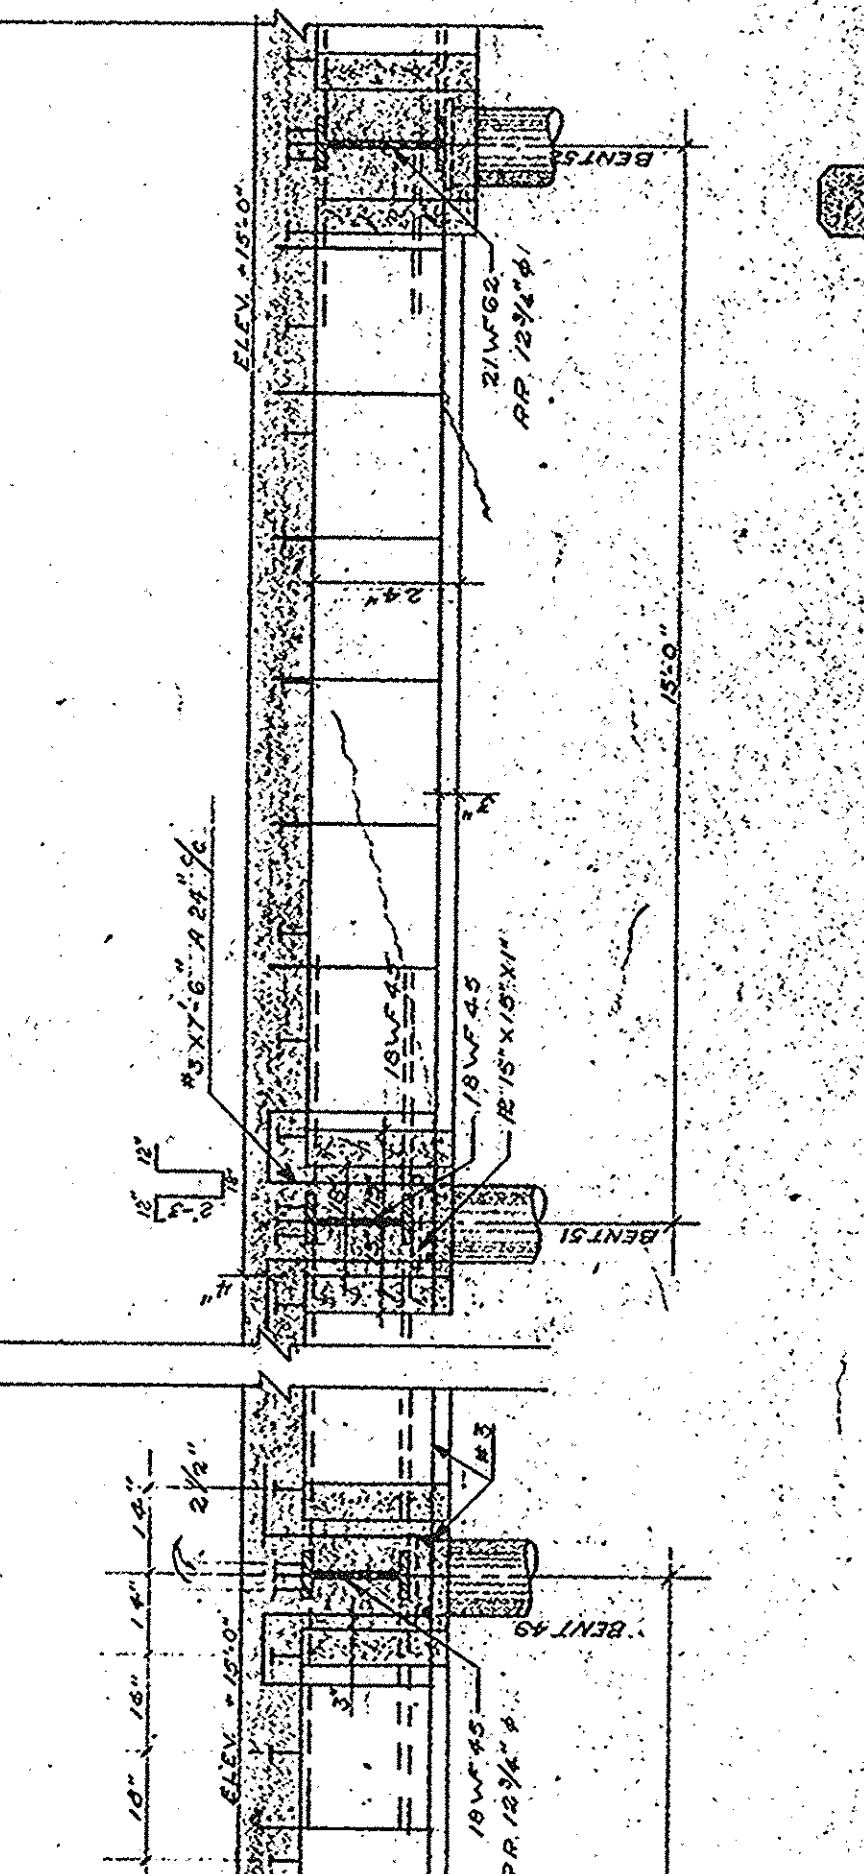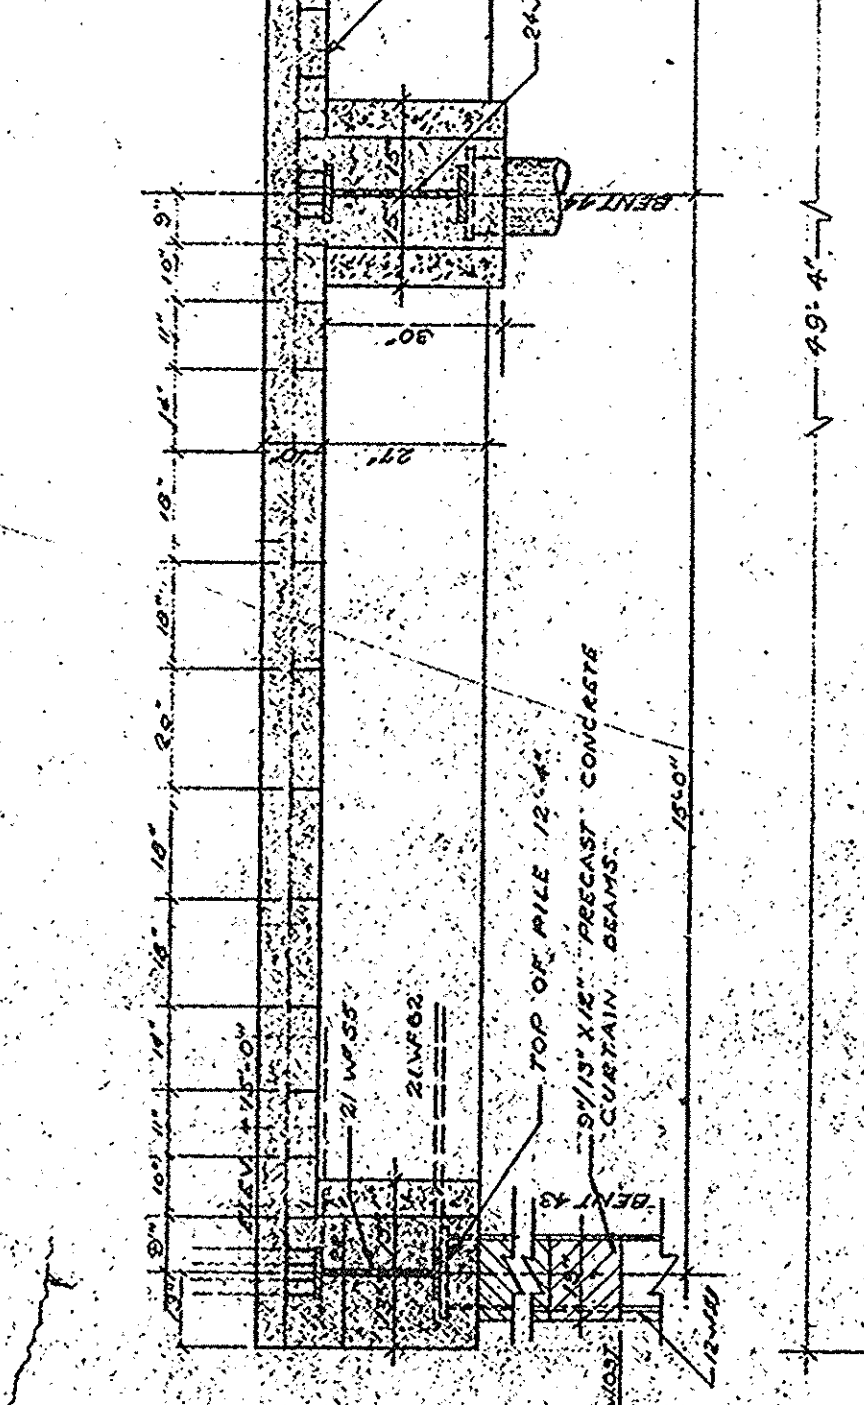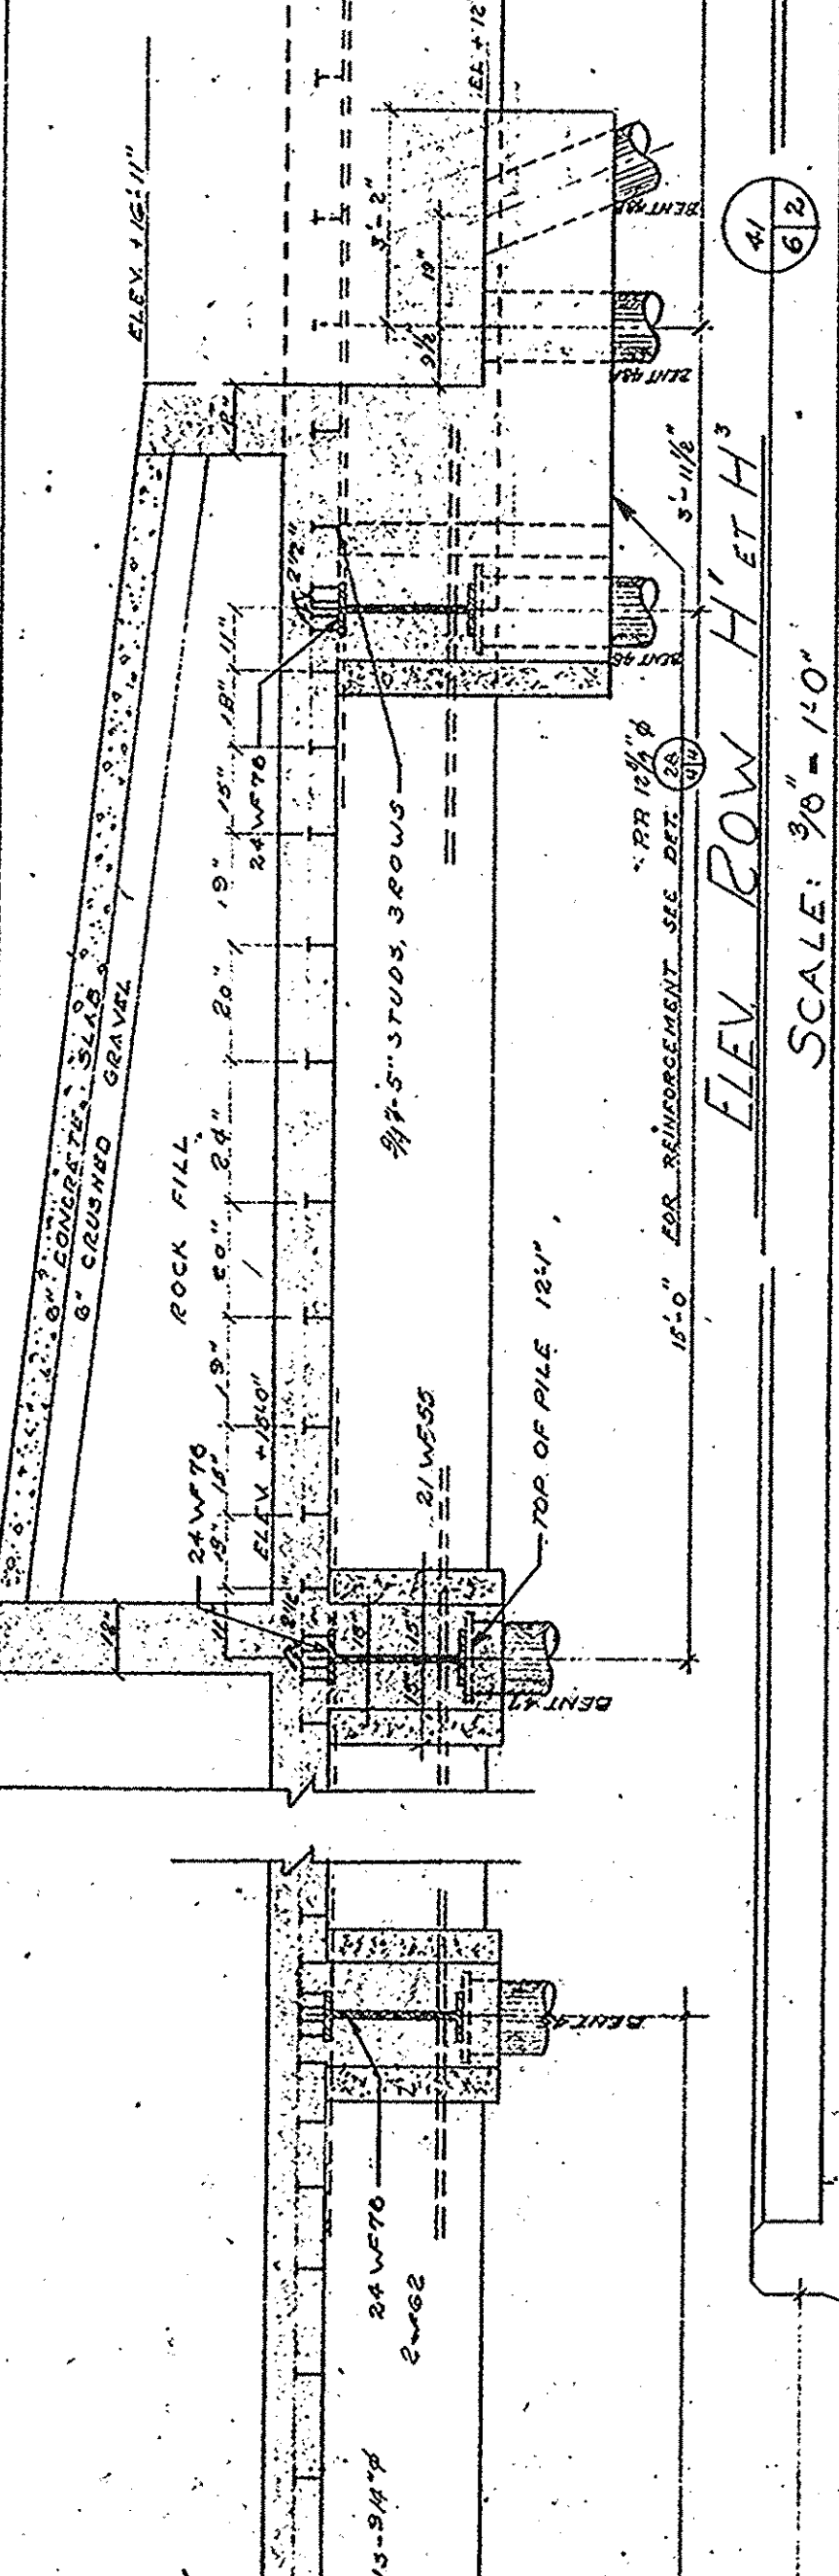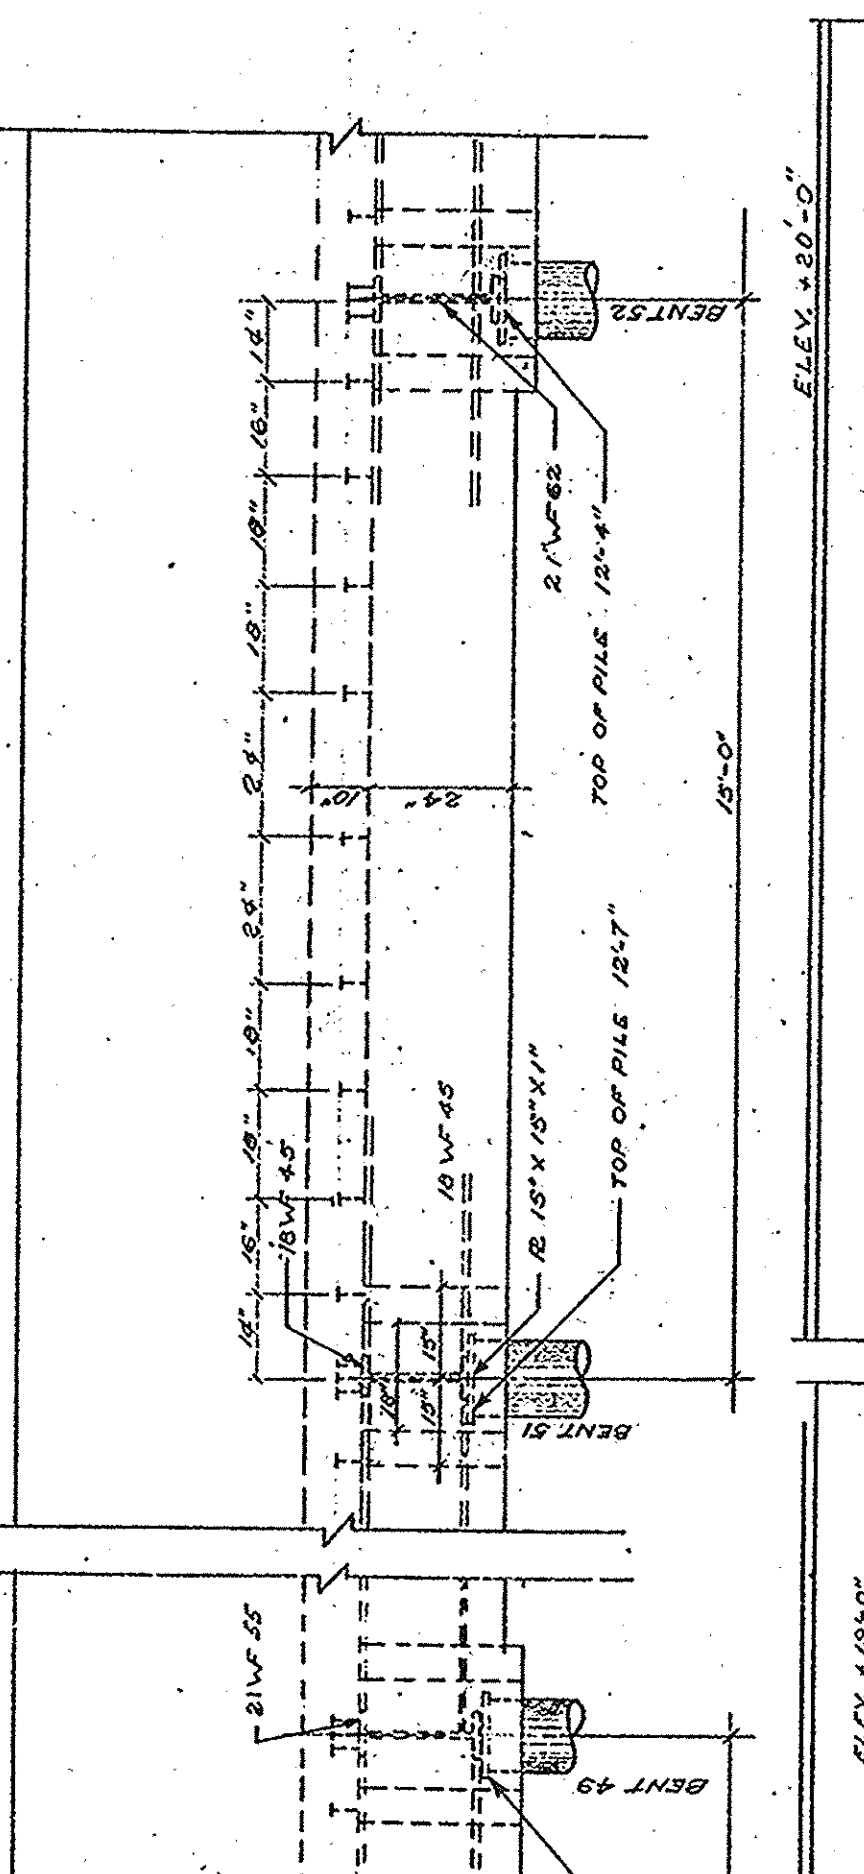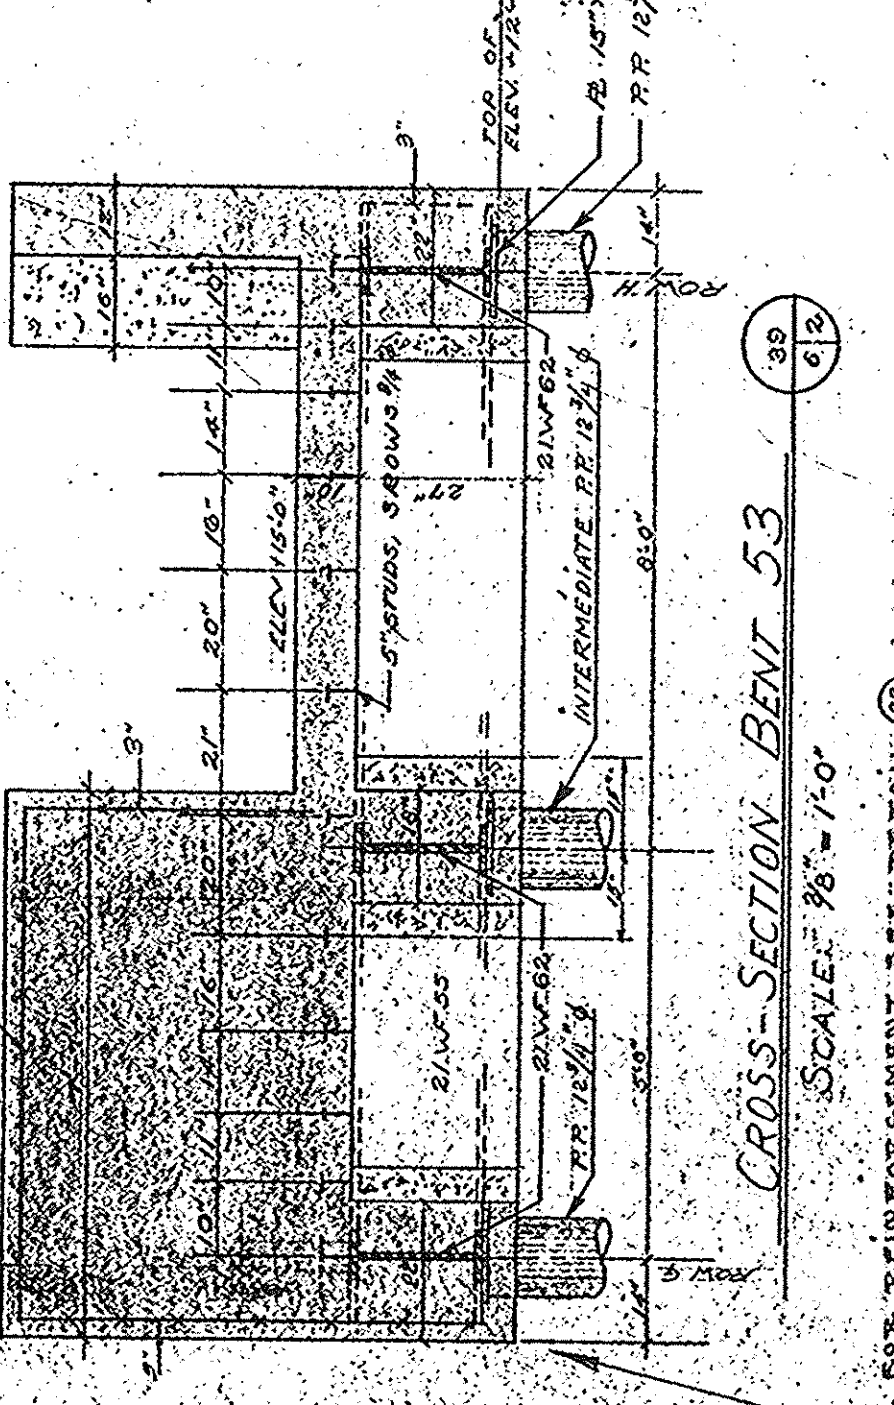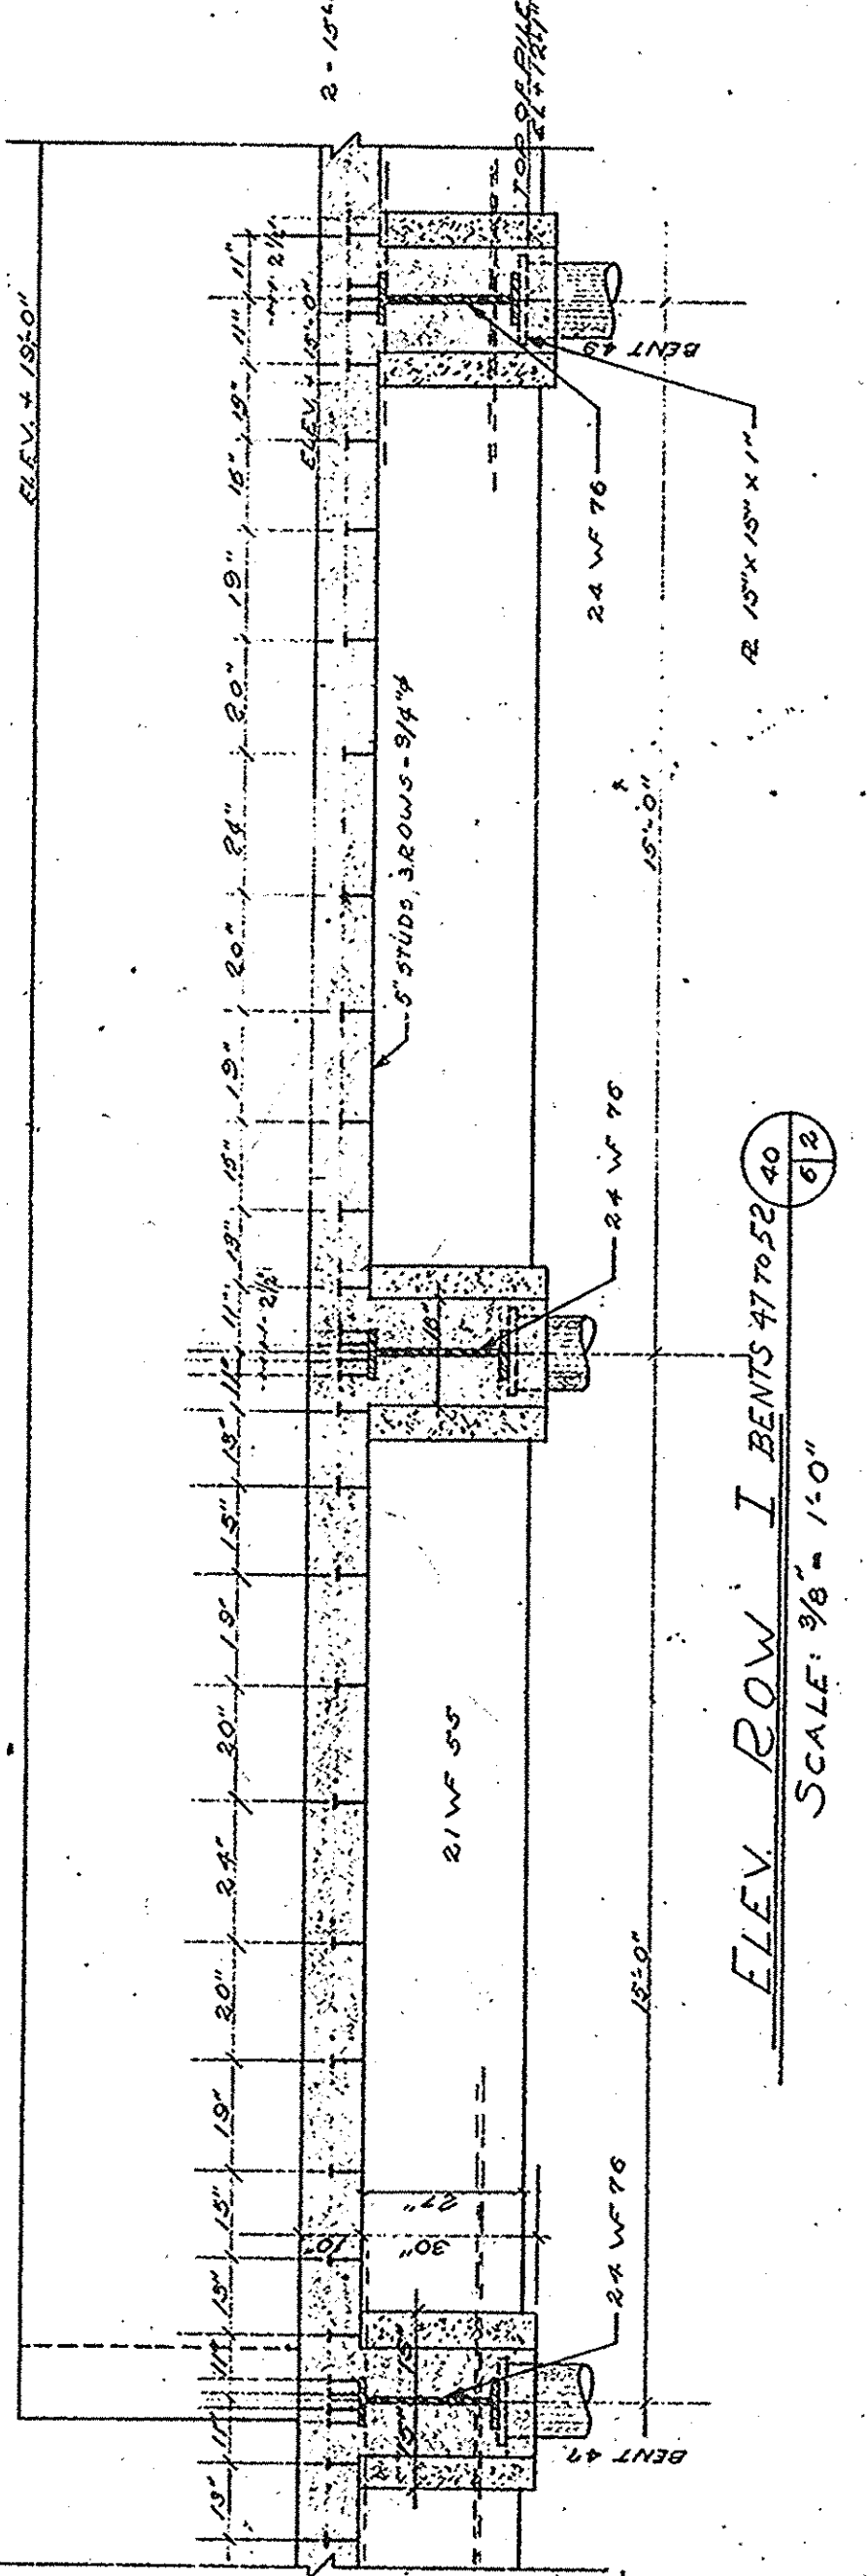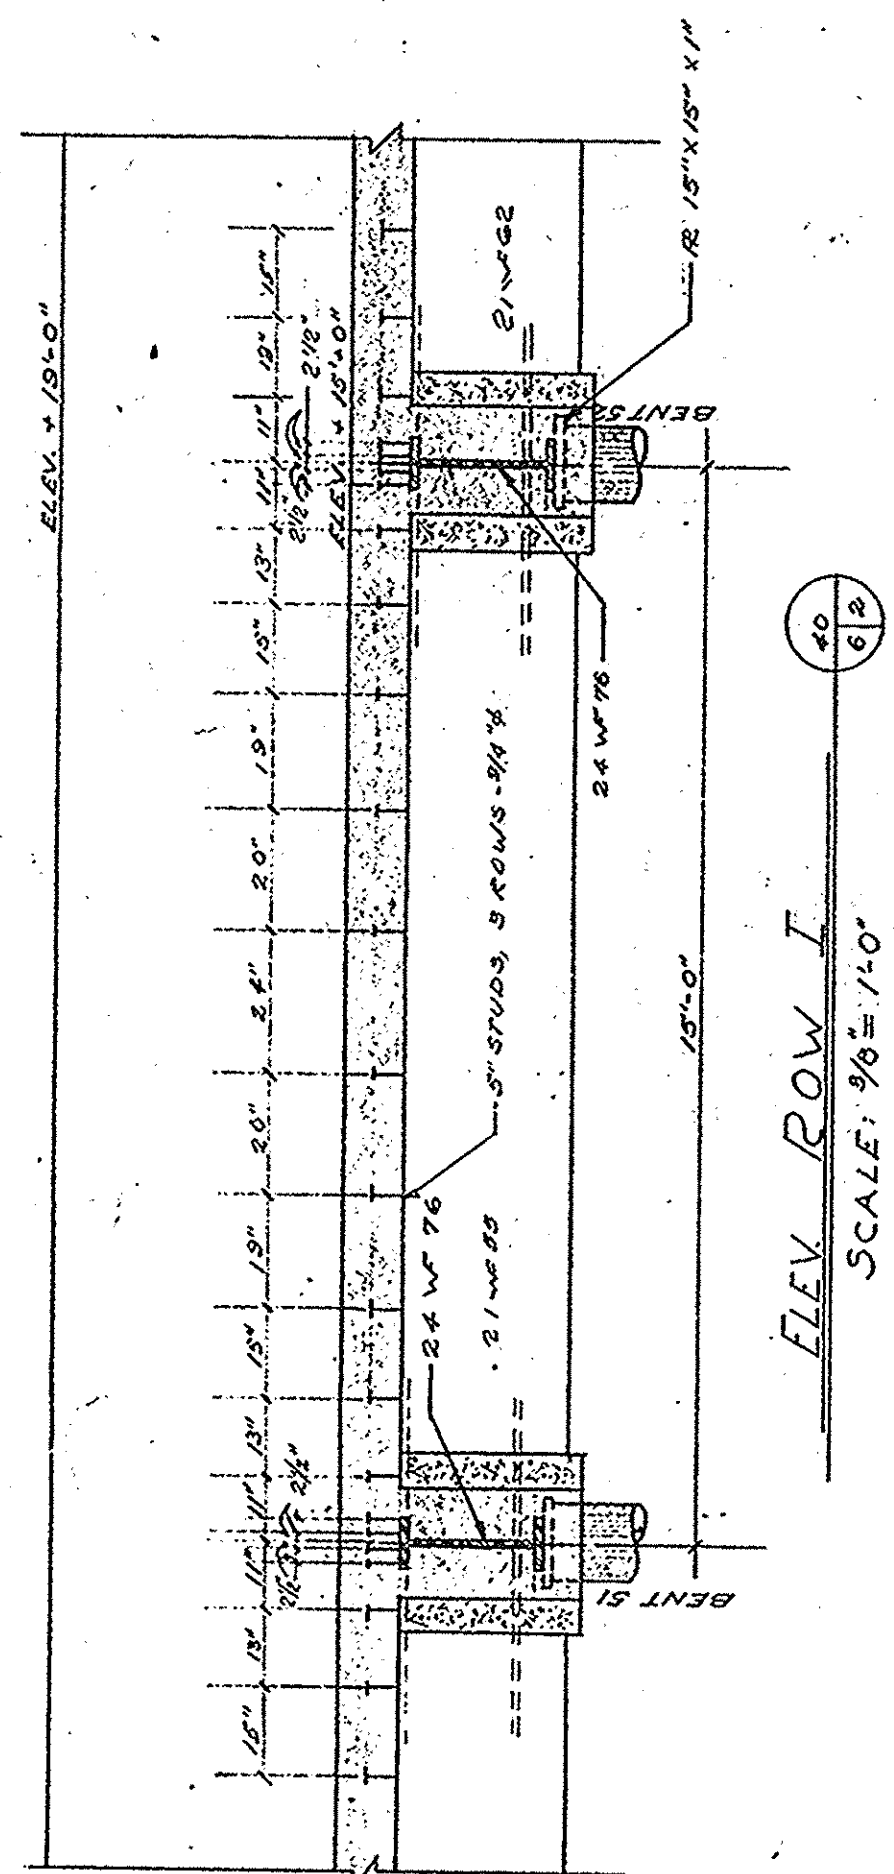

17-00