
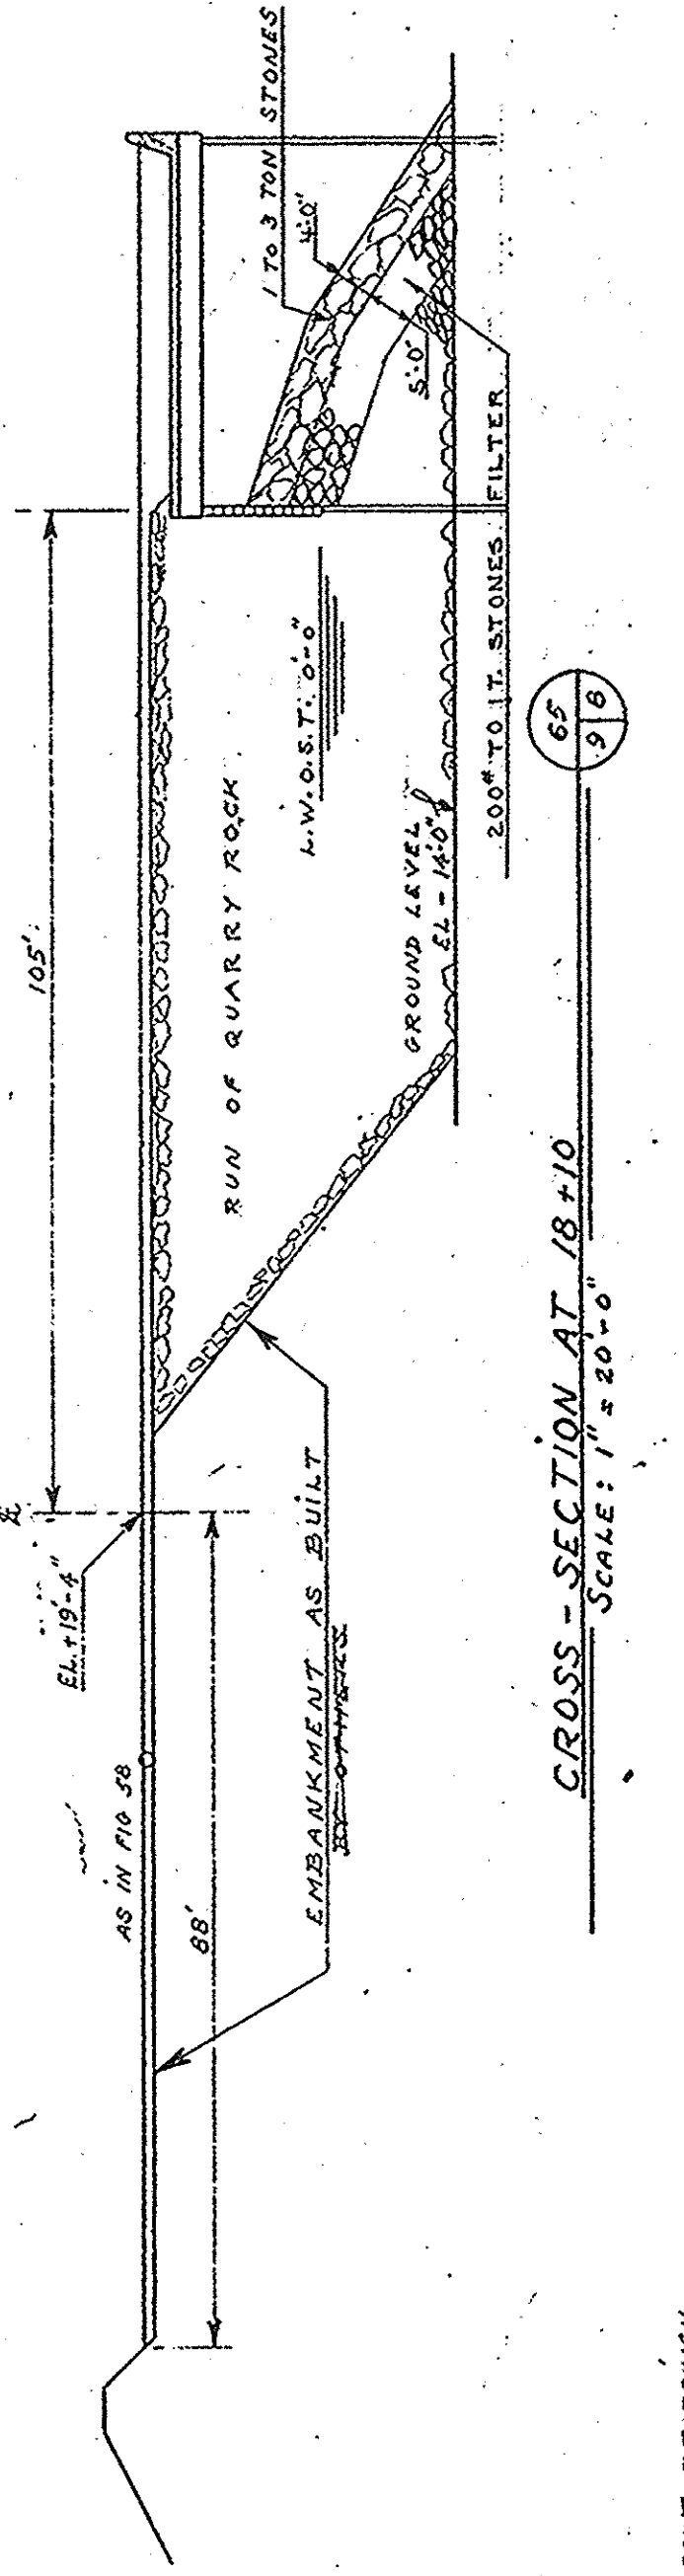


MENARD, MAR SAN & THIBEAULT
CONSULTING ENGINEERS
80 OUEST, ST. GERMAIN, RIMOUSKI, QU.




A. detail no.
B. location
C. dwg. no.
D. detail no.


date	revisions	GENERAL
5 SEPT, 1968		




CROSS-SECTION AT 18+10
SCALE: 1" = 20'-0"

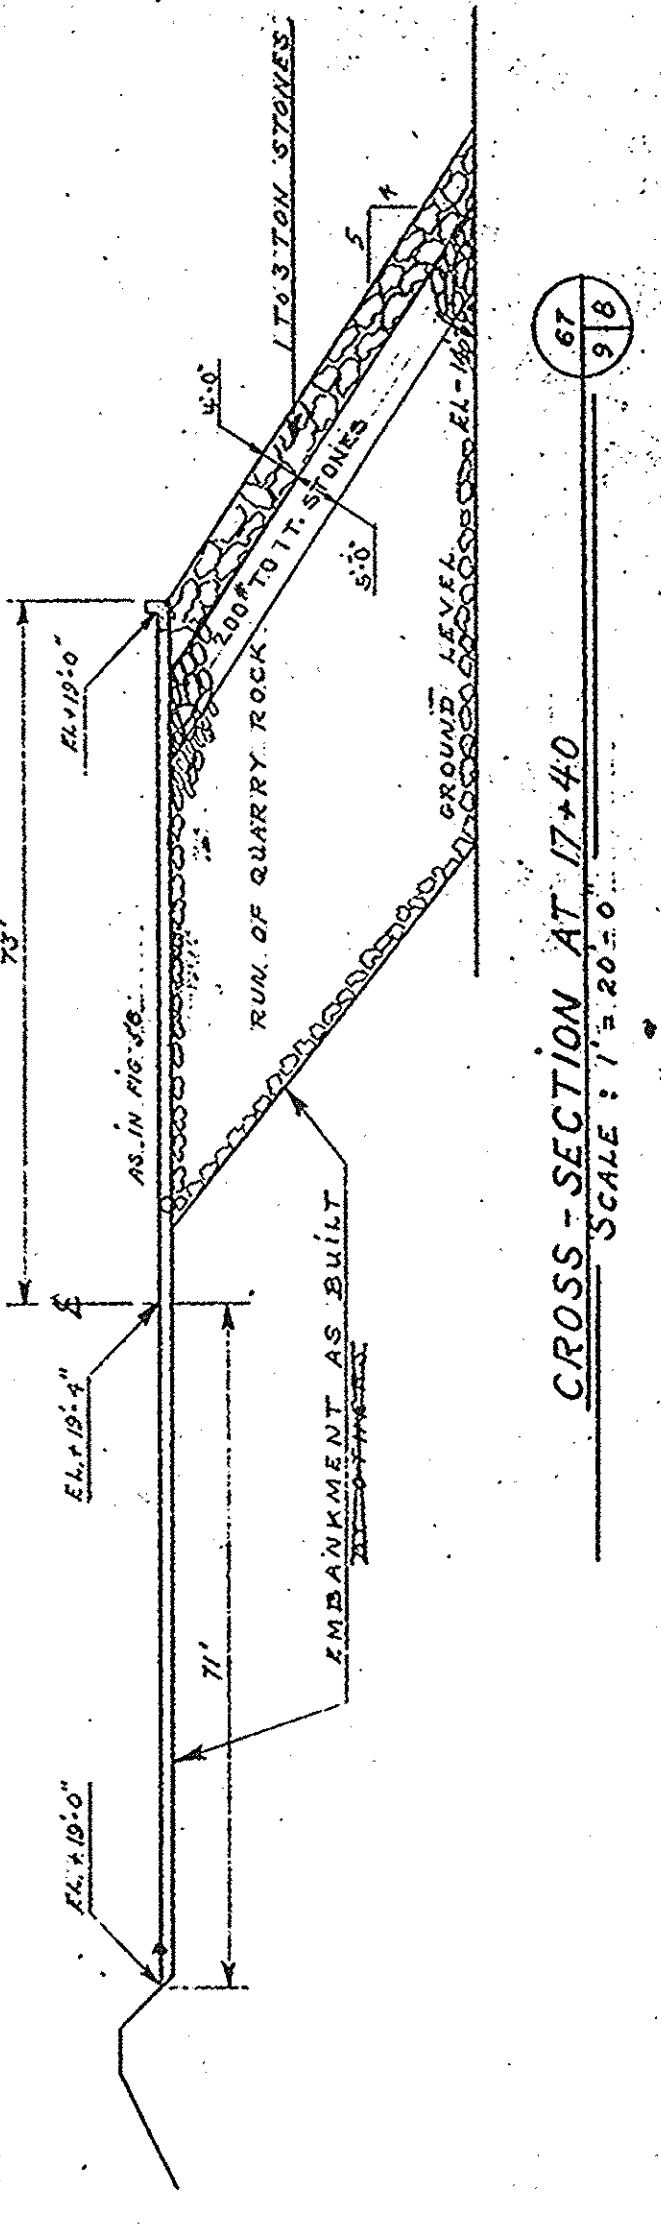


CROSS-SECTION AT 17+40
SCALE: 1"=20'-0"

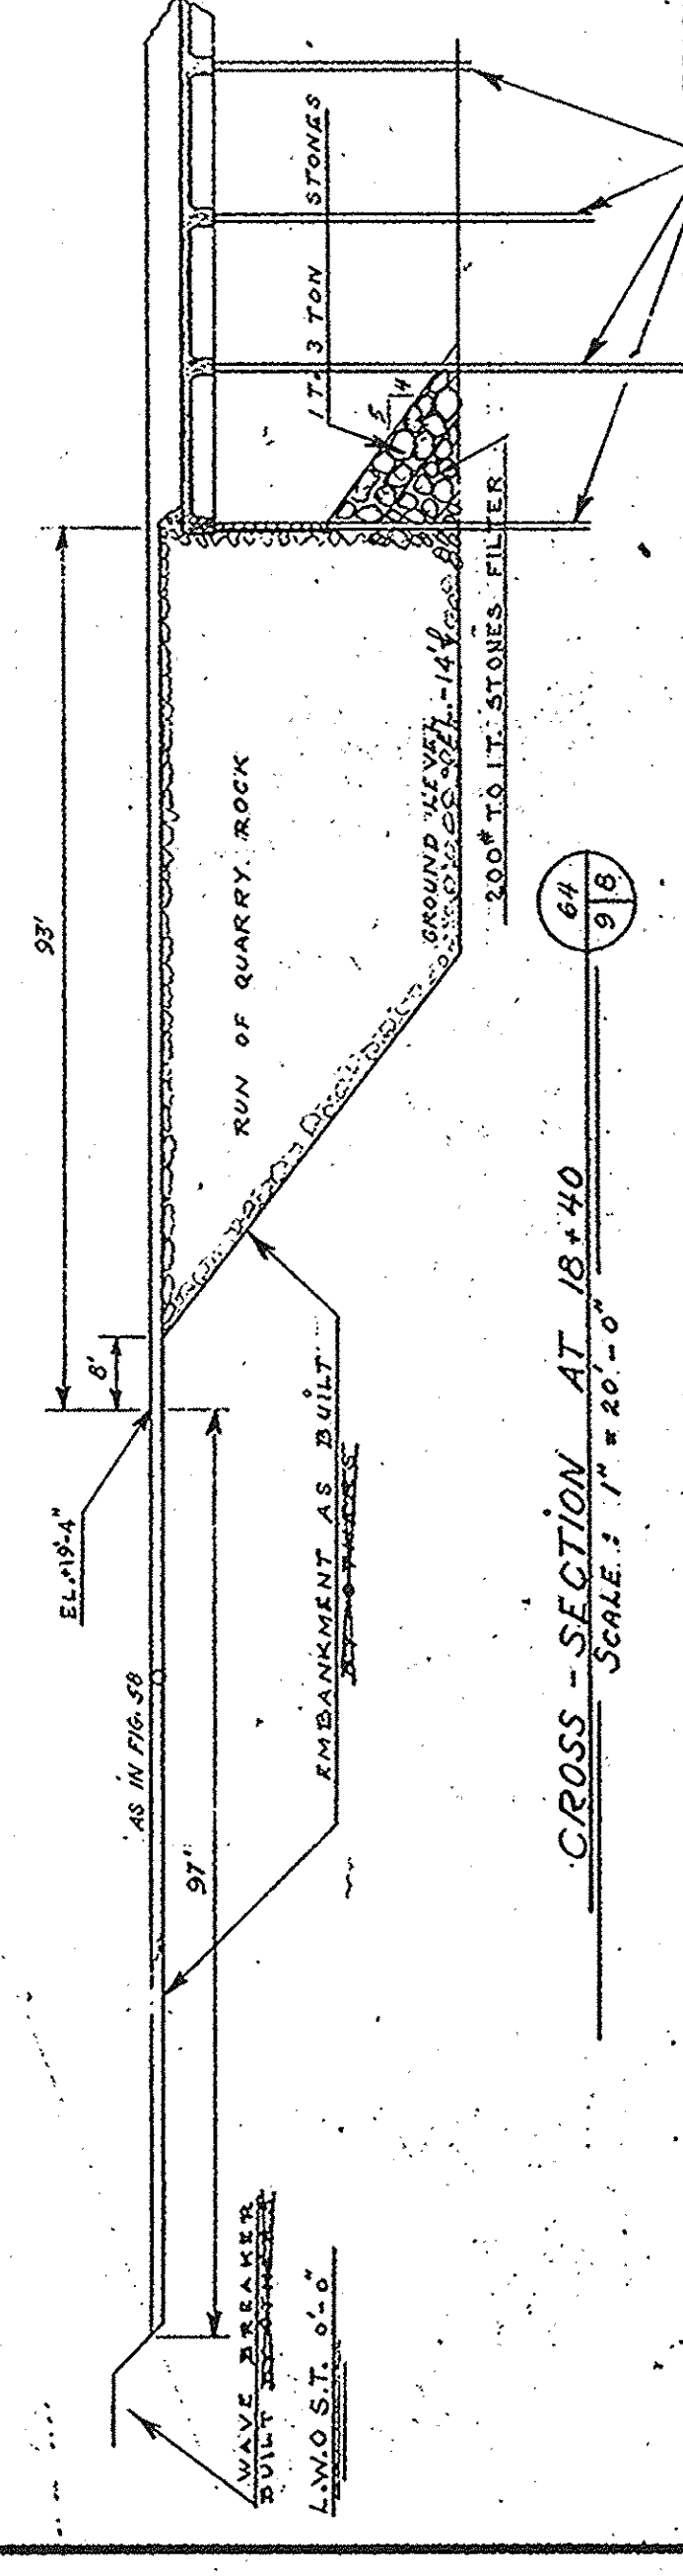

CROSS-SECTION AT 18+40
SCALE: 1" = 20'-0"

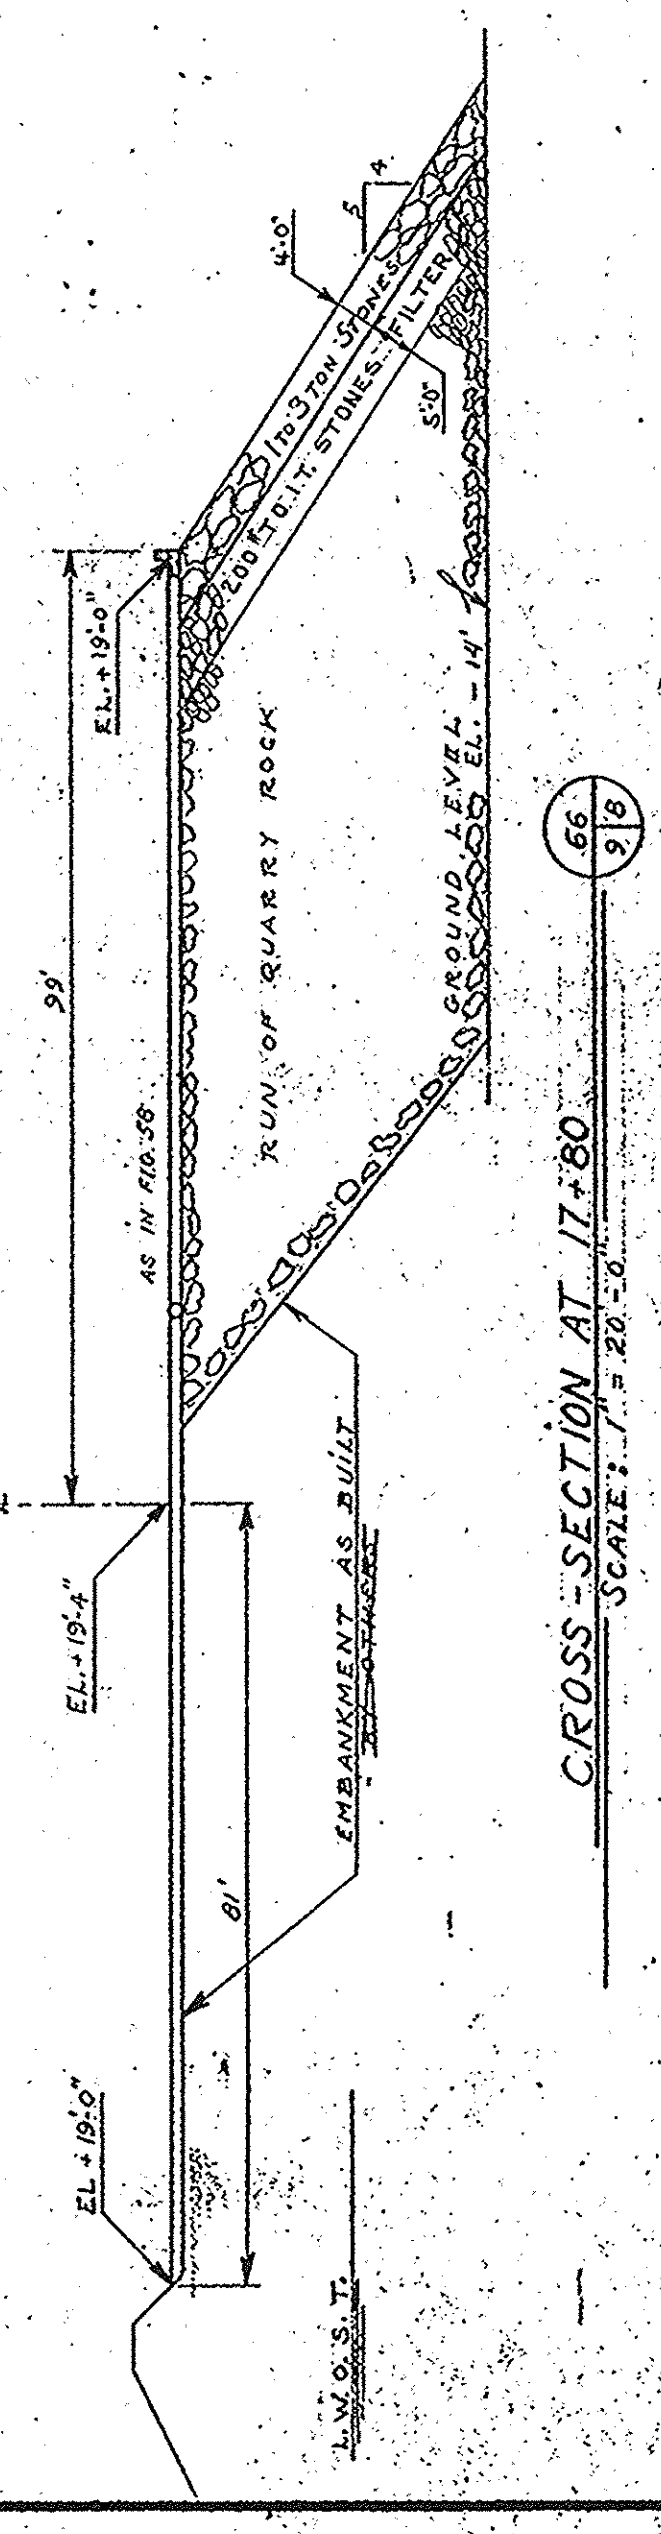

CROSS-SECTION AT 17+80
SCALE: 1" = 20'-0"

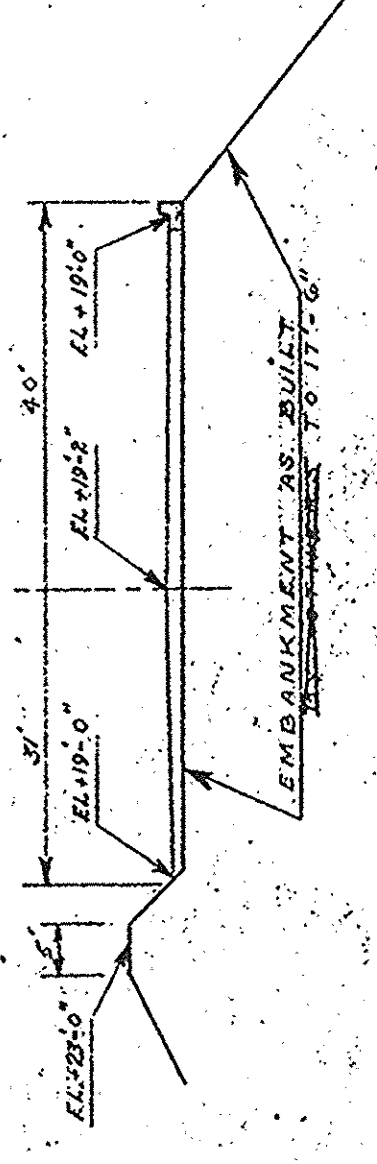


TYPICAL CROSS-SECTION - 2'-4" To 16'-0"


SCALE 1" = 2'-0"

98


70

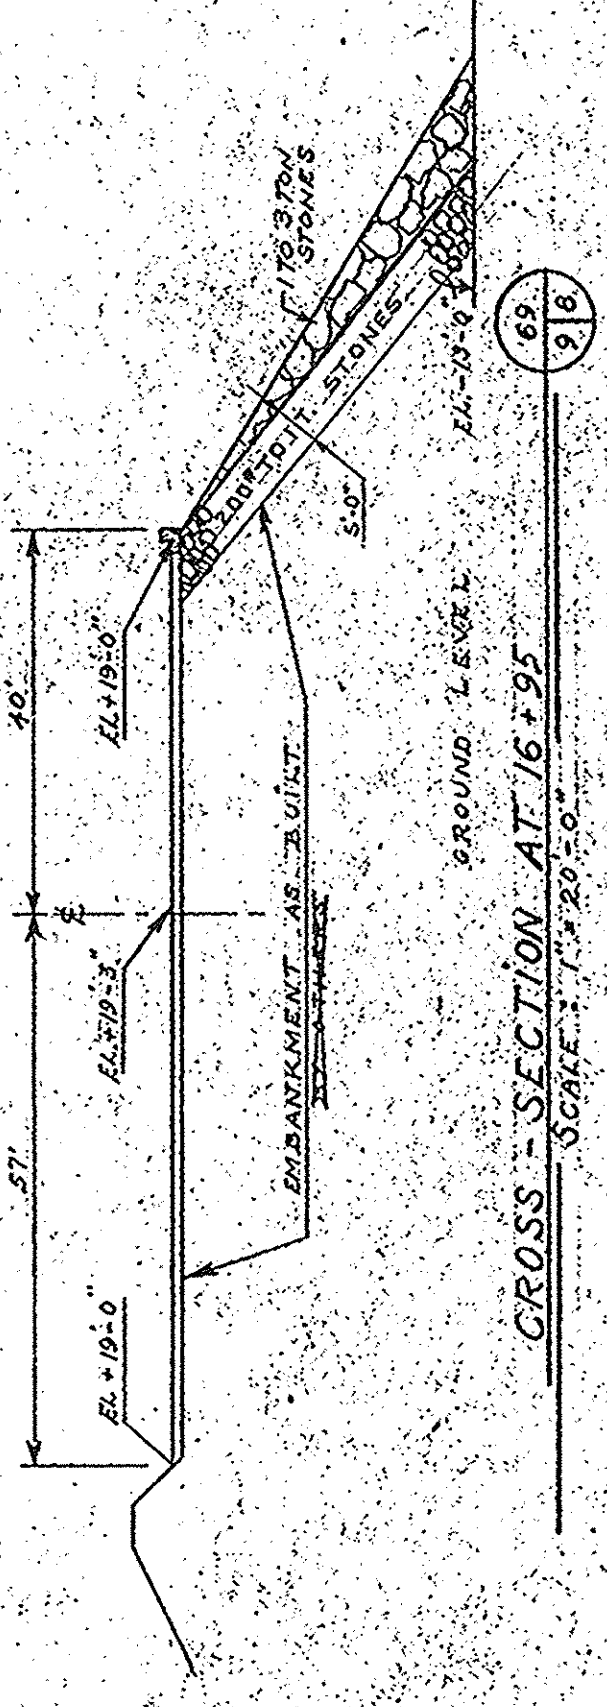


CROSS - SECTION AT 16' SCALE: 1" = 20'-0"

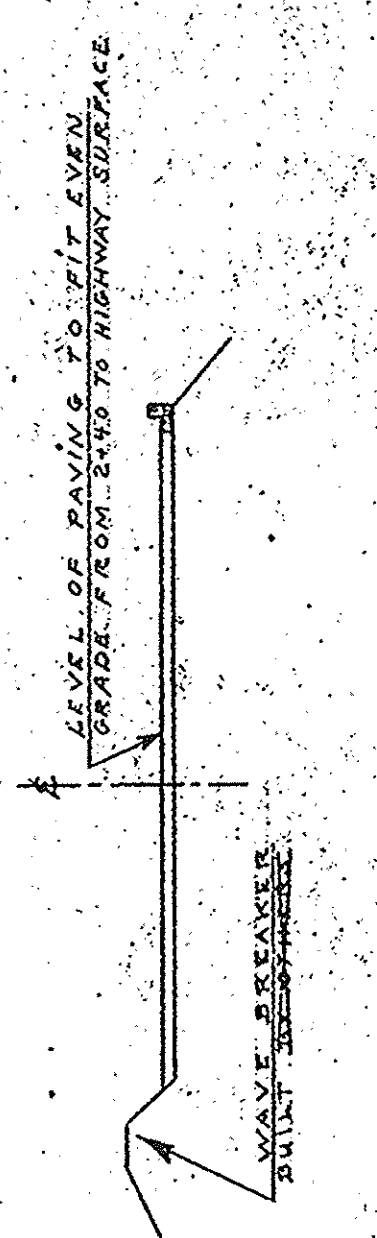


TYPICAL CROSS-SECTION 0+00 TO 2+40

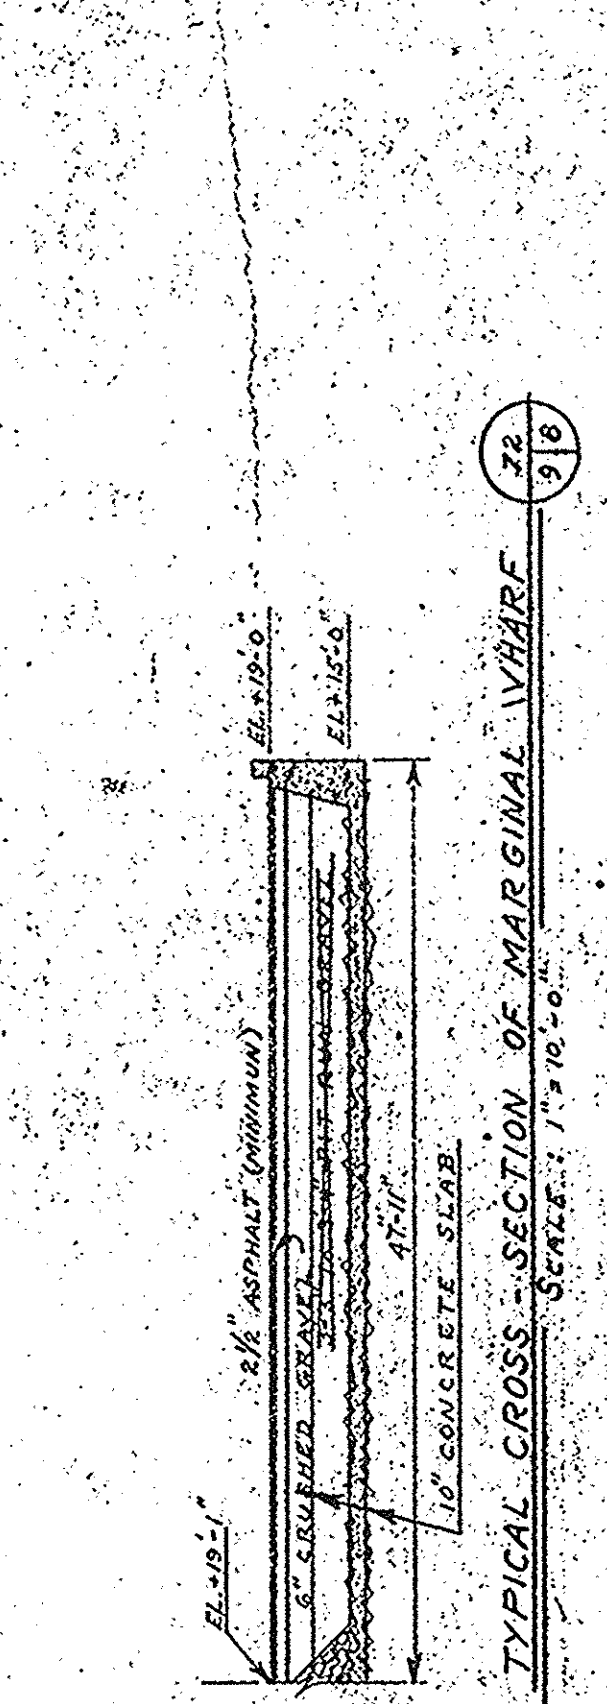


TYPICAL CROSS - SECTION OF MARGINAL WHARF

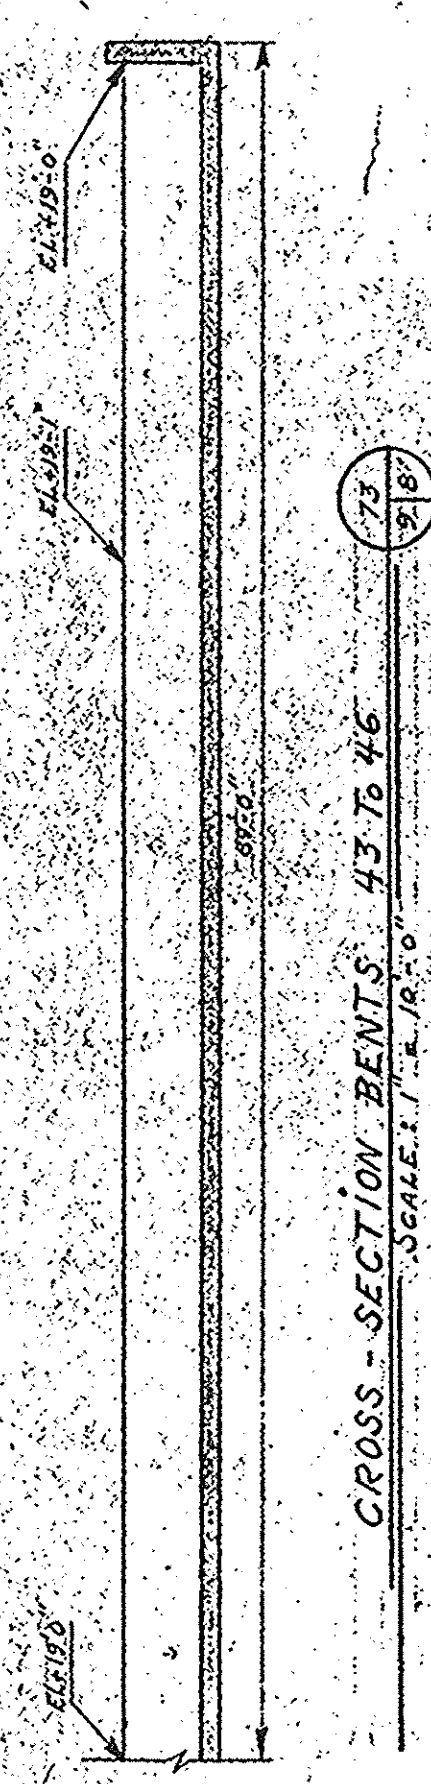

CROSS-SECTION BENTS 43 TO 46
SCALE: 1" = 10'-0"
73 28

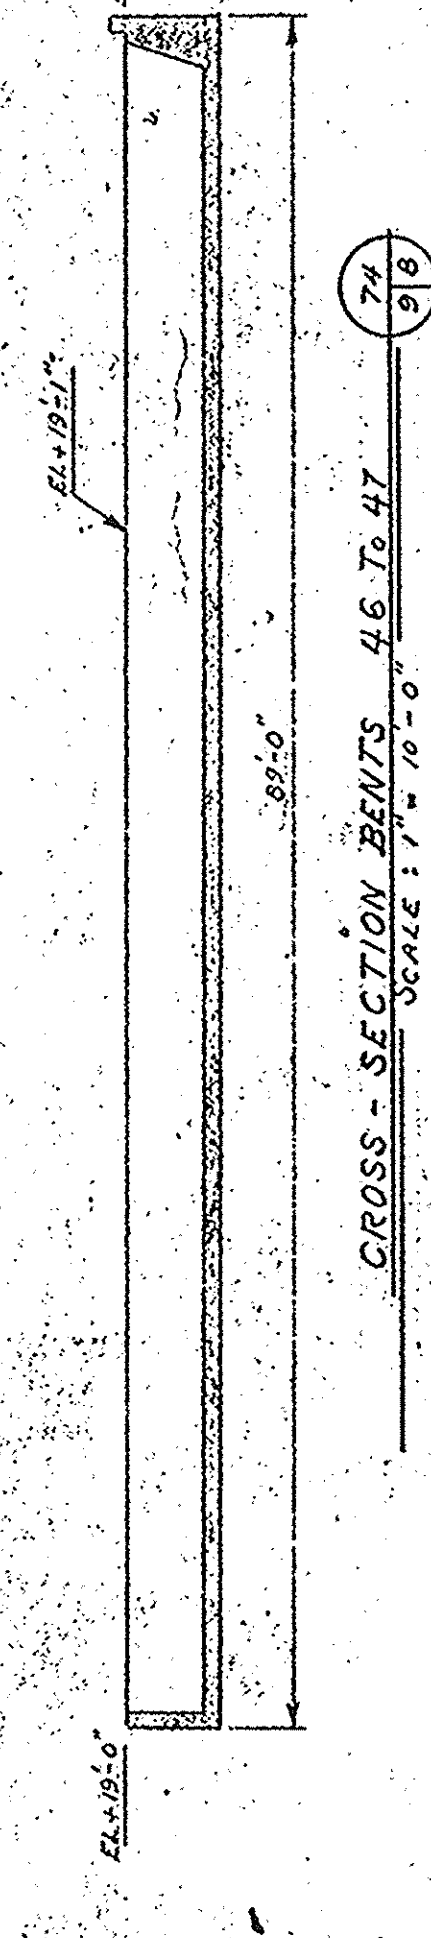


CROSS - SECTION BENTS 46 To 47
SCALE: 1" = 10'-0"

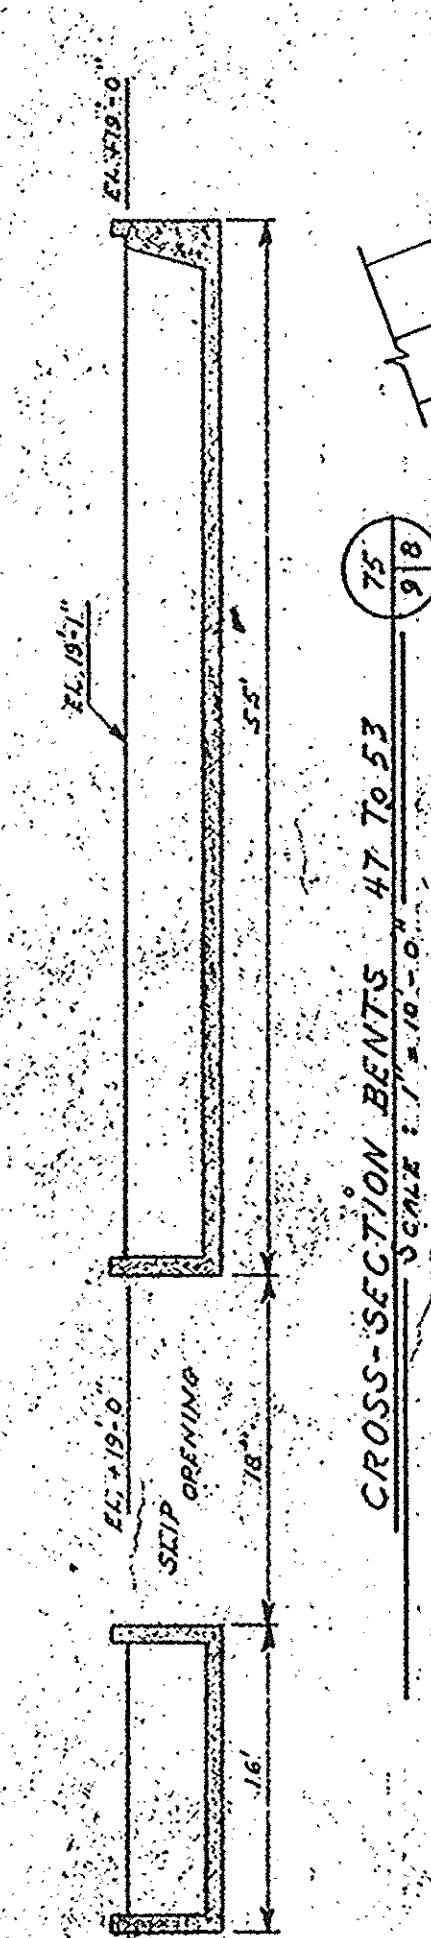


CROSS-SECTION BENTS 47 To 53
SCALE: 1" = 10'-0"
75 98




GROSS-SECTION BENTS 54 TO 74
SCALE: 1" = 10'-0"
76
78

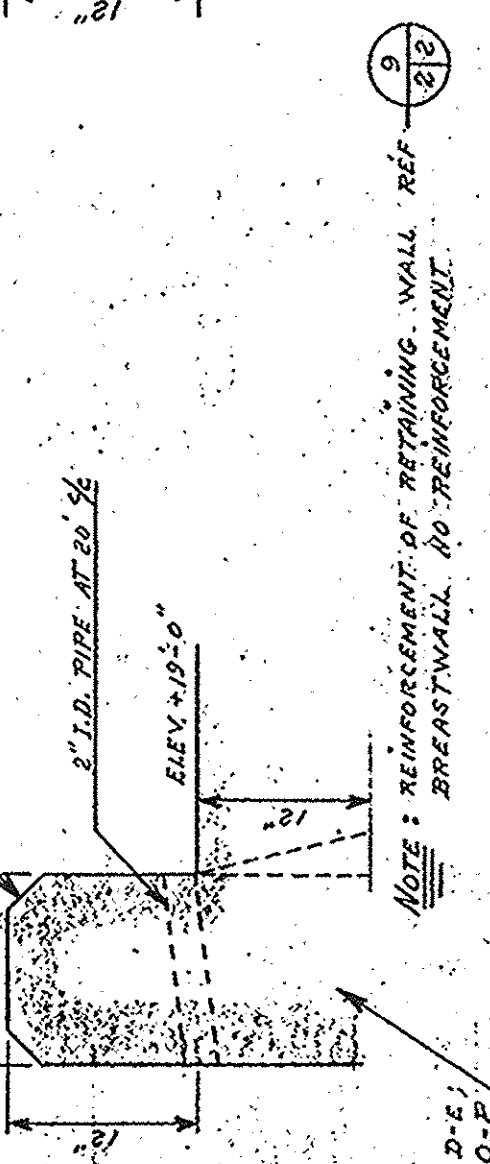


CONCRETE WHEELGUARD
SCALE: 1" = 1'-0"

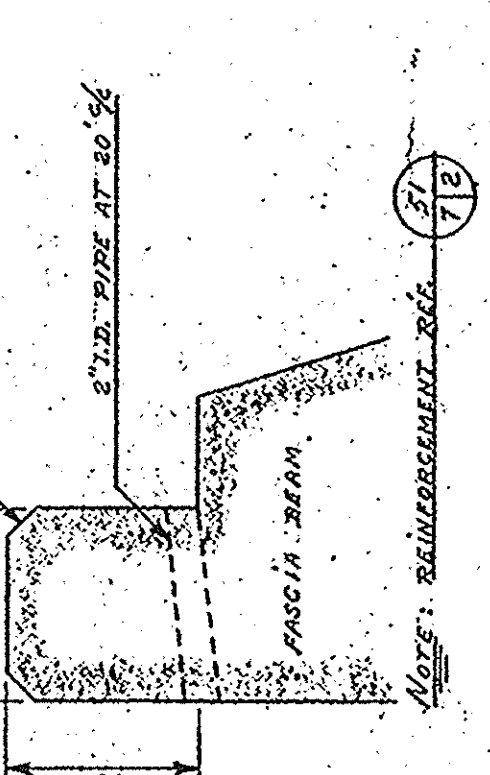


WHEEL GUARD FROM e. of 97°
SCALE: 1" = 1'-0"

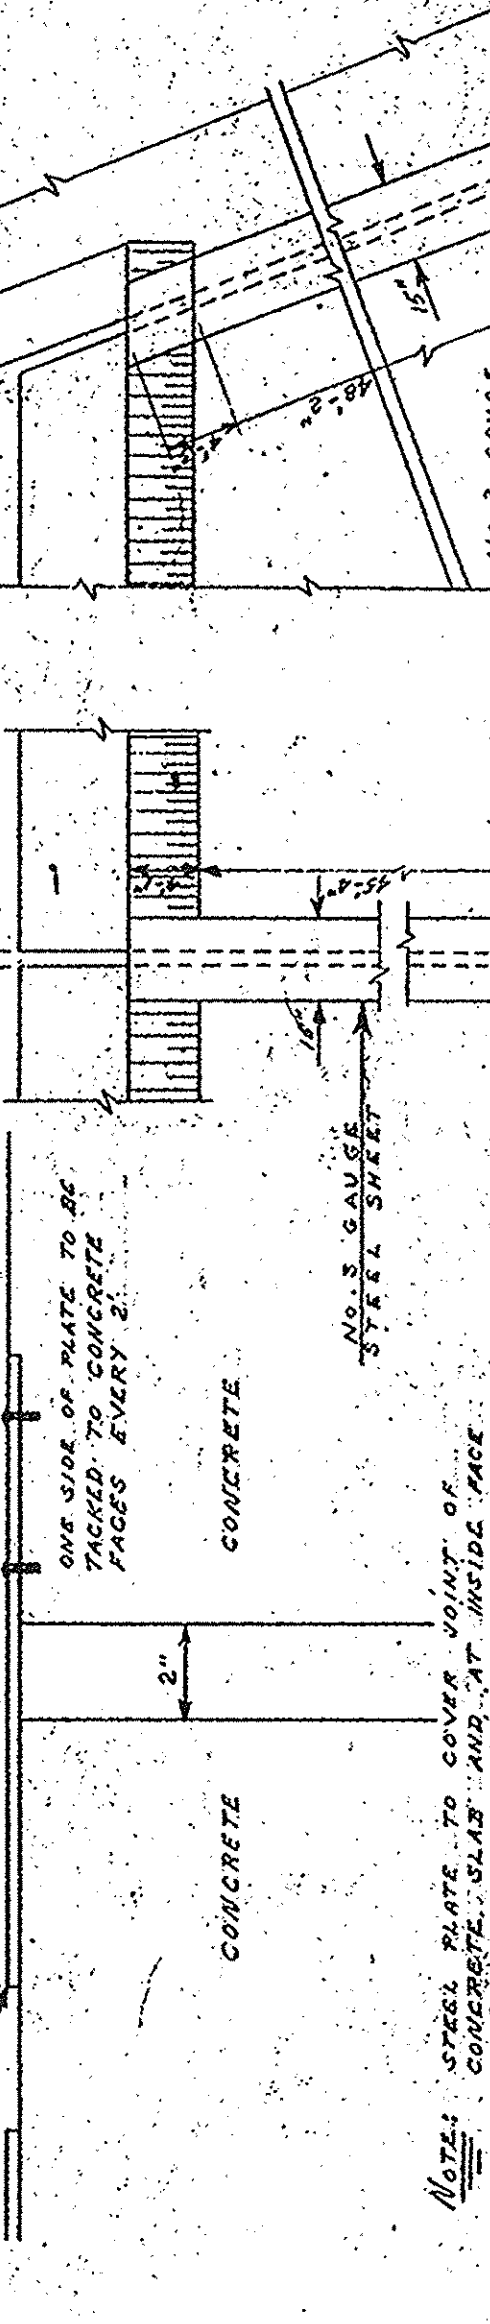


79 EXPANSION JOINT ARRANGEMENT 80 EXP. JOINT BENTS 21-22 81 EXP. JOINT SCALE 3" 1'-0" 92 SCALE 3/8" = 1'-0" 92

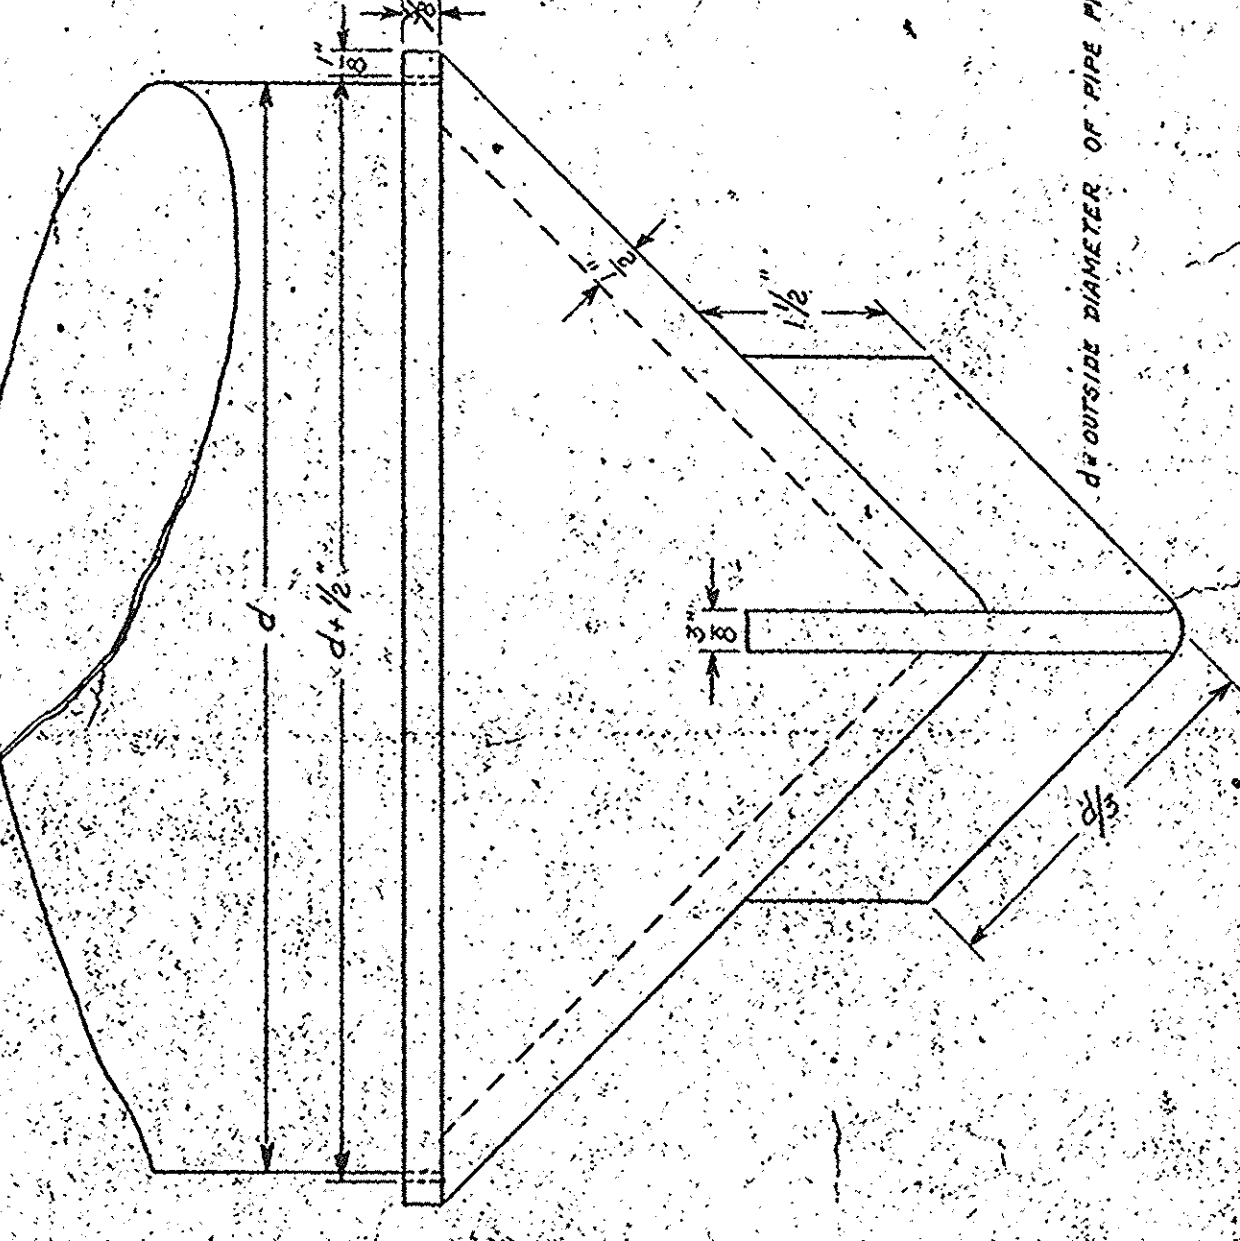

DETAILS OF STEEL SHOES

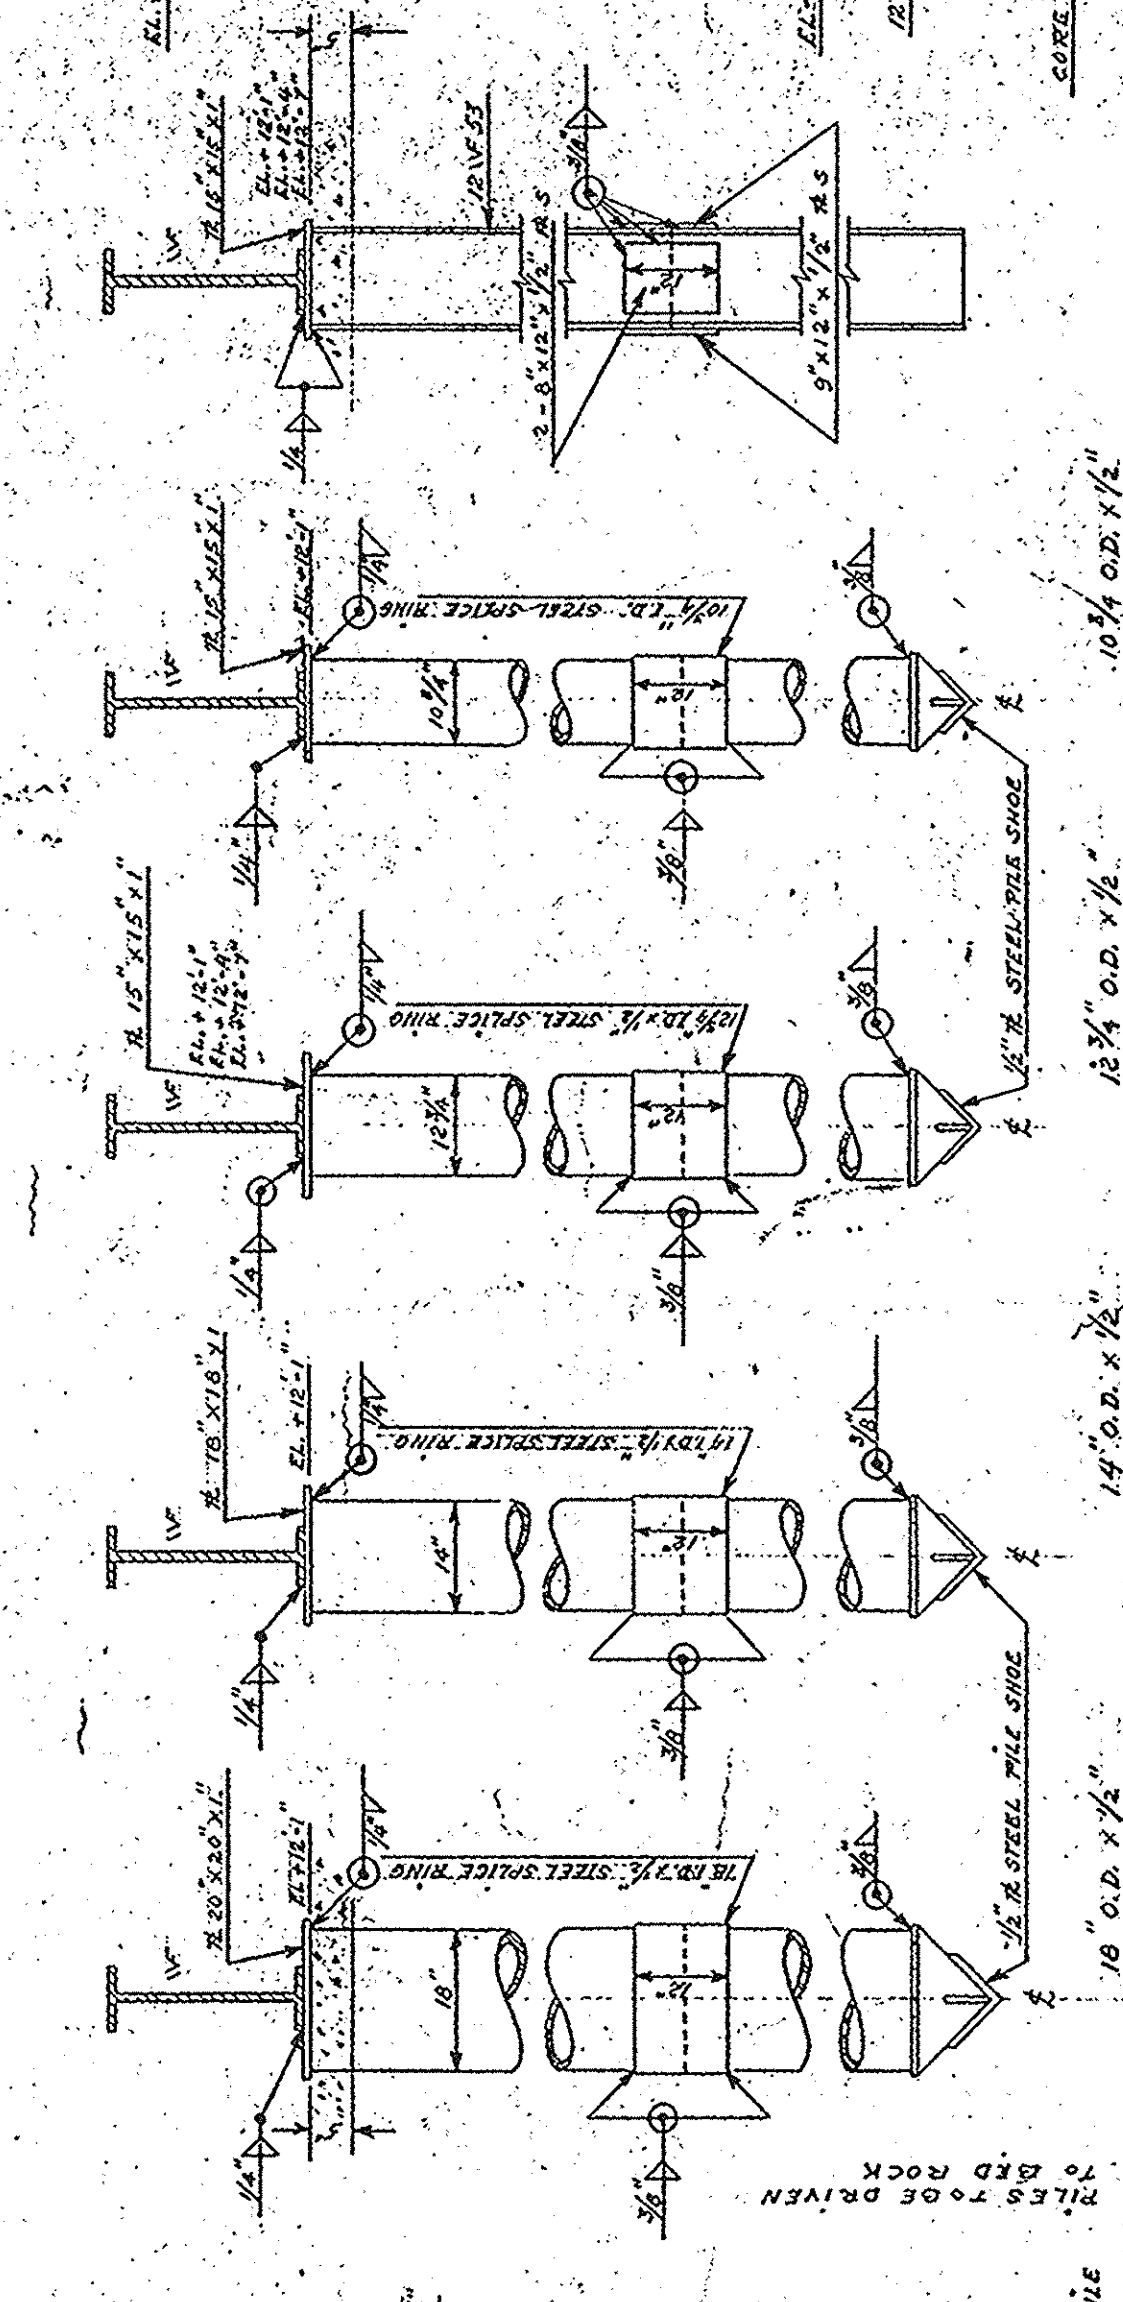

PIPE PILE DETAILS
SCALE: 1/2" = 1'-0"

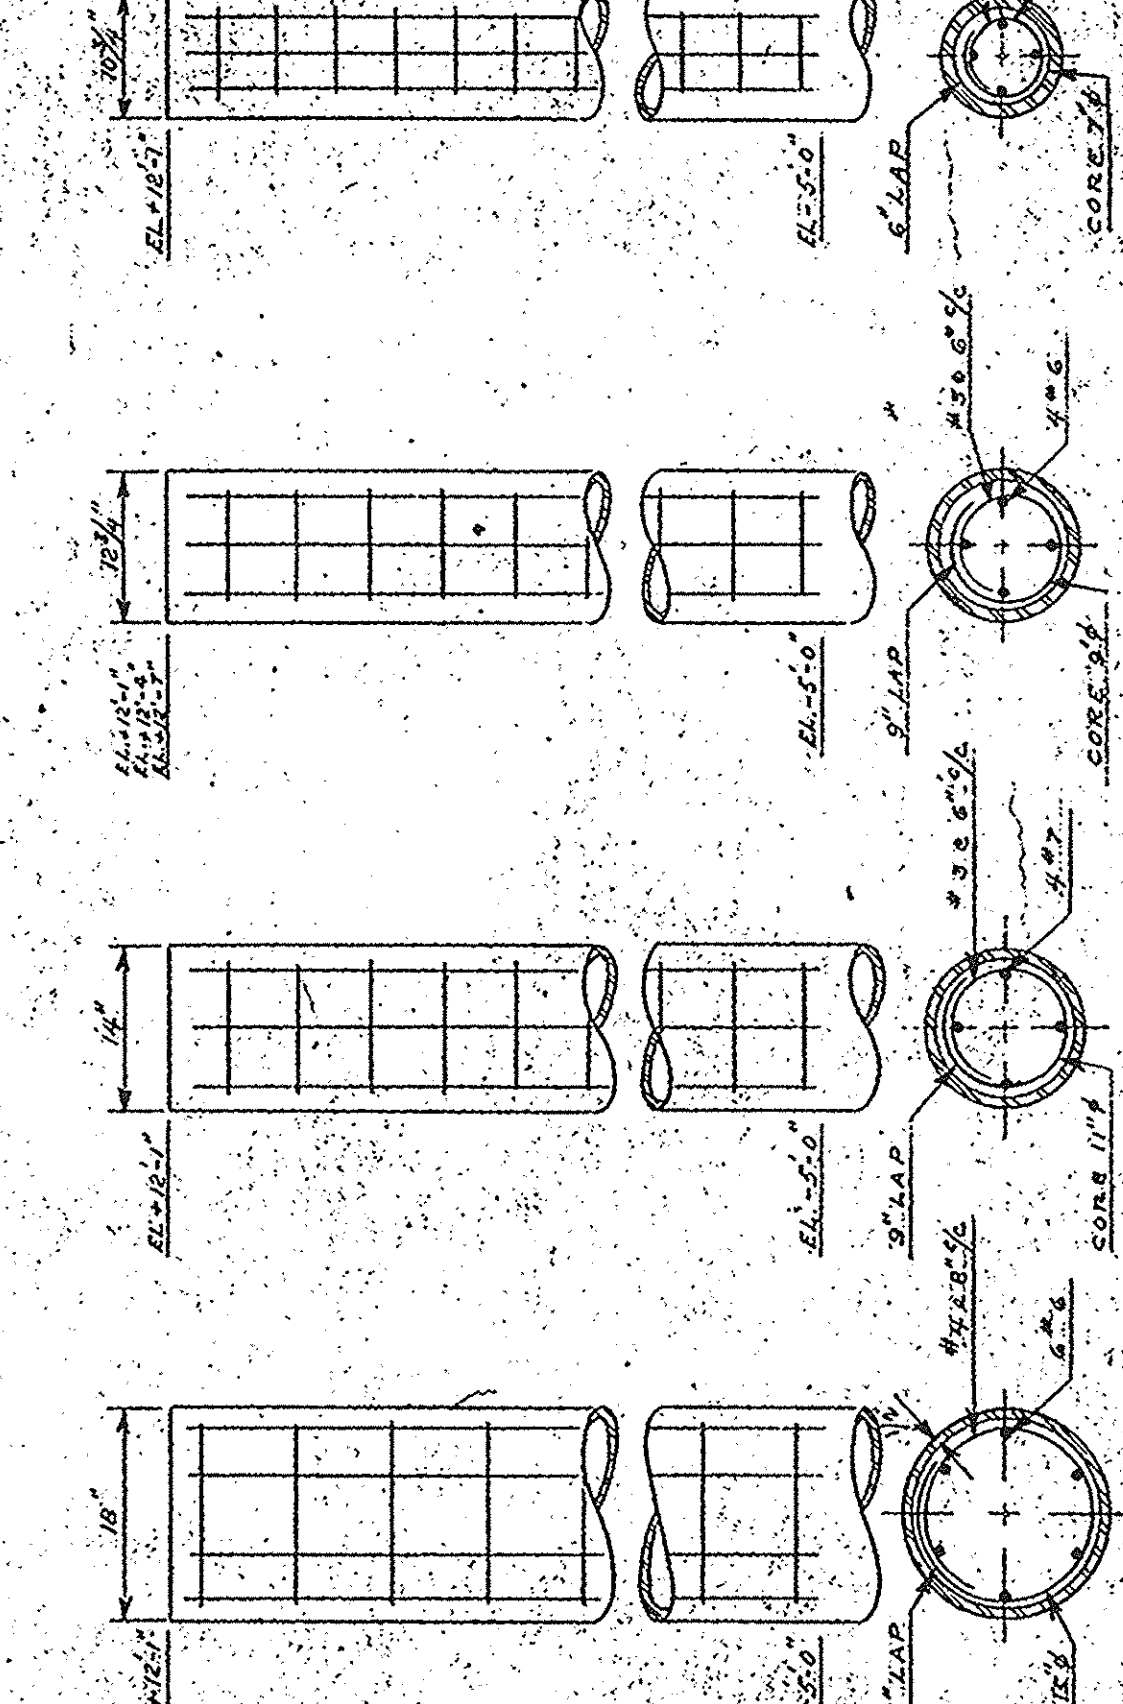

REINFORCING STEEL IN PIPE PILES
SCALE: $\frac{3}{4}$ " ϕ = 1'-0"

AS BUILT



Job title*	Titre du projet
MARTINE JANTREBOIS POTAIN, QUIN	"HARBOUR IMPROVEMENTS"
PIERRE "C" SIBIRYAK	

Drawing title: Titre du dessin

STONE FURNACEMENT, FILL
& PAVING - WHEELBOARDS,
EXPANSION JOINTS -
PIPE PILES DETAILS

date:	date:	date:
designed by:	drawn by:	reviewed by:
conçu par: EXCEL	dessiné par:	1-3

examining party: <i>W. J. P. 2-19-15</i>	approved by: <i>W. J. P. 2-19-15</i>	job number: no du projet: <i>C.A. M-17-10</i>
	approved by: <i>W. J. P. 2-19-15</i>	job number: no du projet: <i>C.A. M-17-10</i>