

KEY PLAN
N.T.S.


Public Works and Government Services Canada / Travaux publics et Services gouvernementaux Canada
REAL PROPERTY SERVICES
 Pacific Region
 SERVICES IMMOBILIERS

Klohn Crippen Berger

ANCHOR QEA

DRAWING LIST **SITE PLAN**
1:1000

DRAWING NUMBER	TITLE	DRAWING NUMBER	TITLE
C 1	SITE PLAN AND DRAWING LIST	S 1 TO S 109	NOT USED
C 2	NOTES AND ABBREVIATIONS	110	CONSTRUCTION AT HIGH MAST LIGHT AREA
C 3	EXISTING BATHYMETRY AND SURVEY INFORMATION	111 TO S 121	NOT USED
C 4	EXISTING CONDITIONS AND GEOTECHNICAL INFORMATION	122	WEST AND SOUTH JETTY DECK - CHAIN LADDER AND ACCESS LADDERS MODIFICATIONS
C 5	WEST JETTY - GENERAL ARRANGEMENT - PLAN	123 TO S 127	NOT USED
C 6	SOUTH JETTY - GENERAL ARRANGEMENT - PLAN	128	FENDERING - SHEET 1
C 7	WEST AND SOUTH JETTY - GENERAL ARRANGEMENT - SECTIONS	129	FENDERING - SHEET 2
C 8	CONTRACTOR'S WORK AREA AND SITE ACCESS	130	HAND RAIL
C 9	NOT USED	131	ACCESS LADDERS AT NAVIGATION MARKER DOLPHINS
C 10	SOUTH JETTY EXISTING AND MODIFIED PLANS	132 TO S 150	NOT USED
C 11 TO C 13	NOT USED	151	TUG BOAT WHARF - DETAILS
C 14	PHOTOGRAPHS OF EXISTING CONDITIONS - SHEET 1		
C 15	PHOTOGRAPHS OF EXISTING CONDITIONS - SHEET 2		
C 16	PHOTOGRAPHS OF EXISTING CONDITIONS - SHEET 3		
C 17	PHOTOGRAPHS OF EXISTING CONDITIONS - SHEET 4		
C 18 TO C 20	NOT USED		
C 21	REQUIRED DREDGE PLAN		
C 22	DREDGE CROSS SECTIONS - SHEET 1		
C 23	DREDGE CROSS SECTIONS - SHEET 2		
C 24	NOT USED		
C 25	DREDGE DETAILS - SHEET 1		
C 26	DREDGE DETAILS - SHEET 2		
C 27	MATERIAL OFFLOADING, HANDLING, STORAGE, AND TURBIDITY CONTROL DETAILS		
C 28	ENGINEERED CAPPING PLAN		
C 29	ENGINEERED CAPPING CROSS SECTIONS - SHEET 1		
C 30	ENGINEERED CAPPING CROSS SECTIONS - SHEET 2		
C 31	NOT USED		
C 32	ENGINEERED CAPPING DETAILS - SHEET 1		
C 33	ENGINEERED CAPPING DETAILS - SHEET 2		
C 34 TO C 45	NOT USED		
C 46	SERVICES TERMINATION PITS		
C 47	PHOTOGRAPHS OF AS-BUILT CONDITIONS		
C 48	WEST JETTY NAVIGATION MARKER DOLPHINS AS-BUILT		
C 49	PILE REPAIRS AS-BUILTS - SHEET 1		
C 50	PILE REPAIRS AS-BUILTS - SHEET 2		
C 51	PILE REPAIRS AS-BUILTS - SHEET 3		
CSM 1	WEST AND SOUTH JETTY - EXISTING CONDITIONS - FENDER REMOVAL - SHEET 1		
CSM 2	WEST AND SOUTH JETTY - EXISTING CONDITIONS - FENDER REMOVAL - SHEET 2		
CSM 3	WEST AND SOUTH JETTY - SHEET PILE WALL - EXISTING CONDITIONS		
CSM 4	SHEET PILE WALL MODIFICATIONS - PLAN AND ELEVATIONS		
CSM 5	SHEET PILE WALL MODIFICATIONS - NOTES AND SECTIONS		
CSM 6	SHEET PILE WALL MODIFICATIONS - CONSTRUCTION SEQUENCE		
CSM 7	SHEET PILE WALL MODIFICATIONS - DETAILS - SHEET 1		
CSM 8	SHEET PILE WALL MODIFICATIONS - DETAILS - SHEET 2		
CSM 9	SHEET PILE WALL MODIFICATIONS - DETAILS - SHEET 3		
CSM 10	PILE DRIVING RECORDS - SHEET 1		
CSM 11	PILE DRIVING RECORDS - SHEET 2		
CSM 12	PILE DRIVING RECORDS - SHEET 3		
CSM 13	PILE DRIVING RECORDS - SHEET 4		
D 1	WEST JETTY - EXISTING DECK STRUCTURE AND DEMOLITION - PLAN		
D 2	SOUTH JETTY - EXISTING DECK STRUCTURE AND DEMOLITION - PLAN		
D 3	SOUTH JETTY - EXISTING DECK STRUCTURE AND DEMOLITION - SECTIONS		
D 4	WEST JETTY - DEMOLITION ITEM DESCRIPTION AND ACTION TABLE		
D 5	WEST AND SOUTH JETTY - DEMOLITION ITEM DESCRIPTION AND ACTION TABLE		
D 6	SOUTH JETTY - EXISTING UNDER-DECK CONDITIONS AND DEMOLITION - PLAN		
D 7	EXISTING HIGH MAST LIGHT AREA AND DEMOLITION - SHEET 1		
D 8	EXISTING HIGH MAST LIGHT AREA AND DEMOLITION - SHEET 2		
D 9	RECORD DRAWINGS VARIOUS		
E 1	EXISTING SERVICES - CABLE TRAY LAYOUT - PLAN, SECTIONS AND DETAILS		
E 2	EXISTING SERVICES - ELECTRICAL CABLES AND KIOSKS - PLAN AND PHOTOS		
E 3	EXISTING SERVICES - SUBSTATION CABLE TRAY AND DUCTS - PLAN, SECTIONS AND DETAILS		
E 4	SERVICES - CABLE TRAY AND CABLES LAYOUT - PLAN		
E 5 TO E 8	NOT USED		
E 9	EXISTING SERVICES - ELECTRICAL CABLE SCHEDULE		
E 10	MODIFICATIONS TO SERVICES - ELECTRICAL CABLE SCHEDULE		
E 11	SOUTH JETTY - MODIFICATIONS TO CATHODIC PROTECTION SYSTEM		
E 12	SERVICES - ELECTRICAL - TERMINATION DETAILS		
M 1	EXISTING SERVICES - FIRE WATER MAIN AND KIOSKS - PLAN, SECTIONS AND DETAIL		
M 2	EXISTING SERVICES - SANITARY SEWER - PLAN		
M 3	EXISTING SERVICES - COMPRESSED AIR - PLAN		
M 4	SERVICES - FIRE WATER MAIN - PLAN AND DETAILS		
M 5	SERVICES - SANITARY SEWER - PLAN AND SECTION		
M 6	SERVICES - COMPRESSED AIR - PLAN		
M 7	NOT USED		
M 8	SERVICES FIRE WATER MAIN, SANITARY SEWER AND COMPRESSED AIR - DETAILS		
M 9	NOT USED		
M 10	NOT USED		

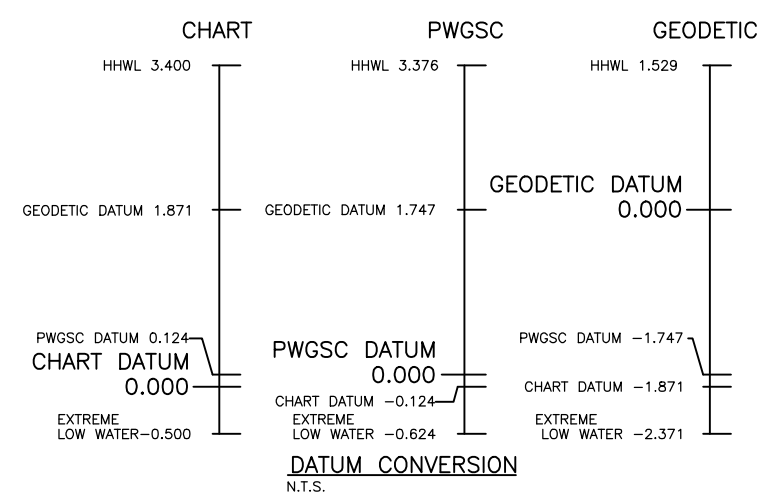

Revision/Revision	Description/Description	Date/Date
2	RECORD DRAWING	2017/03/29
1	ADDENDUM NO. 2	2015/03/20
0	ISSUED FOR TENDER	2014/12/19

Client/client
PUBLIC WORKS AND GOVERNMENT SERVICES CANADA

Project title/Titre du projet
ESQUIMALT GRAVING DOCK
 825 ADMIRALS ROAD, VICTORIA, BC

ESQUIMALT GRAVING DOCK WATERLOT PHASE 2 SOUTH JETTY UNDER-PIER SEDIMENT REMEDIATION

Consultant Signature Only

Designed by/Concept par
 GEOFF COOPER


Drawn by/Desainé par
 ARNIE RIST

PWGSC Project Manager/Administrateur de Projets TPSPC
 ANDREW MYLLY

Regional Manager, Environmental Services
 COLLIN KINGMAN

Drawing title/Titre du dessin
SITE PLAN AND DRAWING LIST

Project No./No. du projet	Sheet/feuille	Revision no./révision
R.018400.002	C1	2

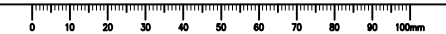

1. GENERAL NOTES:

- 1.1. DETAILED REQUIREMENTS FOR MATERIALS AND FABRICATION ARE DESCRIBED IN THE SPECIFICATIONS. FOR CONVENIENCE, CERTAIN EXTRACTS ARE REPRODUCED BELOW, IN THE EVENT OF A CONFLICT BETWEEN THE DRAWINGS & THE SPECIFICATIONS, THE SPECIFICATIONS SHALL GOVERN.
- 1.2. DIMENSIONS ARE IN MILLIMETRES UNLESS NOTED OTHERWISE. ELEVATIONS ARE IN METRES, CHART DATUM.
- 1.3. DIMENSIONS, LAYOUT AND DETAILS OF EXISTING STRUCTURES ARE BASED ON DRAWINGS OBTAINED FROM PUBLIC WORKS AND GOVERNMENT SERVICES CANADA AND MAY BE SUBJECT TO CONSTRUCTION VARIATIONS AND MODIFICATIONS. THE CONTRACTOR SHALL VERIFY DIMENSIONS AND CONFIGURATION PRIOR TO ANY DEMOLITION AND REMOVAL AND BRING ANY DISCREPANCIES OR POTENTIAL CONFLICTS TO THE ATTENTION OF THE DEPARTMENTAL REPRESENTATIVE. REFERENCE DRAWINGS ARE LISTED IN THE SPECIFICATIONS.
- 1.4. CONTRACTOR SHALL COMPLETE PRE-CONSTRUCTION SURVEY TO MEET BATHYMETRY DATA COLLECTION REQUIREMENTS A MINIMUM OF TEN (10) WORKING DAYS PRIOR TO DREDGING OR DEBRIS REMOVAL WORK, AS DESCRIBED IN SECTION 02 21 13 - SURVEYING AND POSITIONING CONTROL.
- 1.5. THE CONTRACTOR SHALL COORDINATE ALL ACTIVITIES WITH THE DEPARTMENTAL REPRESENTATIVE. LOCATION OF THE CONTRACTOR'S SITE OFFICE AND MATERIAL STORAGE SHALL BE APPROVED BY THE DEPARTMENTAL REPRESENTATIVE.
- 1.6. TIDE ELEVATIONS (CHART DATUM):

EXTREME HIGH WATER LEVEL (EHWL)	3.8m
HIGHER HIGH WATER LEVEL (HHWL)	3.4m
MEAN WATER LEVEL (MWL)	1.9m
LOWER LOW WATER LEVEL (LLWL)	0.1m
EXTREME LOW WATER LEVEL	-0.5m
- 1.7. PWGSC SITE BENCHMARK IS "BOLT". FROM PWGSC PLAN SK4593-1 DATED OCTOBER 1989, "BOLT" IS ELEVATION 4.725m TO PWGSC DATUM, BOLT IS 4.849m ABOVE LLWL; LLWL IS 0.124m BELOW PWGSC DATUM 0.0; LLWL IS 1.871m BELOW GEODETIC ELEVATION.
 TO CONVERT FROM GEODETIC DATUM TO CHART DATUM, ADD 1.871m.
 TO CONVERT FROM GEODETIC DATUM TO PWGSC DATUM, ADD 1.747m.
 TO CONVERT FROM PWGSC DATUM TO CHART DATUM, ADD 0.124m.
- 1.8. FOR CONTROL MONUMENT INFORMATION SEE DRAWING C3.
- 1.9. THE SOUTH JETTY REMEDIATION WORKS HAVE BEEN DESIGNED FOR FORCES ASSOCIATED WITH USAGE, E.G. LIVE LOADS, CRANE LOADS AND THE ENVIRONMENTAL FORCES SET FORTH IN THE NATIONAL BUILDING CODE OF CANADA, 2010. DESIGN LIVE LOADS FOR SPECIFIC STRUCTURAL COMPONENTS ARE AS SPECIFIED ON THE RELEVANT DRAWINGS. THE DESIGN SERVICE LIFE FOR MAJOR STRUCTURAL COMPONENTS IS:

HIGH MAST LIGHT	75 YEARS
BULL RAIL	20 YEARS
SAFETY LADDERS	20 YEARS
FENDER PILES	20 YEARS
HAND RAIL	20 YEARS
- 1.10. UNDERPIER AREA LOWER INTERTIDAL AND SUBTIDAL BATHYMETRY WITHIN THE TEMPORARY RE-SUSPENSION BARRIER CONTAINMENT AREA IS FROM FEBRUARY 2009, JUNE 2010 AND JANUARY 2011 CRA CANADA SURVEYS LTD. MULTI BEAM SURVEY. UPPER INTERTIDAL ELEVATIONS FROM SEPTEMBER 2009 AND JULY 2011 SURVEY BY FOCUS CORPORATION. OPEN WATER AREAS OUTSIDE OF THE TEMPORARY RE-SUSPENSION BARRIER CONTAINMENT AREA WERE DREDGED AS PART OF THE PHASE 1B OPEN-WATER REMEDIATION PROJECT. OPEN WATER BATHYMETRY SURVEY WAS CONDUCTED BY CRA CANADA SURVEYS INC. ON 2014/03/05 FOLLOWING COMPLETION OF PHASE 1B WORK.
- 1.11. SCALES INDICATED ON DRAWINGS ARE FULL SIZE A1 DRAWINGS.
- 1.12. THE EXISTING SOUTH JETTY SHEET PILE PERIMETER WALL WAS DESIGNED AS A TEMPORARY STRUCTURE WITH A DESIGN SERVICE LIFE FOR MAJOR STRUCTURAL COMPONENTS OF 10 YEARS. FOR DETAILS AND CONFIGURATION OF EXISTING SHEET PILE PERIMETER WALL, REFER TO THE PROJECT REFERENCE DRAWINGS. SEISMIC LOADS WERE NOT CONSIDERED FOR THE SHEET PILE CONTAINMENT WALL AS IT IS CONSIDERED A TEMPORARY STRUCTURE.
- 1.13. DESIGN LOADS ON SHEET PILE PERIMETER WALL WHEN RE-DRIVEN TO ELEVATION SHOWN ON THE DRAWINGS, AND WHEN JETTY DECK SUPPORT CONDITION HAS BEEN REMOVED:
 - A.) PROPWASH LOADS:
 - A.) CONTRACTOR TUG (500 HP) 25% POWER 1 THRUSTER - 5m FROM WALL
 - B.) SEASPAN HAWK 10% POWER 2 THRUSTERS - 15m FROM WALL
- 1.14. FOR ALLOWABLE DECK LOADS, SEE APPENDIX TO THE SPECIFICATIONS. EGD LOAD RATING LAYOUT, SKETCH 2 (KM ENGINEERING GROUP INC. 2005), SUPPLEMENTED BY MORE RECENT RECORD DRAWINGS FOR WEST/SOUTH CRANE PAD REHABILITATION WORKS.
- 1.15. TYPICAL ABBREVIATIONS:

APPROX/~	APPROXIMATE(LY)	DWG	DRAWING	H	HORIZONTAL	NAD	NORTH AMERICAN DATUM	REV	REVISION	TYP	TYPICAL
BC	BRITISH COLUMBIA	E	EASTING	HA	HECTARES	NF	NEAR FACE	SIM.	SIMILAR	U.N.O.	UNLESS NOTED OTHERWISE
BOT	BOTTOM	EF	EACH FACE	HHWL	HIGHER HIGH WATER LEVEL	No.	NUMBER	SO	SQUARE	U/S	UNDER SIDE
C/C	CENTRE TO CENTRE	EGD	ESQUIMALT GRAVING DOCK	ID	INNER DIAMETER	NOM	NOMINAL	STA	STATIONING	TYP.	TYPICAL
CCTV	CLOSED CIRCUIT TELEVISION	EHWL	EXTREME HIGH WATER LEVEL	INV	INVERT	N.T.S.	NOT TO SCALE	STD.	STANDARD	UHMW	ULTRA HIGH MOLECULAR WEIGHT POLYETHYLENE
CD	CHART DATUM	EL	ELEVATION	LLWL	LOWER LOW WATER LEVEL	O.D.	OUTSIDE DIAMETER	SS	STAINLESS STEEL	UTM	UNIVERSAL TRANSVERSE MERCATOR
C.I.P.	CAST IN PLACE	EQ SP	EQUALLY SPACED	LTD.	LIMITED	P	PLATE	T	TOP	V	VERTICAL
CRB	CONCRETE ROAD BARRIER	EW	EACH WAY	m	METRE	PROJ	PROJECTION	TBD	TO BE DETERMINED	X	EASTING
CSRS	CANADIAN SPATIAL REFERENCE SYSTEM	EXP JT	EXPANSION JOINT	MAX	MAXIMUM	PWGSC	PUBLIC WORKS AND GOVERNMENT SERVICES CANADA	T.O.	TOP OF	Y	NORTHING
CL	CLEAR	FF	FAR FACE	MIN	MINIMUM	RAD,R	RADIUS	T.O.C	TOP OF CONCRETE	Z	ELEVATION IN METRES
C/W	COMPLETE WITH	GALV	GALVANIZED	mm	MILLIMETRE	REF.	REFERENCE	T.O.R	TOP OF RAIL		
CJ	CONSTRUCTION JOINT	H	HORIZONTAL	MPa	MEGAPASCAL	REINF	REINFORCEMENT	TRB	TEMPORARY RESUSPENSION BARRIER		
Ø	DIAMETER	HA	HECTARES	MWL	MEAN WATER LEVEL	REQ/REQ'D	REQUIRED	TRBCA	TEMPORARY RESUSPENSION BARRIER CONTAINMENT AREA		
DU	DREDGE UNIT	HHWL	HIGHER HIGH WATER LEVEL	N	NORTHING						
☉	CENTERLINE	GALV	GALVANIZED								

2. TEMPORARY RE-SUSPENSION BARRIERS:

- 2.1. SEE SPECIFICATIONS FOR DESIGN REQUIREMENTS REGARDING TEMPORARY RE-SUSPENSION BARRIERS.

3. CONCRETE:

- 3.3. ALL DECK SLAB CONCRETE AT THE HIGH MAST LIGHT SHALL HAVE COMPRESSIVE STRENGTH OF 45 MPa @ 28 DAYS. ALL OTHER CONCRETE SHALL HAVE COMPRESSIVE STRENGTH OF 30 MPa @ 28 DAYS.
- 3.4. ALL EXPOSED EDGES SHALL HAVE 20mm CHAMFER, U.N.O.

4. CONCRETE REINFORCEMENT:

- 4.1. REINFORCING BARS SHALL BE UNCOATED BILLET STEEL BARS CONFORMING TO CAN/CSA G30.18-09, 400 MPa MIN. YIELD OR ASTM A615 GRADE 75 WHERE INDICATED.
- 4.2. DESIGNATION OF REINFORCING BARS:

3-10M0800 MEANS THREE 10M BARS 800 LONG. 2-C20M1500 MEANS TWO 20M BARS, EACH WITH A 90 DEGREE STANDARD HOOK ON EACH END AND A TOTAL LENGTH OF 1500 PER BAR.

--- --- --- DENOTES BOTTOM BARS.
 - - - - - DENOTES TOP BARS.
- 4.3. DIMENSIONS TO REINFORCEMENT ARE TO CENTRE LINES OF BARS, EXCEPT WHERE CONCRETE COVER OR CLEARANCE BETWEEN BARS IS SHOWN.
- 4.4. CONCRETE COVER FOR REINFORCEMENT (CAST-IN-PLACE):

TOP SURFACES OF JETTY STRUCTURES	70
ALL OTHER CONCRETE FACES, U.N.O.	70

5. STRUCTURAL STEEL AND STEEL FABRICATIONS:


- 5.1. STRUCTURAL STEEL SHALL MEET CAN/CSA G40.20-04 FOR GENERAL REQUIREMENTS, AND CAN/CSA G40.21-04 FOR QUALITY.

GRADES OF MATERIAL, UNLESS NOTED OTHERWISE:	
STRUCTURAL STEEL AND MISC. METAL	350W
BOLTS, NUTS AND WASHERS	ASTM A325M
ANCHOR BOLTS	ASTM A307
CONCRETE ANCHOR RODS	ASTM A193 GRADE B7
- 5.2. ALL STEEL TO BE HOT DIPPED GALVANIZED, U.N.O.
- 5.3. EXPOSED METALWORK TO BE GROUNDED PER SPECIFICATION 26 05 27.

6. TIMBER AND TIMBER PILES:

- 6.1. THESE NOTES APPLY UNLESS NOTED OTHERWISE ON THE DRAWINGS.
- 6.2. ALL TIMBER WORK SHALL CONFORM TO CSA 086.01, DFO TECHNICAL REPORT GUIDELINES TO PROTECT FISH AND FISH HABITAT FROM TREATED WOOD USED IN AQUATIC ENVIRONMENTS IN THE PACIFIC REGION AND GOOD MARINE TIMBER PRACTICE.
- 6.3. DIMENSIONS TO AND OF EXISTING TIMBER ARE BASED ON REFERENCE DRAWINGS AND REQUIRE SITE CONFIRMATION BY THE CONTRACTOR.
- 6.4. SAWN TIMBER SHALL BE NO. 1 COASTAL DOUGLAS FIR.
- 6.5. PRESSURE TREATMENT OF TIMBER SHALL BE IN ACCORDANCE WITH CSA-080 SERIES-08 (R2012).
- 6.6. THE TOPS OF THE REINSTATED FENDER PILES AND DOLPHINS SHALL BE CUT AT 1 VERTICAL TO 5 HORIZONTAL TOWARDS THE WATER PRIOR TO CAPPING. THE CUT FACE SHALL BE TREATED WITH 2 COATS OF COPPER NAPHTHENATE AND ONE COAT OF TROWEL MASTIC AT LEAST 6mm THICK. THE PILE TOP SHALL THEN BE COVERED WITH A SHEET OF 0.8mm (22 GAUGE) ANNEALED CORROSION RESISTANT ALUMINUM CUT 150mm WIDER THAN THE DIAMETER OF THE PILE TOP. THE OVERHANGING EDGES SHALL BE CRIMPED AND TURNED DOWN AND NAILED WITH 8 ALUMINUM ROOFING NAILS.
- 6.7. ALL BOLT HOLES THROUGH TIMBER PILES SHALL BE TREATED WITH 2 COATS OF NAPHTHENATE PRIOR TO BOLTING. THIS APPLIES TO NEW HOLES AND TO RE-USED HOLES.
- 6.8. HOLES AND UNUSED BOLT HOLES IN EXISTING PILES SHALL BE PLUGGED FULL LENGTH WITH TAPERED TIGHT FITTING TREATED HARDWOOD DOWELS. COPPER NAPHTHENATE SHALL BE POURED OR SWABBED INTO THE HOLE AND THE DOWEL SHALL BE TREATED PRIOR TO INSTALLATION.
- 6.9. BOLTS IN TIMBERS AND PILES SHALL CONFORM TO ASTM A307 GRADE A WHEREVER STANDARD BOLT LENGTHS ARE SUITABLE. BOLTS SHALL BE TIGHTENED FROM THE NUT END.
- 6.10. BOLTS IN TIMBERS AND PILES FOR NON STANDARD LENGTHS SHALL BE THREADED CONFORMING TO ASTM A307 GRADE C. WASHERS SHALL BE PROVIDED AT BOTH NUT AND BOLT HEAD. WASHERS SHALL BE MALLEABLE IRON, Ogee, OR ROUND PLATE WASHERS. FOR ROUND PLATE WASHERS, WASHER DIAMETER BY THICKNESS SHALL BE 70x6 FOR 16 DIAMETER; 85x8 FOR 19 DIAMETER; AND 100x10 FOR 25 DIAMETER BOLTS. POLYURETHANE MASTIC SHALL BE PLACED UNDER ALL WASHERS.
- 6.11. LAG BOLTS SHALL CONFORM TO CSA STANDARD B34.

SYMBOLS:

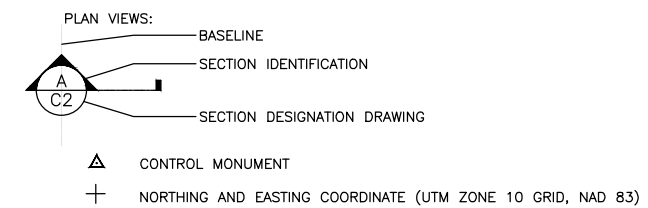

1	RECORD DRAWING	2017/03/29
0	ISSUED FOR TENDER	2014/12/19
Revision/	Description/Description	Date/Date

Client/client
PUBLIC WORKS AND GOVERNMENT SERVICES CANADA

Project title/Titre du projet
ESQUIMALT GRAVING DOCK
825 ADMIRALS ROAD, VICTORIA, BC

ESQUIMALT GRAVING DOCK WATERLOT PHASE 2
SOUTH JETTY UNDER-PIER SEDIMENT REMEDIATION

Consultant Signature Only

Designed by/Concept par
GEOFF COOPER


Drawn by/Dessiné par
ARNIE RIST


PWGSC Project Manager/Administrateur de Projets /PSCG
ANDREW MYLLY

Regional Manager, Environmental Services
COLLIN KINGMAN

Drawing title/Titre du dessin
NOTES AND ABBREVIATIONS

Project No./No. du projet	Sheet/	Revision no./
R.018400.002	C2	1

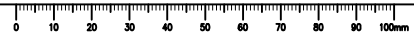

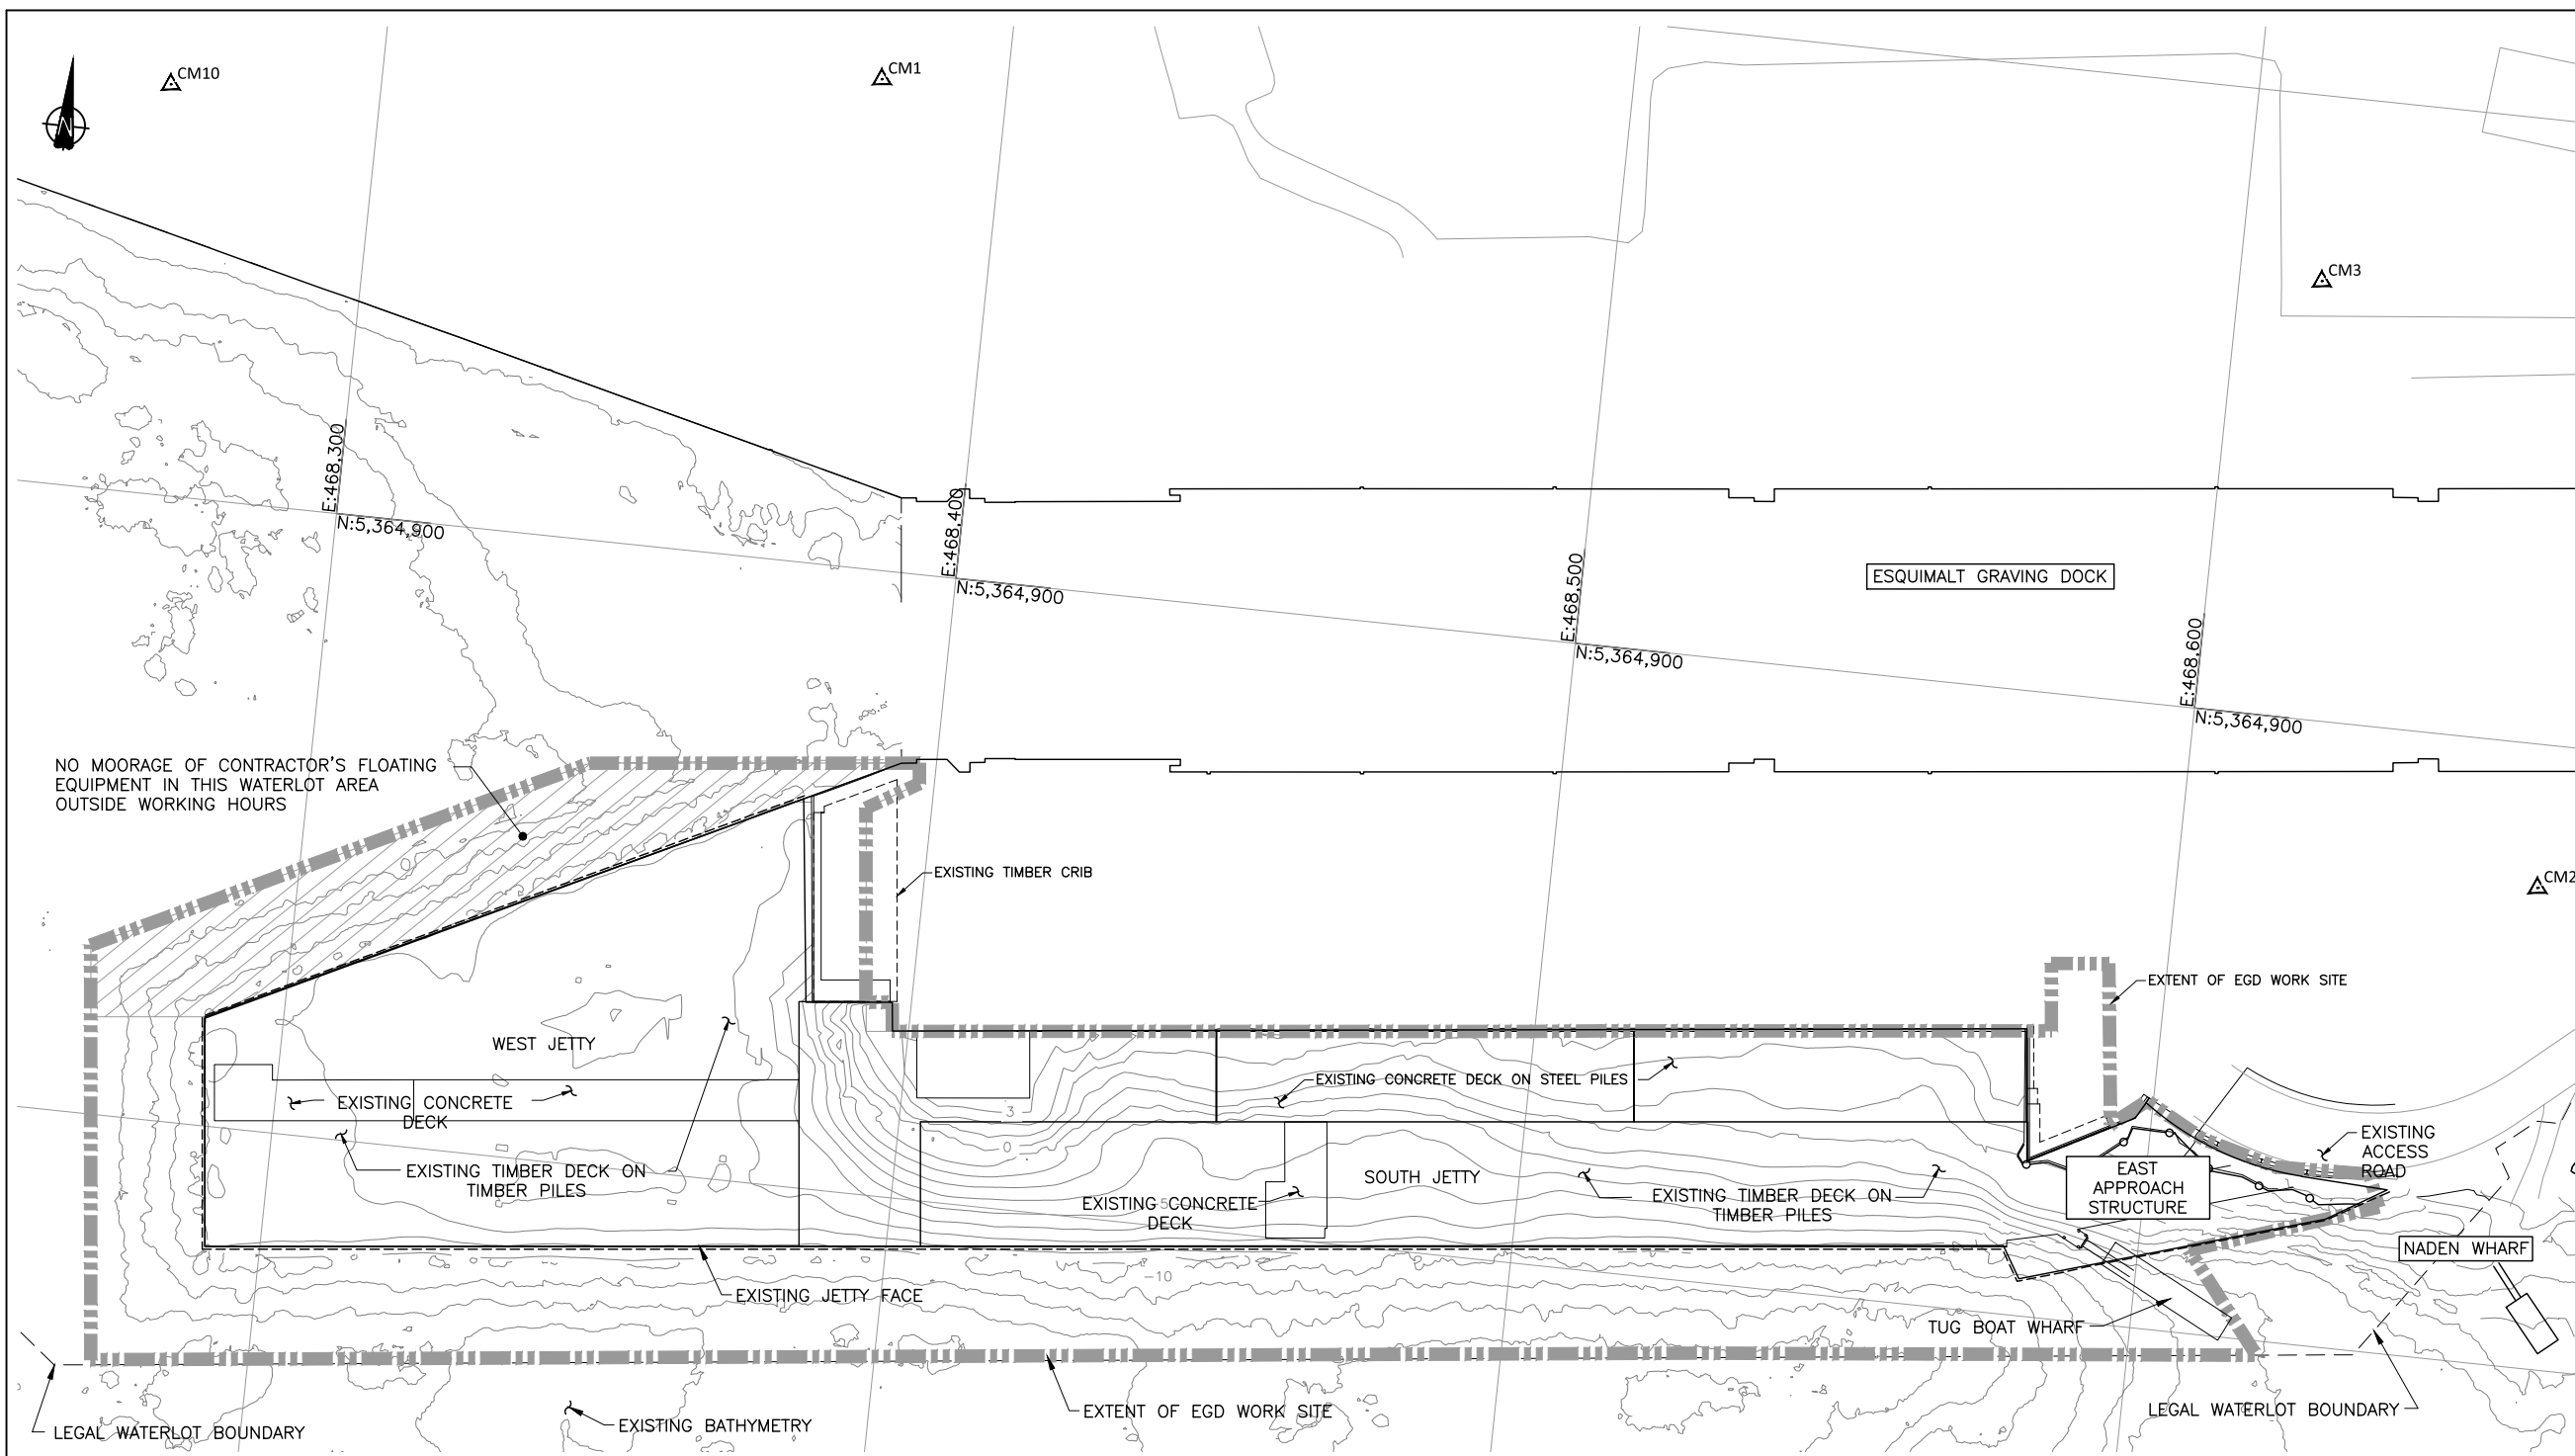

PLAN
1:600

CONTROL MONUMENT ID	MONUMENT CONTROLLER	COORDINATES		
		NORTHING (Y)	EASTING (X)	ELEVATION IN METRES (Z)
CM 1	EGD	5364978.464	468379.840	17.846
CM 2	EGD	5364877.036	468657.811	7.562
CM 3	EGD	5364970.304	468613.214	7.787
CM 10	EGD	5364965.758	468266.364	2.256

NOTES:
 UPLAND HORIZONTAL DATUM: UTM NAD83 (CSRS)
 UPLAND VERTICAL DATUM: GEODETIC
 EGD: ESQUIMALT GRAVING DOCK
 MASCOT: MANAGEMENT OF SURVEY CONTROL OPERATIONS AND TASKS (MINISTRY OF AGRICULTURE AND LANDS)

HORIZONTAL DATUM: UTM ZONE 10 GRID, NAD83.
 VERTICAL DATUM: CHART DATUM (C.D.)

- NOTES:**
1. BASE MAP FROM GOLDER, JANUARY 2012.
 2. EGD WORK SITE ALSO INCLUDES UPLAND AREAS OF THE EGD FACILITY AS SHOWN ON THE DRAWINGS AND DESCRIBED IN THE SPECIFICATIONS.
 3. OPEN WATER AREAS OUTSIDE OF THE TEMPORARY RE-SUSPENSION BARRIER CONTAINMENT AREA WERE REMEDIATED AS PART OF THE PHASE 1B OPEN-WATER REMEDIATION PROJECT. SURVEY WAS CONDUCTED BY CRA CANADA SURVEYS INC. ON 2014/03/05.
 4. CONTRACTOR TO COORDINATE WITH PWGSC REGARDING USE OF CONTROL MONUMENTS AS DESCRIBED ABOVE OR CAN-NET SURVEY DATUM CONTROL. SEE SECTION 02 21 13 SURVEY AND POSITIONING CONTROL.
 5. CONTRACTOR TO VERIFY THE COORDINATES AND ELEVATION OF ALL CONTROL MONUMENTS USED PRIOR TO START OF WORK.
 6. TUG BOAT WHARF LOCATION AND DIMENSIONS SURVEYED BY CRA CANADA SURVEYS INC. ON 2013/11/13. TUG BOAT WHARF TO BE RELOCATED ACCORDING TO THE SPECIFICATIONS.
 7. THE GLOBAL TERM SOUTH JETTY, AS DEFINED IN THE SPECIFICATIONS, INCLUDES BOTH THE WEST JETTY AND SOUTH JETTY AREAS AS SHOWN ON THE DRAWINGS.

- LEGEND:**
- 14--- PRE-CONSTRUCTION BATHYMETRY IN METERS
 - TEMPORARY RE-SUSPENSION BARRIER CONTAINMENT AREA
 - EXTENT OF EGD WORK SITE
 - △CM10 CONTROL MONUMENT LOCATION AND DESIGNATION
 - ORDINARY HIGH WATER LINE
 - JETTY SECTION DELINEATION

Revision/Revision	Description/Description	Date/Date
1	RECORD DRAWING	2017/03/31
0	ISSUED FOR TENDER	2014/12/19

Client/client
PUBLIC WORKS AND GOVERNMENT SERVICES CANADA


Project title/Titre du projet
**ESQUIMALT GRAVING DOCK
 825 ADMIRALS ROAD, VICTORIA, BC**


ESQUIMALT GRAVING DOCK WATERLOT PHASE 2 SOUTH JETTY UNDER-PIER SEDIMENT REMEDIATION

Consultant Signature Only
 Designed by/Concept par
 MATT WOLTMAN
 Drawn by/Dessiné par
 CHRIS HEWETT
 PWGSC Project Manager/Administrateur de Projets TPSGC
 ANDREW MYLLY
 Regional Manager, Environmental Services
 COLLIN KINGMAN
 Drawing title/Titre du dessin

EXISTING BATHYMETRY AND SURVEY INFORMATION

Project No./No. du projet	Sheet/feuille	Revision no./no. de révision
R.018400.002	C3	1

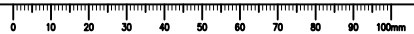

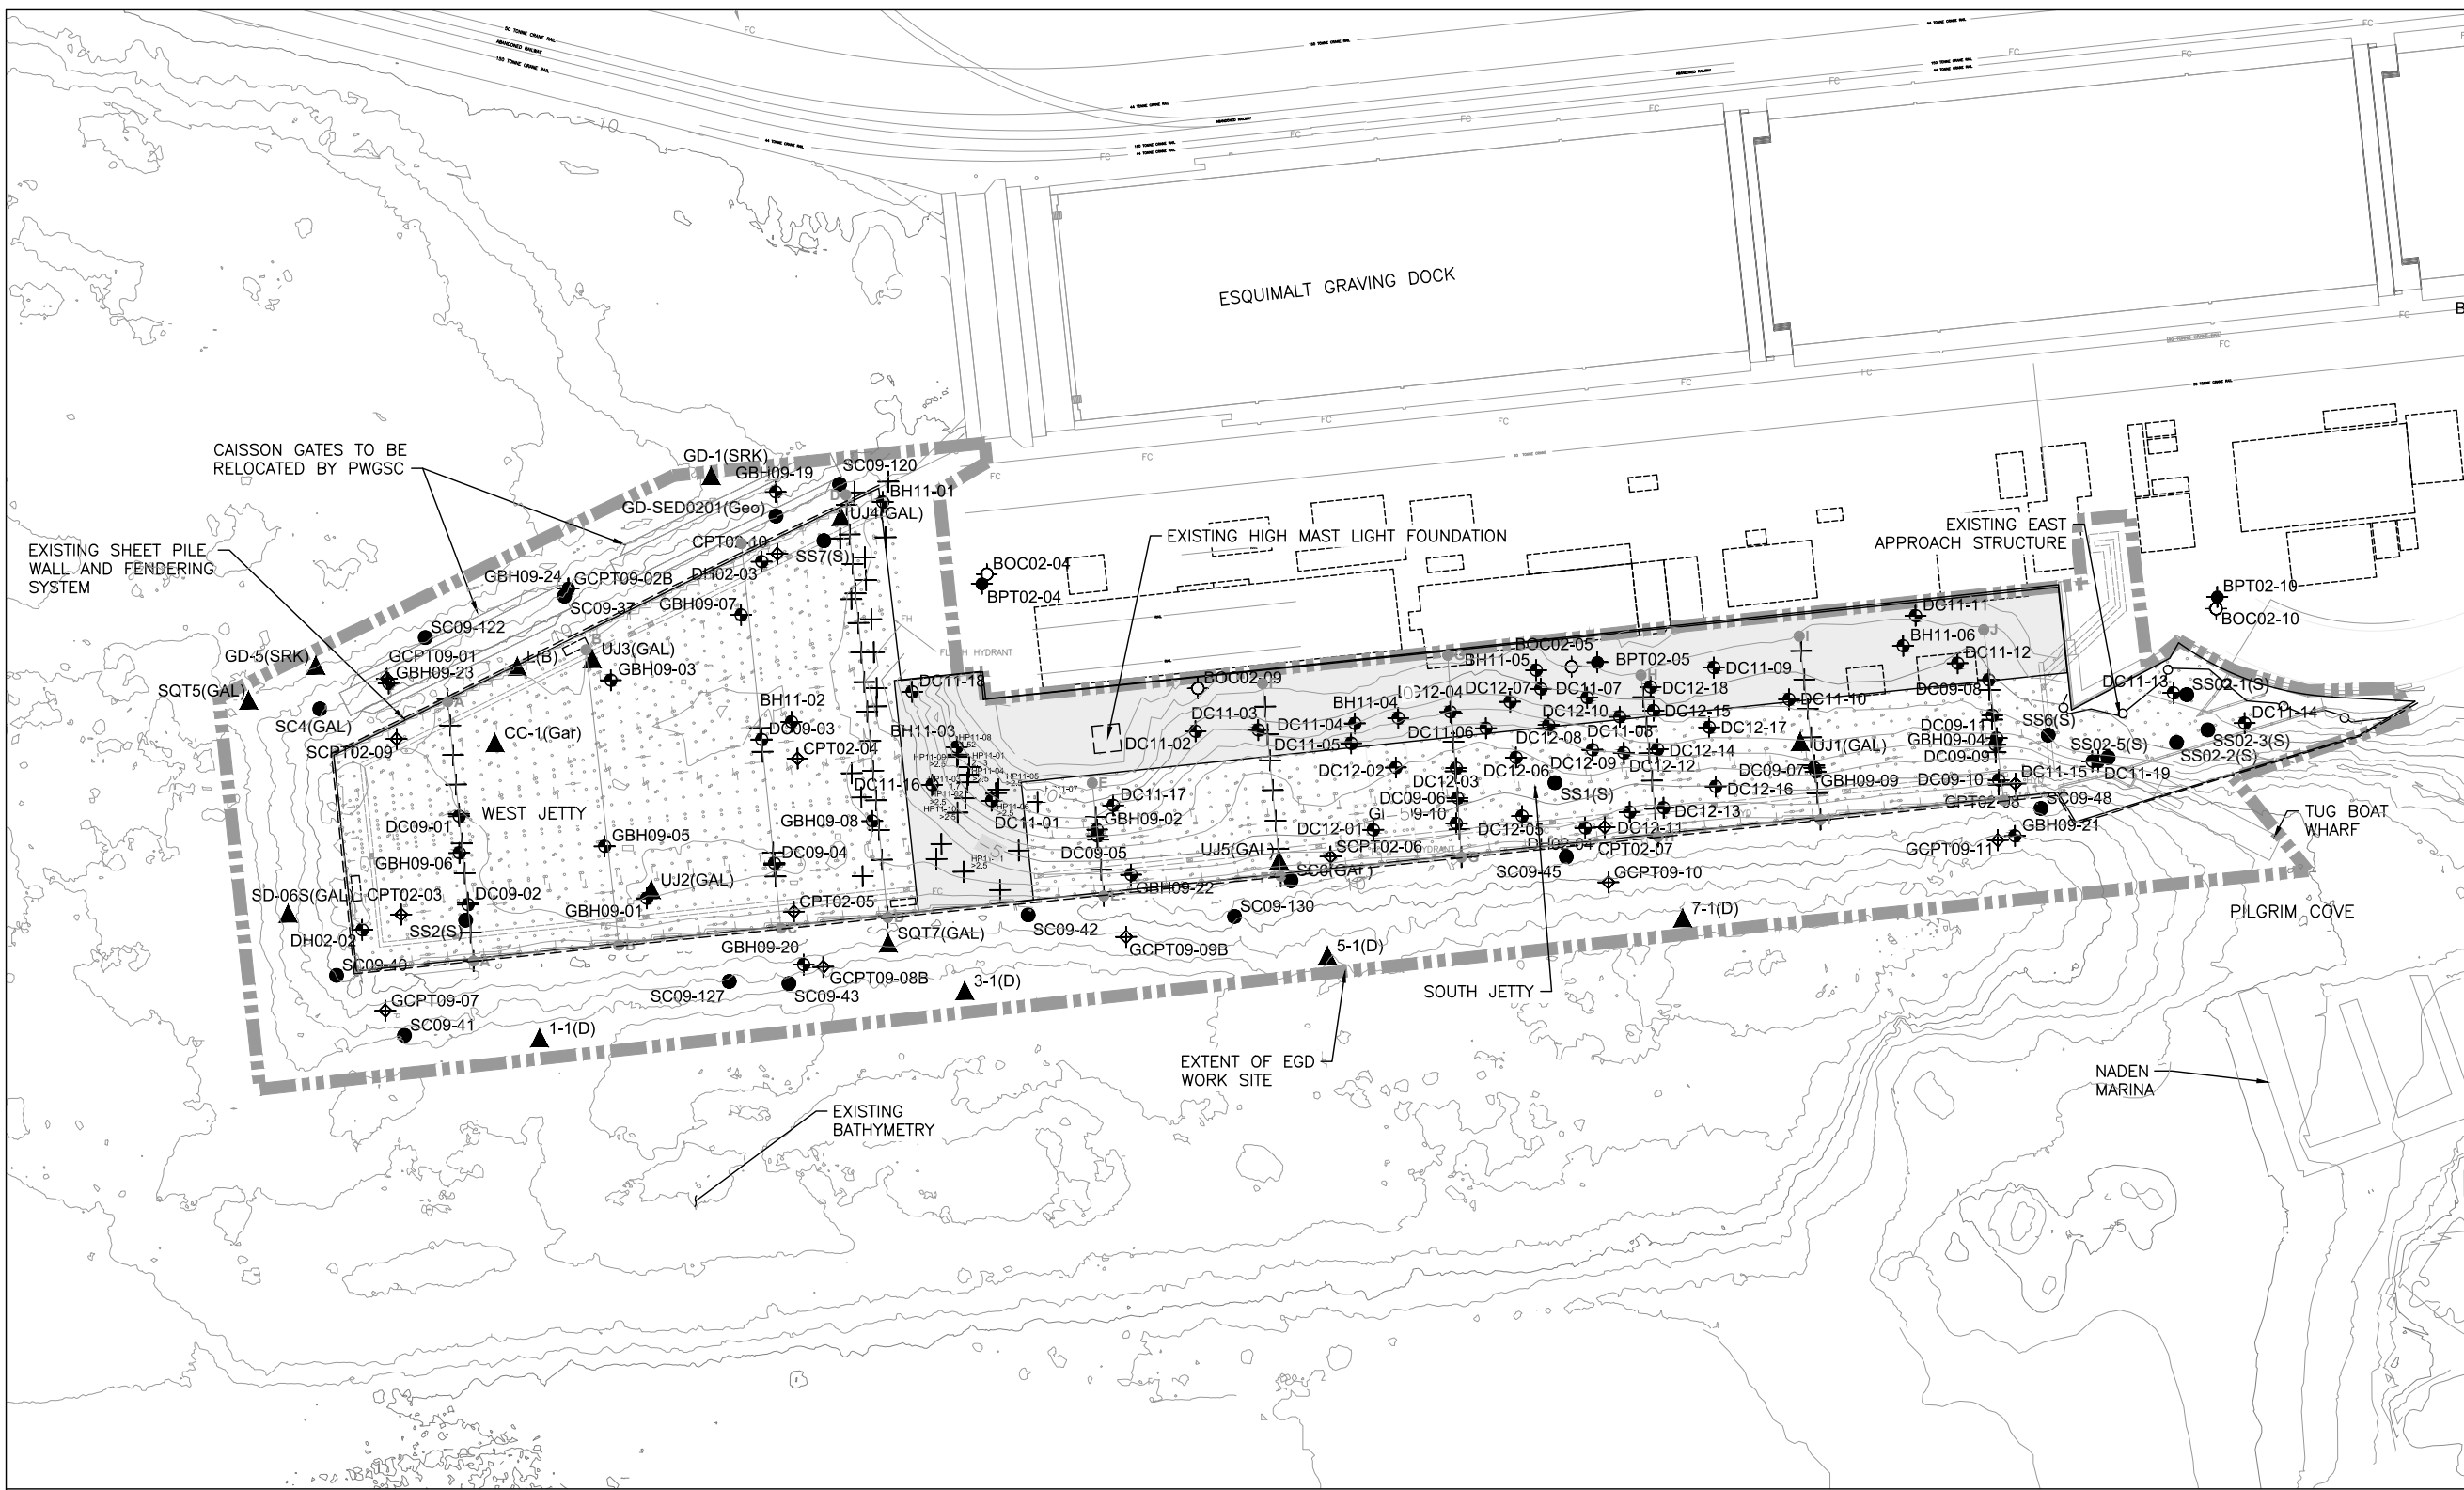

Revision/Revision	Description/Description	Date/Date
2	RECORD DRAWING	2017/03/31
1	ADDENDUM NO. 2	2015/03/20
0	ISSUED FOR TENDER	2014/12/10

Client/client
PUBLIC WORKS AND GOVERNMENT SERVICES CANADA

Project title/Titre du projet
**ESQUIMALT GRAVING DOCK
 825 ADMIRALS ROAD, VICTORIA, BC**

**ESQUIMALT GRAVING DOCK
 WATERLOT PHASE 2
 SOUTH JETTY UNDER-PIER
 SEDIMENT REMEDIATION**

Consultant Signature Only
 Designed by/Concept par
MATT WOLTMAN
 Drawn by/Dessiné par
CHRIS HEWETT
 PWSC Project Manager/Administrateur de Projets TPSGC
ANDREW MYLLY
 Regional Manager, Environmental Services
COLLIN KINGMAN

Drawing title/Titre du dessin
**EXISTING CONDITIONS AND
 GEOTECHNICAL INFORMATION**

Project No./No. du projet
R.018400.002

Sheet/
C4

Revision no./
2


HORIZONTAL DATUM: UTM ZONE 10 GRID, NAD83.
 VERTICAL DATUM: CHART DATUM (C.D.)

NOTES:

- UNDERPIER AREA LOWER INTERTIDAL AND SUBTIDAL BATHYMETRY WITHIN THE TEMPORARY RE-SUSPENSION BARRIER CONTAINMENT AREA IS FROM FEBRUARY 2009, JUNE 2010 AND JANUARY 2011 CRA CANADA SURVEYS LTD. MULTI BEAM SURVEY. UPPER INTERTIDAL ELEVATIONS FROM SEPTEMBER 2009 AND JULY 2011 SURVEY BY FOCUS CORPORATION. OPEN WATER AREAS OUTSIDE OF THE TEMPORARY RE-SUSPENSION BARRIER CONTAINMENT AREA WERE DREDGED AS PART OF THE PHASE 1B OPEN-WATER REMEDIATION PROJECT. OPEN WATER BATHYMETRY SURVEY WAS CONDUCTED BY CRA CANADA SURVEYS INC. ON 2014/03/05 FOLLOWING COMPLETION OF PHASE 1B WORK.
- BASE MAP FROM GOLDER, JANUARY 2012.
- REFERENCE DWG C1 FOR DATUM INFORMATION.
- SHEETPILE EXTENDS AROUND THE PERIMETER OF THE SOUTH JETTY (SEE SHEET PILE CONTRACT DRAWINGS ATTACHMENT IN THE APPENDIX).
- CONTRACTOR TO CONFIRM LOCATIONS OF FIRE SPRINKLER OPENINGS AND CATWALK ACCESS HATCHES (SHOWN ON DWG S1) AND MAINTAIN ACCESS AT ALL TIMES.
- EGD WORK SITE ALSO INCLUDES UPLAND AREAS OF THE EGD FACILITY AS SHOWN ON THE DRAWINGS AND DESCRIBED IN THE SPECIFICATIONS.
- SEDIMENT CORE DATA FROM THE DETAILED SITE INVESTIGATION (GOLDER, FEBRUARY 2012), DATA REPORT LOCATED IN THE APPENDICES TO THE SPECIFICATIONS. GEOTECHNICAL INFORMATION IS AVAILABLE IN THE APPENDICES TO THE SPECIFICATIONS.
- TUG BOAT WHARF LOCATION AND DIMENSIONS SURVEYED BY CRA CANADA SURVEYS INC. ON 2013/11/13. TUG BOAT WHARF TO BE RELOCATED ACCORDING TO THE SPECIFICATIONS.

PLAN


SCALE 1: 600

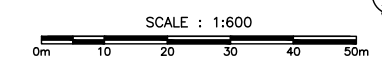


LEGEND:

- 14.0 — PRE-CONSTRUCTION BATHYMETRY IN METERS
- - - - - TEMPORARY RE-SUSPENSION BARRIER CONTAINMENT AREA
- ■ ■ ■ ■ EXTENT OF EGD WORK SITE
- ▲ ● ○ ● ▲ DIVER TRANSECTS
- + GOLDER 2009/2010 PUSH PROBE
- ● ● ● ● 2009/2010/2011/2012 GOLDER AND HISTORICAL SEDIMENT CORE LOCATIONS AND DESIGNATIONS
- ▲ ● ● ● ● HISTORICAL SEDIMENT GRAB SAMPLE LOCATIONS
- ▬ ▬ ▬ ▬ ▬ TIMBER PILED JETTY
- ▬ ▬ ▬ ▬ ▬ CONCRETE DECK WITH STEEL PILING
- ○ — ORDINARY HIGH WATER LINE
- ▬ ▬ ▬ ▬ ▬ EXISTING STRUCTURE

- EXPLORATION LOCATIONS**
- ▲ DIVER CORE (GOLDER)
 - BOREHOLE (GOLDER)
 - SEDIMENT CORE (GOLDER)
 - SONIC BOREHOLE (GOLDER)
 - + JET PROBE (GOLDER)
 - HISTORICAL SEDIMENT CORE
 - HISTORICAL SEDIMENT GRAB SAMPLE
 - ADDITIONAL SAMPLING (KLOHN CRIPPEN BERGER)

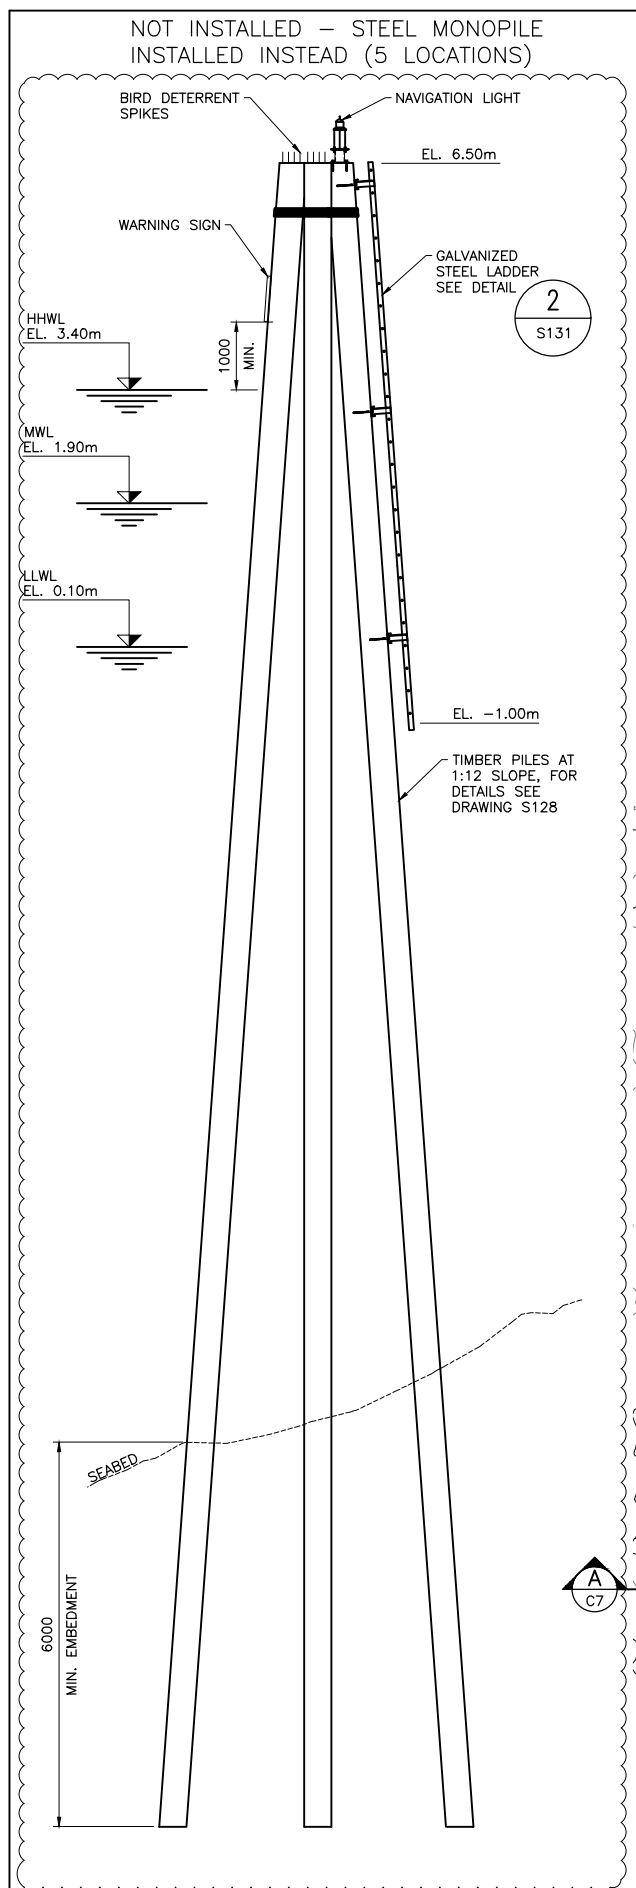

SECTION B
SCALE 1:200

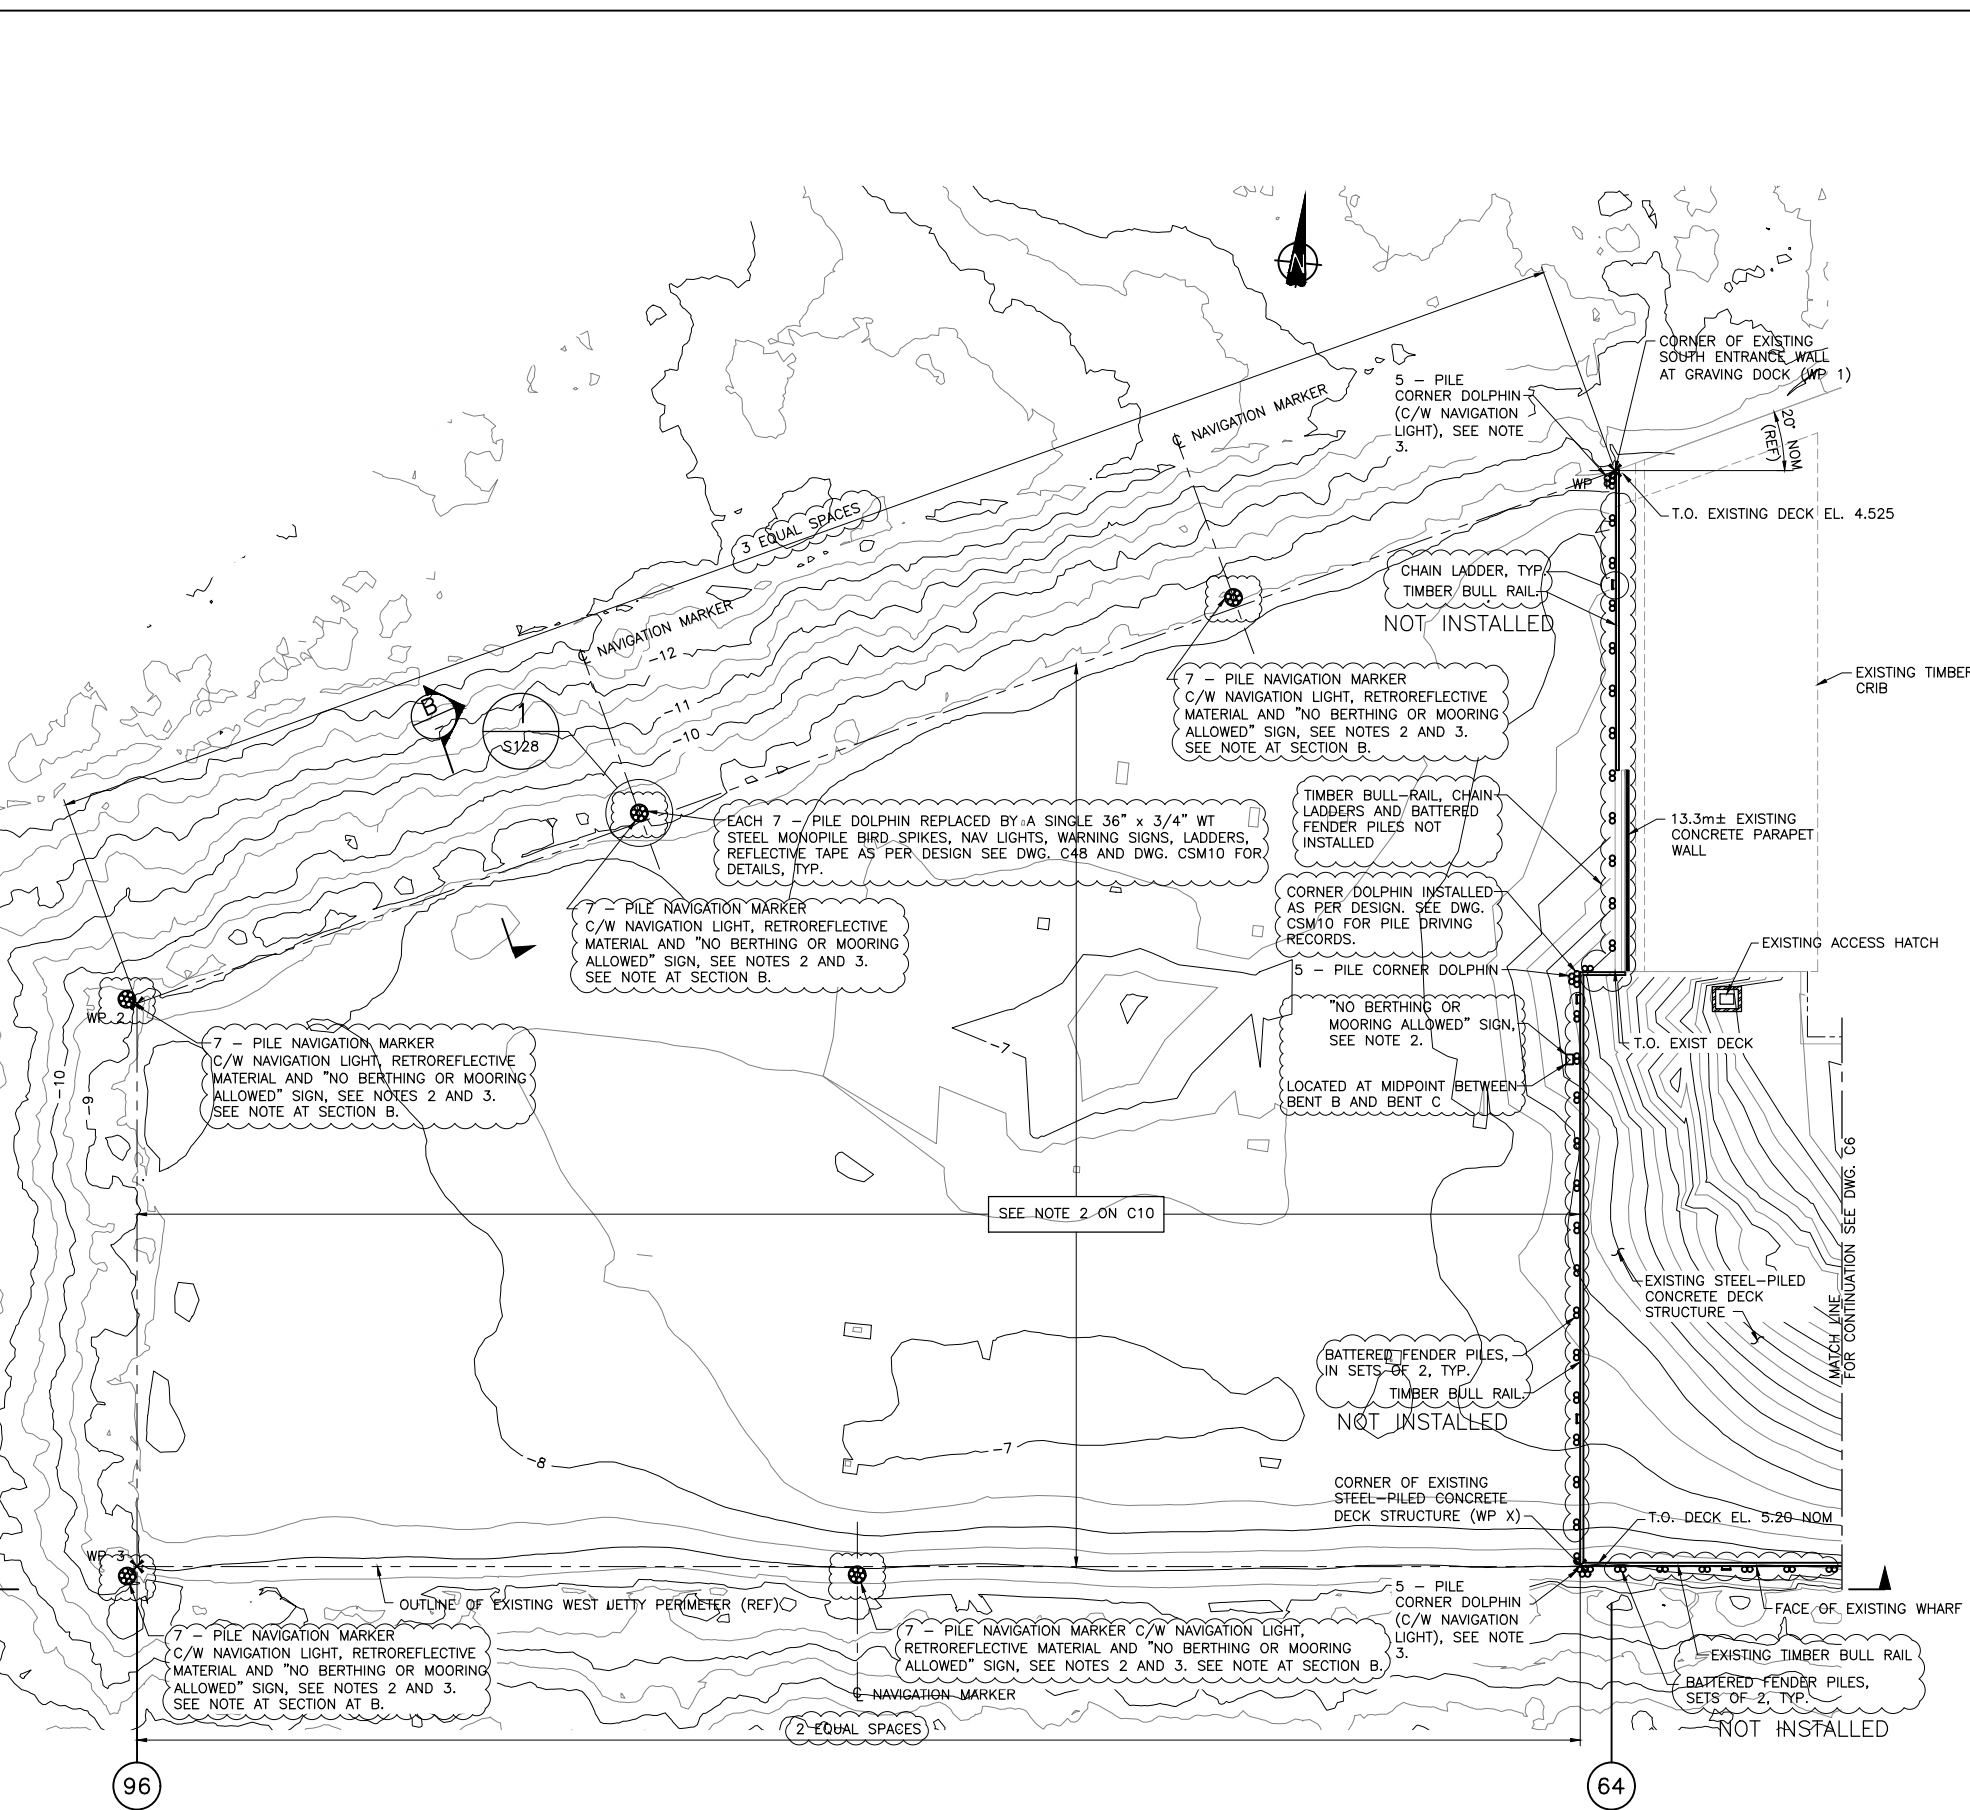

PLAN - WEST JETTY
1:250

- NOTES:**
- FOR EXISTING CONDITIONS SEE DRAWINGS D1 AND D2.
 - WARNING SIGN SHALL BE SECURED TO FENDER PILES, NAVIGATION MARKER PILES OR FACE OF WHARF FACE APPROXIMATELY 1.0m ABOVE HIGH TIDE ELEVATION. SIGN SHALL BE MIN. 900mm WIDE x 600mm HIGH DURABLE MATERIAL AND SHALL STATE THE FOLLOWING IN BLACK FONT ON WHITE BACKGROUND: "NO BERTHING OR MOORING ALLOWED" "L'USAGE DE CE POSTE D'AMARRAGE EST INTERDIT". FONT TYPE AND SIZE SHALL BE AS APPROVED BY DEPARTMENTAL REPRESENTATIVE.
 - NAVIGATION LIGHTS SHALL BE SOLAR-POWERED MARINE LANTERNS WITH YELLOW FLASHING LIGHT OF FLASHING CHARACTER FL4s (FL0.5s Ec3.5s), AND WITH A MINIMUM VISUAL RANGE OF 3.0 NAUTICAL MILES (INTENTIONALLY SET HIGHER THAN CANADIAN COAST GUARD'S MINIMUM REQUIREMENT OF 2.0 NAUTICAL MILES TO ENSURE PERFORMANCE). NAVIGATION LIGHTS SHALL HAVE A MINIMUM BATTERY CHARGE LIFE OF 14 HOURS IN TOTAL DARKNESS AND A MINIMUM BATTERY REPLACEMENT LIFE OF 5 YEARS. SEE SPECIFICATIONS.

WORK POINTS			
WP 1	N 5364863.011	E 468380.921	
WP 2	N 5364817.446	E 468287.389	
WP 3	N 5364780.766	E 468291.229	
WP X	N 5364790.751	E 468386.166	

REVISED COORDINATES

Revision/	Description/Description	Date/Date
2	RECORD DRAWING	2017/03/29
1	ADDENDUM NO. 2	2015/03/31
0	ISSUED FOR TENDER	2014/12/19

Client/client
PUBLIC WORKS AND GOVERNMENT SERVICES CANADA

Project title/Titre du projet
ESQUIMALT GRAVING DOCK
 825 ADMIRALS ROAD, VICTORIA, BC

ESQUIMALT GRAVING DOCK WATERLOT PHASE 2 SOUTH JETTY UNDER-PIER SEDIMENT REMEDIATION

Consultant Signature Only

Designed by/Concept par
 GEOFF COOPER


Drawn by/Desainé par
 ARNIE RIST


PWGC Project Manager/Administrateur de Projets TPSGC
 ANDREW MYLLY

Regional Manager, Environmental Services
 COLLIN KINGMAN

Drawing title/Titre du dessin
WEST JETTY GENERAL ARRANGEMENT PLAN

Project No./No. du projet R.018400.002	Sheet/ C5	Revision no./ 2
--------------------------------------------------	---------------------	---------------------------

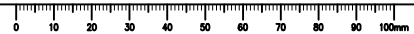


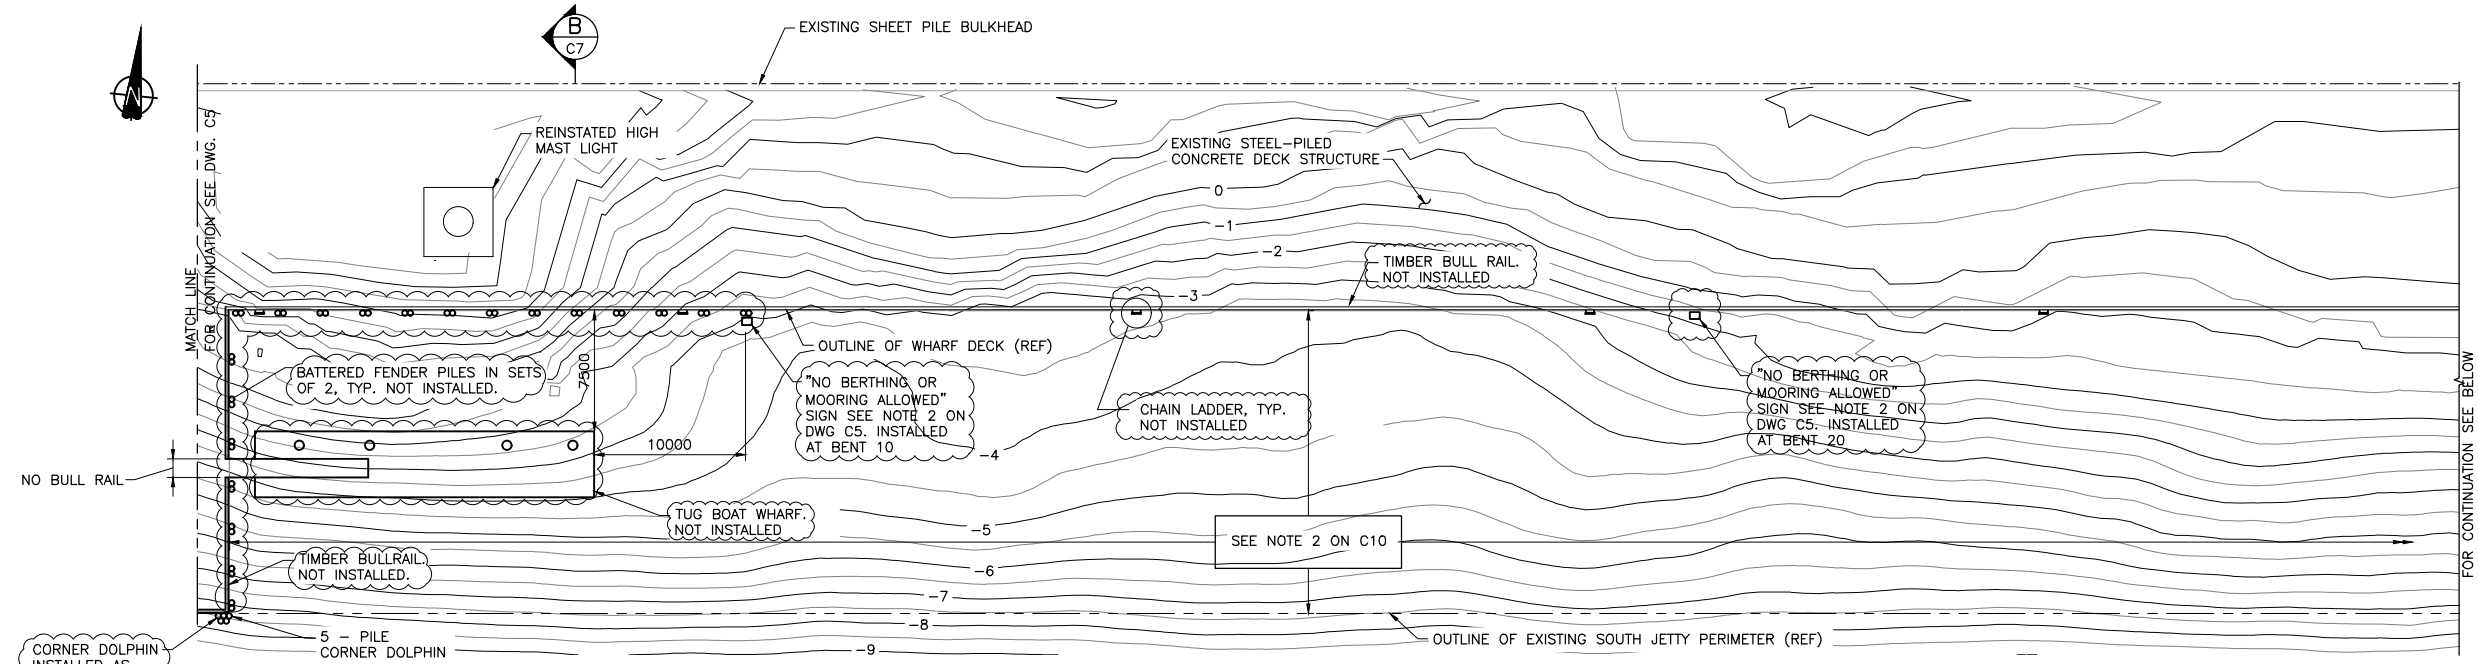

PARTIAL PLAN - SOUTH JETTY
1:250

58

12

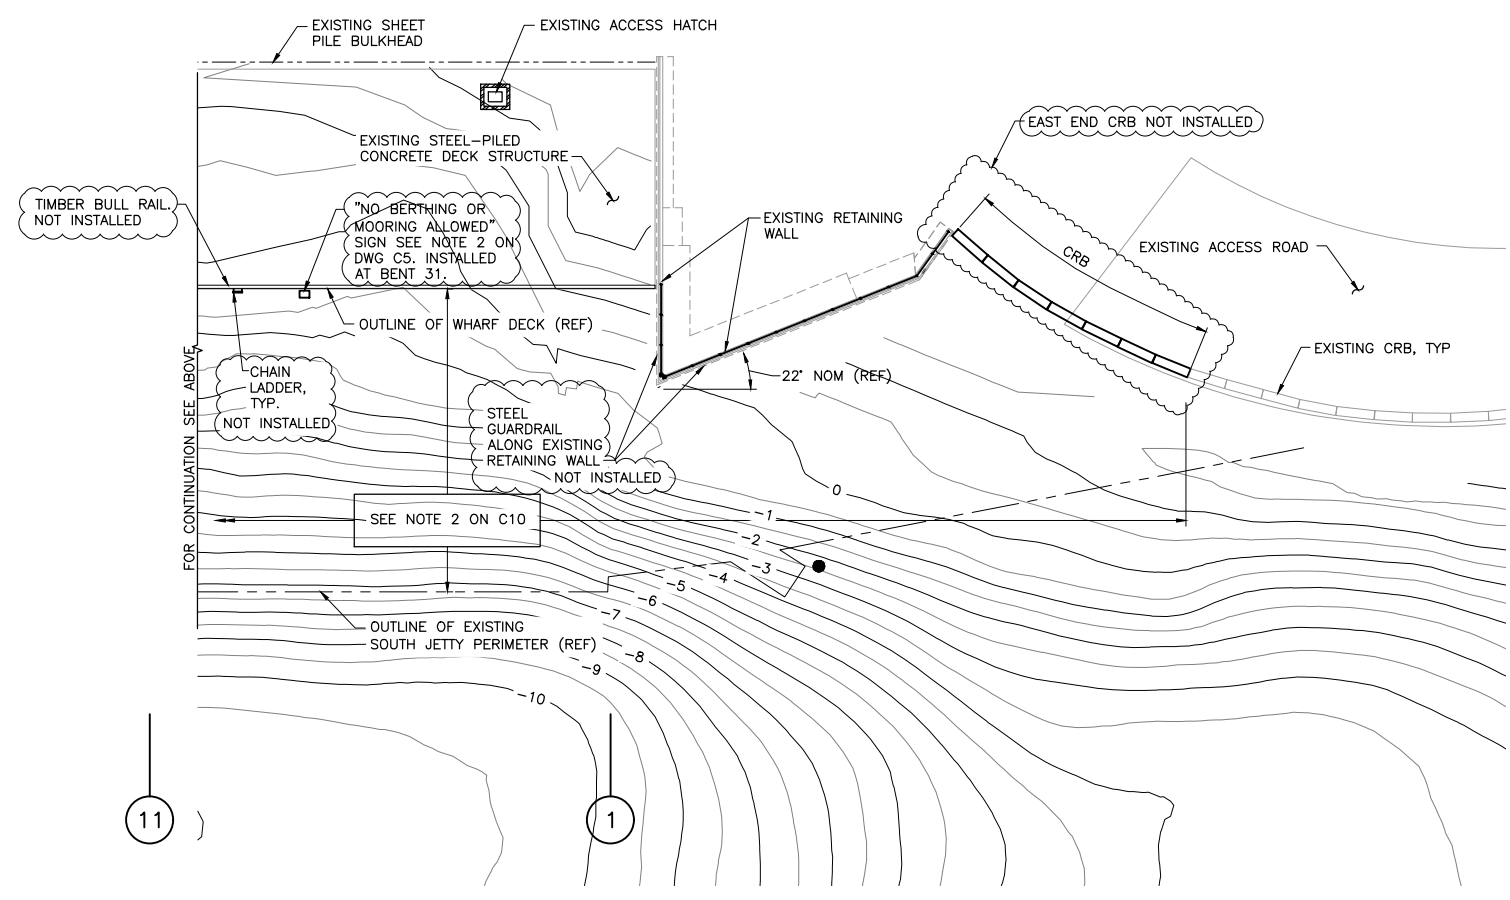

PARTIAL PLAN - SOUTH JETTY
1:250

11

1

NOTES:

- FOR EXISTING CONDITIONS SEE DRAWINGS D1 AND D2.

Revision/Revision	Description/Description	Date/Date
2	RECORD DRAWING	2017/03/29
1	ADDENDUM NO. 2	2015/03/20
0	ISSUED FOR TENDER	2014/12/19

Client/client
PUBLIC WORKS AND GOVERNMENT SERVICES CANADA

Project title/Titre du projet
**ESQUIMALT GRAVING DOCK
825 ADMIRALS ROAD, VICTORIA, BC**

**ESQUIMALT GRAVING DOCK
WATERLOT PHASE 2
SOUTH JETTY UNDER-PIER
SEDIMENT REMEDIATION**

Consultant Signature Only

Designed by/Concept par
GEOFF COOPER


Drawn by/Desainé par
ARNIE RIST


PWGC Project Manager/Administrateur de Projets TPSGC
ANDREW MYLLY

Regional Manager, Environmental Services
COLLIN KINGMAN


Drawing title/Titre du dessin
**SOUTH JETTY
GENERAL ARRANGEMENT
PLAN**

Project No./No. du projet R.018400.002	Sheet/ C6	Revision no./ 2
--------------------------------------------------	---------------------	---------------------------

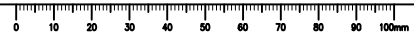

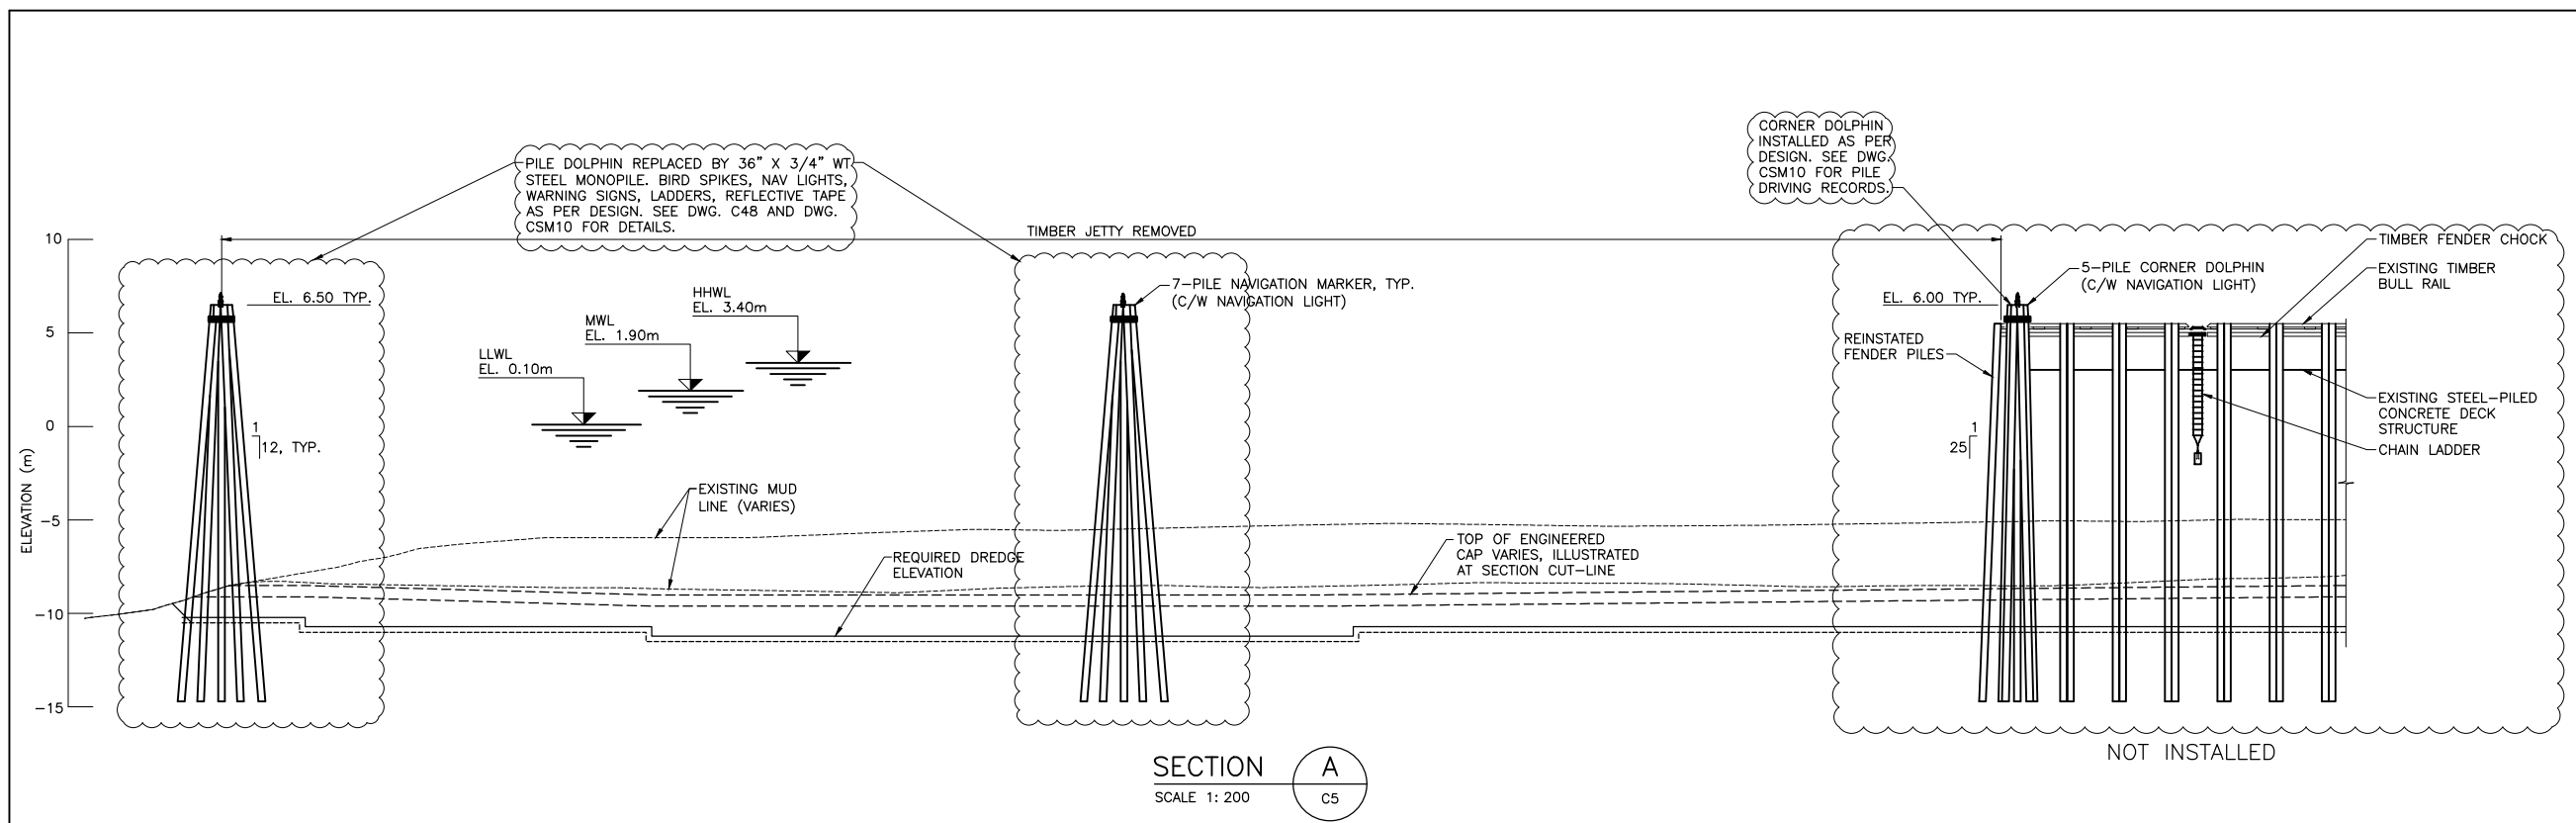

SECTION A
SCALE 1: 200

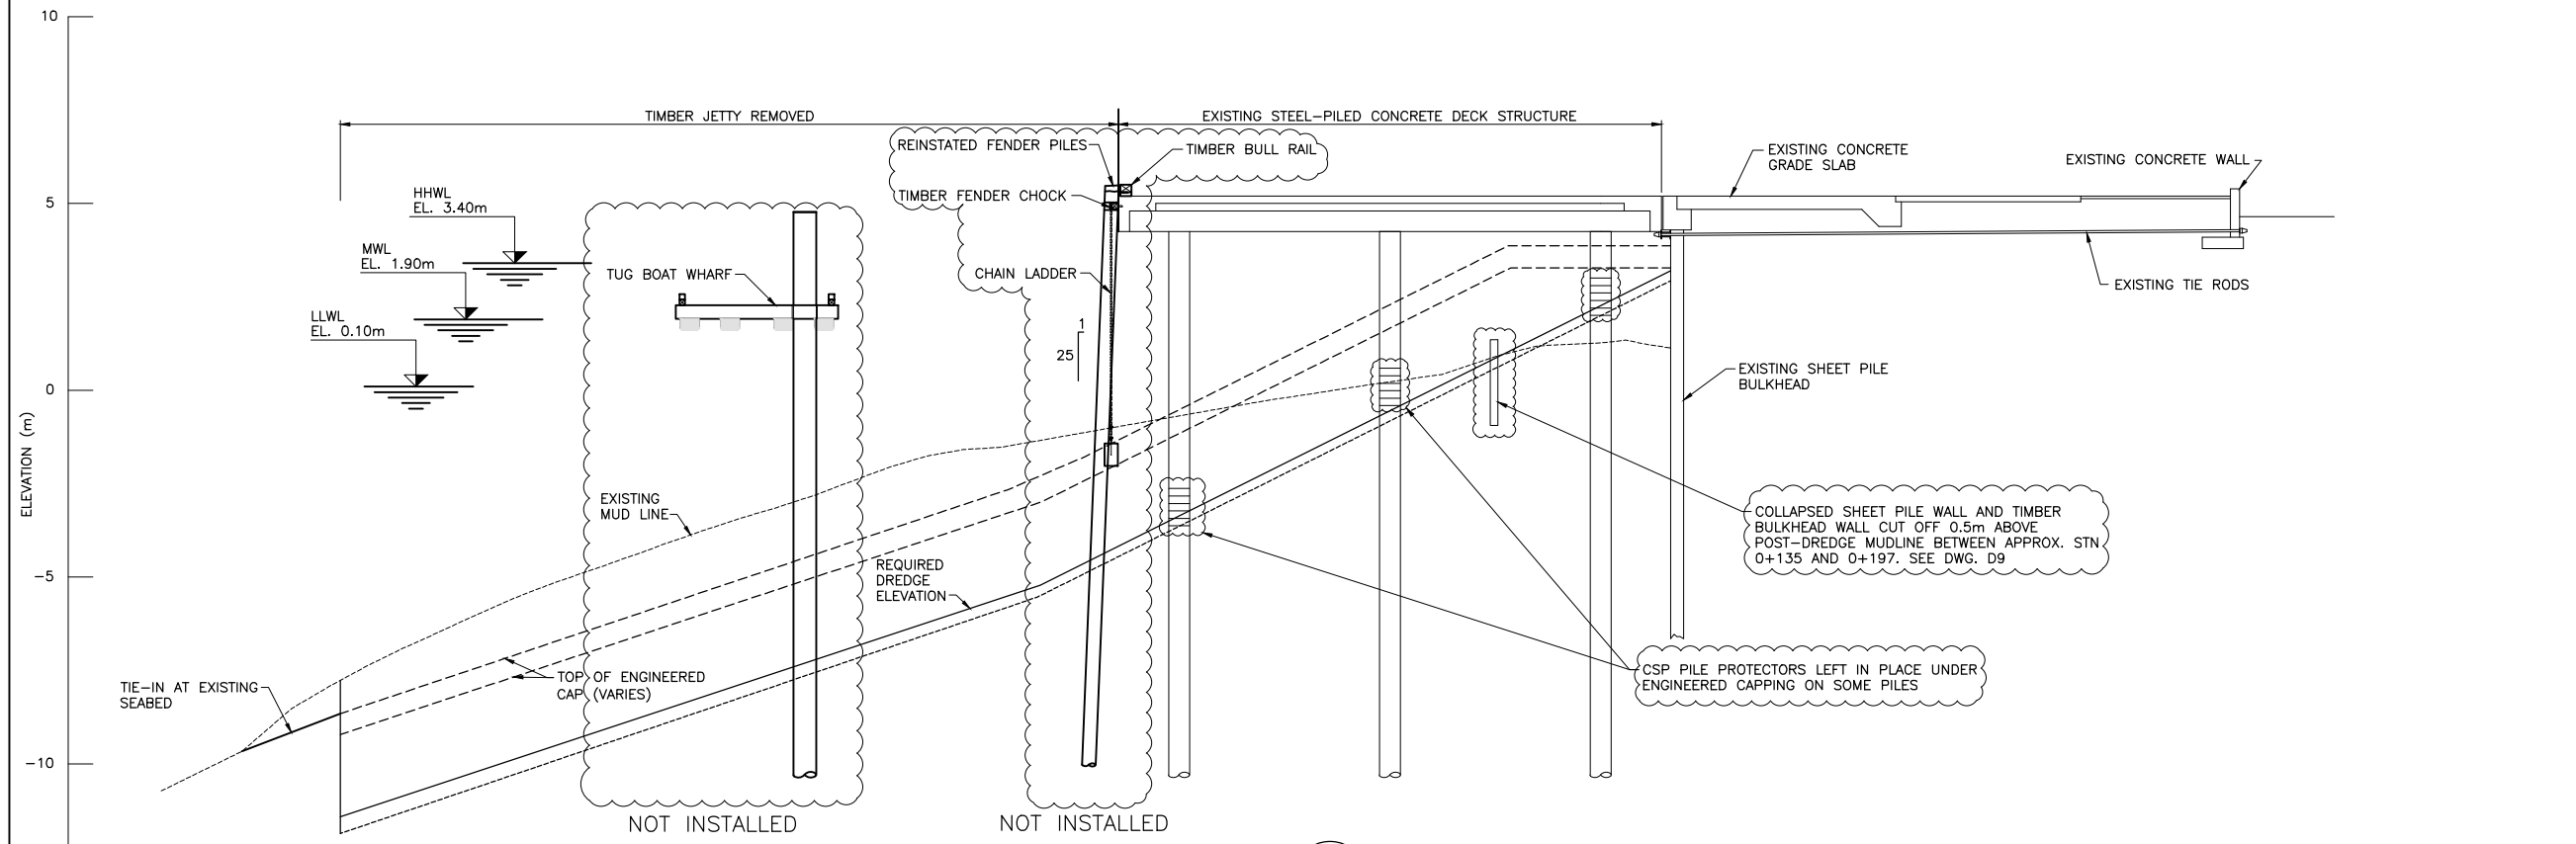

SECTION B
SCALE 1: 100

Revision/Revision	Description/Description	Date/Date
2	RECORD DRAWING	2017/03/29
1	ADDENDUM NO. 2	2015/03/31
0	ISSUED FOR TENDER	2014/12/19

Client/client
PUBLIC WORKS AND GOVERNMENT SERVICES CANADA

Project title/Titre du projet
**ESQUIMALT GRAVING DOCK
825 ADMIRALS ROAD, VICTORIA, BC**

**ESQUIMALT GRAVING DOCK
WATERLOT PHASE 2
SOUTH JETTY UNDER-PIER
SEDIMENT REMEDIATION**

Consultant Signature Only

Designed by/Concept par
GEOFF COOPER


Drawn by/Desainé par
ARNIE RIST

PWGC Project Manager/Administrateur de Projets TPSGC
ANDREW MYLLY

Regional Manager, Environmental Services
COLLIN KINGMAN

Drawing title/Titre du dessin
**WEST AND SOUTH JETTY
GENERAL ARRANGEMENT
SECTIONS**

Project No./No. du projet R.018400.002	Sheet/ C7	Revision no./ 2
--------------------------------------------------	---------------------	---------------------------

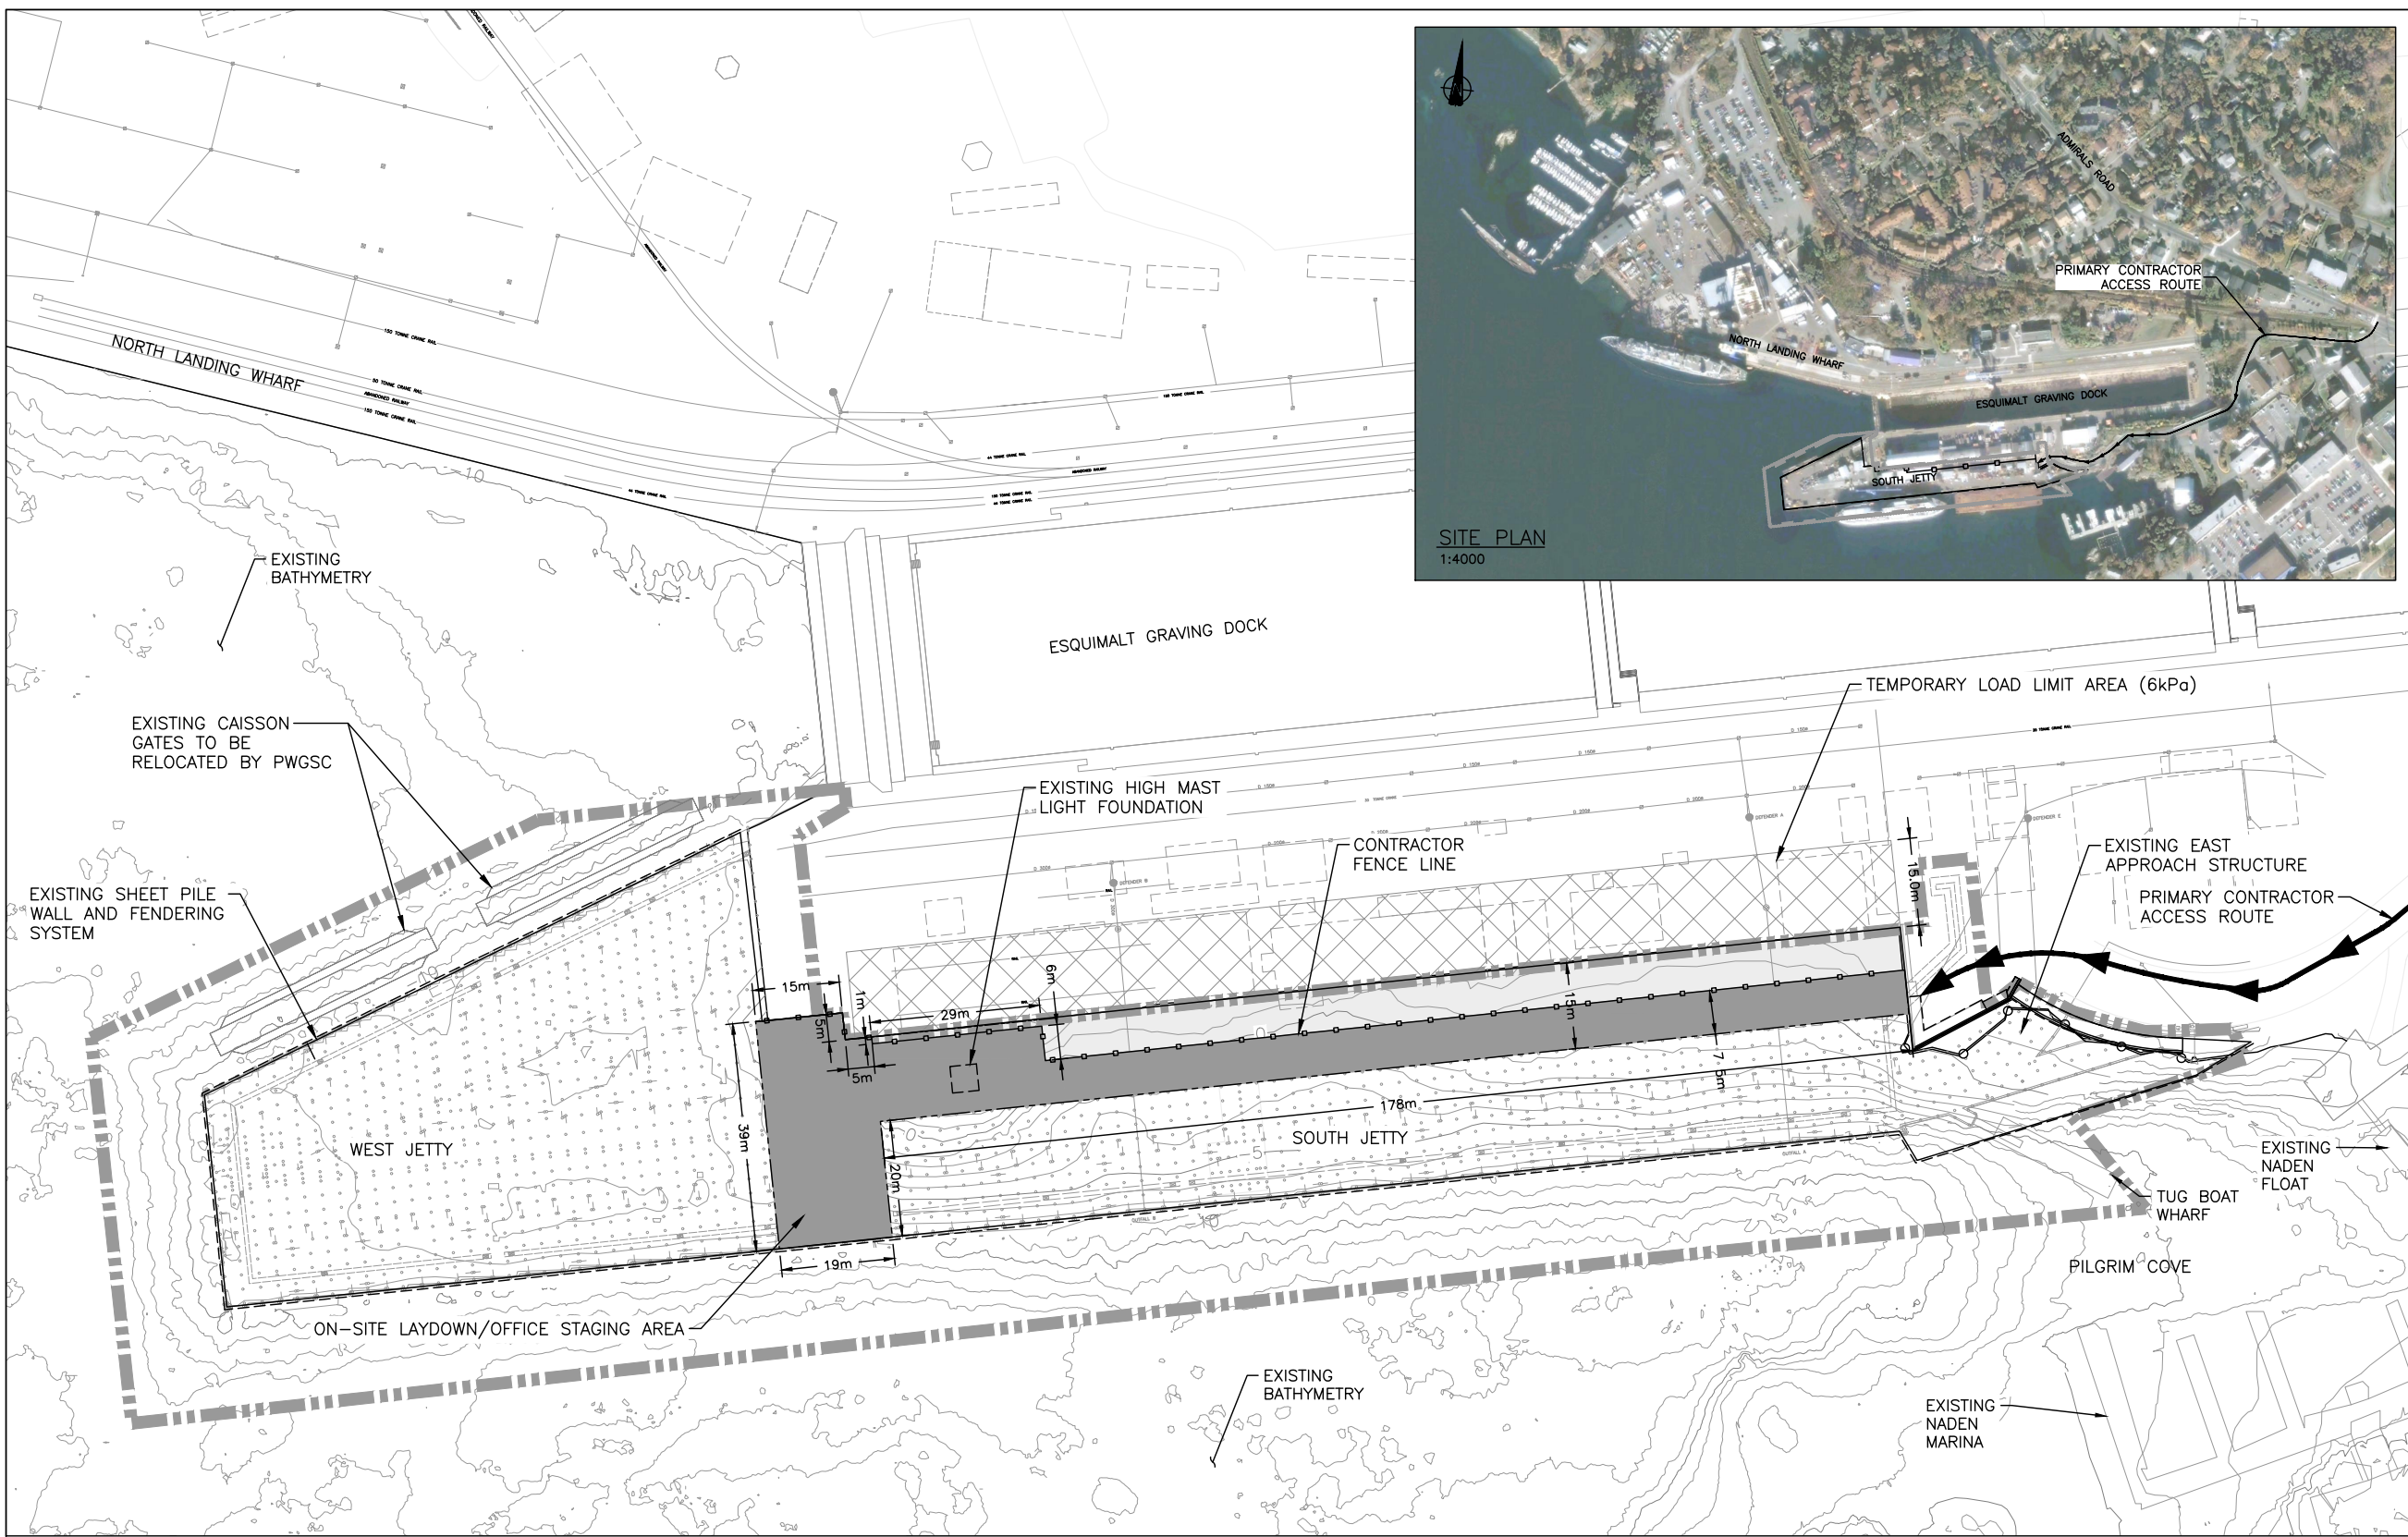

Revision/Revision	Description/Description	Date/Date
2	RECORD DRAWING	2017/03/31
1	ADDENDUM NO. 2	2016/03/20
0	ISSUED FOR TENDER	2014/12/10

Client/client
PUBLIC WORKS AND GOVERNMENT SERVICES CANADA

Project title/Titre du projet
**ESQUIMALT GRAVING DOCK
825 ADMIRALS ROAD, VICTORIA, BC**

**ESQUIMALT GRAVING DOCK
WATERLOT PHASE 2
SOUTH JETTY UNDER-PIER
SEDIMENT REMEDIATION**

Consultant Signature Only

Designed by/Concept par
MATT WOLTMAN
Drawn by/Dessiné par
CHRIS HEWETT
PWGSC Project Manager/Administrateur de Projets TPSCG
ANDREW MYLLY
Regional Manager, Environmental Services
COLLIN KINGMAN

Drawing title/Titre du dessin
**CONTRACTOR'S WORK AREA
AND SITE ACCESS**

Project No./No. du projet	Sheet/	Revision no./
R.018400.002	C8	2


HORIZONTAL DATUM: UTM ZONE 10 GRID, NAD83.
VERTICAL DATUM: CHART DATUM (C.D.)

NOTES:

- UNDERPIER AREA LOWER INTERTIDAL AND SUBTIDAL BATHYMETRY WITHIN THE TEMPORARY RE-SUSPENSION BARRIER CONTAINMENT AREA IS FROM FEBRUARY 2009, JUNE 2010 AND JANUARY 2011 CRA CANADA SURVEYS LTD. MULTI BEAM SURVEY. UPPER INTERTIDAL ELEVATIONS FROM SEPTEMBER 2009 AND JULY 2011 SURVEY BY FOCUS CORPORATION. OPEN WATER AREAS OUTSIDE OF THE TEMPORARY RE-SUSPENSION BARRIER CONTAINMENT AREA WERE DREDGED AS PART OF THE PHASE 1B OPEN-WATER REMEDIATION PROJECT. OPEN WATER BATHYMETRY SURVEY WAS CONDUCTED BY CRA CANADA SURVEYS INC. ON 2014/03/05 FOLLOWING COMPLETION OF PHASE 1B WORK.
- BASE MAP FROM GOLDER, JANUARY 2012.
- REFERENCE DWG C1 FOR DATUM INFORMATION.
- SHEET PILE EXTENDS AROUND THE PERIMETER OF SOUTH JETTY. SEE SHEET PILE CONTRACT DRAWINGS ATTACHMENT IN THE APPENDICES.
- CONTRACTOR TO CONFIRM LOCATIONS OF FIRE SPRINKLER OPENINGS AND CATWALK ACCESS HATCHES AND MAINTAIN ACCESS AT ALL TIMES.
- EGD WORK SITE ALSO INCLUDES UPLAND AREAS OF THE EGD FACILITY AS SHOWN ON THE DRAWINGS AND DESCRIBED IN THE SPECIFICATIONS.
- TUG BOAT WHARF LOCATION AND DIMENSIONS SURVEYED BY CRA CANADA SURVEYS ON 2013/11/13. TUG BOAT WHARF TO BE RELOCATED ACCORDING TO THE SPECIFICATIONS.
- ACCESS FROM WATER AS APPROVED BY QUEEN'S HARBOUR MASTER.
- CONTRACTOR SHALL PROVIDE A 12.2-METRE BY 6.1-METRE (APPROXIMATELY 74m²) AREA WITHIN THE CONTRACTOR STAGING AREA FOR THE DEPARTMENTAL REPRESENTATIVE'S CONSULTANT TEAM TRAILER AT THE REQUEST OF THE DEPARTMENTAL REPRESENTATIVE.
- CONTRACTOR SHALL NOT OBSTRUCT BUILDING ACCESS ADJACENT TO THE CONTRACTOR ON-SITE STAGING AREA.


PLAN

SCALE 1:600

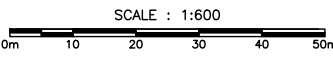


LEGEND:

- 14.0 — PRE-CONSTRUCTION BATHYMETRY IN METRES
- - - - TEMPORARY RE-SUSPENSION BARRIER CONTAINMENT AREA
- ■ ■ ■ EXTENT OF EGD WORK SITE
- ← PRIMARY CONTRACTOR ACCESS ROUTE
- ■ ■ ■ ON-SITE STAGING AREA (WITH CONCRETE DECK WITH STEEL PILING TO REMAIN, SEE NOTE 10)
- ▭ STEEL-PILED CONCRETE
- ▨ TIMBER PILING PRE-SOUTH JETTY DEMOLITION
- ⊗ ⊗ ⊗ ⊗ TEMPORARY LOAD LIMIT AREA
- ○ — ORDINARY HIGH WATER LINE
- □ — CONTRACTOR FENCE LINE

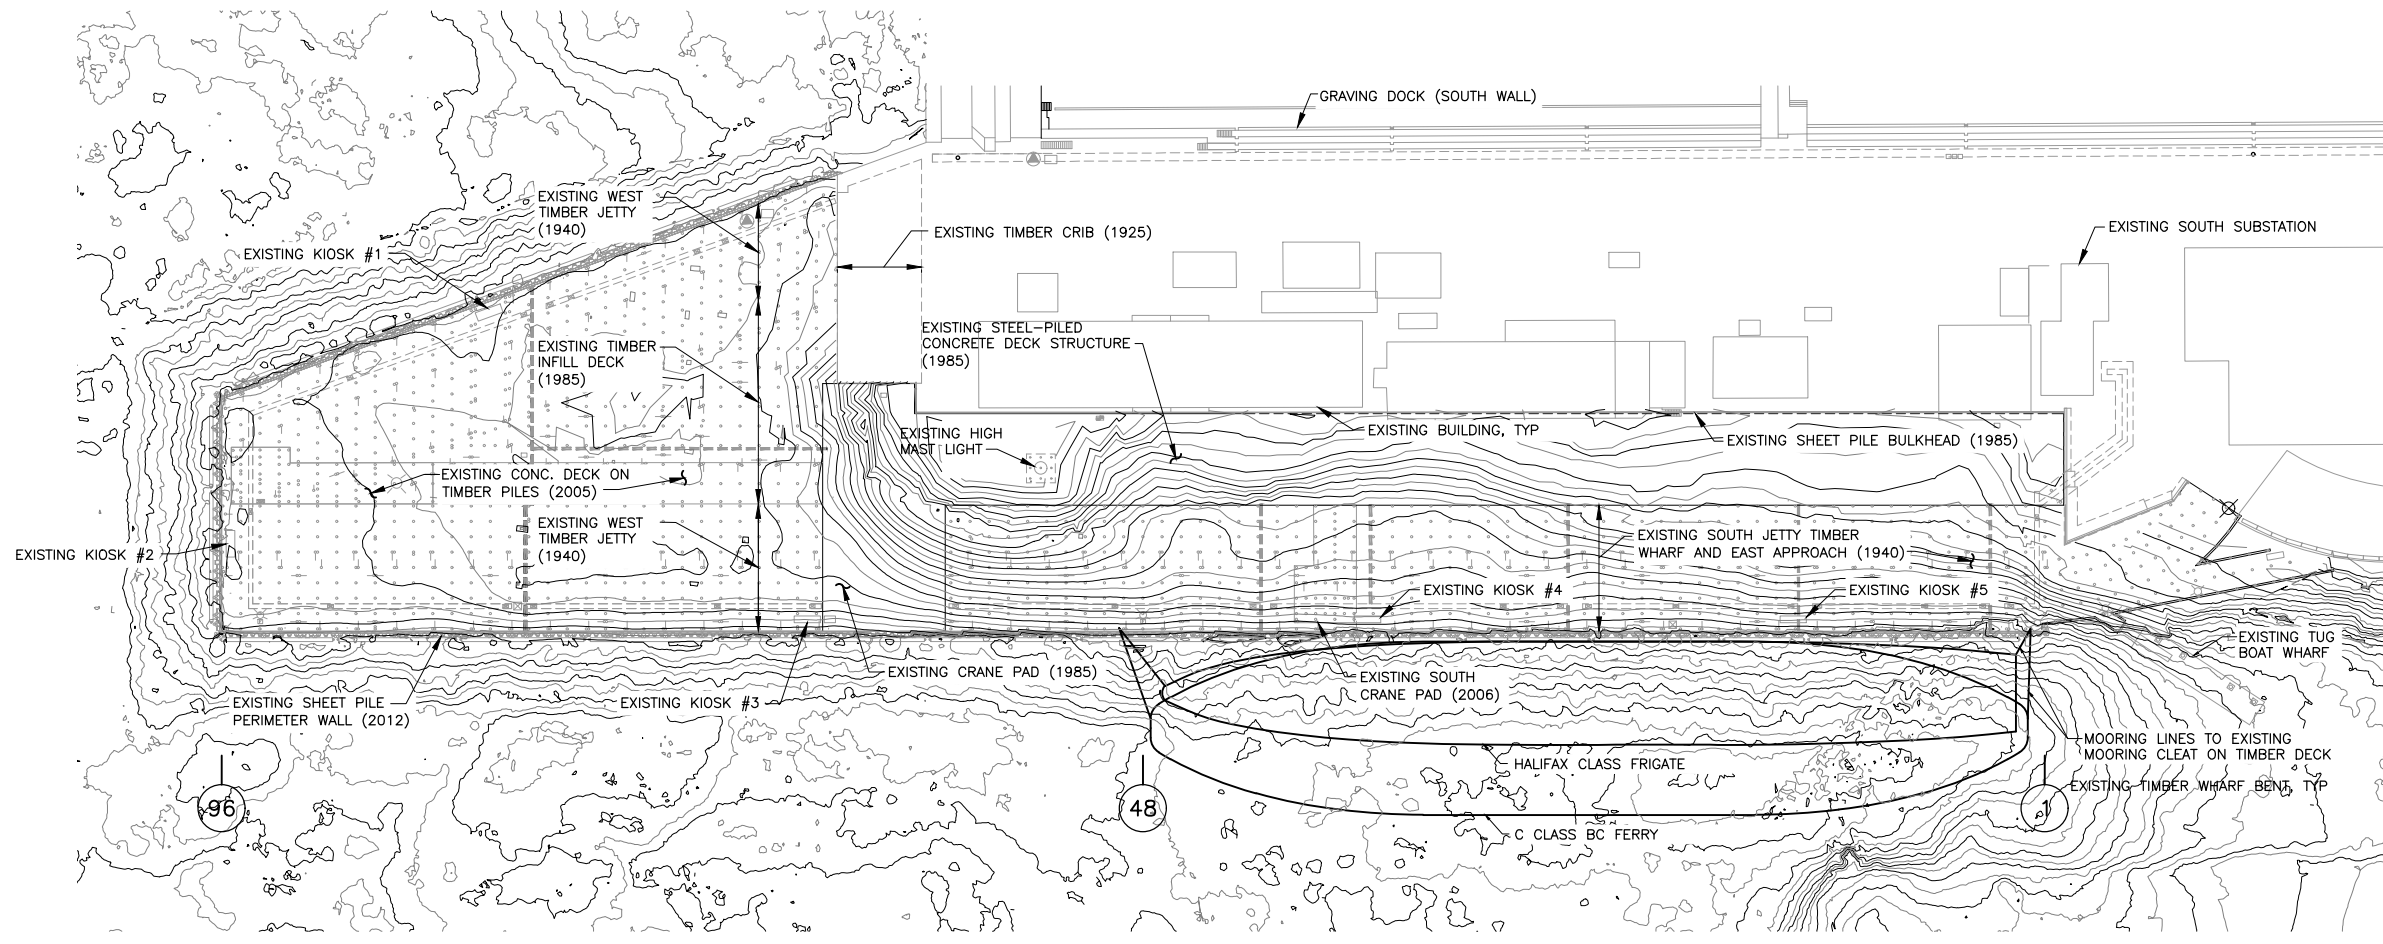

EXISTING SOUTH JETTY GENERAL LAYOUT
1:600

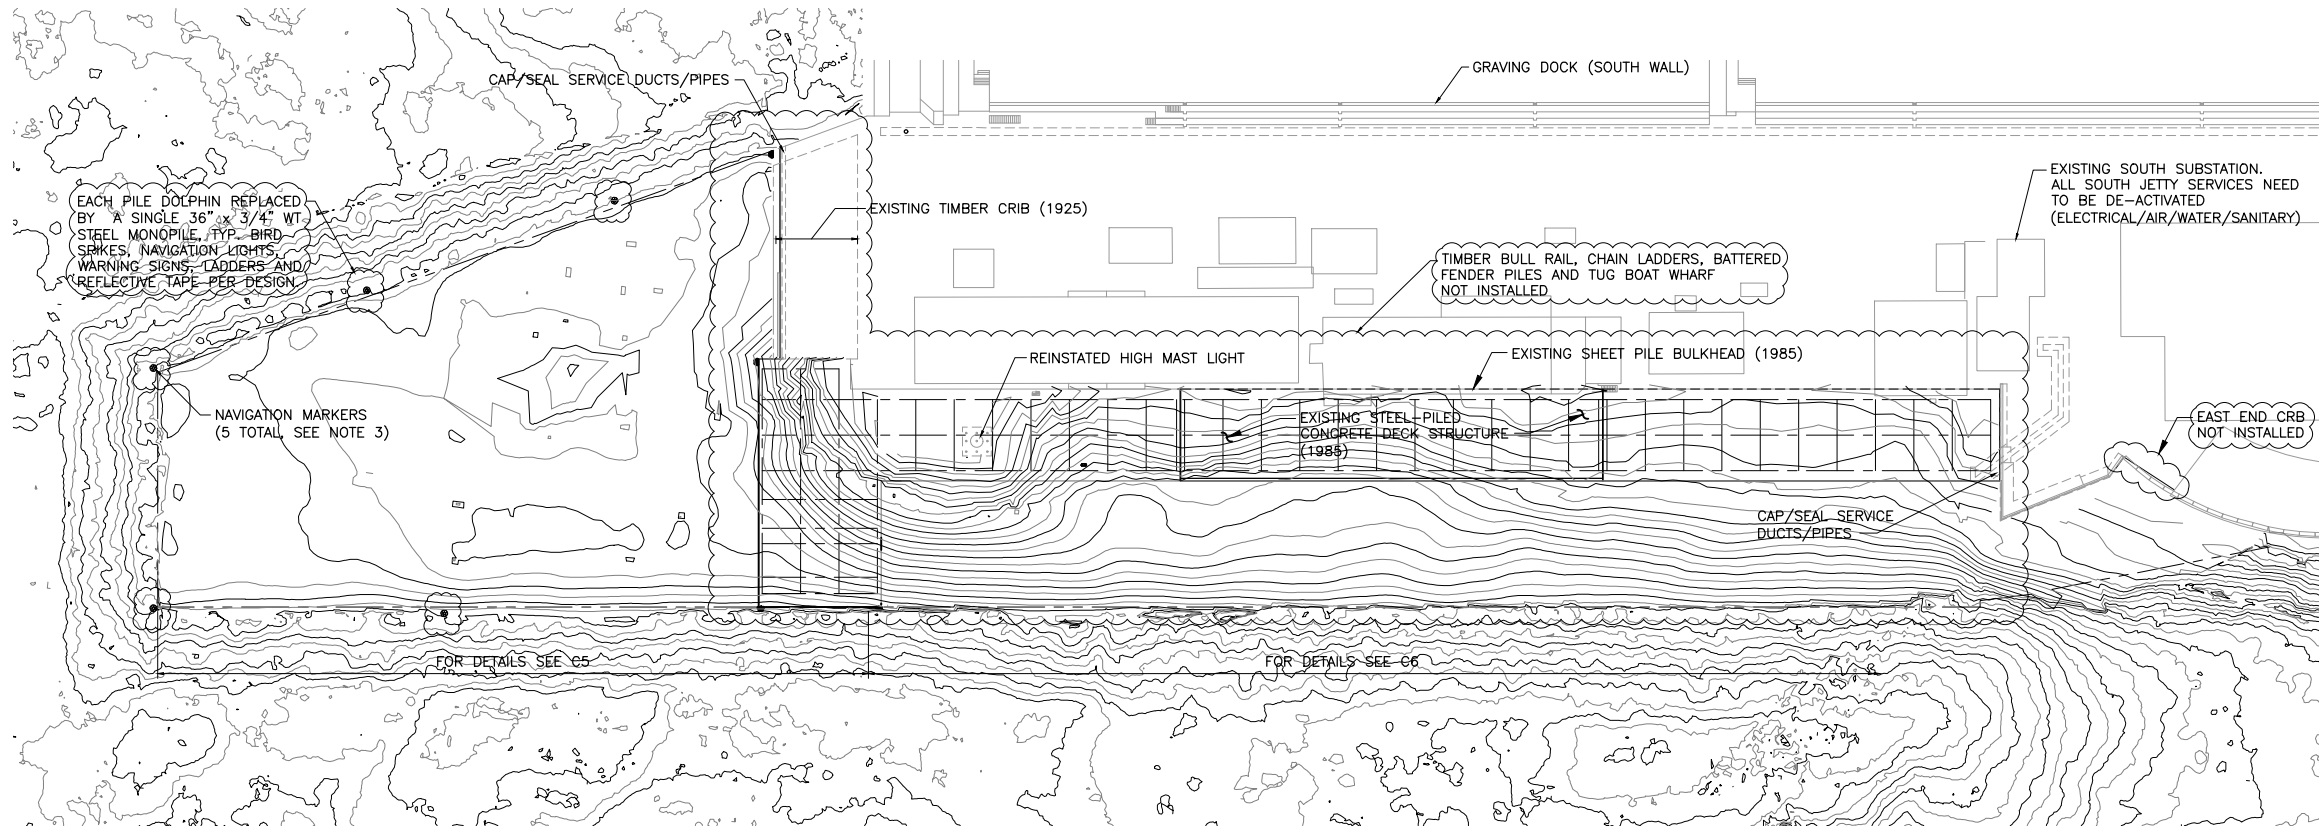

MODIFIED SOUTH JETTY GENERAL LAYOUT
1:600

NOTES:

1. VERTICAL DATUM: CHART DATUM.
2. THE BATHYMETRY SHOWN IS BASED ON EXISTING CONDITIONS. THE MODIFIED BATHYMETRY WITHIN THE EXISTING SOUTH JETTY FOOTPRINT FOLLOWING DREDGING AND CAPPING WILL GENERALLY BE AT OR BELOW THE BATHYMETRY ELEVATIONS SHOWN.
3. NAVIGATION MARKERS ARE INTENDED TO INDICATE THE NAVIGATION CHANNEL AND ARE NOT DESIGNED TO BE BERTHING OR TURNING DOLPHINS.



Revision/	Description/Description	Date/Date
2	RECORD DRAWING	2017/03/29
1	ADDENDUM NO. 2	2015/03/20
0	ISSUED FOR TENDER	2014/12/19

Client/client
PUBLIC WORKS AND GOVERNMENT SERVICES CANADA

Project title/Titre du projet
**ESQUIMALT GRAVING DOCK
825 ADMIRALS ROAD, VICTORIA, BC**

**ESQUIMALT GRAVING DOCK
WATERLOT PHASE 2
SOUTH JETTY UNDER-PIER
SEDIMENT REMEDIATION**

Consultant Signature Only
Designed by/Concept par
GEOFF COOPER
Drawn by/Desainé par
ARNIE RIST
PWSC Project Manager/Administrateur de Projets TPSGC
ANDREW MYLLY
Regional Manager, Environmental Services
COLLIN KINGMAN
Drawing title/Titre du dessin

**SOUTH JETTY EXISTING
AND MODIFIED PLANS**

Project No./No. du projet R.018400.002	Sheet/ C10	Revision no./ 2
--------------------------------------------------	----------------------	---------------------------

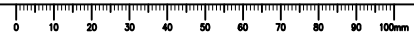




PHOTO C14-01 SOUTH JETTY SHEET PILE WALL - NOTE SMALL BOAT ACCESS OPENING



PHOTO C14-02 STEEL PILED CONCRETE DECK LOOKING EAST - NOTE TIMBER PILE REMNANTS AND LOWER SHEET PILING



PHOTO C14-03 STEEL PILED CONCRETE DECK LOOKING EAST - NOTE BATTER PILES AND TIMBER PILE REMNANTS



PHOTO C14-04 STEEL PILED CONCRETE DECK LOOKING WEST - NOTE CATHODIC PROTECTION CABLES AT SLAB SOFFIT



PHOTO C14-05 STEEL PILED CONCRETE DECK NEXT TO TIMBER PILED WEST JETTY - NOTE TIMBER FIRE STOP WALL AND CROSS-BRACING



PHOTO C14-06 PAINTED SHEET PILE BULKHEAD - NOTE CATHODIC PROTECTION AND REMNANTS OF LOWER SHEET PILING (TIDE APPROX. EL+1.0M)



PHOTO C14-07 REMNANTS OF LOWER SHEET PILING - NOTE SHEET PILED BULKHEAD IN BACKGROUND



PHOTO C14-08 STORMWATER OUTFALL AT SHEET PILE BULKHEAD



PHOTO C14-09 OPEN STEEL PIPE PILE UNDER STEEL PILED CONCRETE DECK - NOTE SAFETY RISK

Revision/Revision	Description/Description	Date/Date
1	RECORD DRAWING	2017/03/29
0	ISSUED FOR TENDER	2014/12/19

Client/client
PUBLIC WORKS AND GOVERNMENT SERVICES CANADA

Project title/Titre du projet
ESQUIMALT GRAVING DOCK
825 ADMIRALS ROAD, VICTORIA, BC

ESQUIMALT GRAVING DOCK WATERLOT PHASE 2 SOUTH JETTY UNDER-PIER SEDIMENT REMEDIATION

Consultant Signature Only

Designed by/Concept par
GEOFF COOPER

Drawn by/Desainé par
MIKE BRIDDEN

PWGSC Project Manager/Administrateur de Projets TPSGC
ANDREW MYLLY

Regional Manager, Environmental Services
COLLIN KINGMAN

Drawing title/Titre du dessin
PHOTOGRAPHS OF EXISTING CONDITIONS SHEET 1

Project No./No. du projet R.018400.002	Sheet/ C14	Revision no./ 1
-------------------------------------------	----------------------	---------------------------



PHOTO C15-01 TIMBER PILED JETTY AT EAST APPROACH – NOTE RIPRAP FORESHORE SLOPE



PHOTO C15-02 TIMBER PILED JETTY – TYPICAL VIEW AT EAST APPROACH JETTY LOOKING WEST

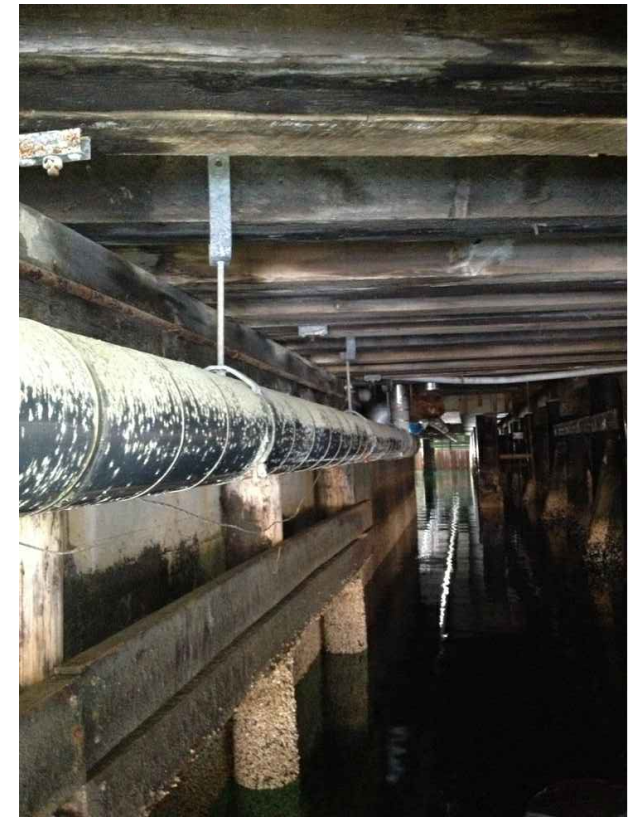


PHOTO C15-03 TIMBER PILED JETTY AT TIMBER CRIB LOOKING SOUTH – NOTE FENDERING AT FACE OF TIMBER CRIB



PHOTO C15-04 TIMBER PILED JETTY – TYPICAL VIEW LOOKING EAST (BEFORE SHEET PILE PERIMETER WALL WAS INSTALLED)



PHOTO C15-05 TIMBER PILED JETTY – VIEW AT EAST END FIRE STOP WALL AND CATWALK (BEFORE SHEET PILE PERIMETER WALL WAS INSTALLED)



PHOTO C15-08 TIMBER INFILL DECK CONSTRUCTION – NOTE CONDITION OF TIMBER AT THIS STRUCTURE



PHOTO C15-06 TIMBER PILED JETTY AT INTERFACE WITH STEEL PILED DECK— NOTE RIPRAP ON FORESHORE AND MISCELLANEOUS CONCRETE FOOTINGS



PHOTO C15-07 TIMBER PILED JETTY – TYPICAL VIEW UNDER WEST CRANE PAD

Revision/Revision	Description/Description	Date/Date
1	RECORD DRAWING	2017/03/29
0	ISSUED FOR TENDER	2014/12/19

Client/client
PUBLIC WORKS AND GOVERNMENT SERVICES CANADA

Project title/Titre du projet
ESQUIMALT GRAVING DOCK
825 ADMIRALS ROAD, VICTORIA, BC

ESQUIMALT GRAVING DOCK WATERLOT PHASE 2 SOUTH JETTY UNDER-PIER SEDIMENT REMEDIATION

Consultant Signature Only

Designed by/Concept par
GEOFF COOPER

Drawn by/Desainé par
MIKE BRIDDEN

PWGC Project Manager/Administrateur de Projets TPSGC
ANDREW MYLLY

Regional Manager, Environmental Services
COLLIN KINGMAN

Drawing title/Titre du dessin
PHOTOGRAPHS OF EXISTING CONDITIONS SHEET 2

Project No./No. du projet R.018400.002	Sheet/ C15	Revision no./ 1
-------------------------------------------	----------------------	---------------------------

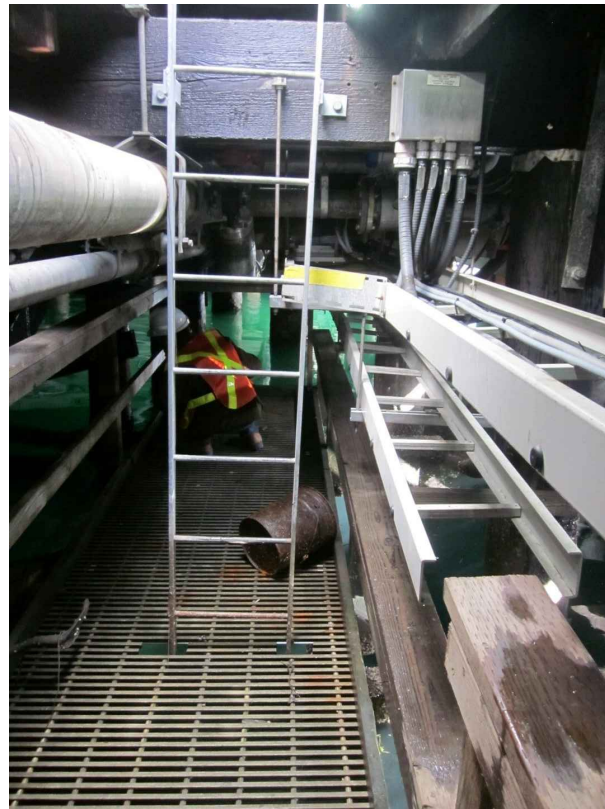


PHOTO C16-01 SOUTH JETTY CATWALK LADDER ACCESS AND CABLING LAYOUT



PHOTO C16-02 SOUTH JETTY CATWALK WITH MECHANICAL AND ELECTRICAL SERVICES



PHOTO C16-03 UNDER-PIER CATWALK - TYPICAL CABLE TRAY



PHOTO C16-06 CONCRETE-FACED TIMBER CRIB NEXT TO TIMBER JETTY PILINGS



PHOTO C16-04 UNDER-PIER MECHANICAL AND ELECTRICAL SERVICES AT TIMBER FIRE STOP WALL



PHOTO C16-05 UNDER-PIER CATWALK AT KIOSK LOCATION - LOOKING WEST



PHOTO C16-07 UNDER-PIER CATWALK AT KIOSK LOCATION - LOOKING EAST

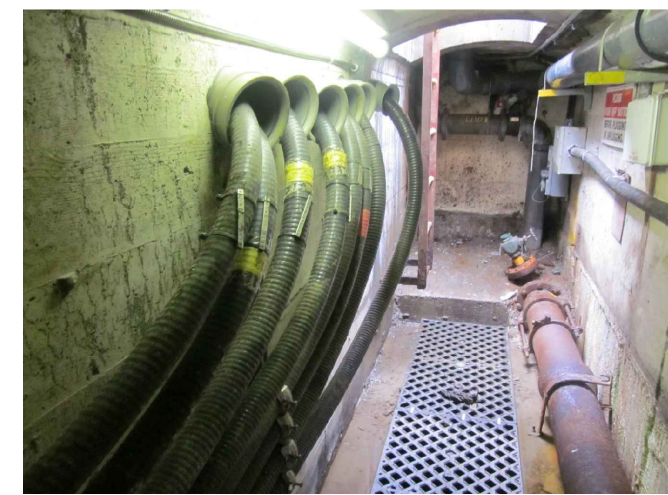


PHOTO C16-08 ELECTRICAL CABLING IN DOCK SERVICE TUNNEL (AT TUNNEL END, JUST EAST OF TIMBER CRIB)

Revision/Revision	Description/Description	Date/Date
1	RECORD DRAWING	2017/03/29
0	ISSUED FOR TENDER	2014/12/19

Client/client

PUBLIC WORKS AND GOVERNMENT SERVICES CANADA

Project title/Titre du projet
ESQUIMALT GRAVING DOCK
825 ADMIRALS ROAD, VICTORIA, BC

ESQUIMALT GRAVING DOCK WATERLOT PHASE 2 SOUTH JETTY UNDER-PIER

Consultant Signature Only

Designed by/Concept par
GEOFF COOPER

Drawn by/Dessiné par
MIKE BRIDDEN

PWGC Project Manager/Administrateur de Projets TPSGC
ANDREW MYLLY

Regional Manager, Environmental Services
COLLIN KINGMAN

Drawing title/Titre du dessin
PHOTOGRAPHS OF EXISTING CONDITIONS SHEET 3

Project No./No. du projet R.018400.002	Sheet/ C16	Revision no./ 1
-------------------------------------------	----------------------	---------------------------



PHOTO C17-01 CABLE TRAY UNDER CONCRETE DECK LOOKING EAST FROM WEST TIMBER PILED JETTY (BEFORE SHEET PILE PERIMETER WALL WAS INSTALLED)



PHOTO C17-02 HIGH MAST LIGHT ABOVE STEEL PILED CONCRETE DECK – NOTE LIMITED SIZE OF DECK OPENING



PHOTO C17-03 HIGH MAST LIGHT FOUNDATION UNDER STEEL PILED CONCRETE DECK – NOTE TIMBER FORMS LEFT IN PLACE



PHOTO C17-04 FORESHORE FILL MOUND UNDER STEEL PILED CRANE PAD – LOOKING WEST



PHOTO C17-05 FORESHORE FILL MOUND UNDER STEEL PILED CRANE PAD – LOOKING NORTHWEST TOWARDS TIMBER CRIB



PHOTO C17-06 SOUTH FACE OF TIMBER CRIB AND RIPRAP FORESHORE SLOPE



PHOTO C17-07 FORESHORE RIPRAP DIRECTLY UNDER STEEL PILED CONCRETE DECK



PHOTO C17-08 FORESHORE FILL MOUND UNDER STEEL PILED CONCRETE DECK – NOTE STEEL WALER AT RIGHT AND SEVERELY LIMITED HEADROOM

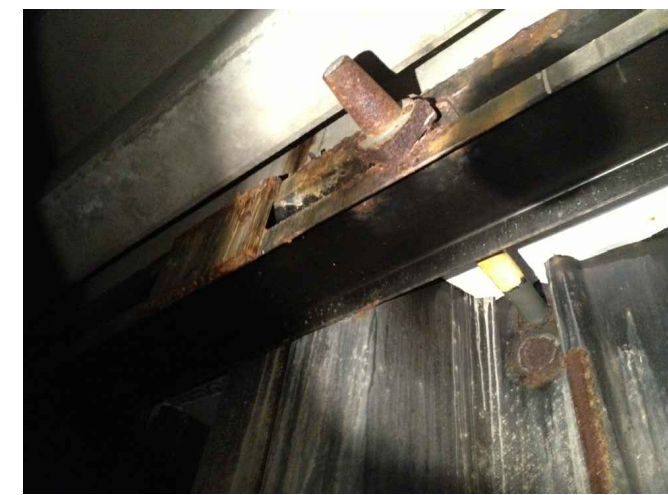


PHOTO C17-09 DETAIL VIEW OF STEEL WALER AND ANCHOR AT PAINTED SHEET PILED BULKHEAD WALL

Revision/Revision	Description/Description	Date/Date
1	RECORD DRAWING	2017/03/29
0	ISSUED FOR TENDER	2014/12/19

PUBLIC WORKS AND GOVERNMENT SERVICES CANADA

Project title/Titre du projet
ESQUIMALT GRAVING DOCK
825 ADMIRALS ROAD, VICTORIA, BC

ESQUIMALT GRAVING DOCK WATERLOT PHASE 2 SOUTH JETTY UNDER-PIER SEDIMENT REMEDIATION

Consultant Signature Only

Designed by/Concept par
GEOFF COOPER

Drawn by/Desainé par
MIKE BRIDDEN

PWGC Project Manager/Administrateur de Projets TPSGC
ANDREW MYLLY

Regional Manager, Environmental Services
COLLIN KINGMAN


Drawing title/Titre du dessin
PHOTOGRAPHS OF EXISTING CONDITIONS SHEET 4

Project No./No. du projet R.018400.002	Sheet/ C17	Revision no./ 1
-------------------------------------------	----------------------	---------------------------

DREDGE AREA BOUNDARY POINT TABLE			DREDGE AREA BOUNDARY POINT TABLE		
	NORTHING (m)	EASTING (m)		NORTHING (m)	EASTING (m)
D1	5364862.3	468379.4	D13	5364832.2	468597.1
D2	5364817.2	468287.3	D14	5364830.4	468596.5
D3	5364780.8	468291.2	D15	5364824.2	468588.9
D4	5364796.1	468437.3	D16	5364825.3	468584.1
D5	5364809.3	468564.0	D17	5364824.5	468580.2
D6	5364811.0	468579.5	D18	5364824.3	468577.6
D7	5364807.0	468579.9	D19	5364845.7	468575.3
D8	5364809.7	468590.5	D20	5364830.5	468433.7
D9	5364820.2	468624.6	D21	5364826.7	468397.4
D10	5364827.1	468623.4	D22	5364831.3	468396.9
D11	5364830.0	468610.5	D23	5364829.8	468383.1
D12	5364836.1	468598.9			

PROJECT BASELINE POINT TABLE		
	NORTHING (m)	EASTING (m)
BL1	5364805.7	468601.0
BL2	5364785.7	468577.5
BL3	5364765.1	468380.4
BL4	5364783.1	468357.6
BL5	5364761.1	468342.6
BL6	5364755.7	468290.8
BL7	5364805.4	468285.6
BL8	5364855.2	468280.4
BL9	5364866.6	468389.8
BL10	5364840.7	468392.6
BL11	5364833.6	468411.0
BL12	5364851.2	468579.1
BL13	5364841.6	468582.5
BL14	5364854.7	468619.6

PROJECT BASELINE DEFINES STATION 0+00 OF CROSS-SECTIONS. SEE DWGS C22/C23.

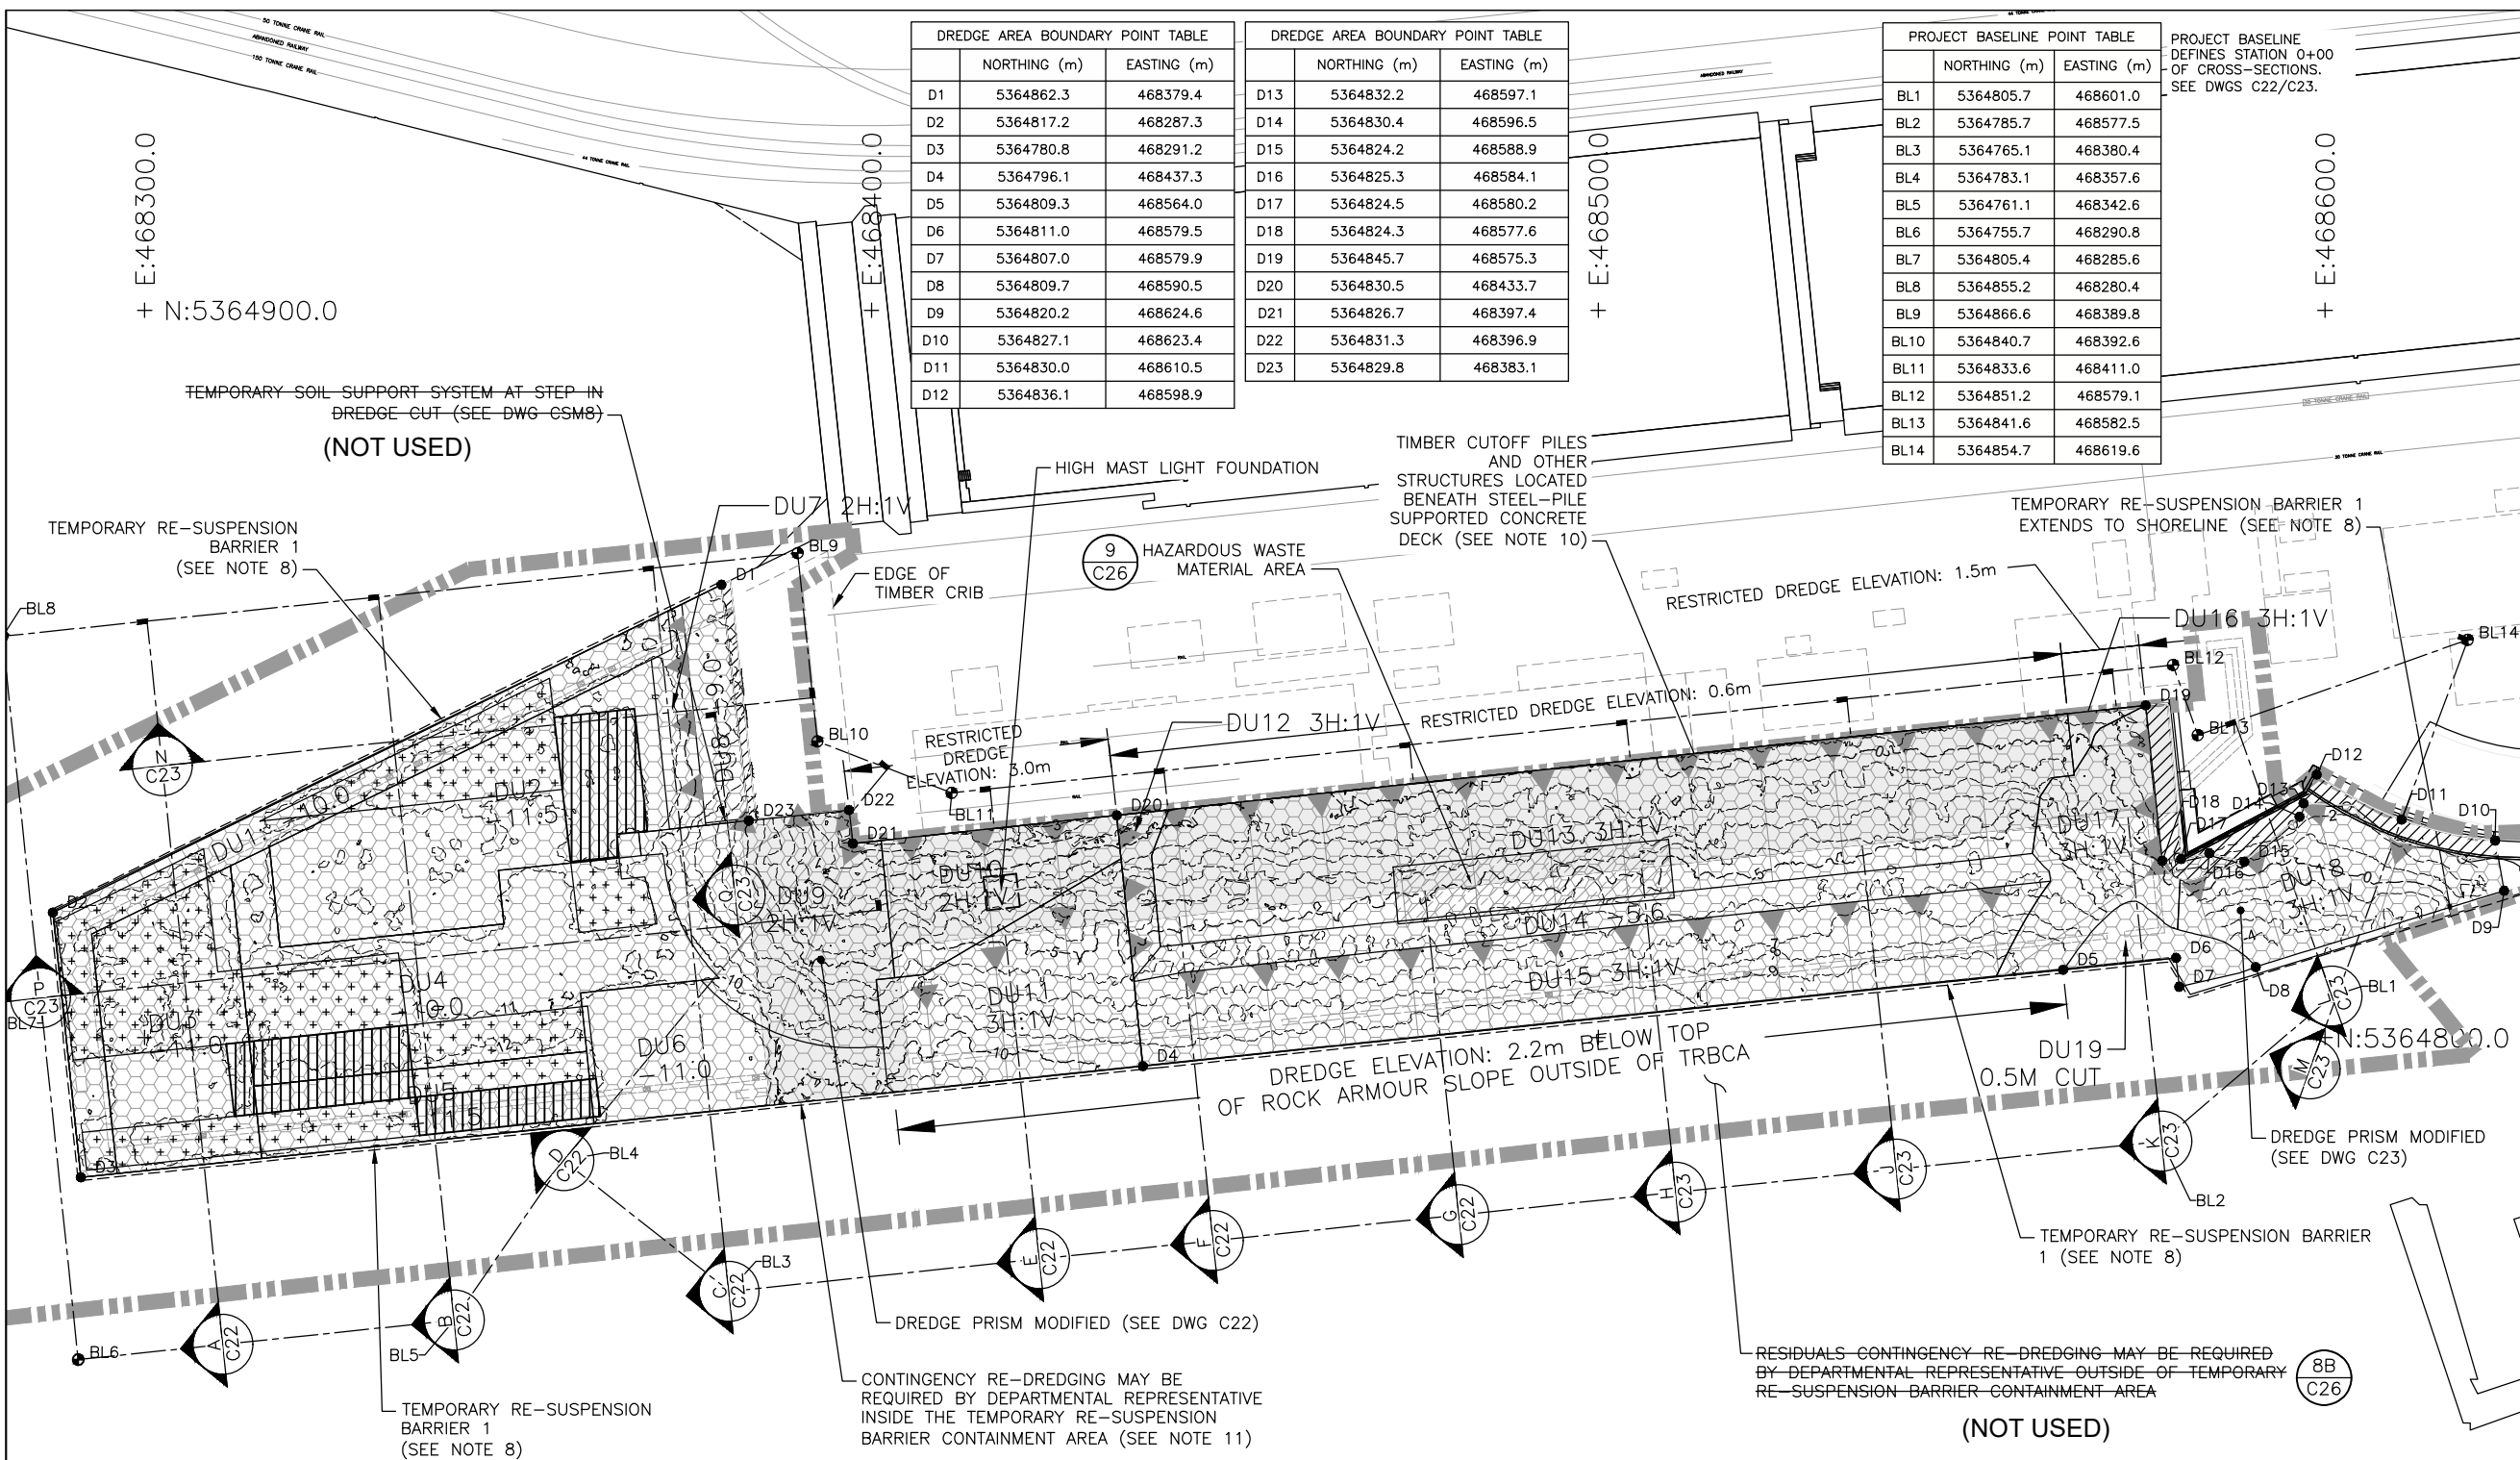

Revision/Revision	Description/Description	Date/Date
2	RECORD DRAWING	2017/03/31
1	ADDENDUM NO. 2	2016/03/20
0	ISSUED FOR TENDER	2014/12/19

PUBLIC WORKS AND GOVERNMENT SERVICES CANADA

Project title/Titre du projet
ESQUIMALT GRAVING DOCK
 825 ADMIRALS ROAD, VICTORIA, BC

ESQUIMALT GRAVING DOCK WATERLOT PHASE 2 SOUTH JETTY UNDER-PIER SEDIMENT REMEDIATION

Consultant Signature Only

Designed by/Concept par
MATT WOLTMAN

Drawn by/Dessiné par
CHRIS HEWETT


PWSC Project Manager/Administrateur de Projets TPSGC
ANDREW MYLLY

Regional Manager, Environmental Services
 Gestionnaire régionale, Services d'architecture et de génie, TPSGC
COLLIN KINGMAN

Drawing title/Titre du dessin
REQUIRED DREDGE PLAN








Project No./No. du projet	Sheet/Feuille	Revision no./La Révision no.
R.018400.002	C21	2

- HORIZONTAL DATUM: UTM ZONE 10 GRID, NAD83.
 VERTICAL DATUM: CHART DATUM (C.D.)
- NOTES:**
- POST-DREDGE BATHYMETRY PROVIDED BY CONTRACTOR AND COMPILED IN 2016. BATHYMETRY PRESENTS POST-REQUIRED DREDGING AND POST-CONTINGENCY RE-DREDGING CONDITIONS AS A COMBINED SINGLE SURVEY COMPILED FROM CONTRACTOR POST-CONSTRUCTION SURVEYS.
 - BASE MAP FROM GOLDER, JANUARY 2012.
 - REFERENCE DWG C1 FOR DATUM INFORMATION.
 - EGD WORK SITE ALSO INCLUDES UPLAND AREAS OF THE EGD FACILITY AS SHOWN ON THE DRAWINGS AND DESCRIBED IN THE SPECIFICATIONS.
 - CONTRACTOR SHALL COMPLETE DREDGING ACTIVITIES ACCORDING TO SEQUENCING REQUIREMENTS SHOWN ON DRAWINGS AND DESCRIBED IN THE SPECIFICATIONS.
 - SEE APPENDIX D REFERENCE DRAWINGS FOR A COMPLETE LIST OF CONTROL POINTS USED TO DEFINE EXTENTS OF DREDGING FOR DREDGE UNITS. CONTRACTOR SHALL TRANSITION DREDGE CUTS FROM THESE EXTENTS TO THE EGD WORK SITE BOUNDARY AS SHOWN ON THE DRAWINGS.
 - DREDGE SURFACE 0.5m WITHIN HAZARDOUS WASTE AREA (DU13) AND DISPOSE OF MATERIAL AS HAZARDOUS WASTE. PWSC TO SAMPLE TO DETERMINE WHETHER UNDERLYING MATERIAL IS HAZARDOUS WASTE. COMPLETE DREDGING TO ELEVATIONS AND GRADES. UNIT PRICE TABLE ASSUMES OTHER MATERIAL REMOVED TO ACHIEVE THE ELEVATIONS WILL BE DISPOSED AS IL+ MATERIAL.
 - TRB LOCATIONS SHOWN AS EXAMPLE ONLY. CONTRACTOR (AND 3RD PARTY VENDOR) SHALL DESIGN, INSTALL AND MAINTAIN TRBS IN ACCORDANCE WITH THE SPECIFICATIONS. CONTRACTOR TO PROVIDE TRB LAYOUT AND DESIGN DETAILS IN THE ENVIRONMENTAL PROTECTION PLAN.
 - OPEN PILES ARE PRESENT BENEATH SOUTH JETTY DECK POSE HEALTH AND SAFETY RISK. CONTRACTOR TO IDENTIFY IN HEALTH AND SAFETY PLAN APPROPRIATE RISK MITIGATION MEASURES THAT WILL BE IMPLEMENTED AT THESE LOCATIONS.
 - SEE DWGS C14, C15, AND D6, TIMBER PILES AND/OR OLD NON-FUNCTIONAL VERTICAL STRUCTURES INCLUDING BROKEN TIMBER PILES OR BROKEN STRUCTURAL ELEMENTS ARE PRESENT BENEATH THE STEEL-PILE SUPPORTED CONCRETE DECK IN DREDGE UNITS 6, 9, 10, 11, 12, 13, 16, AND 17. REMOVE TIMBER CUTOFF PILES AND OTHER STRUCTURES ENCOUNTERED DURING DREDGING IN ACCORDANCE WITH THE SPECIFICATIONS.
 - CONTINGENCY RE-DREDGING WAS PERFORMED FOR MISSED INVENTORY AND RESIDUALS MATERIAL REMOVAL WITHIN THE TEMPORARY RE-SUSPENSION BARRIER CONTAINMENT AREA AT LOCATIONS AS SHOWN, SEE DETAIL 8A AND 8B, DWG C26.

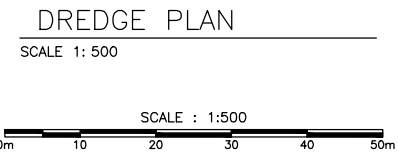

LEGEND:

POST-DREDGE BATHYMETRY IN METERS	DREDGE AREA
EGD WORK SITE BOUNDARY	DREDGE AREA UNDER STEEL-PILE SUPPORTED CONCRETE DECK
TEMPORARY RE-SUSPENSION BARRIER CONTAINMENT AREA	HAZARDOUS WASTE MATERIAL AREA
ORDINARY HIGH WATER LINE	NO DREDGE AREA
DREDGE UNIT BOUNDARY AND DREDGE ELEVATION	MISSED INVENTORY/CONTINGENCY RE-DREDGE AREA
SLOPE DREDGING DREDGE UNIT (DU) BOUNDARY AND GRADE	RESIDUALS CONTINGENCY RE-DREDGE AREA
SLOPE DESIGNATION	BASE LINE CONTROL POINT
	DREDGE AREA CONTROL POINT

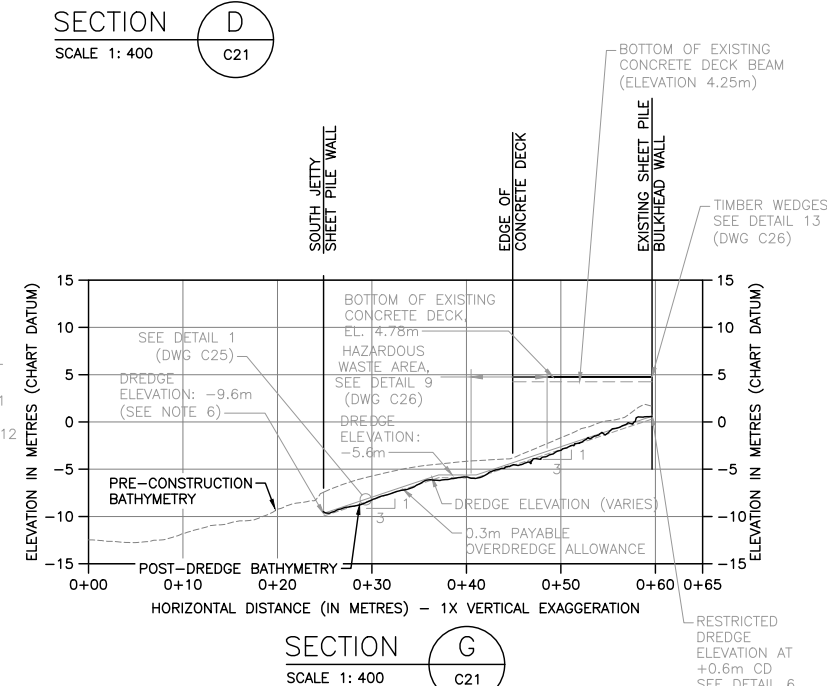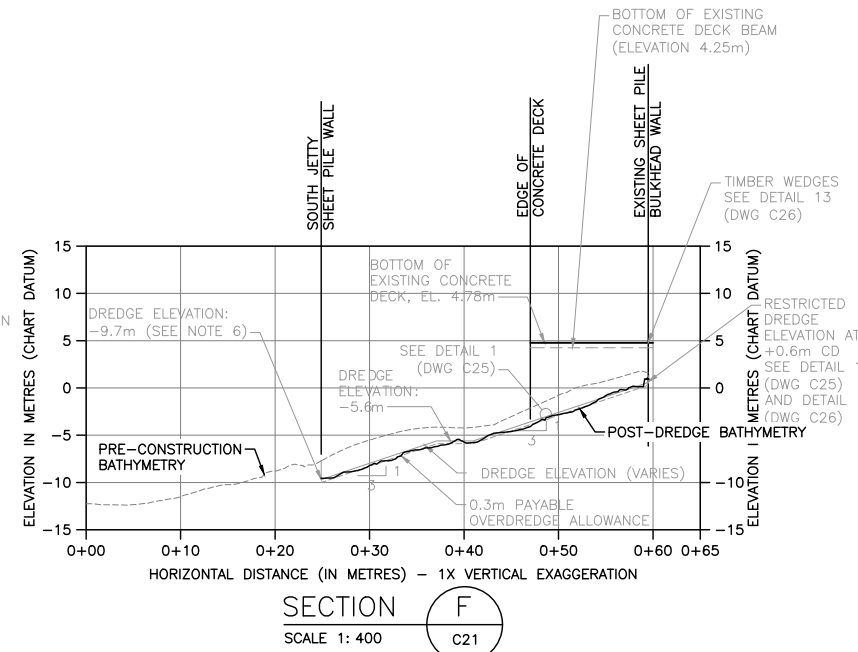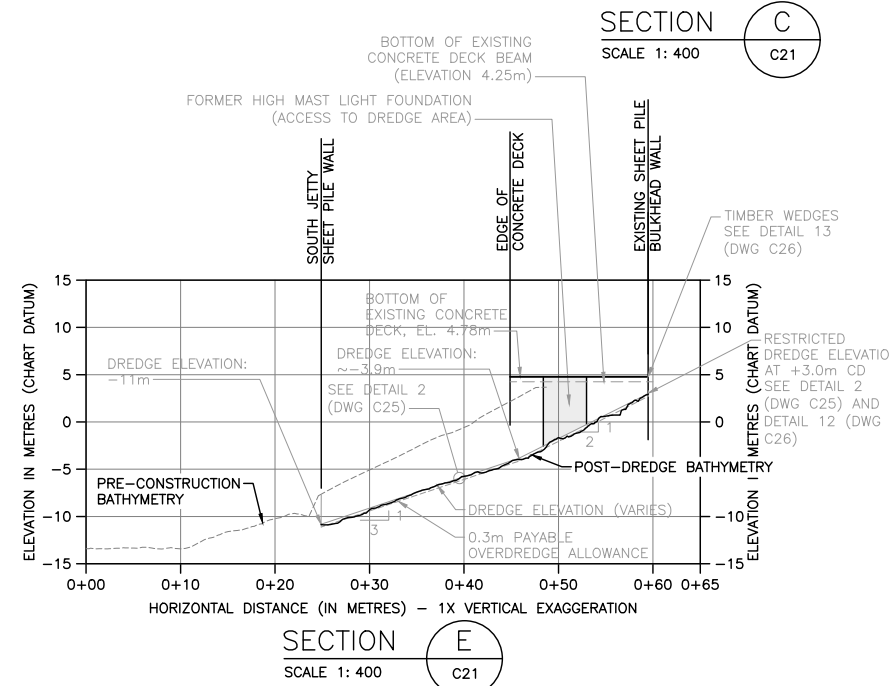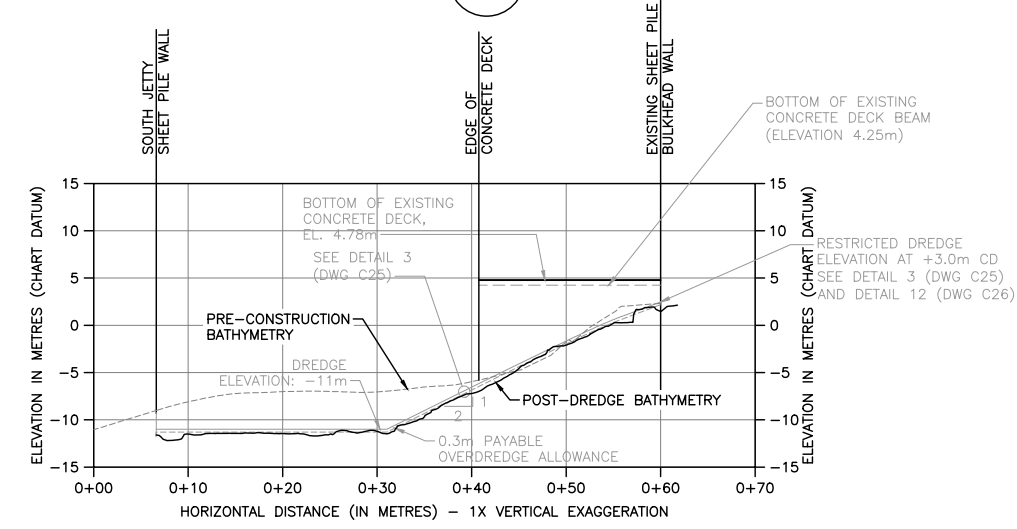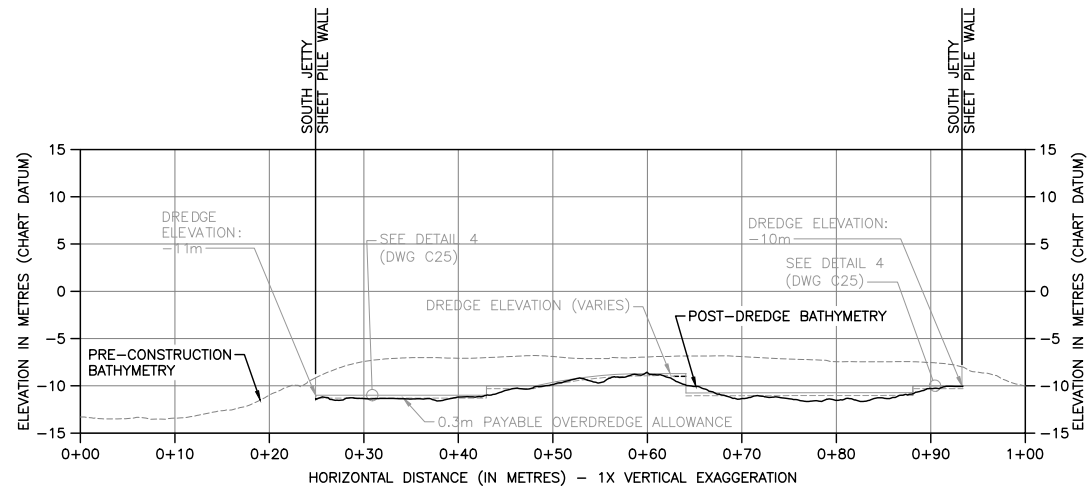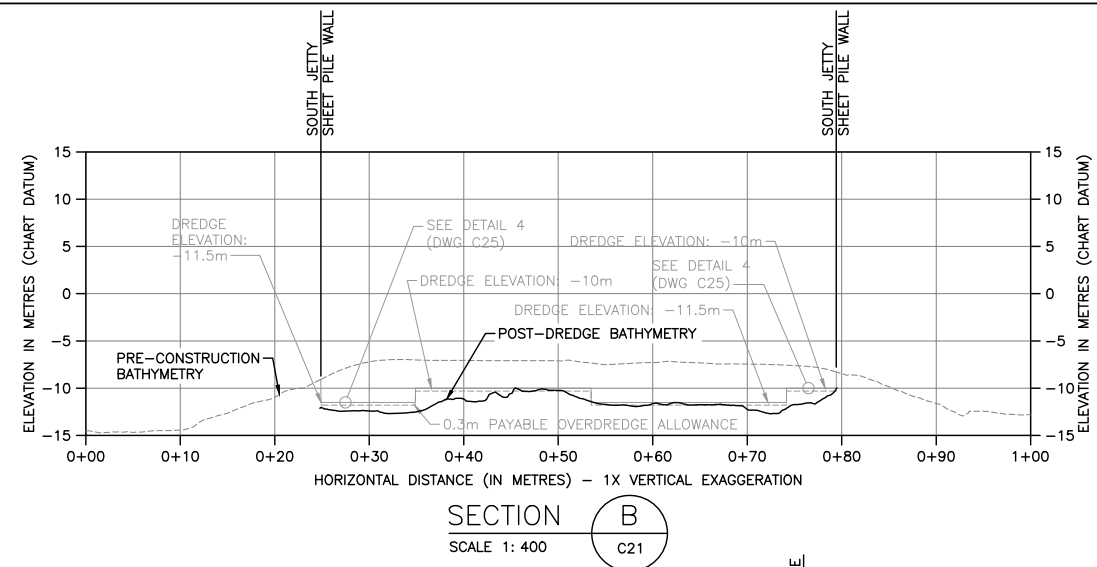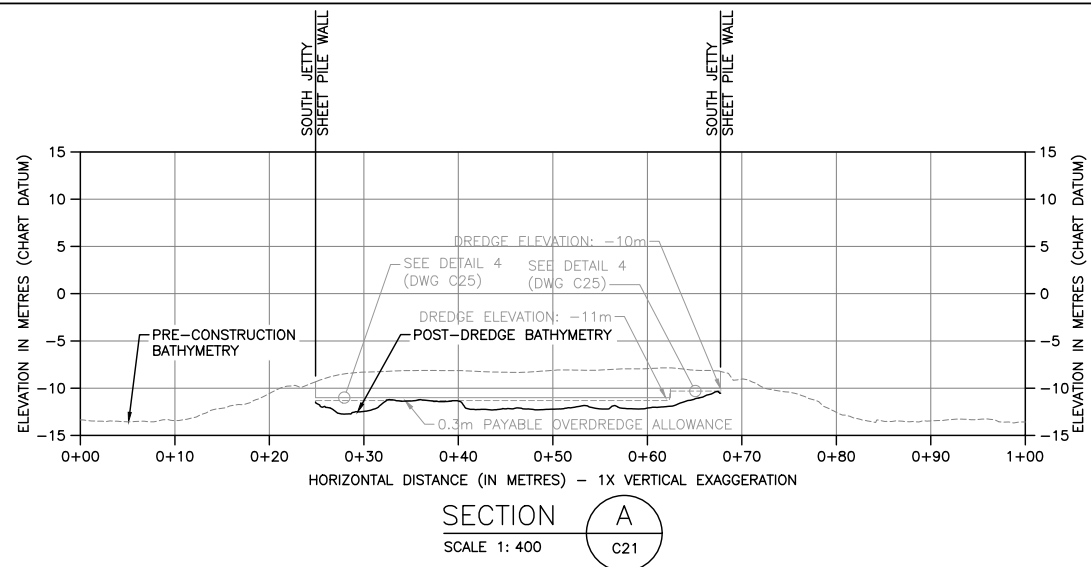

HORIZONTAL DATUM: UTM ZONE 10 GRID, NAD83.
VERTICAL DATUM: CHART DATUM (C.D.)

NOTES:

- POST-DREDGE BATHYMETRY PROVIDED BY CONTRACTOR AND COMPILED IN 2016. BATHYMETRY PRESENTS POST-REQUIRED DREDGING AND POST-CONTINGENCY RE-DREDGING CONDITIONS AS A COMBINED SINGLE SURVEY COMPILED FROM CONTRACTOR POST-CONSTRUCTION SURVEYS.
- REFERENCE DWG C1 FOR DATUM INFORMATION.
- EXISTING TIMBER-PILED STRUCTURE NOT SHOWN FOR CLARITY.
- CONTRACTOR SHALL REFERENCE THE 1985 STEEL-PILED DECK AS-BUILT DRAWINGS FOR DETAILS REGARDING CROSS SECTIONS THROUGH THE STEEL-PILED JETTY STRUCTURE, SHEETPILE BULKHEAD WALL, AND CONCRETE L-WALL.
- EXISTING GRADE IS APPROXIMATE. CONTRACTOR SHALL VERIFY EXISTING GRADES WITH PRE-CONSTRUCTION SURVEY. DREDGE ELEVATION IS APPROXIMATELY 2.2m BELOW EXISTING GRADE AT SOUTH JETTY SHEET PILE WALL FOR SECTIONS E, F, G, H, AND J.
- SLOUGHING OF EXISTING MATERIAL IS ANTICIPATED TO OCCUR AT THE DREDGE UNIT BOUNDARIES FOR ELEVATION DREDGING. SLOUGH VOLUMES ARE INCLUDED IN THE DREDGE PAY VOLUME PROVIDED IN THE SPECIFICATIONS.
- REQUIRED DREDGE PRISM RAISED BY 0.5M IN UNDER-PIER AREA OF DU9 TO ADDRESS EQUIPMENT ACCESS AND MATERIAL REMOVAL ACTIVITIES DURING CONSTRUCTION.

CROSS SECTIONS
SCALE 1: 400

Revision/Revision	Description/Description	Date/Date
1	RECORD DRAWING	2017/03/31
0	ISSUED FOR TENDER	2014/12/10


Client/client
PUBLIC WORKS AND GOVERNMENT SERVICES CANADA


Project title/Titre du projet
**ESQUIMALT GRAVING DOCK
825 ADMIRALS ROAD, VICTORIA, BC**
**ESQUIMALT GRAVING DOCK WATERLOT PHASE 2
SOUTH JETTY UNDER-PIER
SEDIMENT REMEDIATION**

Consultant Signature Only
Designed by/Concept par
MATT WOLTMAN
Drawn by/Dessiné par
CHRIS HEWETT
PWGSC Project Manager/Administrateur de Projets TPSGC
ANDREW MYLLY
Regional Manager, Environmental Services
Gestionnaire régionale, Services d'architecture et de génie, TPSGC
COLLIN KINGMAN


Drawing title/Titre du dessin
DREDGE CROSS SECTIONS - SHEET 1

Project No./No. du projet	Sheet/Feuille	Revision no./La Révision no.
R.018400.002	C22	1

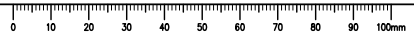


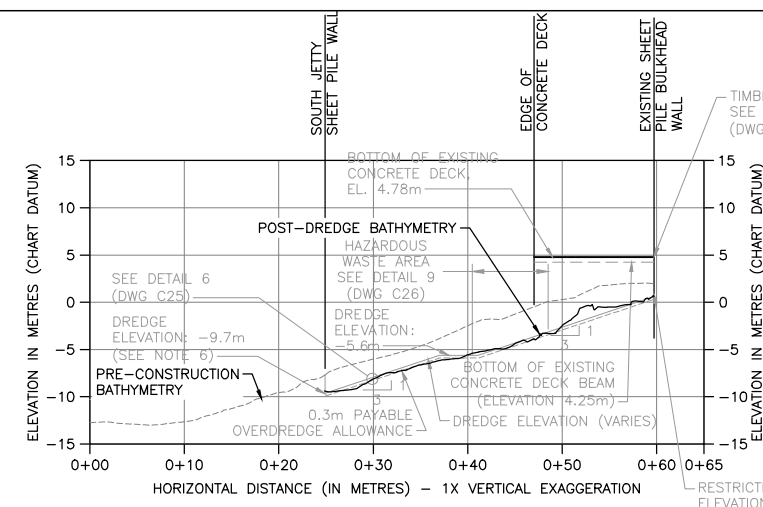


SECTION H
SCALE 1: 400
C21

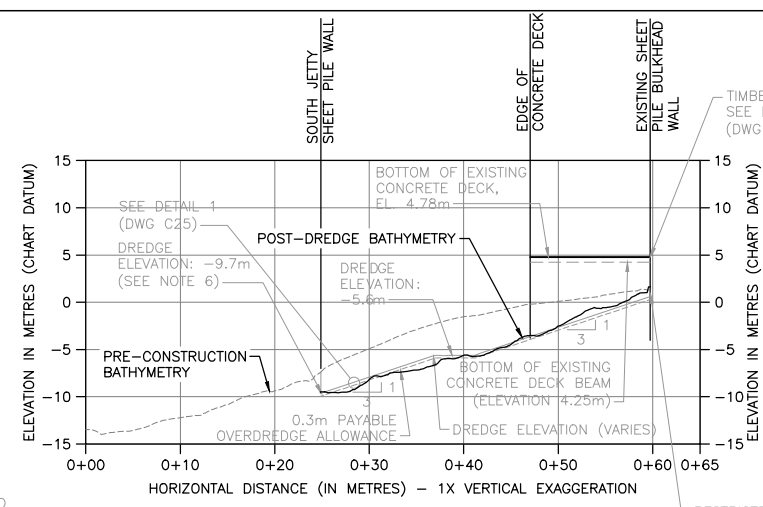


SECTION J
SCALE 1: 400
C21

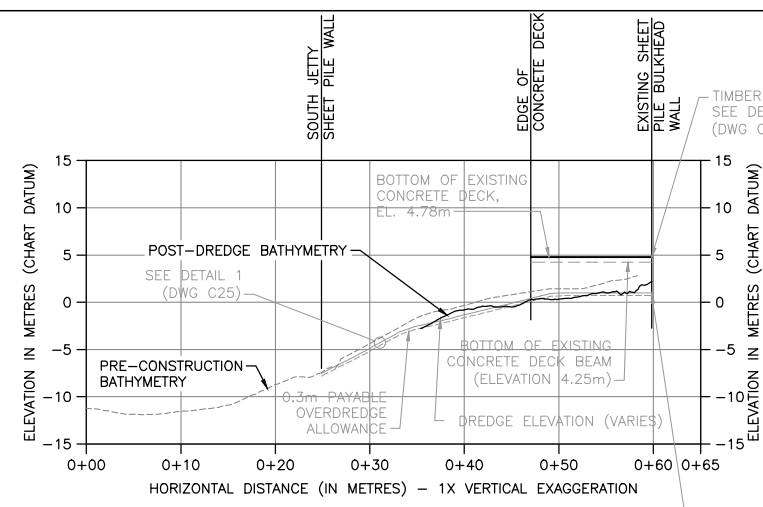


SECTION K
SCALE 1: 400
C21

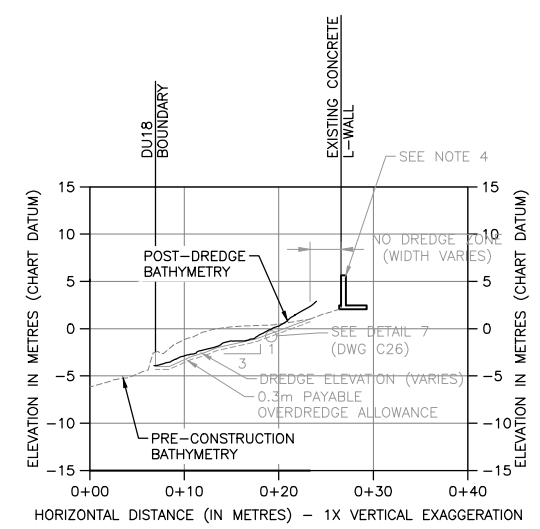


SECTION L
SCALE 1: 400
C21

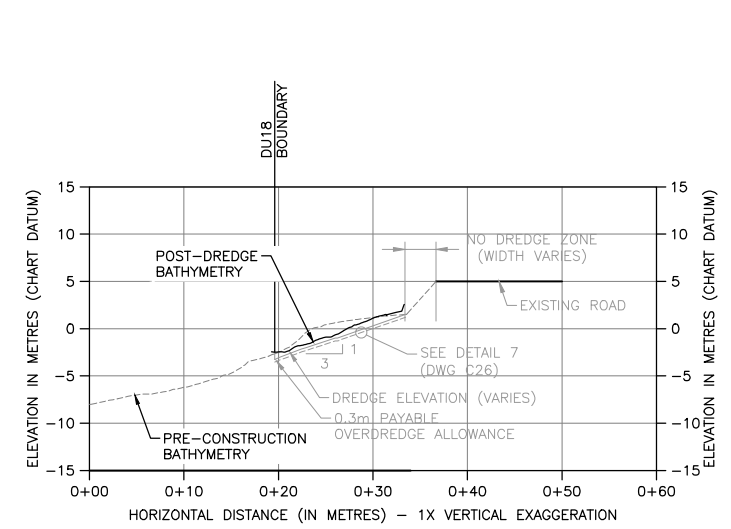


SECTION M
SCALE 1: 400
C21

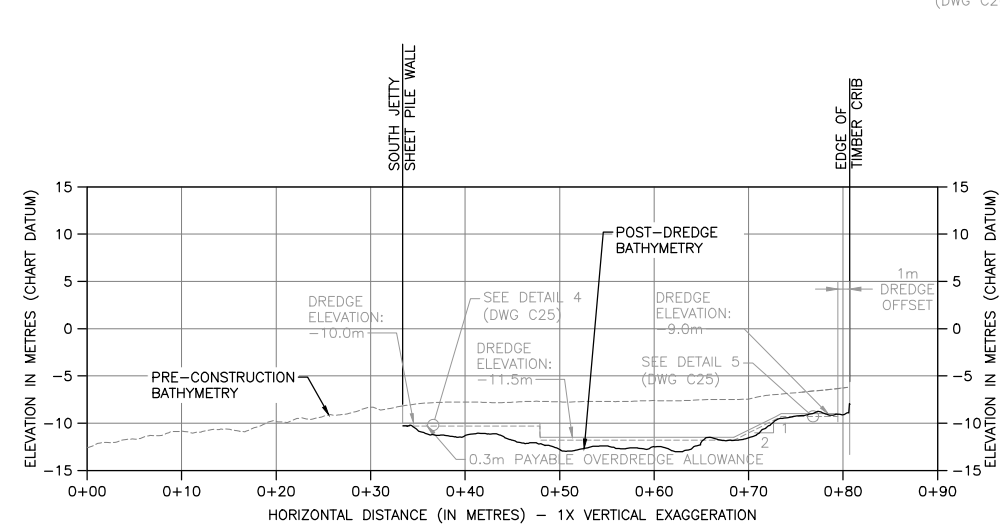

SECTION N
SCALE 1: 400
C21

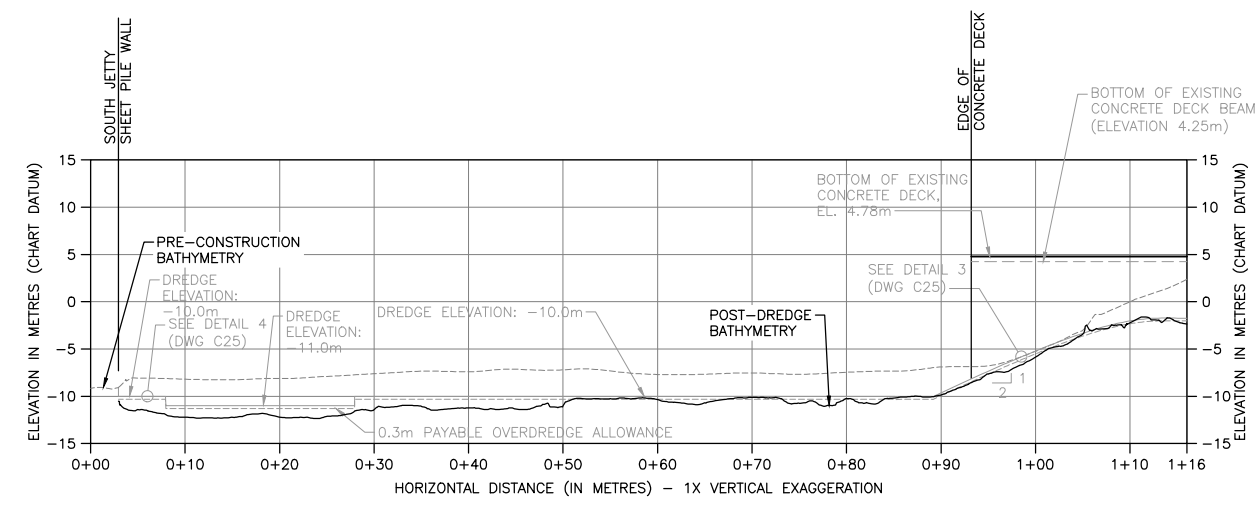

SECTION P
SCALE 1: 400
C21

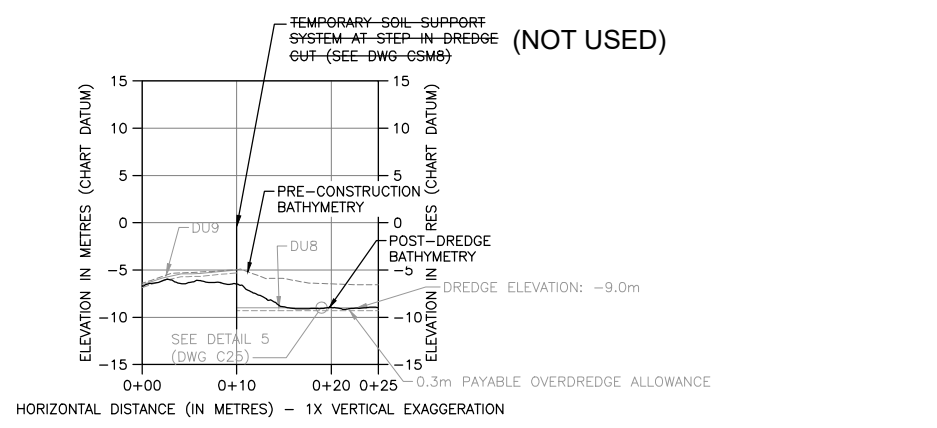

SECTION Q
SCALE 1: 400
C21

HORIZONTAL DATUM: UTM ZONE 10 GRID, NAD83.
VERTICAL DATUM: CHART DATUM (C.D.)

- NOTES:**
1. POST-DREDGE BATHYMETRY PROVIDED BY CONTRACTOR AND COMPILED IN 2016. BATHYMETRY PRESENTS POST-REQUIRED DREDGING AND POST-CONTINGENCY RE-DREDGING CONDITIONS AS A COMBINED SINGLE SURVEY COMPILED FROM CONTRACTOR POST-CONSTRUCTION SURVEYS.
 2. REFERENCE DWG C1 FOR DATUM INFORMATION.
 3. EXISTING TIMBER-PILED STRUCTURE NOT SHOWN FOR CLARITY.
 4. CONTRACTOR SHALL REFERENCE THE 1985 STEEL-PILED DECK AS-BUILT DRAWINGS FOR DETAILS REGARDING CROSS SECTIONS THROUGH THE STEEL-PILED JETTY STRUCTURE, SHEETPILE BULKHEAD WALL, AND CONCRETE L-WALL.
 5. EXISTING GRADE IS APPROXIMATE. CONTRACTOR SHALL VERIFY EXISTING GRADES WITH PRE-CONSTRUCTION SURVEY. DREDGE ELEVATION IS APPROXIMATELY 2.2m BELOW EXISTING GRADE AT SOUTH JETTY SHEET PILE WALL FOR SECTIONS E, F, G, H, AND J.
 6. SLOUGHING OF EXISTING MATERIAL IS ANTICIPATED TO OCCUR AT THE DREDGE UNIT BOUNDARIES FOR ELEVATION DREDGING. SLOUGH VOLUMES ARE INCLUDED IN THE DREDGE PAY VOLUME PROVIDED IN THE SPECIFICATIONS.
 7. REQUIRED DREDGE PRISM RAISED BY 0.5M IN UNDER-PIER AREA OF DU9 TO ADDRESS EQUIPMENT ACCESS AND MATERIAL REMOVAL ACTIVITIES DURING CONSTRUCTION.
 8. REQUIRED DREDGE PRISM RAISED BY IN DU18 TO ADDRESS STRUCTURE AND SHORELINE STABILITY CONSIDERATIONS ENCOUNTERED DURING CONSTRUCTION.
 9. POST-DREDGE SURFACE AREAS ABOVE THE REQUIRED DREDGING ELEVATION ARE REPRESENTATIVE OF AREAS WITH HARD MATERIAL AND/OR BLAST ROCK THAT WAS NOT REQUIRED FOR REMOVAL.

Revision/Revision	Description/Description	Date/Date
1	RECORD DRAWING	2017/03/31
0	ISSUED FOR TENDER	2014/12/19

Client/client
PUBLIC WORKS AND GOVERNMENT SERVICES CANADA


Project title/Titre du projet
**ESQUIMALT GRAVING DOCK
825 ADMIRALS ROAD, VICTORIA, BC**


**ESQUIMALT GRAVING DOCK
WATERLOT PHASE 2
SOUTH JETTY UNDER-PIER
SEDIMENT REMEDIATION**

Consultant Signature Only
Designed by/Concept par
MATT WOLTMAN
Drawn by/Dessiné par
CHRIS HEWETT
PWGSC Project Manager/Administrateur de Projets TPSGC
ANDREW MYLLY
Regional Manager, Environmental Services
Gestionnaire régionale, Services d'architectural et de génie, TPSGC
COLLIN KINGMAN

Drawing title/Titre du dessin
DREDGE CROSS SECTIONS - SHEET 2


Project No./No. du projet R.018400.002	Sheet/Feuille C23	Revision no./La Révision no. 1
--------------------------------------------------	-----------------------------	------------------------------------------

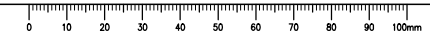

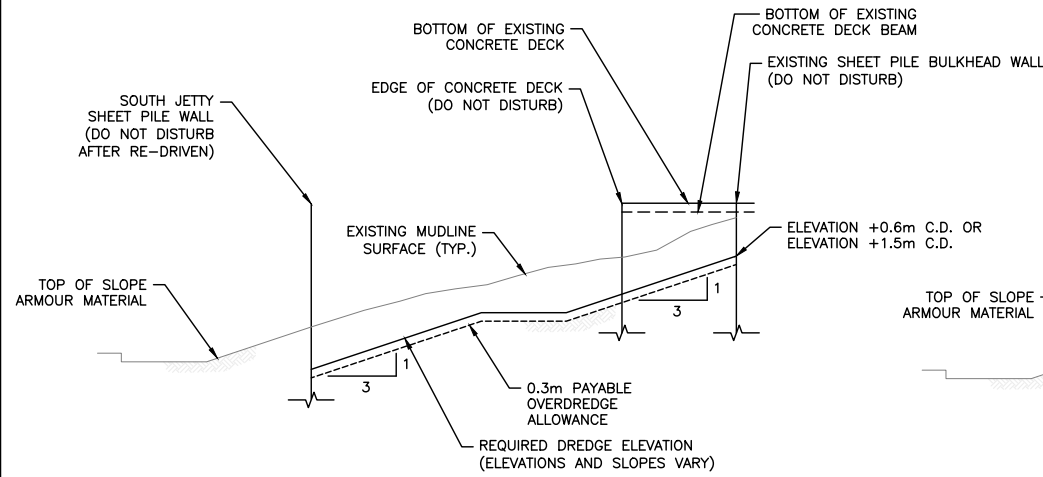


DETAIL 1 NOT TO SCALE C22/C23

NOTE: CONTRACTOR TO ADHERE TO RESTRICTED ELEVATION REQUIREMENTS WHEN COMPLETING DREDGE ACTIVITIES ADJACENT TO BULKHEADS

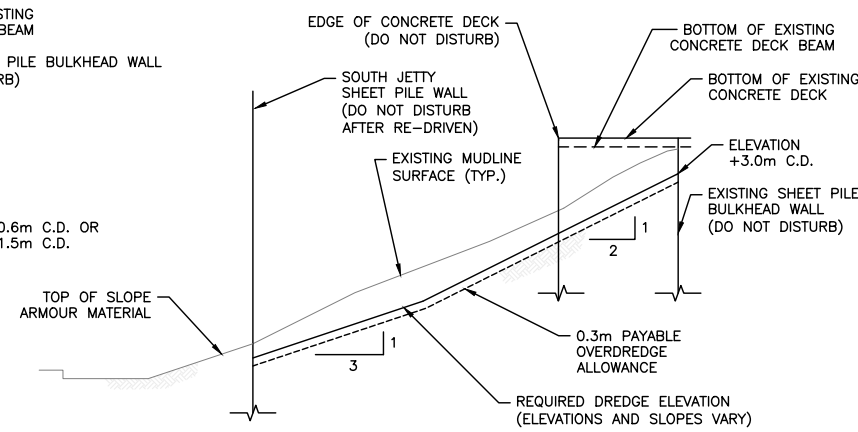


DETAIL 2 NOT TO SCALE C22

NOTE: CONTRACTOR TO ADHERE TO RESTRICTED ELEVATION REQUIREMENTS WHEN COMPLETING DREDGE ACTIVITIES ADJACENT TO BULKHEADS

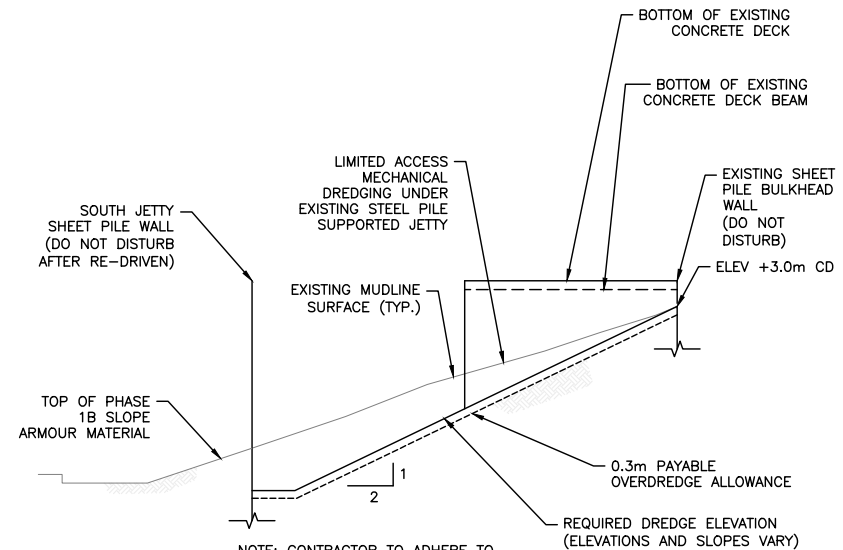


DETAIL 3 NOT TO SCALE C22/C23


NOTE: CONTRACTOR TO ADHERE TO RESTRICTED ELEVATION REQUIREMENTS WHEN COMPLETING DREDGE ACTIVITIES ADJACENT TO BULKHEADS

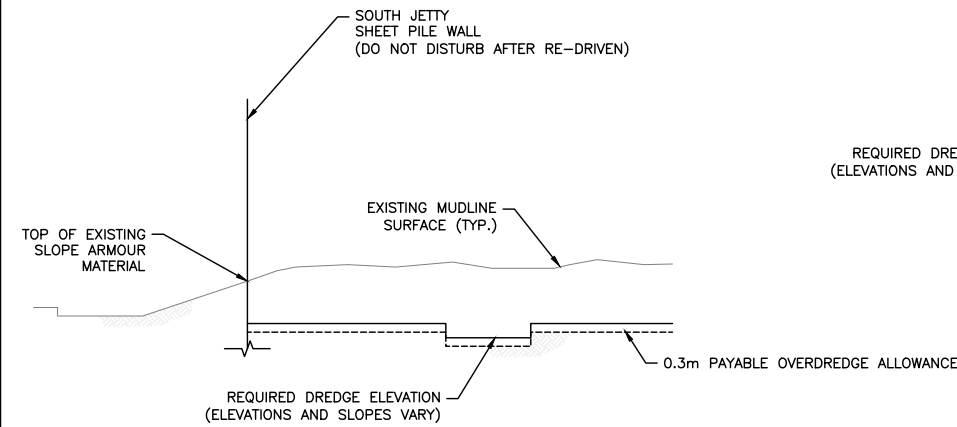

DETAIL 4 NOT TO SCALE C22/C23

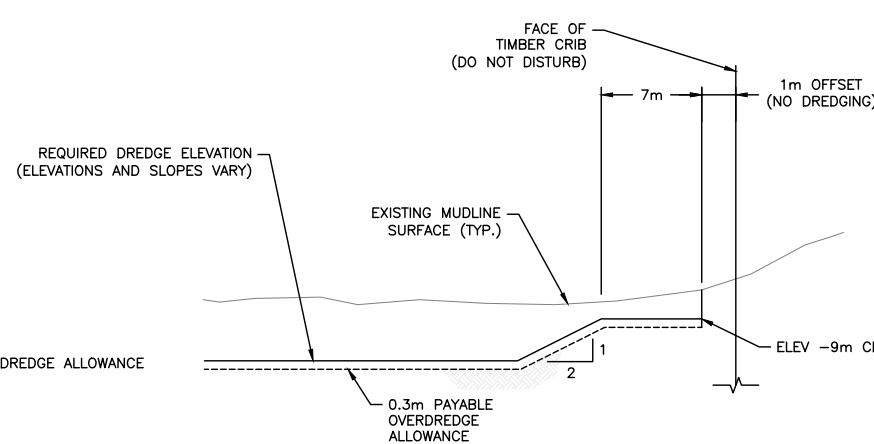

DETAIL 5 NOT TO SCALE C23

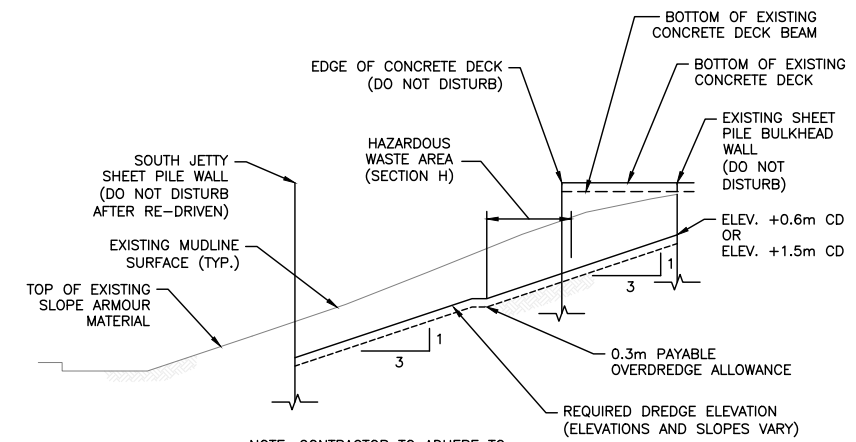

DETAIL 6 NOT TO SCALE C23

NOTE: CONTRACTOR TO ADHERE TO RESTRICTED ELEVATION REQUIREMENTS WHEN COMPLETING DREDGE ACTIVITIES ADJACENT TO BULKHEADS

- NOTES:
- EXISTING TIMBER-PILED STRUCTURE NOT SHOWN FOR CLARITY.
 - CONTRACTOR SHALL REFERENCE THE 1985 STEEL-PILE DECK AS-BUILT DRAWINGS FOR DETAILS REGARDING CROSS SECTIONS THROUGH THE STEEL-PILED JETTY STRUCTURE, SHEETPILE BULKHEAD WALL, AND CONCRETE L-WALL.

Revision/Revision	Description/Description	Date/Date
1	RECORD DRAWING	2017/03/31
0	ISSUED FOR TENDER	2014/12/10

PUBLIC WORKS AND GOVERNMENT SERVICES CANADA

Project title/Titre du projet
ESQUIMALT GRAVING DOCK
 825 ADMIRALS ROAD, VICTORIA, BC
ESQUIMALT GRAVING DOCK WATERLOT PHASE 2
SOUTH JETTY UNDER-PIER SEDIMENT REMEDIATION

Consultant Signature Only

Designed by/Concept par
 MATT WOLTMAN


Drawn by/Dessiné par
 CHRIS HEWETT

PWSC Project Manager/Administrateur de Projets TPSGC
 ANDREW MYLLY


Regional Manager, Environmental Services
 COLLIN KINGMAN

Drawing title/Titre du dessin
DREDGE DETAILS - SHEET 1

Project No./No. du projet	Sheet/Feuille	Revision no./Révision no.
R.018400.002	C25	1

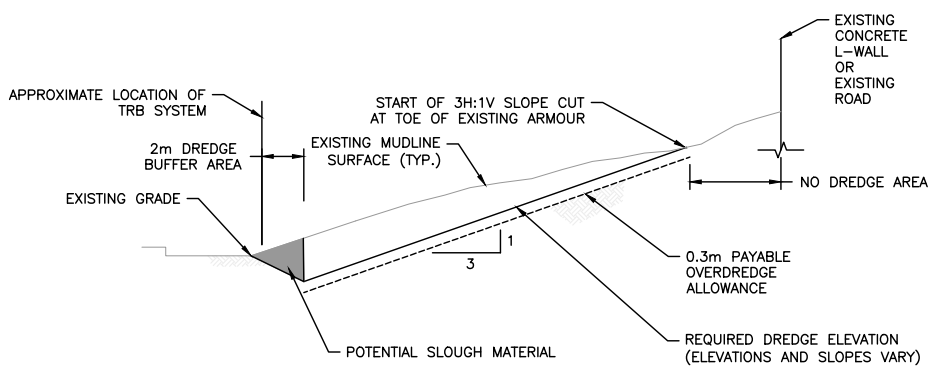


DETAIL 7
NOT TO SCALE C23

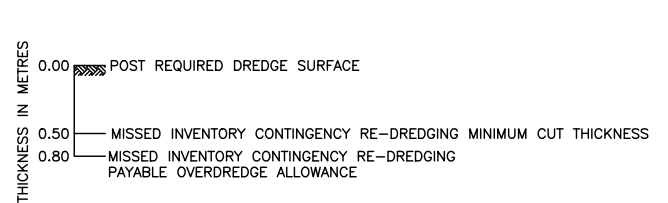


CONTINGENCY RE-DREDGE - MISSED INVENTORY

DETAIL 8A
NOT TO SCALE C21

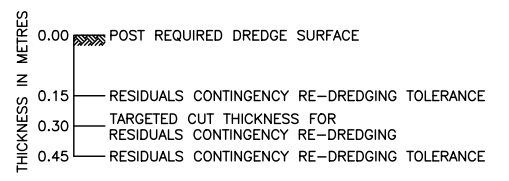


CONTINGENCY RE-DREDGE - RESIDUALS

DETAIL 8B
NOT TO SCALE C21

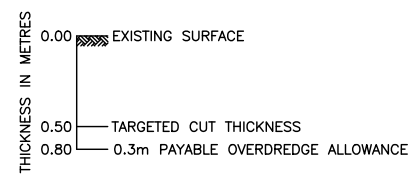


TARGETED CUT THICKNESS FOR HAZARDOUS WASTE AREA

DETAIL 9
NOT TO SCALE C21/C22/C23

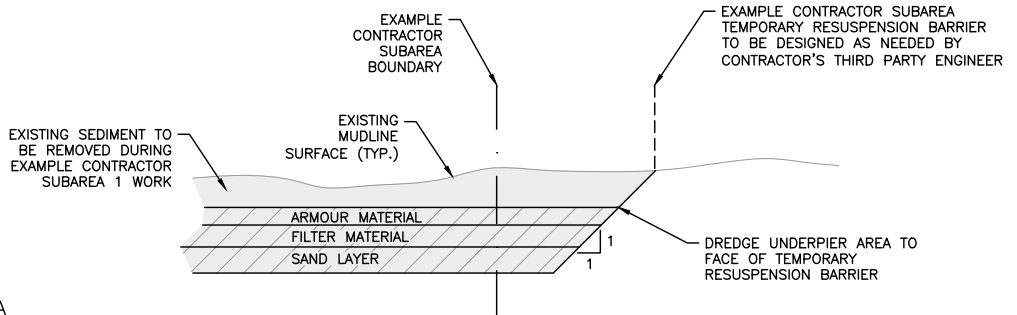


DETAIL (EXAMPLE) 10
NOT TO SCALE

NOTE: DETAIL 10 AND 11 SHOW EXAMPLE CONTRACTOR SUBAREA TRANSITION AREA.

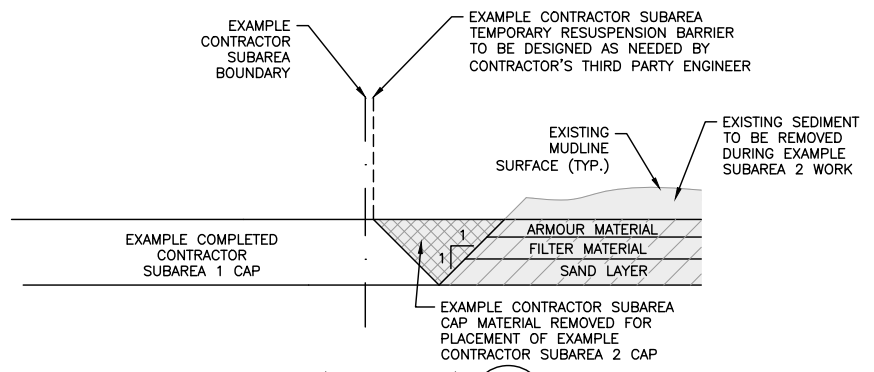


DETAIL (EXAMPLE) 11
NOT TO SCALE

NOTE: DETAIL 10 AND 11 SHOW EXAMPLE CONTRACTOR SUBAREA TRANSITION AREA.

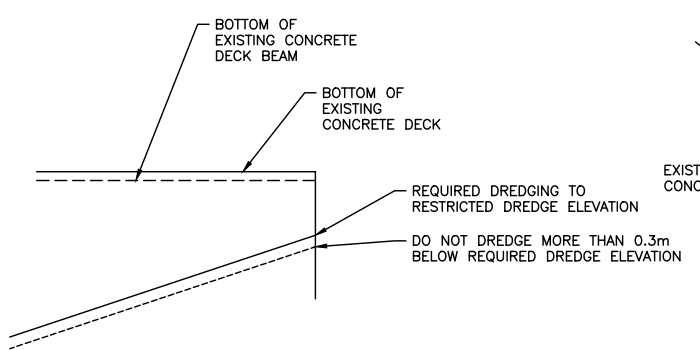


DETAIL 12
NOT TO SCALE C22/C23

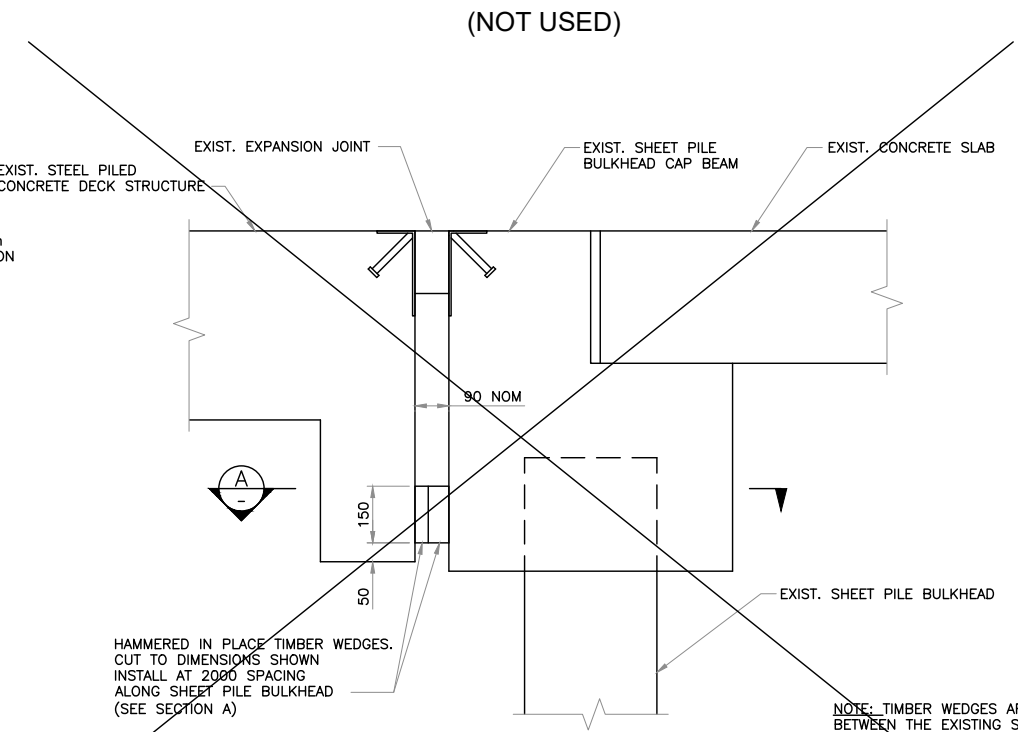

DETAIL 13
SCALE 1:10 C22/C23

NOTE: TIMBER WEDGES ARE TO BE INSTALLED IN THE MOVEMENT JOINT GAP BETWEEN THE EXISTING STEEL-PILED CONCRETE DECK AND THE ANCHORED BULKHEAD WALL CAP BEAM PRIOR TO START OF DREDGING. TIMBER WEDGES TO BE REMOVED AFTER PLACEMENT OF FILTER MATERIAL IN THE IMMEDIATE ADJACENT AREA.

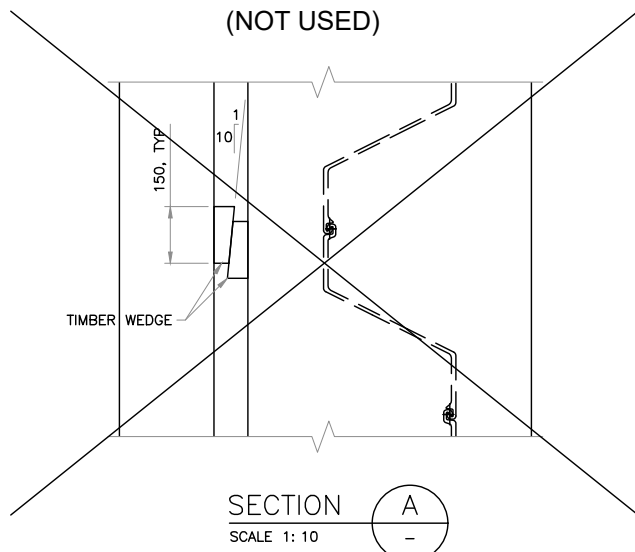

- NOTES:
- EXISTING TIMBER-PILED STRUCTURE NOT SHOWN FOR CLARITY.
 - CONTRACTOR SHALL REFERENCE THE 1985 STEEL-PILES DECK AS-BUILT DRAWINGS FOR DETAILS REGARDING CROSS SECTIONS THROUGH THE STEEL-PILED JETTY STRUCTURE, SHEETPILE BULKHEAD WALL, AND CONCRETE L-WALL.
 - CONTRACTOR SUBAREAS 1 AND 2 ARE FOR EXAMPLE PURPOSES ONLY AND ARE NOT DEFINED LOCATIONS.

Revision/Revision	Description/Description	Date/Date
1	RECORD DRAWING	2017/03/31
0	ISSUED FOR TENDER	2014/12/19

Client/client
PUBLIC WORKS AND GOVERNMENT SERVICES CANADA




Project title/Titre du projet
**ESQUIMALT GRAVING DOCK
825 ADMIRALS ROAD, VICTORIA, BC**

**ESQUIMALT GRAVING DOCK
WATERLOT PHASE 2
SOUTH JETTY UNDER-PIER
SEDIMENT REMEDIATION**

Consultant Signature Only
Designed by/Concept par MATT WOLTMAN
Drawn by/Dessiné par CHRIS HEWETT
PWSC Project Manager/Administrateur de Projets TPSGC ANDREW MYLLY
Regional Manager, Environmental Services COLLIN KINGMAN

Drawing title/Titre du dessin
DREDGE DETAILS - SHEET 2

Project No./No. du projet	Sheet/Feuille	Revision no./Révision no.
R.018400.002	C26	1

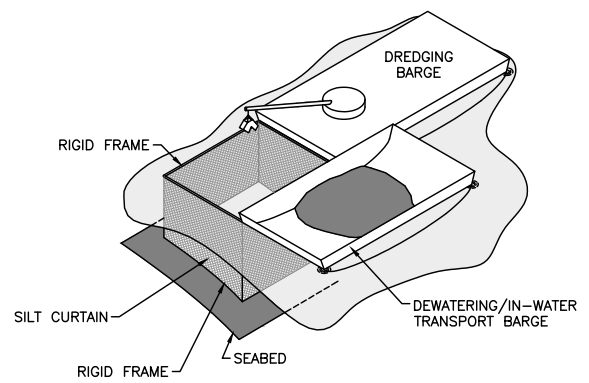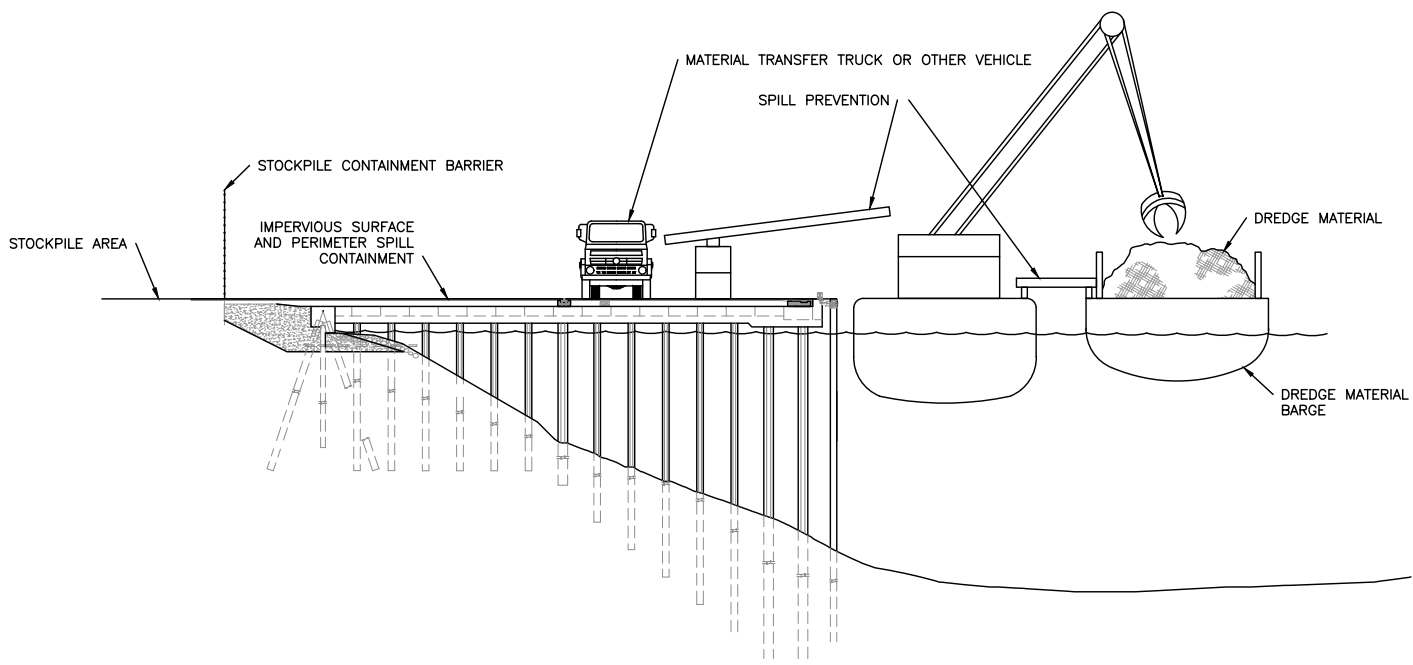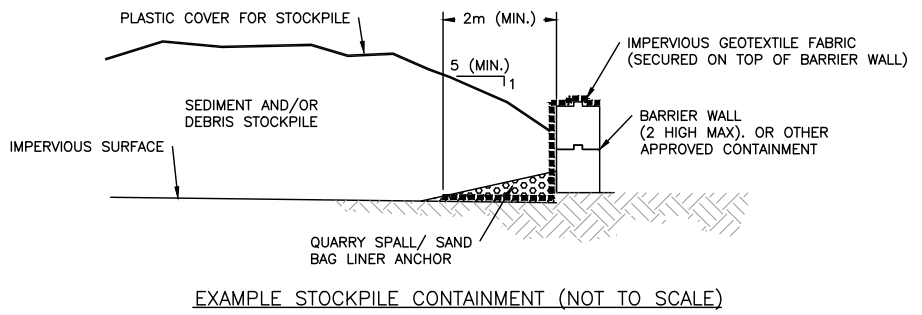

EXAMPLE ADDITIONAL TRB ARRANGEMENT #1 FOR MATERIAL TRANSFER (DREDGE BARGE TO MATERIAL BARGE): TRB AFFIXED TO DREDGE BARGE; DREDGE BARGE AND MATERIAL BARGE LOCATED WITHIN THE TEMPORARY RE-SUSPENSION BARRIER CONTAINMENT AREA (NOT TO SCALE)



PHOTO 1: EXAMPLE OF OFFLOADING OPERATIONAL CONTROLS


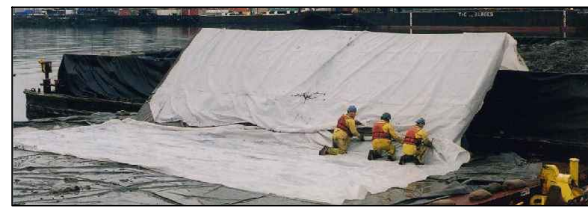


PHOTO 2: EXAMPLE OF OFFLOADING OPERATIONAL CONTROLS

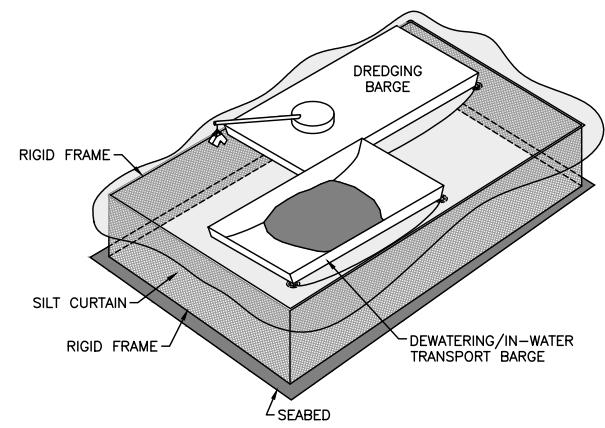

EXAMPLE ADDITIONAL TRB ARRANGEMENT #2 FOR MATERIAL TRANSFER (DREDGE BARGE TO MATERIAL BARGE): TRB SURROUNDING DREDGE BARGE AND MATERIAL BARGE; DREDGE BARGE AND MATERIAL BARGE LOCATED WITHIN THE TEMPORARY RE-SUSPENSION BARRIER CONTAINMENT AREA (NOT TO SCALE)


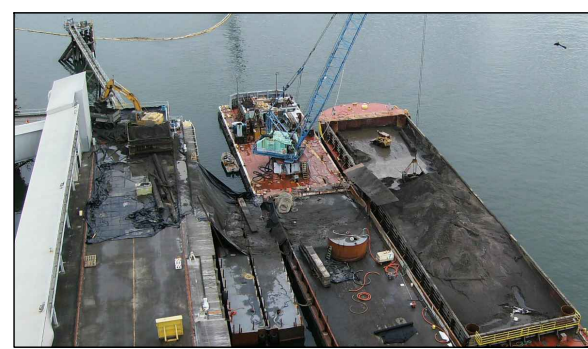


PHOTO 3: EXAMPLE OF OFFLOADING TO TRUCKS OPERATIONAL CONTROLS

EXAMPLE OFFLOAD FACILITY CONTROLS

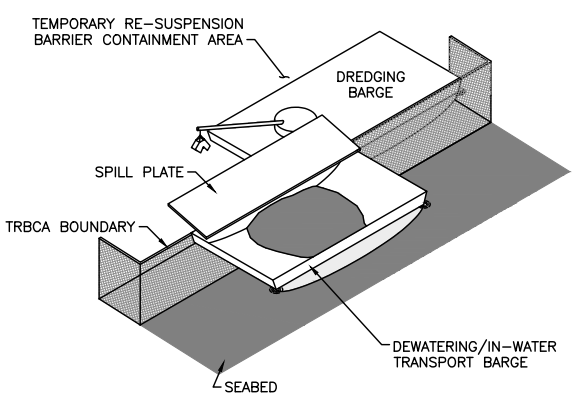

EXAMPLE MATERIAL BARGE MOORAGE OUTSIDE OF TEMPORARY RE-SUSPENSION BARRIER CONTAINMENT AREA; USE OF SPILL PLATE ON MATERIAL BARGE TO PREVENT SPILLAGE OUTSIDE THE TRBCA; DREDGE BARGE LOCATED WITHIN THE TEMPORARY RE-SUSPENSION BARRIER CONTAINMENT AREA (NOT TO SCALE)

NOTES:

1. EXAMPLE SILT CURTAIN ARRANGEMENTS ARE SHOWN AS CONCEPTUAL EXAMPLES OF TRB SYSTEMS ONLY. CONTRACTOR MAY ELECT TO USE ADDITIONAL TRB SYSTEMS AROUND THE DREDGE AND/OR DEWATERING BARGES TO ENSURE COMPLIANCE WITH WATER QUALITY CRITERIA.
2. EXAMPLES SHOWN ARE FOR CONTRACTOR INFORMATION ONLY AND INTENDED TO SHOW EXAMPLE BEST MANAGEMENT PRACTICES. DESIGN AND OPERATIONS OF STOCKPILE MANAGEMENT AND OFFLOADING OPERATIONS ARE THE RESPONSIBILITY OF THE CONTRACTOR. COMPLY WITH ALL CONTRACT DOCUMENTS, ENVIRONMENTAL MANAGEMENT PLAN, AND THE FEDERAL, PROVINCIAL, AND MUNICIPAL PERMIT REQUIREMENTS FOR OFFLOAD FACILITY AND STOCKPILING.
3. PLACEMENT OF SEDIMENT NO MORE THAN 1.5 METRE HIGH IMMEDIATELY AGAINST BARRIER WALL IS A TYPICAL STANDARD OF PRACTICE IN STOCKPILE CONTAINMENT.
4. MAINTAINING A SLOPE NO STEEPER THAN 5H:1V ADJACENT TO A BARRIER WALL IS A TYPICAL STANDARD OF PRACTICE IN STOCKPILE CONTAINMENT.
5. SPILLS THAT OCCUR DURING OFFLOADING AND TRANSFER SHALL DRAIN ONTO BARGE OR WITHIN A CONTAINED UPLAND AREA. SPILL PROTECTION SHALL BE CONSTRUCTED FROM IMPERVIOUS MATERIAL.
6. CONTRACTOR SHALL CLEAN OFFLOAD FACILITY DAILY.
7. STOCKPILE CONTAINMENT DETAIL SHOWS SEDIMENT STACKED GREATER THAN 1.5 METRE HIGH FOR ILLUSTRATIVE PURPOSES ONLY. DEPICTION OF STACKED SEDIMENT DOES NOT INDICATE POTENTIAL WORKABILITY AND FLOW BEHAVIOR OF DREDGED MATERIAL, AND SHALL NOT BE USED BY THE CONTRACTOR AS BASIS FOR ANTICIPATING DREDGE MATERIAL CONDITIONS DURING THE WORK.
8. CONTRACTOR SHALL SUBMIT STOCKPILE CONTAINMENT DESIGN DETAILS TO THE DEPARTMENTAL REPRESENTATIVE FOR REVIEW.
9. BUCKET SWING RADIUS SHOULD NOT EXTEND PAST SPILL PREVENTION FEATURES.

Revision/Revision	Description/Description	Date/Date
1	RECORD DRAWING	2017/03/31
0	ISSUED FOR TENDER	2014/12/18

Client/client
PUBLIC WORKS AND GOVERNMENT SERVICES CANADA

Project title/Titre du projet
**ESQUIMALT GRAVING DOCK
825 ADMIRALS ROAD, VICTORIA, BC**

**ESQUIMALT GRAVING DOCK
WATERLOT PHASE 2
SOUTH JETTY UNDER-PIER
SEDIMENT REMEDIATION**

Consultant Signature Only

Designed by/Concept par
MATT WOLTMAN

Drawn by/Dessiné par
CHRIS HEWETT

PWSC Project Manager/Administrateur de Projets TPSC
ANDREW MYLLY


Regional Manager, Environmental Services
COLLIN KINGMAN

Drawing title/Titre du dessin
**MATERIAL OFFLOADING, HANDLING,
STORAGE, AND TURBIDITY CONTROL
DETAILS**

Project No./No. du projet
R.018400.002

Sheet/
C27

Revision no./
1

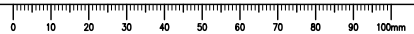




CAP AREA POINT TABLE		
	NORTHING (m)	EASTING (m)
C1	5364862.3	468379.4
C2	5364817.4	468287.4
C3	5364780.8	468291.3
C4	5364790.0	468378.9
C5	5364796.1	468437.3
C6	5364810.9	468579.3
C7	5364807.0	468579.9
C8	5364820.4	468625.2
C9	5364827.1	468623.2
C10	5364830.0	468610.5
C11	5364836.1	468598.9
C12	5364833.5	468597.4
C13	5364824.8	468580.8

CAP AREA POINT TABLE		
	NORTHING (m)	EASTING (m)
C14	5364846.0	468578.6
C15	5364830.5	468433.7
C16	5364826.7	468397.4
C17	5364831.3	468396.9
C18	5364829.8	468383.4
C19	5364845.5	468381.5
C20	5364840.1	468376.0
C21	5364842.9	468370.7
C22	5364826.8	468354.5
C23	5364823.6	468354.9
C24	5364824.2	468359.3
C25	5364806.7	468365.0
C26	5364806.3	468361.8

PROJECT BASELINE POINT TABLE		
	NORTHING (m)	EASTING (m)
BL1	5364805.7	468601.0
BL2	5364785.7	468577.5
BL3	5364765.1	468380.4
BL4	5364783.1	468357.6
BL5	5364761.1	468342.6
BL6	5364755.7	468290.8
BL7	5364805.4	468285.6
BL8	5364855.2	468280.4
BL9	5364866.6	468389.8
BL10	5364840.7	468392.6
BL11	5364833.6	468411.0
BL12	5364851.2	468579.1
BL13	5364841.6	468582.5
BL14	5364854.7	468619.6

PROJECT BASELINE DEFINES STATION 0+00 OF CROSS-SECTIONS. SEE DWGS C29/C30.

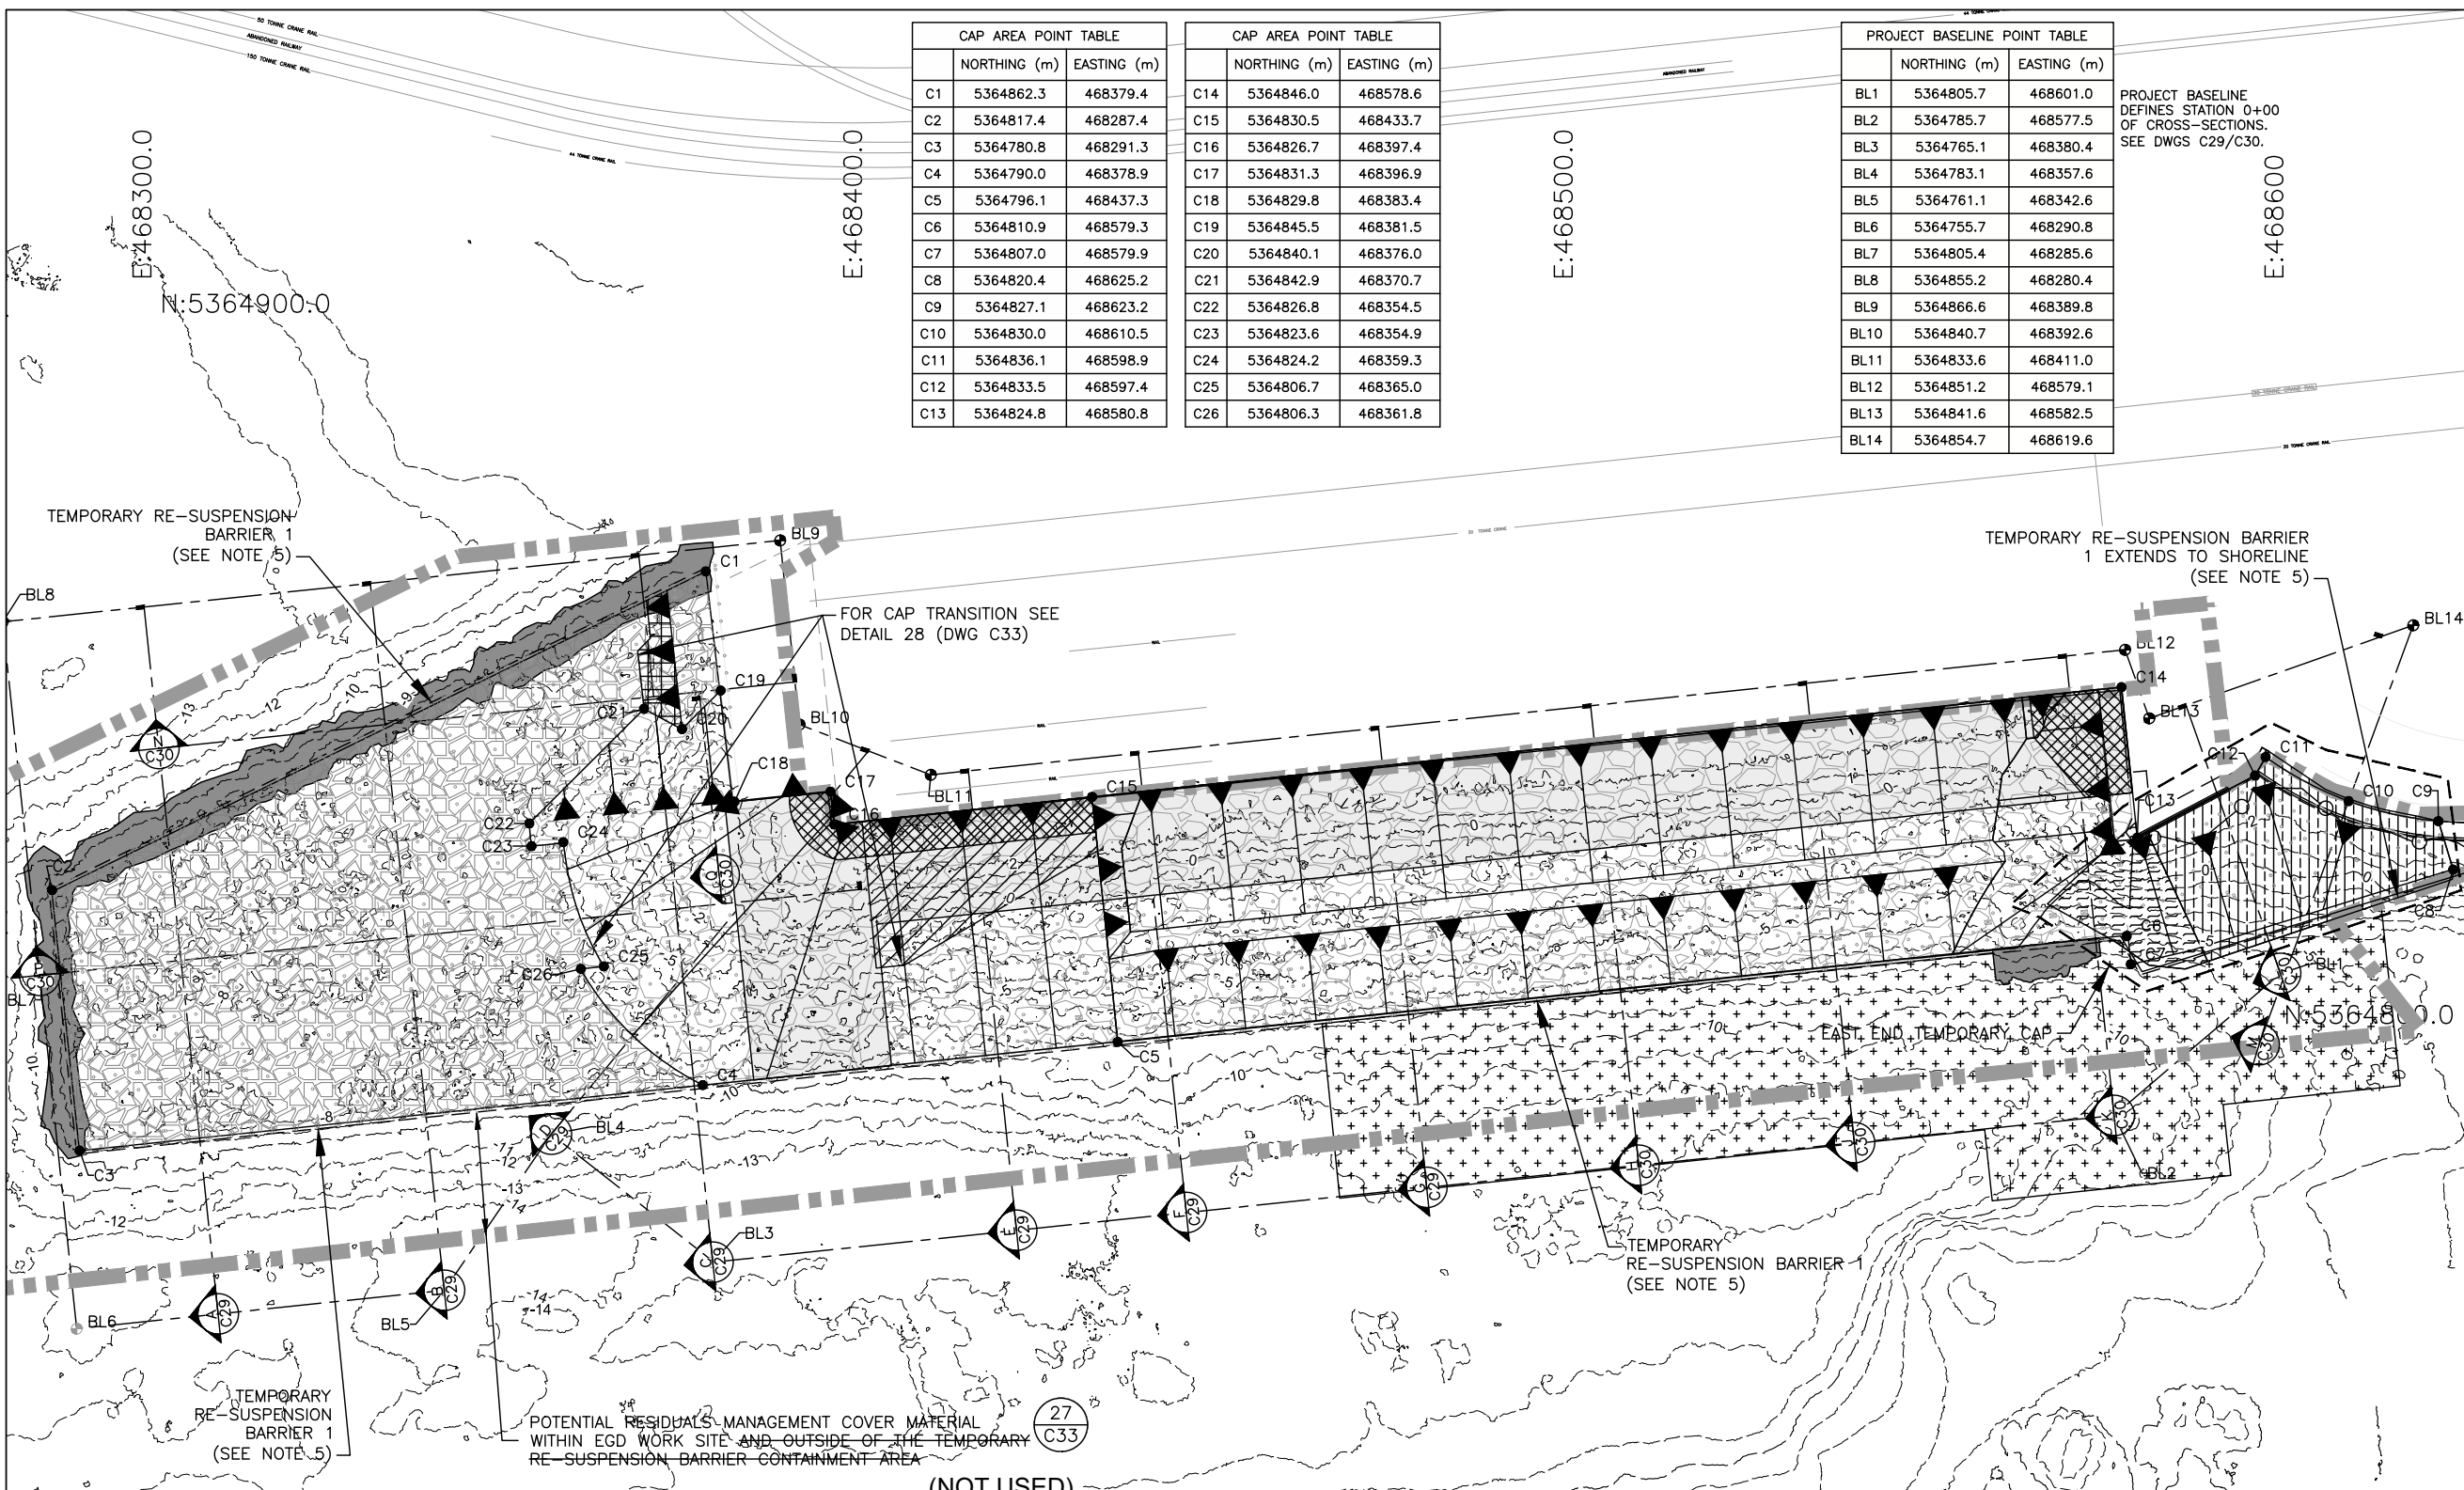

NOTES:


- BATHYMETRY OBTAINED FROM POST-CONSTRUCTION SURVEY DATED DECEMBER 27, 2016.
- BASE MAP FROM GOLDBER, JANUARY 2012.
- REFERENCE DWG C1 FOR DATUM INFORMATION.
- REFER TO TECHNICAL SPECIFICATIONS REGARDING WORK SEQUENCING AND REMEDIATION ZONES.
- CONTRACTOR (AND 3RD PARTY VENDOR) SHALL DESIGN, INSTALL AND MAINTAIN TRBS IN ACCORDANCE WITH THE SPECIFICATIONS. CONTRACTOR TO PROVIDE TRB LAYOUT AND DESIGN DETAILS IN THE ENVIRONMENTAL PROTECTION PLAN.
- TYPE 3 ENGINEERED CAP DESIGN REVISED TO REDUCE MINIMUM SAND AND FILTER MATERIAL THICKNESSES WITHIN 3 METRES OF THE FACE OF THE UPLAND BULKHEAD WALL IN ZONES 2 AND 3 AND UNDER THE CONCRETE DECK AREA AT WESTERN BOUNDARY OF ZONE 3.

LEGEND:

- POST-ENGINEERED CAPPING MATERIAL PLACEMENT BATHYMETRY IN METRES
- TEMPORARY RE-SUSPENSION BARRIER CONTAINMENT AREA (SEE DWG C32 FOR CONTROL POINTS)
- EGD WORK SITE BOUNDARY
- CAP SLOPE DESIGNATION
- ORDINARY HIGH WATER LINE
- EXISTING STEEL-PILE SUPPORTED CONCRETE DECK
- TYPE 1 ENGINEERED CAP: 0.15-METRE ROCK ARMOUR LAYER OVER FILTER LAYER OVER SAND (TYPE 1) LAYER. SEE DETAIL 22 (DWG C33)
- TYPE 2 ENGINEERED CAP: 0.15-METRE ROCK ARMOUR LAYER OVER FILTER LAYER OVER SAND (TYPE 2) LAYER. SEE DETAIL 23 (DWG C33)
- TYPE 3 ENGINEERED CAP: 0.30-METRE ROCK ARMOUR LAYER OVER FILTER LAYER OVER SAND (TYPE 2) LAYER. SEE DETAIL 24 (DWG C33)
- TYPE 4 ENGINEERED CAP: 0.30-METRE ROCK ARMOUR LAYER OVER FILTER LAYER OVER SAND (TYPE 3) LAYER. SEE DETAIL 25 (DWG C33)
- IMPERMEABLE GEOSYNTHETIC MATERIAL

CAPPING PLAN

SCALE 1: 500

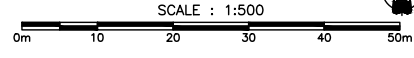

- BASE LINE CONTROL POINT
- CAPPING AREA CONTROL POINT
- 0.15M-METRE ROCK ARMOUR MATERIAL PLACEMENT AREA AT EAST END TEMPORARY CAP (0.3M MINIMUM REQUIRED THICKNESS AND 0.15M PAYABLE OVER-PLACEMENT ALLOWANCE)
- FILTER MATERIAL PLACEMENT AREA AT EAST END TEMPORARY CAP (0.3M MINIMUM REQUIRED THICKNESS AND 0.15M PAYABLE OVER-PLACEMENT ALLOWANCE)
- ADDITIONAL 0.30M ARMOUR ROCK SLOPE PROTECTION
- RMC MATERIAL PLACEMENT OUTSIDE THE TRBCA, SEE DETAIL 27 (DWG C33)

Revision/Revision	Description/Description	Date/Date
2	RECORD DRAWING	2017/03/31
1	ADDENDUM NO. 2	2015/03/20
0	ISSUED FOR TENDER	2014/12/10

Client/client: PUBLIC WORKS AND GOVERNMENT SERVICES CANADA

Project title/Titre du projet: ESQUIMALT GRAVING DOCK 825 ADMIRALS ROAD, VICTORIA, BC


ESQUIMALT GRAVING DOCK WATERLOT PHASE 2 SOUTH JETTY UNDER-PIER SEDIMENT REMEDIATION

Consultant Signature Only


Designed by/Concept par: MATT WOLTMAN
 Drawn by/Dessiné par: CHRIS HEWETT
 PWGSC Project Manager/Administrateur de Projets TPSGC: ANDREW MYLLY
 Regional Manager, Environmental Services/Gestionnaire régionale, Services d'architecture et de génie, TPSGC: COLLIN KINGMAN

Drawing title/Titre du dessin: **ENGINEERED CAPPING PLAN**


Project No./No. du projet	Sheet/Feuille	Revision no./La Révision no.
R.018400.002	C28	2

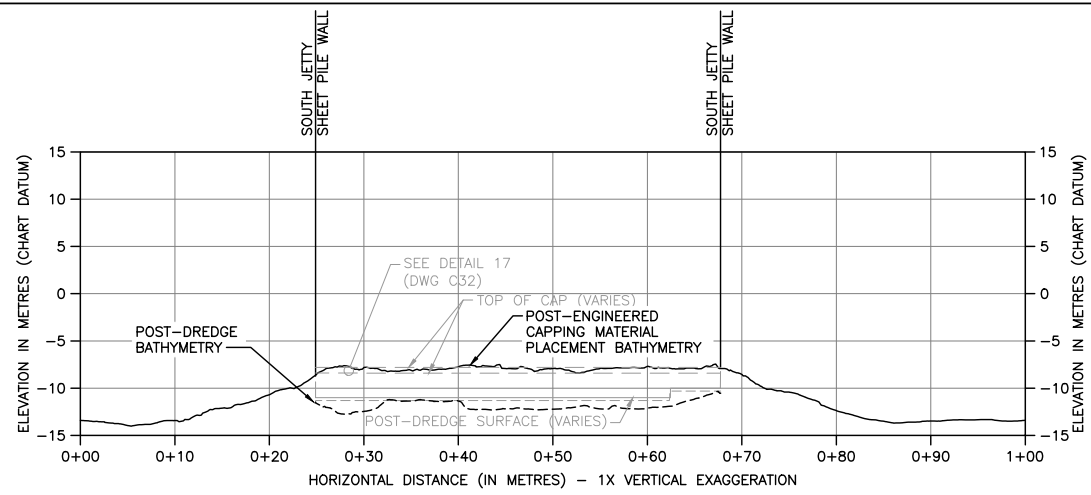


SECTION A
SCALE 1: 400
C28

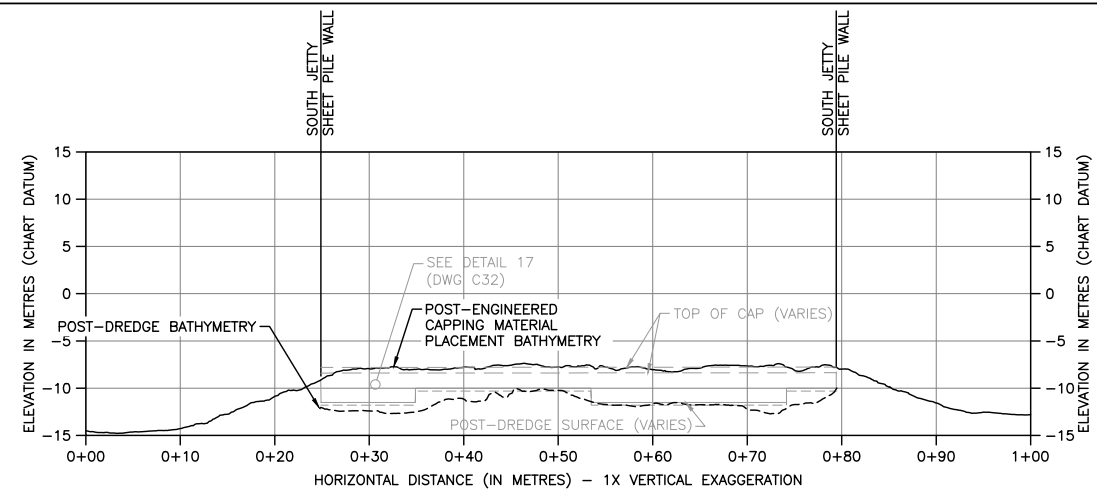


SECTION B
SCALE 1: 400
C28

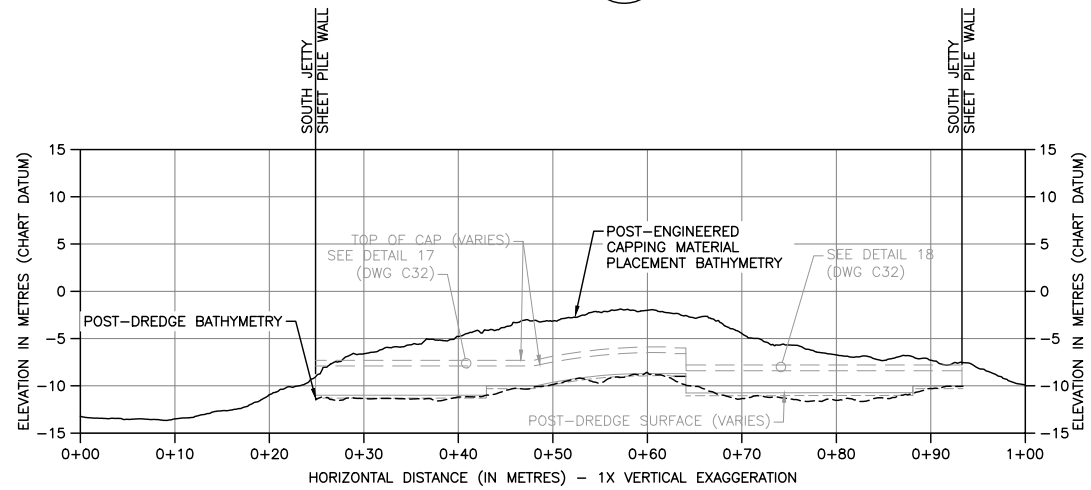


SECTION C
SCALE 1: 400
C28

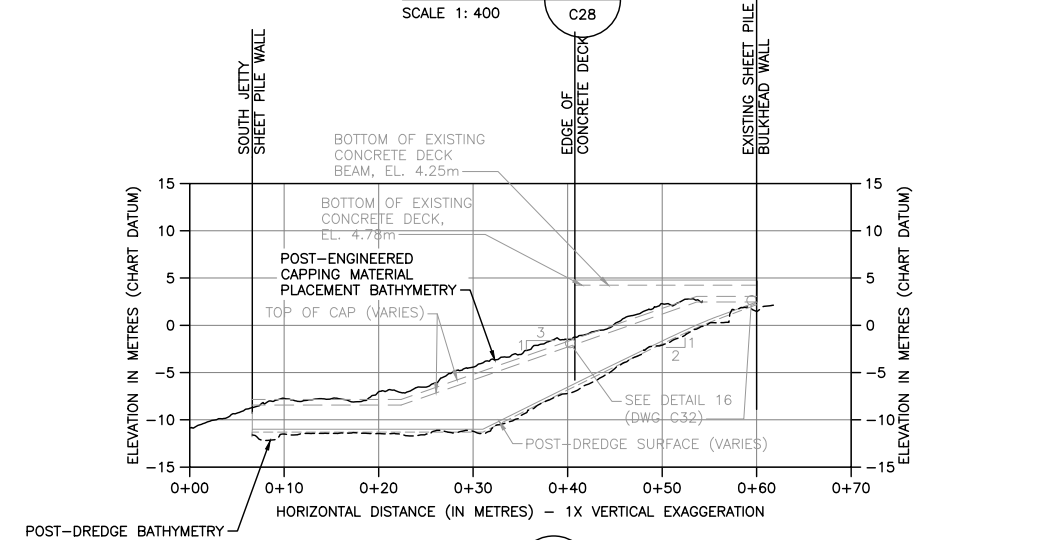


SECTION D
SCALE 1: 400
C28

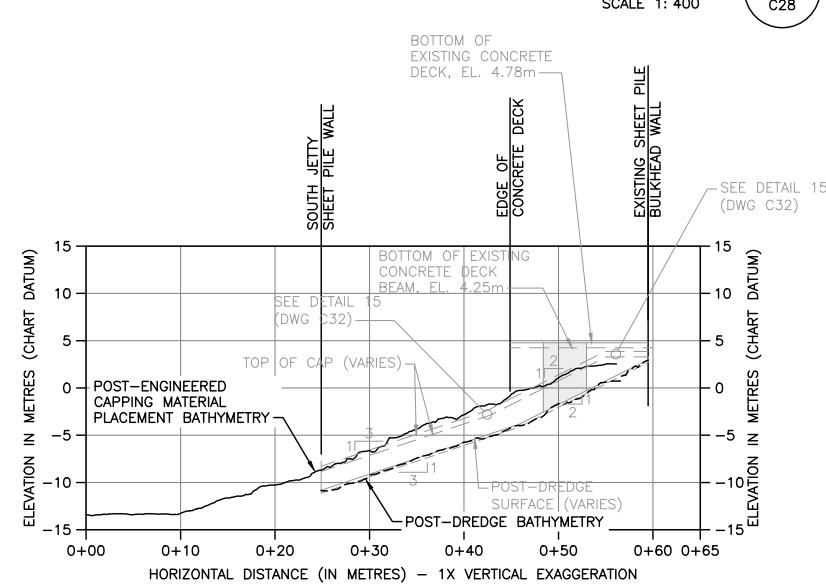

SECTION E
SCALE 1: 400
C28

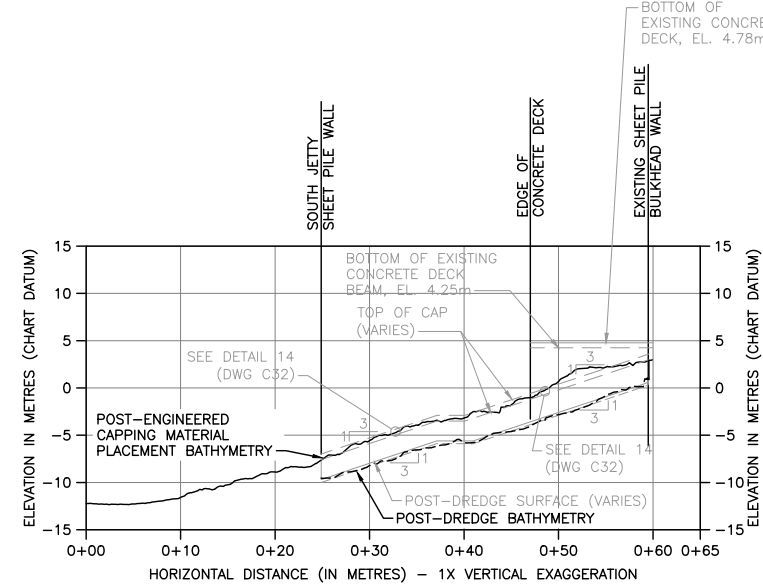

SECTION F
SCALE 1: 400
C28

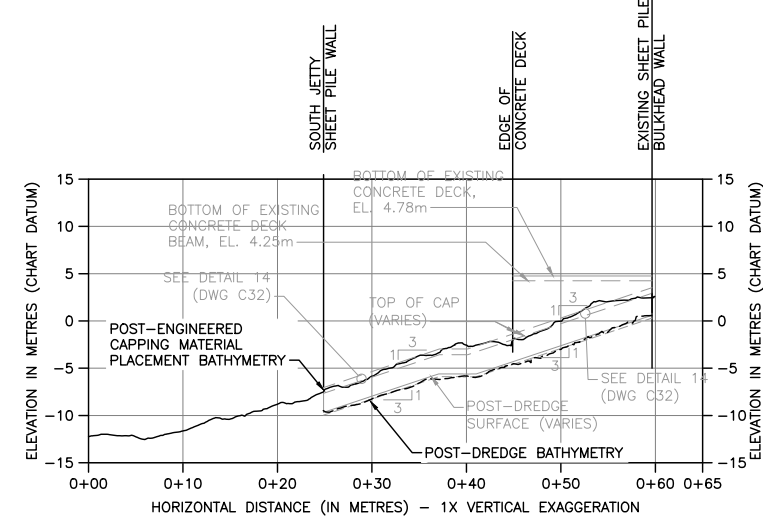

SECTION G
SCALE 1: 400
C28

CROSS SECTIONS
SCALE 1: 400

HORIZONTAL DATUM: UTM ZONE 10 GRID, NAD83.
VERTICAL DATUM: CHART DATUM (C.D.)

- NOTES:
- BATHYMETRY OBTAINED FROM POST-CONSTRUCTION SURVEY DATED DECEMBER 27, 2016.
 - REFERENCE DWG C1 FOR DATUM INFORMATION.
 - TOP OF DESIGN ENGINEERED CAP SURFACES REPRESENT MINIMUM THICKNESS AND MAXIMUM OVERPLACEMENT ALLOWANCES.
 - TOP OF DESIGN ENGINEERED CAP SHOWN ON CROSS SECTIONS IN 2H:1V DREDGE SLOPE AREAS OF THE AREAS OF WORK NEAR EXISTING SHEET PILE BULKHEAD WALL HAVE VARIABLE THICKNESS REQUIREMENTS THAT ARE NEEDED TO CONSTRUCT THE TYPE 3 SEDIMENT CAP TO A STABLE 3H:1V GRADE.
 - EXISTING TIMBER-PILED STRUCTURE NOT SHOWN FOR CLARITY.
 - CONTRACTOR SHALL REFERENCE THE 1985 STEEL-PILED DECK AS-BUILT DRAWINGS FOR DETAILS REGARDING CROSS SECTIONS THROUGH THE STEEL-PILED JETTY STRUCTURE, SHEETPILE BULKHEAD WALL, AND CONCRETE L-WALL.

Revision/Revision	Description/Description	Date/Date
2	RECORD DRAWING	2017/03/31
0	ISSUED FOR TENDER	2014/12/10

Client/client
PUBLIC WORKS AND GOVERNMENT SERVICES CANADA


Project title/Titre du projet
**ESQUIMALT GRAVING DOCK
825 ADMIRALS ROAD, VICTORIA, BC**


**ESQUIMALT GRAVING DOCK
WATERLOT PHASE 2
SOUTH JETTY UNDER-PIER
SEDIMENT REMEDIATION**

Consultant Signature Only
Designed by/Concept par
MATT WOLTMAN
Drawn by/Dessiné par
CHRIS HEWETT
PWSC Project Manager/Administrateur de Projets TPSC
ANDREW MYLLY
Regional Manager, Environmental Services
Gestionnaire régionale, Services d'architecture et de génie, TPSC
COLLIN KINGMAN


Drawing title/Titre du dessin
**ENGINEERED CAPPING
CROSS SECTIONS - SHEET 1**

Project No./No. du projet	Sheet/Feuille	Revision no./La Révision no.
R.018400.002	C29	1

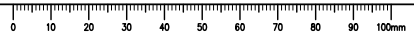


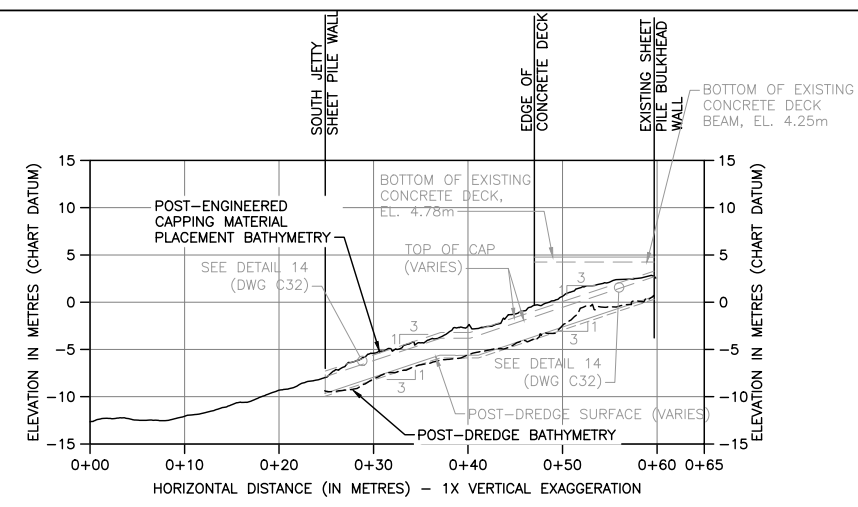


SECTION H SCALE 1: 400 C28

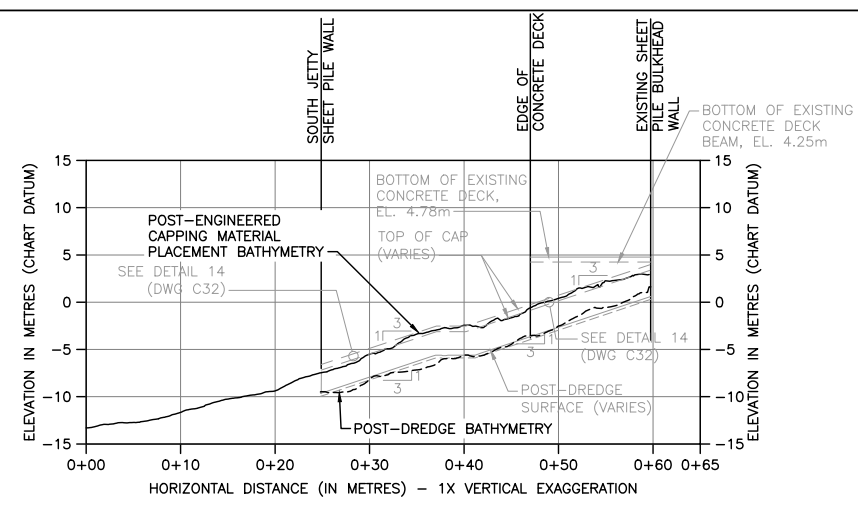


SECTION J SCALE 1: 400 C28

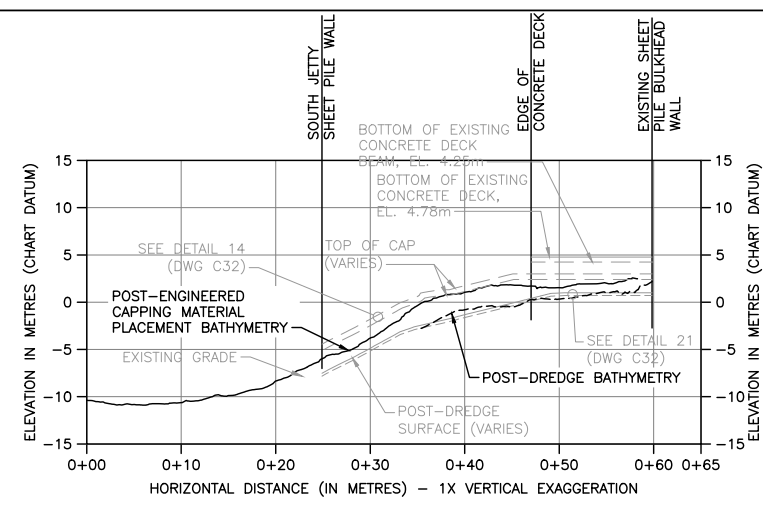


SECTION K SCALE 1: 400 C28

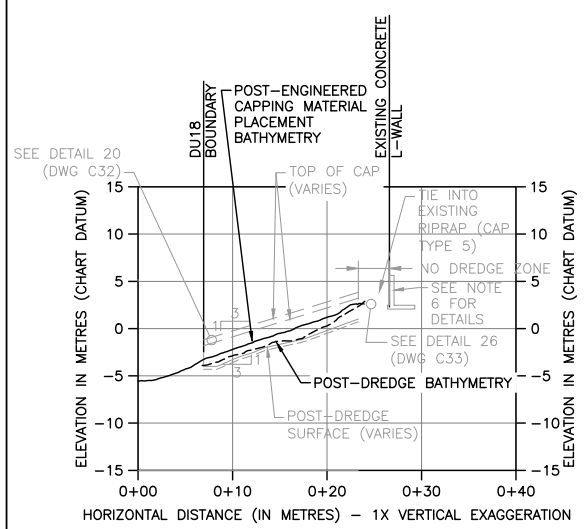


SECTION L SCALE 1: 400 C28

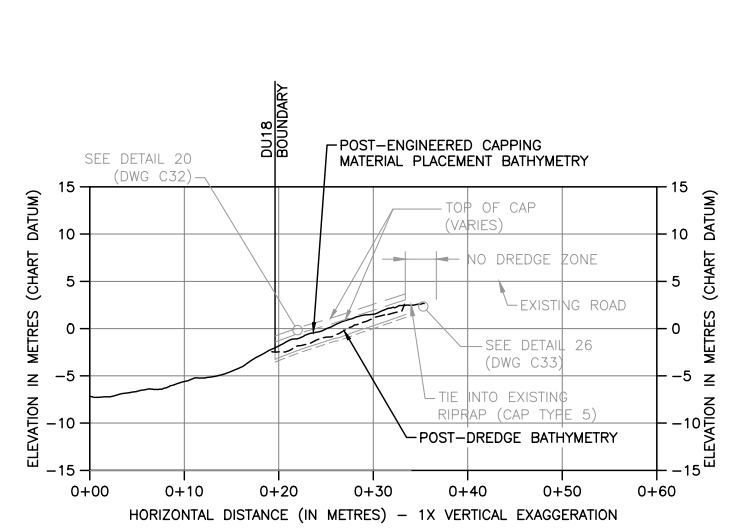


SECTION M SCALE 1: 400 C28

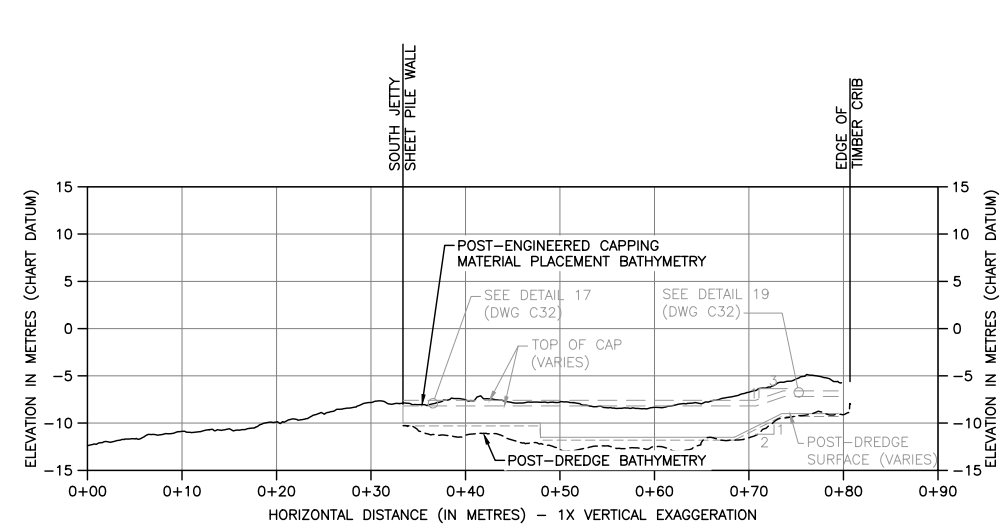

SECTION N SCALE 1: 400 C28

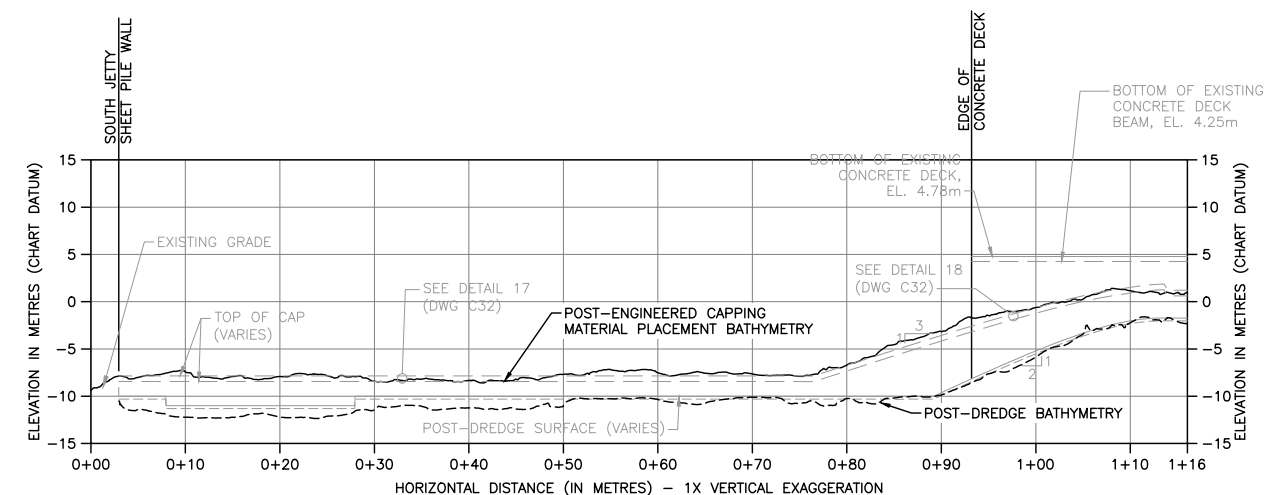

SECTION P SCALE 1: 400 C28

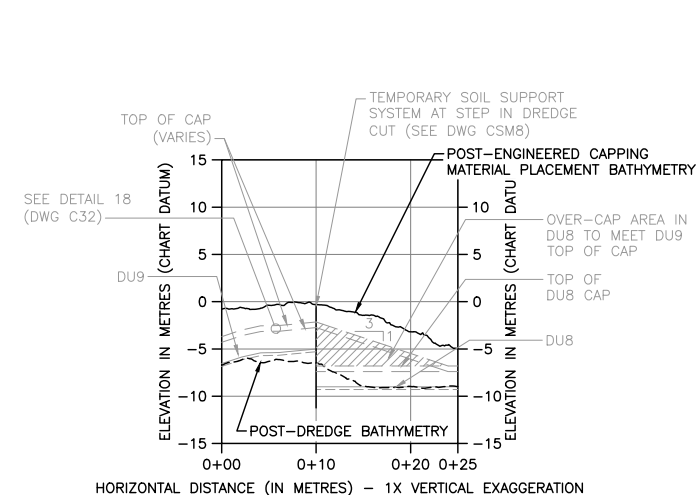

SECTION Q SCALE 1: 400 C28

HORIZONTAL DATUM: UTM ZONE 10 GRID, NAD83.
VERTICAL DATUM: CHART DATUM (C.D.)

- NOTES:
- BATHYMETRY OBTAINED FROM POST-CONSTRUCTION SURVEY DATED DECEMBER 27, 2016.
 - REFERENCE DWG C1 FOR DATUM INFORMATION.
 - TOP OF DESIGN ENGINEERED CAP SURFACES REPRESENT MINIMUM PLACEMENT THICKNESS AND MAXIMUM OVERPLACEMENT ALLOWANCES.
 - TOP OF DESIGN ENGINEERED CAP SHOWN ON CROSS SECTIONS IN 2H:1V DREDGE SLOPE AREAS OF THE AREAS OF WORK NEAR EXISTING SHEET PILE BULKHEAD WALL HAVE VARIABLE THICKNESS REQUIREMENTS THAT ARE NEEDED TO CONSTRUCT THE TYPE 3 SEDIMENT CAP TO A STABLE 3H:1V GRADE.
 - EXISTING TIMBER-PILED STRUCTURE NOT SHOWN FOR CLARITY.
 - CONTRACTOR SHALL REFER TO THE 1985 STEEL-PILED DECK AS-BUILT DRAWINGS FOR DETAILS REGARDING CROSS SECTIONS THROUGH THE STEEL-PILED JETTY STRUCTURE, SHEETPILE BULKHEAD WALL, AND CONCRETE L-WALL.

CROSS SECTIONS
SCALE 1: 400

Revision/	Description/Description	Date/Date
1	RECORD DRAWING	2017/03/31
0	ISSUED FOR TENDER	2014/12/10

Client/client
PUBLIC WORKS AND GOVERNMENT SERVICES CANADA


Project title/Titre du projet
**ESQUIMALT GRAVING DOCK
825 ADMIRALS ROAD, VICTORIA, BC**


**ESQUIMALT GRAVING DOCK
WATERLOT PHASE 2
SOUTH JETTY UNDER-PIER
SEDIMENT REMEDIATION**

Consultant Signature Only
Designed by/Concept par MATT WOLTMAN
Drawn by/Dessiné par CHRIS HEWETT
PWSC Project Manager/Administrateur de Projets TPSC ANDREW MYLLY
Regional Manager, Environmental Services Gestionnaire régionale, Services d'architecture et de génie, TPSC COLLIN KINGMAN


Drawing title/Titre du dessin
**ENGINEERED CAPPING
CROSS SECTIONS - SHEET 2**

Project No./No. du projet	Sheet/Feuille	Revision no./La Révision no.
R.018400.002	C30	1

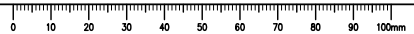


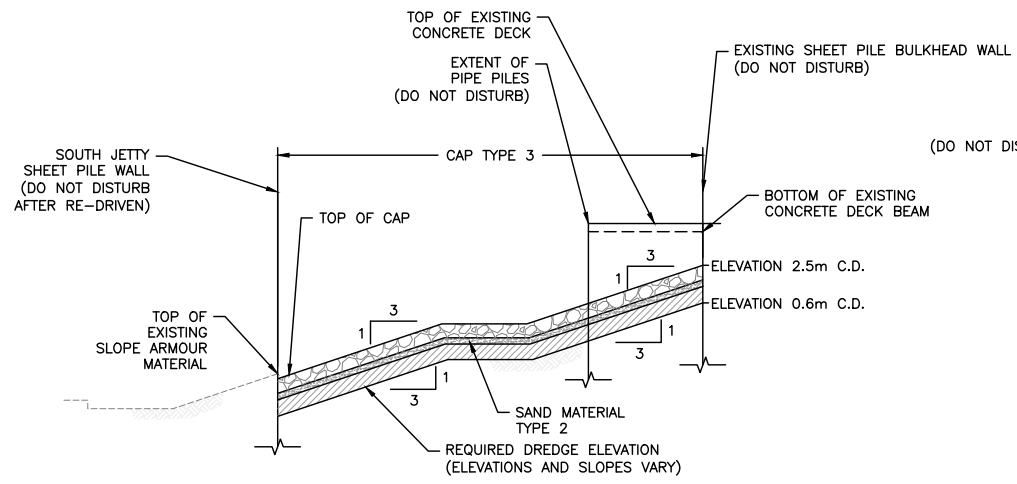


DETAIL 14
NOT TO SCALE
C29/C30
TYPE 3 ENGINEERED CAP

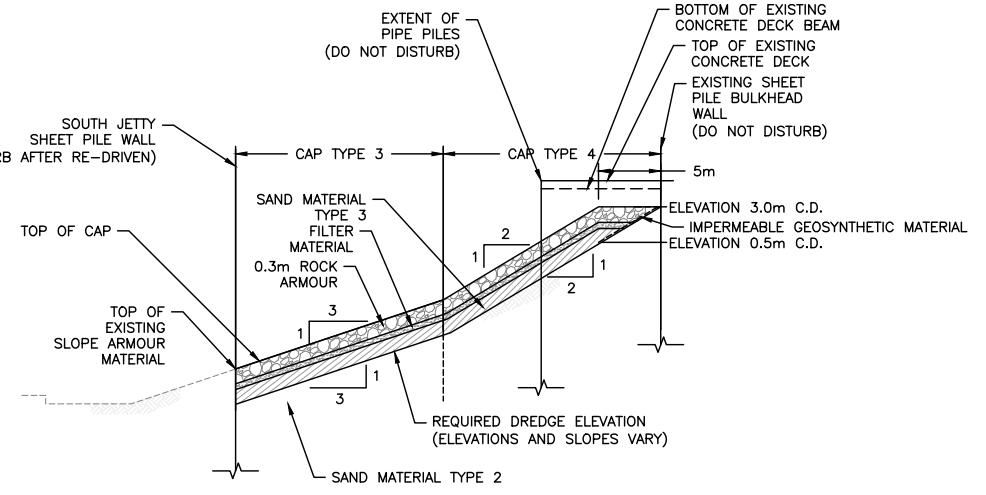


DETAIL 15
NOT TO SCALE
C29
TYPE 3 AND TYPE 4 ENGINEERED CAP AND IMPERMEABLE GEOSYNTHETIC MATERIAL
NOTE: IMPERMEABLE GEOSYNTHETIC MATERIAL REQUIRED FOR CAP TYPE 4 WHERE SAND MATERIAL TYPE 3 HAS A THICKNESS OF LESS THAN 1.0m NEAR EXISTING SHEET PILE BULKHEAD WALL.

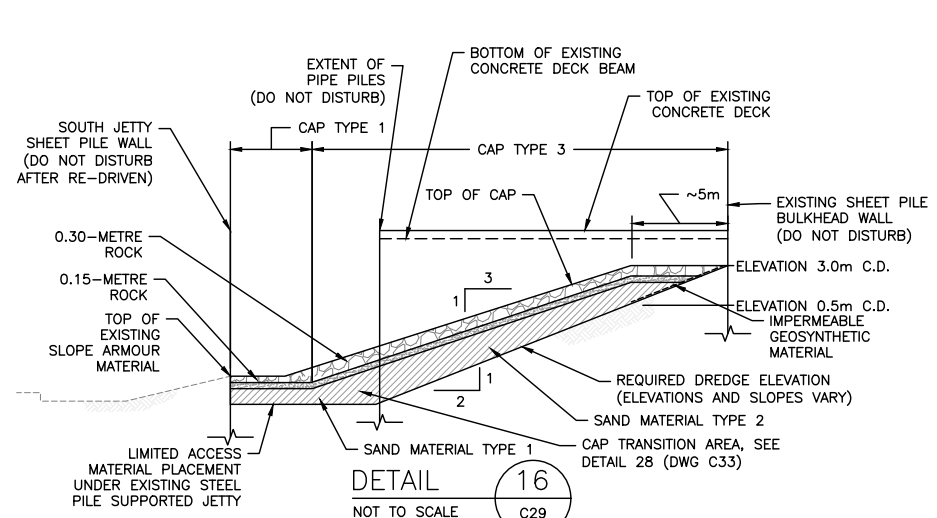


DETAIL 16
NOT TO SCALE
C29
TYPE 1 AND TYPE 3 ENGINEERED CAP
NOTES:
1. IMPERMEABLE GEOSYNTHETIC MATERIAL REQUIRED FOR CAP TYPE 3 WHERE SAND MATERIAL TYPE 2 HAS A THICKNESS OF LESS THAN 1.0m NEAR EXISTING SHEET PILE BULKHEAD WALL.
2. CONTRACTOR SHALL PLACE A MINIMUM OF 1m OF SAND MATERIAL OVER ALL DREDGE AREAS EXCLUDING AREA REQUIRING IMPERMEABLE GEOSYNTHETIC MATERIAL.

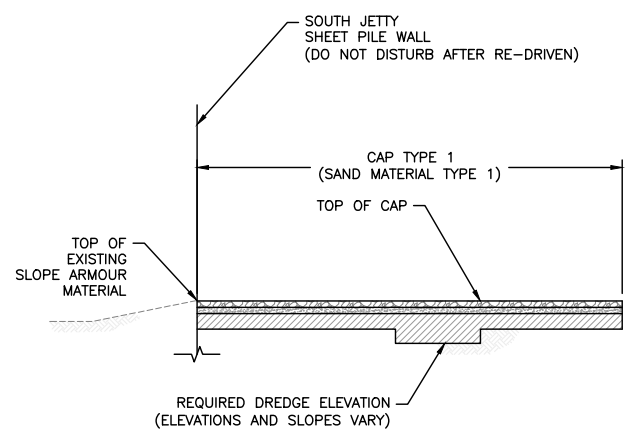


DETAIL 17
NOT TO SCALE
C29/C30
TYPE 1 ENGINEERED CAP

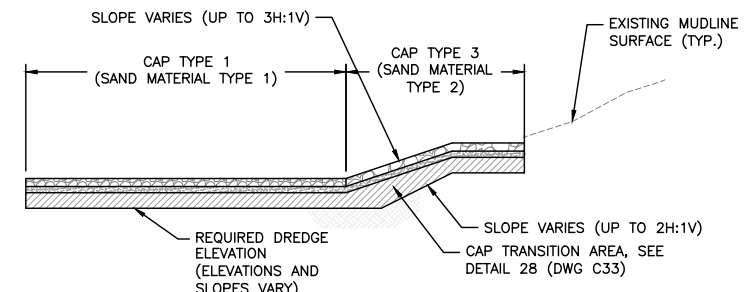


DETAIL 18
NOT TO SCALE
C29/C30
TYPE 1 AND TYPE 3 ENGINEERED CAP

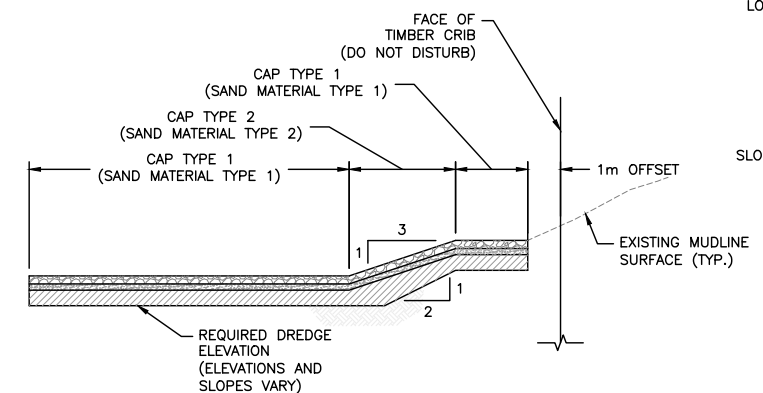

DETAIL 19
NOT TO SCALE
C30
TYPE 1 ENGINEERED CAP

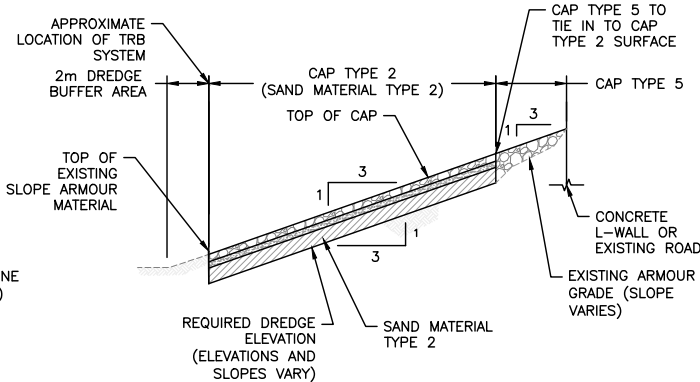

DETAIL 20
NOT TO SCALE
C30
TYPE 2 AND TYPE 5 ENGINEERED CAP

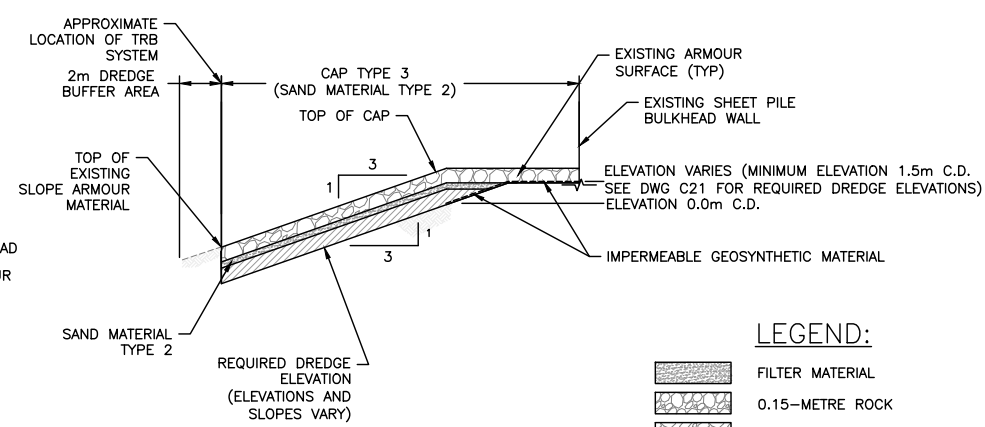

DETAIL 21
NOT TO SCALE
C30
TYPE 3 ENGINEERED CAP

LEGEND:

	FILTER MATERIAL
	0.15-METRE ROCK
	0.30-METRE ROCK
	SAND LAYER

NOTES:
1. EXISTING TIMBER-PILED STRUCTURE NOT SHOWN FOR CLARITY.
2. CONTRACTOR SHALL REFERENCE THE 1985 STEEL-PILES DECK AS-BUILT DRAWINGS FOR DETAILS REGARDING CROSS SECTIONS THROUGH THE STEEL-PILED JETTY STRUCTURE, SHEETPILE BULKHEAD WALL, AND CONCRETE L-WALL.

Revision/Revision	Description/Description	Date/Date
1	RECORD DRAWING	2017/03/31
0	ISSUED FOR TENDER	2014/12/18


Client/client
PUBLIC WORKS AND GOVERNMENT SERVICES CANADA

Project title/Titre du projet
**ESQUIMALT GRAVING DOCK
825 ADMIRALS ROAD, VICTORIA, BC**

**ESQUIMALT GRAVING DOCK
WATERLOT PHASE 2
SOUTH JETTY UNDER-PIER
SEDIMENT REMEDIATION**

Consultant Signature Only
Designed by/Concept par
MATT WOLTMAN
Drawn by/Dessiné par
CHRIS HEWETT
PWGSC Project Manager/Administrateur de Projets TPSGC
ANDREW MYLLY
Regional Manager, Environmental Services
COLLIN KINGMAN
Drawing title/Titre du dessin
ENGINEERED CAPPING DETAILS - SHEET 1


Project No./No. du projet R.018400.002	Sheet/ C32	Revision no./ 1
--------------------------------------------------	----------------------	---------------------------

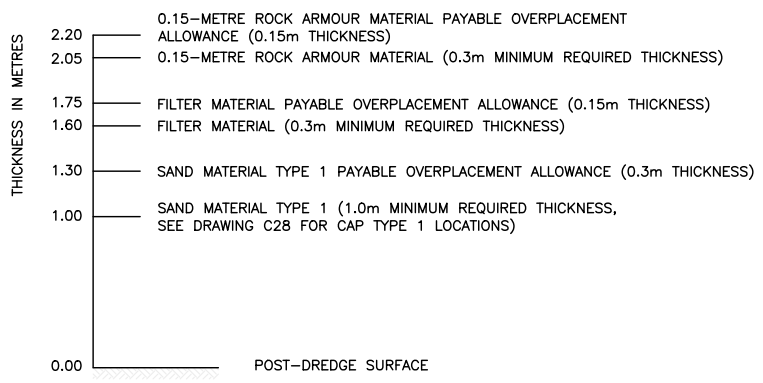

TYPE 1 ENGINEERED CAP: 0.15-METRE ROCK ARMOUR LAYER OVER FILTER MATERIAL OVER SAND LAYER

DETAIL 22 NOT TO SCALE C28


NOTE: MINIMUM REQUIRED THICKNESS AND PAYABLE OVERPLACEMENT ALLOWANCES SHOWN ON THE DETAIL REPRESENT GENERAL CONDITIONS REQUIRED TO MEET THE DESIGN AND GRADES AND ELEVATION REQUIREMENTS FOR PLACEMENT OF CAP TYPE 1 MATERIALS. THE MINIMUM REQUIRED THICKNESS AND PAYABLE OVERPLACEMENT ALLOWANCE FOR TYPE 1 SAND MATERIAL SHALL BE INCREASED IN SELECT AREAS OF THE EGD WORK SITE WHERE PLACEMENT OF ADDITIONAL TYPE 1 SAND MATERIAL IS REQUIRED TO MEET THE DESIGN GRADES AND ELEVATIONS SHOWN ON THE DRAWINGS. THE DEPARTMENTAL REPRESENTATIVE MAY DIRECT THE CONTRACTOR TO REMOVE EXCESSIVE OVERPLACEMENT MATERIAL THAT IS PLACED ABOVE THE DESIGN GRADES AND ELEVATIONS AT NO ADDITIONAL COST TO PWGSC.

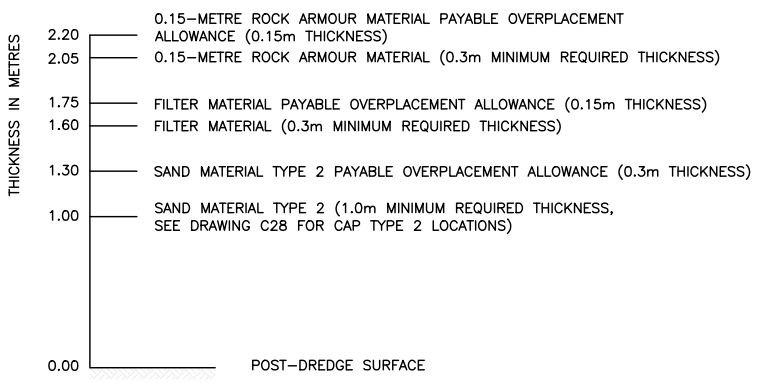

TYPE 2 ENGINEERED CAP: 0.15-METRE ROCK ARMOUR LAYER OVER FILTER MATERIAL OVER SAND LAYER

DETAIL 23 NOT TO SCALE C28


NOTE: MINIMUM REQUIRED THICKNESS AND PAYABLE OVERPLACEMENT ALLOWANCES SHOWN ON THE DETAIL REPRESENT GENERAL CONDITIONS REQUIRED TO MEET THE DESIGN AND GRADES AND ELEVATION REQUIREMENTS FOR PLACEMENT OF CAP TYPE 2 MATERIALS. THE MINIMUM REQUIRED THICKNESS AND PAYABLE OVERPLACEMENT ALLOWANCE FOR TYPE 2 SAND MATERIAL SHALL BE INCREASED IN SELECT AREAS OF THE EGD WORK SITE WHERE PLACEMENT OF ADDITIONAL TYPE 2 SAND MATERIAL IS REQUIRED TO MEET THE DESIGN GRADES AND ELEVATIONS SHOWN ON THE DRAWINGS. THE DEPARTMENTAL REPRESENTATIVE MAY DIRECT THE CONTRACTOR TO REMOVE EXCESSIVE OVERPLACEMENT MATERIAL THAT IS PLACED ABOVE THE DESIGN GRADES AND ELEVATIONS AT NO ADDITIONAL COST TO PWGSC.

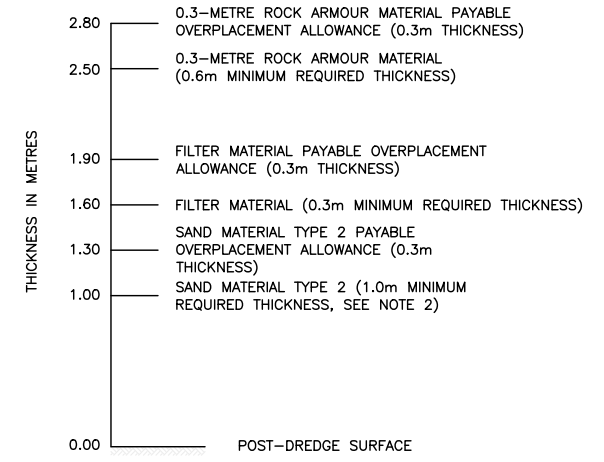

TYPE 3 ENGINEERED CAP: 0.30-METRE ROCK ARMOUR LAYER OVER FILTER MATERIAL OVER SAND MATERIAL TYPE 2 LAYER

DETAIL 24 NOT TO SCALE C28


NOTES:
 1. MINIMUM REQUIRED THICKNESS AND PAYABLE OVERPLACEMENT ALLOWANCES SHOWN ON THE DETAIL REPRESENT GENERAL CONDITIONS REQUIRED TO MEET THE DESIGN AND GRADES AND ELEVATION REQUIREMENTS FOR PLACEMENT OF CAP TYPE 3 MATERIALS (EXCLUDING AREAS REQUIRING IMPERMEABLE GEOSYNTHETIC MATERIAL). THE MINIMUM REQUIRED THICKNESS AND PAYABLE OVERPLACEMENT ALLOWANCE FOR TYPE 2 SAND MATERIAL SHALL BE INCREASED IN SELECT AREAS OF THE EGD WORK SITE WHERE PLACEMENT OF ADDITIONAL TYPE 2 SAND MATERIAL IS REQUIRED TO MEET THE DESIGN GRADES AND ELEVATIONS SHOWN ON THE DRAWINGS. THE DEPARTMENTAL REPRESENTATIVE MAY DIRECT THE CONTRACTOR TO REMOVE EXCESSIVE OVERPLACEMENT MATERIAL THAT IS PLACED ABOVE THE DESIGN GRADES AND ELEVATIONS AT NO ADDITIONAL COST TO PWGSC.
 2. REQUIRED THICKNESS OF SAND MATERIAL TYPE 3 VARIES BETWEEN 0.0 AND 1.0m IN AREAS REQUIRING IMPERMEABLE GEOSYNTHETIC MATERIAL NEAR EXISTING SHEET PILE BULKHEAD WALL.
 3. REQUIRED THICKNESS OF FILTER MATERIAL VARIES BETWEEN 0.0 AND 0.3m IN AREAS REQUIRING IMPERMEABLE GEOSYNTHETIC MATERIAL NEAR EXISTING SHEETPILE BULKHEAD.
 4. SEE NOTE 6 ON DWG C28.

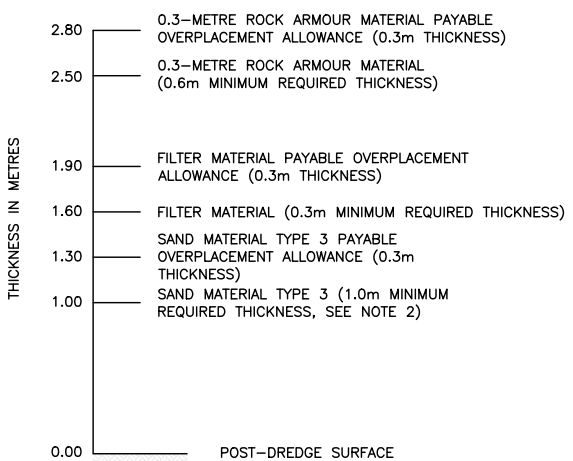

TYPE 4 ENGINEERED CAP: 0.30-METRE ROCK ARMOUR LAYER OVER FILTER MATERIAL OVER SAND MATERIAL TYPE 3 LAYER

DETAIL 25 NOT TO SCALE C28


NOTES:
 1. TOTAL ENGINEERED CAP PLACEMENT THICKNESS CAN VARY BETWEEN A MINIMUM TOTAL THICKNESS OF 1.9m (EXCLUDING AREAS REQUIRING IMPERMEABLE GEOSYNTHETIC MATERIAL) AND UP TO 2.8m THICKNESS AND WILL BE PAYABLE. ADDITIONAL PLACEMENT ABOVE 2.8m WILL BE CONSIDERED EXCESSIVE OVERPLACEMENT AND WILL NOT BE PAID. THE DEPARTMENTAL REPRESENTATIVE MAY DIRECT THE CONTRACTOR TO REMOVE EXCESSIVE OVERPLACEMENT AT NO ADDITIONAL COST TO PWGSC.
 2. REQUIRED THICKNESS OF SAND MATERIAL TYPE 2 VARIES BETWEEN 0.0 AND 1.0m IN AREAS REQUIRING IMPERMEABLE GEOSYNTHETIC MATERIAL NEAR EXISTING SHEET PILE BULKHEAD WALL.
 3. REQUIRED THICKNESS OF FILTER MATERIAL VARIES BETWEEN 0.0 AND 0.3m IN AREAS REQUIRING IMPERMEABLE GEOSYNTHETIC MATERIAL NEAR EXISTING SHEETPILE BULKHEAD.

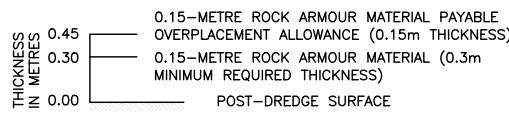

TYPE 5 ENGINEERED CAP: 0.15-METRE ROCK ARMOUR


DETAIL 26 NOT TO SCALE C28/C30

NOTE: TOTAL ENGINEERED CAP PLACEMENT THICKNESS CAN VARY BETWEEN A MINIMUM TOTAL THICKNESS OF 0.0m AND UP TO 0.45m THICKNESS AND WILL BE PAYABLE. ADDITIONAL PLACEMENT ABOVE 0.45m WILL BE CONSIDERED EXCESSIVE OVERPLACEMENT AND WILL NOT BE PAID. THE DEPARTMENTAL REPRESENTATIVE MAY DIRECT THE CONTRACTOR TO REMOVE EXCESSIVE OVERPLACEMENT AT NO ADDITIONAL COST TO PWGSC.

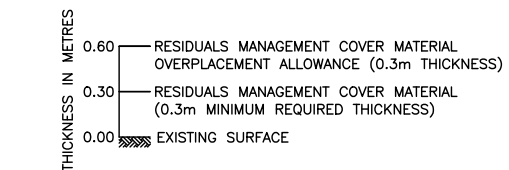

RESIDUALS MANAGEMENT COVER PLACEMENT

DETAIL 27 NOT TO SCALE C28

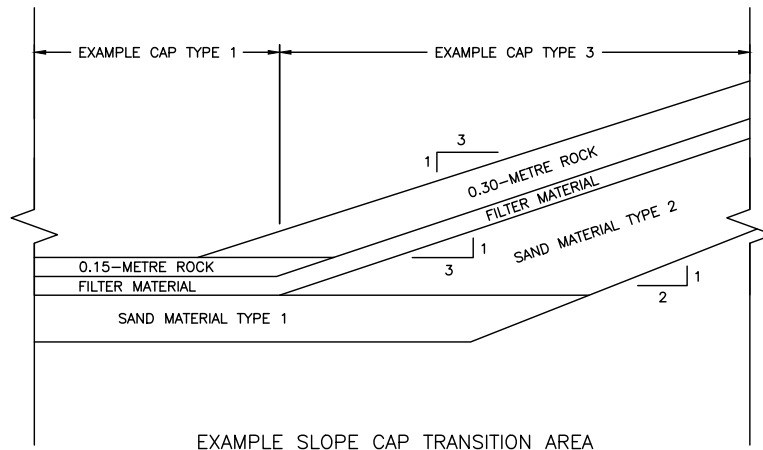

EXAMPLE SLOPE CAP TRANSITION AREA

DETAIL 28 NOT TO SCALE C32

NOTES:
 1. CONTRACTOR SHALL DESCRIBE SEQUENCING OF CAP LAYER PLACEMENT AS PART OF THE CONSTRUCTION WORK PLAN.
 2. CONTRACTOR SHALL PLACE A MINIMUM OF 1m OF SAND MATERIAL OVER ALL DREDGE AREAS EXCLUDING AREAS REQUIRING IMPERMEABLE GEOSYNTHETIC MATERIAL.

Revision/Revision	Description/Description	Date/Date
2	RECORD DRAWING	2017/03/31
1	ADDENDUM NO. 2	2015/03/20
0	ISSUED FOR TENDER	2014/12/19

Client/client
PUBLIC WORKS AND GOVERNMENT SERVICES CANADA

Project title/Titre du projet
**ESQUIMALT GRAVING DOCK
 825 ADMIRALS ROAD, VICTORIA, BC**

**ESQUIMALT GRAVING DOCK
 WATERLOT PHASE 2
 SOUTH JETTY UNDER-PIER
 SEDIMENT REMEDIATION**

Consultant Signature Only

Designed by/Concept par
 MATT WOLTMAN


Drawn by/Dessiné par
 CHRIS HEWETT

PWGSC Project Manager/Administrateur de Projets TPSCG
 ANDREW MYLLY

Regional Manager, Environmental Services
 COLLIN KINGMAN


Drawing title/Titre du dessin
ENGINEERED CAPPING DETAILS - SHEET 2

Project No./No. du projet R.018400.002	Sheet/ C33	Revision no./ 2
-------------------------------------------	---------------	--------------------

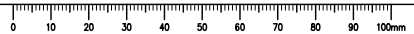


NOT INSTALLED


NOT INSTALLED

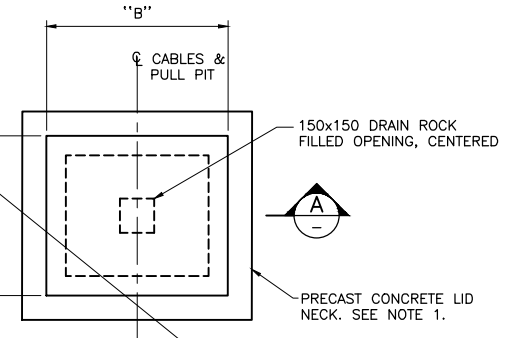

DETAIL 2
SCALE: N.T.S. E12

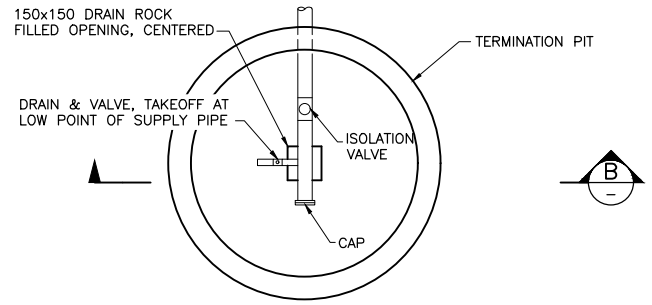


DETAIL 1 1
SCALE: N.T.S. M6 M8

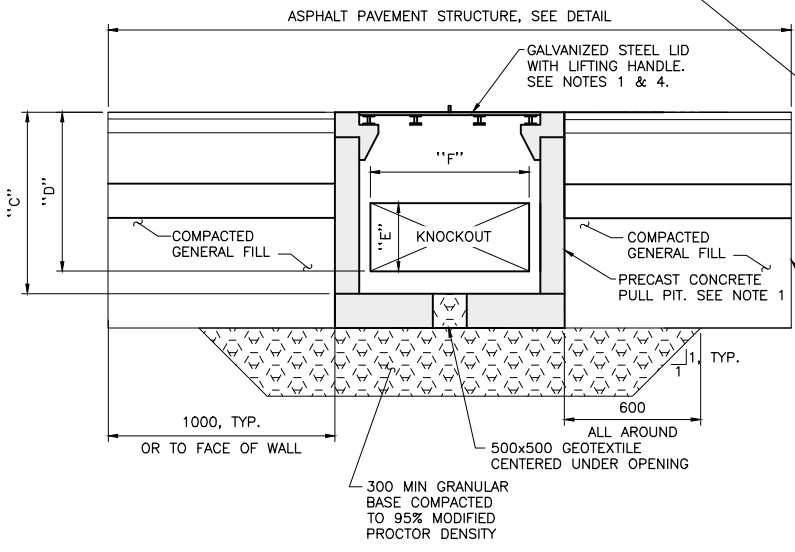

SECTION A
SCALE: N.T.S.

TYPICAL PRECAST CONCRETE PULL PIT

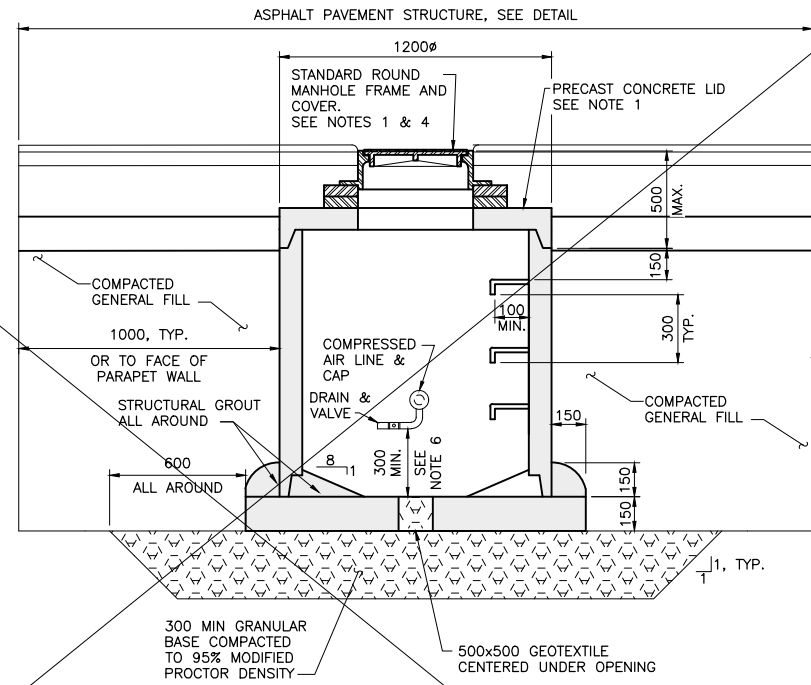


SECTION B
SCALE: N.T.S.

TYPICAL 1200mm PRECAST CONCRETE TERMINATION PIT T6 & T7

COMPRESSED AIR TERMINATION PIT (T6) PROVIDED TO PWGSC. INSTALLATION OF PIT T6 NOT IN CONTRACT.

TERMINATION LOCATION	"A"	"B"	"C"	"D"	"E"	"F"
T1	700	900	800	700	300	800
T2	1000	1600	800	700	300	1500
T3	400	400	800	700	200	300
T4	1000	700	600	500	300	600
T5	700	1200	600	500	300	1100

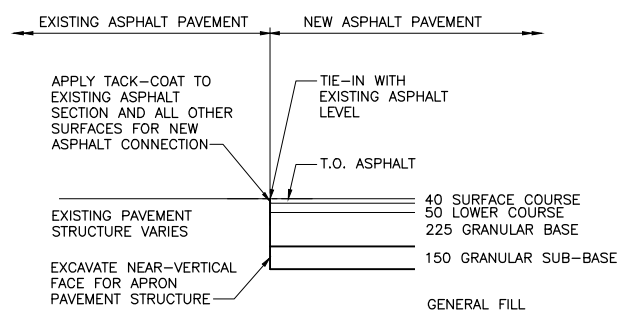

ASPHALT PAVEMENT STRUCTURE TIE-IN
N.T.S.

NOTES:

- ALL TERMINATION PIT AND PULL PIT COMPONENTS, INCLUDING LIDS, MANHOLE FRAME AND COVER, AND PRECAST CONCRETE COMPONENTS SHALL BE DESIGNED FOR THE FOLLOWING SITE-SPECIFIC LIVE LOADS (ALL LOADS ARE UNFACTORED):
 - UNIFORMLY DISTRIBUTED LOAD (UDL): 28.7kPa (600psf)
 - UDL NEED NOT BE CONSIDERED COINCIDENT WITH VEHICLE WHEEL LOADS
 - AXLE LOADING:
 - TRUCK LOADING (CL-625 PER S6-06):
 - FRONT AXLE 50kN (DISTRIBUTED TO 2 WHEELS)
 - REAR AXLE 175kN (DISTRIBUTED TO 2 PAIRS OF WHEELS)
 - ESQUIMALT FIRE TRUCK (TYPE 1), 1993 THIBAUT ENGINE:
 - FRONT AXLE 75kN (DISTRIBUTED TO 2 WHEELS)
 - REAR AXLES 100kN (DISTRIBUTED TO 2 PAIRS OF WHEELS)
 - ESQUIMALT FIRE TRUCK (TYPE 2), 1999 E ONE LADDER TRUCK:
 - FRONT AXLE 85kN (DISTRIBUTED TO 2 WHEELS)
 - REAR AXLES 210kN (DISTRIBUTED TO 2 PAIRS OF WHEELS)
 - ESQUIMALT FIRE TRUCK (TYPE 3), 2008 FORT GARY RESCUE TRUCK:
 - FRONT AXLE 55kN (DISTRIBUTED TO 2 WHEELS)
 - REAR AXLES 105kN (DISTRIBUTED TO 2 PAIRS OF WHEELS)
 DYNAMIC LOAD ALLOWANCE (DLA) SHOULD BE ADDED TO ALL AXLE/WHEEL LOADS.
- SEAL ALL CONDUIT ENDS IN TERMINATION PIT WITH SUITABLE COMPOUND TO PREVENT ENTRANCE OF SALT WATER, MOISTURE OR GASES.
- LOCATIONS FOR TERMINATION PITS AND PULL PITS SHOWN ON DRAWINGS ARE APPROXIMATE. CONTRACTOR SHALL LOCATE BASED ON SITE CONDITIONS AND COORDINATE WITH DEPARTMENTAL REPRESENTATIVE PRIOR TO COMMENCEMENT OF THIS WORK.
- TERMINATION PIT COVERS AND PULL PIT COVERS SHALL BEAR CLEAR MARKING NOT LESS THAN 100mm IN SIZE INDICATING THE SERVICE CONTAINED USING THE FOLLOWING LEGEND: "AIR" COMPRESSED AIR, "ELEC" ELECTRICAL.
- CONTRACTOR TO LOCATE AND PROTECT ADJACENT ELECTRICAL CONDUITS DURING EXCAVATION WORK.
- COMPRESSED AIR SHALL BE A MINIMUM OF 300mm ABOVE THE BOTTOM OF THE TERMINATION PIT. LOCAL ADJUSTMENT TO ELEVATION OF COMPRESSED AIR SHALL BE MADE IF NECESSARY.

Revision/Revision	Description/Description	Date/Date
1	RECORD DRAWING	2017/03/29
0	ISSUED FOR TENDER	2014/12/19

PUBLIC WORKS AND GOVERNMENT SERVICES CANADA

Project title/Titre du projet
ESQUIMALT GRAVING DOCK
825 ADMIRALS ROAD, VICTORIA, BC

ESQUIMALT GRAVING DOCK WATERLOT PHASE 2
SOUTH JETTY UNDER-PIER
SEDIMENT REMEDIATION

Designed by/Concept par
DHILEEP ABEYGODA
Drawn by/Desain par
MIKE BRIDDEN
PWGSC Project Manager/Administrateur de Projets TPSGC
ANDREW MYLLY
Regional Manager, Environmental Services
COLLIN KINGMAN

Drawing title/Titre du dessin
SERVICES - TERMINATION PITS

Project No./No. du projet R.018400.002	Sheet/ C46	Revision no./ 1
-------------------------------------------	---------------	--------------------



PHOTO C47-01 EAST APPROACH STRUCTURE AND CONCRETE L-WALL - NOTE TIMBER BENT AND PILE CAP



PHOTO C47-02 UTILITIES TERMINATED AND CAPPED AT FACE OF CONCRETE L-WALL - NOTE TEMPORARY ELECTRICAL SERVICE TERMINATED WITH JUNCTION BOX AT DECK LEVEL



PHOTO C47-03 REMOVED MECHANICAL KIOSKS



PHOTO C47-04 NAVIGATIONAL DOLPHINS AND CORNER DOLPHIN AT THE NORTHWEST FACE OF THE TIMBER CRIB

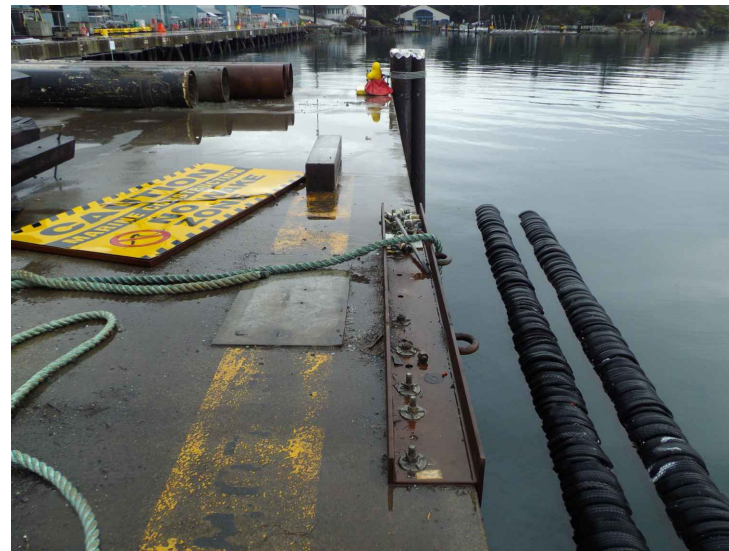


PHOTO C47-05 PILED DECK CRANE PAD SOUTH FACE - NOTE CORNER DOLPHIN AND STEEL BRACKET

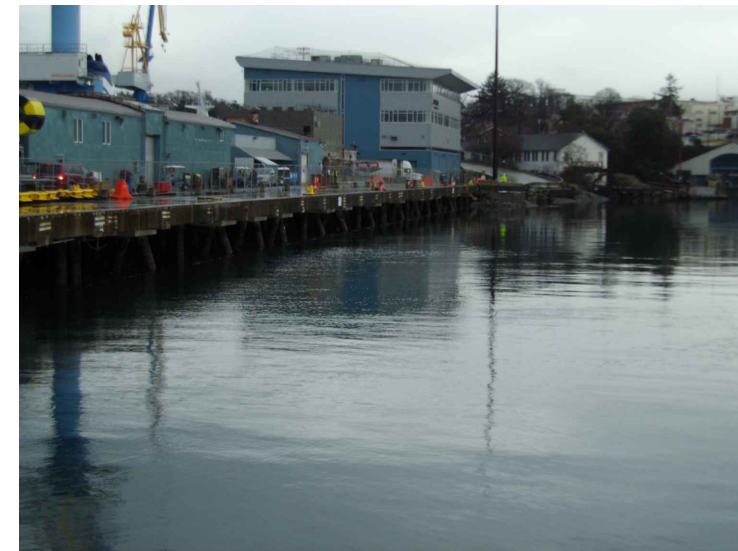


PHOTO C47-06 PILED DECK SOUTH FACE

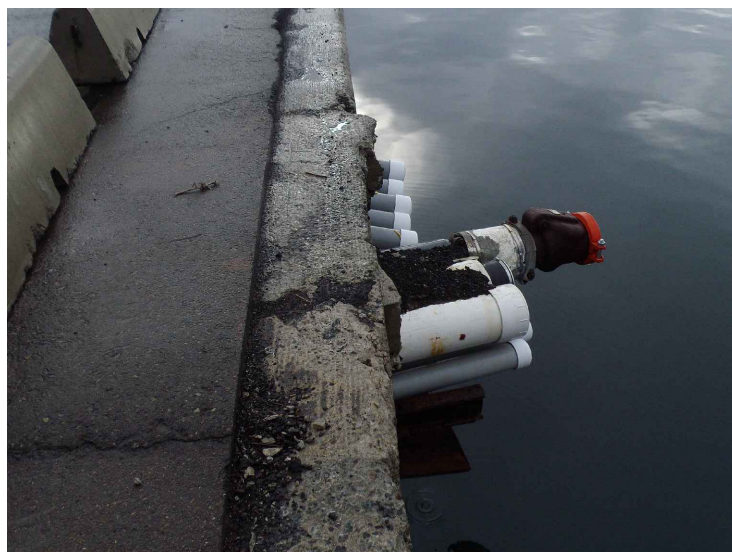


PHOTO C47-07 UTILITIES TERMINATED AT THE WEST FACE OF THE TIMBER CRIB

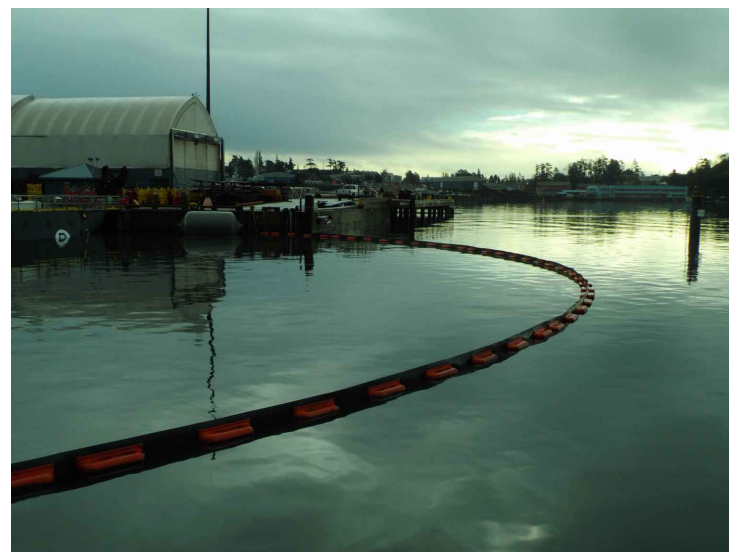


PHOTO C47-08 TIMBER CRIB WEST FACE



PHOTO C47-09 TUG BOAT WHARF AND SOUTH FACE OF PILED DECK - NOTE REINSTATED HIGH MAST LIGHT

Revision/Revision	Description/Description	Date/Date
0	RECORD DRAWING	2017/03/29

Client/client
PUBLIC WORKS AND GOVERNMENT SERVICES CANADA




Project title/Titre du projet
ESQUIMALT GRAVING DOCK
 825 ADMIRALS ROAD, VICTORIA, BC
ESQUIMALT GRAVING DOCK WATERLOT PHASE 2
SOUTH JETTY UNDER-PIER SEDIMENT REMEDIATION

Consultant Signature Only
 Designed by/Concept par
 DANIEL LAWSON
 Drawn by/Desainé par
 ALEXANDER SCEKIC
 PWGSC Project Manager/Administrateur de Projets TPSGC
 ANDREW MYLLY
 Regional Manager, Environmental Services
 COLLIN KINGMAN


Drawing title/Titre du dessin
PHOTOGRAPHS OF AS-BUILT CONDITIONS

Project No./No. du projet R.018400.002	Sheet/ C47	Revision no./ 0
--------------------------------------------------	----------------------	---------------------------



PT	NORTHING	EASTING	TOP ELEVATION	DESCRIPTION
11	5364785.174	468338.675	6.50	CALC PILE 36"
12	5364780.059	468290.655	6.50	CALC PILE 36"
13	5364818.003	468286.666	6.50	CALC PILE 36"
14	5364813.219	468317.708	6.50	CALC PILE 36"
15	5364848.439	468349.295	6.50	CALC PILE 36"
41	5364848.403	468349.228	6.51	AB PILE 15 @CO
45	5364833.213	468317.99	6.50	AB PILE 14 @CO
46	5364818.034	468286.633	7.28	AB PILE 13 @TOP CUT
47	5364780.163	468290.447	6.75	AB PILE 12 @TOP CUT/35
48	5364785.051	468338.815	6.73	AB PILE 11 @TOP CUT/33

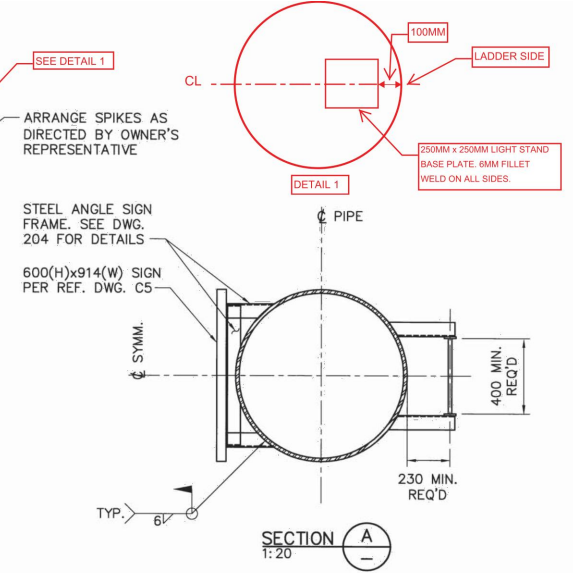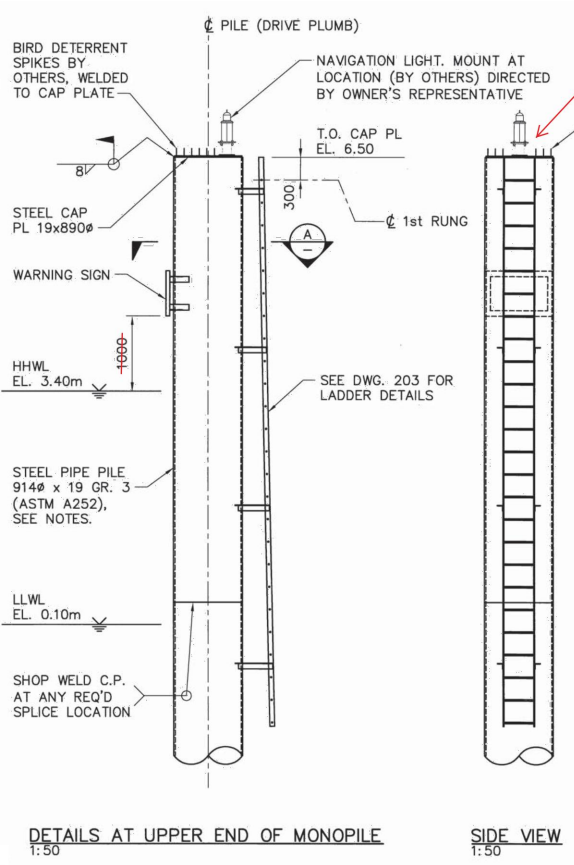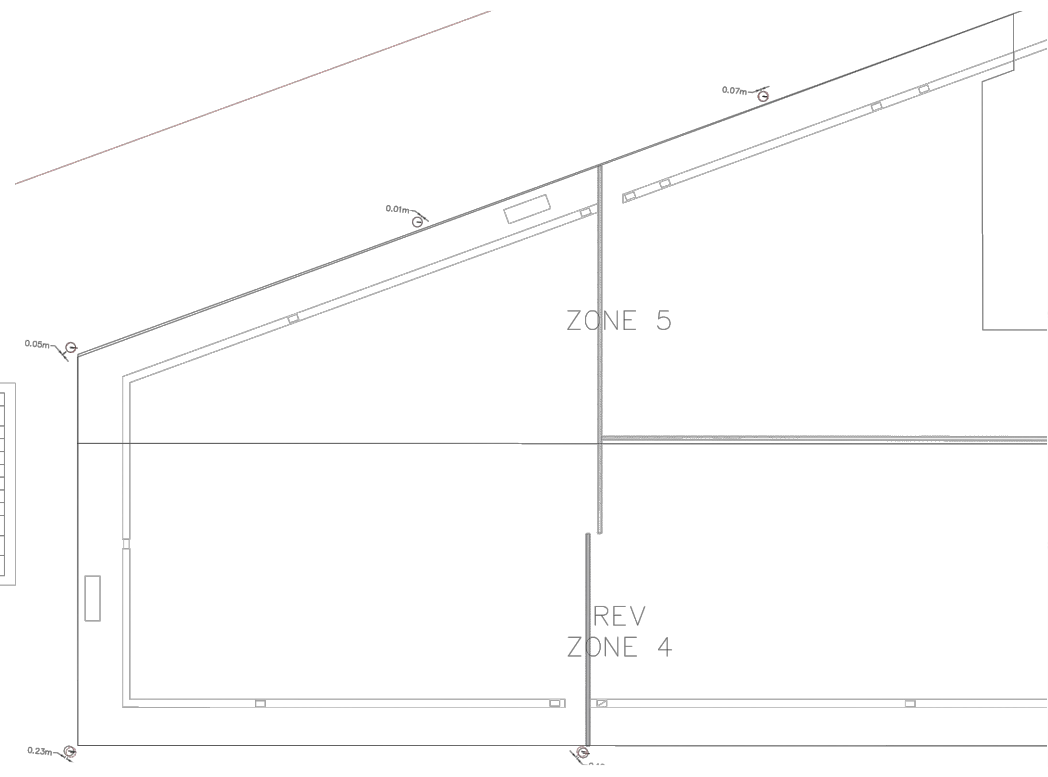

- NOTES:**
- DESIGN LIFE 10 YEARS.
 - VANCOUVER PILE DRIVING LTD. TO PROVIDE DETAILS FOR PASSIVE ANODES FOR CORROSION PROTECTION SYSTEM.
 - SIGN BRACKET DESIGN: 1:50 WIND
 - PIPE PILES WILL BE ASSEMBLED FROM MISC. LENGTHS OF USED PILES, ALL OF SAME CROSS-SECTION AND TO MIN. REQ'D AND COMPATIBLE GRADES. CONDITION ASSESSMENT OF ASSEMBLIES TO BE SUBMITTED FOR REVIEW.

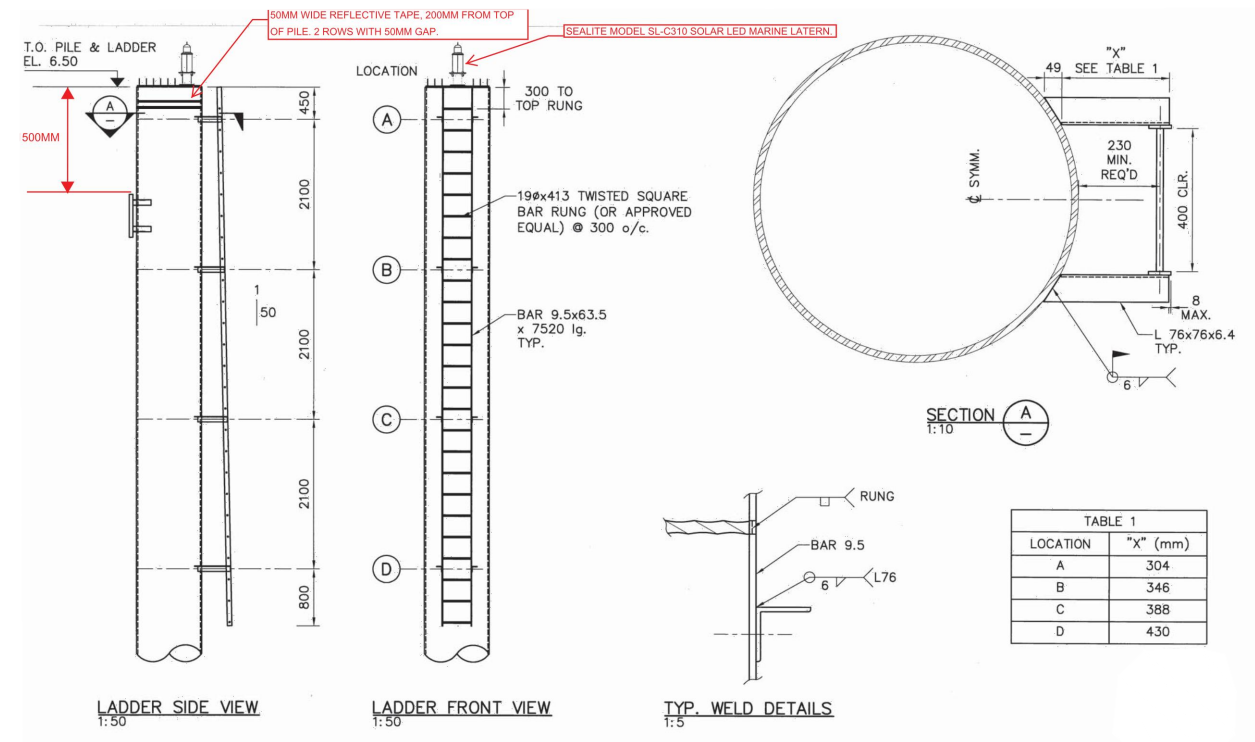

- NOTES:**
- ALL STEEL SUPPLY AND FABRICATION TO CSA G40.20/G40.21-13, AND S16-14; ALL MAT'L GRADE 300W.
 - ALL WELDING IN ACCORDANCE WITH CSA W59-13. ALL WELDERS SHALL BE APPROPRIATELY CERTIFIED, AND ALL WELDING SHALL BE PERFORMED IN A SHOP CERTIFIED TO W47.1-09 (R2014).
 - GRIND SMOOTH ANY BURRS ON HANDHOLDS PRIOR TO GALVANIZING.
 - ASSEMBLY TO BE HOT DIPPED GALVANIZED IN CONFORMANCE WITH CSA-G164 AND TOUCHED-UP AROUND SITE WELDS AS DIRECTED BY OWNER'S REPRESENTATIVE.
 - DESIGN LIFE: 10 YEARS.
 - WORKSAFEBC CONFORMANCE PER PWGSC ADV-432 DATED 18 OCT. 2016.

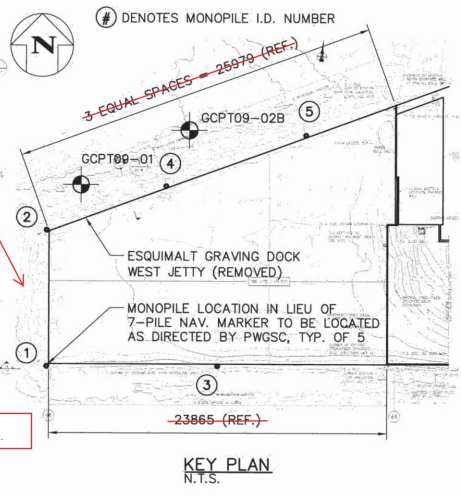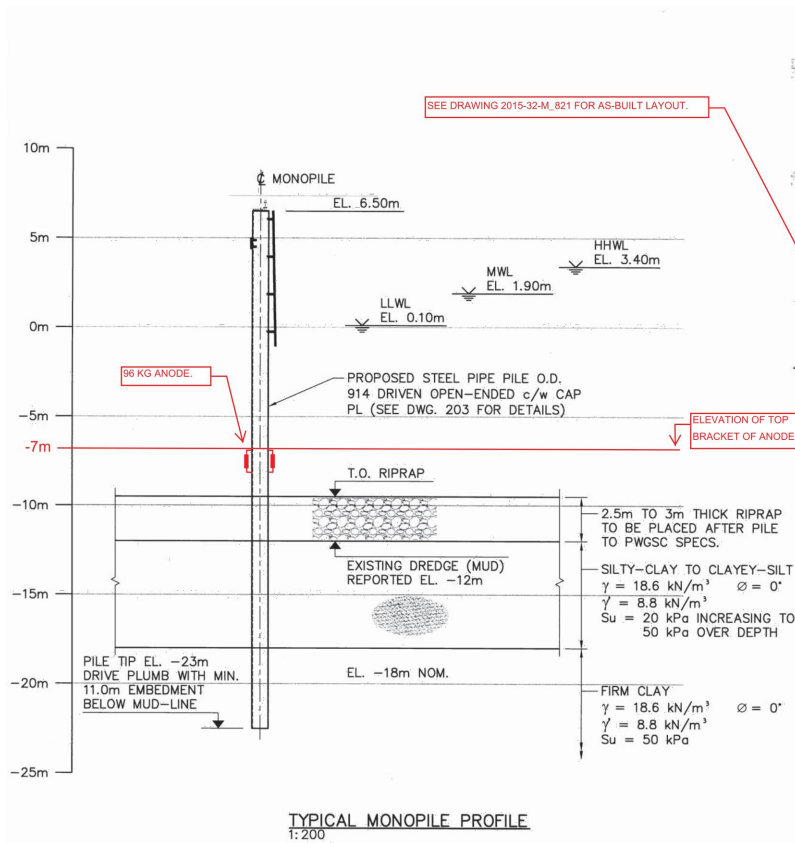

- NOTES:**
- REF. PWGSC DOCUMENT ADV-403-2016-09-30-RS-EGD-WL... "NAVIGATION MARKER DOLPHIN ALTERNATE", AND RELATED CONTRACT DRAWINGS.
 - REFERENCE DWGS. DATED , 2015/03/31 PWGSC/ANCHOR OEA/KLOHN CRIPPEN BERGER: R.018400.002-C5-REV. 1, R.018400.002-C7-REV. 1, R.018400.002-S128-REV. 1, & R.018400.002-S131-REV. 0
 - DESIGN SOIL PARAMETERS PER SOIL LOG REFERENCES FROM BOREHOLES GCPT09-01 & GCPT09-02B (FIGURES F-1 AND F-2, REV. 2) IN GOLDER ASSOCIATES GEOTECH REPORT #09-1475-5008, DATED MARCH 3, 2010.
 - MONOPILE EMBEDMENT AND CROSS SECTION BASED ON COMPARABLE IMPACT RESISTANCE TO SPECIFIED 7-PILE, 14#, TIMBER NAV. MARKER EMBEDDED 6m, PER REF. DWGS.
 - SEE PILE DRIVING RECORDS FOR PILE EMBEDMENT DEPTHS.
 - 2 ANODES PER PILE. 96KG ANODES INSTALLED AT 180 DEGREES TO EACH OTHER.

MONOPILE NAVIGATION DOLPHIN ORIGINALLY DESIGNED AND SEALED BY ALL-SPAN ENGINEERING & CONSTRUCTION LTD. TYP.

NAVIGATIONAL DOLPHIN PILES - AS-BUILTS

Revision/Revision	Description/Description	Date/Date
0	RECORD DRAWING	2017/03/28

PUBLIC WORKS AND GOVERNMENT SERVICES CANADA

Project title/Titre du projet
ESQUIMALT GRAVING DOCK
 825 ADMIRALS ROAD, VICTORIA, BC

ESQUIMALT GRAVING DOCK WATERLOT PHASE 2 SOUTH JETTY UNDER-PIER SEDIMENT REMEDIATION

Consultant Signature Only

Designed by/Concept par
 DANIEL LAWSON

Drawn by/Desainé par
 ALEXANDER SCEKIC


PWGSC Project Manager/Administrateur de Projets TPSGC
 ANDREW MYLLY

Regional Manager, Environmental Services
 COLLIN KINGMAN

Drawing title/Titre du dessin
WEST JETTY NAVIGATION MARKER DOLPHINS AS-BUILT

Project No./No. du projet	Sheet/	Revision no./
R.018400.002	C48	0

Symbol	Observation #	Bent	Date of Observation	Divers Observations
•	1	33D-E	11-May-16	No observed pile damage, CSP in moderate condition
•	2	33D-W	04-May-16	No new items of note
•	3	32D-E	11-May-16	No observed pile damage, CSP in moderate condition
•	4	32D-W	28-Jul-16	Missing CSP
(North batter)			May-11-2016	- Light pile scrapes (no bare steel visible)
			May-11-2016	- Damage at approximately EL -6.1m CD
			May-11-2016	- 3 dents observed
			May-11-2016	- Southeast Dent (above hole): Inverted teardrop shape, soft edges, 550mm long x 280mm wide x (20-30)mm deep
			May-11-2016	- West Dent (upper): Inverted teardrop shape, soft edges, 610mm long x 260mm wide x 50mm deep
			May-11-2016	- West Dent (lower): Oval shape, hard edges, 280mm long x 200mm wide x 60mm deep
			May-11-2016	- 2 hole observed
			May-11-2016	- Top of hole is 450mm below a pile splice
			May-11-2016	- Punctured steel is curled inwards
			28-Jul-16	- Hole #1 is 250mm in diameter and blends in with dent above
			28-Jul-16	- Hole #2 is 150mm in diameter with 350 diameter dent
			May-11-2016	- Internal mudline of pile is stiff about 350mm from bottom of bottom hole
			May-11-2016	- The hole is located on the southeast side of the pile
•	5	31D	11-May-16	Light scrapes on pile above CSP, CSP has localized tear at top, pile coating in poor condition
•	6	30D-W	11-May-16	No new items of note
•	7	30C-N	11-May-16	Moderate damage to CSP, no observed pile damage
•	8	29C-S	28-Jul-16	No new items of note
•	9	28D-E	28-Jul-16	Localized tear and small dents in CSP, pile coating in poor condition (blistering), no observed pile damage
•	10	28D-W	28-Jul-16	No new items of note
•	11	28B-N	04-May-16	Missing CSP, no observed pile damage
•	12	27D	28-Jul-16	No new items of note
•	13	27C	11-May-16	Corner fold of CSP, no observed pile damage, pile coating in poor condition (blisters)
•	14	26D-E	28-Jul-16	No new items of note
•	15	26D-W	28-Jul-16	1 Dent observed
•	16	24D	04-May-16	- 150mm x 200mm x 30mm deep @ EL -0.23m CD
•	17	23D-E	04-May-16	Missing CSP, no observed pile damage
•	18	23D-W	11-May-16	No new items of note
(North batter)			11-May-16	- 1 hole observed
			04-May-16	- 350mm dia. dent with 250mm dia. hole @ mudline (EL -4.04m CD), hole partially filled with mud
			11-May-16	- 2 dents observed
			11-May-16	- West: teardrop shaped, soft edges, 580mm long x 250mm wide x 25 mm deep
			11-May-16	- Crescent shaped dent, soft edges, 270mm long x 120mm wide x 20mm deep
•	19	22D	04-May-16	Missing CSP, scoring damage
•	20	21D-E	11-May-16	CSP in good condition, light scrapes on pile, no bare steel observed
•	21	21D-W	04-May-16	Missing CSP
(North batter)			11-May-16	- 2 dents observed
			11-May-16	- Round shape, soft edges, 150mm in diameter, 25mm deep
			11-May-16	- Round shape, soft edges, 180mm in diameter, 25mm deep
•	22	20D-E	04-May-16	Missing CSP, no observed pile damage
•	23	22D-W	11-May-16	Moderate damage to CSP, light scrapes on pile below CSP
•	24	18D-E	11-May-16	Top CSP in good condition, bottom CSP has one corner fold, no observed pile damage
•	25	18D-W	11-May-16	Minor damage to CSP, no observed pile damage
•	26	18C-N	04-May-16	Scoring Damage
•	27	17D-E	11-May-16	Moderate damage to CSP, light scrapes on pile
•	28	17D-W	04-May-16	Missing CSP, light scoring
•	29	16D-E	04-May-16	Missing CSP, light scoring
•	30	16D-W	04-May-16	Missing CSP, light scoring
•	31	16C-N	04-May-16	Missing CSP, light scoring
•	32	15D	11-May-16	CSP in good condition, no observed pile damage
•	33	15C	11-May-16	CSP in good condition, no observed pile damage
•	34	14D-E	11-May-16	Minor damage to CSP and 1 corner fold, light scrapes on pile, no bare steel observed
•	35	9D-W	11-May-16	CSP in good condition.
(North batter)			11-May-16	- 1 dent observed
			04-May-16	- 250mm x 100mm dent, 25mm deep at mudline (EL -2.74m CD)
•	36	8D-W	11-May-16	Minor damage to CSP
(North batter)			04-May-16	- 1 dent observed
			04-May-16	- 150mm diameter dent, 10mm deep at mudline (EL -2.74m CD)
•	37	7D	04-May-16	Scoring
•	38	6D-E	04-May-16	Scoring
•	39	5D-E	04-May-16	Scoring
•	40	4F-N	04-May-16	Missing CSP
(west batter)			12-May-16	- 2 dents observed
			12-May-16	- 940mm long x 220mm wide x 12mm deep dent across splice, 2m above mudline (EL -3.74m CD)
			12-May-16	- 560mm long x 210mm wide by 15mm deep dent, 2.5m above mudline (EL -3.24m CD)
•	41	4G-N	04-May-16	Missing CSP
(west batter)			12-May-16	- 3 dents observed
			12-May-16	- 185mm long x 160mm wide x 15mm deep dent, 4m above mudline (EL -2.59m CD)
			12-May-16	- 250mm x 120mm dent, 5-6mm deep, 3-4m above mudline (EL -3.59m to -2.59m CD)
			12-May-16	- 530mm long x 280mm x 50mm deep dent
•	43	4H-N	04-May-16	Missing CSP
(west batter)			12-May-16	- 1 hole observed
			12-May-16	- 360mm long x 220mm wide hole at mudline
			12-May-16	- 1 Dent Observed
			12-May-16	- 650mm x 380mm
•	43	4I-N	04-May-16	Missing CSP
(west batter)			12-May-16	- 1 hole observed
			12-May-16	- 320mm diameter hole at northwest corner, 2m above mudline (EL -7.24m CD)
			12-May-16	- 1 dent observed
			12-May-16	- 170mm diameter x 25mm deep dent at southwest corner, 1.5m above mudline

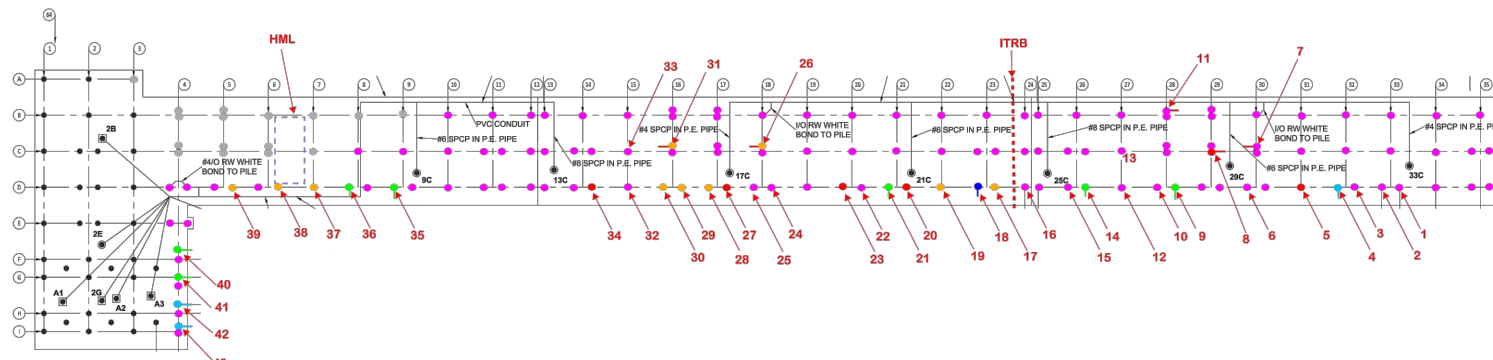

PILE DAMAGE - PLAN

Summary

Symbol	Qty	Description
•	16	No observed pile damage
•	7	Dent only
•	4	Dent with hole
•	10	Scoring
•	6	Light scrapes
•	43	Items of note
•	35	CSP installed, no dredging in area to date
•	16	No CSP installed
•	88	No pile damage, CSP in place
•	139	No damaged observed total

Notes:
- All piles from Bent 24 to Bent 35 were inspected on July 28, 2016. Only damaged piles were video taped.

Hole Only - Quantity	
Pile #4	2
Pile #18	1
Pile #42	1
Pile #43	1
Total	5

Dent Only - Quantity	
Pile #4	3
Pile #9	1
Pile #14	1
Pile #18	2
Pile #21	1
Pile #35	2
Pile #36	1
Pile #40	2
Pile #41	3
Pile #43	1
Total	17

Total # of Damaged Piles

Pile #4
Pile #18
Pile #42
Pile #9
Pile #14
Pile #43
Pile #21
Pile #35
Pile #36
Pile #40
Pile #41
Pile #43
11

PILE REPAIRS ORIGINALLY DESIGNED AND SEALED BY ALL-SPAN ENGINEERING & CONSTRUCTION LTD. TYP.



Revision/Revision	Description/Description	Date/Date
0	RECORD DRAWING	2017/03/29

PUBLIC WORKS AND GOVERNMENT SERVICES CANADA


Project Title/Titre du projet
ESQUIMALT GRAVING DOCK
825 ADMIRALS ROAD, VICTORIA, BC



ESQUIMALT GRAVING DOCK WATERLOT PHASE 2 SOUTH JETTY UNDER-PIER SEDIMENT REMEDIATION

Consultant Signature Only
Designed by/Concept par DANIEL LAWSON
Drawn by/Desainé par ALEXANDER SKEKIC
PWGSC Project Manager/Administrateur de Projets TPSGC ANDREW MYLLY
Regional Manager, Environmental Services COLLIN KINGMAN

Drawing Title/Titre du dessin
PILE REPAIRS AS-BUILTS SHEET 1



Project No./No. du projet	Sheet/feuille	Revision no./révision
R.018400.002	C49	0

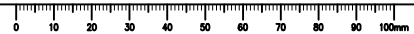

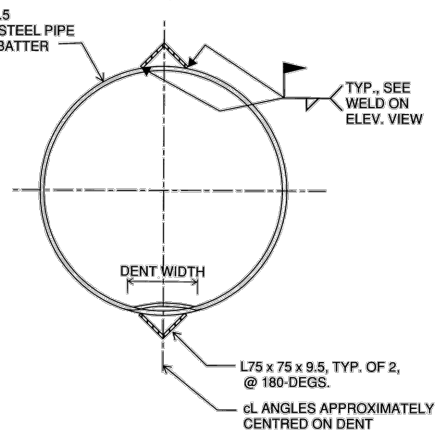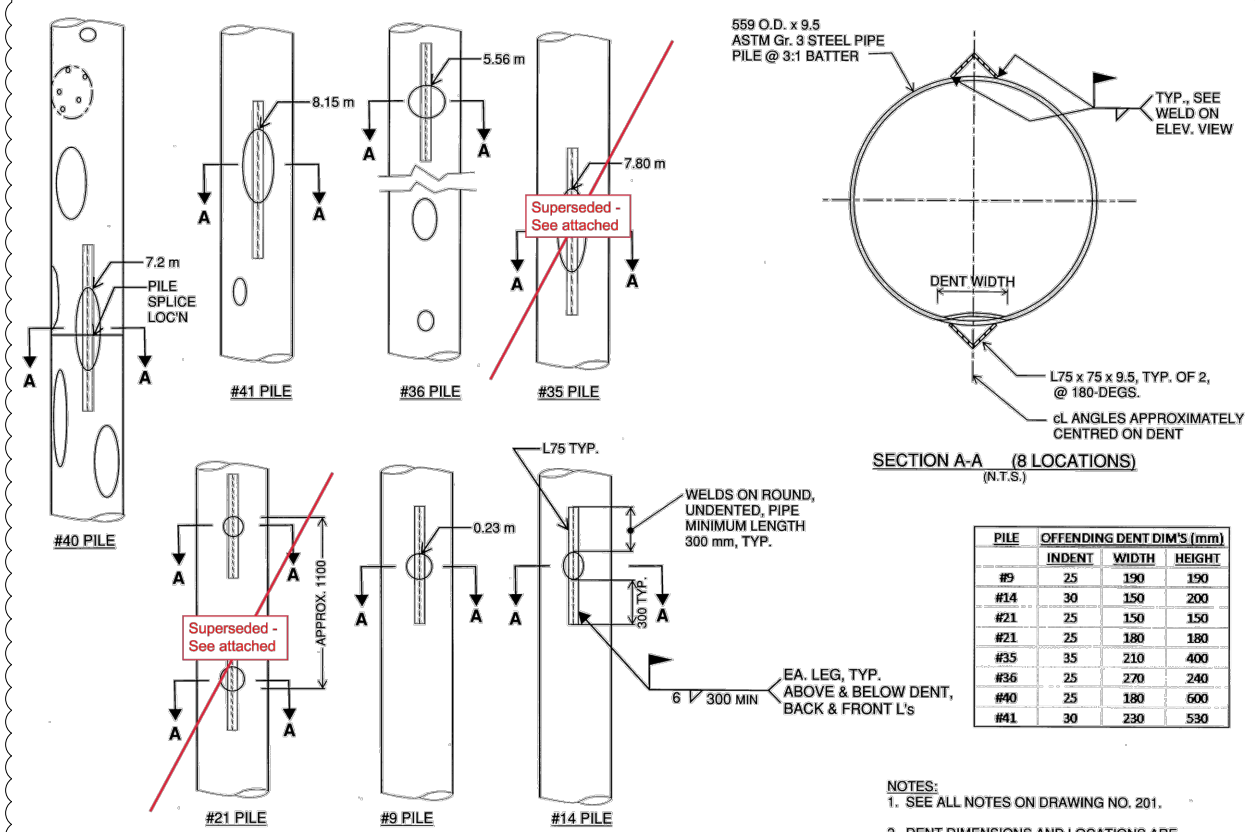


PILE	OFFENDING DENT DIM'S (mm)		
	INDENT	WIDTH	HEIGHT
#9	25	190	190
#14	30	150	200
#21	25	150	150
#21	25	180	180
#35	35	210	400
#36	25	270	240
#40	25	180	600
#41	30	230	530

NOTES:
 1. SEE ALL NOTES ON DRAWING NO. 201.
 2. DENT DIMENSIONS AND LOCATIONS ARE PER DIVE INFORMATION PROVIDED BY VAN-PILE, 11 AUG 2016.

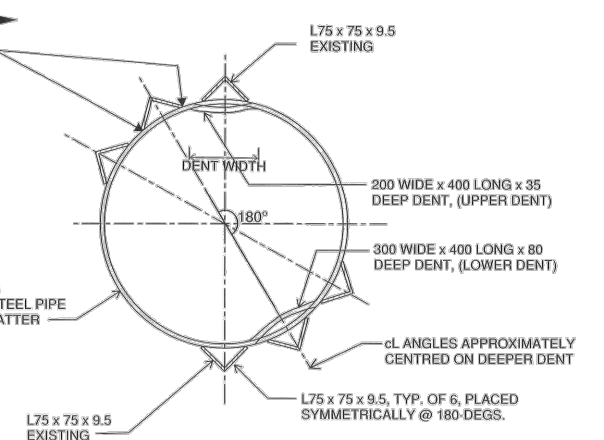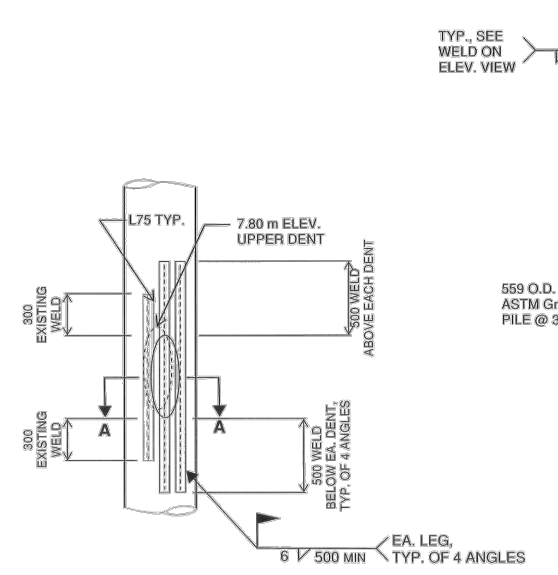

NOTES:
 1. ALL STEEL GRADE 300W TO CSA GRADE G40.20/G40.21.
 2. ALL WELDING BY APPROPRIATELY TICKETED WET WELDERS PER CSA W47.1-09 AND THE CWB; PERFORMANCE & VISUAL INSPECTION TO CONFORM WITH CSA W59-13 AND AWS D3.6M-2010. ALL ELECTRODES METRIC E49XX OR IMP E70XX, WITH APPROPRIATE COATING.
 3. DESIGN REF'S: ALL PWGSC ADVISORIES TO MNQM CONTRACTING LTD., (EGD WATERLOT REMEDIATION PROJECT PH2 SOUTH JETTY UNDER-PIER SEDIMENT REMEDIATION, E2899-151108/001/PWY).
 4. SPECS. ON THIS DWG SUPERSEDE THOSE SHOWN FOR PILE #35 SHOWN ON DWG 204. PILE DAMAGE SHOWN PER DIVE INFORMATION RECEIVED FROM VAN-PILE SEPT 22, 2016.

PILE REPAIRS ORIGINALLY DESIGNED AND SEALED BY ALL-SPAN ENGINEERING & CONSTRUCTION LTD. TYP.

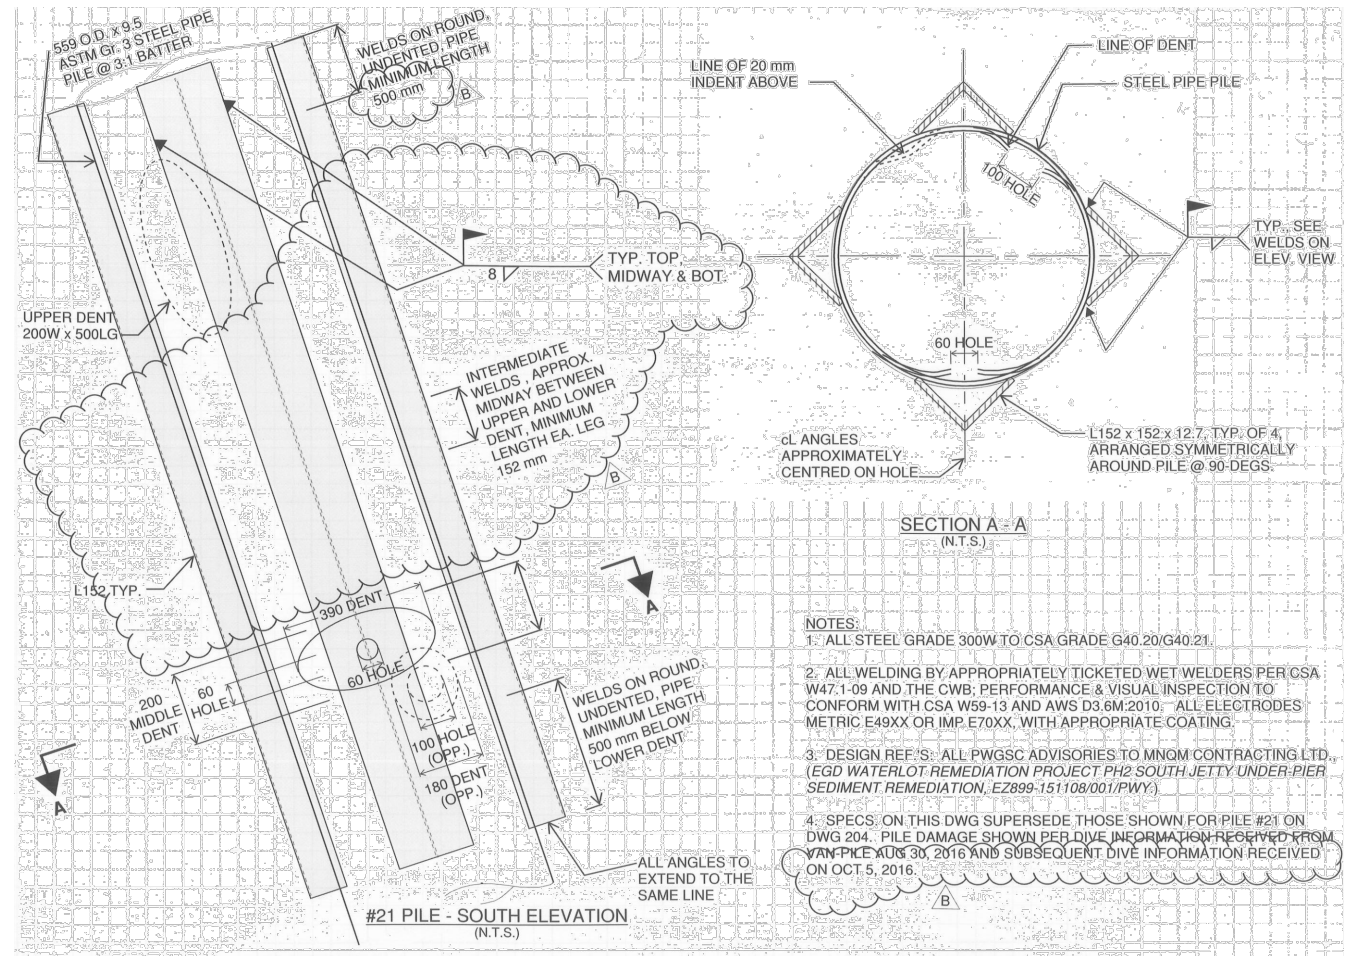

0	RECORD DRAWING	2017/03/29
---	----------------	------------

Revision/Revision	Description/Description	Date/Date
-------------------	-------------------------	-----------

Client/client
PUBLIC WORKS AND GOVERNMENT SERVICES CANADA

Project title/Titre du projet
**ESQUIMALT GRAVING DOCK
 825 ADMIRALS ROAD, VICTORIA, BC**

**ESQUIMALT GRAVING DOCK
 WATERLOT PHASE 2
 SOUTH JETTY UNDER-PIER
 SEDIMENT REMEDIATION**

Consultant Signature Only

Designed by/Concept par
 DANIEL LAWSON




Drawn by/Desainé par
 ALEXANDER SCEKIC

PWGSC Project Manager/Administrateur de Projets TPSGC
 ANDREW MYLLY



Regional Manager, Environmental Services
 COLLIN KINGMAN

Drawing title/Titre du dessin
**PILE REPAIRS
 AS-BUILTS
 SHEET 2**



Project No./No. du projet R.018400.002	Sheet/ C50	Revision no./ 0
-------------------------------------------	---------------	--------------------

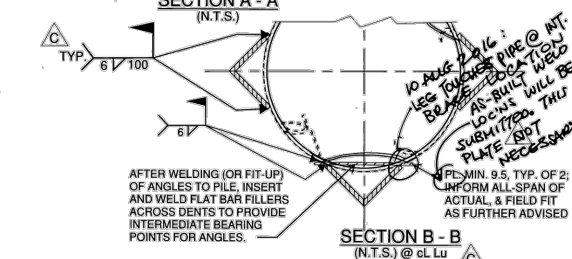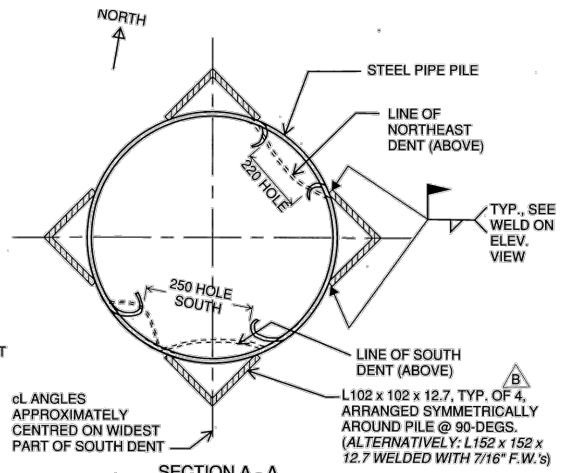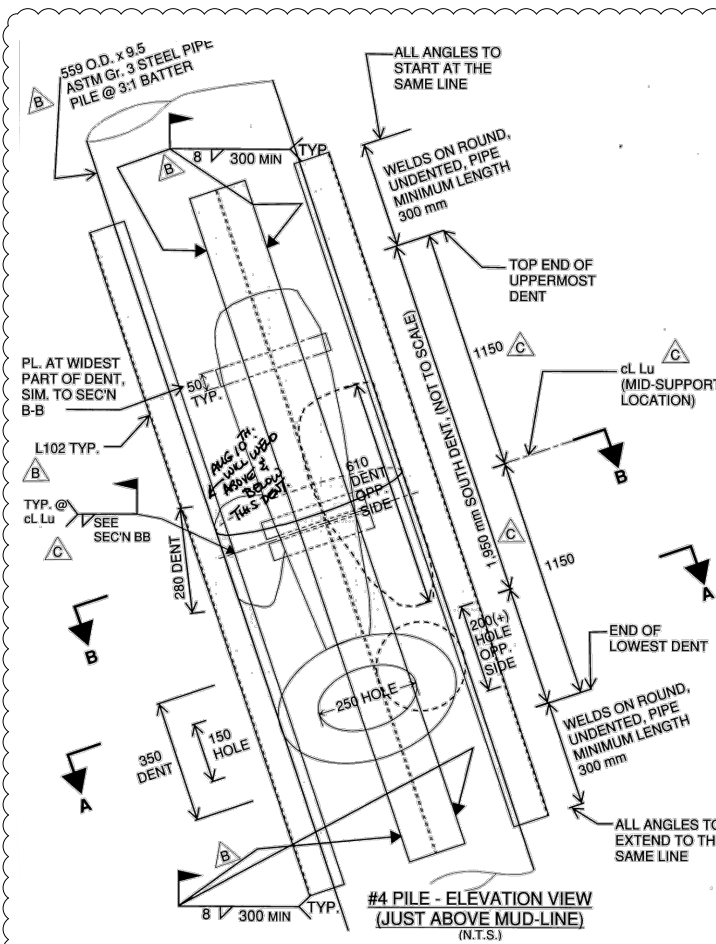



NOTES:
 1. ALL STEEL GRADE 300W TO CSA GRADE G40.20/G40.21.
 2. ALL WELDING BY APPROPRIATELY TICKETED WET WELDERS PER CSA W47.1-09 AND THE CWB; PERFORMANCE & VISUAL INSPECTION TO CONFORM WITH CSA W59-13 AND AWS D3.6M:2010. ALL ELECTRODES METRIC E49XX OR IMP E70XX, WITH APPROPRIATE COATING.
 3. DESIGN REF.'S: ALL PWGSC ADVISORIES TO MNQM CONTRACTING LTD., (EGD WATERLOT REMEDIATION PROJECT PH2 SOUTH JETTY UNDER-PIER SEDIMENT REMEDIATION, E2899-151108/001/PWY.)

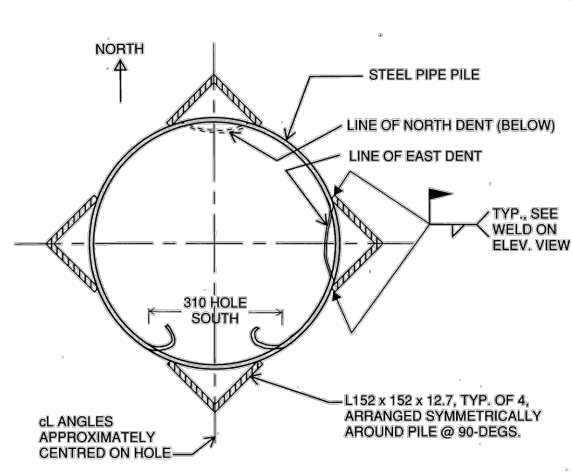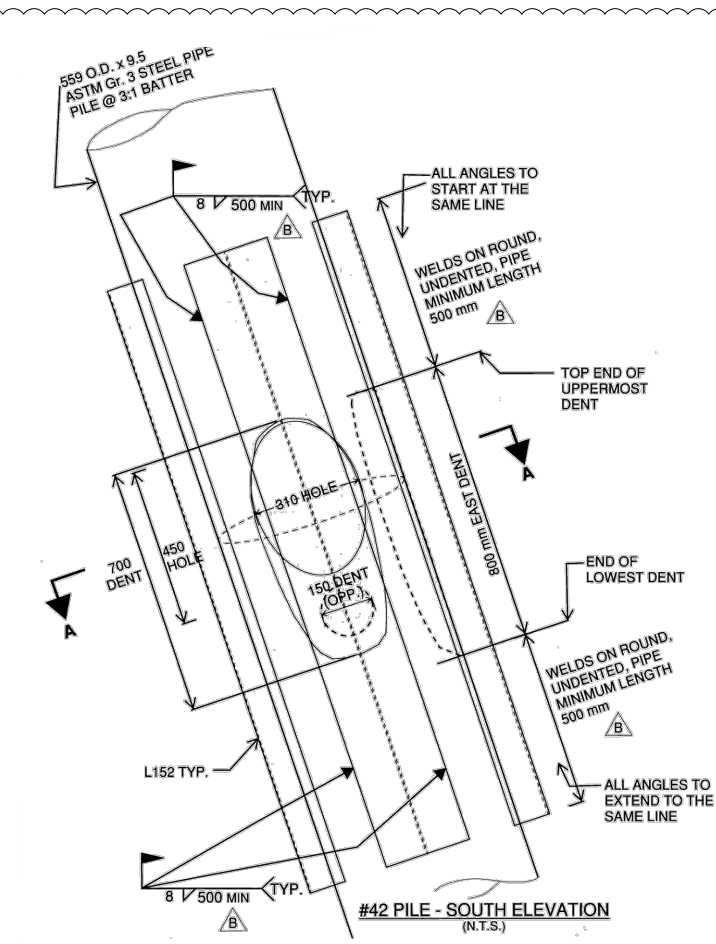

NOTES:
 1. ALL STEEL GRADE 300W TO CSA GRADE G40.20/G40.21.
 2. ALL WELDING BY APPROPRIATELY TICKETED WET WELDERS PER CSA W47.1-09 AND THE CWB; PERFORMANCE & VISUAL INSPECTION TO CONFORM WITH CSA W59-13 AND AWS D3.6M:2010. ALL ELECTRODES METRIC E49XX OR IMP E70XX, WITH APPROPRIATE COATING.
 3. DESIGN REF.'S: ALL PWGSC ADVISORIES TO MNQM CONTRACTING LTD., (EGD WATERLOT REMEDIATION PROJECT PH2 SOUTH JETTY UNDER-PIER SEDIMENT REMEDIATION, E2899-151108/001/PWY.)

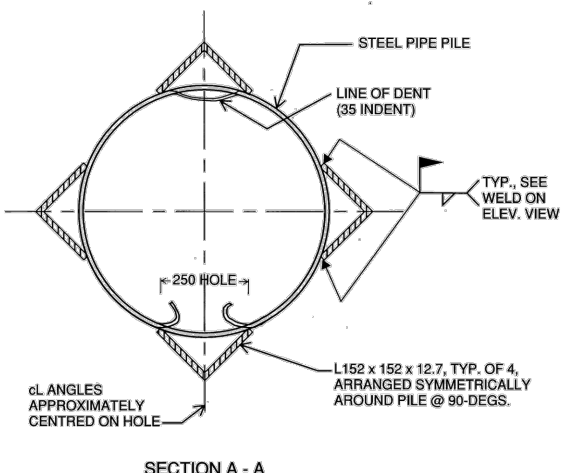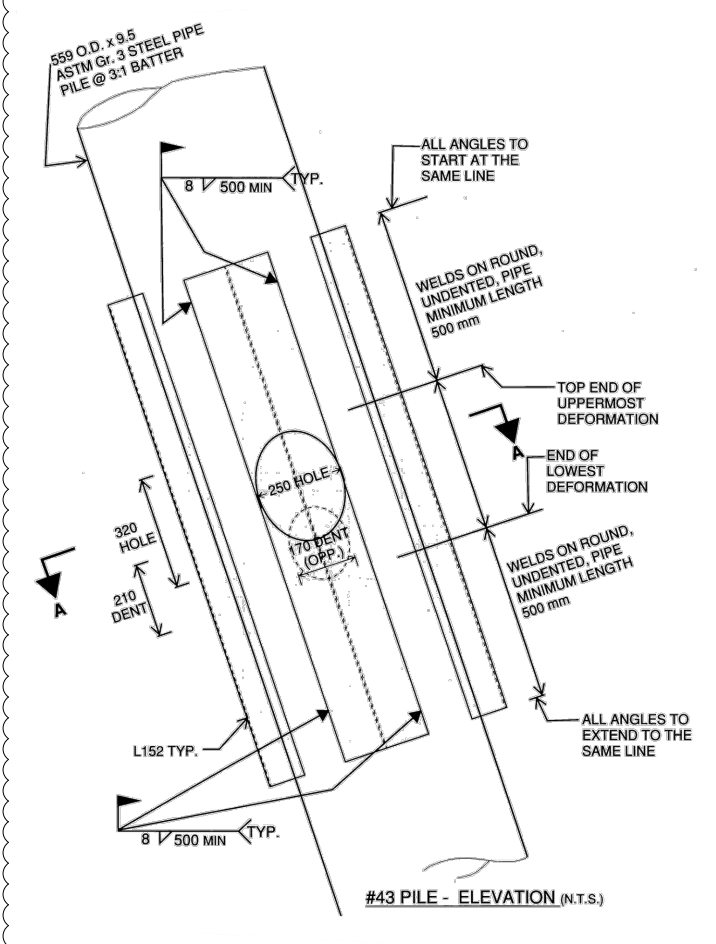


NOTES:
 1. SEE ALL NOTES ON DRAWING NO. 201.
 PILE REPAIRS ORIGINALLY DESIGNED AND SEALED BY ALL-SPAN ENGINEERING & CONSTRUCTION LTD. TYP.

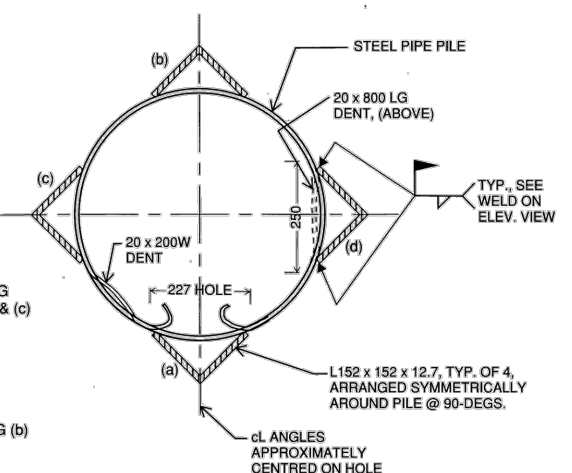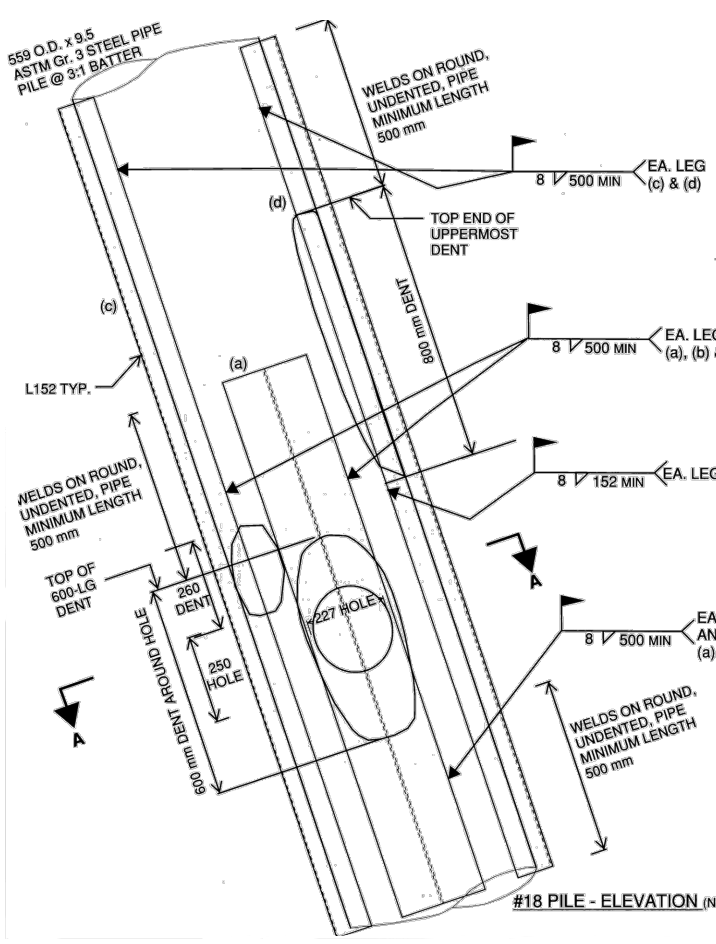


NOTES:
 1. SEE ALL NOTES ON DRAWING NO. 201.


0	RECORD DRAWING	2017/03/29
Revision/	Description/Description	Date/Date
Client/client		
PUBLIC WORKS AND GOVERNMENT SERVICES CANADA		
Project title/Titre du projet ESQUIMALT GRAVING DOCK 825 ADMIRALS ROAD, VICTORIA, BC		
ESQUIMALT GRAVING DOCK WATERLOT PHASE 2 SOUTH JETTY UNDER-PIER SEDIMENT REMEDIATION		
Consultant Signature Only		
Designed by/Concept par DANIEL LAWSON		
Drawn by/Desainé par ALEXANDER SCEKIC		
PWGSC Project Manager/Administrateur de Projets TP5GC ANDREW MYLLY		
Regional Manager, Environmental Services COLLIN KINGMAN		
Drawing title/Titre du dessin PILE REPAIRS AS-BUILTS SHEET 3		
Project No./No. du projet R.018400.002	Sheet/ C51	Revision no./ 0

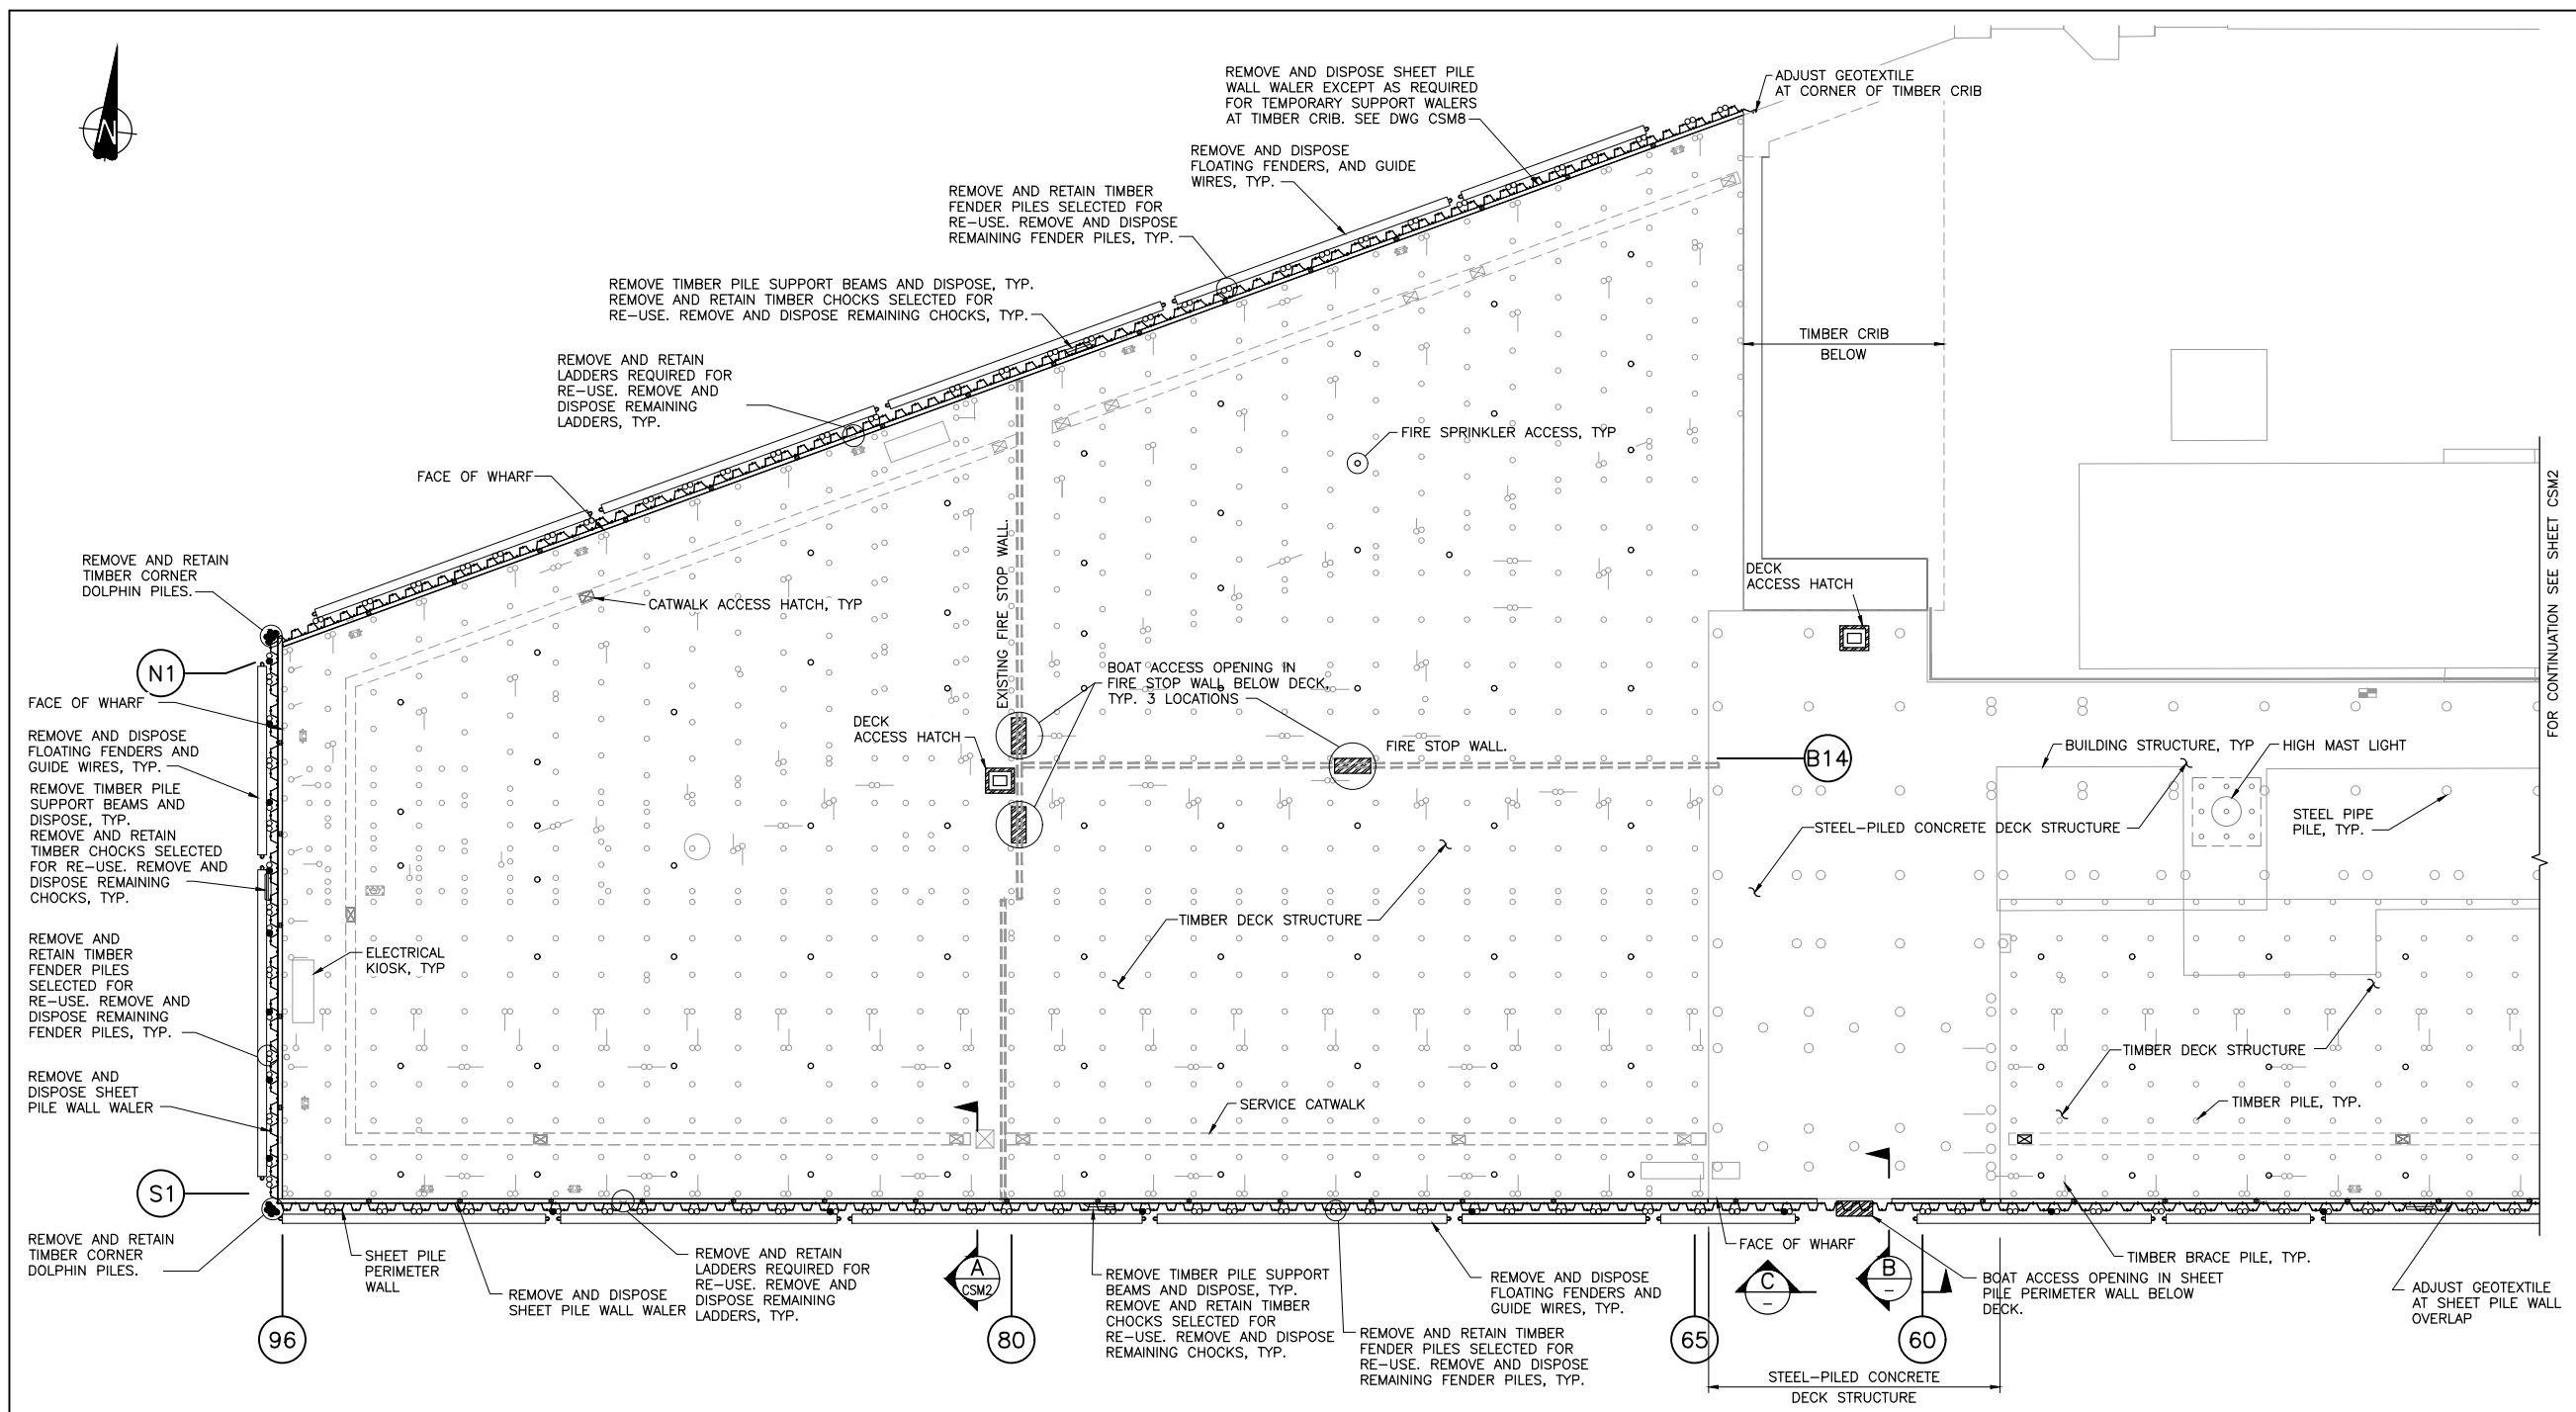

PLAN WEST TIMBER JETTY
 SCALE 1: 250

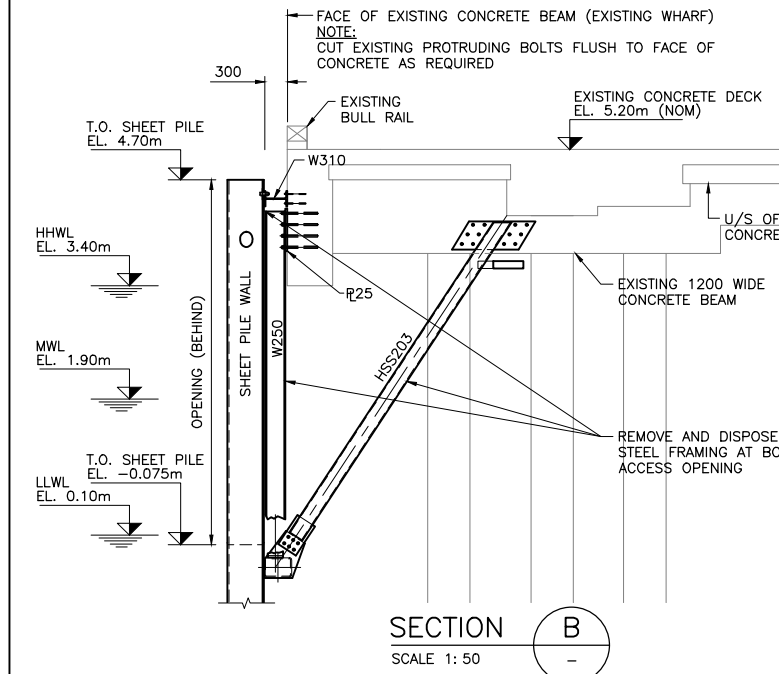

SECTION B
 SCALE 1: 50

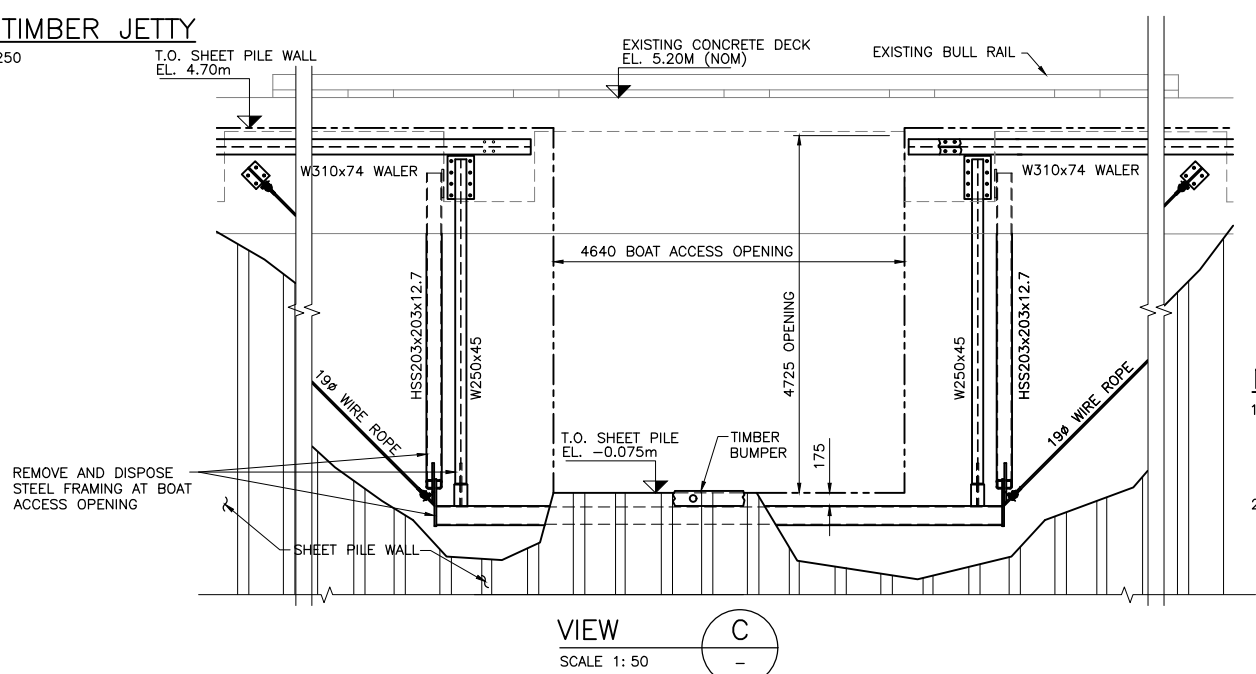

VIEW C
 SCALE 1: 50

- NOTES:**
- THIS DRAWING SHOWS EXISTING ITEMS TO BE REMOVED, DISPOSED AND RETAINED TO FACILITATE RE-DRIVING OF THE EXISTING SHEET PILE PERIMETER WALL AT THE WEST AND SOUTH JETTY.
 - FOR SHEET PILE WALL AND BOAT ACCESS FRAME DETAILS SEE REFERENCE DRAWINGS.

Revision/Revision	Description/Description	Date/Date
1	RECORD DRAWING	2017/03/29
0	ISSUED FOR TENDER	2014/12/19

PUBLIC WORKS AND GOVERNMENT SERVICES CANADA


Project title/Titre du projet
ESQUIMALT GRAVING DOCK
 825 ADMIRALS ROAD, VICTORIA, BC

ESQUIMALT GRAVING DOCK WATERLOT PHASE 2 SOUTH JETTY UNDER-PIER SEDIMENT REMEDIATION


Consultant Signature Only
 Designed by/Concept par: JANET TONG
 Drawn by/Desainé par: ARNIE RIST
 PWGSC Project Manager/Administrateur de Projets TPSGC: ANDREW MYLLY
 Regional Manager, Environmental Services: COLLIN KINGMAN

Drawing title/Titre du dessin
WEST AND SOUTH JETTY EXISTING CONDITIONS FENDER REMOVAL SHEET 1


Project No./No. du projet R.018400.002	Sheet/ CSM1	Revision no./ 1
--------------------------------------------------	-----------------------	---------------------------

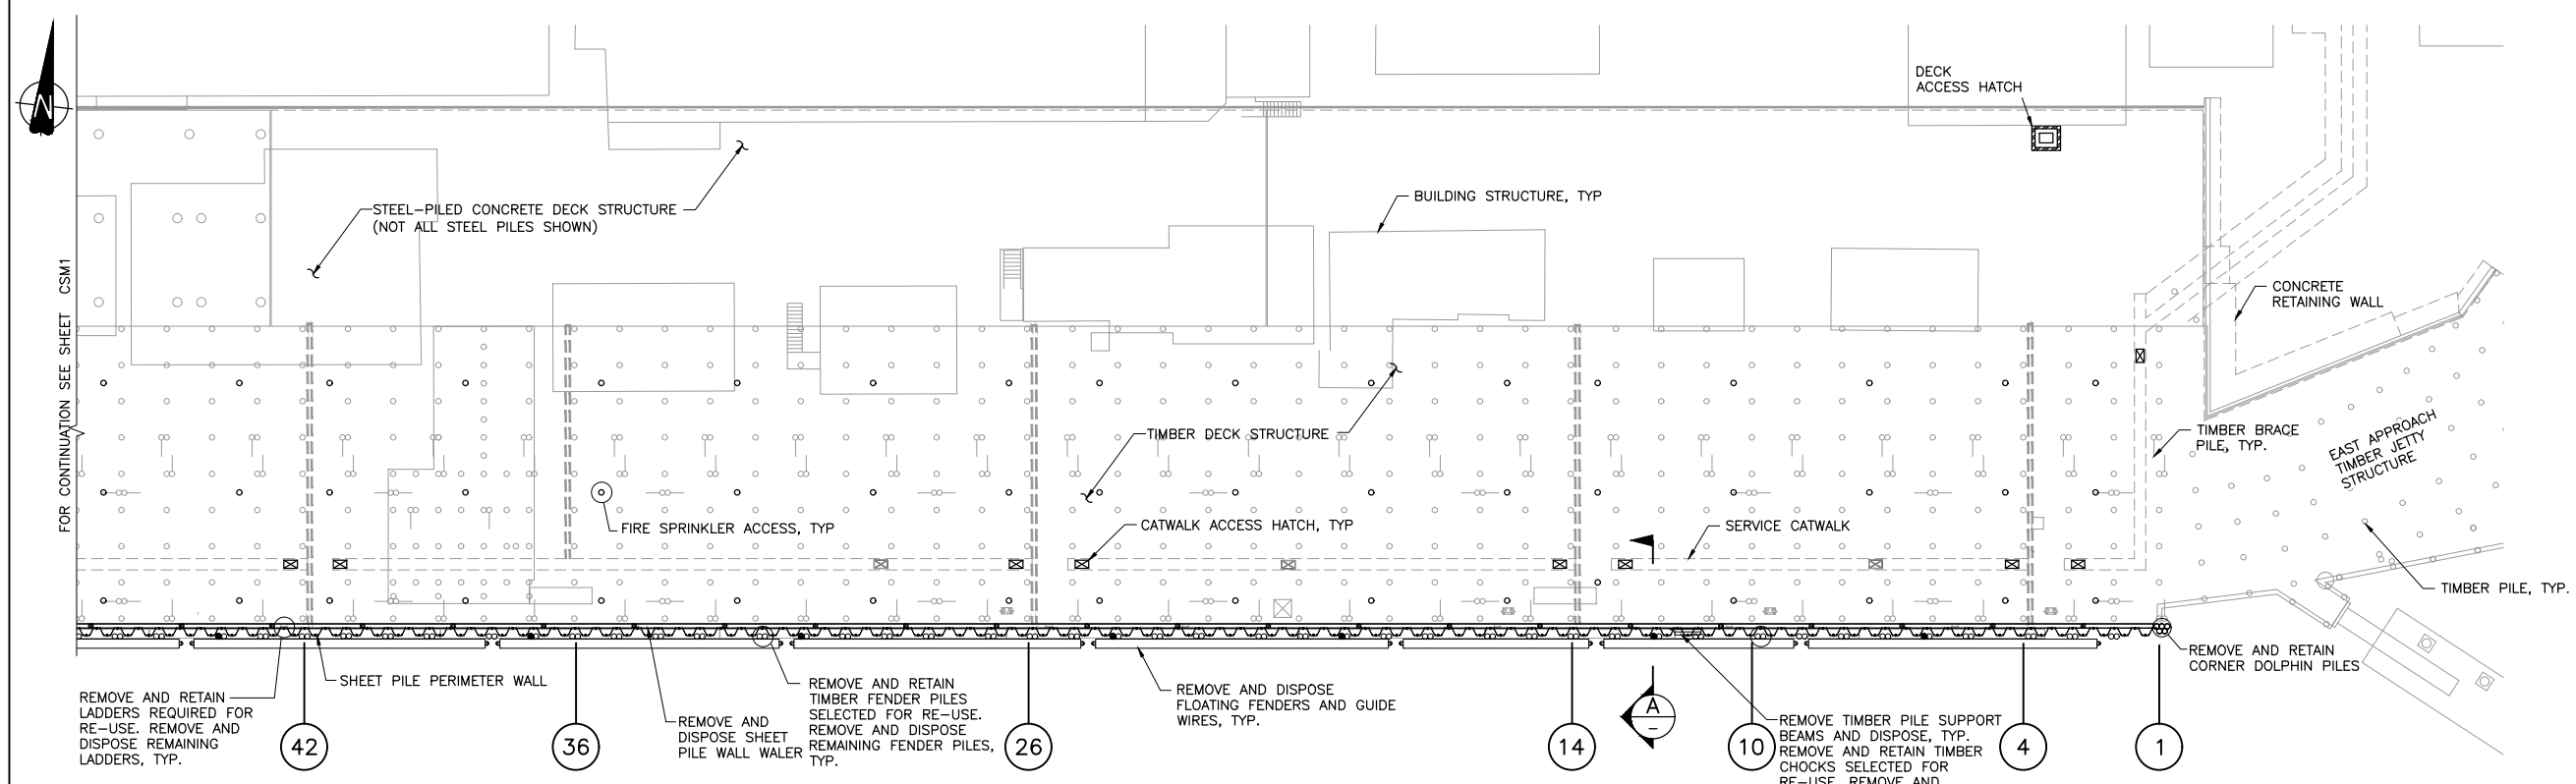

PLAN SOUTH TIMBER JETTY
SCALE 1: 250

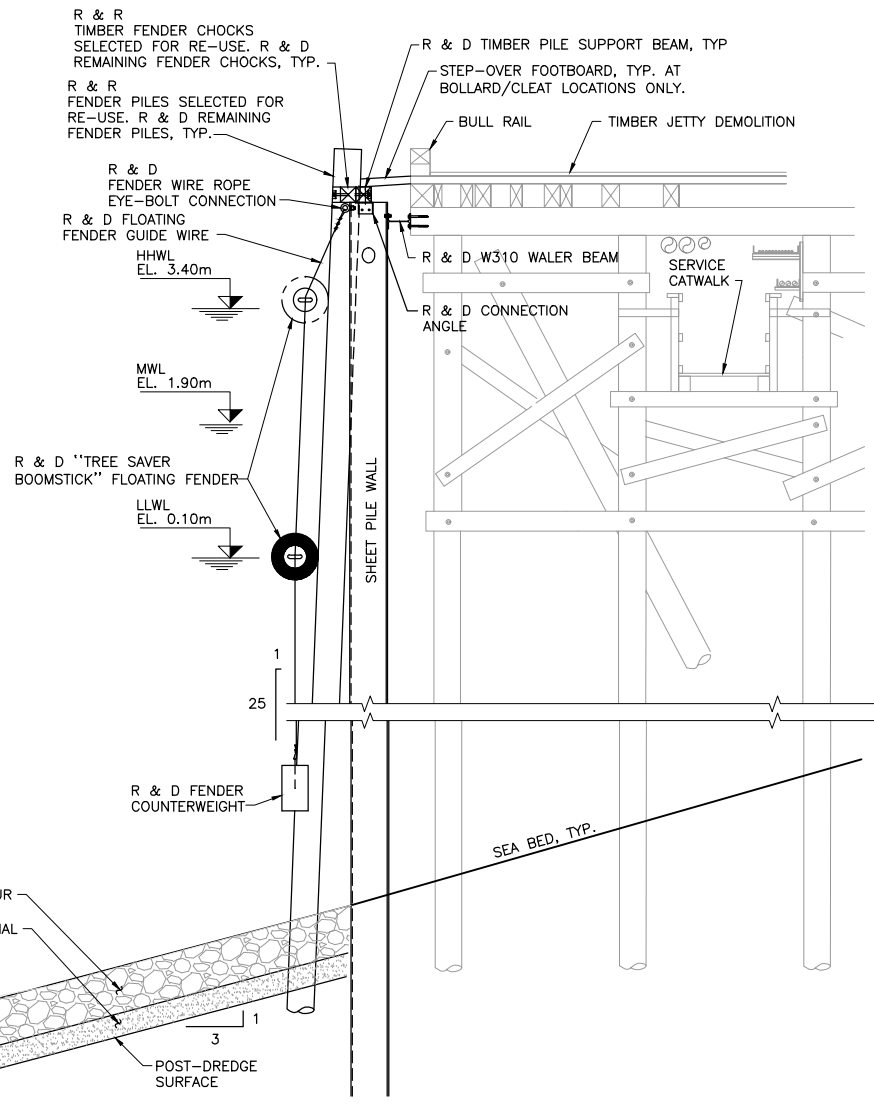

SECTION A-A
SCALE 1: 50
EXISTING WHARF FENDER SYSTEM (TYPICAL)

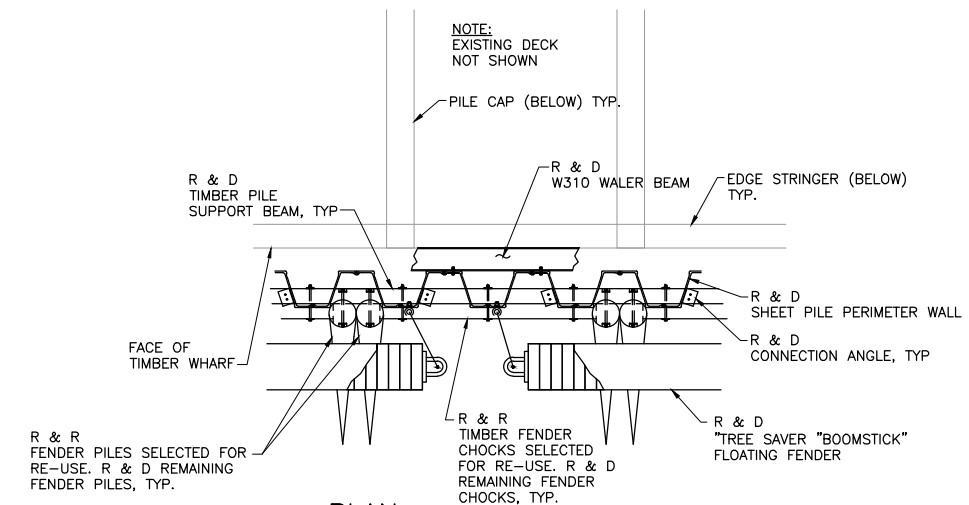

PLAN EXISTING WHARF FENDER SYSTEM
SCALE 1: 50

LEGEND:
R & D DENOTES REMOVE AND DISPOSE
R & R DENOTES REMOVE AND RETAIN

NOTES:
1. THIS DRAWING SHOWS EXISTING ITEMS TO BE REMOVED, DISPOSED AND RETAINED TO FACILITATE RE-DRIVING OF THE EXISTING SHEET PILE PERIMETER WALL AT THE SOUTH JETTY.
2. FOR SHEET PILE WALL DETAILS SEE REFERENCE DRAWINGS.

Revision/Revision	Description/Description	Date/Date
1	RECORD DRAWING	2017/03/29
0	ISSUED FOR TENDER	2014/12/29

Client/client
PUBLIC WORKS AND GOVERNMENT SERVICES CANADA


Project title/Titre du projet
ESQUIMALT GRAVING DOCK 825 ADMIRALS ROAD, VICTORIA, BC

ESQUIMALT GRAVING DOCK WATERLOT PHASE 2 SOUTH JETTY UNDER-PIER SEDIMENT REMEDIATION

Consultant Signature Only
Designed by/Concept par JANET TONG
Drawn by/Desain par ARNIE RIST
PWGSC Project Manager/Administrateur de Projets TPSGC ANDREW MYLLY
Regional Manager, Environmental Services COLLIN KINGMAN


Drawing title/Titre du dessin
WEST AND SOUTH JETTY EXISTING CONDITIONS FENDER REMOVAL SHEET 2

Project No./No. du projet	Sheet/feuille	Revision no./no. de révisión
R.018400.002	CSM2	1

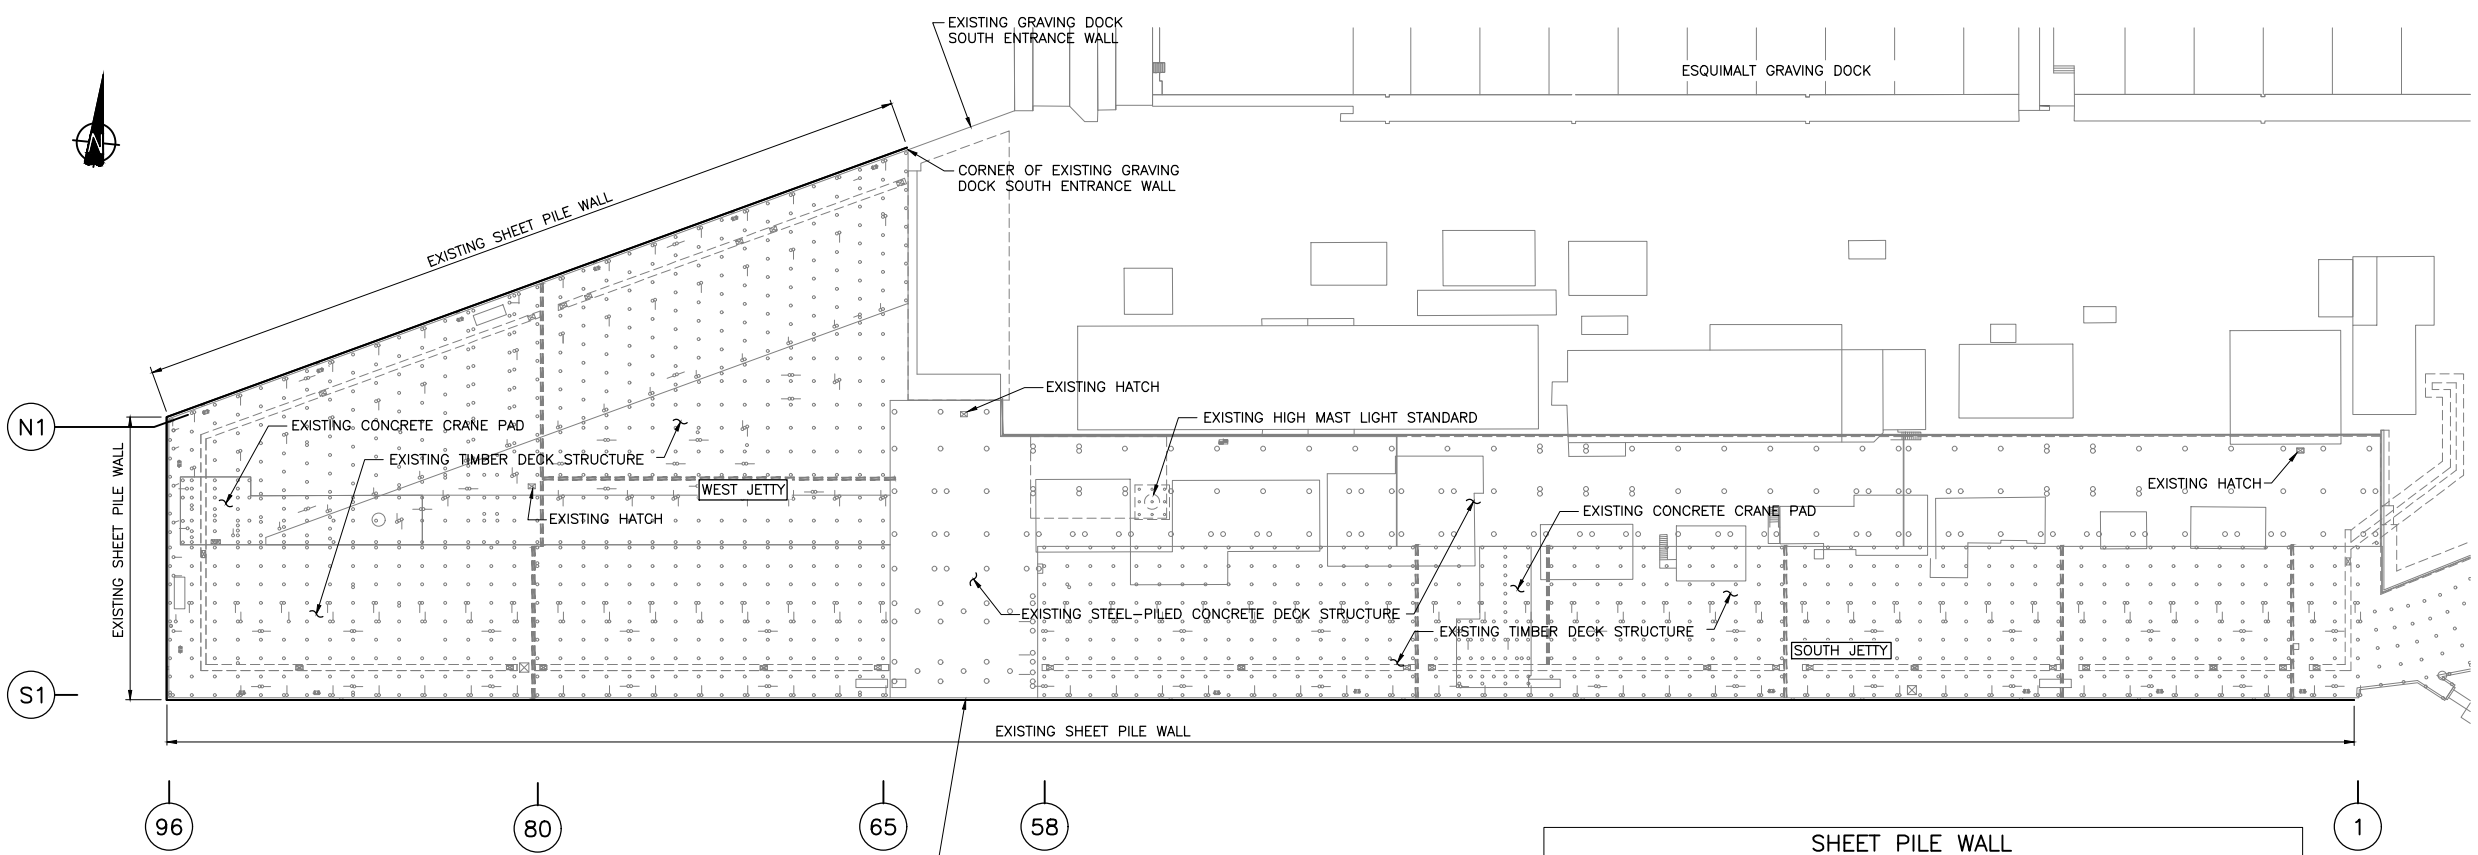


PLAN
 1:500
 NOTE:
 FENDER PILES, CORNER DOLPHINS,
 "TREE SAVER BOOMSTICK" FLOATS, AND
 LADDERS NOT SHOWN

SHEET PILE WALL					
TYPE	DESIGN MUDLINE ELEVATION	SHEET PILE WALL SECTION	DIMENSIONS		PILE TIP ELEVATION
			W	H	
TYPE A	-7m	AZ 26-700	1400	460	-12m
TYPE B	-8m	AZ 38-700N	1400	500	-13.5m
TYPE C	-9m	AZ 50	1180	483	-16m U.N.O.
TYPE D	-8m	AZ 50	1180	483	AS NOTED
TYPE E	-8m	AZ 38-700N	1400	500	-15m

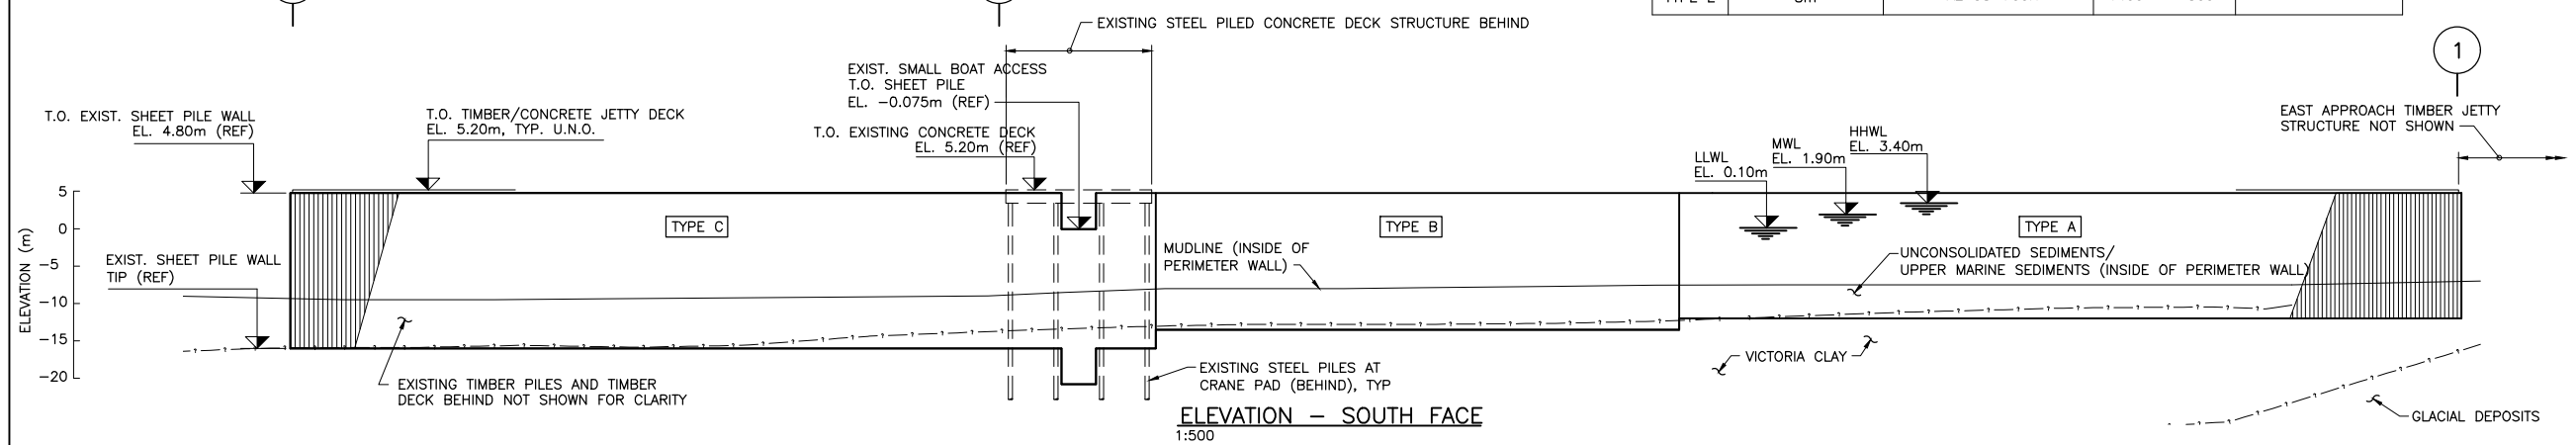

ELEVATION - SOUTH FACE
 1:500

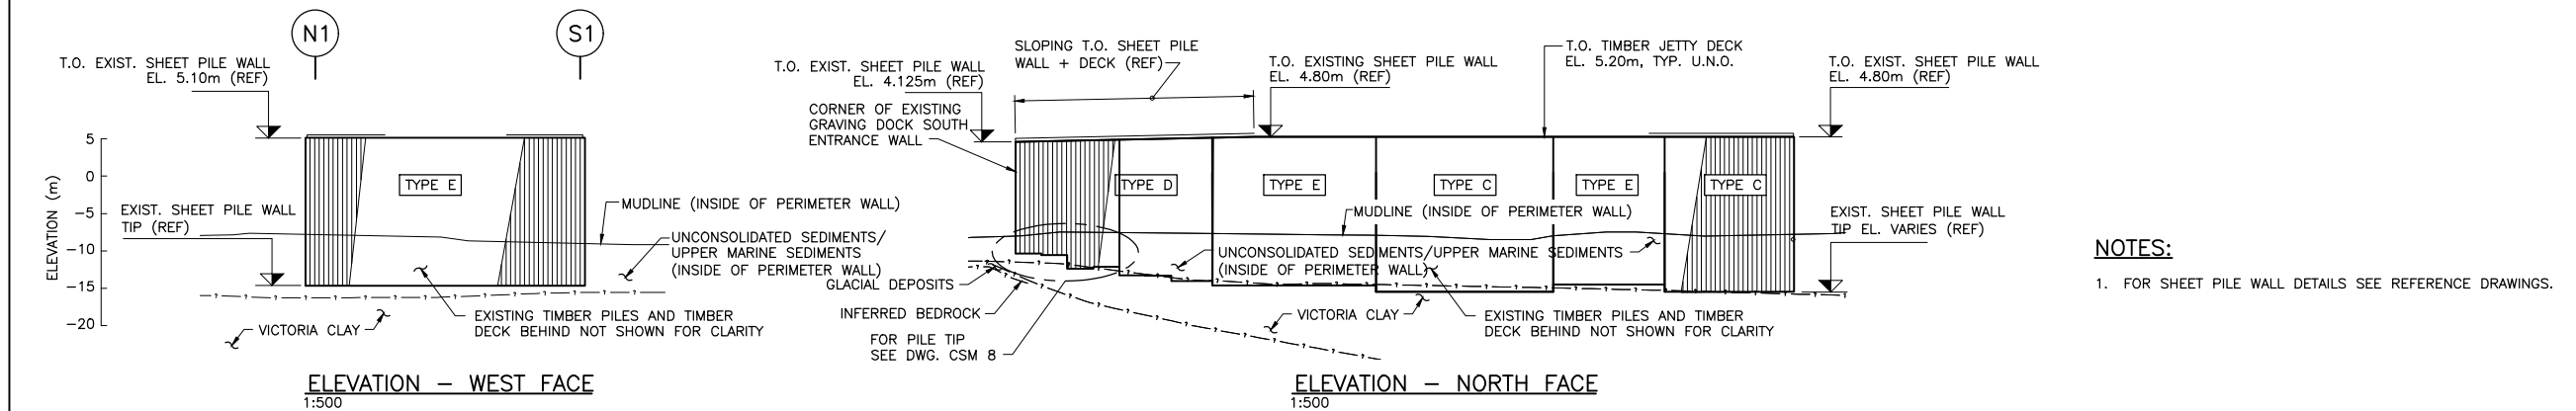

ELEVATION - WEST FACE
 1:500

ELEVATION - NORTH FACE
 1:500

NOTES:
 1. FOR SHEET PILE WALL DETAILS SEE REFERENCE DRAWINGS.

Revision/Revision	Description/Description	Date/Date
1	RECORD DRAWING	2017/03/29
0	ISSUED FOR TENDER	2014/12/19

Client/client
PUBLIC WORKS AND GOVERNMENT SERVICES CANADA

Project title/Titre du projet
**ESQUIMALT GRAVING DOCK
 825 ADMIRALS ROAD, VICTORIA, BC**

**ESQUIMALT GRAVING DOCK WATERLOT PHASE 2
 SOUTH JETTY UNDER-PIER SEDIMENT REMEDIATION**

Consultant Signature Only

Designed by/Concept par
JANET TONG


Drawn by/Desainé par
ARNIE RIST




PWGC Project Manager/Administrateur de Projets TPSCG
ANDREW MYLLY

Regional Manager, Environmental Services
COLLIN KINGMAN

Drawing title/Titre du dessin
WEST AND SOUTH JETTY SHEET PILE WALL EXISTING CONDITIONS

Project No./No. du projet R.018400.002	Sheet/ CSM3	Revision no./ 1
--------------------------------------------------	-----------------------	---------------------------

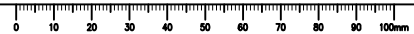

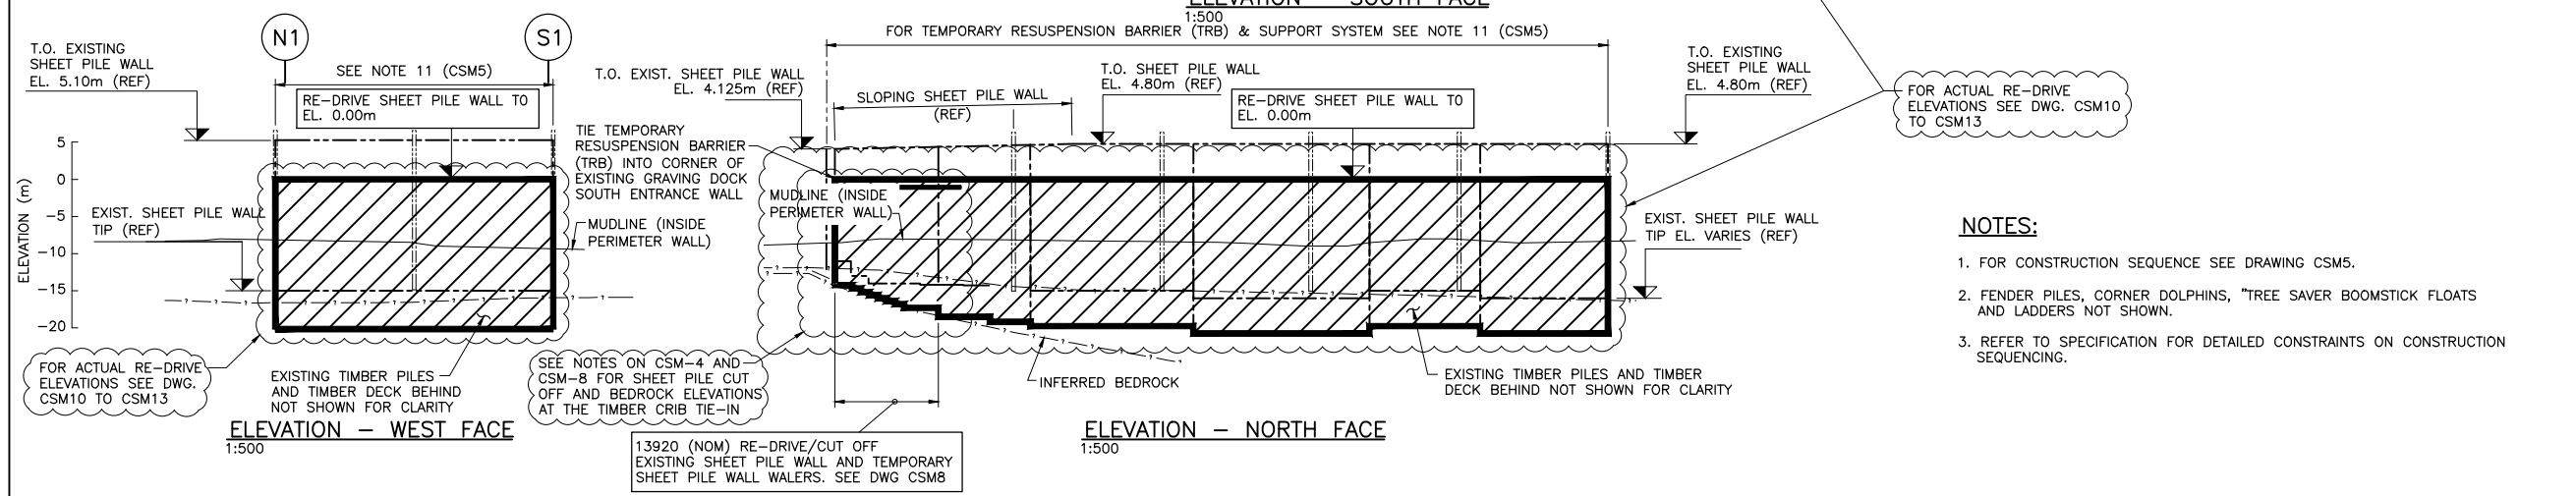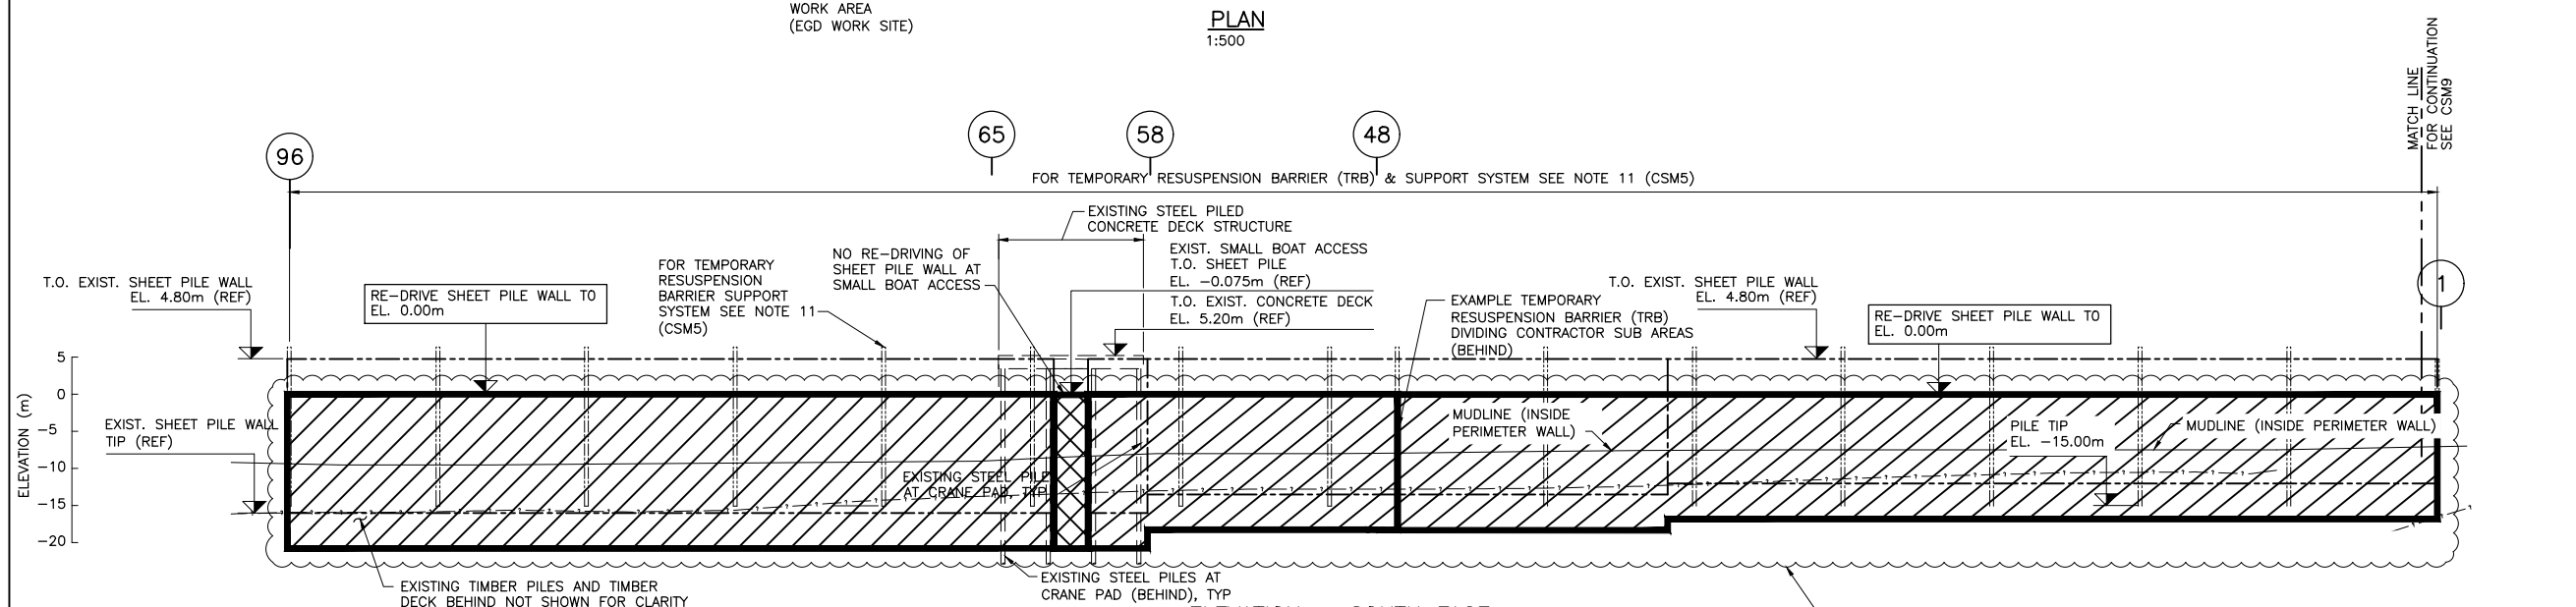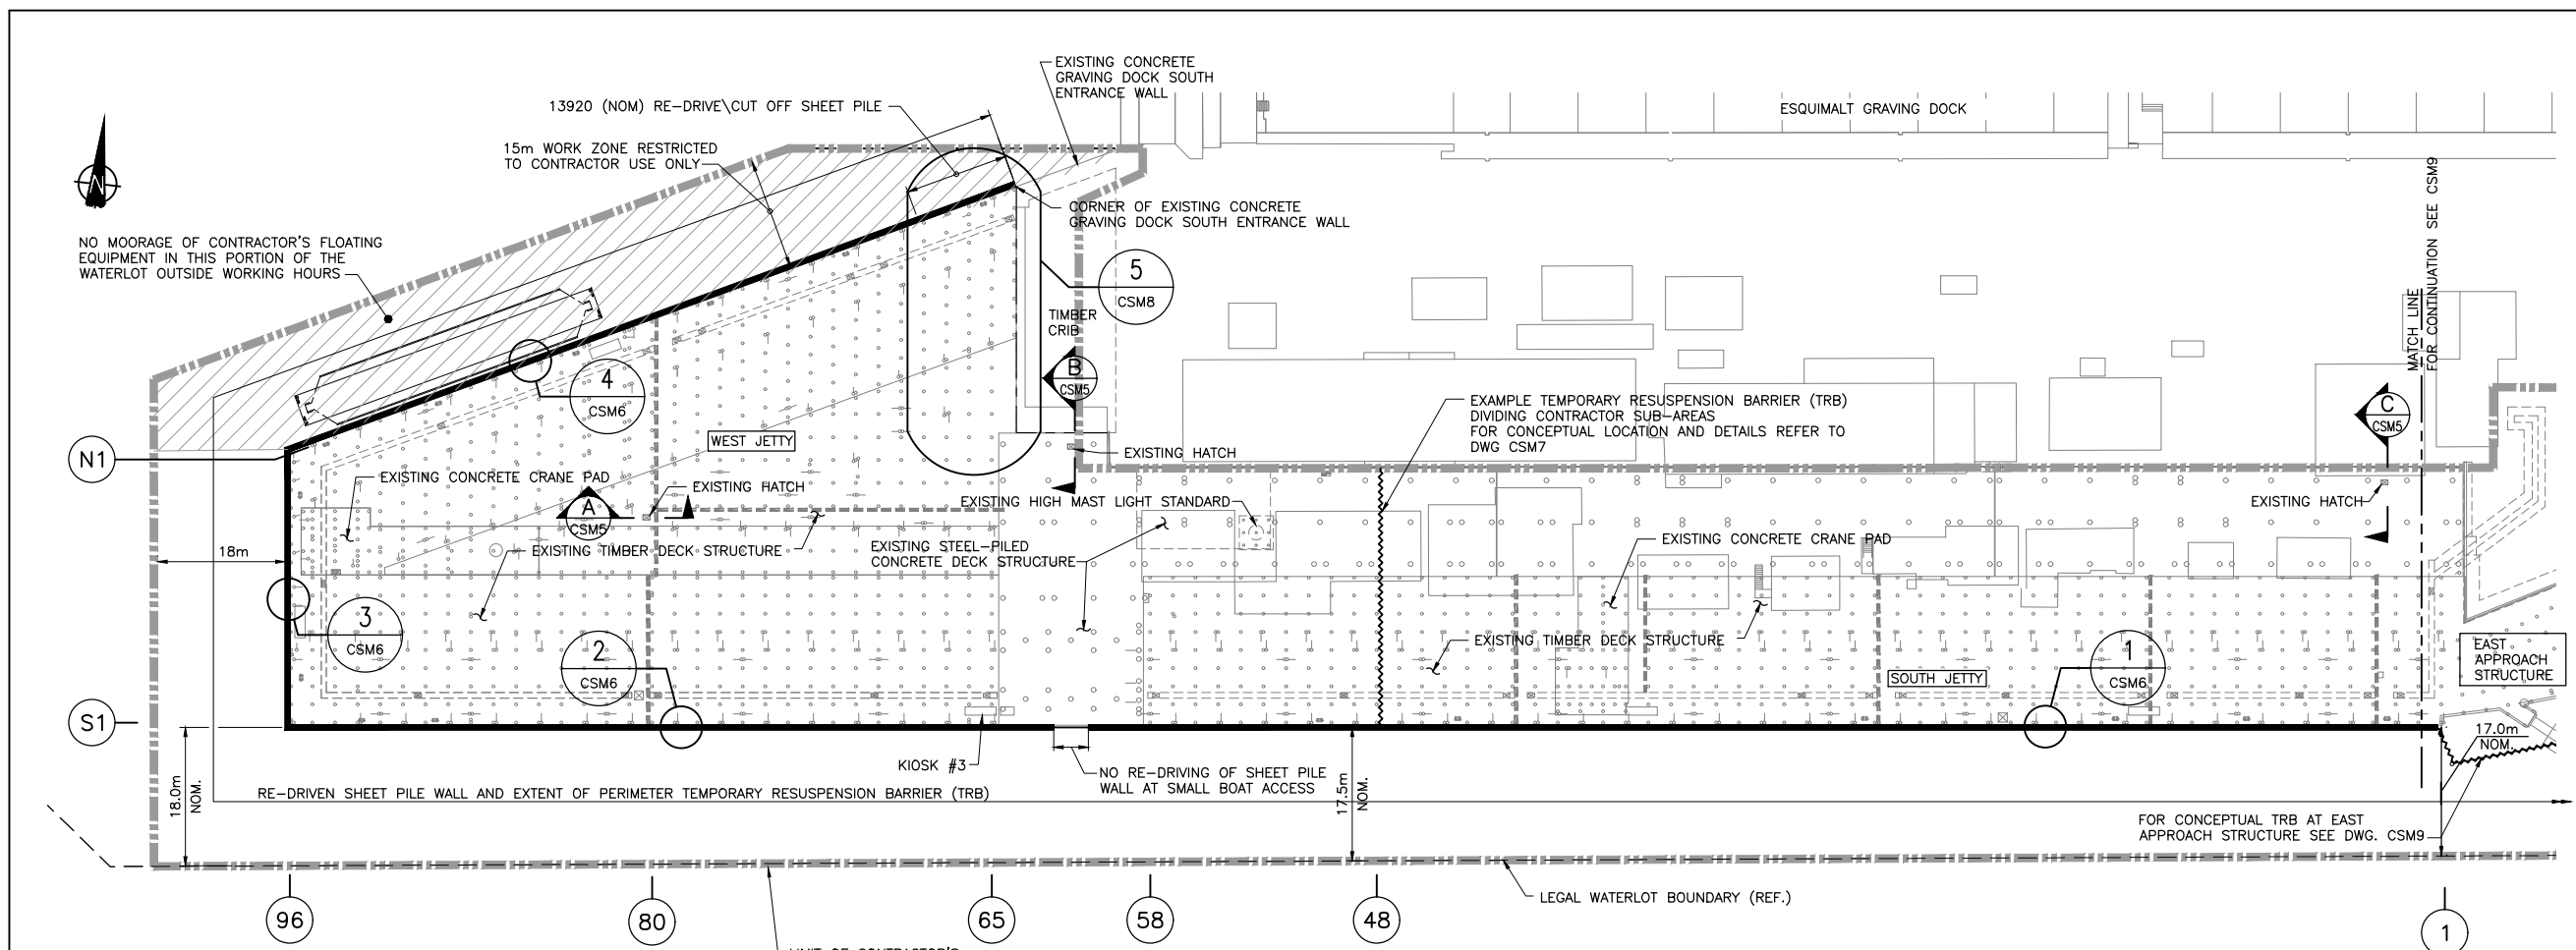

- NOTES:**
1. FOR CONSTRUCTION SEQUENCE SEE DRAWING CSM5.
 2. FENDER PILES, CORNER DOLPHINS, TREE SAVER BOOMSTICK FLOATS AND LADDERS NOT SHOWN.
 3. REFER TO SPECIFICATION FOR DETAILED CONSTRAINTS ON CONSTRUCTION SEQUENCING.

Revision/	Description/Description	Date/Date
1	RECORD DRAWING	2017/03/29
0	ISSUED FOR TENDER	2014/12/19

Client/client
PUBLIC WORKS AND GOVERNMENT SERVICES CANADA



Project title/Titre du projet
**ESQUIMALT GRAVING DOCK
 825 ADMIRALS ROAD, VICTORIA, BC**

**ESQUIMALT GRAVING DOCK
 WATERLOT PHASE 2
 SOUTH JETTY UNDER-PIER
 SEDIMENT REMEDIATION**

Consultant Signature Only
 Designed by/Concept par
 JANET TONG
 Drawn by/Desainé par
 ARNIE RIST
 PWGSC Project Manager/Administrateur de Projets TPSGC
 ANDREW MYLLY
 Regional Manager, Environmental Services
 COLLIN KINGMAN

Drawing title/Titre du dessin
**SHEET PILE WALL MODIFICATIONS
 PLAN AND ELEVATIONS**

Project No./No. du projet R.018400.002	Sheet/ CSM4	Revision no./ 1
--------------------------------------------------	-----------------------	---------------------------

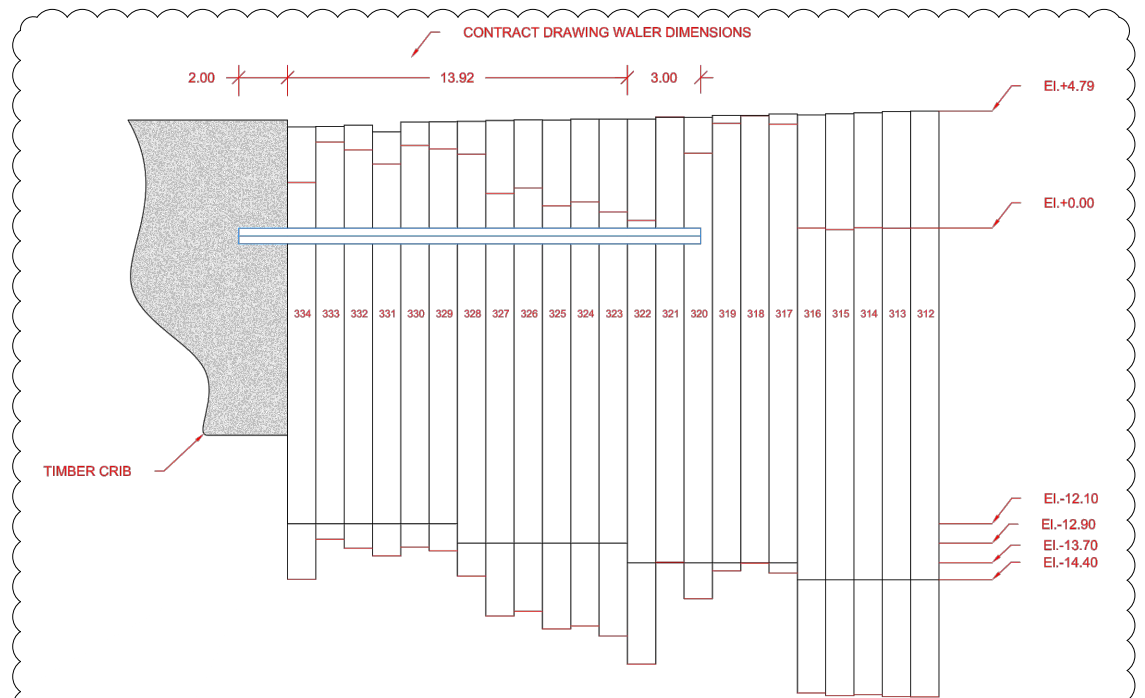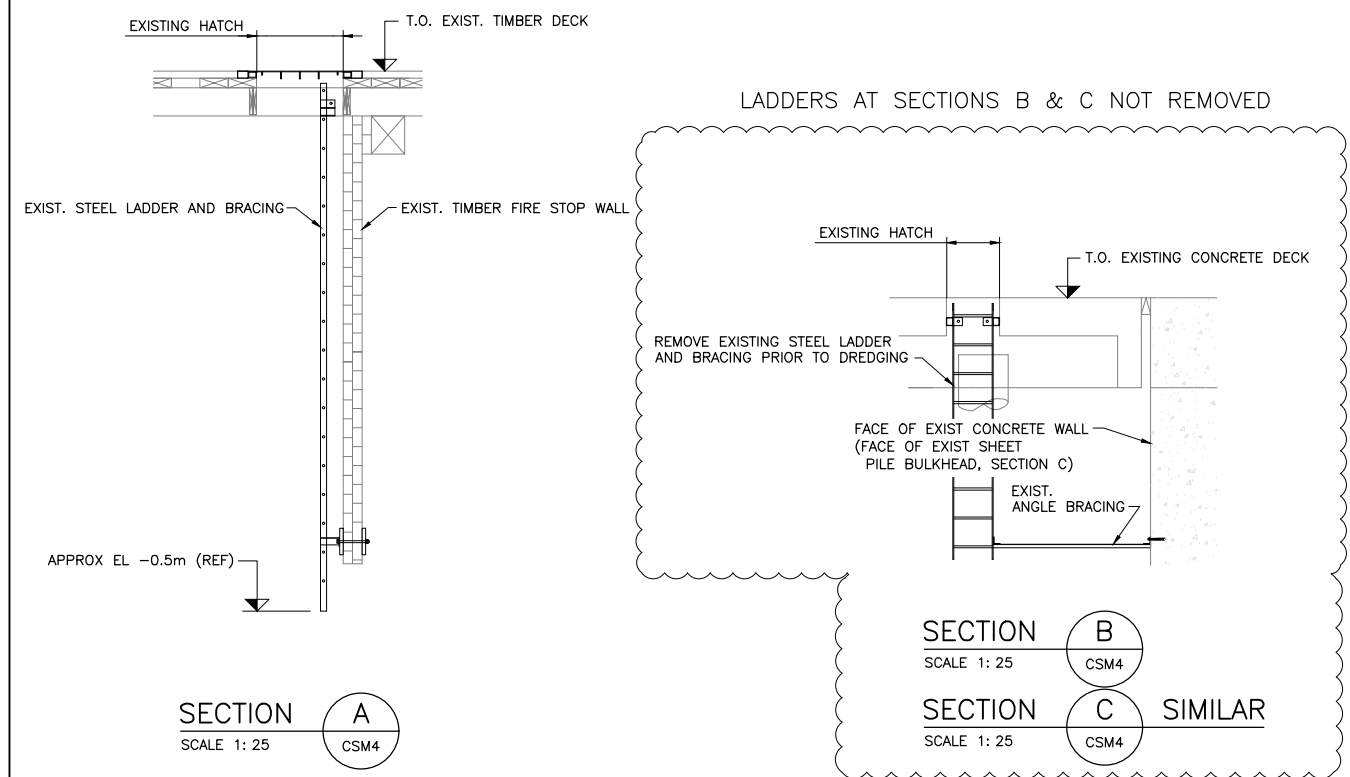

NORTH FACE PERIMETER SHEET PILE WALL PILE DRIVING RECORDS

Type	Pile Pair ID	Initial Top Elevation	Initial Tip Elevation	Final Top Elevation	Final Tip Elevation	Elevation of Bedrock
Type D	312	4.79	-14.40	0.00	-19.19	N/A
Type D	313	4.77	-14.40	-0.01	-19.18	N/A
Type D	314	4.72	-14.40	0.02	-19.10	N/A
Type D	315	4.68	-14.40	-0.06	-19.14	N/A
Type D	316	4.63	-14.40	0.00	-19.03	N/A
Type D	317	4.67	-13.70	4.25	-14.32	-14.32
Type D	318	4.61	-13.70	4.59	-13.72	-13.72
Type D	319	4.61	-13.70	4.28	-14.03	-14.03
Type D	320	4.51	-13.70	3.86	-15.17	-15.17
Type D	321	4.53	-13.70	4.55	-13.68	-13.68
Type D	322	4.46	-13.70	0.31	-17.85	-17.85
Type D	323	4.46	-12.90	0.66	-16.70	-16.70
Type D	324	4.46	-12.90	3.07	-16.29	-16.29
Type D	325	4.42	-12.90	0.91	-16.41	-16.41
Type D	326	4.43	-12.90	1.64	-15.69	-15.69
Type D	327	4.40	-12.90	1.42	-15.88	-15.88
Type D	328	4.37	-12.90	3.02	-14.25	-14.25
Type D	329	4.35	-12.10	3.24	-13.21	-13.21
Type D	330	4.34	-12.10	3.38	-13.06	-13.06
Type D	331	3.94	-12.10	2.62	-13.42	-13.42
Type D	332	4.21	-12.10	3.20	-13.11	-13.11
Type D	333	4.16	-12.10	3.52	-12.74	-12.74
Type D	334	4.14	-12.10	1.86	-14.38	-14.38

Initial Top Elevation based on survey during SPW re-drive. No records for 319 and 321 therefore assumed adjacent sheet pile top elevation.
 No pile driving records for piles 319, 320, and 321 however the pile driving foreman confirmed piles were driven to refusal.
 Initial Tip Elevation for piles 312 and 313 assumed to be El. -14.40m.
 Initial Tip Elevation based on record drawings.
 Initial Top Elevation recorded on March 11, March 15, or March 19. Highest Initial Top Elevation shown above.

INDICATIVE CONSTRUCTION SEQUENCE (SEE DWG CSM4):

- TEMPORARY RESUSPENSION BARRIER (TRB) ELEMENTS AND CONFIGURATIONS ARE SHOWN FOR ILLUSTRATIVE PURPOSES ONLY. CONTRACTOR'S THIRD PARTY ENGINEER SHALL VERIFY SPECIFIC DESIGN APPROACH FOR TEMPORARY RESUSPENSION BARRIER (TRB) SYSTEM.
- REMOVE "TREE SAVER BOOMSTICK" FENDER LOGS, GUIDE WIRES AND WEIGHTS AND DISPOSE OFF-SITE.
- REMOVE FENDER PILES, CORNER DOLPHINS AND CHOCKS AND STORE SELECTED FENDER PILES, CORNER DOLPHINS AND CHOCKS FOR RE-USE; DISPOSE OF REMAINING FENDER PILES AND CHOCKS. REMOVE TIMBER PILE SUPPORT BEAMS AND DISPOSE OFF-SITE.
- REMOVE LADDERS. STORE LADDERS REQUIRED FOR RE-USE. DISPOSE OF REMAINING LADDERS.
- DISCONNECT SHEET PILE WALL FROM STEEL WALER, REMOVE STEEL WALER (EXCEPT AS SHOWN ON DRAWING CSM8) AND DISPOSE OFF-SITE.
- INSTALL COVERS OVER VENT HOLES IN SHEET PILE WALL.
- DISCONNECT AND REMOVE STEEL FRAMING AT BOAT ACCESS OPENING AND DISPOSE OFF-SITE.
- RE-DRIVE EXISTING SHEET PILE WALL AS SHOWN.
- DURING RE-DRIVING OF SHEET PILES, MAINTAIN AND ADJUST THE EXISTING GEOTEXTILE AT OVERLAP JOINTS IN THE EXISTING STEEL SHEET PILE WALL AND AT THE NORTH WEST CORNER OF THE TIMBER CRIB, TO PROVIDE A CONTINUOUS AND UNBROKEN BARRIER FOR THE FULL HEIGHT OF THE RE-DRIVEN SHEET PILE WALL ABOVE MUD LINE.
- CUT EXISTING SHEET PILE WALL DOWN TO EL. 0.0m WHERE INDICATED.
- INSTALL TEMPORARY STEEL SUPPORT BRACING AT TIMBER CRIB.
- INSTALL TEMPORARY RESUSPENSION BARRIER (TRB) SYSTEM AS DESIGNED BY CONTRACTOR'S THIRD PARTY ENGINEER.
- REMOVE TIMBER PILED WEST JETTY AND SOUTH JETTY STRUCTURES AND EAST APPROACH STRUCTURE.
- REMOVE CONTAMINATED SEDIMENT BY DREDGING, AND INSTALL ENGINEERED CAPPING MATERIALS.
- INSTALL TIMBER FENDER PILES, CORNER DOLPHINS AND NAVIGATION MARKER DOLPHINS PRIOR TO PLACING ARMOUR ROCK.
- REMOVE TEMPORARY RESUSPENSION BARRIER (TRB) SYSTEM.
- EXTRACT RE-DRIVEN SHEET PILES AND DISPOSE OFF-SITE.

NOTE: FENDER PILES AND CHOCKS NOT RE-INSTALLED. SOME TIMBER PILES USED FOR CORNER DOLPHINS

NO LADDERS RE-USED

NOT INSTALLED

NOTE:

- REFER TO SPECIFICATION FOR DETAILED CONSTRAINTS ON CONSTRUCTION SEQUENCING.

Revision/Revision	Description/Description	Date/Date
1	RECORD DRAWING	2017/03/29
0	ISSUED FOR TENDER	2014/12/19

Client/client
PUBLIC WORKS AND GOVERNMENT SERVICES CANADA

Project title/Titre du projet
ESQUIMALT GRAVING DOCK
 825 ADMIRALS ROAD, VICTORIA, BC

ESQUIMALT GRAVING DOCK WATERLOT PHASE 2 SOUTH JETTY UNDER-PIER SEDIMENT REMEDIATION

Consultant Signature Only

Designed by/Concept par
 GEOFF COOPER


Drawn by/Desainé par
 ARNIE RIST


PWGC Project Manager/Administrateur de Projets TPSGC
 ANDREW MYLLY

Regional Manager, Environmental Services
 COLLIN KINGMAN

Drawing title/Titre du dessin
SHEET PILE WALL MODIFICATIONS NOTES AND SECTIONS


Project No./No. du projet	Sheet/	Revision no./
R.018400.002	CSM5	1

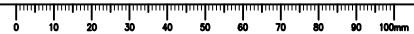

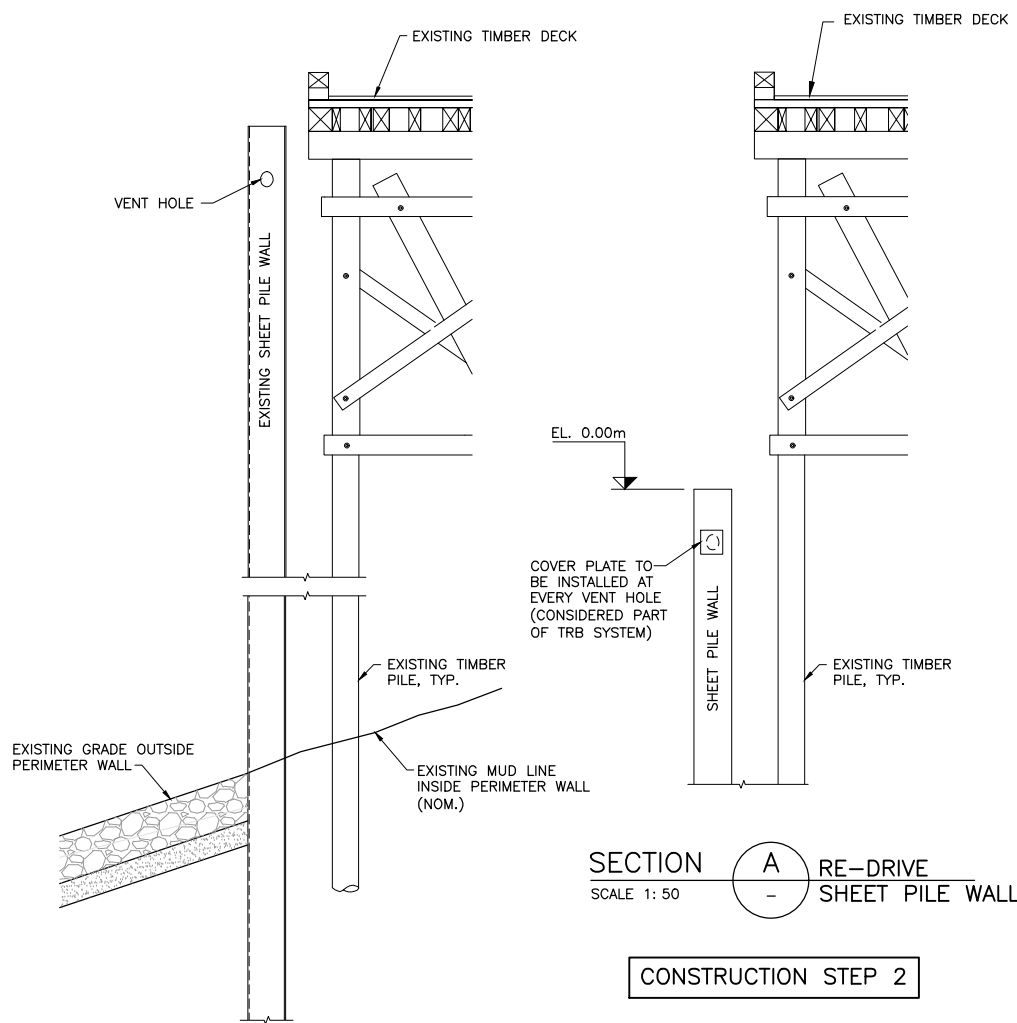


SECTION A RE-DRIVE SHEET PILE WALL SCALE 1:50

CONSTRUCTION STEP 2

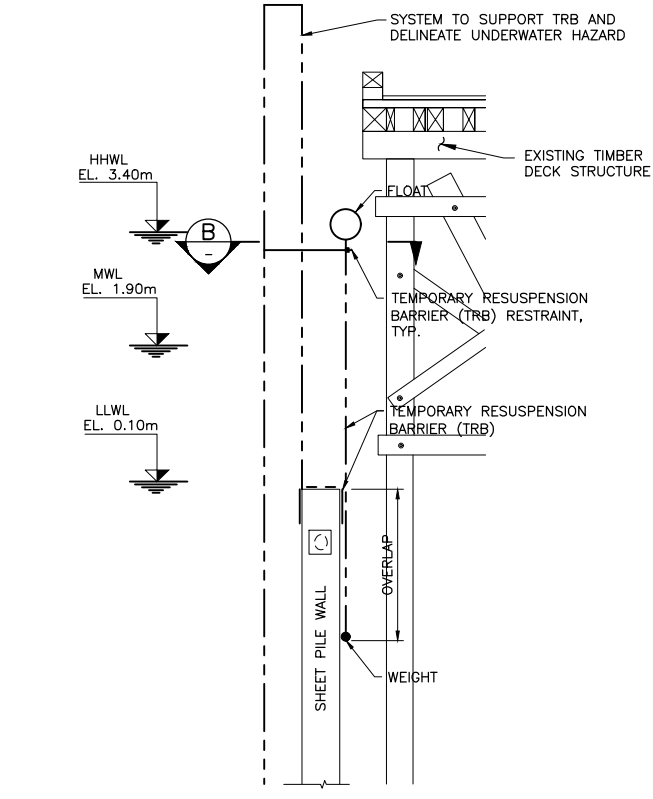


SECTION A TEMPORARY RESUSPENSION BARRIER (TRB) (CONTRACTOR'S DESIGN) SCALE 1:50

CONSTRUCTION STEP 3

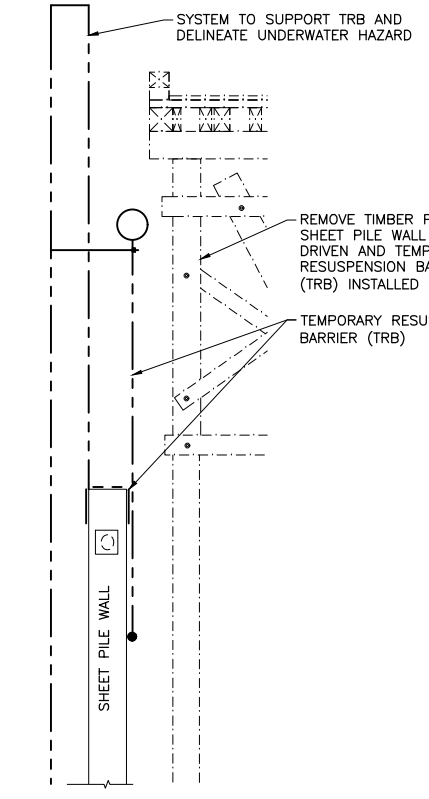


SECTION A TIMBER DECK STRUCTURE REMOVED SCALE 1:50

CONSTRUCTION STEP 4

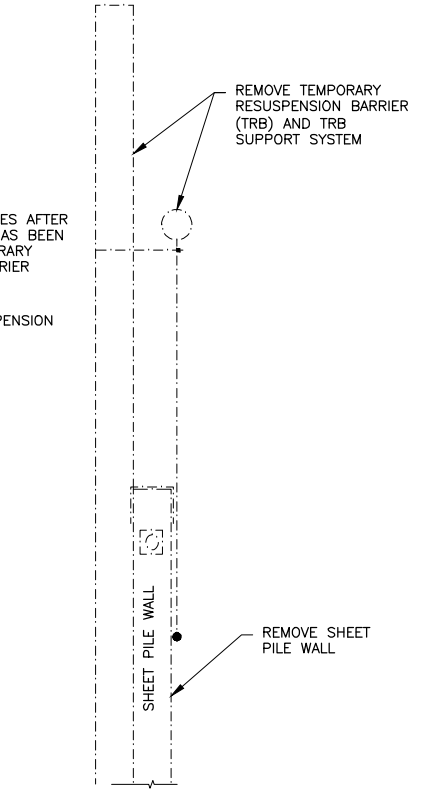


SECTION A SHEET PILE WALL & TRB REMOVED SCALE 1:50

CONSTRUCTION STEP 5

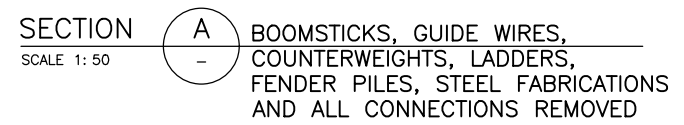


SECTION A BOOMSTICKS, GUIDE WIRES, COUNTERWEIGHTS, LADDERS, FENDER PILES, STEEL FABRICATIONS AND ALL CONNECTIONS REMOVED SCALE 1:50

CONSTRUCTION STEP 1

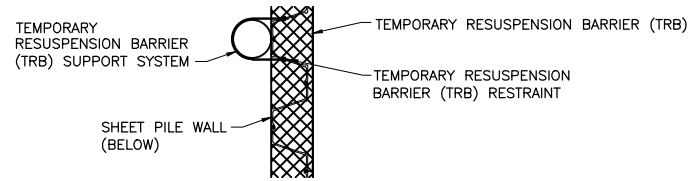

SECTION B SCALE 1:50

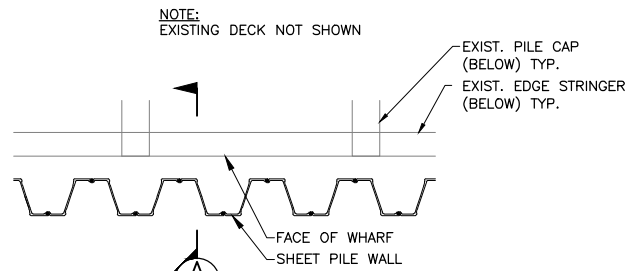

DETAIL 1 2 3 4 SCALE 1:50 CSM4 CSM4 CSM4 CSM4

NOTES:

- CONTRACTOR TO ENSURE THAT THE SHEET PILE WALL ELEVATION AT THE SMALL BOAT ACCESS DOES NOT CHANGE DURING RE-DRIVING OF ADJACENT SHEET PILES.
- TEMPORARY RESUSPENSION BARRIER (TRB) ELEMENTS AND CONFIGURATION ARE SHOWN FOR ILLUSTRATIVE PURPOSES ONLY.
- TEMPORARY RESUSPENSION BARRIER (TRB) SYSTEM INCLUDING SUPPORTING SYSTEM IS TO BE DESIGNED BY THE CONTRACTOR'S THIRD PART ENGINEER. SEE SPECIFICATION FOR PERFORMANCE CRITERIA.
- CONTRACTOR TO COVER VENT HOLES PRIOR TO RE-DRIVING SHEET PILES.
- THE RE-DRIVEN SHEET PILE WALL IS DESIGNED TO RESIST ENVIRONMENTAL FORCES (BUT NOT VESSEL IMPACT) EXERTED AS PRESSURE DISTRIBUTIONS AGAINST ITS FACE. CONTRACTOR'S DESIGN FOR TEMPORARY RESUSPENSION BARRIER (TRB) SHALL NOT CAUSE ANY ADDITIONAL LATERAL LOADING ON RE-DRIVEN SHEET PILE WALL.
- THE ELEVATION OF THE CONTRACTOR'S VESSEL PROPELLER MAY BE POSITIONED AT OR ABOVE THE SHEET PILE WALL ELEVATION DEPENDING ON WATER LEVEL. THE CONTRACTOR SHALL USE CAUTION WHEN OPERATING VESSELS DURING HIGH TIDE TO PREVENT PROPWASH FROM DISTURBING THE TRB IN ACCORDANCE WITH THE SPECIFICATIONS.

Revision/Revision	Description/Description	Date/Date
1	RECORD DRAWING	2017/03/29
0	ISSUED FOR TENDER	2014/12/19

Client/client
PUBLIC WORKS AND GOVERNMENT SERVICES CANADA

Project title/Titre du projet
ESQUIMALT GRAVING DOCK 825 ADMIRALS ROAD, VICTORIA, BC

ESQUIMALT GRAVING DOCK WATERLOT PHASE 2 SOUTH JETTY UNDER-PIER SEDIMENT REMEDIATION

Consultant Signature Only

Designed by/Concept par
BILL CHRISTENSEN


Drawn by/Desainé par
ARNIE RIST


PWGC Project Manager/Administrateur de Projets TPSGC
ANDREW MYLLY

Regional Manager, Environmental Services
COLLIN KINGMAN


Drawing title/Titre du dessin
SHEET PILE WALL MODIFICATIONS CONSTRUCTION SEQUENCE

Project No./No. du projet R.018400.002	Sheet/ CSM6	Revision no./ 1
--------------------------------------------------	-----------------------	---------------------------

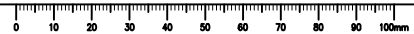


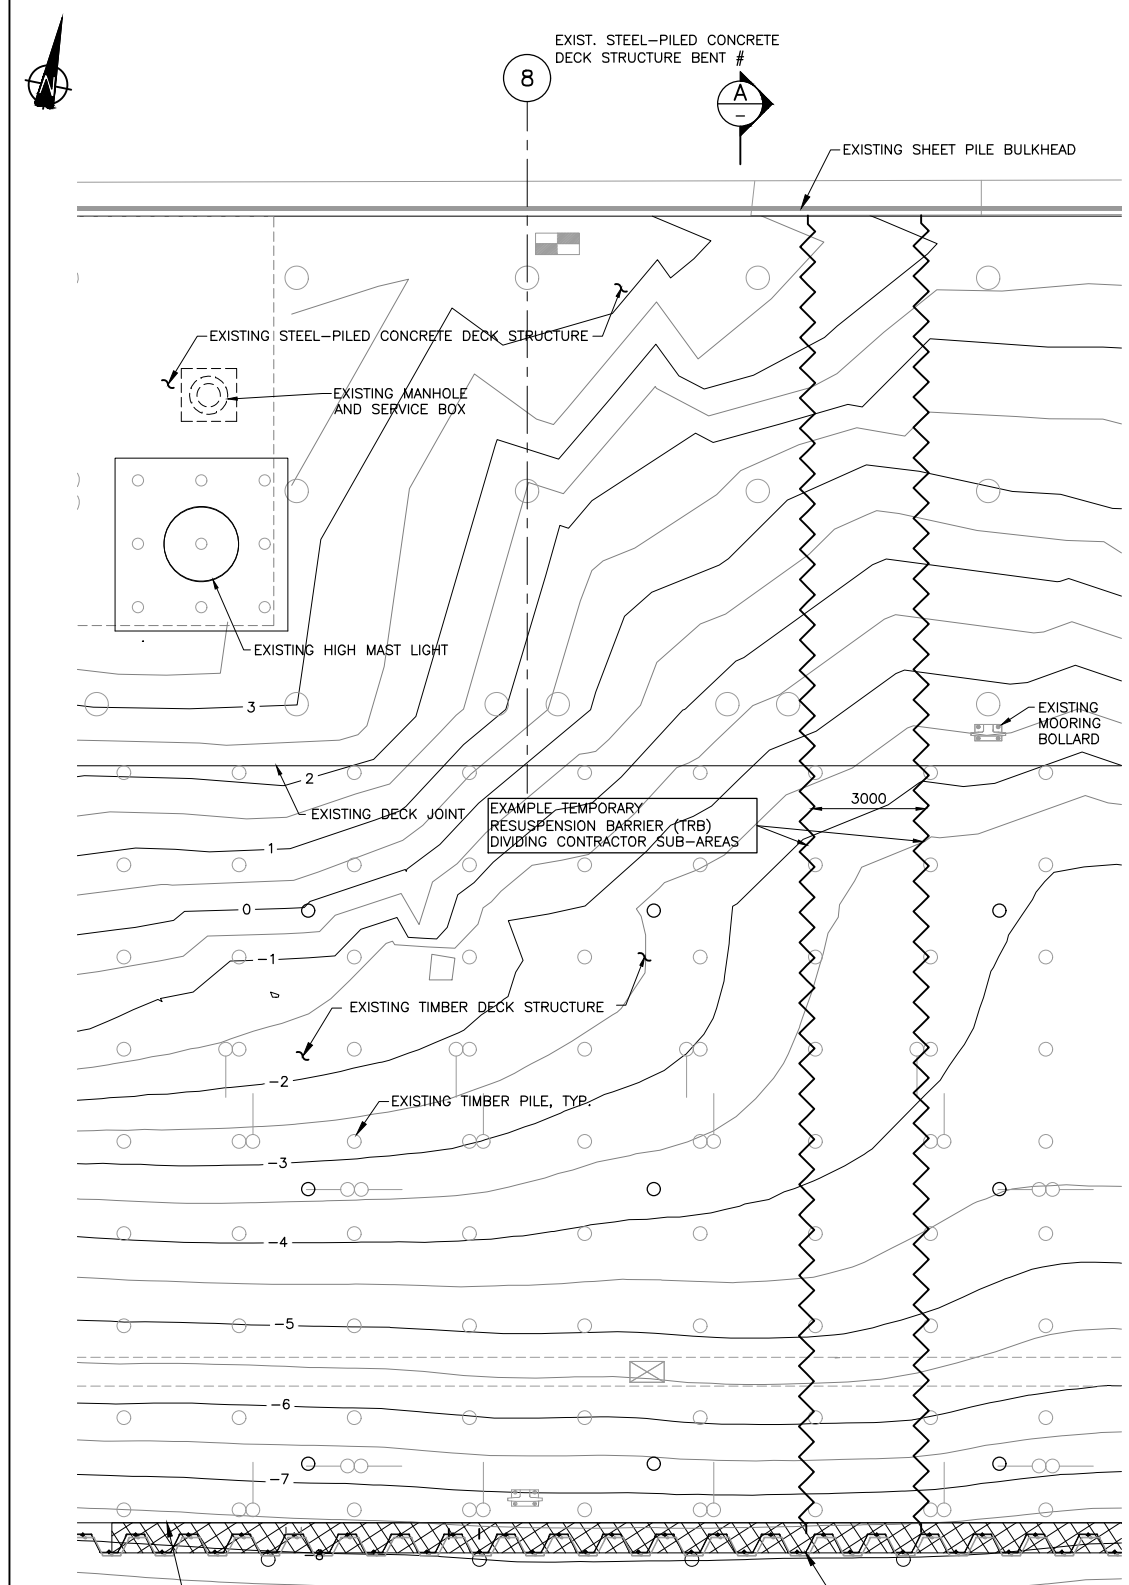

PLAN
1:100

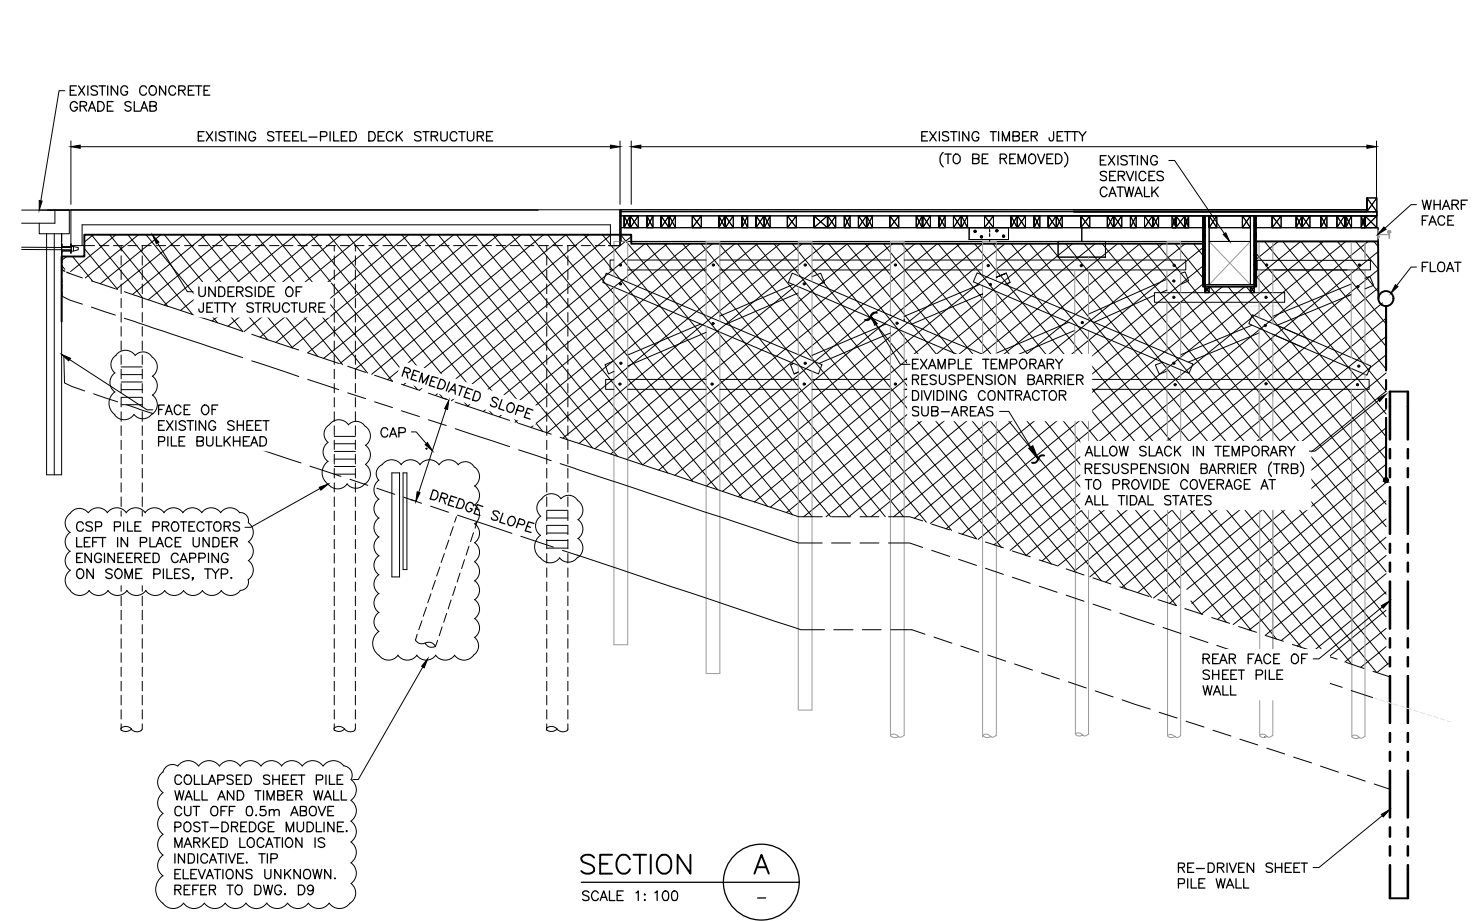

SECTION A
SCALE 1: 100

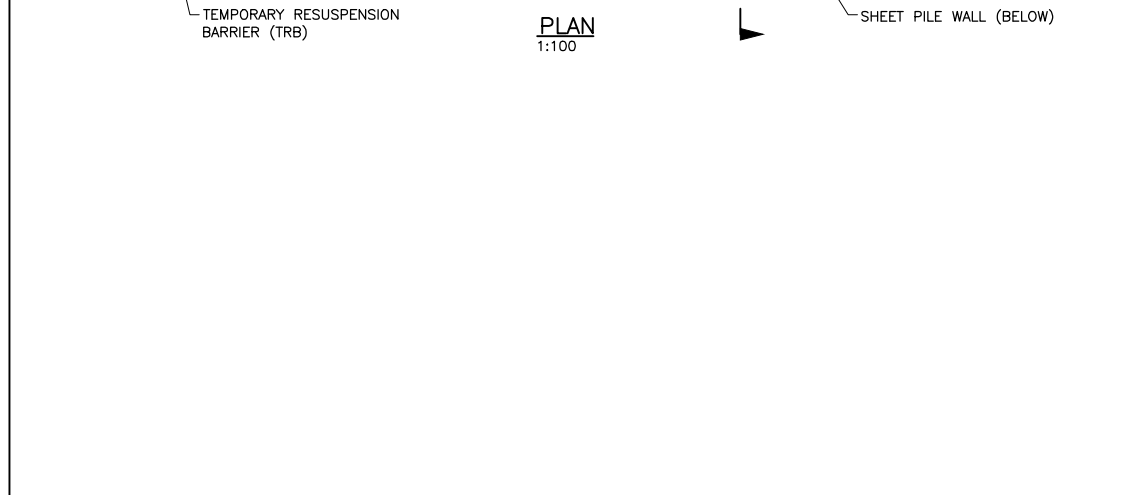

- NOTES:**
1. TEMPORARY RESUSPENSION BARRIER (TRB) ELEMENTS AND CONFIGURATION ARE SHOWN FOR ILLUSTRATIVE PURPOSES ONLY.
 2. TEMPORARY RESUSPENSION BARRIER (TRB) SYSTEM INCLUDING SUPPORTING SYSTEM IS TO BE DESIGNED BY THE CONTRACTOR'S THIRD PARTY ENGINEER. SEE SPECIFICATION FOR PERFORMANCE CRITERIA.

1	RECORD DRAWING	2017/03/29
0	ISSUED FOR TENDER	2014/12/19
Revision/	Description/Description	Date/Date


Client/client
PUBLIC WORKS AND GOVERNMENT SERVICES CANADA

Project title/Titre du projet
ESQUIMALT GRAVING DOCK
 825 ADMIRALS ROAD, VICTORIA, BC
ESQUIMALT GRAVING DOCK WATERLOT PHASE 2
SOUTH JETTY UNDER-PIER SEDIMENT REMEDIATION


Consultant Signature Only
 Designed by/Concept par
BILL CHRISTENSEN
 Drawn by/Dessiné par
ARNIE RIST
 PWSC Project Manager/Administrateur de Projets TPSC
ANDREW MYLLY
 Regional Manager, Environmental Services
COLLIN KINGMAN

Drawing title/Titre du dessin
SHEET PILE WALL MODIFICATIONS
DETAILS - SHEET 1


Project No./No. du projet R.018400.002	Sheet/ CSM7	Revision no./ 1
--------------------------------------------------	-----------------------	---------------------------

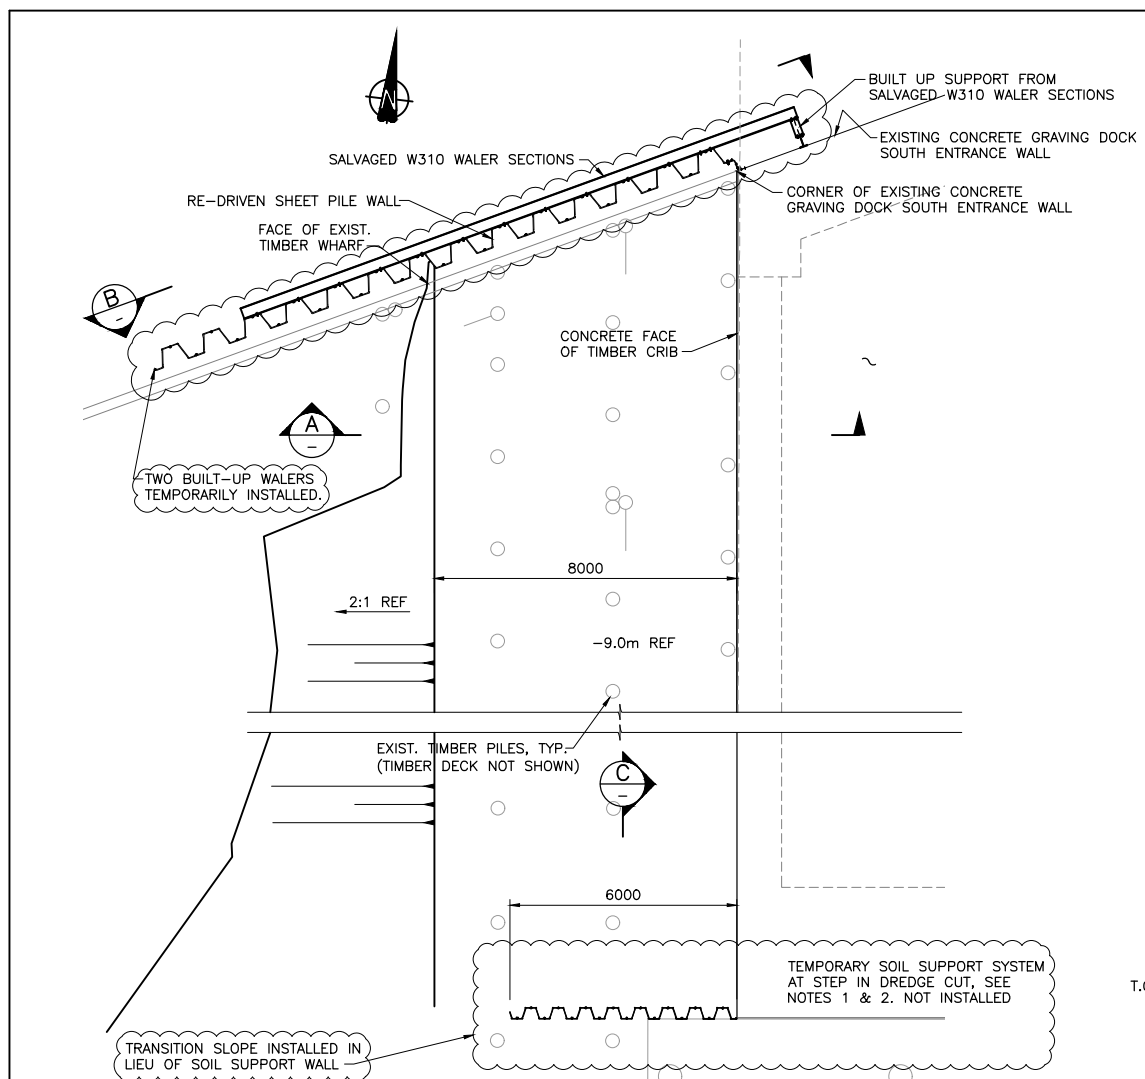


DETAIL 5
 SCALE 1: 100
 CSM4

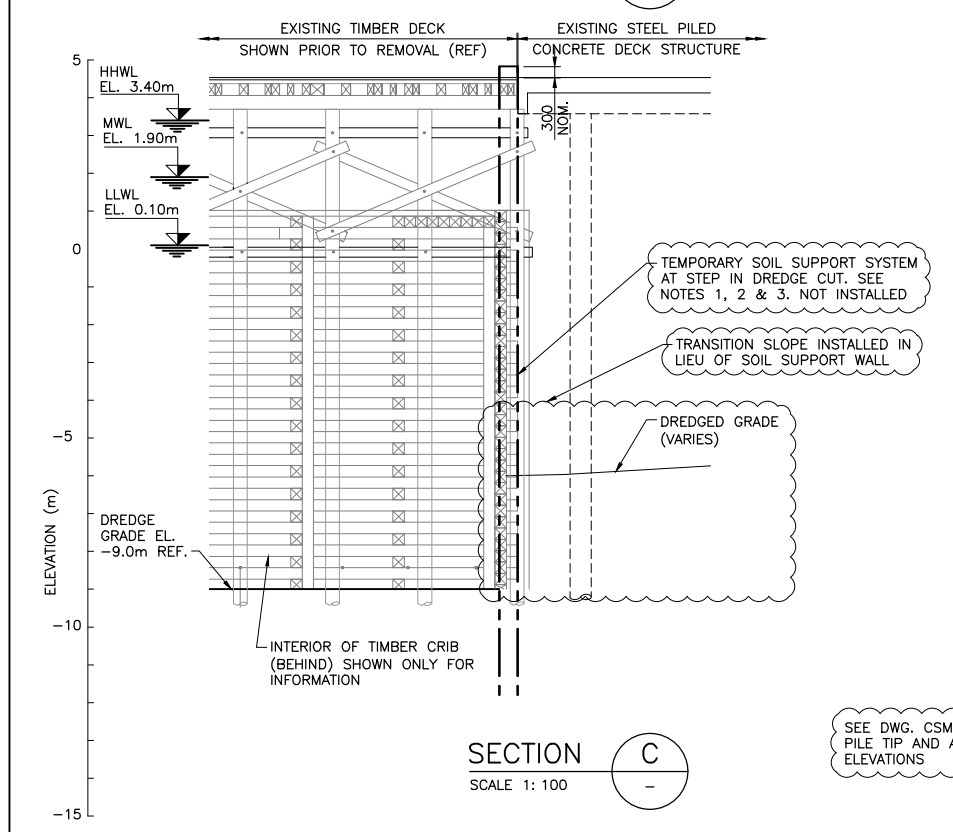

SECTION C
 SCALE 1: 100

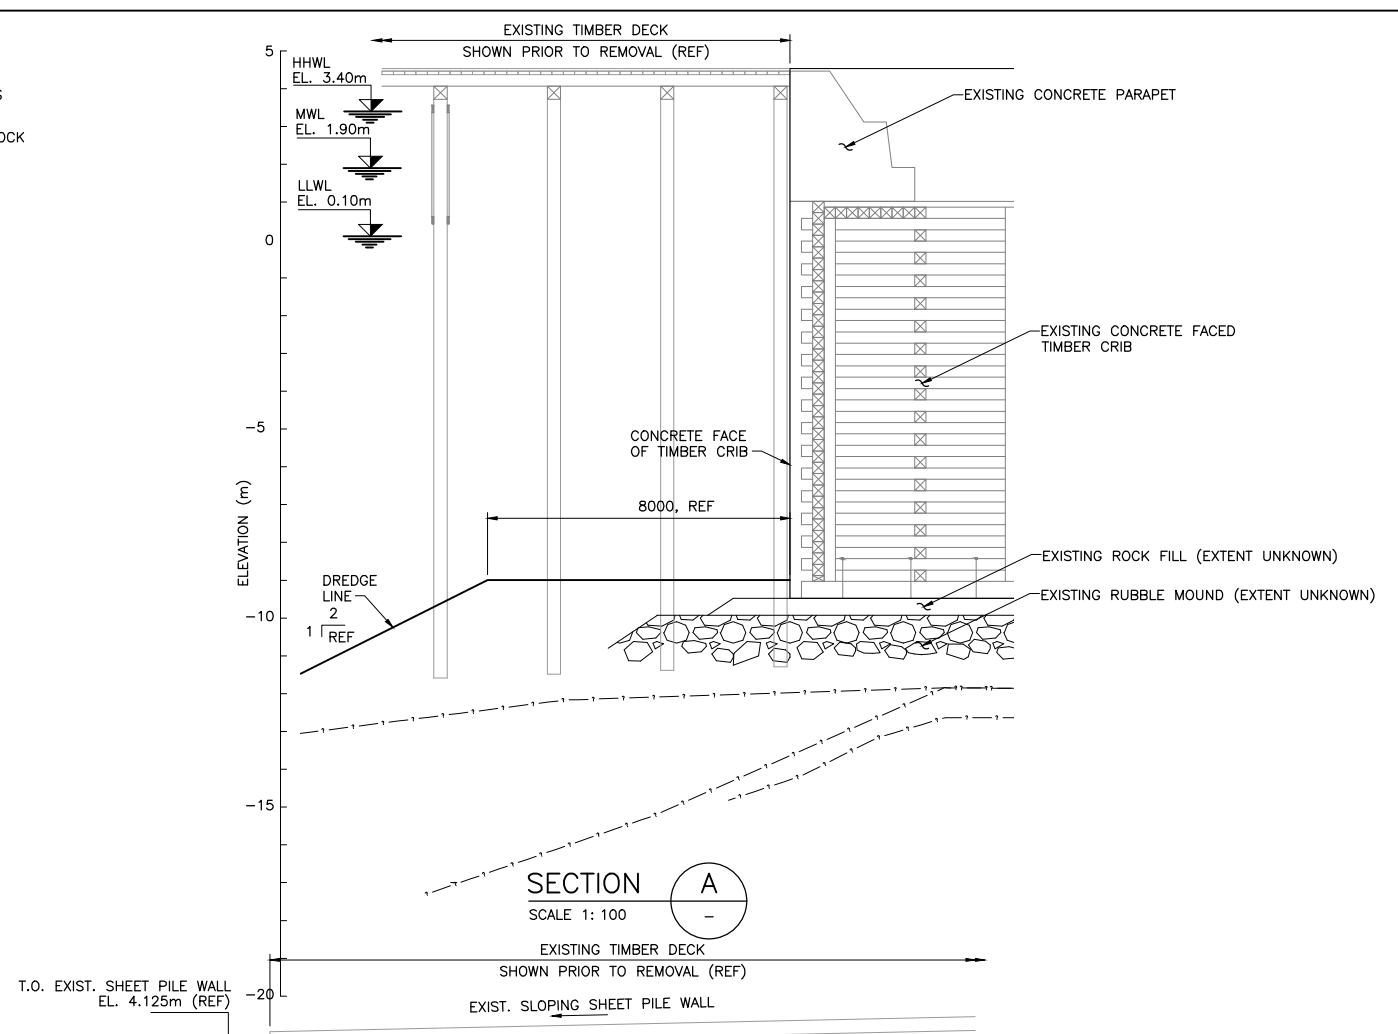

SECTION A
 SCALE 1: 100

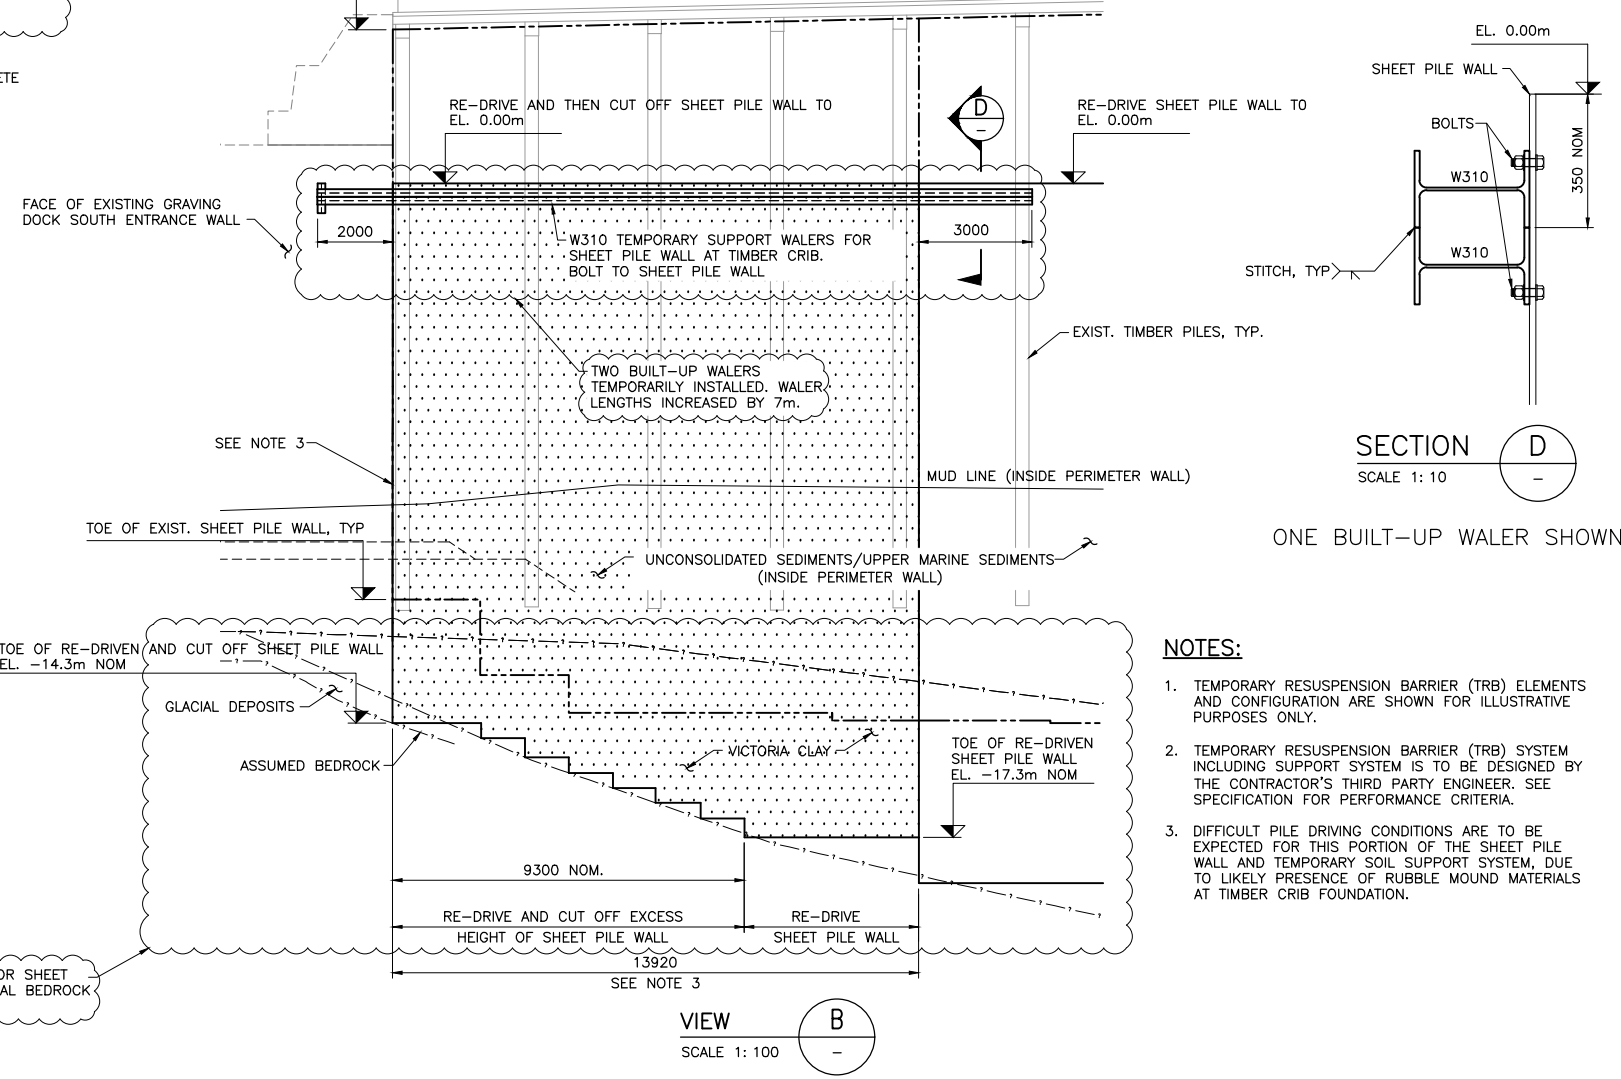

VIEW B
 SCALE 1: 100

- NOTES:**
1. TEMPORARY RESUSPENSION BARRIER (TRB) ELEMENTS AND CONFIGURATION ARE SHOWN FOR ILLUSTRATIVE PURPOSES ONLY.
 2. TEMPORARY RESUSPENSION BARRIER (TRB) SYSTEM INCLUDING SUPPORT SYSTEM IS TO BE DESIGNED BY THE CONTRACTOR'S THIRD PARTY ENGINEER. SEE SPECIFICATION FOR PERFORMANCE CRITERIA.
 3. DIFFICULT PILE DRIVING CONDITIONS ARE TO BE EXPECTED FOR THIS PORTION OF THE SHEET PILE WALL AND TEMPORARY SOIL SUPPORT SYSTEM, DUE TO LIKELY PRESENCE OF RUBBLE MOUND MATERIALS AT TIMBER CRIB FOUNDATION.

Revision/Revision	Description/Description	Date/Date
1	RECORD DRAWING	2017/03/29
0	ISSUED FOR TENDER	2014/12/19

PUBLIC WORKS AND GOVERNMENT SERVICES CANADA

Project title/Titre du projet
ESQUIMALT GRAVING DOCK
 825 ADMIRALS ROAD, VICTORIA, BC

ESQUIMALT GRAVING DOCK WATERLOT PHASE 2 SOUTH JETTY UNDER-PIER SEDIMENT REMEDIATION

Consultant Signature Only

Designed by/Concept par
 BILL CHRISTENSEN


Drawn by/Desainé par
 ARNIE RIST

PWGC Project Manager/Administrateur de Projets TPSCG
 ANDREW MYLLY


Regional Manager, Environmental Services
 COLLIN KINGMAN

Drawing title/Titre du dessin
SHEET PILE WALL MODIFICATIONS DETAILS - SHEET 2


Project No./No. du projet R.018400.002	Sheet/ CSM8	Revision no./ 1
--------------------------------------------------	-----------------------	---------------------------

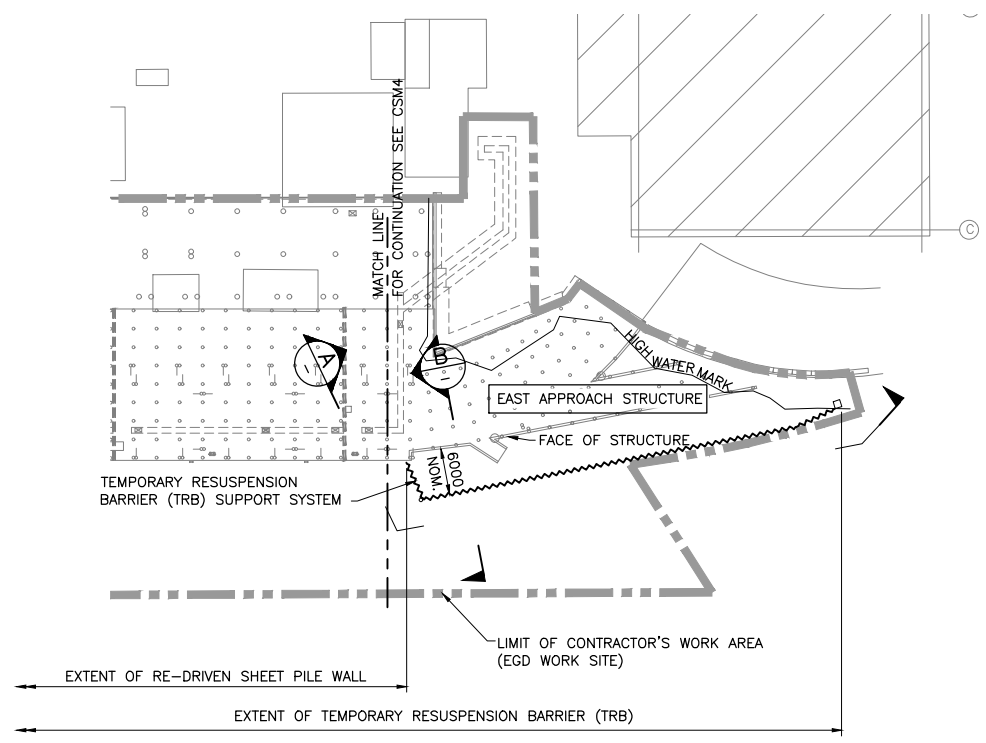

PLAN
SCALE 1:250

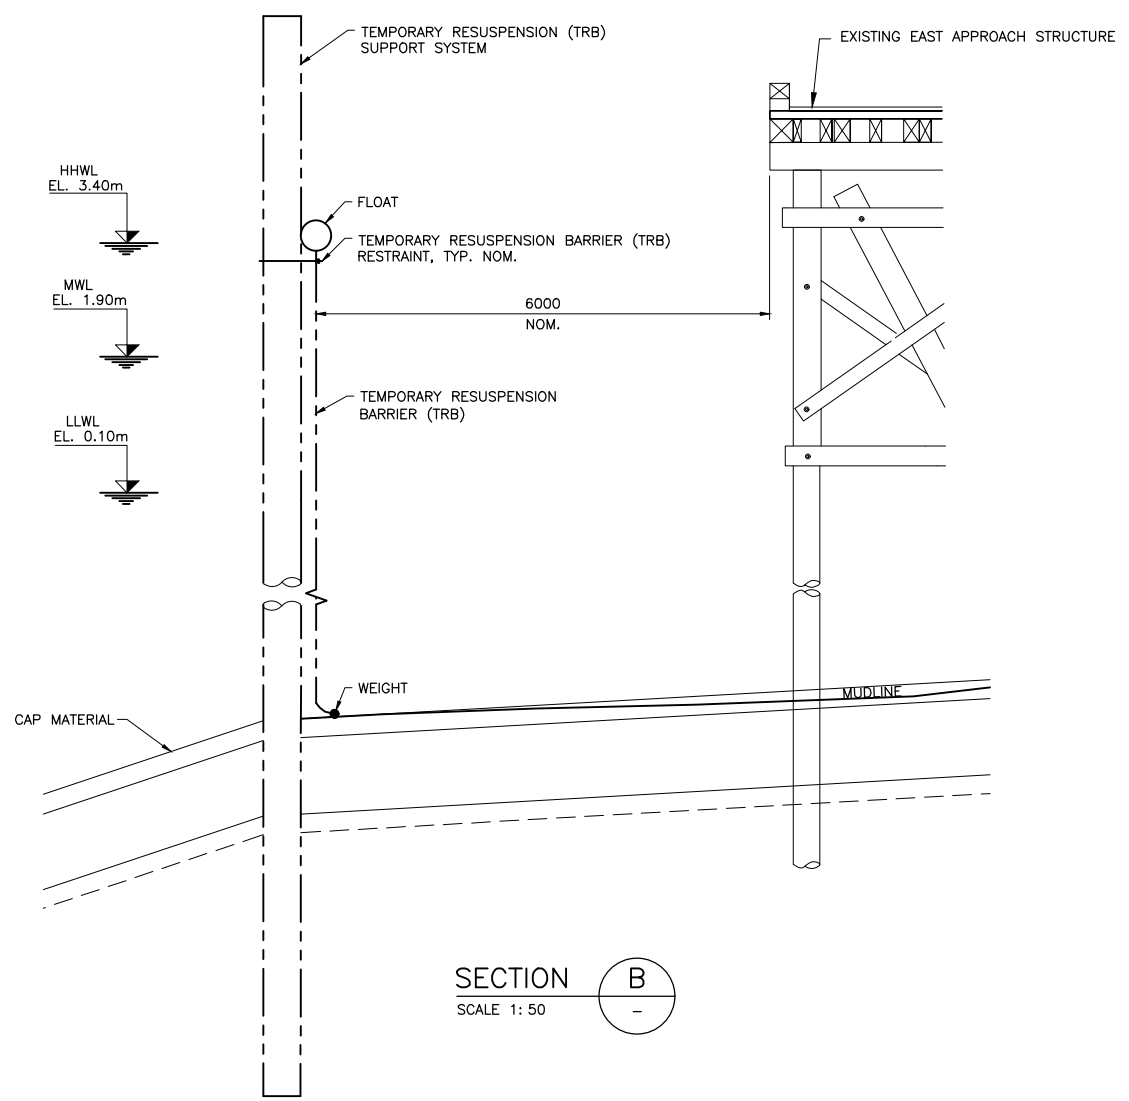

SECTION B
SCALE 1:50

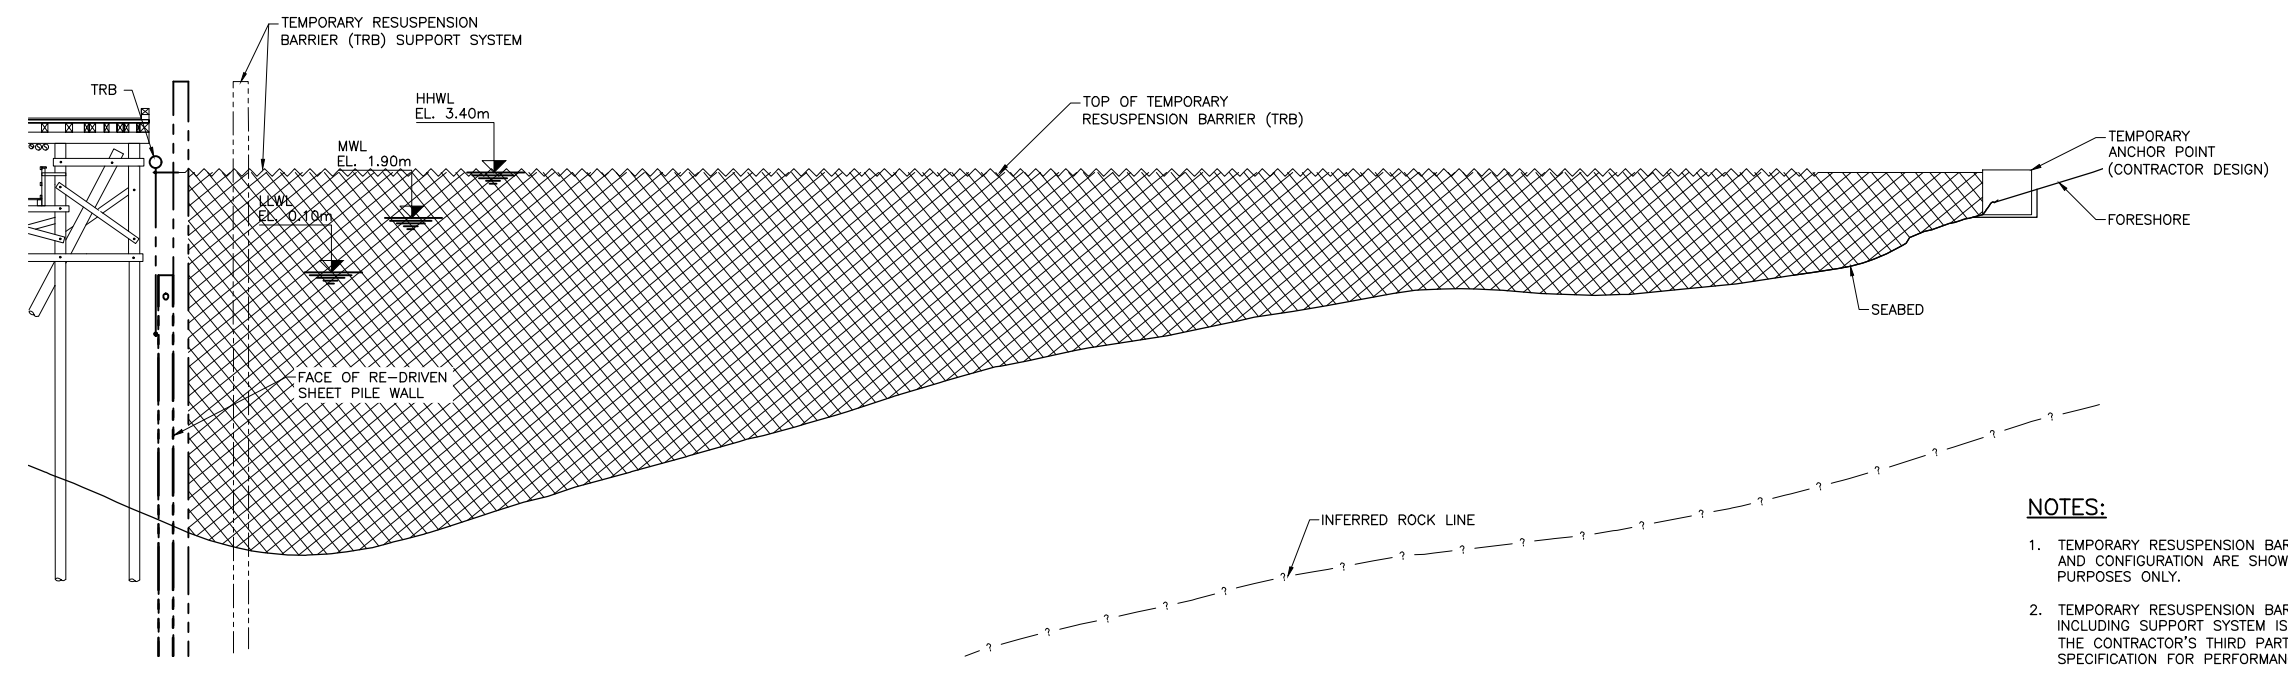

ELEVATION - DEVELOPED A
SCALE 1:125

NOTES:

1. TEMPORARY RESUSPENSION BARRIER (TRB) ELEMENTS AND CONFIGURATION ARE SHOWN FOR ILLUSTRATIVE PURPOSES ONLY.
2. TEMPORARY RESUSPENSION BARRIER (TRB) SYSTEM INCLUDING SUPPORT SYSTEM IS TO BE DESIGNED BY THE CONTRACTOR'S THIRD PARTY ENGINEER. SEE SPECIFICATION FOR PERFORMANCE CRITERIA.

Revision/Revision	Description/Description	Date/Date
1	RECORD DRAWING	2017/03/29
0	ISSUED FOR TENDER	2014/12/19

Client/client
PUBLIC WORKS AND GOVERNMENT SERVICES CANADA

Project title/Titre du projet
**ESQUIMALT GRAVING DOCK
825 ADMIRALS ROAD, VICTORIA, BC**

**ESQUIMALT GRAVING DOCK
WATERLOT PHASE 2
SOUTH JETTY UNDER-PIER
SEDIMENT REMEDIATION**

Consultant Signature Only
Designed by/Concept par
BILL CHRISTENSEN
Drawn by/Desainé par
ARNIE RIST
PWSC Project Manager/Administrateur de Projets TPSGC
ANDREW MYLLY
Regional Manager, Environmental Services
COLLIN KINGMAN

Drawing title/Titre du dessin
**SHEET PILE WALL MODIFICATIONS
DETAILS - SHEET 3**

Project No./No. du projet	Sheet/feuille	Revision no./no. de révisión
R.018400.002	CSM9	1

PILE DRIVING RECORD - CORNER DOLPHIN PILES
PILE TYPE: CREOSOTE TIMBER PILE (RE-USED MATERIAL)
EQUIPMENT: ICE 416L VIBRATORY HAMMER WITH TIMBER HEAD ATTACHMENT

PILE NUMBER	LOCATION	DATE	PILE LENGTH	FINAL CUT OFF ELEVATION	EMBEDMENT	NOTES	LOCATION SKETCH
1	NW CORNER OF TIMBER CRIB	08-Nov-16	21.6m	6.00m CHART DATUM	4.7m	PILE WAS DRIVEN TO REFUSAL	
2	NW CORNER OF TIMBER CRIB	08-Nov-16	21.9m	6.00m CHART DATUM	4.5m	PILE WAS DRIVEN TO REFUSAL	
3	NW CORNER OF TIMBER CRIB	08-Nov-16	21.9m	6.00m CHART DATUM	3.7m	PILE WAS DRIVEN TO REFUSAL	
4	NW CORNER OF TIMBER CRIB	09-Nov-16	21.9m	6.00m CHART DATUM	4.6m	PILE WAS DRIVEN TO REFUSAL IN TWO ATTEMPTS	
5	NW CORNER OF TIMBER CRIB	09-Nov-16	21.9m	6.00m CHART DATUM	3.7m	PILE WAS DRIVEN TO REFUSAL	

PILE NUMBER	LOCATION	DATE	PILE LENGTH	FINAL CUT OFF ELEVATION	EMBEDMENT	NOTES	LOCATION SKETCH
1	SW CORNER OF TIMBER CRIB	10-Nov-16	21.6m	6.00m CHART DATUM	7.9m	PILE DID NOT HIT REFUSAL	
2	SW CORNER OF TIMBER CRIB	10-Nov-16	21.6m	6.00m CHART DATUM	9.1m	PILE DID NOT HIT REFUSAL	
3	SW CORNER OF TIMBER CRIB	10-Nov-16	21.9m	6.00m CHART DATUM	7.3m	PILE DID NOT HIT REFUSAL	
4	SW CORNER OF TIMBER CRIB	10-Nov-16	22.0m	6.00m CHART DATUM	7.4m	PILE DID NOT HIT REFUSAL	
5	SW CORNER OF TIMBER CRIB	10-Nov-16	21.6m	6.00m CHART DATUM	9.8m	PILE DID NOT HIT REFUSAL	


PILE NUMBER	LOCATION	DATE	PILE LENGTH	FINAL CUT OFF ELEVATION	EMBEDMENT	NOTES	LOCATION SKETCH
1	SW CORNER OF CONC. JETTY	17-Nov-16	21.9m	6.00m CHART DATUM	6.1m	PILE DID NOT HIT REFUSAL	
2	SW CORNER OF CONC. JETTY	17-Nov-16	21.9m	6.00m CHART DATUM	6.1m	PILE DID NOT HIT REFUSAL	
3	SW CORNER OF CONC. JETTY	17-Nov-16	21.9m	6.00m CHART DATUM	6.1m	PILE DID NOT HIT REFUSAL	
4	SW CORNER OF CONC. JETTY	17-Nov-16	21.9m	6.00m CHART DATUM	6.1m	PILE DID NOT HIT REFUSAL	
5	SW CORNER OF CONC. JETTY	17-Nov-16	21.9m	6.00m CHART DATUM	6.1m	PILE DID NOT HIT REFUSAL	

PILE NUMBER	LOCATION	DATE	PILE LENGTH	FINAL CUT OFF ELEVATION	EMBEDMENT	NOTES	LOCATION SKETCH
1	SE CORNER OF CONC. JETTY	30-Nov-16	21.6m	6.00m CHART DATUM	5.5m	PILE DID NOT HIT REFUSAL	
2	SE CORNER OF CONC. JETTY	30-Nov-16	21.3m	6.00m CHART DATUM	5.5m	PILE DID NOT HIT REFUSAL	
3	SE CORNER OF CONC. JETTY	30-Nov-16	21.8m	6.00m CHART DATUM	5.8m	PILE DID NOT HIT REFUSAL	
4	SE CORNER OF CONC. JETTY	30-Nov-16	21.9m	6.00m CHART DATUM	5.8m	PILE DID NOT HIT REFUSAL	
5	SE CORNER OF CONC. JETTY	01-Dec-16	21.6m	6.00m CHART DATUM	5.5m	PILE DID NOT HIT REFUSAL	

CORNER DOLPHINS – PILE DRIVING RECORDS

PILE DRIVING RECORD - NAVIGATION MARKER MONOPILES
PILE TYPE: 914mm O.D. x 19.1mm THICK WALL, STEEL PIPE PILE
EQUIPMENT: APE MODEL 300 VIBRATORY EXTRACTOR WITH CAISSON BEAM

PILE NUMBER	LOCATION	DATE	PILE LENGTH	FINAL CUT OFF ELEVATION	EMBEDMENT	NOTES
1	FORMER WEST JETTY	03-Nov-16	31.9m	6.5m CHART DATUM	15.4m	DESIGN EMBEDMENT OF 13m EXCEEDED. 0.78m CUT OFF TOP.
2	FORMER WEST JETTY	04-Nov-16	31.2m	6.5m CHART DATUM	15.1m	DESIGN EMBEDMENT OF 13m EXCEEDED. 0.23m CUT OFF TOP.
3	FORMER WEST JETTY	04-Nov-16	31.4m	6.5m CHART DATUM	16.2m	DESIGN EMBEDMENT OF 13m EXCEEDED. 0.23m CUT OFF TOP.
4	FORMER WEST JETTY	04-Nov-16	31.2m	6.5m CHART DATUM	15.9m	DESIGN EMBEDMENT OF 13m EXCEEDED.
5	FORMER WEST JETTY	04-Nov-16	31.2m	6.5m CHART DATUM	17.2m	DESIGN EMBEDMENT OF 13m EXCEEDED.

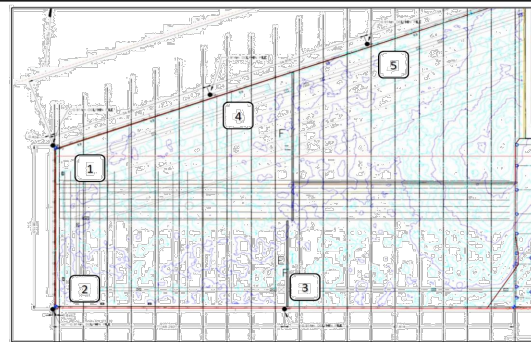

NAVIGATION DOLPHIN PILES – PILE DRIVING RECORDS

PILE DRIVING RECORD - PERIMETER SHEET PILE WALL - 10NOV2015 TO 16NOV2016

- NOTES:
1) ALL ELEVATIONS IN CHART DATUM.
2) SHEET PILE WALL PILE DRIVING RECORDS ARE INCOMPLETE AND CONTAIN ERRORS
3) PILE PAIR ID NUMBERING STARTS (PILE PAIR ID #1) AT THE SOUTHEAST END OF THE WALL, AND FINISHES (PILE PAIR #35) AT THE NORTHWEST CORNER OF THE TIMBER CRIB
4) IN GENERAL, THE SHEET PILES WERE RE-DRIVEN IN A CLOCKWISE DIRECTION AROUND THE SOUTH JETTY PERIMETER

TYPE	DATE	PILE PAIR ID - REV 0	PILE PAIR ID - REV 1	SECTION TYPE	LOCATION ON STRUCTURE	INITIAL CUT-OFF ELEVATION	INITIAL TIP ELEVATION	FINAL CUT OFF ELEVATION	FINAL TIP ELEVATION	ELEVATION OF BEDROCK	EQUIPMENT
Type A	10-Nov-15	05	1	AZ 26-700	South Face	4.8	-12.00	2	-14.80	None.	APE 50 VIBRATORY HAMMER
Type A	10-Nov-15	1	2	AZ 26-700	South Face	4.8	-12.00	2	-14.80	None.	APE 50 VIBRATORY HAMMER
Type A	10-Nov-15	2	3	AZ 26-700	South Face	4.8	-12.00	2	-14.80	None.	APE 50 VIBRATORY HAMMER
Type A	10-Nov-15	3	4	AZ 26-700	South Face	4.8	-12.00	2	-14.80	None.	APE 50 VIBRATORY HAMMER
Type A	10-Nov-15	35	36	AZ 26-700	South Face	4.8	-12.00	2	-14.80	None.	APE 50 VIBRATORY HAMMER
Type A	11-Nov-15	36	37	AZ 26-693	South Face	4.8	-12.00	2	-14.80	None.	APE 50 VIBRATORY HAMMER
Type A	11-Nov-15	37	38	AZ 26-694	South Face	4.8	-12.00	2	-14.80	None.	APE 50 VIBRATORY HAMMER
Type A	11-Nov-15	38	39	AZ 26-695	South Face	4.8	-12.00	2	-14.80	None.	APE 50 VIBRATORY HAMMER
Type A	11-Nov-15	39	40	AZ 26-696	South Face	4.8	-12.00	2	-14.80	None.	APE 50 VIBRATORY HAMMER
Type A	11-Nov-15	40	41	AZ 26-697	South Face	4.8	-12.00	2	-14.80	None.	APE 50 VIBRATORY HAMMER
Type A	11-Nov-15	68	69	AZ 26-700	South Face	4.8	-12.00	2	-14.80	None.	APE 50 VIBRATORY HAMMER
Type A	11-Nov-15	69	70	AZ 26-700	South Face	4.8	-12.00	2	-14.80	None.	APE 50 VIBRATORY HAMMER
Type A	11-Nov-15	70	71	AZ 26-700	South Face	4.8	-12.00	2	-14.80	None.	APE 50 VIBRATORY HAMMER
Type A	12-Nov-15	71	72	AZ 38-700N	South Face	4.8	-12.00	2	-14.80	None.	APE 50 VIBRATORY HAMMER
Type A	12-Nov-15	72	73	AZ 38-700N	South Face	4.8	-12.00	2	-14.80	None.	APE 50 VIBRATORY HAMMER
Type A	12-Nov-15	73	74	AZ 38-700N	South Face	4.8	-12.00	2	-14.80	None.	APE 50 VIBRATORY HAMMER
Type B	12-Nov-15	1	75	AZ 38-700N	South Face	4.8	-13.50	2	-16.30	None.	APE 50 VIBRATORY HAMMER
Type B	12-Nov-15	2	76	AZ 38-700N	South Face	4.8	-13.50	2	-16.30	None.	APE 50 VIBRATORY HAMMER
Type B	12-Nov-15</										



PILE DRIVING RECORD - PERIMETER SHEET PILE WALL - 24NOV2015 TO 13JAN2016

NOTES:

- 1) ALL ELEVATIONS IN CHART DATUM.
- 2) SHEET PILE WALL PILE DRIVING RECORDS ARE INCOMPLETE AND CONTAIN ERRORS.
- 3) PILE PAIR ID NUMBERING STARTS (PILE PAIR ID #1) AT THE SOUTHEAST END OF THE WALL, AND FINISHES (PILE PAIR #335) AT THE NORTHWEST CORNER OF THE TIMBER CRIB.
- 4) IN GENERAL, THE SHEET PILES WERE RE-DRIVEN IN A CLOCKWISE DIRECTION AROUND THE SOUTH JETTY PERIMETER.

TYPE	DATE	PILE PAIR ID - REV 0	PILE PAIR ID - REV 1	SECTION TYPE	LOCATION ON STRUCTURE	TIME DRIVEN	INITIAL CUT-OFF ELEVATION	INITIAL TIP ELEVATION	START ELEVATION	FINAL CUT OFF ELEVATION	FINAL TIP ELEVATION	ELEVATION OF BEDROCK	EQUIPMENT	NOTES
Type A	24-Nov-15	1	2	AZ 26-700	South Face	12:00	4.8	-12.00	2.83	0.02	-16.78	None	APE 300 VIBRATORY HAMMER	
Type A	24-Nov-15	2	3	AZ 26-700	South Face	10:06	4.8	-12.00	2.87	0.02	-16.78	None	APE 300 VIBRATORY HAMMER	
Type A	24-Nov-15	3	4	AZ 26-700	South Face	9:57	4.8	-12.00	2.83	1.01	-15.79	None	APE 300 VIBRATORY HAMMER	
Type A	24-Nov-15	4	5	AZ 26-700	South Face	9:15	4.8	-12.00	2.88	1.01	-15.79	None	APE 300 VIBRATORY HAMMER	
Type A	24-Nov-15	5	6	AZ 26-700	South Face	12:07	4.8	-12.00	2.85	0.02	-16.78	None	APE 300 VIBRATORY HAMMER	
Type A	24-Nov-15	6	7	AZ 26-700	South Face	12:17	4.8	-12.00	2.82	0.02	-16.78	None	APE 300 VIBRATORY HAMMER	
Type A	24-Nov-15	7	8	AZ 26-700	South Face	12:24	4.8	-12.00	2.78	0.01	-16.79	None	APE 300 VIBRATORY HAMMER	
Type A	24-Nov-15	8	9	AZ 26-700	South Face	12:32	4.8	-12.00	2.79	0.03	-16.77	None	APE 300 VIBRATORY HAMMER	
Type A	24-Nov-15	9	10	AZ 26-700	South Face	12:41	4.8	-12.00	2.85	0.03	-16.77	None	APE 300 VIBRATORY HAMMER	
Type A	24-Nov-15	10	11	AZ 26-700	South Face	12:50	4.8	-12.00	2.83	0.02	-16.78	None	APE 300 VIBRATORY HAMMER	
Type A	24-Nov-15	11	12	AZ 26-700	South Face	13:01	4.8	-12.00	2.82	0.01	-16.79	None	APE 300 VIBRATORY HAMMER	
Type A	24-Nov-15	12	13	AZ 26-700	South Face	13:09	4.8	-12.00	2.84	0.03	-16.77	None	APE 300 VIBRATORY HAMMER	
Type A	24-Nov-15	13	14	AZ 26-700	South Face	13:19	4.8	-12.00	2.95	0.02	-16.78	None	APE 300 VIBRATORY HAMMER	
Type A	24-Nov-15	14	15	AZ 26-700	South Face	13:30	4.8	-12.00	2.99	0.03	-16.77	None	APE 300 VIBRATORY HAMMER	
Type A	24-Nov-15	15	16	AZ 26-700	South Face	14:09	4.8	-12.00	2.94	0.02	-16.78	None	APE 300 VIBRATORY HAMMER	
Type A	24-Nov-15	16	17	AZ 26-700	South Face	14:25	4.8	-12.00	2.93	0.1	-16.70	None	APE 300 VIBRATORY HAMMER	
Type A	24-Nov-15	17	18	AZ 26-700	South Face	15:58	4.8	-12.00	2.88	0.08	-16.72	None	APE 300 VIBRATORY HAMMER	
Type A	24-Nov-15	18	19	AZ 26-700	South Face	16:05	4.8	-12.00	2.91	0.08	-16.72	None	APE 300 VIBRATORY HAMMER	
Type A	24-Nov-15	19	20	AZ 26-700	South Face	16:11	4.8	-12.00	2.9	0.09	-16.71	None	APE 300 VIBRATORY HAMMER	
Type A	24-Nov-15	20	21	AZ 26-700	South Face	16:20	4.8	-12.00	2.89	0.1	-16.70	None	APE 300 VIBRATORY HAMMER	
Type A	24-Nov-15	21	22	AZ 26-700	South Face	16:28	4.8	-12.00	2.99	0.09	-16.71	None	APE 300 VIBRATORY HAMMER	
Type A	24-Nov-15	22	23	AZ 26-700	South Face	16:35	4.8	-12.00	3	0.09	-16.71	None	APE 300 VIBRATORY HAMMER	
Type A	24-Nov-15	23	24	AZ 26-700	South Face	16:46	4.8	-12.00	3.05	0.09	-16.71	None	APE 300 VIBRATORY HAMMER	
Type A	24-Nov-15	24	25	AZ 26-700	South Face	16:54	4.8	-12.00	3	0.1	-16.70	None	APE 300 VIBRATORY HAMMER	
Type A	25-Nov-15	25	26	AZ 26-700	South Face	8:25	4.8	-12.00	2.99	0.02	-16.78	None	APE 300 VIBRATORY HAMMER	
Type A	25-Nov-15	26	27	AZ 26-700	South Face	8:31	4.8	-12.00	2.96	0.08	-16.72	None	APE 300 VIBRATORY HAMMER	
Type A	25-Nov-15	27	28	AZ 26-700	South Face	8:38	4.8	-12.00	2.9	0.08	-16.72	None	APE 300 VIBRATORY HAMMER	
Type A	25-Nov-15	28	29	AZ 26-700	South Face	8:44	4.8	-12.00	2.92	0.08	-16.72	None	APE 300 VIBRATORY HAMMER	
Type A	25-Nov-15	29	30	AZ 26-700	South Face	8:50	4.8	-12.00	2.95	0.09	-16.71	None	APE 300 VIBRATORY HAMMER	
Type A	25-Nov-15	30	31	AZ 26-700	South Face	8:57	4.8	-12.00	2.95	0.1	-16.70	None	APE 300 VIBRATORY HAMMER	COFFEE BREAK
Type A	25-Nov-15	31	32	AZ 26-700	South Face	9:25	4.8	-12.00	2.98	0.1	-16.70	None	APE 300 VIBRATORY HAMMER	
Type A	25-Nov-15	32	33	AZ 26-700	South Face	9:50	4.8	-12.00	2.96	0.07	-16.73	None	APE 300 VIBRATORY HAMMER	
Type A	25-Nov-15	33	34	AZ 26-700	South Face	9:57	4.8	-12.00	3.02	0.07	-16.72	None	APE 300 VIBRATORY HAMMER	
Type A	25-Nov-15	34	35	AZ 26-700	South Face	10:03	4.8	-12.00	3.01	0.06	-16.74	None	APE 300 VIBRATORY HAMMER	
Type A	25-Nov-15	35	36	AZ 26-700	South Face	10:07	4.8	-12.00	3.05	0.1	-16.70	None	APE 300 VIBRATORY HAMMER	
Type A	25-Nov-15	36	37	AZ 26-700	South Face	10:12	4.8	-12.00	3.01	0.06	-16.74	None	APE 300 VIBRATORY HAMMER	
Type A	25-Nov-15	37	38	AZ 26-700	South Face	10:20	4.8	-12.00	3.06	0.11	-16.69	None	APE 300 VIBRATORY HAMMER	
Type A	25-Nov-15	38	39	AZ 26-700	South Face	10:26	4.8	-12.00	3.03	0.09	-17.57	None	APE 300 VIBRATORY HAMMER	WESTERN SINGLE SHEET SLID DOWN TO CUT OFF ELEVATION OF -0.77 DURING PAIR #39 DRIVING
Type A	25-Nov-15	39	40	AZ 26-700	South Face	10:33	4.8	-12.00	3	1.06	-15.74	None	APE 300 VIBRATORY HAMMER	STOPPED AT CUT OFF ELEVATION 1.06 DUE TO #39 MOVEMENT
Type A	25-Nov-15	40	41	AZ 26-700	South Face	10:56	4.8	-12.00	2.98	0.1	-16.70	None	APE 300 VIBRATORY HAMMER	
Type A	25-Nov-15	41	42	AZ 26-700	South Face	11:03	4.8	-12.00	2.9	0.07	-16.73	None	APE 300 VIBRATORY HAMMER	
Type A	25-Nov-15	42	43	AZ 26-700	South Face	11:09	4.8	-12.00	2.84	0.08	-16.72	None	APE 300 VIBRATORY HAMMER	#6 DERRICK ENCOUNTERED MECHANICAL BREAKDOWN AFTER LUNCH BREAK. SHUT DOWN
Type A	26-Nov-15	43	44	AZ 26-700	South Face	12:45	4.8	-12.00	2.83	0.06	-16.74	None	APE 300 VIBRATORY HAMMER	START LATE DUE TO MAINTENANCE/MECHANICAL
Type A	26-Nov-15	44	45	AZ 26-700	South Face	12:51	4.8	-12.00	2.88	0.08	-16.72	None	APE 300 VIBRATORY HAMMER	
Type A	26-Nov-15	45	46	AZ 26-700	South Face	12:57	4.8	-12.00	2.95	0.06	-16.74	None	APE 300 VIBRATORY HAMMER	
Type A	26-Nov-15	46	47	AZ 26-700	South Face	13:04	4.8	-12.00	2.97	0.1	-16.70	None	APE 300 VIBRATORY HAMMER	
Type A	26-Nov-15	47	48	AZ 26-700	South Face	13:12	4.8	-12.00	2.94	0.1	-16.70	None	APE 300 VIBRATORY HAMMER	
Type A	26-Nov-15	48	49	AZ 26-700	South Face	13:19	4.8	-12.00	2.95	0.1	-16.70	None	APE 300 VIBRATORY HAMMER	
Type A	26-Nov-15	49	50	AZ 26-700	South Face	13:29	4.8	-12.00	2.99	0.08	-16.72	None	APE 300 VIBRATORY HAMMER	
Type A	26-Nov-15	50	51	AZ 26-700	South Face	13:36	4.8	-12.00	3.02	0.08	-16.72	None	APE 300 VIBRATORY HAMMER	SHUT DOWN FOR MECHANICAL ISSUES
Type A	26-Nov-15	51	52	AZ 26-700	South Face	16:18	4.8	-12.00	2.84	0.09	-16.71	None	APE 300 VIBRATORY HAMMER	
Type A	26-Nov-15	52	53	AZ 26-700	South Face	16:22	4.8	-12.00	2.96	0.1	-16.70	None	APE 300 VIBRATORY HAMMER	
Type A	26-Nov-15	53	54	AZ 26-700	South Face	16:26	4.8	-12.00	2.9	0.08	-16.72	None	APE 300 VIBRATORY HAMMER	
Type A	26-Nov-15	54	55	AZ 26-700	South Face	16:33	4.8	-12.00	2.62	0.07	-16.73	None	APE 300 VIBRATORY HAMMER	
Type A	26-Nov-15	55	56	AZ 26-700	South Face	16:37	4.8	-12.00	2.75	0.1	-16.70	None	APE 300 VIBRATORY HAMMER	
Type A	26-Nov-15	56	57	AZ 26-700	South Face	16:42	4.8	-12.00	2.95	0.08	-16.78	None	APE 300 VIBRATORY HAMMER	
Type A	26-Nov-15	57	58	AZ 26-700	South Face	16:47	4.8	-12.00	2.98	0.09	-16.71	None	APE 300 VIBRATORY HAMMER	
Type A	26-Nov-15	58	59	AZ 26-700	South Face	16:51	4.8	-12.00	2.97	0.08	-16.72	None	APE 300 VIBRATORY HAMMER	
Type A	26-Nov-15	59	60	AZ 26-700	South Face	16:56	4.8	-12.00	3.06	0.05	-16.75	None	APE 300 VIBRATORY HAMMER	
Type A	01-Dec-15	60	61	AZ 26-700	South Face	15:36	4.8	-12.00	3.07	0.09	-16.71	None	ICE 448 VIBRATORY HAMMER (WITH APE EXTENSION)	SHUT DOWN FOR NIGHT
Type A	01-Dec-15	61	62	AZ 26-700	South Face	15:45	4.8	-12.00	3.05	0.1	-16.70	None	ICE 448 VIBRATORY HAMMER (WITH APE EXTENSION)	START
Type A	01-Dec-15	62	63	AZ 26-700	South Face	16:14	4.8	-12.00	3.1	0.1	-16.70	None	ICE 448 VIBRATORY HAMMER (WITH APE EXTENSION)	COFFEE
Type A	01-Dec-15	63	64	AZ 26-700	South Face	16:21	4.8	-12.00	3.06	0.08	-16.72	None	ICE 448 VIBRATORY HAMMER (WITH APE EXTENSION)	
Type A	01-Dec-15	64	65	AZ 26-700	South Face	16:26	4.8	-12.00	3.08	0.1	-16.70	None	ICE 448 VIBRATORY HAMMER (WITH APE EXTENSION)	SOFT / EASY DRIVING
Type A	01-Dec-15	65	66	AZ 26-700	South Face	16:30	4.8	-12.00	3.08	0.1	-16.70	None	ICE 448 VIBRATORY HAMMER (WITH APE EXTENSION)	
Type A	01-Dec-15	66	67	AZ 26-700	South Face	16:34	4.8	-12.00	3.08	0.11	-16.70	None	ICE 448 VIBRATORY HAMMER (WITH APE EXTENSION)	
Type A	01-Dec-15	67	68	AZ 26-700	South Face	16:44	4.8	-12.00	3.1	0.1	-16.70	None	ICE 448 VIBRATORY HAMMER (WITH APE EXTENSION)	HAD TO CUT BOLT FROM SHEET
Type A	01-Dec-15	68	69	AZ 26-700	South Face	16:49	4.8	-12.00	3.1	0.1	-16.69	None	ICE 448 VIBRATORY HAMMER (WITH APE EXTENSION)	
Type A	01-Dec-15	69	70	AZ 26-700	South Face	16:52	4.8	-12.00	3.09	2.38	-14.42	None	ICE 448 VIBRATORY HAMMER (WITH APE EXTENSION)	BOLTS SHEARED OFF FROM HAMMER HEAD. STOP DRIVING AT CUT OFF ELEVATION 2.48M
Type A	02-Dec-15	69	70	AZ 26-700	South Face	9:07	4.8	-12.00	2.38	0.11	-16.69	None	ICE 448 VIBRATORY HAMMER (WITH APE EXTENSION)	START
Type A	02-Dec-15	70	71	AZ 26-700	South Face	9:13	4.8	-12.00	2.99	0.07	-16.73	None	ICE 448 VIBRATORY HAMMER (WITH APE EXTENSION)	
Type A	02-Dec-15	71	72	AZ 26-700	South Face	9:39	4.8	-12.00	3.16	0.06	-16.74	None	ICE 448 VIBRATORY HAMMER (WITH APE EXTENSION)	
Type A	02-Dec-15	72	73	AZ 26-700	South Face	9:43	4.8	-12.00	3.17	0.05	-16.75	None	ICE 448 VIBRATORY HAMMER (WITH APE EXTENSION)	
Type A	02-Dec-15	73	74	AZ 26-700	South Face	9:46	4.8	-12.00	3.19	0.08	-16.72	None	ICE 448 VIBRATORY HAMMER (WITH APE EXTENSION)	
Type B	02-Dec-15	74	75	AZ 38-700N	South Face	9:50	4.8	-13.50	3.26	0.11	-18.19	None	ICE 448 VIBRATORY HAMMER (WITH APE EXTENSION)	
Type B	02-Dec-15	75	76	AZ 38-700N	South Face	9:57	4.8	-13.50	3.25	0.1	-18.20	None	ICE 448 VIBRATORY HAMMER (WITH APE EXTENSION)	
Type B	02-Dec-15	76	77	AZ 38-700N	South Face	10:02	4.8	-13.50	3.15	0.09	-18.21	None	ICE 448 VIBRATORY HAMMER (WITH APE EXTENSION)	MOVE RIG
Type B	02-Dec-15	77	78	AZ 38-700N	South Face	10:45	4.8	-13.50	3.18	0.08	-18.22	None	ICE 448 VIBRATORY HAMMER (WITH APE EXTENSION)	
Type B	02-Dec-15	78	79	AZ 38-700N	South Face	10:49	4.8	-13.50	3.03	0.1	-18.20	None	ICE 448 VIBRATORY HAMMER (WITH APE EXTENSION)	
Type B	02-Dec-15	79	80	AZ 38-700N	South Face	10:53	4.8	-13.50	3.18	0.08	-18.20	None	ICE 448 VIBRATORY HAMMER (WITH APE EXTENSION)	
Type B	02-Dec-15	80	81	AZ 38-700N	South Face	10:56	4.8	-13.50	3.19	0.08	-18.22	None	ICE 448 VIBRATORY HAMMER (WITH APE EXTENSION)	
Type B	02-Dec-15	81	82	AZ 38-700N	South Face	11:00	4.8	-13.50	3.15	0.12	-18.18	None	ICE 448 VIBRATORY HAMMER (WITH APE EXTENSION)	
Type B	02-Dec-15	82	83	AZ 38-700N	South Face	11:05	4.8	-13.50	3.13	0.09	-18.21	None	ICE 448 VIBRATORY HAMMER (WITH APE EXTENSION)	LUNCH
Type B	02-Dec-15	83	84</											



PILE DRIVING RECORD - PERIMETER SHEET PILE WALL - 14JAN2016 TO 26FEB2016

NOTES:

- 1) ALL ELEVATIONS IN CHART DATUM.
2) SHEET PILE WALL PILE DRIVING RECORDS ARE INCOMPLETE AND CONTAIN ERRORS.
3) PILE PAIR ID NUMBERING STARTS (PILE PAIR ID #1) AT THE SOUTHEAST END OF THE WALL, AND FINISHES (PILE PAIR #335) AT THE NORTHWEST CORNER OF THE TIMBER CRIB.
4) IN GENERAL, THE SHEET PILES WERE RE-DRIVEN IN A CLOCKWISE DIRECTION AROUND THE SOUTH JETTY PERIMETER.

Table with columns: TYPE, DATE, PILE PAIR ID - REV.0, PILE PAIR ID - REV.1, SECTION TYPE, LOCATION ON STRUCTURE, TIME DRIVEN, INITIAL CUT-OFF ELEVATION, INITIAL TIP ELEVATION, START ELEVATION, FINAL CUT OFF ELEVATION, FINAL TIP ELEVATION, ELEVATION OF BEDROCK, EQUIPMENT, NOTES. Contains 335 rows of pile driving data.

Revision/Description/Date table with 3 columns: Revision, Description/Description, Date/Date. Includes entries for RECORD DRAWING and COFFEE BREAK.

PUBLIC WORKS AND GOVERNMENT SERVICES CANADA logo and project information: Project title/Titre du projet: ESQUIMALT GRAVING DOCK 825 ADMIRALS ROAD, VICTORIA, BC

ESQUIMALT GRAVING DOCK WATERLOT PHASE 2 SOUTH JETTY UNDER-PIER SEDIMENT REMEDIATION

Consultant Signature Only
Designed by/Concept par DANIEL LAWSON
Drawn by/Desainé par ALEXANDER SECKIC

PFWSG Project Manager/Administrateur de Projets TPSGC ANDREW MYLLY
Regional Manager, Environmental Services COLLIN KINGMAN

Drawing title/Titre du dessin: PILE DRIVING RECORDS SHEET 3

Project No./No. du projet: R.018400.002, Sheet/CSM12, Revision no./0

PERIMETER SHEET PILE WALL PILE DRIVING RECORDS - SHEET 3






PILE DRIVING RECORD - PERIMETER SHEET PILE WALL - 08MAR2016 TO 19MAR2016

- NOTES:
 1) ALL ELEVATIONS IN CHART DATUM.
 2) SHEET PILE WALL PILE DRIVING RECORDS ARE INCOMPLETE AND CONTAIN ERRORS.
 3) PILE PAIR ID NUMBERING STARTS (PILE PAIR ID #1) AT THE SOUTHEAST END OF THE WALL, AND FINISHES (PILE PAIR #335) AT THE NORTHWEST CORNER OF THE TIMBER CRIB.
 4) IN GENERAL, THE SHEET PILES WERE RE-DRIVEN IN A CLOCKWISE DIRECTION AROUND THE SOUTH JETTY PERIMETER.

TYPE	DATE	PILE PAIR ID - REV D	PILE PAIR ID - REV E	SECTION TYPE	LOCATION ON STRUCTURE	TIME DRIVEN	INITIAL CUT-OFF ELEVATION	INITIAL TIP ELEVATION	START ELEVATION	FINAL CUT OFF ELEVATION	FINAL TIP ELEVATION	ELEVATION OF BEDROCK	EQUIPMENT	NOTES
Type C	08-Mar-16	220	221	AZ 50	South Face	12-32	4.85	-16.00	4.85	-0.02	-20.87	None	APE 200 VIBRATORY HAMMER	
Type C	08-Mar-16	221	222	AZ 50	South Face	12-39	4.86	-16.00	4.86	0	-20.86	None	APE 200 VIBRATORY HAMMER	
Type C	08-Mar-16	222	223	AZ 50	South Face	12-46	4.86	-16.00	4.86	0	-20.86	None	APE 200 VIBRATORY HAMMER	
Type C	08-Mar-16	223	224	AZ 50	South Face	12-52	4.87	-16.00	4.87	-0.01	-20.88	None	APE 200 VIBRATORY HAMMER	
Type E	08-Mar-16	224	225	AZ 38-700N	West Face	13-04	4.88	-15.00	4.88	-0.01	-19.89	None	APE 200 VIBRATORY HAMMER	
Type E	08-Mar-16	225	226	AZ 38-700N	West Face	13-10	5.1	-15.00	5.1	-0.01	-20.11	None	APE 200 VIBRATORY HAMMER	
Type E	08-Mar-16	226	227	AZ 38-700N	West Face	13-13	5.01	-15.00	5.01	-0.03	-20.04	None	APE 200 VIBRATORY HAMMER	
Type E	08-Mar-16	227	228	AZ 38-700N	West Face	13-18	5.1	-15.00	5.1	-0.06	-20.16	None	APE 200 VIBRATORY HAMMER	
Type E	08-Mar-16	228	229	AZ 38-700N	West Face	13-21	5.15	-15.00	5.15	-0.05	-20.20	None	APE 200 VIBRATORY HAMMER	LOCATION OF OVERLAP JOINT
Type E	08-Mar-16	229	230	AZ 38-700N	West Face	13-26	5.1	-15.00	5.1	0.04	-20.06	None	APE 200 VIBRATORY HAMMER	
Type E	08-Mar-16	230	231	AZ 38-700N	West Face	13-29	5.2	-15.00	5.2	-0.01	-20.21	None	APE 200 VIBRATORY HAMMER	
Type E	08-Mar-16	231	232	AZ 38-700N	West Face	13-33	5.2	-15.00	5.2	-0.01	-20.21	None	APE 200 VIBRATORY HAMMER	COFFEE BREAK
Type E	08-Mar-16	232	233	AZ 38-700N	West Face	13-38	5.19	-15.00	5.19	0	-20.19	None	APE 200 VIBRATORY HAMMER	
Type E	08-Mar-16	233	234	AZ 38-700N	West Face	14-02	5.2	-15.00	5.2	-0.01	-20.21	None	APE 200 VIBRATORY HAMMER	
Type E	08-Mar-16	234	235	AZ 38-700N	West Face	14-05	5.12	-15.00	5.12	-0.03	-20.15	None	APE 200 VIBRATORY HAMMER	
Type E	08-Mar-16	235	236	AZ 38-700N	West Face	14-07	5.17	-15.00	5.17	-0.02	-20.19	None	APE 200 VIBRATORY HAMMER	
Type E	08-Mar-16	236	237	AZ 38-700N	West Face	14-33	5.2	-15.00	5.2	-0.02	-20.22	None	APE 200 VIBRATORY HAMMER	STOP TO UNLOAD CSP
Type E	08-Mar-16	237	238	AZ 38-700N	West Face	14-36	5.2	-15.00	5.2	-0.02	-20.22	None	APE 200 VIBRATORY HAMMER	
Type E	08-Mar-16	238	239	AZ 38-700N	West Face	14-39	5.16	-15.00	5.16	-0.02	-20.18	None	APE 200 VIBRATORY HAMMER	
Type E	08-Mar-16	239	240	AZ 38-700N	West Face	14-42	5.15	-15.00	5.15	-0.02	-20.17	None	APE 200 VIBRATORY HAMMER	
Type E	08-Mar-16	240	241	AZ 38-700N	West Face	14-45	5.16	-15.00	5.16	-0.01	-20.17	None	APE 200 VIBRATORY HAMMER	
Type E	08-Mar-16	241	242	AZ 38-700N	West Face	14-48	5.17	-15.00	5.17	0	-20.17	None	APE 200 VIBRATORY HAMMER	
Type E	08-Mar-16	242	243	AZ 38-700N	West Face	14-54	5.17	-15.00	5.17	0.04	-20.13	None	APE 200 VIBRATORY HAMMER	
Type E	08-Mar-16	243	244	AZ 38-700N	West Face	14-58	5.16	-15.00	5.16	0	-20.16	None	APE 200 VIBRATORY HAMMER	
Type E	08-Mar-16	244	245	AZ 38-700N	West Face	15-01	5.18	-15.00	5.18	-0.03	-20.21	None	APE 200 VIBRATORY HAMMER	
Type E	08-Mar-16	245	246	AZ 38-700N	West Face	15-05	5.17	-15.00	5.17	0.01	-20.17	None	APE 200 VIBRATORY HAMMER	
Type E	08-Mar-16	246	247	AZ 38-700N	West Face	15-09	5.2	-15.00	5.2	-0.02	-20.20	None	APE 200 VIBRATORY HAMMER	
Type E	08-Mar-16	247	248	AZ 38-700N	West Face	15-17	5.2	-15.00	5.2	-0.02	-20.22	None	APE 200 VIBRATORY HAMMER	
Type E	08-Mar-16	248	249	AZ 38-700N	West Face	15-21	5.19	-15.00	5.19	-0.02	-20.21	None	APE 200 VIBRATORY HAMMER	END DRIVING
Type C	10-Mar-16	176	175	N/A	South Face	9-57	0.01	-16.00	-0.01	0	-17.00	N/A	APE 200 VIBRATORY HAMMER	REDRIVE TO ACCOMMODATE TRB GATE
Type E	10-Mar-16	249	250	AZ38-700N	West Face	11-57	5.18	-15.00	5.18	-0.01	-20.19	N/A	APE 200 VIBRATORY HAMMER	LAST PAIR ON WEST FACE
Type E	10-Mar-16	250	251	AZ38-700N	West Face	12-03	4.88	-15.00	4.88	-0.02	-19.90	N/A	APE 200 VIBRATORY HAMMER	
Type C	10-Mar-16	250.5	252	AZ 50	North Face	19-20	4.88	-16.00	4.88	0.3	-20.58	N/A	APE 200 VIBRATORY HAMMER	
Type C	10-Mar-16	251	253	AZ 50	North Face	19-35	4.34	-16.00	4.34	0.05	-20.29	N/A	APE 200 VIBRATORY HAMMER	
Type C	10-Mar-16	252	254	AZ 50	North Face	12-28	4.87	-16.00	4.87	0	-20.87	N/A	APE 200 VIBRATORY HAMMER	
Type C	10-Mar-16	253	255	AZ 50	North Face	12-33	4.87	-16.00	4.87	0.01	-20.86	N/A	APE 200 VIBRATORY HAMMER	
Type C	10-Mar-16	254	256	AZ 50	North Face	12-37	4.87	-16.00	4.87	0	-20.87	N/A	APE 200 VIBRATORY HAMMER	
Type C	10-Mar-16	255	257	AZ 50	North Face	12-43	4.87	-16.00	4.87	0	-20.87	N/A	APE 200 VIBRATORY HAMMER	
Type C	10-Mar-16	256	258	AZ 50	North Face	12-49	4.85	-16.00	4.85	0.01	-20.84	N/A	APE 200 VIBRATORY HAMMER	STOP TO LOAD TRB
Type C	10-Mar-16	257	259	AZ 50	North Face	17-38	4.83	-16.00	4.83	0.04	-20.79	N/A	APE 200 VIBRATORY HAMMER	START DRIVING AGAIN
Type C	10-Mar-16	258	260	AZ 50	North Face	17-45	4.84	-16.00	4.84	-0.13	-20.97	N/A	APE 200 VIBRATORY HAMMER	
Type C	10-Mar-16	259	261	AZ 50	North Face	17-53	4.85	-16.00	4.85	0.04	-20.81	N/A	APE 200 VIBRATORY HAMMER	
Type C	10-Mar-16	260	262	AZ 50	North Face	18-09	4.87	-16.00	4.87	0.02	-20.85	N/A	APE 200 VIBRATORY HAMMER	
Type C	10-Mar-16	261	263	AZ 50	North Face	18-18	4.84	-16.00	4.84	0.34	-20.33	N/A	APE 200 VIBRATORY HAMMER	
Type C	10-Mar-16	262	264	AZ 50	North Face	18-27	4.86	-16.00	4.86	0.02	-20.84	N/A	APE 200 VIBRATORY HAMMER	
Type C	10-Mar-16	263	265	AZ 50	North Face	19-44	4.86	-16.00	4.86	0.01	-20.85	N/A	APE 200 VIBRATORY HAMMER	
Type C	10-Mar-16	264	266	AZ 50	North Face	19-56	4.86	-16.00	4.86	0.03	-20.83	N/A	APE 200 VIBRATORY HAMMER	
Type C	10-Mar-16	265	267	AZ 50	North Face	20-07	4.7	-16.00	4.7	0.01	-20.69	N/A	APE 200 VIBRATORY HAMMER	
Type C	10-Mar-16	266	268	AZ 50	North Face	20-16	4.86	-16.00	4.86	0.02	-20.84	N/A	APE 200 VIBRATORY HAMMER	
Type E	10-Mar-16	267	269	AZ38-700N	North Face	20-27	4.85	-15.00	4.85	0.03	-19.82	N/A	APE 200 VIBRATORY HAMMER	
Type E	10-Mar-16	268	270	AZ38-700N	North Face	20-35	4.84	-15.00	4.84	0.02	-19.82	N/A	APE 200 VIBRATORY HAMMER	
Type E	10-Mar-16	269	271	AZ38-700N	North Face	20-42	4.85	-15.00	4.85	0.01	-19.84	N/A	APE 200 VIBRATORY HAMMER	
Type E	10-Mar-16	270	272	AZ38-700N	North Face	20-54	4.84	-15.00	4.84	0.01	-19.83	N/A	APE 200 VIBRATORY HAMMER	
Type E	10-Mar-16	271	273	AZ38-700N	North Face	21-41	4.82	-15.00	4.82	0.02	-19.82	N/A	APE 200 VIBRATORY HAMMER	
Type E	10-Mar-16	272	274	AZ38-700N	North Face	21-47	4.83	-15.00	4.83	-0.01	-19.84	N/A	APE 200 VIBRATORY HAMMER	
Type E	10-Mar-16	273	275	AZ38-700N	North Face	21-53	4.81	-15.00	4.81	0.01	-19.80	N/A	APE 200 VIBRATORY HAMMER	
Type E	10-Mar-16	274	276	AZ38-700N	North Face	22-28	4.81	-15.00	4.81	0.04	-19.77	N/A	APE 200 VIBRATORY HAMMER	
Type E	10-Mar-16	275	277	AZ38-700N	North Face	22-45	4.85	-15.00	4.85	-0.01	-19.86	N/A	APE 200 VIBRATORY HAMMER	
Type E	10-Mar-16	276	278	AZ38-700N	North Face	22-40	4.8	-15.00	4.8	-0.02	-19.82	N/A	APE 200 VIBRATORY HAMMER	
Type C	10-Mar-16	277	279	AZ 50	North Face	22-45	4.88	-16.00	4.88	0.04	-20.84	N/A	APE 200 VIBRATORY HAMMER	
Type C	10-Mar-16	278	280	AZ 50	North Face	22-54	4.87	-16.00	4.87	0.02	-20.85	N/A	APE 200 VIBRATORY HAMMER	
Type C	10-Mar-16	279	281	AZ 50	North Face	22-59	4.85	-16.00	4.85	0.02	-20.83	N/A	APE 200 VIBRATORY HAMMER	
Type C	10-Mar-16	280	282	AZ 50	North Face	23-04	4.86	-16.00	4.86	0.01	-20.84	N/A	APE 200 VIBRATORY HAMMER	
Type C	10-Mar-16	281	283	AZ 50	North Face	23-10	4.87	-16.00	4.87	0.01	-20.86	N/A	APE 200 VIBRATORY HAMMER	
Type C	10-Mar-16	282	284	AZ 50	North Face	23-18	4.88	-16.00	4.88	0.02	-20.86	N/A	APE 200 VIBRATORY HAMMER	
Type C	10-Mar-16	283	285	AZ 50	North Face	23-25	4.88	-16.00	4.88	0	-20.88	N/A	APE 200 VIBRATORY HAMMER	
Type C	10-Mar-16	284	286	AZ 50	North Face	03-02	4.87	-16.00	4.87	0.06	-20.81	N/A	APE 200 VIBRATORY HAMMER	
Type C	10-Mar-16	285	287	AZ 50	North Face	01-14	4.87	-16.00	4.87	-0.01	-20.88	N/A	APE 200 VIBRATORY HAMMER	
Type C	10-Mar-16	286	288	AZ 50	North Face	02-20	4.87	-16.00	4.87	0	-20.87	N/A	APE 200 VIBRATORY HAMMER	
Type C	10-Mar-16	287	289	AZ 50	North Face	02-28	4.88	-16.00	4.88	-0.08	-20.96	N/A	APE 200 VIBRATORY HAMMER	
Type C	10-Mar-16	288	290	AZ 50	North Face	04-5	4.88	-16.00	4.88	-0.06	-20.94	N/A	APE 200 VIBRATORY HAMMER	
Type C	10-Mar-16	289	291	AZ 50	North Face	05-2	4.87	-16.00	4.87	0.01	-20.86	N/A	APE 200 VIBRATORY HAMMER	
Type C	10-Mar-16	290	292	AZ 50	North Face	05-9	4.86	-16.00	4.86	0.06	-20.80	N/A	APE 200 VIBRATORY HAMMER	
Type C	10-Mar-16	291	293	AZ 50	North Face	1-06	4.87	-16.00	4.87	0.01	-20.86	N/A	APE 200 VIBRATORY HAMMER	
Type C	10-Mar-16	292	294	AZ 50	North Face	1-14	4.87	-16.00	4.87	0.02	-20.85	N/A	APE 200 VIBRATORY HAMMER	
Type C	10-Mar-16	293	295	AZ 50	North Face	1-23								

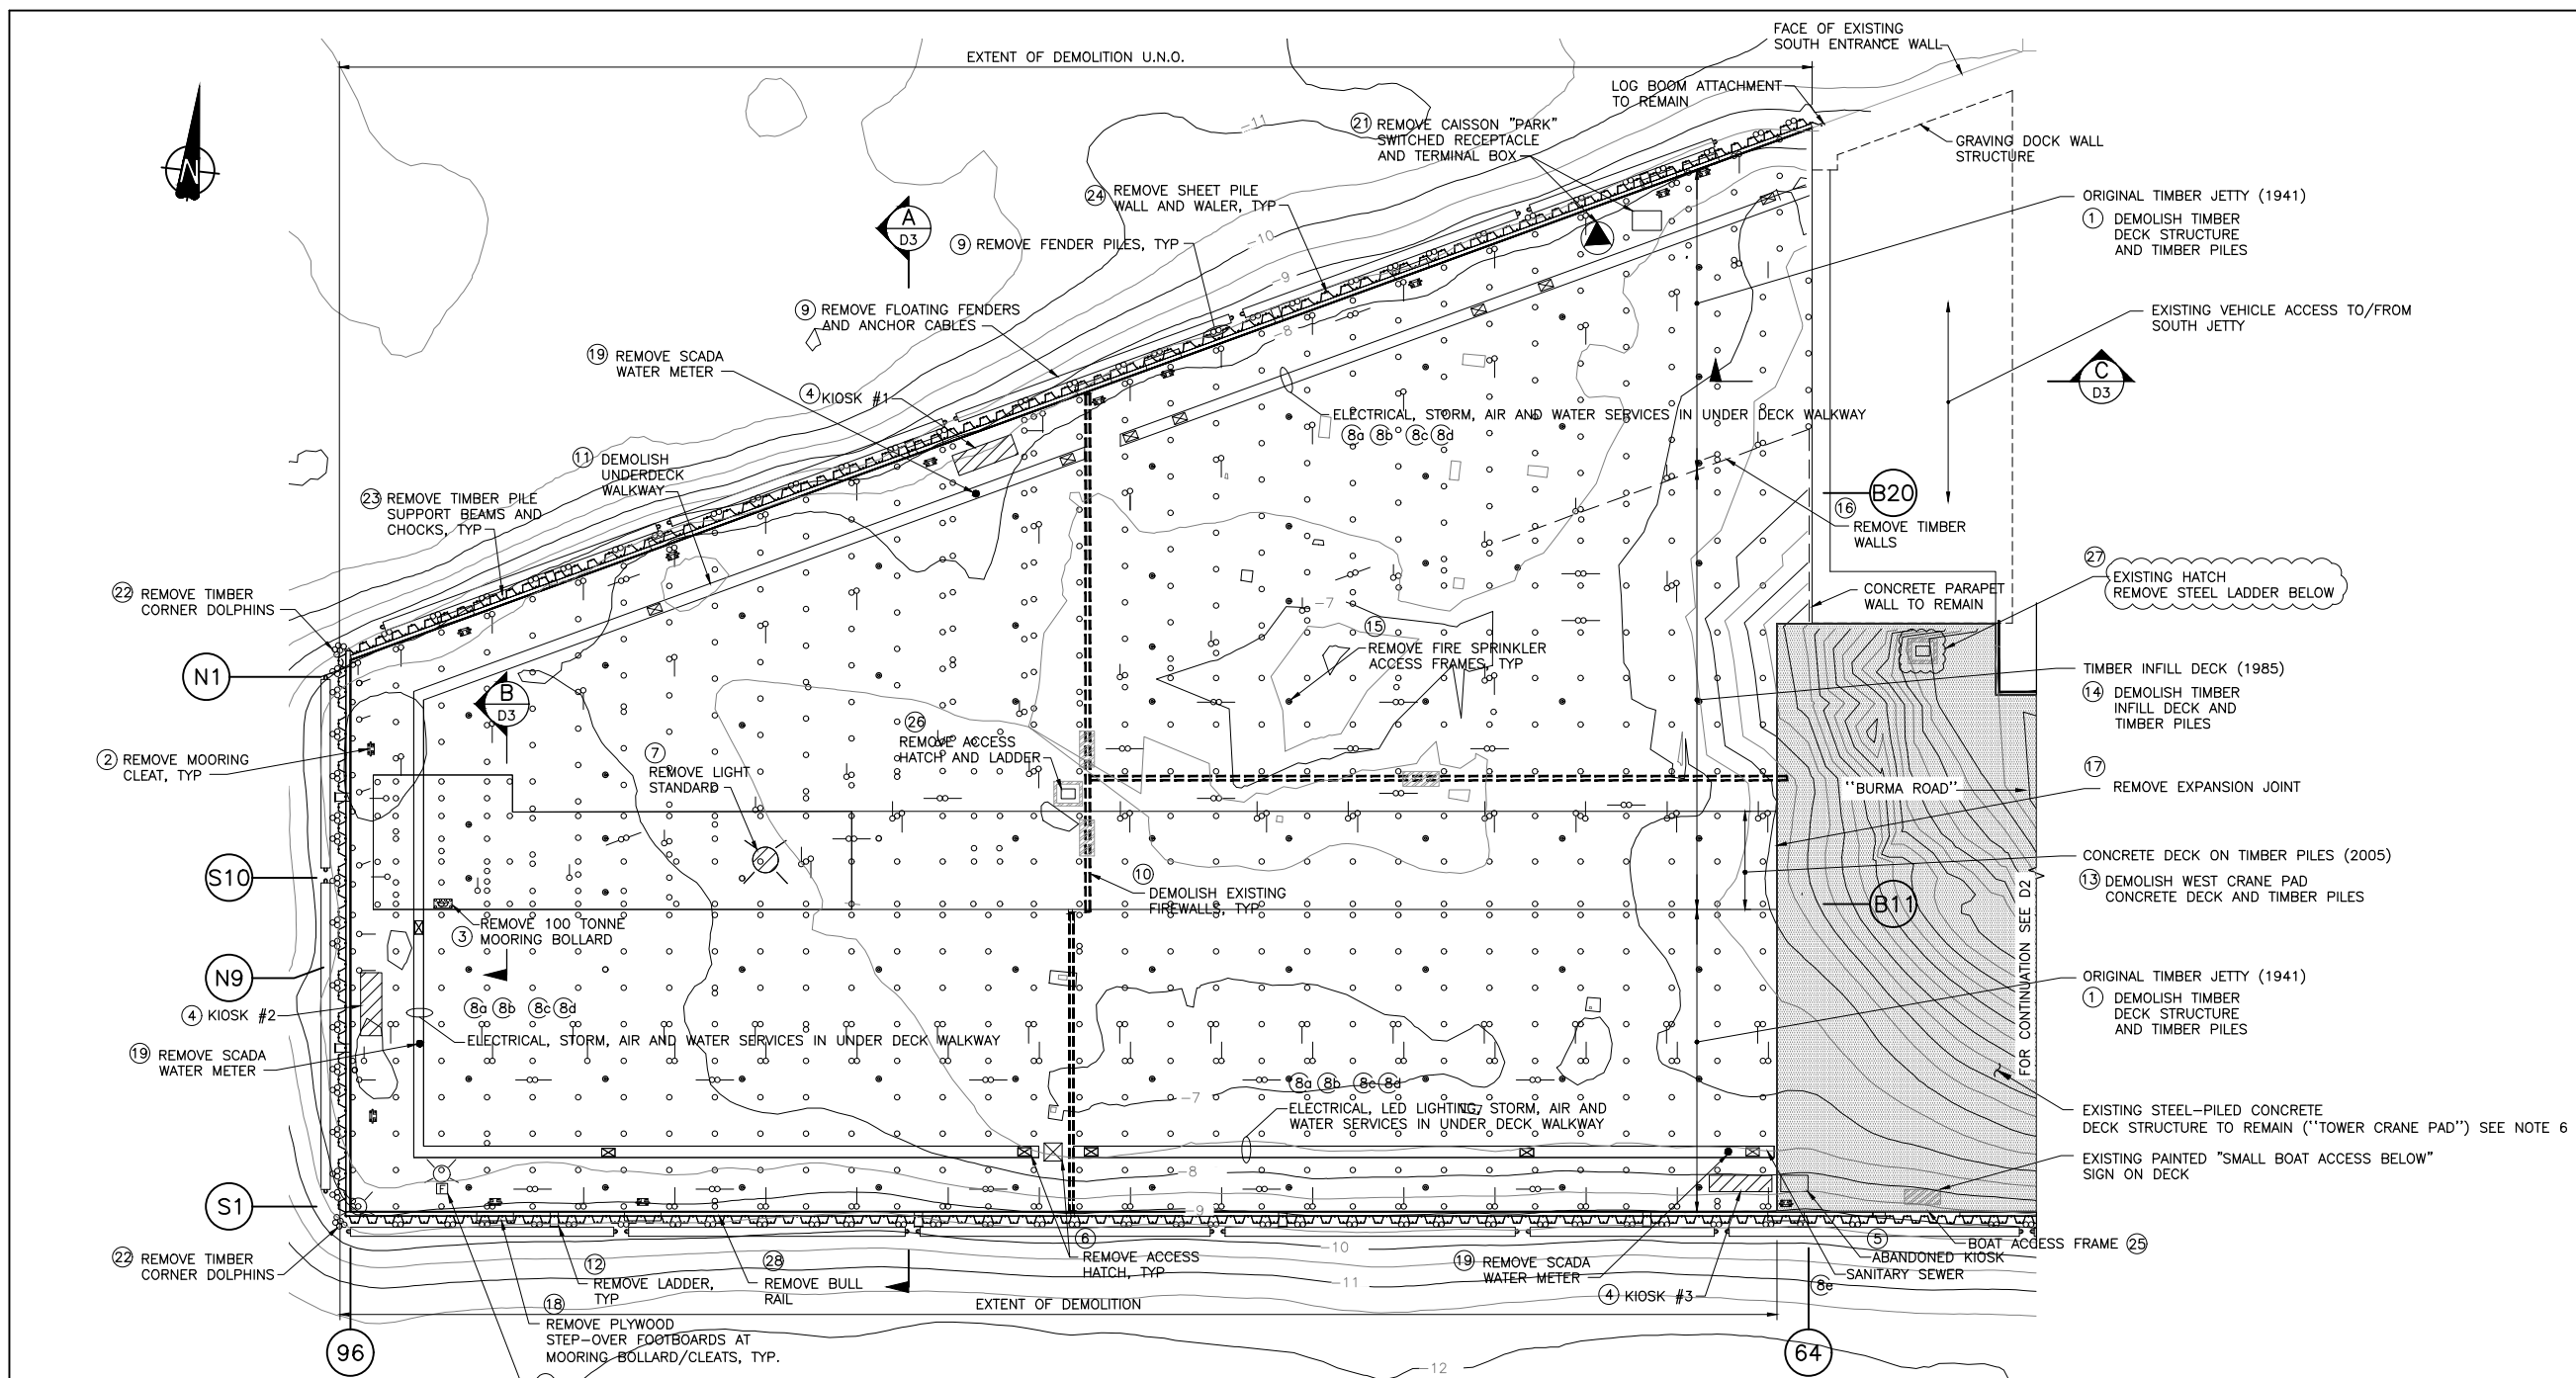

PLAN WEST TIMBER JETTY
 1:250





REFERENCE DRAWINGS:

1. KM ENGINEERING GROUP – AS–BUILTS, JANUARY 06, 2009. PROJECT #861231
 - 1.1. DRAWINGS:
 - 1.1.1. S2
 - 1.1.2. S3
 - 1.1.3. S4
 - 1.1.4. S5
 - 1.1.5. S7
 2. PETERSON GALLOWAY LTD. – AS–BUILTS, AUGUST 23, 2005. PROJECT #846342
 - 2.1. DRAWINGS:
 - 2.1.1. S03
 - 2.1.2. S04
 - 2.1.3. S05
 - 2.1.4. S06
 3. WESTMAR – RECORD DRAWINGS, MARCH 31, 2004. PROJECT #846342
 - 3.1. DRAWINGS:
 - 3.1.1. D–S2
 - 3.1.2. D–S3
 - 3.1.3. D–S5
 - 3.1.4. D–S6
 - 3.1.5. D–S7
 - 3.1.6. D–S8
 - 3.1.7. D–S9
 4. KER PRIESTMAN & ASSOCIATES LTD. – AS–BUILTS, JULY 26, 1985 PROJECT #PR100772
 - 4.1. DRAWINGS:
 - 4.1.1. 35
 - 4.1.2. 38
 - 4.1.3. 39
 - 4.1.4. 40
 - 4.1.5. 41
 5. ORIGINAL TIMBER JETTY DRAWINGS, 1941
 - 5.1. FULL DRAWING SET (NOT LABELED)
- ADDITIONAL RECORD/AS–BUILTS ALSO AVAILABLE

NOTES:

1. TIMBER DECK STRUCTURE TYPICALLY CONSISTS OF:
 ASPHALT TOPPING
 102 DECK PLANKING
 305 DECK PLANKING
 305 STRINGERS
2. WEST CRANE PAD TYPICALLY CONSISTS OF:
 400 THICK REINFORCED CONCRETE SLAB
 12.7 PRESERVED PLYWOOD DECK FORMWORK
 102 STRINGERS
 WEST CRANE PAD APPROACH TYPICALLY CONSISTS OF:
 200 THICK REINFORCED CONCRETE SLAB
 20 PRESERVED PLYWOOD DECK FORMWORK
 305 STRINGERS
3. TIMBER INFILL DECK TYPICALLY CONSISTS OF:
 ASPHALT TOPPING
 100 DECKING
 300 STRINGERS
4. FOR NUMBERS DENOTED (X) REFER TO TABLE ON D4.
5. ALL EXISTING UTILITIES ARE SHOWN ACCORDING TO AVAILABLE RECORD DRAWINGS. THE CONTRACTOR SHALL LOCATE ALL EXISTING UTILITIES PRIOR TO CONSTRUCTION, INCLUDING UNDERGROUND FIRE WATER, SANITARY SEWER, COMPRESSED AIR, POWER AND TELEPHONE SERVICE DUCTS AND SHALL NOTIFY THE DEPARTMENTAL REPRESENTATIVE OF ANY DISCREPANCIES OR CONFLICTS A MINIMUM OF 72 HOURS PRIOR TO CONSTRUCTION. ANY ADDITIONAL WORK REQUIRED AS A RESULT OF FAILING TO PRE-LOCATE KNOWN OR POTENTIAL CONFLICTS WILL BE COMPLETED AT THE CONTRACTOR'S EXPENSE.
6. EXISTING "TOWER CRANE PAD" SOUTH FACE MISALIGNED BY APPROXIMATE 150 MM.
7. CONTRACTOR TO PERFORM FIELD SURVEY OF EXISTING CONDITIONS AND NOTIFY DEPARTMENTAL REPRESENTATIVE IF DISCREPANCIES ARE FOUND.
8. CONTRACTOR TO INSPECT AND DOCUMENT THE CONDITION OF THE FOLLOWING STRUCTURAL ITEMS PRIOR TO COMMENCING DEMOLITION WORK (REFER TO SPECIFICATIONS):
 - 8.1. STEEL PILED CONCRETE JETTY
 - 8.2. WEST AND SOUTH FACES OF TIMBER CRIB
 - 8.3. SHEET PILE PERIMETER WALL
 - 8.4. CONCRETE RETAINING WALL AT EAST APPROACH
 - 8.5. SHEET PILE BULKHEAD WALL
9. FOR MODIFIED CONDITIONS SEE DRAWINGS C5 AND C6.

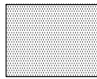LEGEND

-  APPROXIMATE EXTENT OF "BURMA ROAD" & TOWER CRANE PAD
-  TIMBER PILE
-  TIMBER BRACE PILE
-  FIRE SPRINKLER ACCESS FRAMES

Revision/Revision	Description/Description	Date/Date
1	RECORD DRAWING	2017/03/29
0	ISSUED FOR TENDER	2014/12/19

PUBLIC WORKS AND GOVERNMENT SERVICES CANADA

Project title/Titre du projet
ESQUIMALT GRAVING DOCK
 825 ADMIRALS ROAD, VICTORIA, BC

ESQUIMALT GRAVING DOCK WATERLOT PHASE 2 SOUTH JETTY UNDER-PIER SEDIMENT REMEDIATION

Consultant Signature Only

Designed by/Concept par
 JANET TONG


Drawn by/Desainé par
 ARNIE RIST

PWGC Project Manager/Administrateur de Projets TPSGC
 ANDREW MYLLY

Regional Manager, Environmental Services
 COLLIN KINGMAN


Drawing title/Titre du dessin
WEST JETTY EXISTING DECK STRUCTURE AND DEMOLITION PLAN

Project No./No. du projet	Sheet/	Revision no./
R.018400.002	D1	1

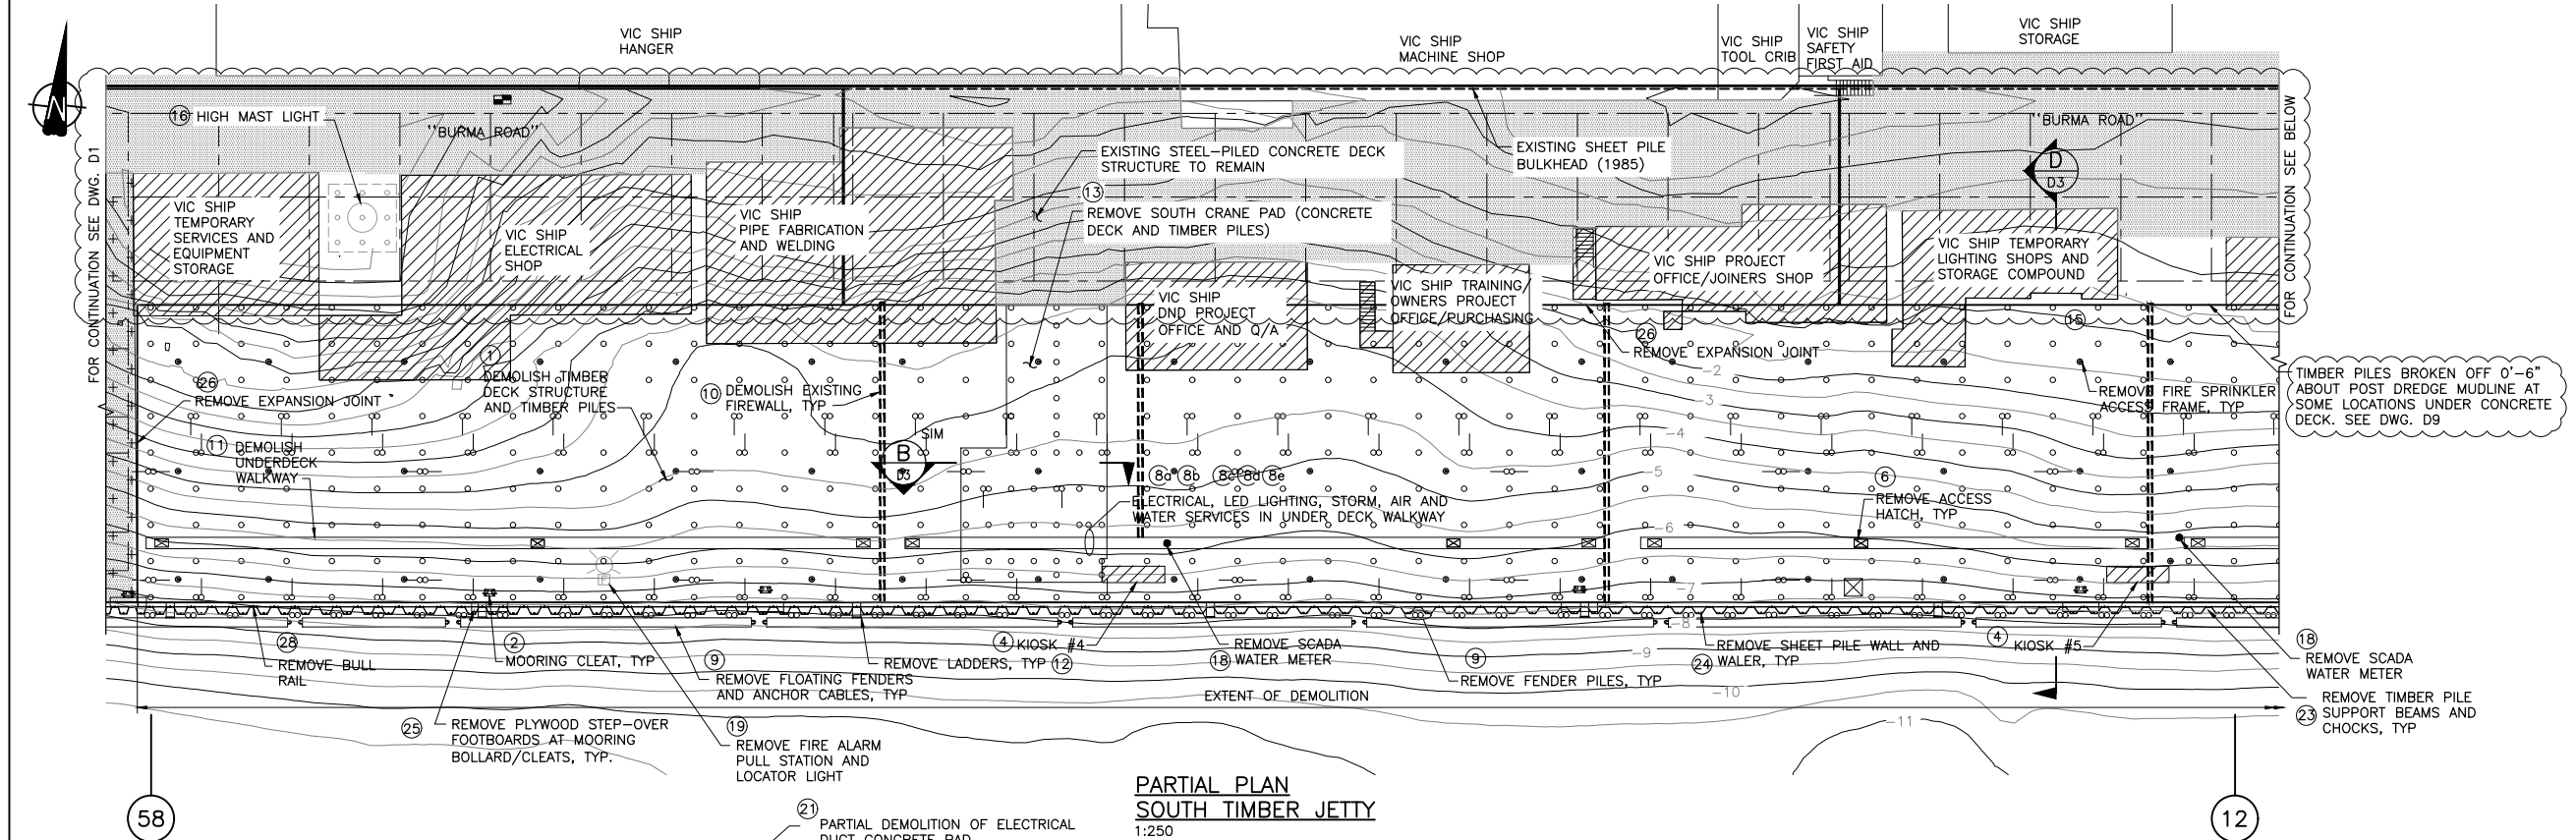

PARTIAL PLAN SOUTH TIMBER JETTY
1:250

TIMBER PILES BROKEN OFF 0'-6" ABOUT POST DREDGE MUDLINE AT SOME LOCATIONS UNDER CONCRETE DECK. SEE DWG. D9

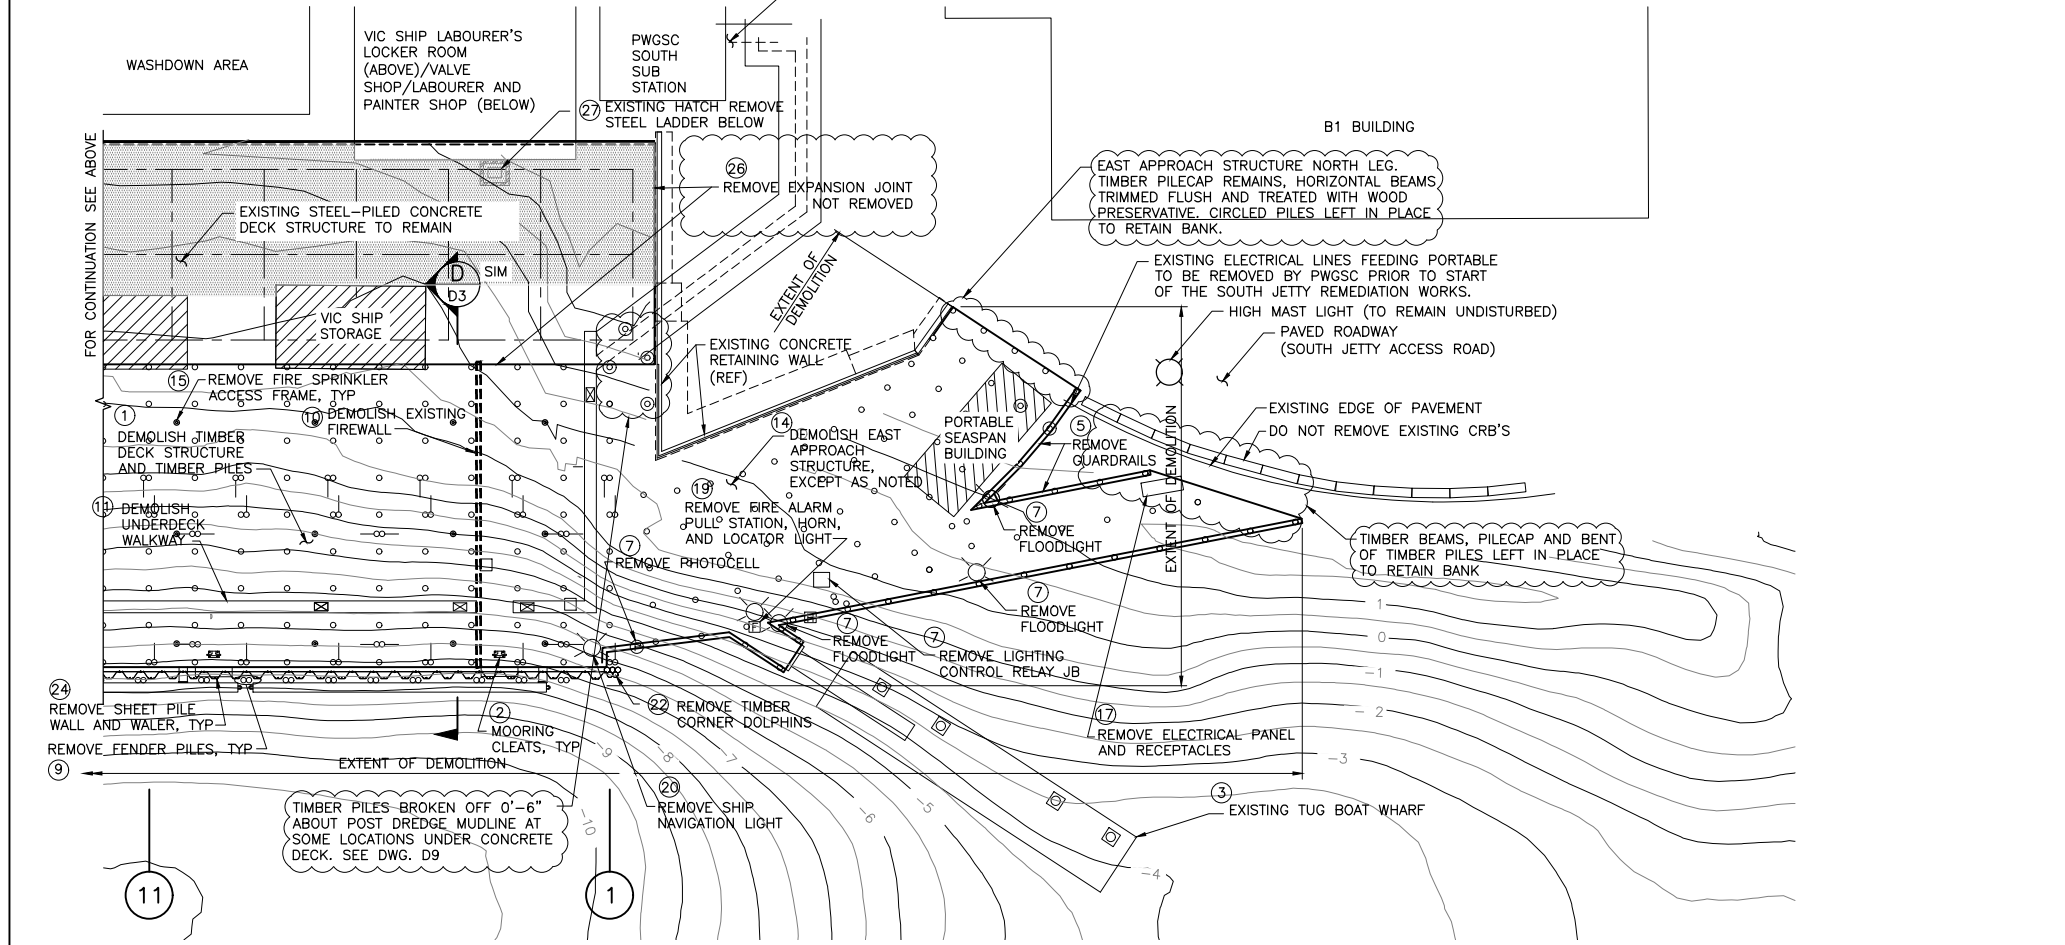

PARTIAL PLAN SOUTH TIMBER JETTY
1:250

TIMBER PILES BROKEN OFF 0'-6" ABOUT POST DREDGE MUDLINE AT SOME LOCATIONS UNDER CONCRETE DECK. SEE DWG. D9

NOTES:

- TIMBER DECK STRUCTURE TYPICALLY CONSISTS OF:
 ASPHALT TOPPING
 102 DECK PLANKING
 305 DECK PLANKING
 305 STRINGERS
- SOUTH CRANE PAD TYPICALLY CONSISTS OF:
 400 THICK REINFORCED CONCRETE SLAB
 12.7 PRESERVED PLYWOOD DECK FORMWORK
 102 STRINGERS
 SOUTH CRANE PAD APPROACH TYPICALLY CONSISTS OF:
 200 THICK REINFORCED CONCRETE SLAB
 20 PRESERVED PLYWOOD DECK FORMWORK
 305 STRINGERS
- EAST APPROACH STRUCTURE TYPICALLY CONSISTS OF:
 ASPHALT TOPPING
 90 DECKING
 290 STRINGERS
- FOR NUMBERS DENOTED (X) REFER TO TABLE ON D5.
- ALL EXISTING UTILITIES ARE SHOWN ACCORDING TO AVAILABLE RECORD DRAWINGS. THE CONTRACTOR SHALL LOCATE ALL EXISTING UTILITIES PRIOR TO CONSTRUCTION, INCLUDING UNDERGROUND FIRE WATER, SANITARY SEWER, COMPRESSED AIR, POWER AND TELEPHONE SERVICE DUCTS AND SHALL NOTIFY THE DEPARTMENTAL REPRESENTATIVE OF ANY DISCREPANCIES OR CONFLICTS A MINIMUM OF 72 HOURS PRIOR TO CONSTRUCTION. ANY ADDITIONAL WORK REQUIRED AS A RESULT OF FAILING TO PRE-LOCATE KNOWN OR POTENTIAL CONFLICTS WILL BE COMPLETED AT THE CONTRACTOR'S EXPENSE.
- FOR MODIFIED CONDITIONS SEE DRAWINGS C5 AND C6.

LEGEND

- EXISTING STRUCTURES AND BUILDINGS TO BE REMOVED BY PWGSC PRIOR TO START OF THE SOUTH JETTY REMEDIATION WORKS.
- APPROXIMATE EXTENT OF "BURMA ROAD" & TOWER CRANE PAD
- TIMBER PILE
- TIMBER BRACE PILE
- FIRE SPRINKLER ACCESS FRAMES

Revision/Revision	Description/Description	Date/Date
1	RECORD DRAWING	2017/03/29
0	ISSUED FOR TENDER	2014/12/19

PUBLIC WORKS AND GOVERNMENT SERVICES CANADA


Project title/Titre du projet
ESQUIMALT GRAVING DOCK
 825 ADMIRALS ROAD, VICTORIA, BC

ESQUIMALT GRAVING DOCK WATERLOT PHASE 2 SOUTH JETTY UNDER-PIER SEDIMENT REMEDIATION


Consultant Signature Only
 Designed by/Concept par
 JANET TONG
 Drawn by/Desainé par
 ARNIE RIST
 PWGSC Project Manager/Administrateur de Projets TPSGC
 ANDREW MYLLY
 Regional Manager, Environmental Services
 COLLIN KINGMAN

Drawing title/Titre du dessin
SOUTH JETTY EXISTING DECK STRUCTURE AND DEMOLITION PLAN


Project No./No. du projet R.018400.002	Sheet/ D2	Revision no./ 1
--------------------------------------------------	---------------------	---------------------------

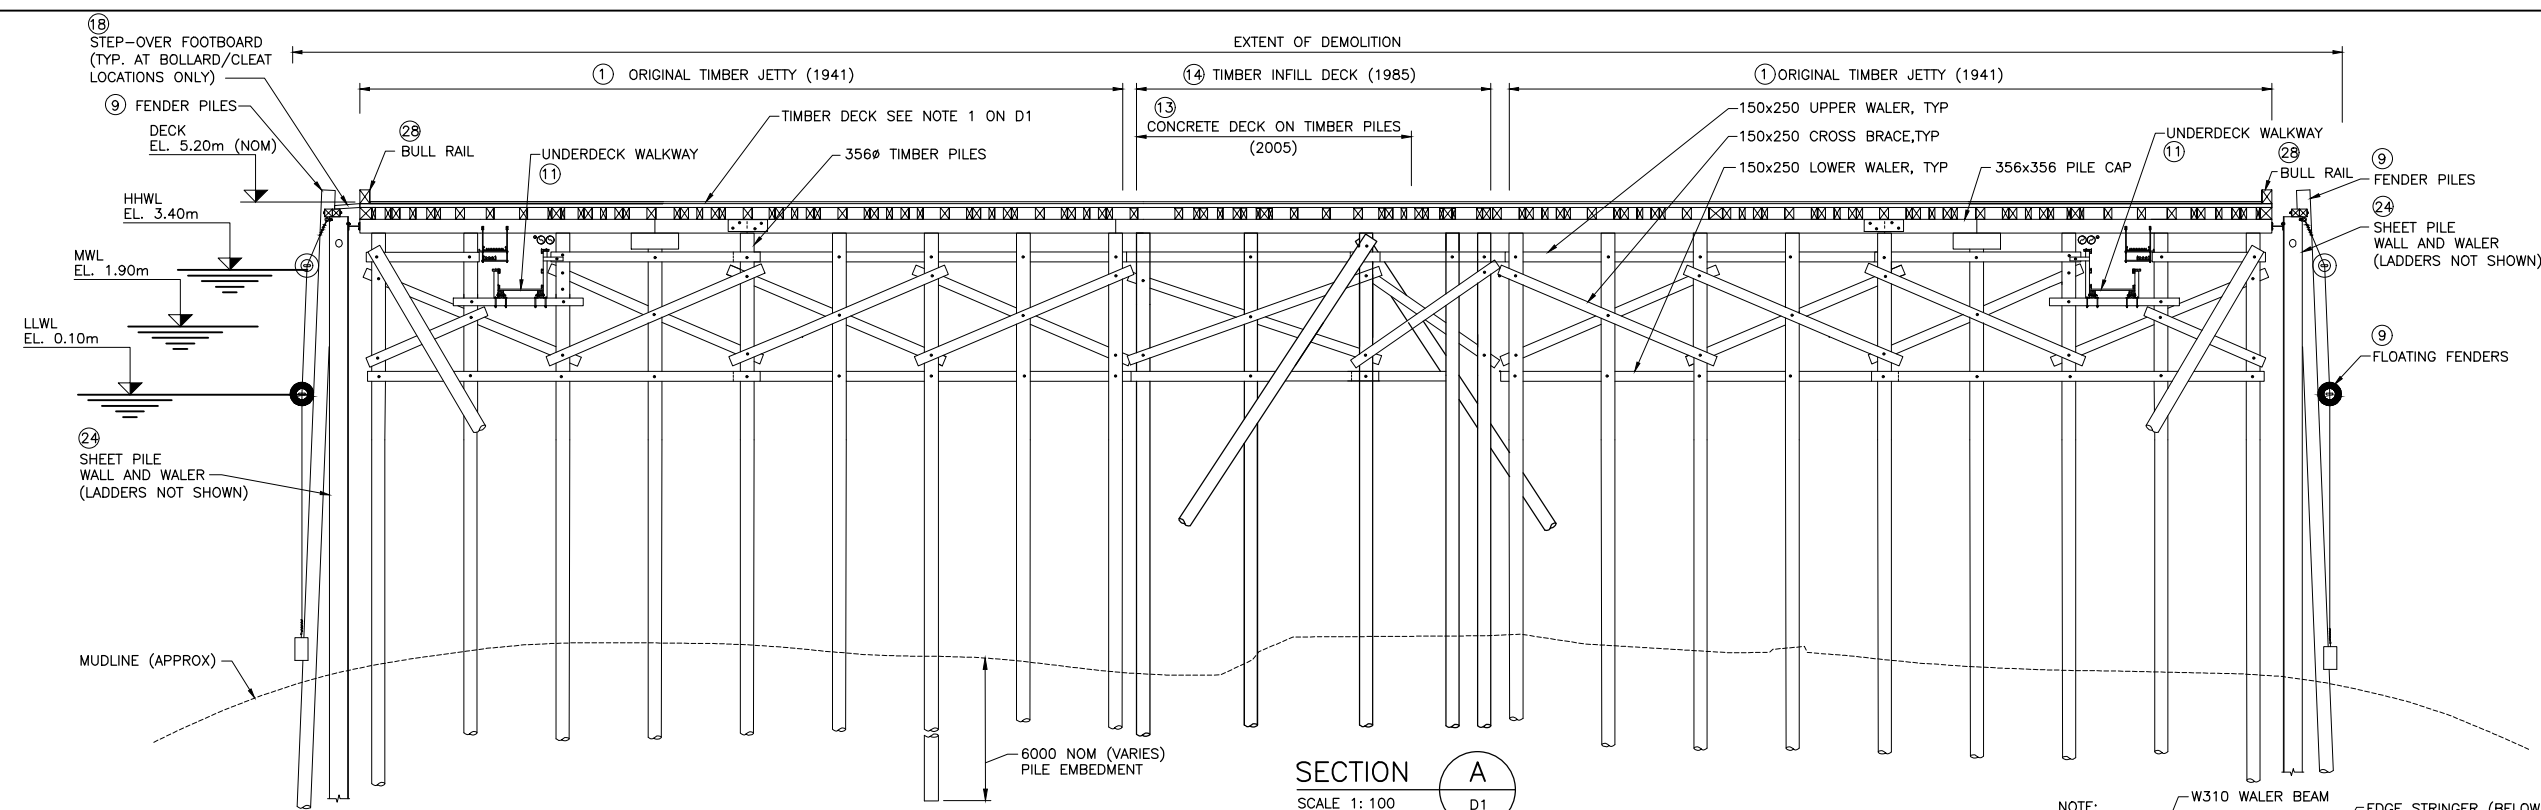


SECTION A
 SCALE 1: 100
 (AT WEST TIMBER JETTY)

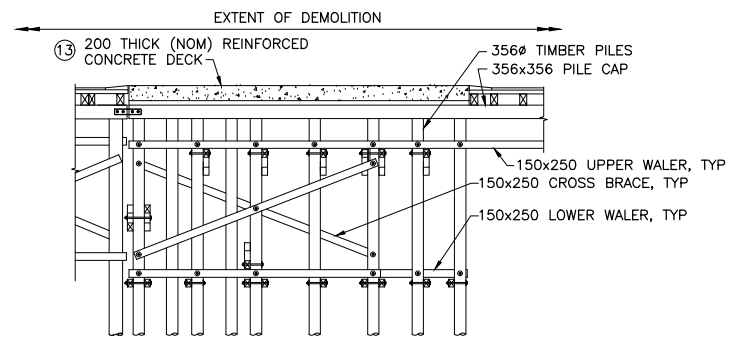


SECTION B
 SCALE 1: 100
 (AT WEST TIMBER JETTY)

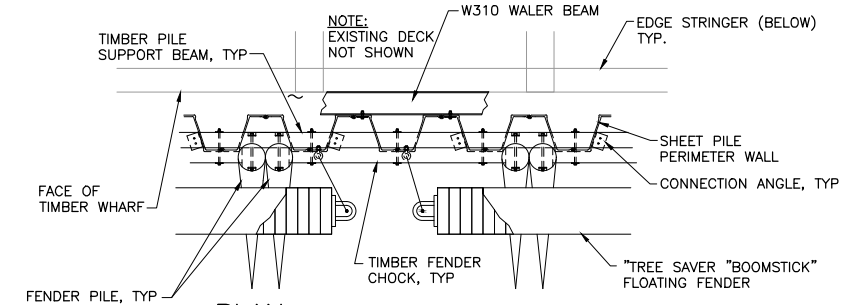

PLAN
 EXISTING WHARF FENDER SYSTEM
 SCALE 1: 50

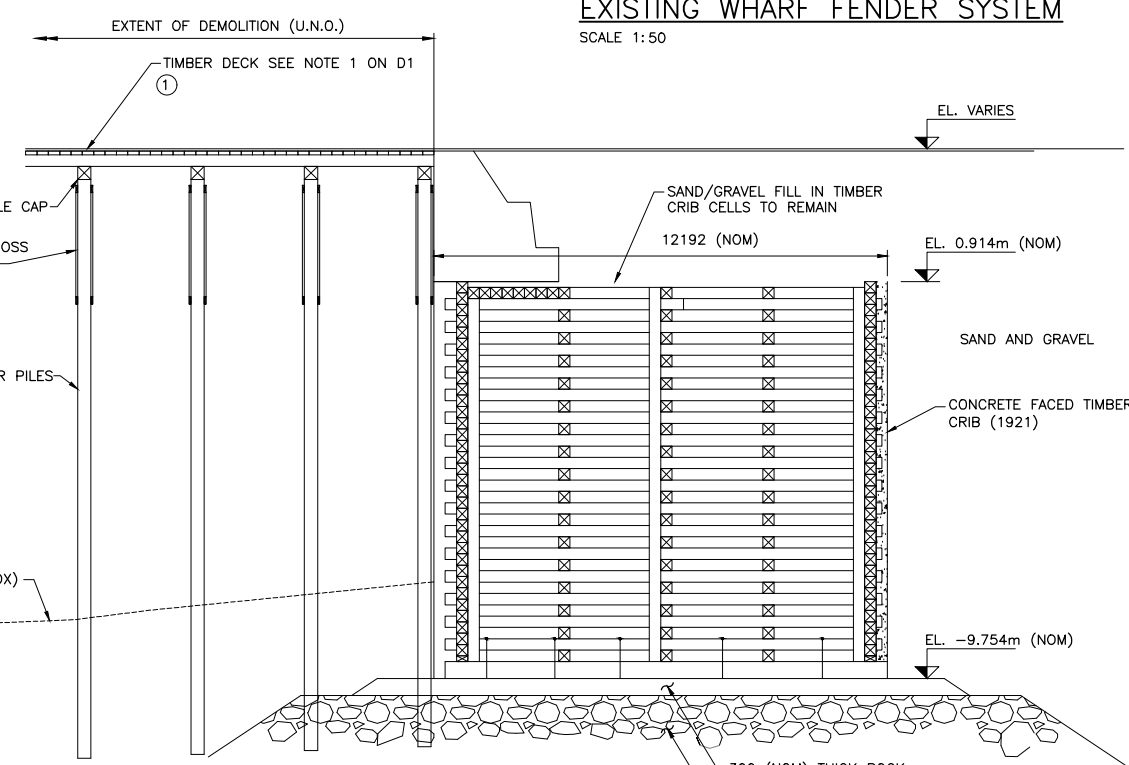

SECTION C
 SCALE 1: 100
 (AT WEST TIMBER JETTY)

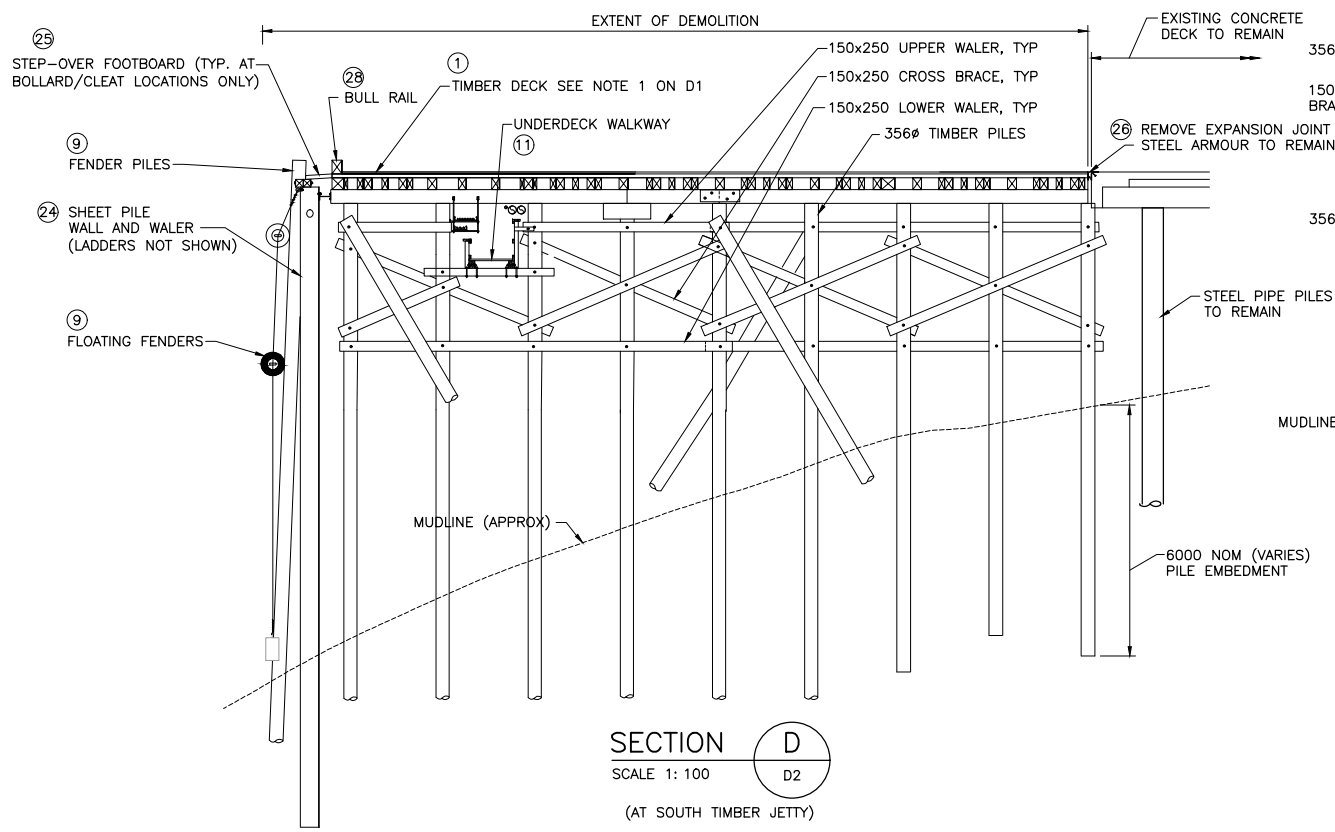

SECTION D
 SCALE 1: 100
 (AT SOUTH TIMBER JETTY)

Revision/	Description/	Date/
1	RECORD DRAWING	2017/03/29
0	ISSUED FOR TENDER	2014/12/19

Client/client
PUBLIC WORKS AND GOVERNMENT SERVICES CANADA

Project title/Titre du projet
ESQUIMALT GRAVING DOCK
 825 ADMIRALS ROAD, VICTORIA, BC

ESQUIMALT GRAVING DOCK WATERLOT PHASE 2
SOUTH JETTY UNDER-PIER SEDIMENT REMEDIATION

Consultant Signature Only
 Designed by/Concept par
 JANET TONG
 Drawn by/Dessiné par
 ARNIE RIST
 PWGSC Project Manager/Administrateur de Projets TFSGC
 ANDREW MYLLY
 Regional Manager, Environmental Services
 COLLIN KINGMAN

Drawing title/Titre du dessin
WEST JETTY AND SOUTH JETTY
EXISTING DECK STRUCTURE AND DEMOLITION
SECTIONS

Project No./No. du projet	Sheet/	Revision no./
R.018400.002	D3	1



WEST TIMBER JETTY			ITEMS DEMOLISHED, REMOVED, RELOCATED, OR RETAINED
ITEM NUMBER	BRIEF DESCRIPTION OF ITEMS	ACTION	
①	TIMBER DECK STRUCTURE AND TIMBER PILES	REMOVE TO DEMOLITION EXTENTS SHOWN AND DISPOSE. SEE NOTE 1 ON D1.	
②	12 MOORING CLEATS	REMOVE AND RETURN TO PWGSC. STORE IN LOCATION DESIGNATED BY THE DEPARTMENTAL REPRESENTATIVE.	
③	1 100 TONNE BOLLARD	REMOVE AND RETURN TO PWGSC. STORE IN LOCATION DESIGNATED BY THE DEPARTMENTAL REPRESENTATIVE.	
④	3 KIOSKS AND JETTY MOUNT TERMINAL BOXES	REMOVE, PREPARE FOR STORAGE AND STORE IN LOCATION DESIGNATED BY DEPARTMENTAL REPRESENTATIVE. PREPARATION FOR STORAGE INCLUDES TIGHTLY PLUGGING ALL EXTERNAL OPENINGS. (e.g. PIPES AND SWITCHGEAR)	
⑤	1 ABANDONED KIOSK WITH FIRE ALARM SIGA-CT2 CONTROL RELAY MODULE	REMOVE AND RETURN TO PWGSC. STORE IN LOCATION DESIGNATED BY THE DEPARTMENTAL REPRESENTATIVE.	
⑥	14 ACCESS HATCHES INCLUDING FRAMES	REMOVE AND DISPOSE.	
⑦	1 LIGHT STANDARD	REMOVE AND DISPOSE. SEE DWG E4 FOR POWER CABLE REMOVAL.	
⑧a	ELECTRICAL SERVICES	REMOVE AND DISPOSE CABLES TO THE EXTENTS SHOWN ON DWG E1, E2 & E4. REMOVE AND RETAIN UNDER-DECK CABLE TRAY FOR RE-USE AS SHOWN ON DWG E4. REMOVE AND DISPOSE LED LIGHTING.	
⑧b	STORM SERVICES	REMOVE AND DISPOSE.	
⑧c	FIRE WATER MAIN	REMOVE TO THE EXTENTS SHOWN ON DWG M4. RETAIN FOR RE-USE ALL PVC PIPE MECHANICAL COUPLINGS, VALVES AND FITTINGS THAT CAN BE USED IN THE WORK. RETURN TO PWGSC ALL FLOW METERS WITH A TAG INDICATING THE ASSOCIATED KIOSK NUMBER. DISPOSE OF ALL OTHER FIRE WATER ITEMS.	
⑧d	COMPRESSED AIR LINE	REMOVE AND DISPOSE TO EXTENTS SHOWN ON DWG M6.	
⑧e	SANITARY SEWER	REMOVE AND DISPOSE TO EXTENTS SHOWN ON M5.	
⑨	FLOATING FENDERS AND FENDER PILES	REMOVE AND DISPOSE FLOATING FENDERS INCLUDING ANCHOR CABLES. REMOVE AND RETAIN FENDER PILES SELECTED FOR RE-USE. REMOVE AND DISPOSE REMAINING FENDER PILES. (SEE NOTE 2.)	
⑩	FIREWALLS	REMOVE AND DISPOSE.	
⑪	UNDERDECK WALKWAY	REMOVE AND DISPOSE.	
⑫	10 LADDERS	REMOVE AND MODIFY LADDERS REQUIRED FOR RE-USE AS SHOWN ON DWG S122. REMOVE AND DISPOSE REMAINING LADDERS.	
⑬	WEST CRANE PAD CONCRETE DECK AND TIMBER PILES	REMOVE AND DISPOSE. SEE NOTE 2 ON DWG D1.	
⑭	TIMBER INFILL DECK AND TIMBER PILES	REMOVE AND DISPOSE. SEE NOTE 3 ON DWG D1.	
⑮	73 FIRE SPRINKLER ACCESS (LIDS AND FRAMES)	REMOVE AND DISPOSE.	
⑯	TIMBER WALLS	REMOVE AND DISPOSE.	
⑰	EXPANSION JOINT	REMOVE AND DISPOSE. STEEL ARMORING EMBEDDED IN CONCRETE DECK TO REMAIN.	
⑱	PLYWOOD STEP-OVER FOOTBOARDS	REMOVE AND DISPOSE.	
⑲	KIOSK SCADA WATER METERS	REMOVE AND RETURN TO PWGSC. CORRESPONDING LABELS TO BE REMOVED AND RETURNED TO PWGSC.	
⑳	FIRE ALARM PULL STATION AND LOCATOR LIGHT	REMOVE AND RETURN TO PWGSC. STORE IN LOCATION DESIGNATED BY THE DEPARTMENTAL REPRESENTATIVE.	
㉑	CAISSON "PARK" SWITCHED RECEPTACLE AND TERMINAL BOX	REMOVE AND DISPOSE.	
㉒	CORNER TIMBER DOLPHINS	REMOVE AND RETAIN FOR RE-USE.	
㉓	TIMBER SUPPORT BEAMS AND CHOCKS	REMOVE AND DISPOSE TIMBER SUPPORT BEAMS. REMOVE AND RETAIN CHOCKS SELECTED FOR RE-USE. REMOVE AND DISPOSE REMAINING FENDER CHOCKS.	
㉔	SHEET PILE WALL AND WALER	REMOVE AND DISPOSE, EXCEPT FOR WALER REQUIRED FOR TEMPORARY SUPPORT AT TIMBER CRIB. SEE DWG CSM8.	
㉕	BOAT ACCESS FRAME	REMOVE AND DISPOSE.	
㉖	DECK ACCESS HATCH AND LADDER	REMOVE AND DISPOSE.	
㉗	STEEL ACCESS LADDER	REMOVE, RETAIN AND MODIFY FOR RE-USE. (SEE DWG S122)	
㉘	BULL RAIL	REMOVE AND RETAIN BULL RAIL SELECTED FOR RE-USE. REMOVE AND DISPOSE REMAINING BULL RAIL. (SEE NOTE 2.)	

Revision/Revision	Description/Description	Date/Date
1	RECORD DRAWING	2017/03/29
0	ISSUED FOR TENDER	2014/12/19

Client/client
PUBLIC WORKS AND GOVERNMENT SERVICES CANADA

Project title/Titre du projet
**ESQUIMALT GRAVING DOCK
825 ADMIRALS ROAD, VICTORIA, BC**

**ESQUIMALT GRAVING DOCK
WATERLOT PHASE 2
SOUTH JETTY UNDER-PIER
SEDIMENT REMEDIATION**


Consultant Signature Only
Designed by/Concept par
GEOFF COOPER
Drawn by/Desainé par
ARNIE RIST
PWGSC Project Manager/Administrateur de Projets TPSGC
ANDREW MYLLY
Regional Manager, Environmental Services
COLLIN KINGMAN

Drawing title/Titre du dessin
**WEST JETTY
DEMOLITION ITEM DESCRIPTION AND
ACTION TABLE**

Project No./No. du projet R.018400.002	Sheet/ D4	Revision no./ 1
--------------------------------------------------	---------------------	---------------------------

NOTES:

- THIS TABLE INDICATES THE PRIMARY ITEMS FOR DEMOLITION AND GIVES GUIDANCE FOR ITEMS TO BE DEMOLISHED, REMOVED, RELOCATED OR RETAINED. ALL ITEMS WITHIN THE EXTENTS OF DEMOLITION, AS SHOWN ON DRAWING D1, ARE TO BE REMOVED.
- RETAINED BULL RAIL AND CHOCKS RETURNED TO PWGSC. RETAINED FENDER PILES DISPOSED OF.

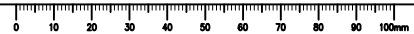



SOUTH TIMBER JETTY		ITEMS DEMOLISHED, REMOVED, RELOCATED, OR RETAINED	ACTION
ITEM NUMBER	BRIEF DESCRIPTION OF ITEMS		
①	TIMBER DECK STRUCTURE AND TIMBER PILES		REMOVE TO DEMOLITION EXTENTS SHOWN AND DISPOSE. SEE NOTE 1 ON D2.
②	6 MOORING CLEATS		REMOVE AND RETURN TO PWGSC. STORE IN LOCATION DESIGNATED BY THE DEPARTMENTAL REPRESENTATIVE.
③	TUG BOAT WHARF, INCLUDING FLOATS, PILES AND GANGWAY		REMOVE, STORE AND RETAIN FOR RE-USE AT LOCATION SHOWN ON DRAWINGS. SEE NOTE 3.
④	2 KIOSKS AND JETTY MOUNT TERMINAL BOXES		REMOVE, PREPARE FOR STORAGE AND STORE IN LOCATION DESIGNATED BY DEPARTMENTAL REPRESENTATIVE. PREPARATION FOR STORAGE INCLUDES TIGHTLY PLUGGING ALL EXTERNAL OPENINGS. (e.g. PIPES AND SWITCHGEAR)
⑤	GUARDRAILS		REMOVE AND DISPOSE.
⑥	15 ACCESS HATCHES INCLUDING FRAMES		REMOVE AND DISPOSE.
⑦	3 FLOODLIGHTS, PHOTOCCELL AND POWER CONTROL RELAY JB		REMOVE AND DISPOSE.
⑧a	ELECTRICAL SERVICES		REMOVE AND DISPOSE CABLES TO EXTENTS SHOWN ON DWG E1, E2 AND E4. REMOVE BURIED CONDUIT AND DUCT BANKS AS SHOWN ON DWG E1 AND E4. REMOVE AND RETAIN FOR RE-USE ALL ELECTRICAL SERVICES ON TUG WHARF FACILITY. REMOVE AND DISPOSE LED LIGHTING.
⑧b	STORM SERVICES		REMOVE AND DISPOSE.
⑧c	FIRE WATER MAIN		REMOVE TO THE EXTENTS SHOWN ON DWG M4. RETAIN FOR RE-USE ALL PVC PIPE MECHANICAL COUPLINGS, VALVES AND FITTINGS THAT CAN BE USED IN THE WORK. RETURN TO PWGSC ALL FLOW METERS WITH A TAG INDICATING THE ASSOCIATED KIOSK NUMBER. DISPOSE OF ALL OTHER FIRE WATER ITEMS.
⑧d	COMPRESSED AIR LINE		REMOVE AND DISPOSE TO EXTENTS SHOWN ON M6.
⑧e	SANITARY SEWER		REMOVE AND DISPOSE TO EXTENTS SHOWN ON M5.
⑨	FLOATING FENDERS AND FENDER PILES		REMOVE AND DISPOSE FLOATING FENDERS INCLUDING INCLUDING ANCHOR CABLES. REMOVE AND RETAIN FENDER PILES SELECTED FOR RE-USE. REMOVE AND DISPOSE REMAINING FENDER PILES.
⑩	FIREWALLS		REMOVE AND DISPOSE.
⑪	UNDERDECK WALKWAY		REMOVE AND DISPOSE.
⑫	8 LADDERS		REMOVE AND MODIFY LADDERS REQUIRED FOR RE-USE AS SHOWN ON DWG S122. REMOVE AND DISPOSE REMAINING LADDERS.
⑬	SOUTH CRANE PAD AND TIMBER PILES		REMOVE AND DISPOSE. SEE NOTE 2 ON DWG D2.
⑭	EAST APPROACH STRUCTURE AND TIMBER PILES		REMOVE TO DEMOLITION EXTENTS SHOWN AND DISPOSE. SEE NOTE 3 ON DWG D2.
⑮	63 FIRE SPRINKLER ACCESS (LIDS AND FRAMES)		REMOVE AND DISPOSE.
⑯	HIGH MAST LIGHT		REMOVE AND RETAIN FOR RE-USE. CCTV SYSTEM, INCLUDING CCTV CAMERA, TRANSFORMER AND ANTENNA, TO BE REMOVED PRIOR TO REMOVING THE HIGH MAST LIGHT POLE AND RETURNED TO DEPARTMENTAL REPRESENTATIVE. CCTV SYSTEM TO BE RE-INSTALLED AFTER HIGH MAST LIGHT POLE IS RE-ERECTED. SEE DRAWINGS D7, D8 AND S110.
⑰	ELECTRICAL PANEL AND RECEPTACLES		REMOVE AND DISPOSE.
⑱	KIOSK SCADA WATER METERS		REMOVE AND RETURN TO PWGSC. CORRESPONDING LABELS TO BE REMOVED AND RETURNED TO PWGSC.
⑲	FIRE ALARM PULL STATIONS, HORN AND LOCATOR LIGHTS		REMOVE AND RETAIN FOR RE-USE AT SOUTH JETTY.
⑳	SHIP NAVIGATION LIGHT		REMOVE AND DISPOSE.
㉑	PARTIAL DEMOLITION OF EXISTING ELECTRICAL DUCT CONCRETE PAD		REMOVE AND DISPOSE.
㉒	CORNER TIMBER DOLPHINS		REMOVE AND RETAIN FOR RE-USE.
㉓	TIMBER SUPPORT BEAMS AND CHOCKS		REMOVE AND DISPOSE TIMBER SUPPORT BEAMS. REMOVE AND RETAIN CHOCKS SELECTED FOR RE-USE. REMOVE AND DISPOSE REMAINING CHOCKS. SEE NOTE 2.
㉔	SHEET PILE WALL AND WALER		REMOVE AND DISPOSE.
㉕	PLYWOOD STEP-OVER FOOTBOARDS		REMOVE AND DISPOSE.
㉖	EXPANSION JOINT		REMOVE AND DISPOSE. STEEL ARMORING EMBEDDED IN CONCRETE DECK TO REMAIN.
㉗	STEEL ACCESS LADDER		REMOVE, RETAIN AND MODIFY FOR RE-USE. (SEE DWG S122). NOT REMOVED.
㉘	BULL RAIL		REMOVE AND RETAIN BULL RAIL SELECTED FOR RE-USE. REMOVE AND DISPOSE REMAINING BULL RAIL. SEE NOTE 2.
㉙	OLD COLLAPSED SHEET PILE WALL		REMOVE AND DISPOSE.
㉚	TIMBER CUT-OFF PILES		REMOVE AND DISPOSE.

Revision/Revision	Description/Description	Date/Date
1	RECORD DRAWING	2017/03/29
0	ISSUED FOR TENDER	2014/12/19

Client/client

PUBLIC WORKS AND GOVERNMENT SERVICES CANADA

Project title/Titre du projet
**ESQUIMALT GRAVING DOCK
 825 ADMIRALS ROAD, VICTORIA, BC**

**ESQUIMALT GRAVING DOCK
 WATERLOT PHASE 2
 SOUTH JETTY UNDER-PIER
 SEDIMENT REMEDIATION**

Consultant Signature Only

Designed by/Concept par
 GEOFF COOPER

Drawn by/Desainé par
 ARNIE RIST

PWGSC Project Manager/Administrateur de Projets TPSGC
 ANDREW MYLLY

Regional Manager, Environmental Services
 COLLIN KINGMAN


Drawing title/Titre du dessin


**SOUTH JETTY
 DEMOLITION ITEM DESCRIPTION AND
 ACTION TABLE**

Project No./No. du projet	Sheet/	Revision no./
R.018400.002	D5	1

NOTES:

- THIS TABLE INDICATES THE PRIMARY ITEMS FOR DEMOLITION AND GIVES GUIDANCE FOR ITEMS TO BE DEMOLISHED, REMOVED, RELOCATED OR RETAINED. ALL ITEMS WITHIN THE EXTENTS OF DEMOLITION, AS SHOWN ON DRAWING D2, ARE TO BE REMOVED.
- RETAINED BULL RAIL AND CHOCKS RETURNED TO PWGSC. RETAINED FENDER PILES DISPOSED OF.
- TUG BOAT WHARF, GANGWAY, PILES, AND ANODES RETURNED TO PWGSC.

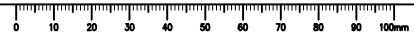

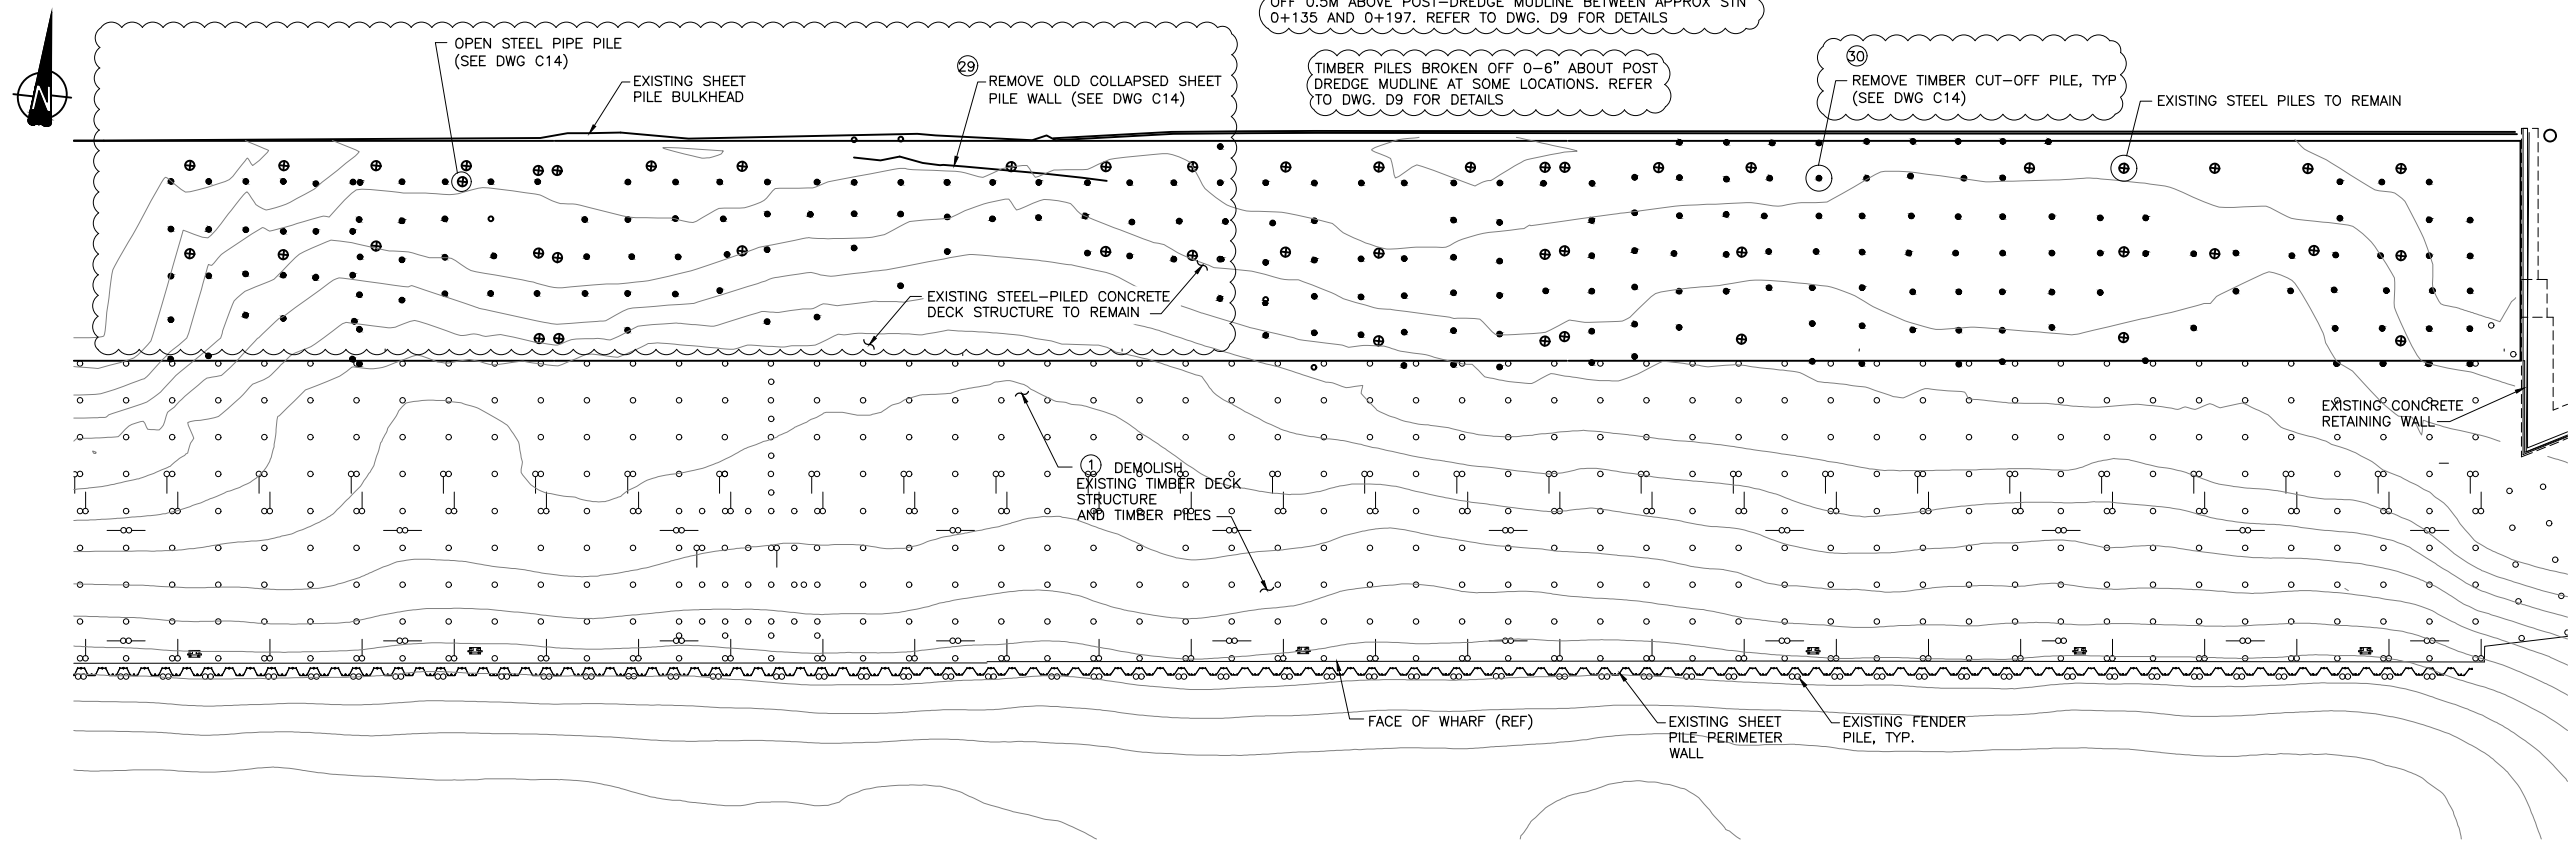

PLAN
SOUTH TIMBER JETTY UNDER-DECK
 1:250

LEGEND

- ⊕ EXISTING STEEL PILE
- EXISTING CUT-OFF TIMBER PILE
- TIMBER PILE
- TIMBER BRACE PILE

NOTES:

1. EXISTING STEEL PILE, CUT-OFF TIMBER PILE AND OLD COLLAPSED SHEET PILE WALL PILE LOCATIONS BASED ON FOCUS SURVEYS ON NOVEMBER 30, 2009 AND JANUARY 21, 2010. ONLY STEEL PILES SURVEYED BY FOCUS ARE SHOWN, i.e. NOT ALL STEEL PILES ARE SHOWN.
2. TOP OF TIMBER CUT-OFF PILE ELEVATION IS TYPICALLY BETWEEN EL. 2.9m AND EL. 3.1m.
3. FOR NUMBERS DENOTED (X) REFER TO TABLE ON D5.

Revision/Revision	Description/Description	Date/Date
1	RECORD DRAWING	2017/03/29
0	ISSUED FOR TENDER	2014/12/19

Client/client
PUBLIC WORKS AND GOVERNMENT SERVICES CANADA


Project title/Titre du projet
ESQUIMALT GRAVING DOCK
 825 ADMIRALS ROAD, VICTORIA, BC
ESQUIMALT GRAVING DOCK WATERLOT PHASE 2
SOUTH JETTY UNDER-PIER
SEDIMENT REMEDIATION

Consultant Signature Only
 Designed by/Concept par
 GEOFF COOPER
 Drawn by/Desainé par
 ARNIE RIST
 PWGSC Project Manager/Administrateur de Projets TPSGC
 ANDREW MYLLY
 Regional Manager, Environmental Services
 COLLIN KINGMAN

Drawing title/Titre du dessin
SOUTH JETTY
EXISTING UNDER-DECK CONDITIONS
AND DEMOLITION - PLAN

Project No./No. du projet R.018400.002	Sheet/ D6	Revision no./ 1
-------------------------------------------	--------------	--------------------



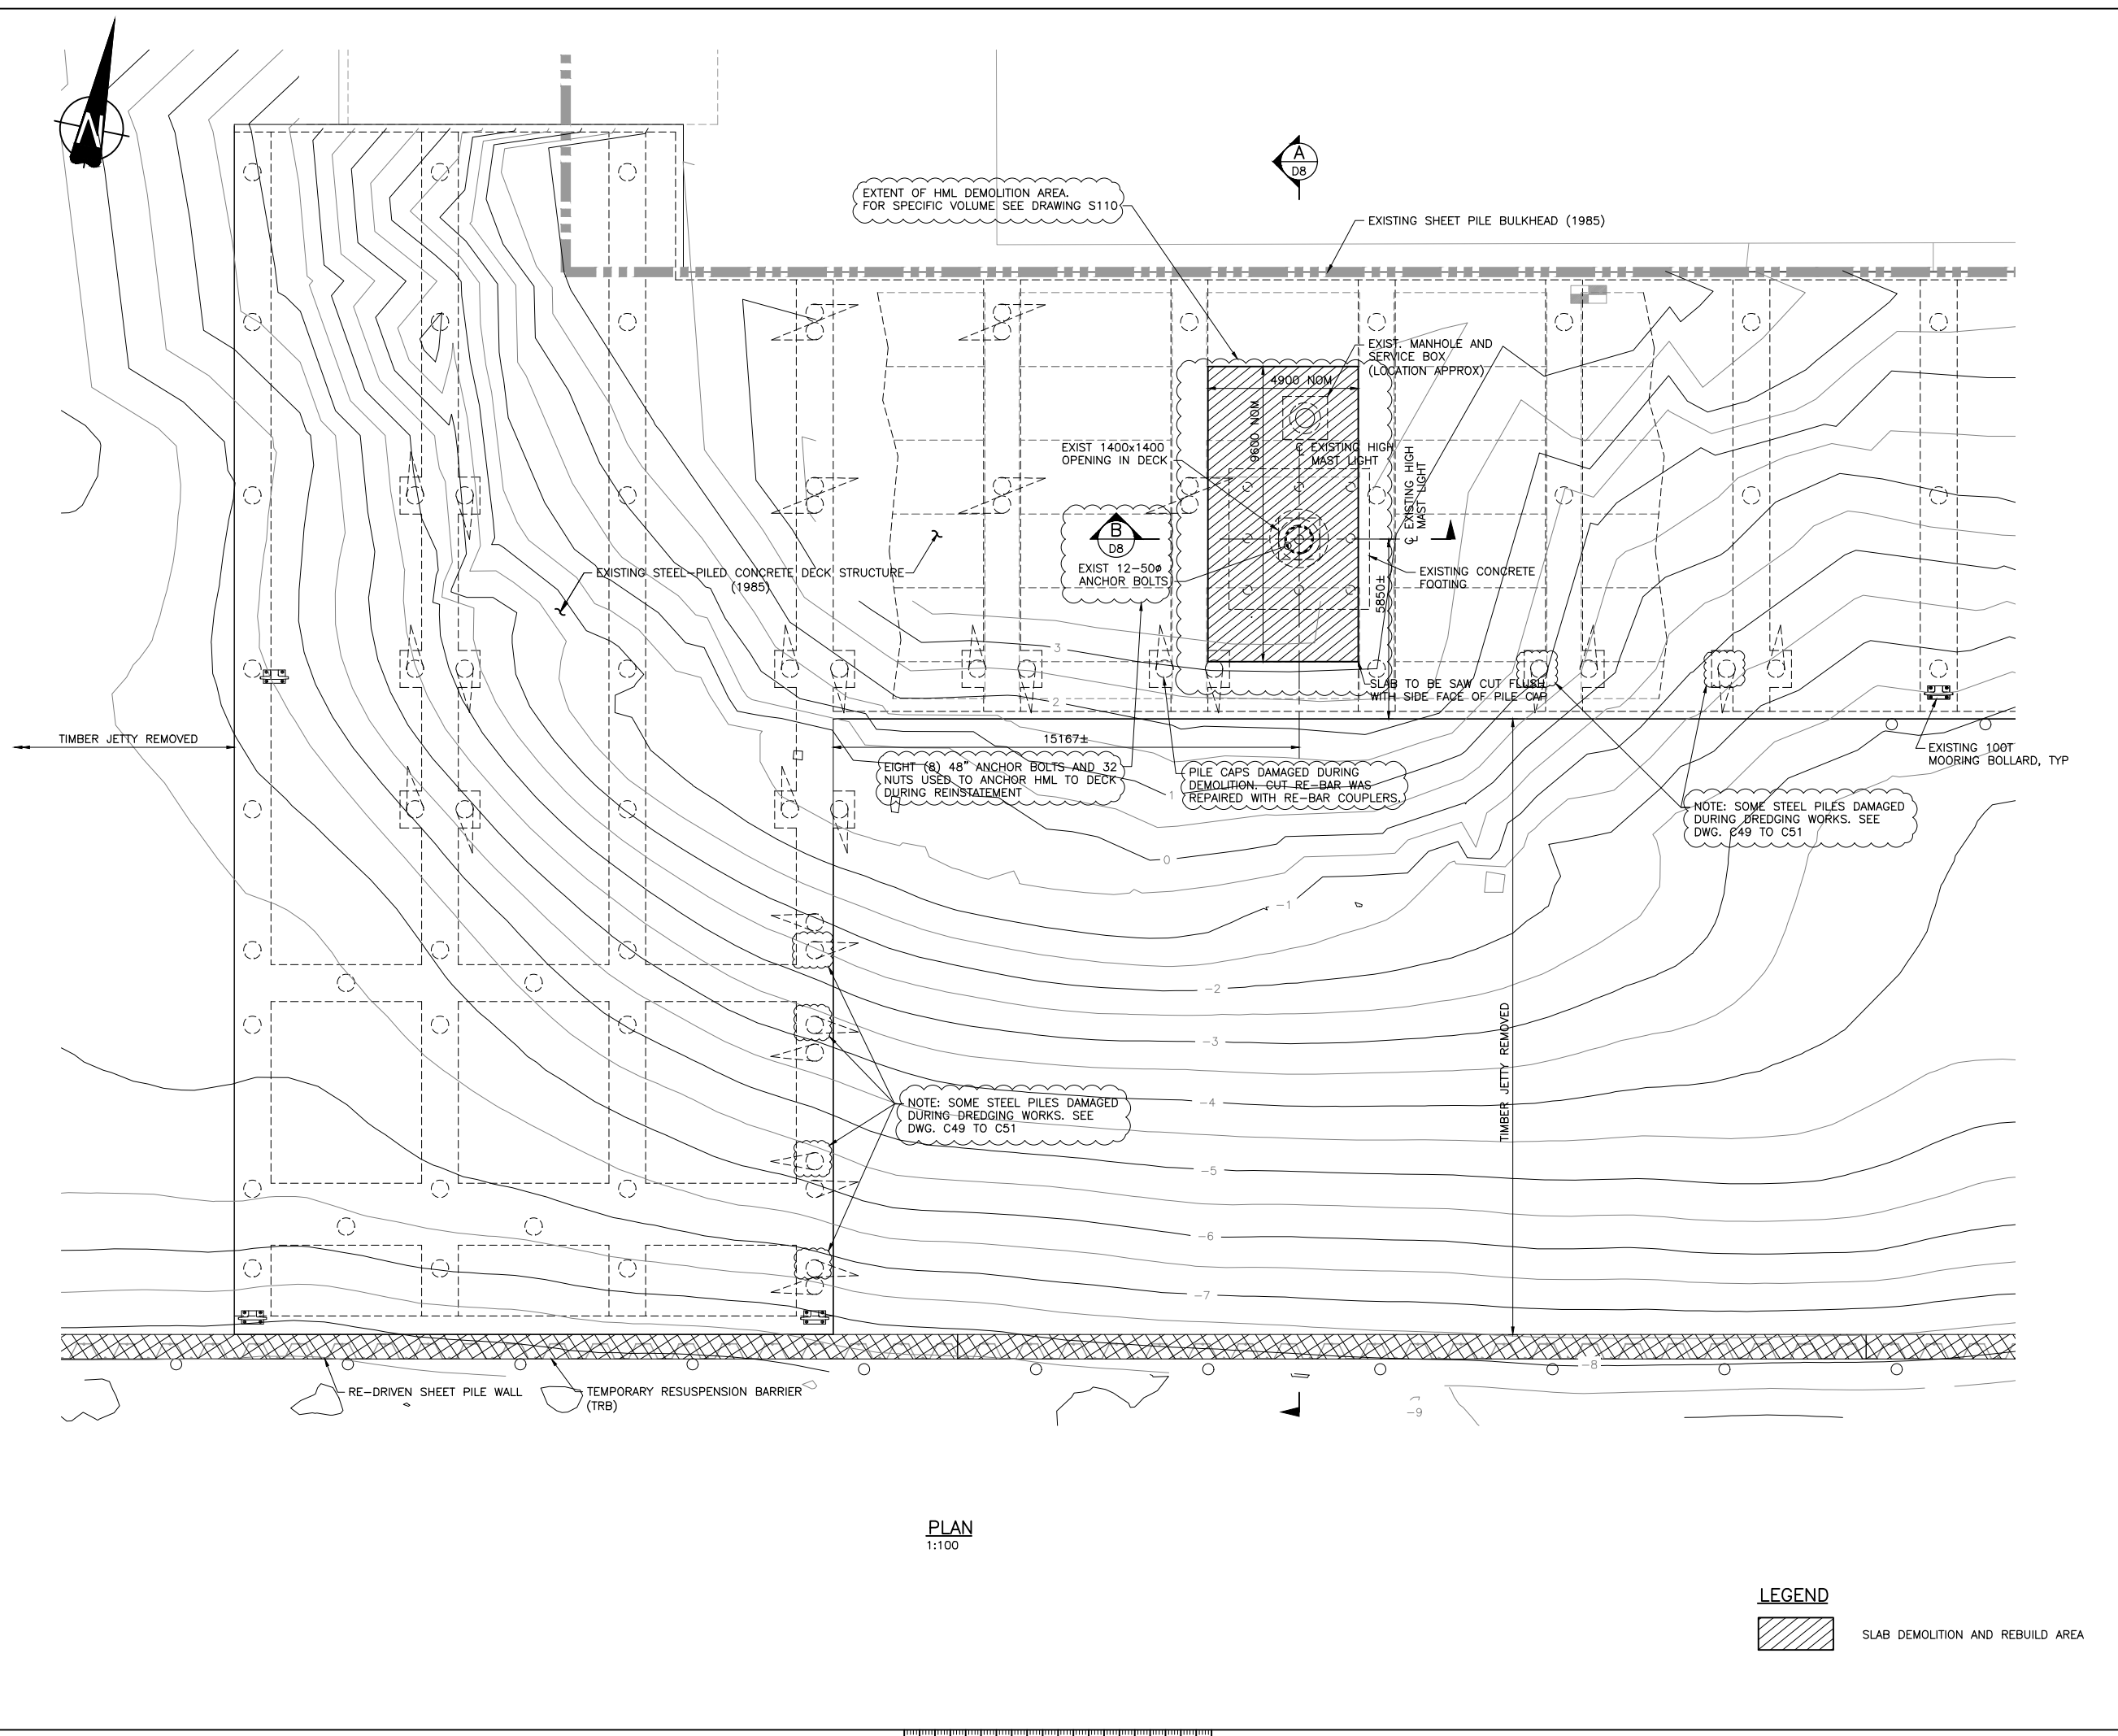

1	RECORD DRAWING	2017/03/29
0	ISSUED FOR TENDER	2014/12/19
Revision/Revisión	Description/Description	Date/Date


Client/client
PUBLIC WORKS AND GOVERNMENT SERVICES CANADA

Project title/Titre du projet
ESQUIMALT GRAVING DOCK
 825 ADMIRALS ROAD, VICTORIA, BC
ESQUIMALT GRAVING DOCK WATERLOT PHASE 2
SOUTH JETTY UNDER-PIER SEDIMENT REMEDIATION


Consultant Signature Only
 Designed by/Concept par
GEOFF COOPER
 Drawn by/Dessiné par
ARNIE RIST
 PWSC Project Manager/Administrateur de Projets TPSC
ANDREW MYLLY
 Regional Manager, Environmental Services
COLLIN KINGMAN

Drawing title/Titre du dessin
EXISTING HIGH MAST LIGHT AREA AND DEMOLITION SHEET 1


Project No./No. du projet R.018400.002	Sheet/ D7	Revision no./ 1
--------------------------------------------------	---------------------	---------------------------

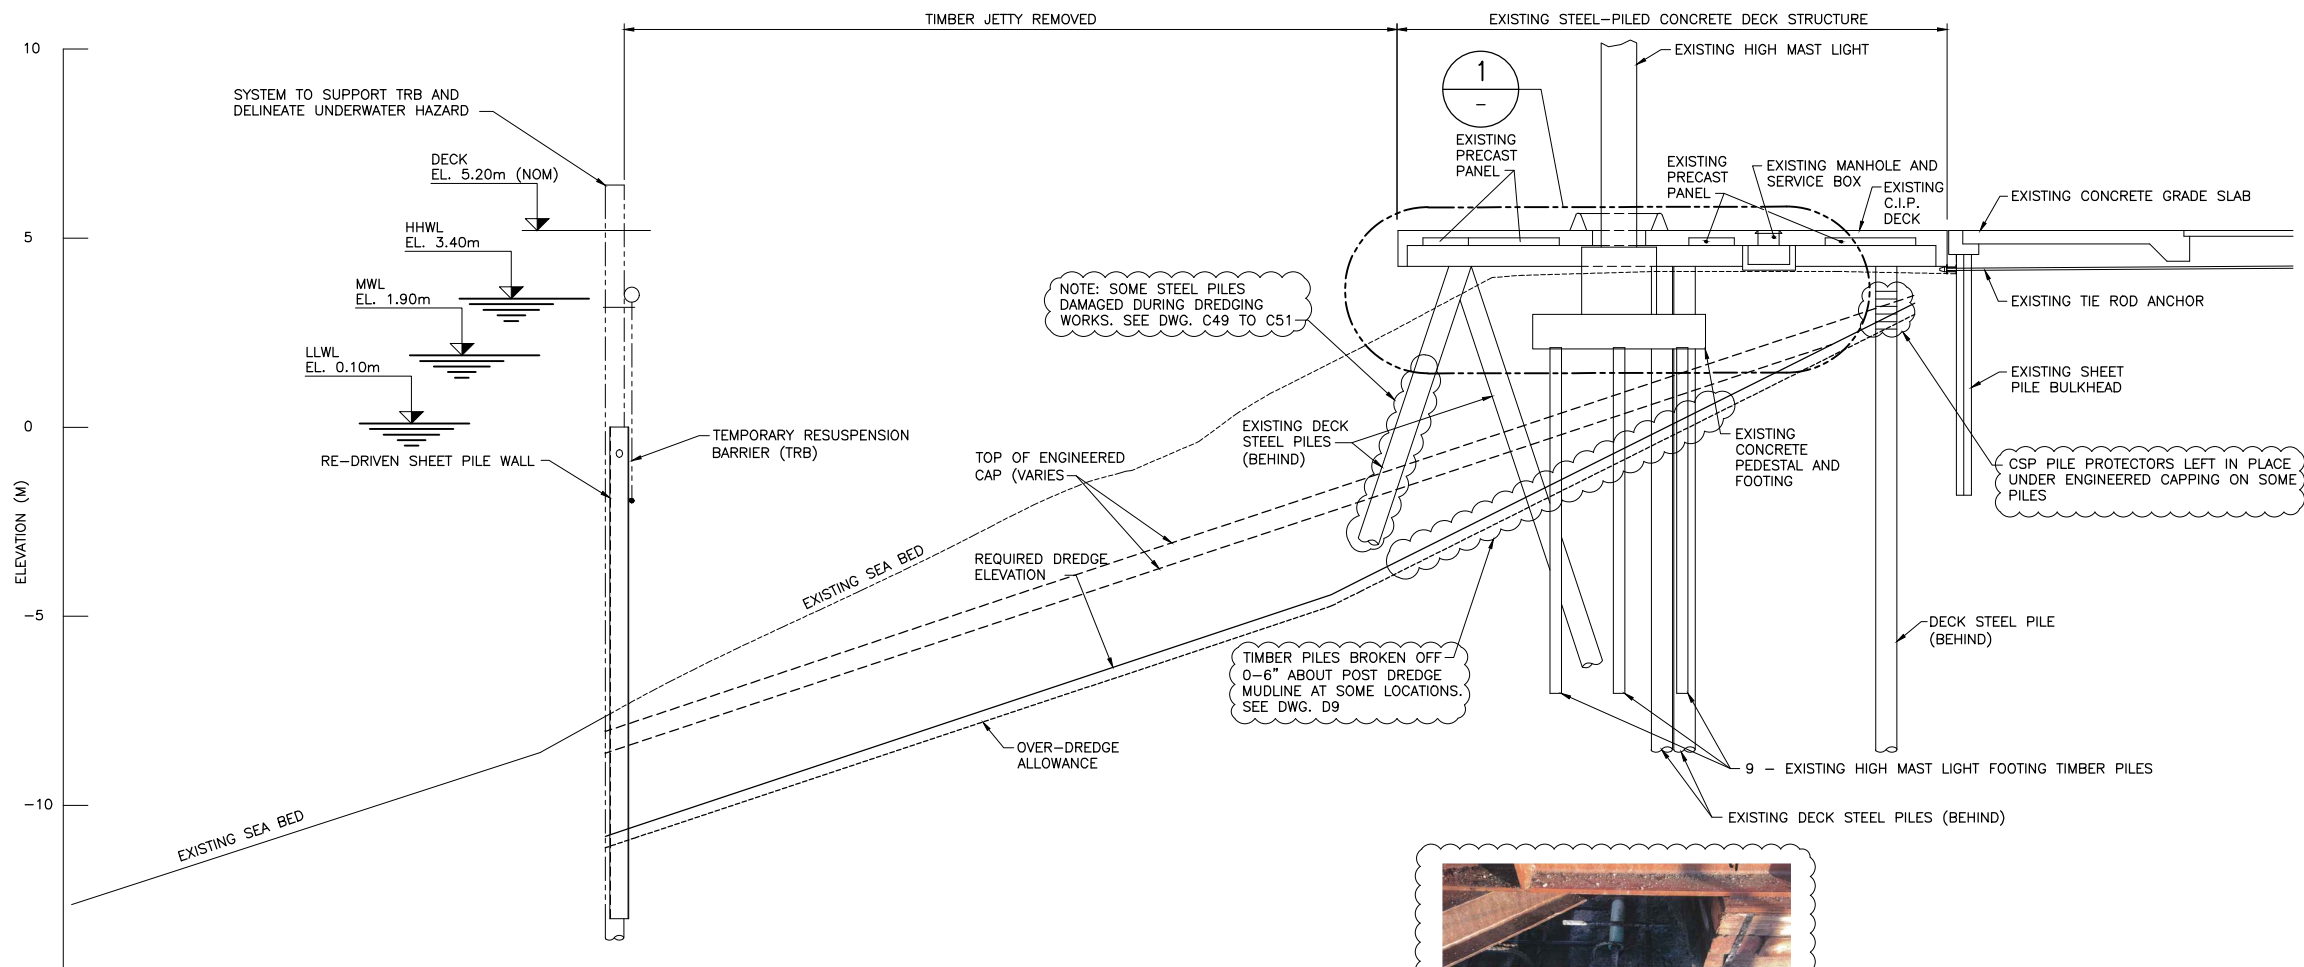

SECTION A
 SCALE 1: 100
 D7

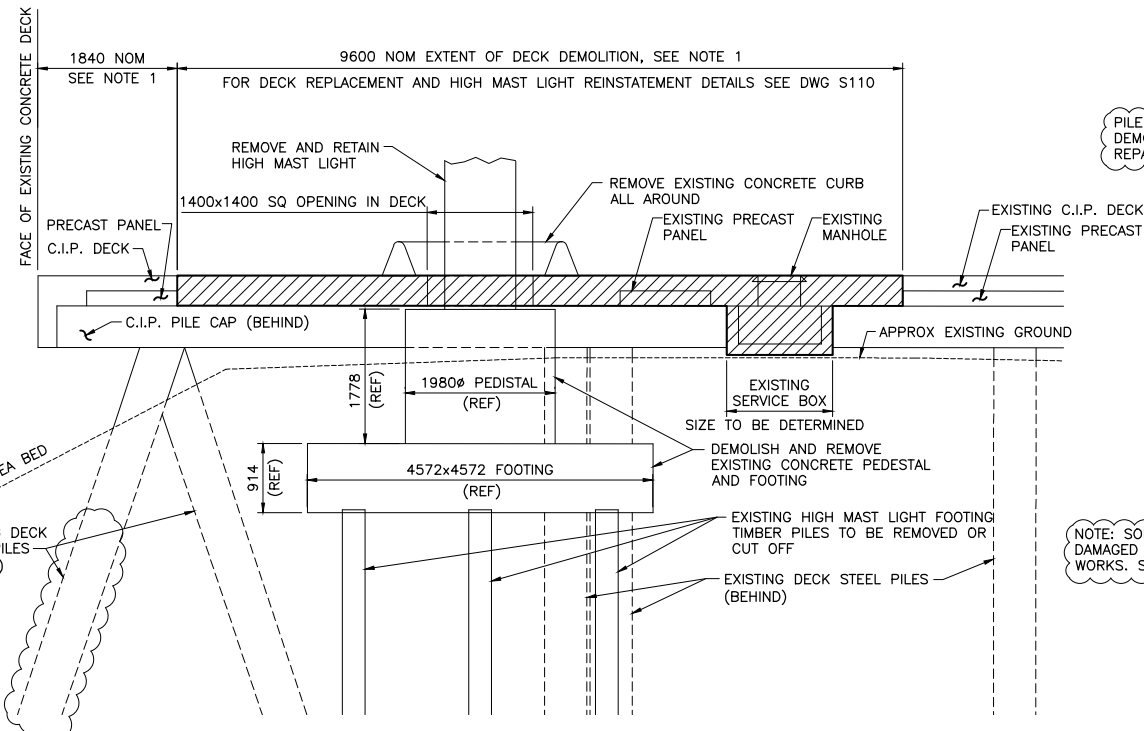

DETAIL 1
 SCALE 1: 50
 D7

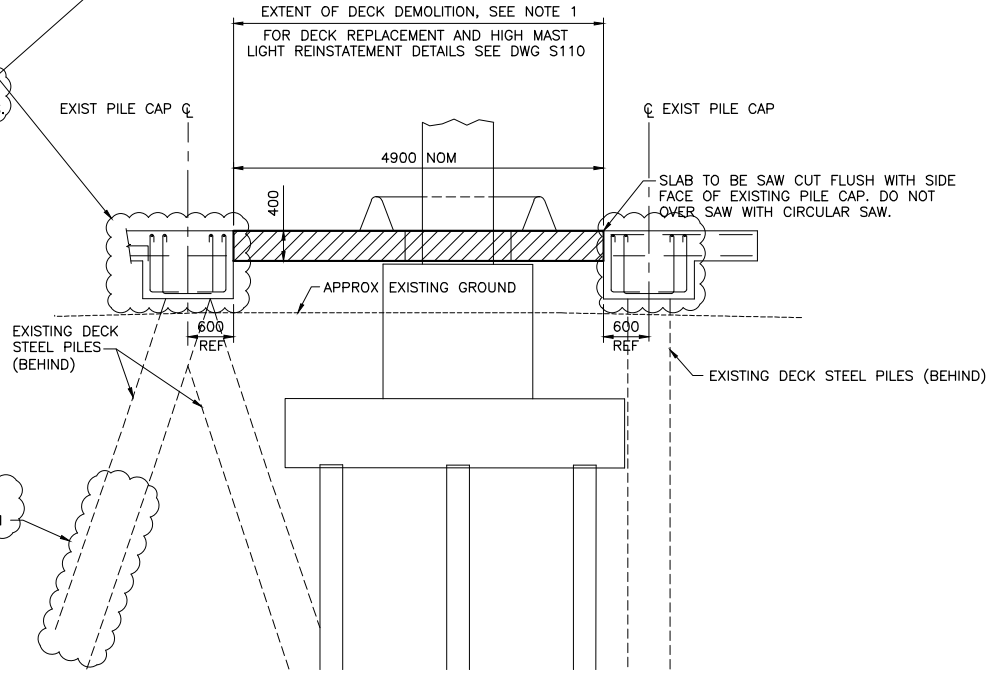

SECTION B
 SCALE 1: 50
 D7

NOTES:
 1. EXTENTS OF DEMOLITION AND REPLACEMENT DECK TO BE DETERMINED PRIOR TO CONSTRUCTION.

Revision/Revision	Description/Description	Date/Date
1	RECORD DRAWING	2017/03/29
0	ISSUED FOR TENDER	2014/12/19


Client/client
PUBLIC WORKS AND GOVERNMENT SERVICES CANADA

Project title/Titre du projet
ESQUIMALT GRAVING DOCK
 825 ADMIRALS ROAD, VICTORIA, BC
ESQUIMALT GRAVING DOCK WATERLOT PHASE 2
SOUTH JETTY UNDER-PIER SEDIMENT REMEDIATION


Consultant Signature Only
 Designed by/Concept par
GEOFF COOPER
 Drawn by/Dessiné par
ARNIE RIST
 PWGSC Project Manager/Administrateur de Projets TPSCG
ANDREW MYLLY
 Regional Manager, Environmental Services
COLLIN KINGMAN

Drawing title/Titre du dessin
EXISTING HIGH MAST LIGHT LIGHT AREA AND DEMOLITION SHEET 2


Project No./No. du projet	Sheet/	Revision no./
R.018400.002	D8	1

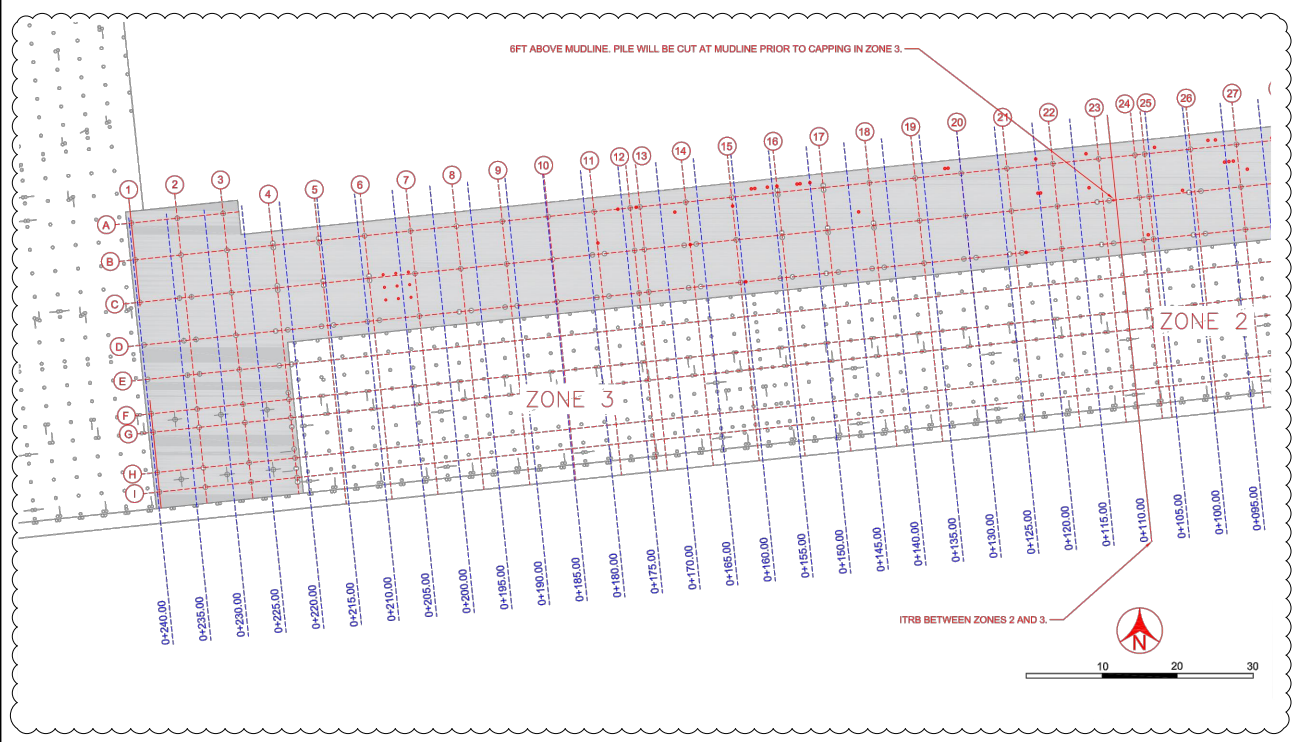


TIMBER CUT-OFF PILES AS-BUILT - SHEET 1

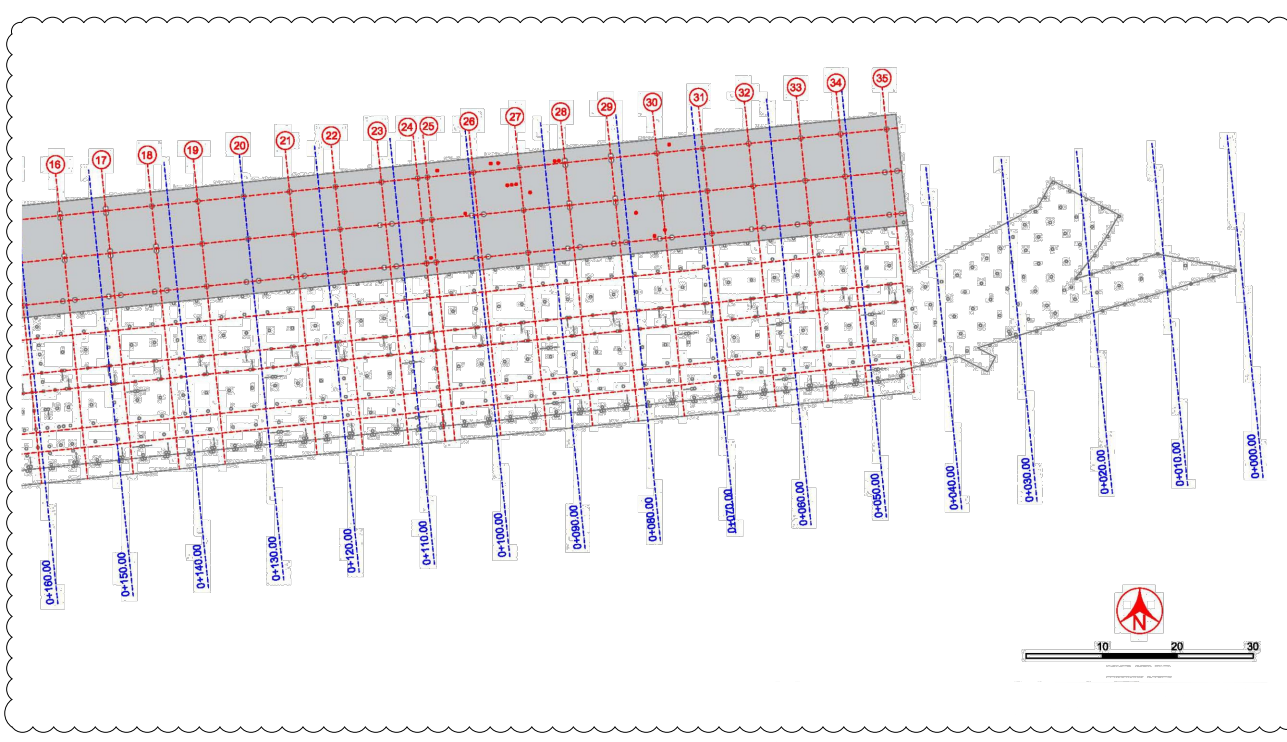

TIMBER CUT-OFF PILES AS-BUILT - SHEET 2

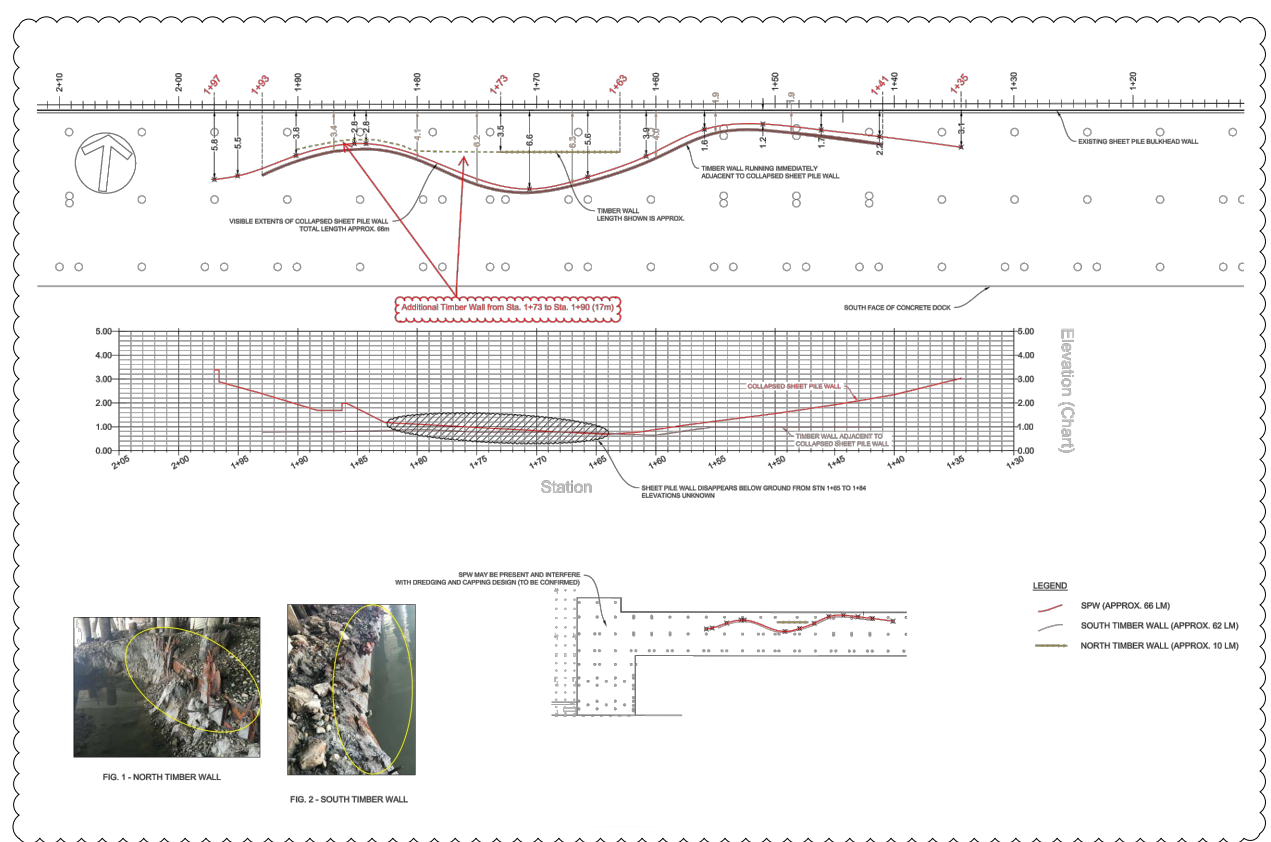

COLLAPSED SHEET PILE WALL AS-BUILT

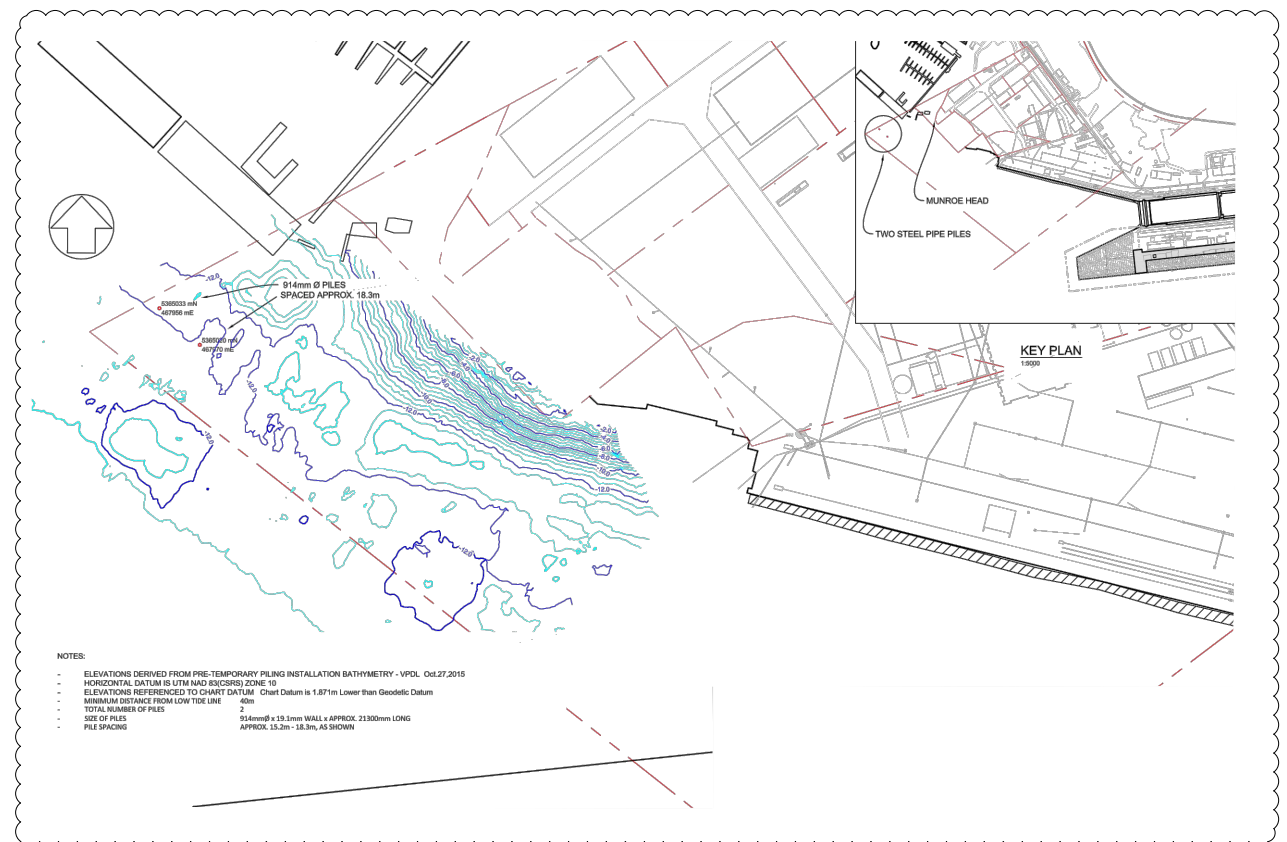

MUNROE HEAD MOORING PILE AS-BUILT

0	RECORD DRAWING	2017/03/29
---	----------------	------------

Revision/Description/Date/Date

Client/client
PUBLIC WORKS AND GOVERNMENT SERVICES CANADA

Project title/Titre du projet
**ESQUIMALT GRAVING DOCK
 825 ADMIRALS ROAD, VICTORIA, BC**

**ESQUIMALT GRAVING DOCK
 WATERLOT PHASE 2
 SOUTH JETTY UNDER-PIER
 SEDIMENT REMEDIATION**

Consultant Signature Only

Designed by/Concept par
 DANIEL LAWSON










Drawn by/Desainé par
 ALEXANDER SKEIC

PWGC Project Manager/Administrateur de Projets TPSGC
 ANDREW MYLLY

Regional Manager, Environmental Services
 COLLIN KINGMAN

Drawing title/Titre du dessin
**RECORD DRAWINGS
 VARIOUS**

Project No./No. du projet R.018400.002	Sheet/ D9	Revision no./ 0
-------------------------------------------	--------------	--------------------

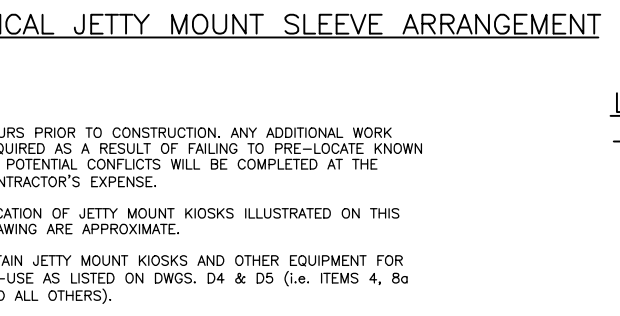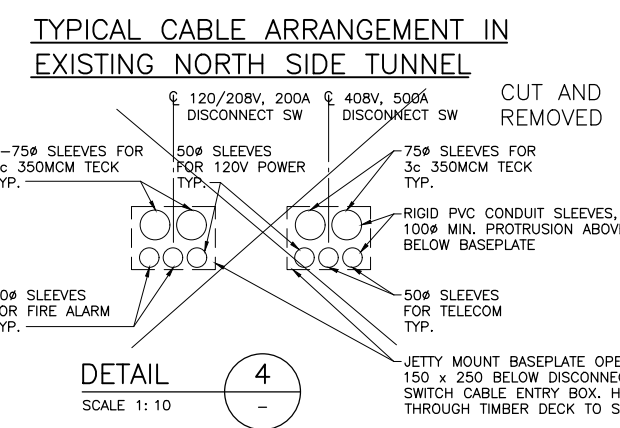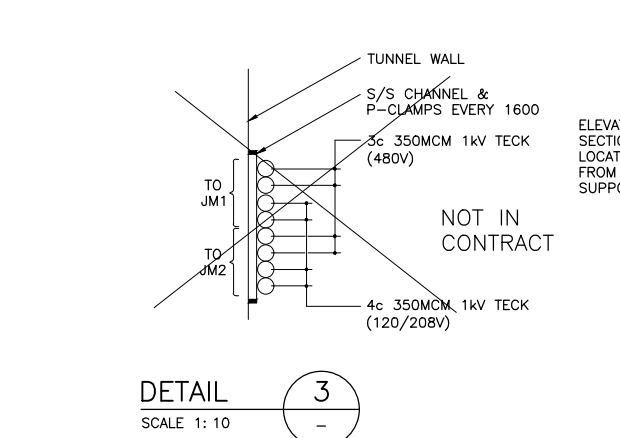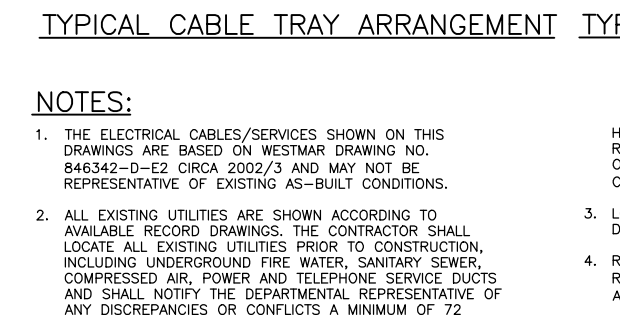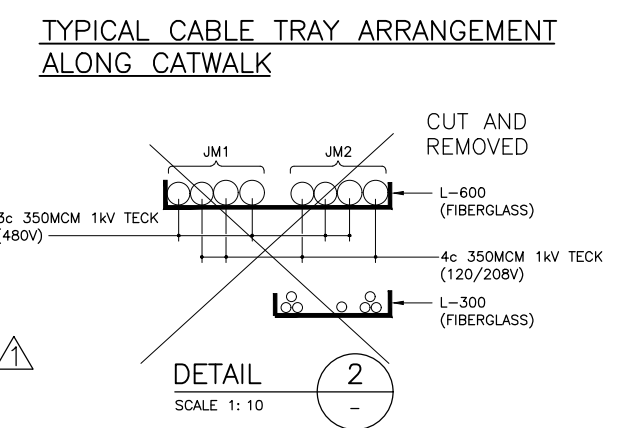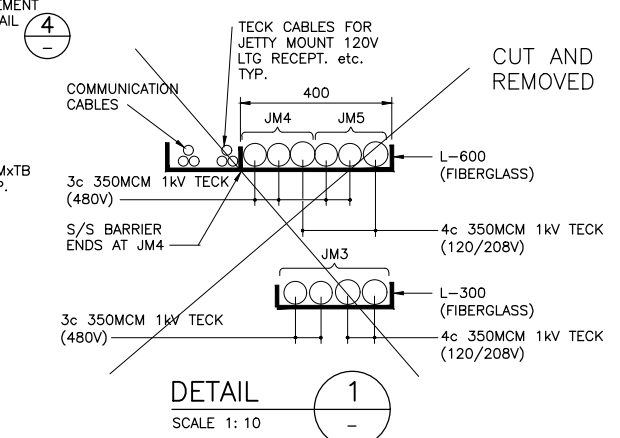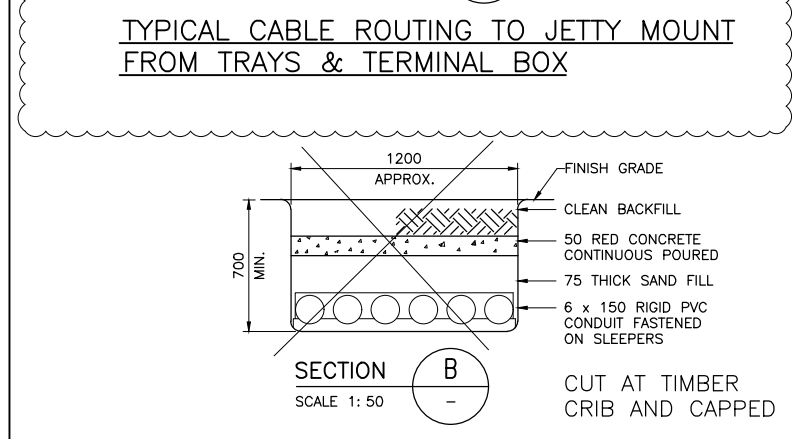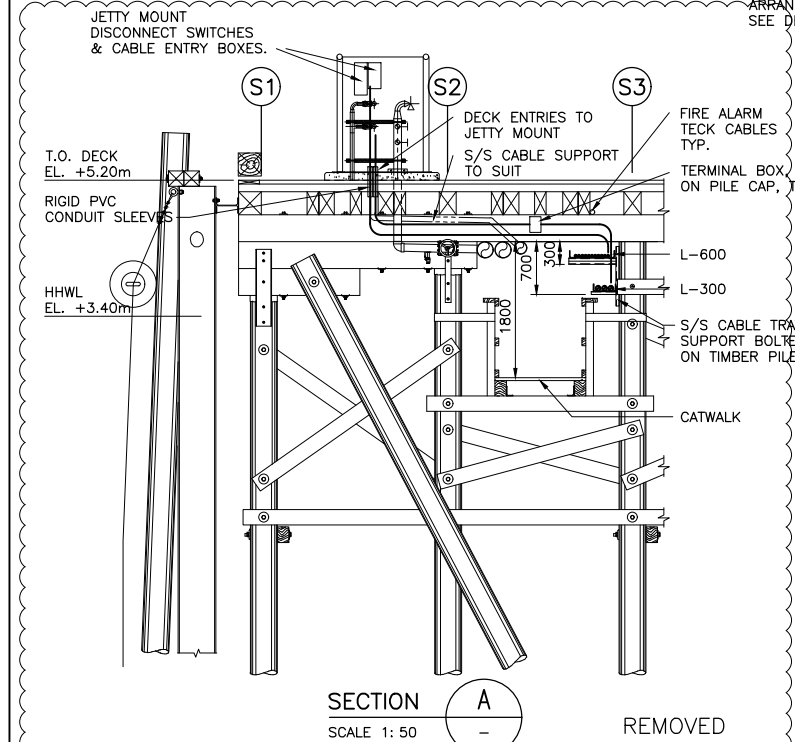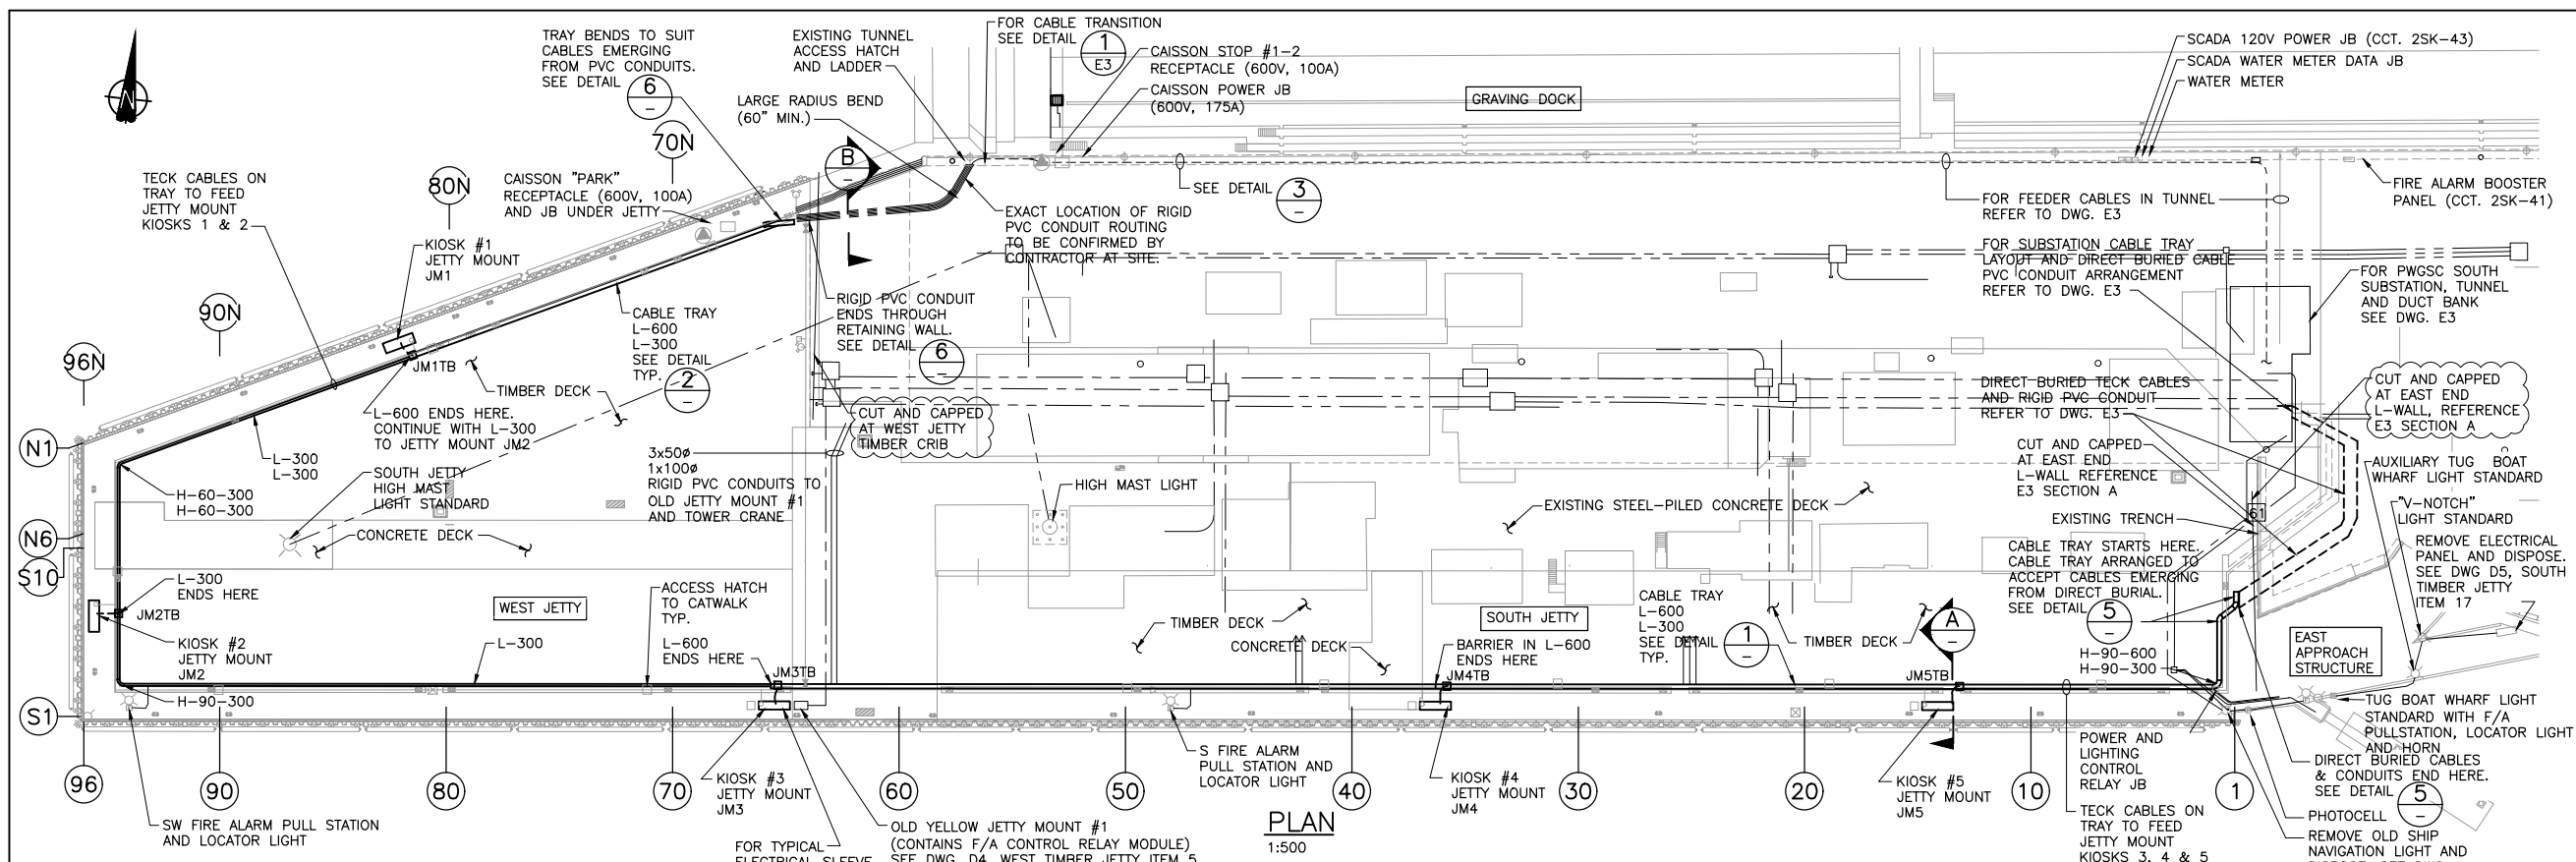

- NOTES:**
1. THE ELECTRICAL CABLES/SERVICES SHOWN ON THIS DRAWINGS ARE BASED ON WESTMAR DRAWING NO. 846342-D-E2 CIRCA 2002/3 AND MAY NOT BE REPRESENTATIVE OF EXISTING AS-BUILT CONDITIONS.
 2. ALL EXISTING UTILITIES ARE SHOWN ACCORDING TO AVAILABLE RECORD DRAWINGS. THE CONTRACTOR SHALL LOCATE ALL EXISTING UTILITIES PRIOR TO CONSTRUCTION, INCLUDING UNDERGROUND FIRE WATER, SANITARY SEWER, COMPRESSED AIR, POWER AND TELEPHONE SERVICE DUCTS AND SHALL NOTIFY THE DEPARTMENTAL REPRESENTATIVE OF ANY DISCREPANCIES OR CONFLICTS A MINIMUM OF 72 HOURS PRIOR TO CONSTRUCTION. ANY ADDITIONAL WORK REQUIRED AS A RESULT OF FAILING TO PRE-LOCATE KNOWN OR POTENTIAL CONFLICTS WILL BE COMPLETED AT THE CONTRACTOR'S EXPENSE.
 3. LOCATION OF JETTY MOUNT KIOSKS ILLUSTRATED ON THIS DRAWING ARE APPROXIMATE.
 4. RETAIN JETTY MOUNT KIOSKS AND OTHER EQUIPMENT FOR RE-USE AS LISTED ON DWGS. D4 & D5 (i.e. ITEMS 4, 8a AND ALL OTHERS).

- LEGEND**
- E---X--- ELECTRICAL CABLE / PULL BOX
 - ⊕ DUPLEX RECEPTACLE
 - ⊙ SPECIAL PURPOSE RECEPTACLE
 - ⊗ FIRE ALARM PULL STATION / LOCATOR LIGHT
 - ⊠ FIRE ALARM HORN
 - ⊙ PHOTOCCELL
 - ⊗ LIGHT STANDARD

Revision/	Description/Description	Date/Date
1	RECORD DRAWING	2017/03/28
0	ISSUED FOR TENDER	2014/12/14

PUBLIC WORKS AND GOVERNMENT SERVICES CANADA

Project title/Titre du projet
ESQUIMALT GRAVING DOCK
 825 ADMIRALS ROAD, VICTORIA, BC

ESQUIMALT GRAVING DOCK WATERLOT PHASE 2 SOUTH JETTY UNDER-PIER SEDIMENT REMEDIATION

Consultant Signature Only

Designed by/Concept par
 ALISON MANSFIELD / ROB JONES


Drawn by/Desainé par
 GABE MENDES

PWGS Project Manager/Administrateur de Projets TPSGC
 ANDREW MYLLY


Regional Manager, Environmental Services
 COLLIN KINGMAN

Drawing title/Titre du dessin
EXISTING SERVICES CABLE TRAY LAYOUT PLAN, SECTIONS AND DETAILS


Project No./No. du projet	Sheet/	Revision no./
R.018400.002	E1	1

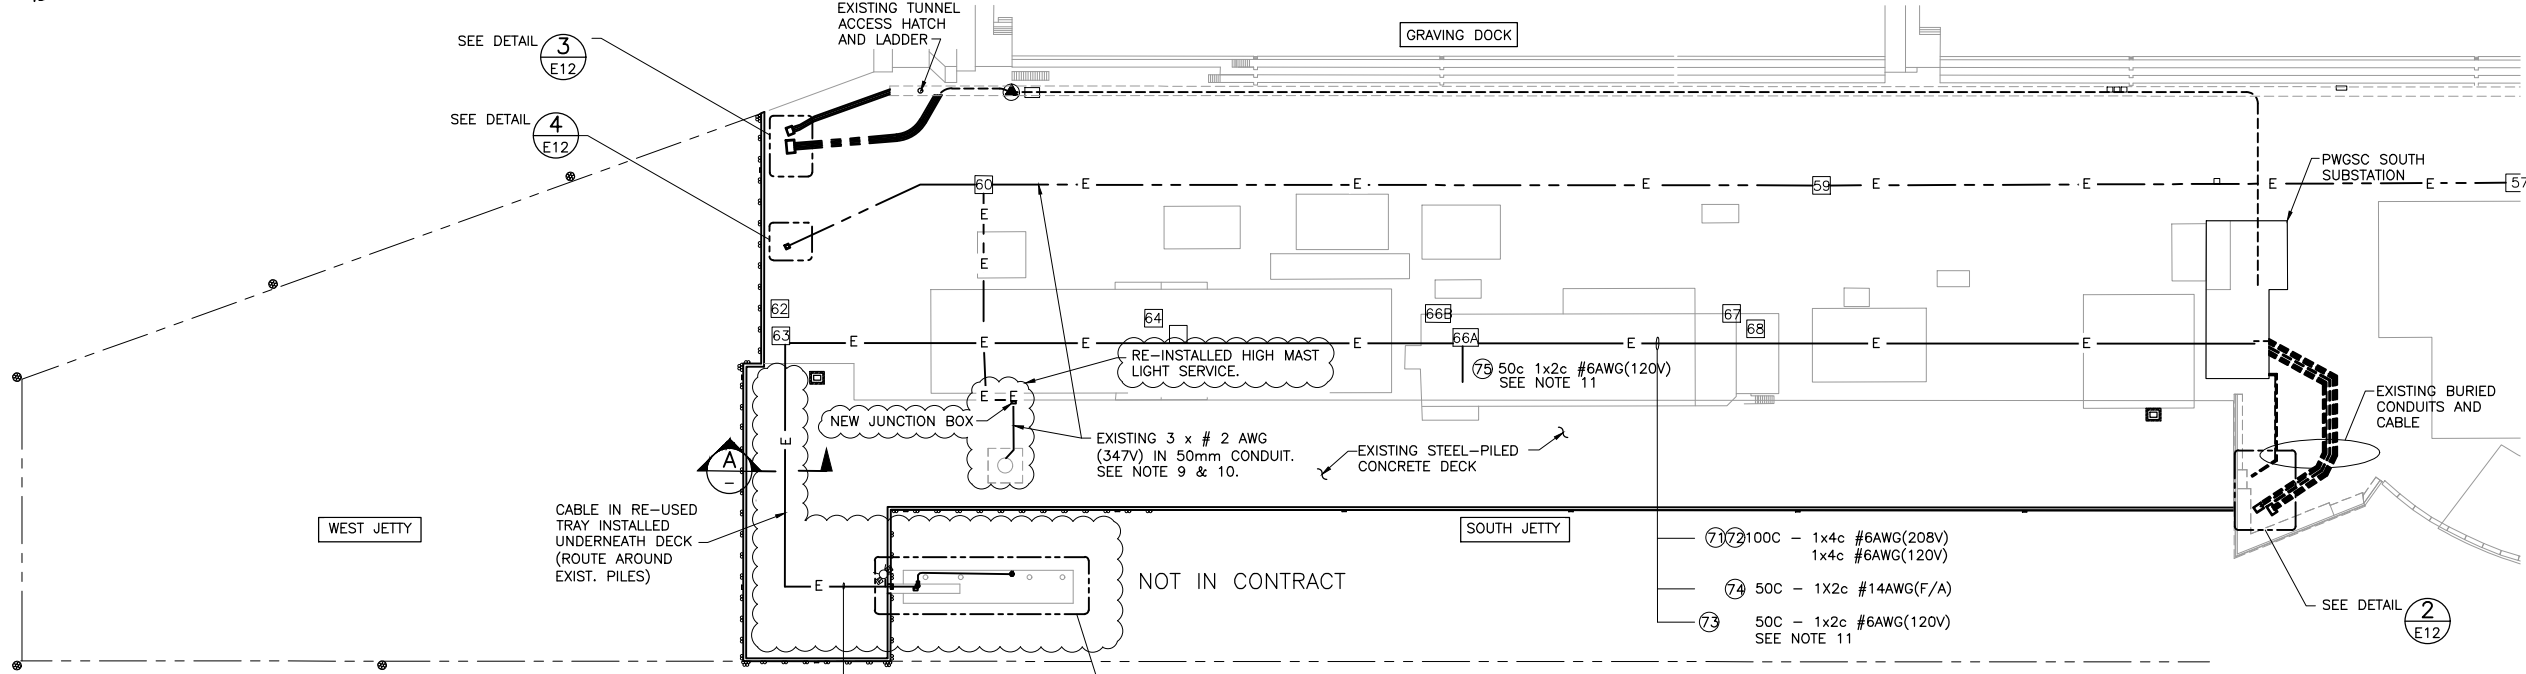

PLAN
SCALE 1:500

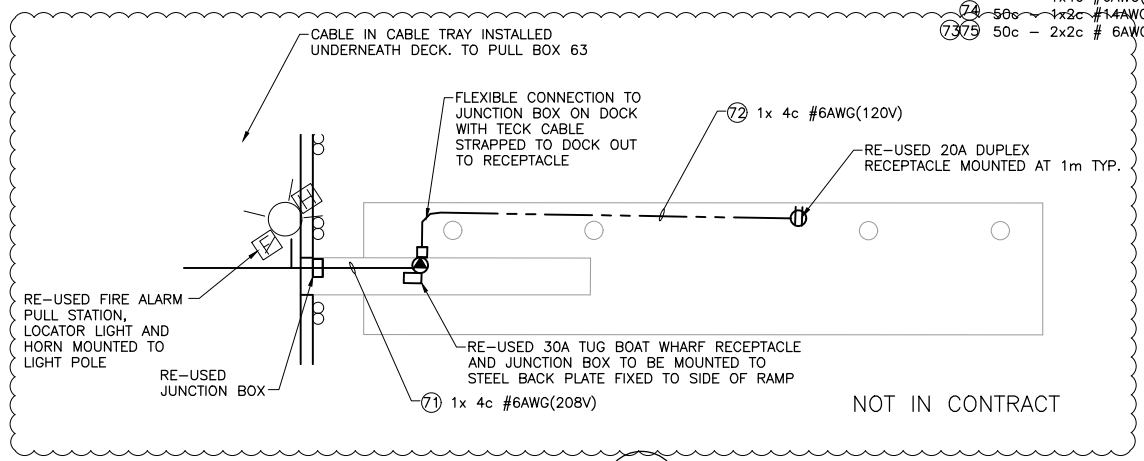

DETAIL 1
SCALE 1:125

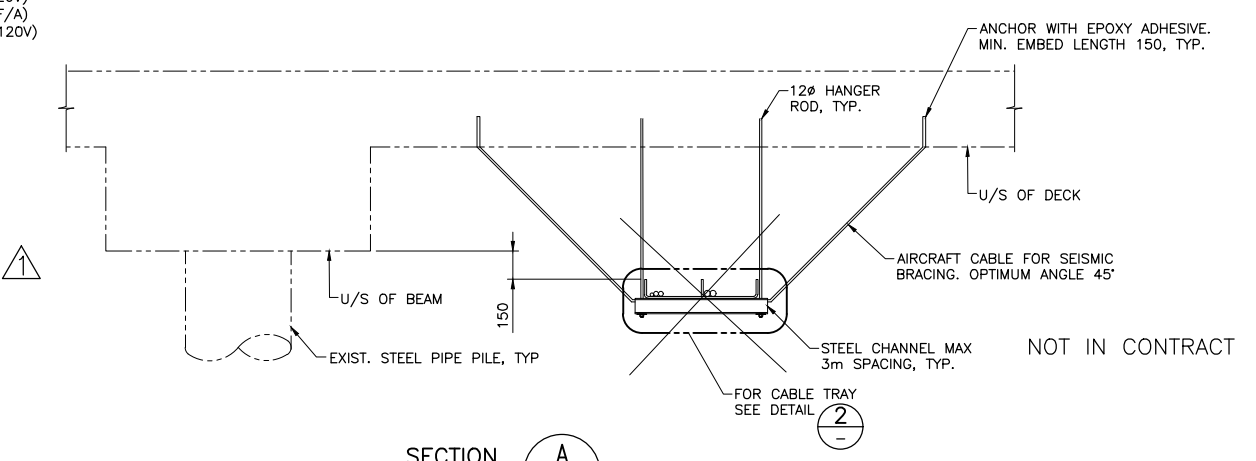

SECTION A
SCALE 1:20


NOTES:

- ALL EXISTING UTILITIES ARE SHOWN ACCORDING TO AVAILABLE RECORD DRAWINGS. THE CONTRACTOR SHALL LOCATE ALL EXISTING UTILITIES PRIOR TO CONSTRUCTION, INCLUDING UNDERGROUND FIRE WATER, SANITARY SEWER, COMPRESSED AIR, POWER AND TELEPHONE SERVICE DUCTS AND SHALL NOTIFY THE DEPARTMENTAL REPRESENTATIVE OF ANY DISCREPANCIES OR CONFLICTS A MINIMUM OF 72 HOURS PRIOR TO CONSTRUCTION. ANY ADDITIONAL WORK REQUIRED AS A RESULT OF FAILING TO PRE-LOCATE KNOWN OR POTENTIAL CONFLICTS WILL BE COMPLETED AT THE CONTRACTOR'S EXPENSE.
- ALL ELECTRICAL INSTALLATIONS SHALL BE PER THE LATEST EDITION OF THE CANADIAN ELECTRICAL CODE.
- FOR MODIFIED CABLE I.D. TAG NUMBER, REFER TO CABLE SCHEDULE ON DWG. E10.
- RE-USE EXISTING TUG BOAT WHARF RECEPTACLES, DISTRIBUTION, LIGHTING, FIRE ALARM STATION, HORN AND OTHER EQUIPMENT. RE-INSTALL TO MATCH EXISTING.
- ALL ELECTRICAL EQUIPMENT TO BE NEMA 4X SUITABLE FOR A MARINE ENVIRONMENT.
- ALL STEEL BRACKETS, SUPPORTS THREADED ROD, ETC. TO BE HOT DIPPED GALVANIZED AFTER FABRICATION UNLESS NOTED OTHERWISE.
- ELECTRICAL EQUIPMENT TO BE SECURED WITH STAINLESS STEEL THREADED ROD ANCHOR BOLTS IN EPOXY ADHESIVE, QUANTITY AND SIZE AS FOLLOWS:

ELECTRICAL EQUIPMENT	No. x DIA.	HOLE DIA.	MIN. DEPTH
CABLE TRAY & SUPPORTS	4 x 12	14	150
WALL CABINETS & EQUIPMENT	4 x 12	14	150
- CONTRACTOR TO DE-ENERGIZE WIRES BY OPENING AND LOCKING OUT CORRESPONDING HIGH MAST LIGHT BREAKER AT SUBSTATION 1 PRIOR TO DISCONNECTING WIRES FROM HIGH MAST. CONTRACTOR TO PULL BACK WIRE TO PULL BOX 60 AND PROPERLY STORE UNTIL THE CABLE IS RE-INSTALLED. THE 2 - 50mmØ CONDUITS TO BE CUT BACK SO NEW HIGH MAST LIGHT FOOTING CAN BE CONSTRUCTED (SEE DRAWING D7). AFTER FOOTING CONSTRUCTED, RE-INSTALL THE 2 - 50mmØ CONDUITS (1 - SPARE) AND RE-CONNECT THE WIRES AND MAKE HIGH MAST LIGHT FUNCTIONAL.
- CONTRACTOR TO CONFIRM SPARE CONDUIT FOR TUG BOAT WHARF CABLES. CONTRACTOR SHALL CONSULT DEPARTMENTAL REPRESENTATIVE BEFORE PULLING INACTIVE CABLE IN ORDER TO MEET CONDUIT REQUIREMENT.

LEGEND

- E --- EXISTING ELECTRICAL CABLE
- E — ELECTRICAL CABLE
- ⊗ PULL BOX
- ⊕ DUPLEX RECEPTACLE
- ⊙ SPECIAL PURPOSE RECEPTACLE
- ⊗ FIRE ALARM PULL STATION AND LOCATOR LIGHT
- ⊕ FIRE ALARM HORN

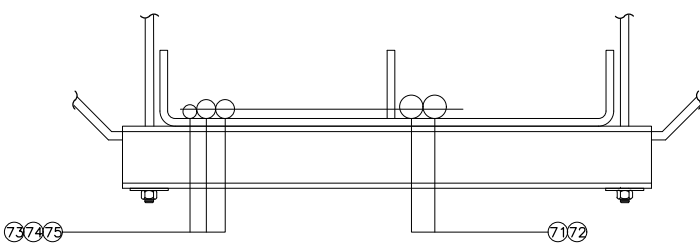

DETAIL 2
SCALE 1:5

NOT IN CONTRACT

1	RECORD DRAWING	2017/03/28
0	ISSUED FOR TENDER	2014/12/14
Revision/	Description/Description	Date/Date
Client/client		
PUBLIC WORKS AND GOVERNMENT SERVICES CANADA		
Project title/Titre du projet ESQUIMALT GRAVING DOCK 825 ADMIRALS ROAD, VICTORIA, BC		
ESQUIMALT GRAVING DOCK WATERLOT PHASE 2 SOUTH JETTY UNDER-PIER SEDIMENT REMEDIATION		
Consultant Signature Only		
Designed by/Concept par ALISON MANSFIELD / ROB JONES		
Drawn by/Desainé par GABE MENDES		
PWGSC Project Manager/Administrateur de Projets TPSGC ANDREW MYLLY		
Regional Manager, Environmental Services COLLIN KINGMAN		
Drawing title/Titre du dessin SERVICES CABLE TRAY AND CABLES LAYOUT PLAN		
Project No./No. du projet R.018400.002	Sheet/ E4	Revision no./ 1



EXISTING CABLE SCHEDULE

I.D. TAG	CABLE I.D. NUMBER	CABLE SIZE	CABLE TYPE	SERVICE DESCRIPTION	ORIGIN	DESTINATION	ROUTING
1	4SS271-JM1/1	3c 350 MCM	TECK 90	480V, FEEDER	SOUTH SUB BREAKER 4SS2-71	JETTY MOUNT JM1 - 500A DS	NORTH TUNNEL
2	4SS271-JM1/2	3c 350 MCM	TECK 90	480V, FEEDER	SOUTH SUB BREAKER 4SS2-71	JETTY MOUNT JM1 - 500A DS	NORTH TUNNEL
3	2SS261-JM1/1	4c 350 MCM	TECK 90	120/208V, FEEDER	SOUTH SUB BREAKER 2SS2-61	JETTY MOUNT JM1 - 200A DS	NORTH TUNNEL
4	2SS261-JM1/2	4c 350 MCM	TECK 90	120/208V, FEEDER	SOUTH SUB BREAKER 2SS2-61	JETTY MOUNT JM1 - 200A DS	NORTH TUNNEL
5	4SS272-JM2/1	3c 350 MCM	TECK 90	480V, FEEDER	SOUTH SUB BREAKER 4SS2-72	JETTY MOUNT JM2 - 500A DS	NORTH TUNNEL
6	4SS272-JM2/2	3c 350 MCM	TECK 90	480V, FEEDER	SOUTH SUB BREAKER 4SS2-72	JETTY MOUNT JM2 - 500A DS	NORTH TUNNEL
7	2SS262-JM2/1	4c 350 MCM	TECK 90	120/208V, FEEDER	SOUTH SUB BREAKER 2SS2-62	JETTY MOUNT JM2 - 200A DS	NORTH TUNNEL
8	2SS262-JM2/2	4c 350 MCM	TECK 90	120/208V, FEEDER	SOUTH SUB BREAKER 2SS2-62	JETTY MOUNT JM2 - 200A DS	NORTH TUNNEL
9	4SS273-JM3/1	3c 350 MCM	TECK 90	480V, FEEDER	SOUTH SUB BREAKER 4SS2-73	JETTY MOUNT JM3 - 500A DS	SOUTH JETTY
10	4SS273-JM3/2	3c 350 MCM	TECK 90	480V, FEEDER	SOUTH SUB BREAKER 4SS2-73	JETTY MOUNT JM3 - 500A DS	SOUTH JETTY
11	2SS263-JM3/1	4c 350 MCM	TECK 90	120/208V, FEEDER	SOUTH SUB BREAKER 2SS2-63	JETTY MOUNT JM3 - 200A DS	SOUTH JETTY
12	2SS263-JM3/2	4c 350 MCM	TECK 90	120/208V, FEEDER	SOUTH SUB BREAKER 2SS2-63	JETTY MOUNT JM3 - 200A DS	SOUTH JETTY
13	4SS274-JM4/1	3c 350 MCM	TECK 90	480V, FEEDER	SOUTH SUB BREAKER 4SS2-74	JETTY MOUNT JM4 - 500A DS	SOUTH JETTY
14	4SS274-JM4/2	3c 350 MCM	TECK 90	480V, FEEDER	SOUTH SUB BREAKER 4SS2-74	JETTY MOUNT JM4 - 500A DS	SOUTH JETTY
15	2SS264-JM4	4c 350 MCM	TECK 90	120/208V, FEEDER	SOUTH SUB BREAKER 2SS2-64	JETTY MOUNT JM4 - 200A DS	SOUTH JETTY
16	4SS275-JM5/1	3c 350 MCM	TECK 90	480V, FEEDER	SOUTH SUB BREAKER 4SS2-75	JETTY MOUNT JM5 - 500A DS	SOUTH JETTY
17	4SS275-JM5/2	3c 350 MCM	TECK 90	480V, FEEDER	SOUTH SUB BREAKER 4SS2-75	JETTY MOUNT JM5 - 500A DS	SOUTH JETTY
18	2SS265-JM5	4c 350 MCM	TECK 90	120/208V, FEEDER	SOUTH SUB BREAKER 2SS2-65	JETTY MOUNT JM5 - 200A DS	SOUTH JETTY
19	NOT USED						
20	2SS2JB-JM5TB/1	2c #1 AWG	TECK 90	120V, 15A FEEDER	SOUTH SUB BREAKER 2SS2JB	TERMINAL BOX #JM5TB	SOUTH JETTY
21	JM5TB-JM4TB/1	2c #1 AWG	TECK 90	120V	TERMINAL BOX #JM5TB	TERMINAL BOX #JM4TB	SOUTH JETTY
22	JM4TB-JM3TB/1	2c #1 AWG	TECK 90	120V	TERMINAL BOX #JM4TB	TERMINAL BOX #JM3TB	SOUTH JETTY
23	JM3TB-JM2TB/1	2c #1 AWG	TECK 90	120V	TERMINAL BOX #JM3TB	TERMINAL BOX #JM2TB	SOUTH JETTY
24	JM2TB-JM1TB/1	2c #1 AWG	TECK 90	120V	TERMINAL BOX #JM2TB	TERMINAL BOX #JM1TB	SOUTH JETTY
25	2SS2-JM5TB/2	2c #8 AWG	TECK 90	120V, 15A FEEDER	SOUTH SUB BREAKER 2SS2	TERMINAL BOX #JM5TB	SOUTH JETTY
26	JM5TB-JM4TB/2	2c #8 AWG	TECK 90	120V	TERMINAL BOX #JM5TB	TERMINAL BOX #JM4TB	SOUTH JETTY
27	JM4TB-JM3TB/2	2c #8 AWG	TECK 90	120V	TERMINAL BOX #JM4TB	TERMINAL BOX #JM3TB	SOUTH JETTY
28	JM3TB-JM2TB/2	2c #8 AWG	TECK 90	120V	TERMINAL BOX #JM3TB	TERMINAL BOX #JM2TB	SOUTH JETTY
29	JM2TB-JM1TB/2	2c #8 AWG	TECK 90	120V	TERMINAL BOX #JM2TB	TERMINAL BOX #JM1TB	SOUTH JETTY
30	2SKCCT42-JM5TB	2c #8 AWG	TECK 90	120V, 15A FEEDER	SOUTH SUB PANEL 2SK, CCT.42	TERMINAL BOX #JM5TB	SOUTH JETTY
31	JM5TB-JM4TB/3	2c #8 AWG	TECK 90	120V	TERMINAL BOX #JM5TB	TERMINAL BOX #JM4TB	SOUTH JETTY
32	JM4TB-JM3TB/3	2c #8 AWG	TECK 90	120V	TERMINAL BOX #JM4TB	TERMINAL BOX #JM3TB	SOUTH JETTY
33	JM3TB-JM2TB/3	2c #8 AWG	TECK 90	120V	TERMINAL BOX #JM3TB	TERMINAL BOX #JM2TB	SOUTH JETTY
34	JM2TB-JM1TB/3	2c #8 AWG	TECK 90	120V	TERMINAL BOX #JM2TB	TERMINAL BOX #JM1TB	SOUTH JETTY
35	JM5TB-JM5/1	4c #12 AWG	TECK 90	120V	TERMINAL BOX #JM5TB	JB FOR LIGHT & RECEP. IN JM5	SOUTH JETTY
36	JM5TB-JM5/2	2c #12 AWG	TECK 90	120V	TERMINAL BOX #JM5TB	F/A 120V TERMINALS IN JM5	SOUTH JETTY
37	JM4TB-JM4/1	4c #12 AWG	TECK 90	120V	TERMINAL BOX #JM4TB	JB FOR LIGHT & RECEP. IN JM4	SOUTH JETTY
38	JM4TB-JM4/2	2c #12 AWG	TECK 90	120V	TERMINAL BOX #JM4TB	F/A 120V TERMINALS IN JM4	SOUTH JETTY
39	JM3TB-JM3/1	4c #12 AWG	TECK 90	120V	TERMINAL BOX #JM3TB	JB FOR LIGHT & RECEP. IN JM3	SOUTH JETTY
40	JM3TB-JM3/2	2c #12 AWG	TECK 90	120V	TERMINAL BOX #JM3TB	F/A 120V TERMINALS IN JM3	SOUTH JETTY
41	JM2TB-JM2/1	4c #12 AWG	TECK 90	120V	TERMINAL BOX #JM2TB	JB FOR LIGHT & RECEP. IN JM2	SOUTH JETTY
42	JM2TB-JM2/2	2c #12 AWG	TECK 90	120V	TERMINAL BOX #JM2TB	F/A 120V TERMINALS IN JM2	SOUTH JETTY
43	JM1TB-JM1/1	4c #12 AWG	TECK 90	120V	TERMINAL BOX #JM1TB	JB FOR LIGHT & RECEP. IN JM1	SOUTH JETTY
44	JM1TB-JM1/2	2c #12 AWG	TECK 90	120V	TERMINAL BOX #JM1TB	F/A 120V TERMINALS IN JM1	SOUTH JETTY
45	F/A BOX-JM5	2c #14 AWG	TECK 90	FIRE ALARM	SIGA-IM F/A BOX @ SOUTH SUB	JETTY MOUNT 5 FIRE ALARM SYSTEM	SOUTH JETTY
46	JM5-JM4/FA	2c #14 AWG	TECK 90	FIRE ALARM	JETTY MOUNT 5 FIRE ALARM SYSTEM	JETTY MOUNT 4 FIRE ALARM SYSTEM	SOUTH JETTY
47	JM4-JM3/FA	2c #14 AWG	TECK 90	FIRE ALARM	JETTY MOUNT 4 FIRE ALARM SYSTEM	JETTY MOUNT 3 FIRE ALARM SYSTEM	SOUTH JETTY
48	JM3-JM2/FA	2c #14 AWG	TECK 90	FIRE ALARM	JETTY MOUNT 3 FIRE ALARM SYSTEM	JETTY MOUNT 2 FIRE ALARM SYSTEM	SOUTH JETTY
49	JM2-JM1/FA	2c #14 AWG	TECK 90	FIRE ALARM	JETTY MOUNT 2 FIRE ALARM SYSTEM	JETTY MOUNT 1 FIRE ALARM SYSTEM	SOUTH JETTY
50	NOT USED						
51	TEL BOX-JM5	12pr #24 AWG	TEL	TELEPHONE	TELEPHONE BOX @ SOUTH SUB	JETTY MOUNT 5 TELEPHONE TB	SOUTH JETTY
52	TEL BOX-JM4	12pr #24 AWG	TEL	TELEPHONE	TELEPHONE BOX @ SOUTH SUB	JETTY MOUNT 4 TELEPHONE TB	SOUTH JETTY
53	TEL BOX-JM3	12pr #24 AWG	TEL	TELEPHONE	TELEPHONE BOX @ SOUTH SUB	JETTY MOUNT 3 TELEPHONE TB	SOUTH JETTY
54	TEL BOX-JM2	12pr #24 AWG	TEL	TELEPHONE	TELEPHONE BOX @ SOUTH SUB	JETTY MOUNT 2 TELEPHONE TB	SOUTH JETTY
55	TEL BOX-JM1	12pr #24 AWG	TEL	TELEPHONE	TELEPHONE BOX @ SOUTH SUB	JETTY MOUNT 1 TELEPHONE TB	SOUTH JETTY
56	SCADA BOX-JM5-0400E1	2pr #18 AWG	STP RS485 AIA JKT	SCADA	SCADA PANEL @ SOUTH WATER METER JB	JETTY MOUNT 5 SCADA WATER METER JB	SOUTH JETTY
57	JM5-JM4/SCADA-0400E2	2pr #18 AWG	STP RS485 AIA JKT	SCADA	JETTY MOUNT 5 SCADA WATER METER JB	JETTY MOUNT 4 SCADA WATER METER JB	SOUTH JETTY
58	JM4-JM3/SCADA-0400E3	2pr #18 AWG	STP RS485 AIA JKT	SCADA	JETTY MOUNT 4 SCADA WATER METER JB	JETTY MOUNT 3 SCADA WATER METER JB	SOUTH JETTY
59	JM3-JM2/SCADA-0400E4	2pr #18 AWG	STP RS485 AIA JKT	SCADA	JETTY MOUNT 3 SCADA WATER METER JB	JETTY MOUNT 2 SCADA WATER METER JB	SOUTH JETTY
60	JM2-JM1/SCADA-0400E5	2pr #18 AWG	STP RS485 AIA JKT	SCADA	JETTY MOUNT 2 SCADA WATER METER JB	JETTY MOUNT 1 SCADA WATER METER JB	SOUTH JETTY
61	JM1-DRYDOCK SPARE	2pr #18 AWG	STP RS485 AIA JKT	SCADA	JETTY MOUNT 1 SCADA WATER METER JB	SERVICE TUNNEL SCADA WATER METER JB	NORTH TUNNEL
62	2SKCCT43-JM5 120V	2c #12 AWG	TECK 90	120V	SOUTH SUB PANEL 2SK, CCT. 43	JM5 120V 2SK-43 JB	SOUTH JETTY
63	JM5-JM4 120V 2SK-43	2c #12 AWG	TECK 90	120V	JM5 120V 2SK-43 JB	JM4 120V 2SK-43 JB	SOUTH JETTY
64	JM4-JM3 120V 2SK-43	2c #12 AWG	TECK 90	120V	JM4 120V 2SK-43 JB	JM3 120V 2SK-43 JB	SOUTH JETTY
65	JM3-JM2 120V 2SK-43	2c #12 AWG	TECK 90	120V	JM3 120V 2SK-43 JB	JM2 120V 2SK-43 JB	SOUTH JETTY
66	JM2-JM1 120V 2SK-43	2c #12 AWG	TECK 90	120V	JM2 120V 2SK-43 JB	JM1 120V 2SK-43 JB	SOUTH JETTY
67	JM1-TUNNEL 120V 2SK-43	2c #12 AWG	TECK 90	120V	JM1 120V 2SK-43 JB	SERVICE TUNNEL 2SK-43 JB	NORTH TUNNEL
68	TOWER CRANE CAMERA	4pr #24 AWG	UTP CAT5e	CCTV	SOUTH SUBSTATION (UNKNOWN)	SOUTH JETTY TOWER CRANE	SOUTH JETTY
69	TOWER CRANE CAMERA	4pr #24 AWG	UTP CAT5e	CCTV	SOUTH SUBSTATION (UNKNOWN)	SOUTH JETTY TOWER CRANE	SOUTH JETTY
70	NOT USED						
71	NOT USED						
88	CAISSON 1/2JB-PARKJM1	3c #2 AWG	TECK 90	600V	CAISSON 1/2 JB IN SERVICE TUNNEL	CAISSON PARK JETTY MOUNT 1	NORTH TUNNEL
89	6SHCCT26-SJ HIGH MAST	3c #1 AWG	RW90/TECK 90	347V	MAIN SUB PANEL 6SH CCT. 26	SOUTH JETTY HIGH MAST LIGHT	EXISTING DUCT BANK
90	NOT USED						
91	2SKCCT18/20-TUG1	4c #8 AWG	TECK 90	208V	SOUTH SUB PANEL 2SK, CCT. 18/20	TUG WHARF RECEPTACLE 30A	SOUTH JETTY
92	2SKCCT22/24-TUG2	4c #8 AWG	TECK 90	208V	SOUTH SUB PANEL 2SK, CCT. 22/24	TUG WHARF RECEPTACLE 30A	SOUTH JETTY
93	2SKCCT23-TUG3	4c #10 AWG	TECK 90	120V	SOUTH SUB PANEL 2SK, CCT. 23	TUG WHARF RECEPTACLE 20A	SOUTH JETTY
94	2SKCCT16-TUGPC	3c #12 AWG	TECK 90	120V	SOUTH SUB PANEL 2SK, CCT. 16	TUG WHARF PHOTOCCELL & CONTROL RELAY	SOUTH JETTY
95	TUGPC-TUGLIGHT1	3c #12 AWG	TECK 90	120V	TUG WHARF PHOTOCCELL	TUG FLOODLIGHT 1	SOUTH JETTY
96	TUGPC-TUGLIGHT2	3c #12 AWG	TECK 90	120V	TUG WHARF PHOTOCCELL	TUG FLOODLIGHT 2	SOUTH JETTY
97	TUGPC-TUGLIGHT3	3c #12 AWG	TECK 90	120V	TUG WHARF PHOTOCCELL	TUG FLOODLIGHT 3	SOUTH JETTY
98	F/A BOX - TUG F/A	2c #12 AWG	TECK 90	120V	VSY QA OFFICE 120V PANEL	TUG WHARF F/A HORN	SOUTH JETTY
99	F/A BOX TUG F/A HORN	2c #14 AWG	TECK 90	FIRE ALARM	VSY QA OFFICE F/A BOOSTER PANEL	TUG WHARF FIRE ALARM	SOUTH JETTY
100	2SKCCT38-F/A LOC LGT TUG	2c #12 AWG	TECK 90	120V	SOUTH SUB PANEL 2SK, CCT. 38	TUG WHARF LOCATOR LIGHT	SOUTH JETTY
101	SIGA-CT2 - JETTY F/A S	2c #14 AWG	TECK 90	FIRE ALARM	SIGA-CT2 F/A CONTROL RELAY KIOSK #3	JETTY FIRE ALARM S	SOUTH JETTY
102	F/A LOC LGT TUG - LOC LGT S	2c #12 AWG	TECK 90	120V	TUG WHARF LOCATOR LIGHT	JETTY LOCATOR LIGHT S	SOUTH JETTY
103	SIGA-CT2 - JETTY F/A SW	2c #14 AWG	TECK 90	FIRE ALARM	SIGA-CT2 F/A CONTROL RELAY KIOSK #3	JETTY FIRE ALARM SW	SOUTH JETTY
104	F/A LOC LGT S - LOC LGT SW	2c #12 AWG	TECK 90	120V	JETTY LOCATOR LIGHT S	JETTY LOCATOR LIGHT SW	SOUTH JETTY
105	SIGA-CT2 - F/A PULL PIT 63	2c #14 AWG	TECK 90	FIRE ALARM	SIGA-CT2 F/A CONTROL RELAY KIOSK #3	PULL PIT 63 F/A LOOP	SOUTH JETTY
106	F/A VSY FAB - QA OFFICE 120V	2c #12 AWG	TECK 90	120V	VSY FAB SHOP 120V PANEL	VSY QA OFFICE 120V PANEL	SOUTH JETTY
107	F/A VSY FAB - QA OFFICE F/A	2c #14 AWG	TECK 90	FIRE ALARM	VSY FAB SHOP F/A BOOSTER PANEL	VSY QA OFFICE F/A BOOSTER PANEL	SOUTH JETTY

NOTES:

- CONTRACTOR TO FIELD VERIFY ALL DETAILS PRIOR TO ORDERING NEW CABLES. OBTAIN INSTRUCTION FROM DEPARTMENTAL REPRESENTATIVE BEFORE ORDERING MATERIAL IF THERE IS ANY DISCREPANCY OR IF ADDITIONAL CABLES NOT SHOWN ARE FOUND.
- FOR CABLES 68 AND 69, EXACT ORIGIN AND DESTINATION IS UNKNOWN. FIELD VERIFY CABLE ROUTE WITH DEPARTMENTAL REPRESENTATIVE.
- FOR CABLE SCHEDULE AFTER DEMOLITION SEE DWG. E10.



Revision/	Description/Description	Date/Date
1	RECORD DRAWING	2017/03/28
0	ISSUED FOR TENDER	2014/12/16

PUBLIC WORKS AND GOVERNMENT SERVICES CANADA

Project title/Titre du projet
ESQUIMALT GRAVING DOCK
825 ADMIRALS ROAD, VICTORIA, BC

ESQUIMALT GRAVING DOCK WATERLOT PHASE 2 SOUTH JETTY UNDER-PIER SEDIMENT REMEDIATION

Consultant Signature Only

Designed by/Concept par
ALISON MANSFIELD / ROB JONES


Drawn by/Desainé par
GABE MENDES

PWGC Project Manager/Administrateur de Projets TPSGC
ANDREW MYLLY

Regional Manager, Environmental Services
COLLIN KINGMAN

Drawing title/Titre du dessin
EXISTING SERVICES ELECTRICAL CABLE SCHEDULE

Project No./No. du projet R.018400.002	Sheet/ E9	Revision no./ 1
--------------------------------------------------	---------------------	---------------------------

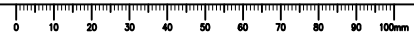

MODIFIED CABLE SCHEDULE

I.D. TAG	CABLE I.D. NUMBER	CABLE SIZE	CABLE TYPE	SERVICE DESCRIPTION	ORIGIN (SEE NOTE 2)	DESTINATION	ROUTING
1	4SS271-JM1/1	3c 350 MCM	TECK 90	480V, FEEDER	SOUTH SUB LOWER FLOOR	PULL PIT T2	NORTH TUNNEL
2	4SS271-JM1/2	3c 350 MCM	TECK 90	480V, FEEDER	SOUTH SUB LOWER FLOOR	PULL PIT T2	NORTH TUNNEL
3	2SS261-JM1/1	4c 350 MCM	TECK 90	120/208V, FEEDER	SOUTH SUB LOWER FLOOR	PULL PIT T2	NORTH TUNNEL
4	2SS261-JM1/2	4c 350 MCM	TECK 90	120/208V, FEEDER	SOUTH SUB LOWER FLOOR	PULL PIT T2	NORTH TUNNEL
5	4SS272-JM2/1	3c 350 MCM	TECK 90	480V, FEEDER	SOUTH SUB LOWER FLOOR	PULL PIT T2	NORTH TUNNEL
6	4SS272-JM2/2	3c 350 MCM	TECK 90	480V, FEEDER	SOUTH SUB LOWER FLOOR	PULL PIT T2	NORTH TUNNEL
7	2SS262-JM2/1	4c 350 MCM	TECK 90	120/208V, FEEDER	SOUTH SUB LOWER FLOOR	PULL PIT T2	NORTH TUNNEL
8	2SS262-JM2/2	4c 350 MCM	TECK 90	120/208V, FEEDER	SOUTH SUB LOWER FLOOR	PULL PIT T2	NORTH TUNNEL
9	4SS273-JM3/1	3c 350 MCM	TECK 90	480V, FEEDER	SOUTH SUB CABLE TRAY	OUTSIDE T4	SOUTH JETTY
10	4SS273-JM3/2	3c 350 MCM	TECK 90	480V, FEEDER	SOUTH SUB CABLE TRAY	OUTSIDE T4	SOUTH JETTY
11	2SS263-JM3/1	4c 350 MCM	TECK 90	120/208V, FEEDER	SOUTH SUB CABLE TRAY	OUTSIDE T4	SOUTH JETTY
12	2SS263-JM3/2	4c 350 MCM	TECK 90	120/208V, FEEDER	SOUTH SUB CABLE TRAY	OUTSIDE T4	SOUTH JETTY
13	4SS274-JM4/1	3c 350 MCM	TECK 90	480V, FEEDER	SOUTH SUB CABLE TRAY	PULL PIT T4	SOUTH JETTY
14	4SS274-JM4/2	3c 350 MCM	TECK 90	480V, FEEDER	SOUTH SUB CABLE TRAY	PULL PIT T4	SOUTH JETTY
15	2SS264-JM4	4c 350 MCM	TECK 90	120/208V, FEEDER	SOUTH SUB CABLE TRAY	OUTSIDE T4	SOUTH JETTY
16	4SS275-JM5/1	3c 350 MCM	TECK 90	480V, FEEDER	SOUTH SUB CABLE TRAY	OUTSIDE T4	SOUTH JETTY
17	4SS275-JM5/2	3c 350 MCM	TECK 90	480V, FEEDER	SOUTH SUB CABLE TRAY	OUTSIDE T4	SOUTH JETTY
18	2SS265-JM5	4c 350 MCM	TECK 90	120/208V, FEEDER	SOUTH SUB CABLE TRAY	OUTSIDE T4	SOUTH JETTY
19	NOT USED						
20	2SS2JB-JM5TB/1	2c #1 AWG	TECK 90	120V, 15A FEEDER	SOUTH SUB CABLE TRAY	PULL PIT T5	SOUTH JETTY
21	NOT USED						
22	NOT USED						
23	NOT USED						
24	NOT USED						
25	2SS2-JM5TB/2	2c #8 AWG	TECK 90	120V, 15A FEEDER	SOUTH SUB CABLE TRAY	PULL PIT T5	SOUTH JETTY
26	NOT USED						
27	NOT USED						
28	NOT USED						
29	NOT USED						
30	2SKCCT42-JM5TB	2c #8 AWG	TECK 90	120V, 15A FEEDER	SOUTH SUB CABLE TRAY	PULL PIT T5	SOUTH JETTY
31	NOT USED						
32	NOT USED						
45	F/A BOX-JM5	2c #14 AWG	TECK 90	FIRE ALARM	SOUTH SUB CABLE TRAY	PULL PIT T5	SOUTH JETTY
46	NOT USED						
47	NOT USED						
48	NOT USED						
49	NOT USED						
50	NOT USED						
51	TEL BOX-JM5	12pr #24 AWG	TEL	TELEPHONE	SOUTH SUB CABLE TRAY	PULL PIT T5	SOUTH JETTY
52	TEL BOX-JM4	12pr #24 AWG	TEL	TELEPHONE	SOUTH SUB CABLE TRAY	PULL PIT T5	SOUTH JETTY
53	TEL BOX-JM3	12pr #24 AWG	TEL	TELEPHONE	SOUTH SUB CABLE TRAY	PULL PIT T5	SOUTH JETTY
54	TEL BOX-JM2	12pr #24 AWG	TEL	TELEPHONE	SOUTH SUB CABLE TRAY	PULL PIT T5	SOUTH JETTY
55	TEL BOX-JM1	12pr #24 AWG	TEL	TELEPHONE	SOUTH SUB CABLE TRAY	PULL PIT T5	SOUTH JETTY
56	SCADA BOX-JM5-0400E1	2pr #18 AWG	STP RS485 AIA JKT	SCADA	SOUTH SUB CABLE TRAY	PULL PIT T5	SOUTH JETTY
57	NOT USED						
58	NOT USED						
59	NOT USED						
60	NOT USED						
61	JM1-DRYDOCK SPARE	2pr #18 AWG	STP RS485 AIA JKT	SCADA	PULL PIT T1	SERVICE TUNNEL SCADA WATER METER JB (SEE NOTE 2)	NORTH TUNNEL
62	2SKCCT43-JM5 120V	2c #12 AWG	TECK 90	120V	SOUTH SUB CABLE TRAY	PULL PIT T5	SOUTH JETTY
63	NOT USED						
64	NOT USED						
65	NOT USED						
66	NOT USED						
67	JM1-TUNNEL 120V 2SK-43	2c #12 AWG	TECK 90	120V	PULL PIT T1	SERVICE TUNNEL 2SK-43 JB (SEE NOTE 2)	NORTH TUNNEL
68	TOWER CRANE CAMERA	4pr #24 AWG	UTP CAT5e	CCTV	SOUTH SUB CABLE TRAY	PULL PIT T5	SOUTH JETTY
69	TOWER CRANE CAMERA	4pr #24 AWG	UTP CAT5e	CCTV	SOUTH SUB CABLE TRAY	PULL PIT T5	SOUTH JETTY
70	NOT USED						
71	2SKCCT22/24-TUG2	4c #6 AWG	TECK 90	208V	SOUTH SUB PANEL 2SK, CCT. 22/24	TUG WHARF RECEPTACLE 30A	EXISTING BURIED CONDUIT
72	2SKCCT23-TUG3	4c #6 AWG	TECK 90	120V	SOUTH SUB PANEL 2SK, CCT. 23	TUG WHARF RECEPTACLE 20A	EXISTING BURIED CONDUIT
73	F/A BOX - TUG F/A	2c #6 AWG	TECK 90	120V	SOUTH SUB PANEL 2SK, CCT. 16	TUG WHARF F/A HORN	EXISTING BURIED CONDUIT
74	F/A BOX TUG F/A HORN	2c #14 AWG	TECK 90	FIRE ALARM	SIGMA-IM BOX @ SOUTH SUB	TUG WHARF FIRE ALARM	EXISTING BURIED CONDUIT
75	VSY MAC-F/A LOC LGT TUG	2c #6 AWG	TECK 90	120V	VSY MACHINE SHOP PANEL 28M	TUG WHARF LOCATOR LIGHT	EXISTING BURIED CONDUIT
76	NOT USED						
77	NOT USED						
78	NOT USED						
79	NOT USED						
80	NOT USED						
81	NOT USED						
82	NOT USED						
83	NOT USED						
84	NOT USED						
85	NOT USED						
86	NOT USED						
87	NOT USED						
88	CAISSON 1/2JB-PARKJM1	3c #2 AWG	TECK 90	600V	CAISSON 1/2 JB IN SERVICE TUNNEL	PULL PIT T1	NORTH TUNNEL
89	6SHCCT26-SJ HIGH MAST	3c #1 AWG	RW90/TECK 90	347V	MAIN SUB PANEL 6SH CCT. 26	PULL PIT T3	EXISTING DUCT BANK
90	NOT USED						
91	2SKCCT18/20-TUG1	4c #8 AWG	TECK 90	208V	SOUTH SUB CABLE TRAY	NEAR PULL PIT T4	SOUTH JETTY
92	2SKCCT22/24-TUG2	4c #8 AWG	TECK 90	208V	SOUTH SUB CABLE TRAY	NEAR PULL PIT T4	SOUTH JETTY
93	2SKCCT23-TUG3	4c #10 AWG	TECK 90	120V	SOUTH SUB CABLE TRAY	NEAR PULL PIT T4	SOUTH JETTY
94	2SKCCT16-TUGPC	3c #12 AWG	TECK 90	120V	SOUTH SUB CABLE TRAY	NEAR PULL PIT T4	SOUTH JETTY
95	NOT USED						
96	NOT USED						
97	NOT USED						
98	NOT USED						
99	NOT USED						
100	2SKCCT38-F/A LOC LGT TUG	2c #12 AWG	TECK 90	120V	SOUTH SUB CABLE TRAY	NEAR PULL PIT T4	SOUTH JETTY
101	NOT USED						
102	NOT USED						
103	NOT USED						
104	NOT USED						
105	NOT USED						
106	NOT USED						
107	NOT USED						

CABLES CUT OFF FLUSH WITH JETTY. STILL CONNECTED AT SOUTH SUB. SHOULD NOT BE ENERGIZED.

CABLES CUT OFF FLUSH WITH JETTY. STILL CONNECTED AT SOUTH SUB. SHOULD NOT BE ENERGIZED.

CABLES CUT OFF FLUSH WITH JETTY. STILL CONNECTED AT SOUTH SUB. SHOULD NOT BE ENERGIZED.

CABLES CUT OFF FLUSH WITH JETTY. STILL CONNECTED AT SOUTH SUB. SHOULD NOT BE ENERGIZED.

NOT IN CONTRACT

SERVICE TUNNEL SCADA WATER METER JB (SEE NOTE 2)

NOT IN CONTRACT

SERVICE TUNNEL 2SK-43 JB (SEE NOTE 2)

CABLES CUT OFF FLUSH WITH JETTY. STILL CONNECTED AT SOUTH SUB. SHOULD NOT BE ENERGIZED.

NOT IN CONTRACT

CABLES CUT OFF FLUSH WITH JETTY. STILL CONNECTED AT SOUTH SUB. SHOULD NOT BE ENERGIZED.

CABLES CUT OFF FLUSH WITH JETTY. STILL CONNECTED AT SOUTH SUB. SHOULD NOT BE ENERGIZED.

CABLES CUT OFF FLUSH WITH JETTY. STILL CONNECTED AT SOUTH SUB. SHOULD NOT BE ENERGIZED.

NOTES:

- CONTRACTOR TO FIELD VERIFY ALL DETAILS PRIOR TO ORDERING NEW CABLES. OBTAIN INSTRUCTION FROM DEPARTMENTAL REPRESENTATIVE BEFORE ORDERING MATERIAL IF THERE IS ANY DISCREPANCY OR IF ADDITIONAL CABLES NOT SHOWN ARE FOUND.
- CABLES SHALL BE DISCONNECTED FROM EQUIPMENT, CAPPED AND SEALED. CABLES WITH A NORTH TUNNEL ROUTING SHALL BE MADE SAFE AND PULLED BACK ONTO THE SUBSTATION LOWER FLOOR. CABLES WITH A SOUTH JETTY ROUTING SHALL BE MADE SAFE AND PULLED BACK ONTO THE EXISTING CABLE TRAY IN THE SOUTH SUB. TAGGING SHALL REMAIN ON CABLES.



Revision/Revision	Description/Description	Date/Date
1	RECORD DRAWING	2017/03/28
0	ISSUED FOR TENDER	2014/12/18

Client/client
PUBLIC WORKS AND GOVERNMENT SERVICES CANADA

Project title/Titre du projet
**ESQUIMALT GRAVING DOCK
825 ADMIRALS ROAD, VICTORIA, BC**

**ESQUIMALT GRAVING DOCK
WATERLOT PHASE 2
SOUTH JETTY UNDER-PIER
SEDIMENT REMEDIATION**

Consultant Signature Only
ALISON MANSFIELD / ROB JONES


Designed by/Concept par
GABE MENDES

PWGC Project Manager/Administrateur de Projets TPSGC
ANDREW MYLLY

Regional Manager, Environmental Services
COLLIN KINGMAN

Drawing title/Titre du dessin
**MODIFICATIONS TO SERVICES
ELECTRICAL CABLE SCHEDULE**

Project No./No. du projet R.018400.002	Sheet/ E10	Revision no./ 1
--------------------------------------------------	----------------------	---------------------------

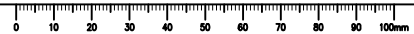



LEGEND:

- LEAD SILVER ANODE
- EXISTING STEEL PIPE PILE


NOTES:

1. TEMPORARILY REMOVE, STORE AND REINSTATE ANODES TO ORIGINAL LOCATION AFTER DREDGING AND ENGINEERED CAPPING WORK ARE COMPLETED.
2. DO NOT DAMAGE THE INSULATION ON THE ANODE CABLE DURING REMOVAL AND REINSTATING.
3. DETAILS TAKEN FROM ESQUIMALT GRAVING DOCK IMPROVEMENTS, PROJECT NUMBER PR.100772 DRAWINGS 15 AND 16 OF 75, SUPPLEMENTED BY FIELD INFORMATION FROM EGD SEDIMENT REMEDIATION SOUTH JETTY UNDER-PIER EROSION PROTECTION RECORD DRAWINGS S15 (REFERENCE DRAWINGS).
4. REFER TO SPECIFICATION SECTION 02 41 13 FOR ICCP SYSTEM REQUIREMENTS.


CORROSION TESTING REQUIREMENTS:

1. SYSTEM NOT TESTED PRIOR TO REMOVAL. SYSTEM TESTED POST INSTALLATION.


New MMO Anode ●
 Original ICCP Anode ○

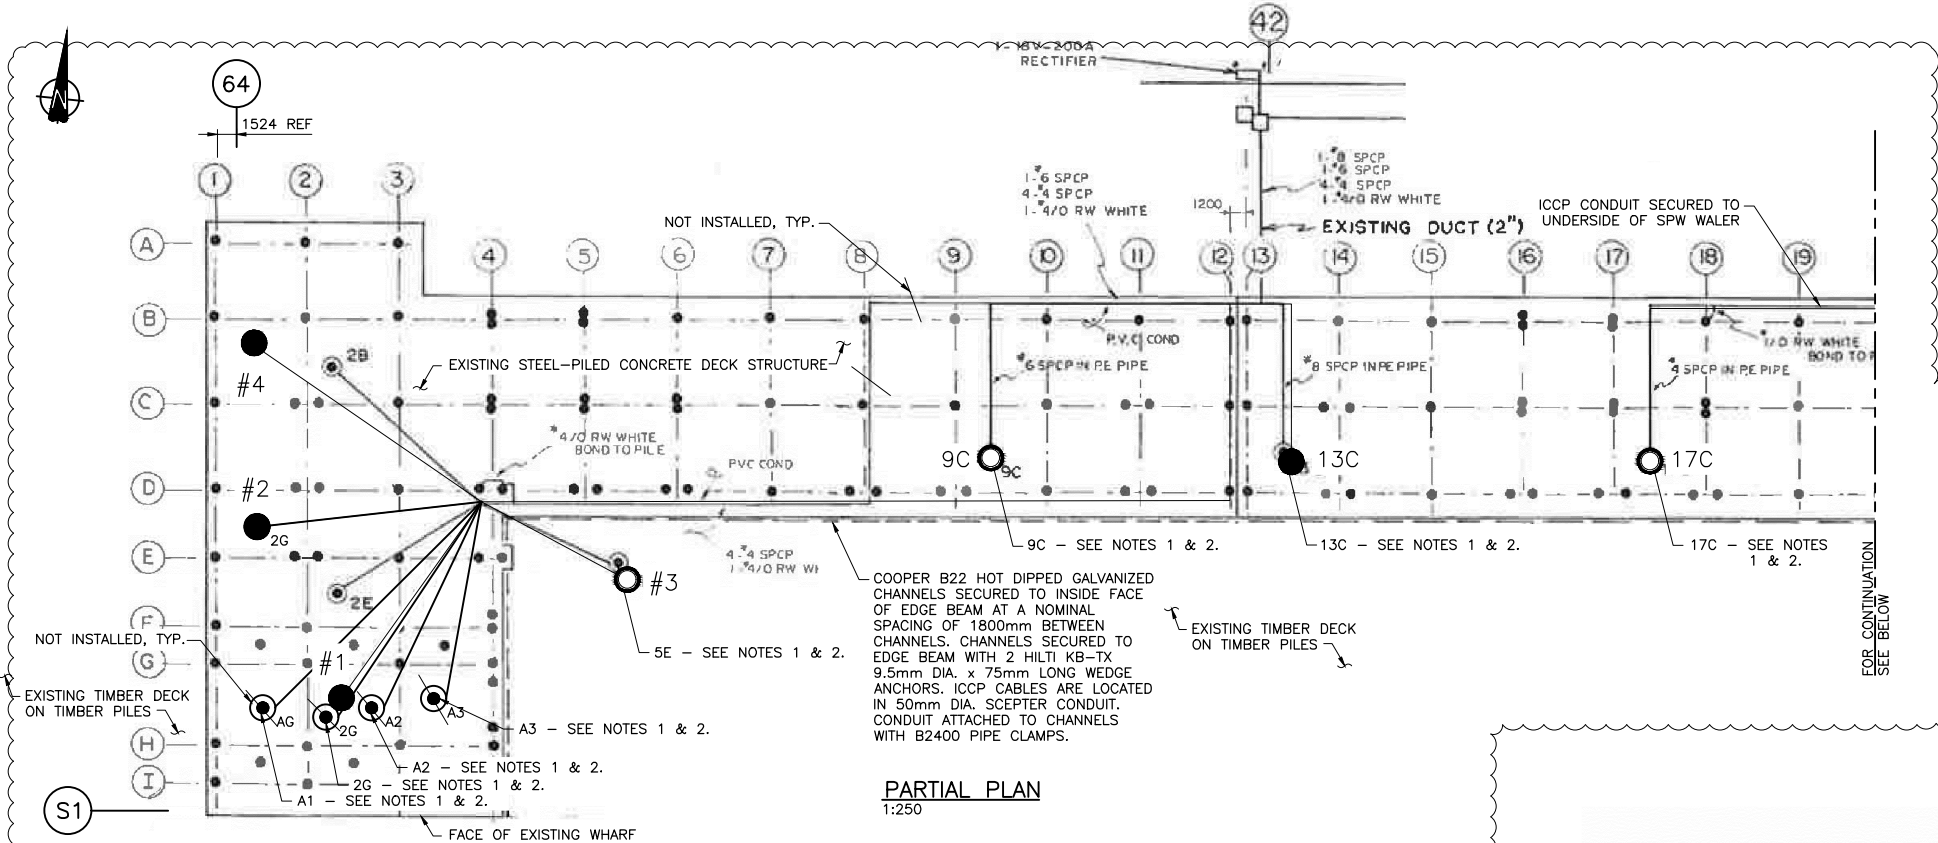


PARTIAL PLAN
1:250

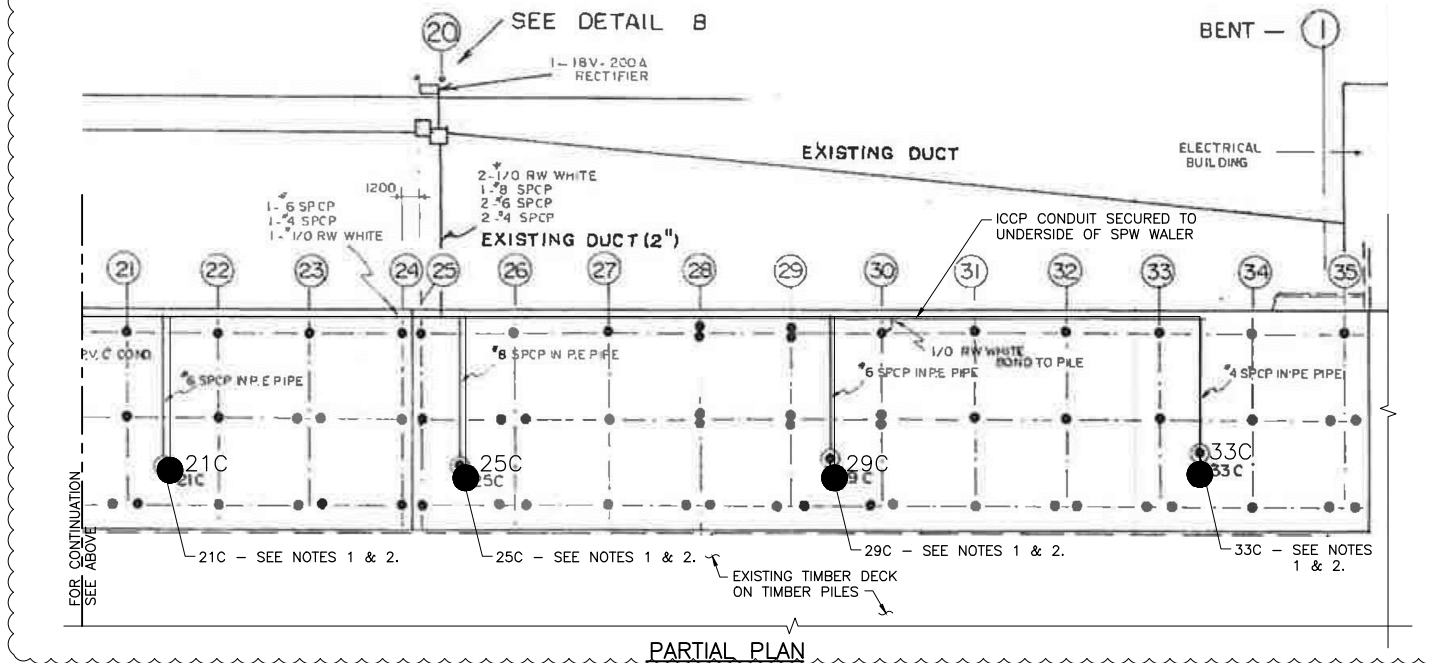

PARTIAL PLAN
1:250

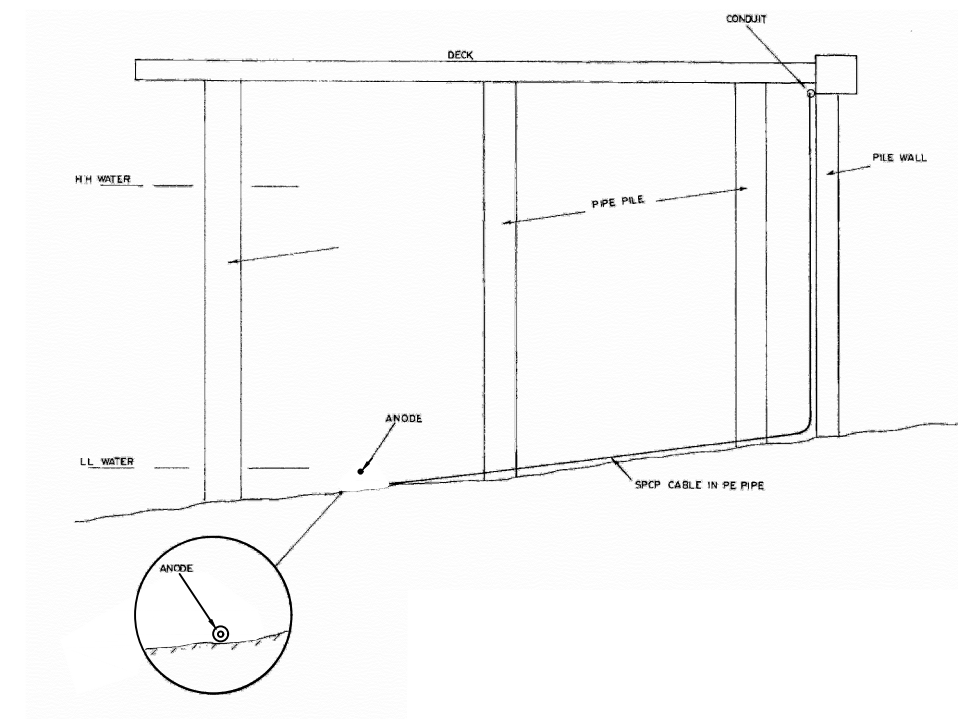

TYPICAL SECTION
N.T.S.

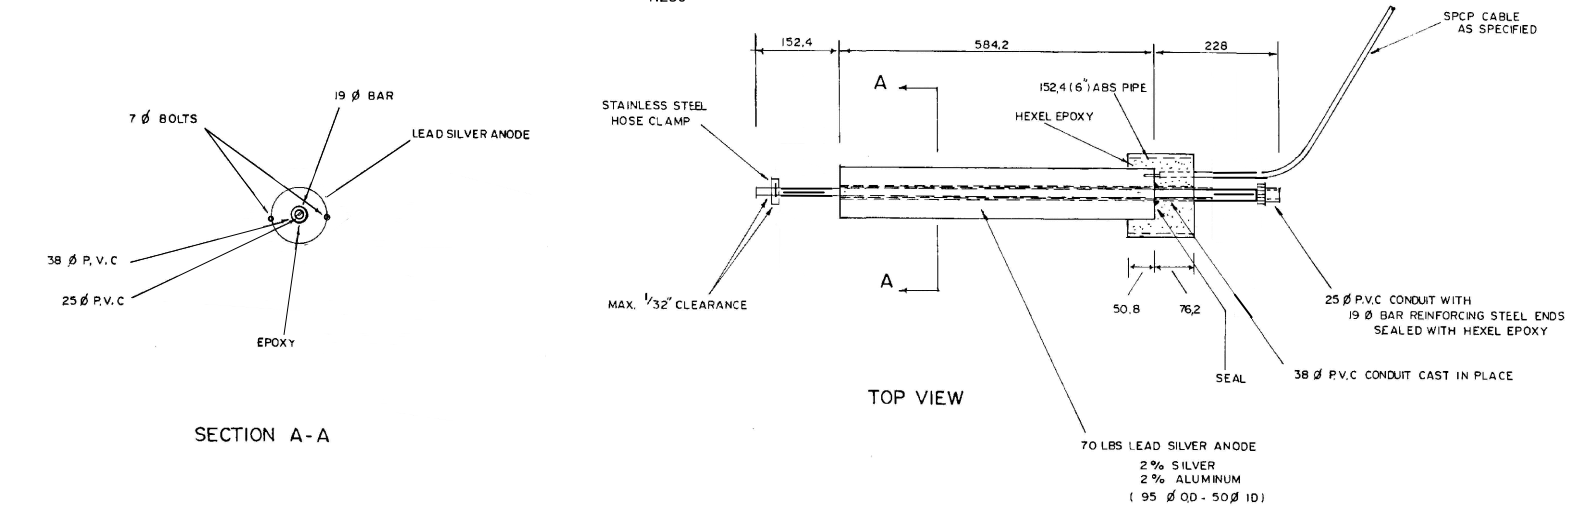

TYPICAL ANODE ASSEMBLY DETAILS
N.T.S.

Revision/Revision	Description/Description	Date/Date
1	RECORD DRAWING	2017/03/29
0	ISSUED FOR TENDER	2014/12/19

PUBLIC WORKS AND GOVERNMENT SERVICES CANADA

Project title/Titre du projet
ESQUIMALT GRAVING DOCK
 825 ADMIRALS ROAD, VICTORIA, BC

ESQUIMALT GRAVING DOCK WATERLOT PHASE 2 SOUTH JETTY UNDER-PIER SEDIMENT REMEDIATION

Consultant Signature Only
 Designed by/Concept par GEOFF COOPER
 Drawn by/Desainé par ARNIE RIST
 PWSC Project Manager/Administrateur de Projets TPSGC ANDREW MYLLY
 Regional Manager, Environmental Services COLLIN KINGMAN

Drawing title/Titre du dessin
SOUTH JETTY MODIFICATIONS TO CATHODIC PROTECTION SYSTEM

Project No./No. du projet R.018400.002	Sheet/ E11	Revision no./ 1
-------------------------------------------	---------------	--------------------






PHOTO 2




PHOTO 1

NOTES:


1. THE ELECTRICAL CABLES/SERVICES SHOWN ON THIS DRAWINGS ARE BASED ON WESTMAR DRAWING NO. 846342-D-E2 CIRCA 2002/3 AND MAY NOT BE REPRESENTATIVE OF EXISTING AS-BUILT CONDITIONS.
2. ALL EXISTING UTILITIES ARE SHOWN ACCORDING TO AVAILABLE RECORD DRAWINGS. THE CONTRACTOR SHALL LOCATE ALL EXISTING UTILITIES PRIOR TO CONSTRUCTION, INCLUDING UNDERGROUND FIRE WATER, SANITARY SEWER, COMPRESSED AIR, POWER AND TELEPHONE SERVICE DUCTS AND SHALL NOTIFY THE DEPARTMENTAL REPRESENTATIVE OF ANY DISCREPANCIES OR CONFLICTS A MINIMUM OF 72 HOURS PRIOR TO CONSTRUCTION. ANY ADDITIONAL WORK REQUIRED AS A RESULT OF FAILING TO PRE-LOCATE KNOWN OR POTENTIAL CONFLICTS WILL BE COMPLETED AT THE CONTRACTOR'S EXPENSE.
3. BEFORE CUTTING, CABLES SHALL BE DE-ENERGIZED BY OPENING AND LOCKING OUT THE FOLLOWING CIRCUIT BREAKERS AND ENSURED DEAD:
 - a. 4SS2-73
 - b. 2SS2-63
 - c. 4SS2-74
 - d. 2SS2-64
 - e. 4SS2-75
 - f. 2SS2-65
 - g. 2SS2JB
 - h. 2SS2
 - i. SOUTH SUB PANEL 2SK, CCT. 42
 CABLE TERMINATING IN THE PULL PITS SHALL BE CUT SO AS TO HAVE A 1 METRE TAIL, CAPPED AND SEALED. CABLE SHALL BE PULLED BACK TO SUBSTATION WHERE POSSIBLE. DIRECT BURIED CABLE SHALL BE CUT NEAR PULL PIT, CAPPED, SEALED AND LEFT IN PLACE. DOWNSTREAM CABLE SHALL BE REMOVED AND DISPOSED.
4. BEFORE CUTTING, CABLES SHALL BE DE-ENERGIZED BY OPENING AND LOCKING OUT THE FOLLOWING CIRCUIT BREAKERS AND ENSURED DEAD:
 - a. SOUTH SUB PANEL 2SK, CC18/20
 - b. SOUTH SUB PANEL 2SK, CC23/24
 - c. SOUTH SUB PANEL 2SK, CC23
 - d. SOUTH SUB PANEL 2SK, CC16
 - e. SOUTH SUB PANEL 2SK, CC38
 - f. VSY QA OFFICE 120 V PANEL
 - g. VSY QA OFFICE F/A BOOSTER PANEL
 DIRECT BURIED CABLE SHALL BE CUT NEAR PULL PIT, CAPPED, SEALED AND LEFT IN PLACE. DOWNSTREAM CABLE SHALL BE REMOVED AND DISPOSED.
5. BEFORE CUTTING, CABLES SHALL BE DE-ENERGIZED BY OPENING AND LOCKING OUT THE FOLLOWING CIRCUIT BREAKERS AND ENSURED DEAD:
 - a. 4SS2-71
 - b. 2SS2-61
 - c. 4SS2-72
 - d. 2SS2-72
 CABLE TERMINATING IN THE PULL PITS SHALL BE CUT SO AS TO HAVE A 1 METRE TAIL, CAPPED AND SEALED. DOWNSTREAM CABLE SHALL BE REMOVED AND DISPOSED.
6. BEFORE CUTTING, CABLE SHALL BE DE-ENERGIZED BY OPENING AND LOCKING OUT CORRESPONDING HIGH MAST LIGHT CIRCUIT BREAKER AT SUBSTATION 1 AND ENSURED DEAD. CABLE SHALL BE CUT SO AS TO HAVE A 1 METRE TAIL, CAPPED, SEALED AND PLACED IN PULL PIT. DOWNSTREAM CABLE SHALL BE REMOVED AND DISPOSED.

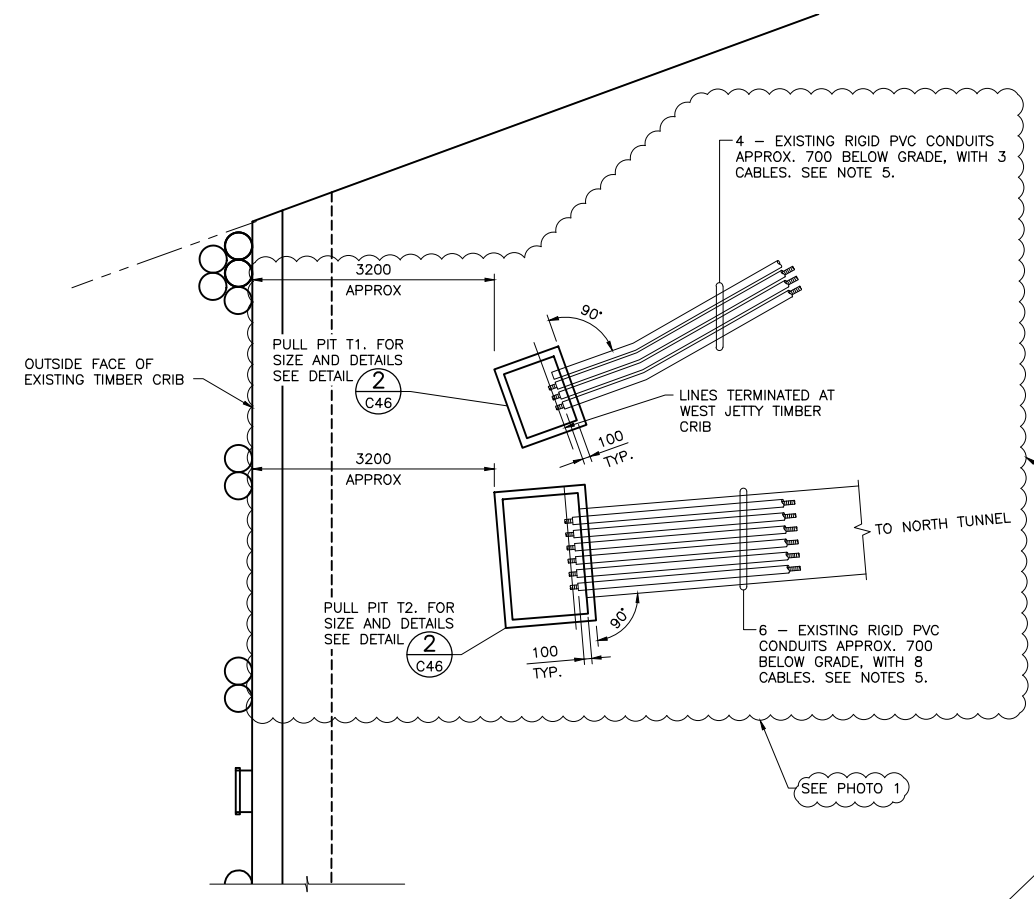

DETAIL 3
SCALE 1: 50
E4

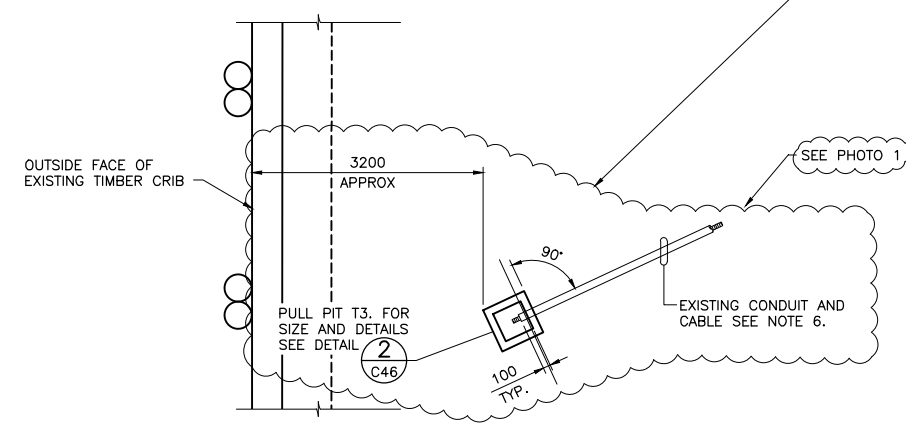

DETAIL 4
SCALE 1: 50
E4

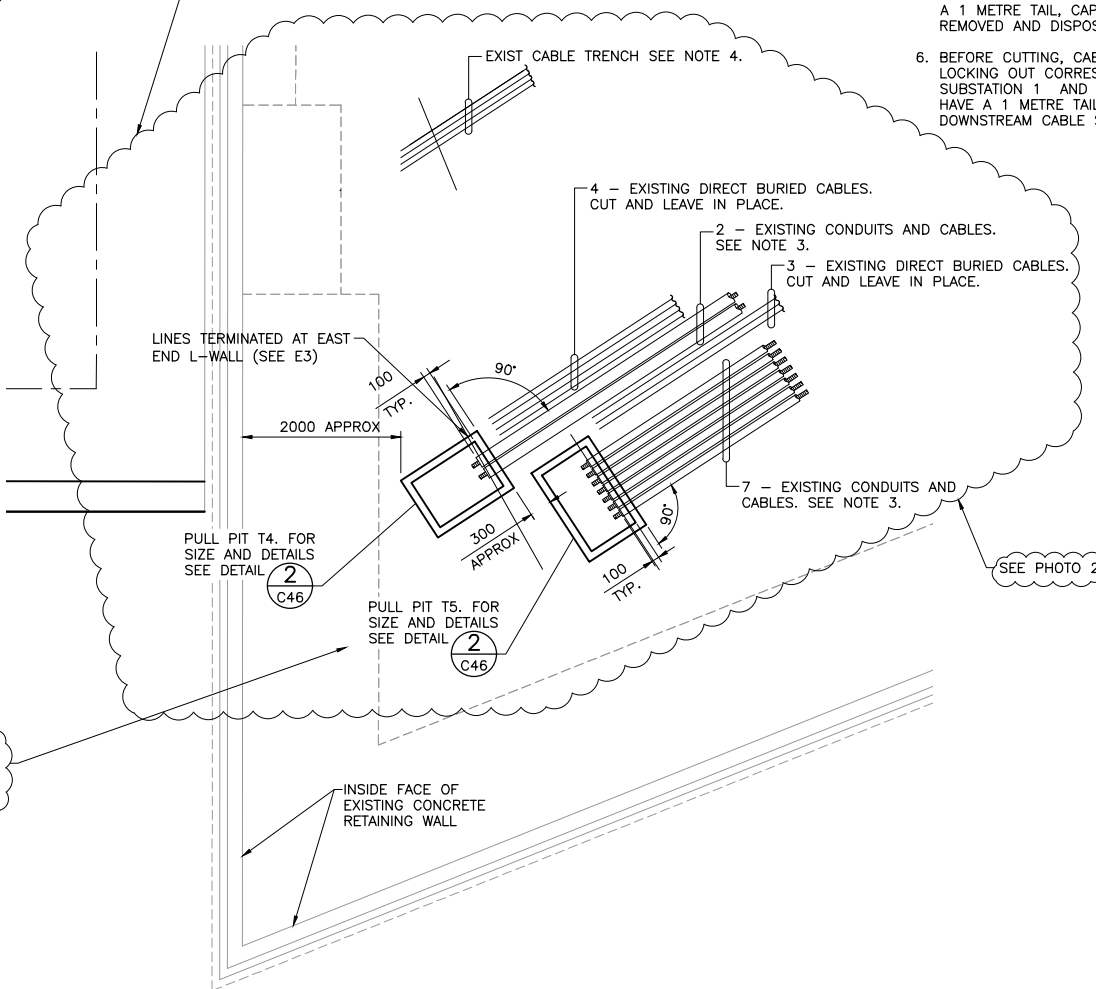

DETAIL 2
SCALE 1: 50
E4

ALL LINES CUT AND CAPPED TERMINATION PITS SUPPLIED TO PWGSC. NOT IN CONTRACT TO INSTALL TERMINATION PITS.

LINES TERMINATED AT WEST JETTY TIMBER CRIB

LINES TERMINATED AT EAST END L-WALL (SEE E3)
PHOTO 2

Revision/Revision	Description/Description	Date/Date
1	RECORD DRAWING	2017/03/28
0	ISSUED FOR TENDER	2014/12/18

Client/client
PUBLIC WORKS AND GOVERNMENT SERVICES CANADA

Project title/Titre du projet
**ESQUIMALT GRAVING DOCK
825 ADMIRALS ROAD, VICTORIA, BC**

**ESQUIMALT GRAVING DOCK
WATERLOT PHASE 2
SOUTH JETTY UNDER-PIER
SEDIMENT REMEDIATION**

Consultant Signature Only

Designed by/Concept par
LAWRENCE DUONG


Drawn by/Desainé par
MIKE BRIDDEN

PWGSC Project Manager/Administrateur de Projets TPSGC
ANDREW MYLLY

Regional Manager, Environmental Services
COLLIN KINGMAN

Drawing title/Titre du dessin
**SERVICES
ELECTRICAL
TERMINATION DETAILS**

Project No./No. du projet R.018400.002	Sheet/ E12	Revision no./ 1
--------------------------------------------------	----------------------	---------------------------

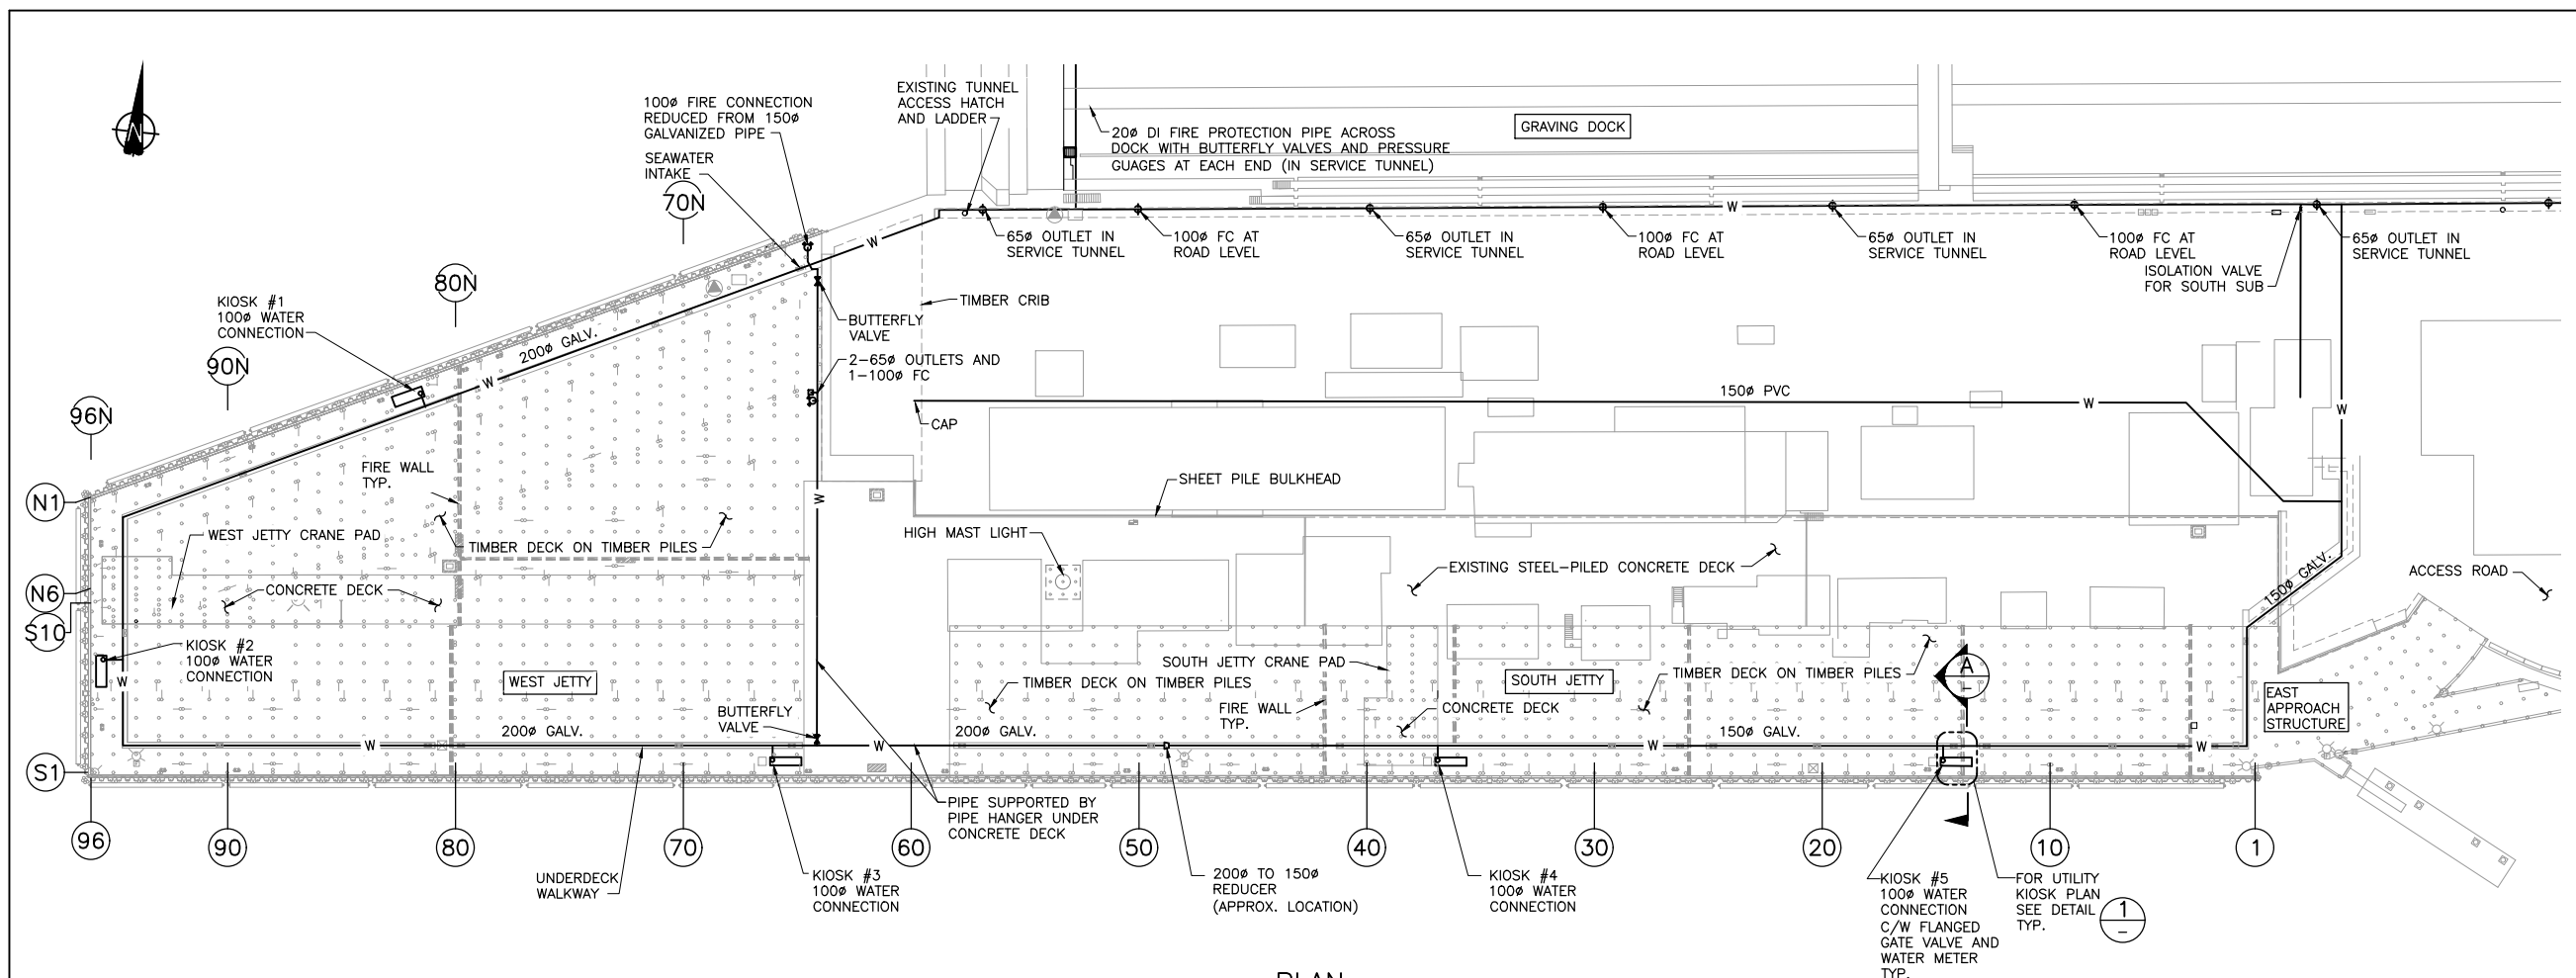



PLAN
1:500

NOTES:


1. EXACT LAYOUT MAY VARY. CONTRACTOR TO FIELD VERIFY ALL DETAILS.
2. SEWER ON KIOSKS 3, 4 AND 5 ONLY.
3. ALL DIMENSIONS FOR REFERENCE ONLY. CONTRACTOR TO VERIFY.
4. DISCONNECT KIOSKS, REMOVE AND RETAIN FOR RE-USE.
5. REMOVE PIPE, MECHANICAL COUPLINGS, VALVES, FLOW METERS & FITTINGS. RETAIN, RE-USE OR DISPOSE AS DESCRIBED ON DWG. D4 AND D5.
6. ALL EXISTING UTILITIES ARE SHOWN ACCORDING TO AVAILABLE RECORD DRAWINGS. THE CONTRACTOR SHALL LOCATE ALL EXISTING UTILITIES PRIOR TO CONSTRUCTION, INCLUDING UNDERGROUND FIRE WATER, SANITARY SEWER, COMPRESSED AIR, POWER AND TELEPHONE SERVICE DUCTS AND SHALL NOTIFY THE DEPARTMENTAL REPRESENTATIVE OF ANY DISCREPANCIES OR CONFLICTS A MINIMUM OF 72 HOURS PRIOR TO CONSTRUCTION. ANY ADDITIONAL WORK REQUIRED AS A RESULT OF FAILING TO PRE-LOCATE KNOWN OR POTENTIAL CONFLICTS WILL BE COMPLETED AT THE CONTRACTOR'S EXPENSE.

LEGEND


—W—X— EXISTING FIRE WATER MAIN / VALVE

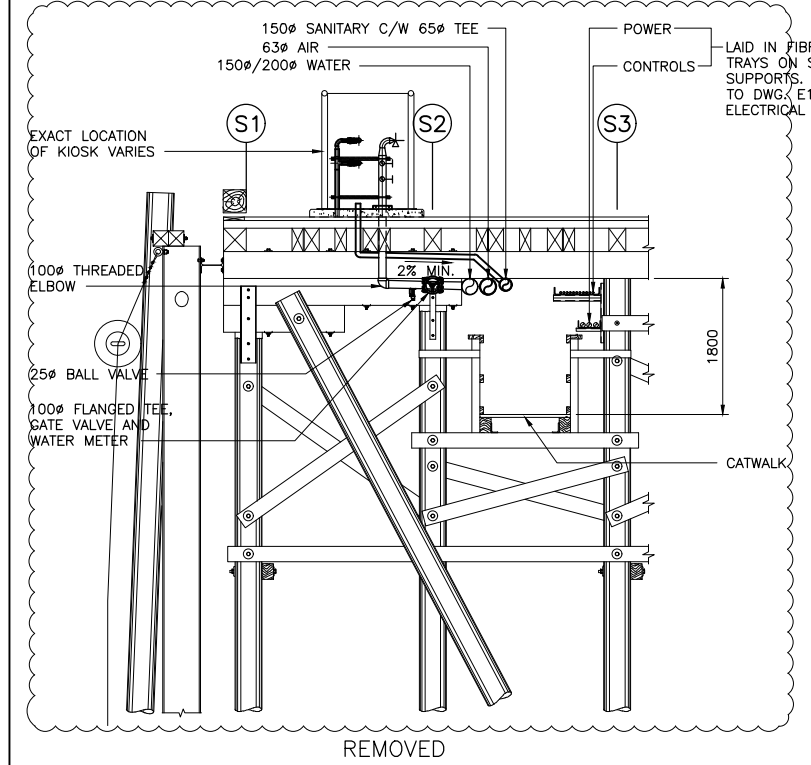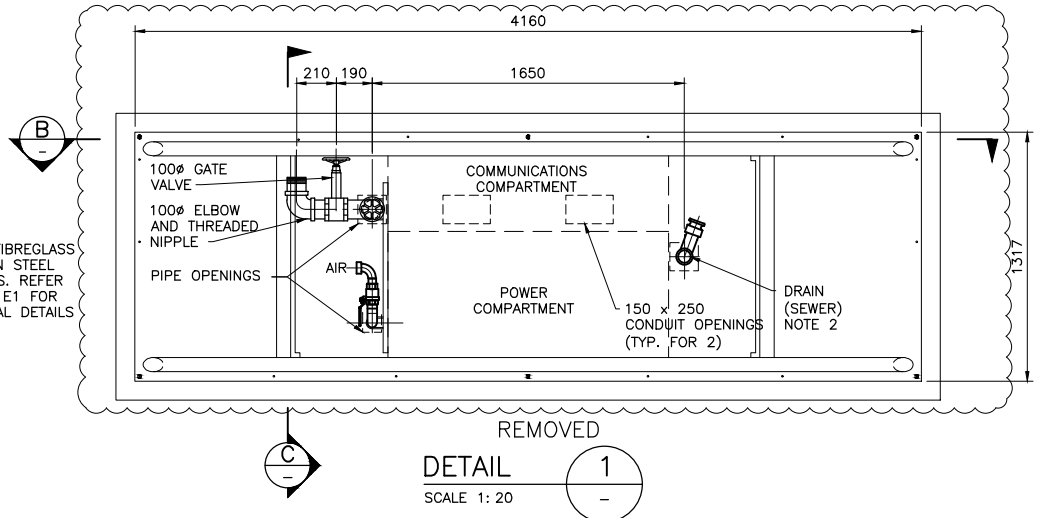

SECTION A
SCALE 1:50
TYPICAL UTILITY ALIGNMENT IN WALKWAY

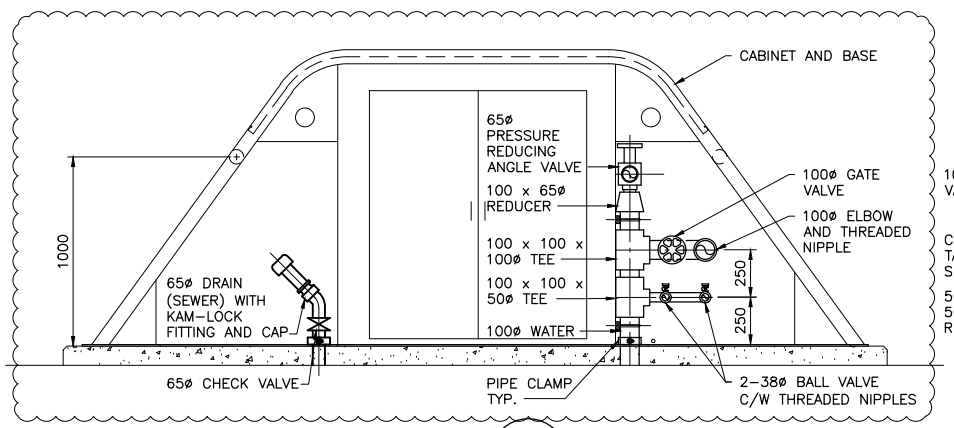

SECTION B
SCALE 1:20
REMOVED AND RETURNED TO PWGSC

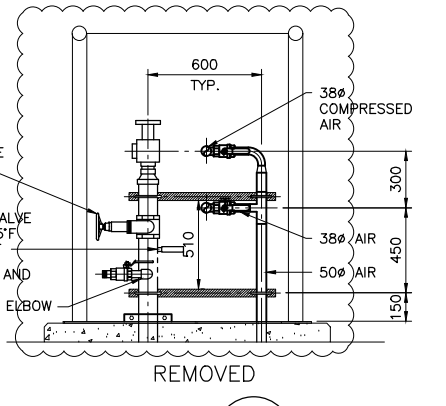

SECTION C
SCALE 1:20

Revision/Revision	Description/Description	Date/Date
1	RECORD DRAWING	2017/03/28
0	ISSUED FOR TENDER	2014/12/18

PUBLIC WORKS AND GOVERNMENT SERVICES CANADA


Project title/Titre du projet
ESQUIMALT GRAVING DOCK
 825 ADMIRALS ROAD, VICTORIA, BC

ESQUIMALT GRAVING DOCK WATERLOT PHASE 2 SOUTH JETTY UNDER-PIER SEDIMENT REMEDIATION

Consultant Signature Only
 Designed by/Concept par
 ANDREW MACK / DOUG SHARPE
 Drawn by/Desainé par
 GABE MENDES
 PWGSC Project Manager/Administrateur de Projets TPSGC
 ANDREW MYLLY
 Regional Manager, Environmental Services
 COLLIN KINGMAN

Drawing title/Titre du dessin
EXISTING SERVICES FIRE WATER MAIN AND KIOSK PLAN, SECTIONS AND DETAIL

Project No./No. du projet	Sheet/	Revision no./
R.018400.002	M1	1

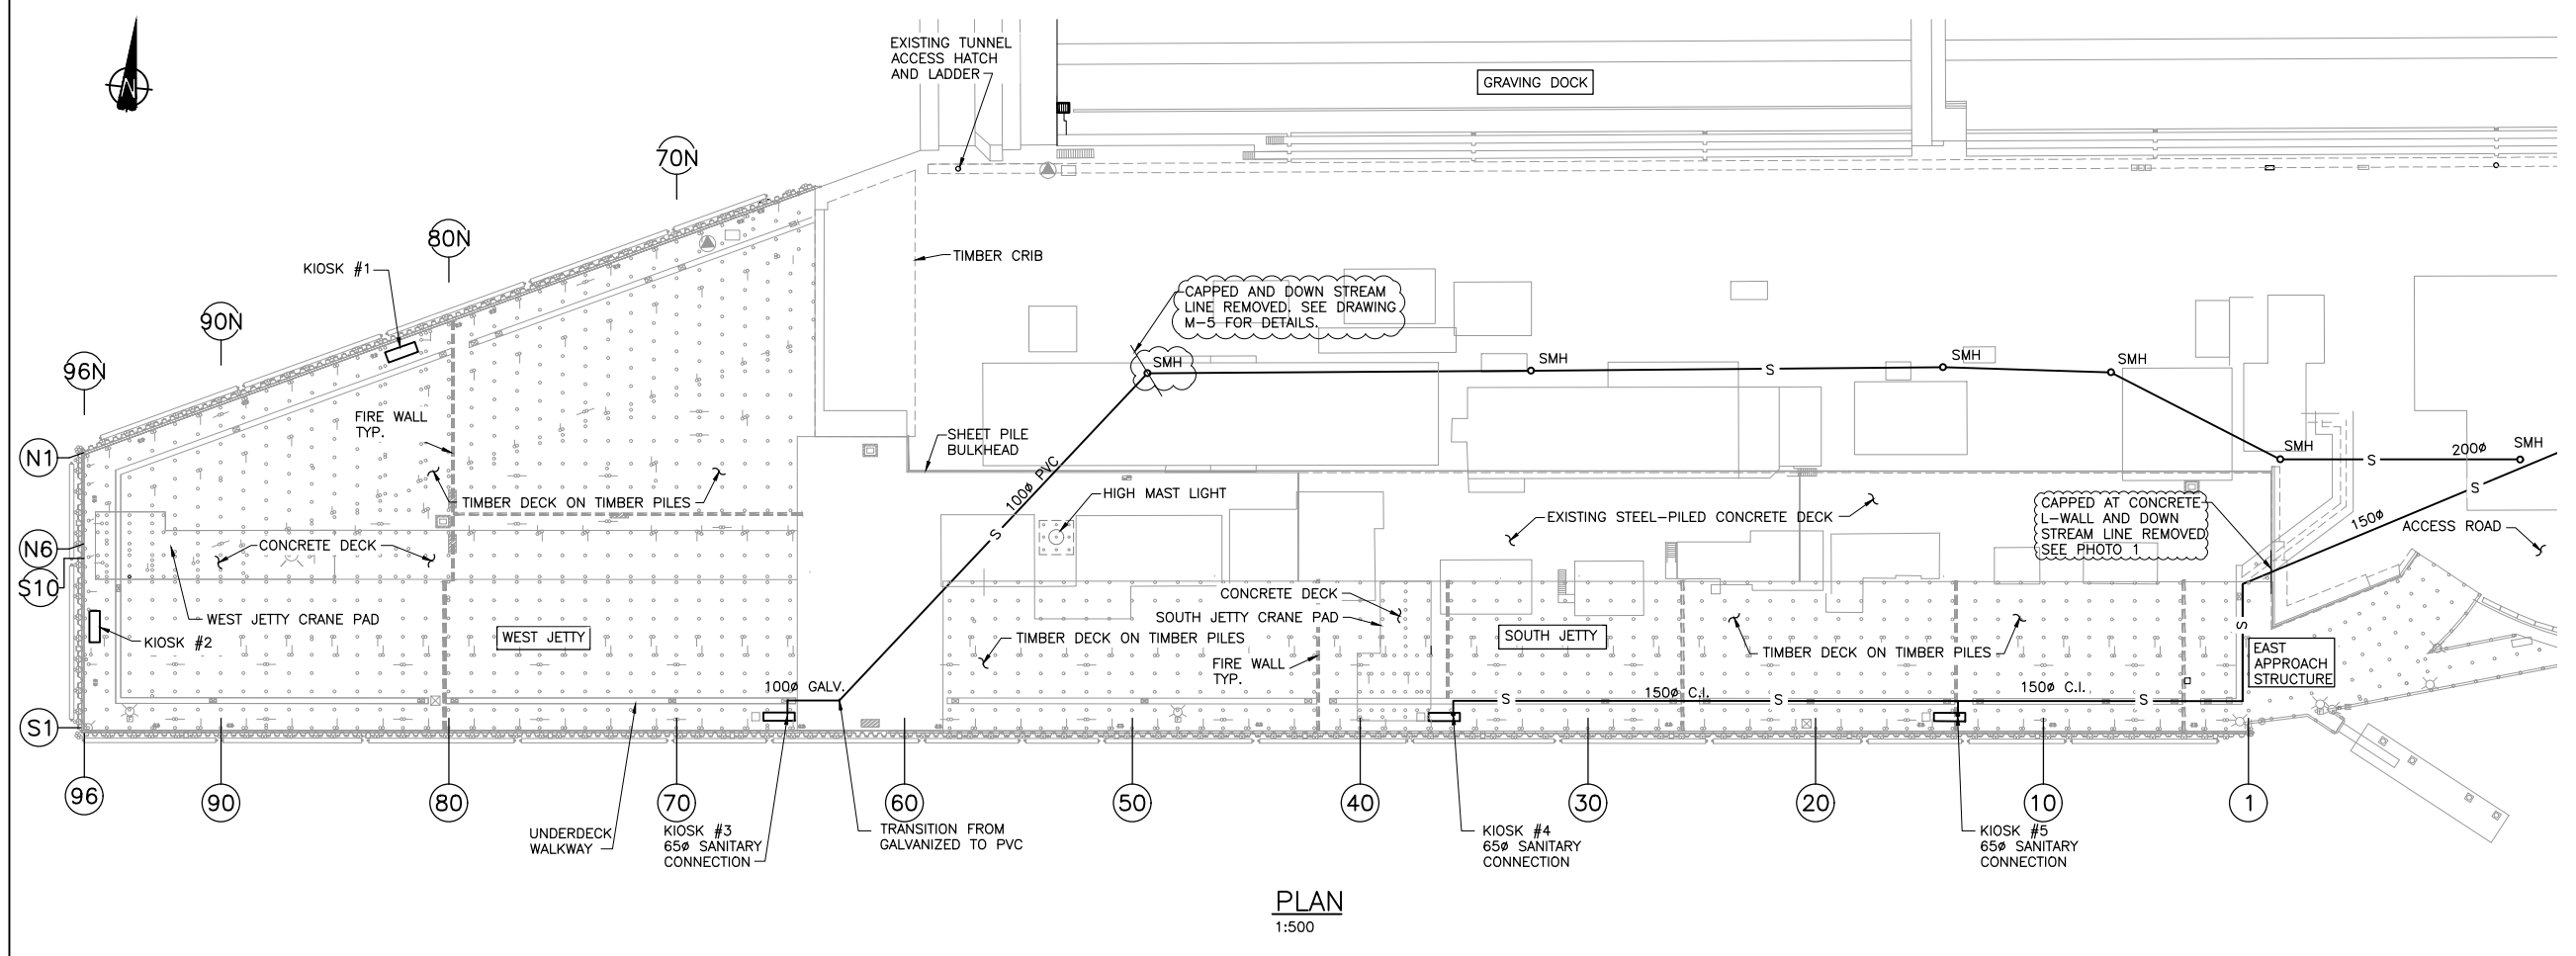

NOTES:

1. EXACT LAYOUT MAY VARY. CONTRACTOR TO FIELD VERIFY ALL DETAILS.
2. FOR KIOSK CONNECTION DETAILS, SEE DWG. M1.
3. REFER TO DWGS. D4 & D5 FOR DEMOLITION.
4. ALL EXISTING UTILITIES ARE SHOWN ACCORDING TO AVAILABLE RECORD DRAWINGS. THE CONTRACTOR SHALL LOCATE ALL EXISTING UTILITIES PRIOR TO CONSTRUCTION, INCLUDING UNDERGROUND FIRE WATER, SANITARY SEWER, COMPRESSED AIR, POWER AND TELEPHONE SERVICE DUCTS AND SHALL NOTIFY THE DEPARTMENTAL REPRESENTATIVE OF ANY DISCREPANCIES OR CONFLICTS A MINIMUM OF 72 HOURS PRIOR TO CONSTRUCTION. ANY ADDITIONAL WORK REQUIRED AS A RESULT OF FAILING TO PRE-LOCATE KNOWN OR POTENTIAL CONFLICTS WILL BE COMPLETED AT THE CONTRACTOR'S EXPENSE.

LEGEND



Revision/Revision	Description/Description	Date/Date
1	RECORD DRAWING	2017/03/28
0	ISSUED FOR TENDER	2014/12/18

Client/client
PUBLIC WORKS AND GOVERNMENT SERVICES CANADA


Project title/Titre du projet
**ESQUIMALT GRAVING DOCK
 825 ADMIRALS ROAD, VICTORIA, BC**

**ESQUIMALT GRAVING DOCK
 WATERLOT PHASE 2
 SOUTH JETTY UNDER-PIER
 SEDIMENT REMEDIATION**

Consultant Signature Only
 Designed by/Concept par
 ANDREW MACK / DOUG SHARPE
 Drawn by/Desainé par
 GABE MENDES
 PWGSC Project Manager/Administrateur de Projets TPSGC
 ANDREW MYLLY
 Regional Manager, Environmental Services
 COLLIN KINGMAN

Drawing title/Titre du dessin
**EXISTING SERVICES
 SANITARY SEWER
 PLAN**

Project No./No. du projet R.018400.002	Sheet/ M2	Revision no./ 1
--------------------------------------------------	---------------------	---------------------------

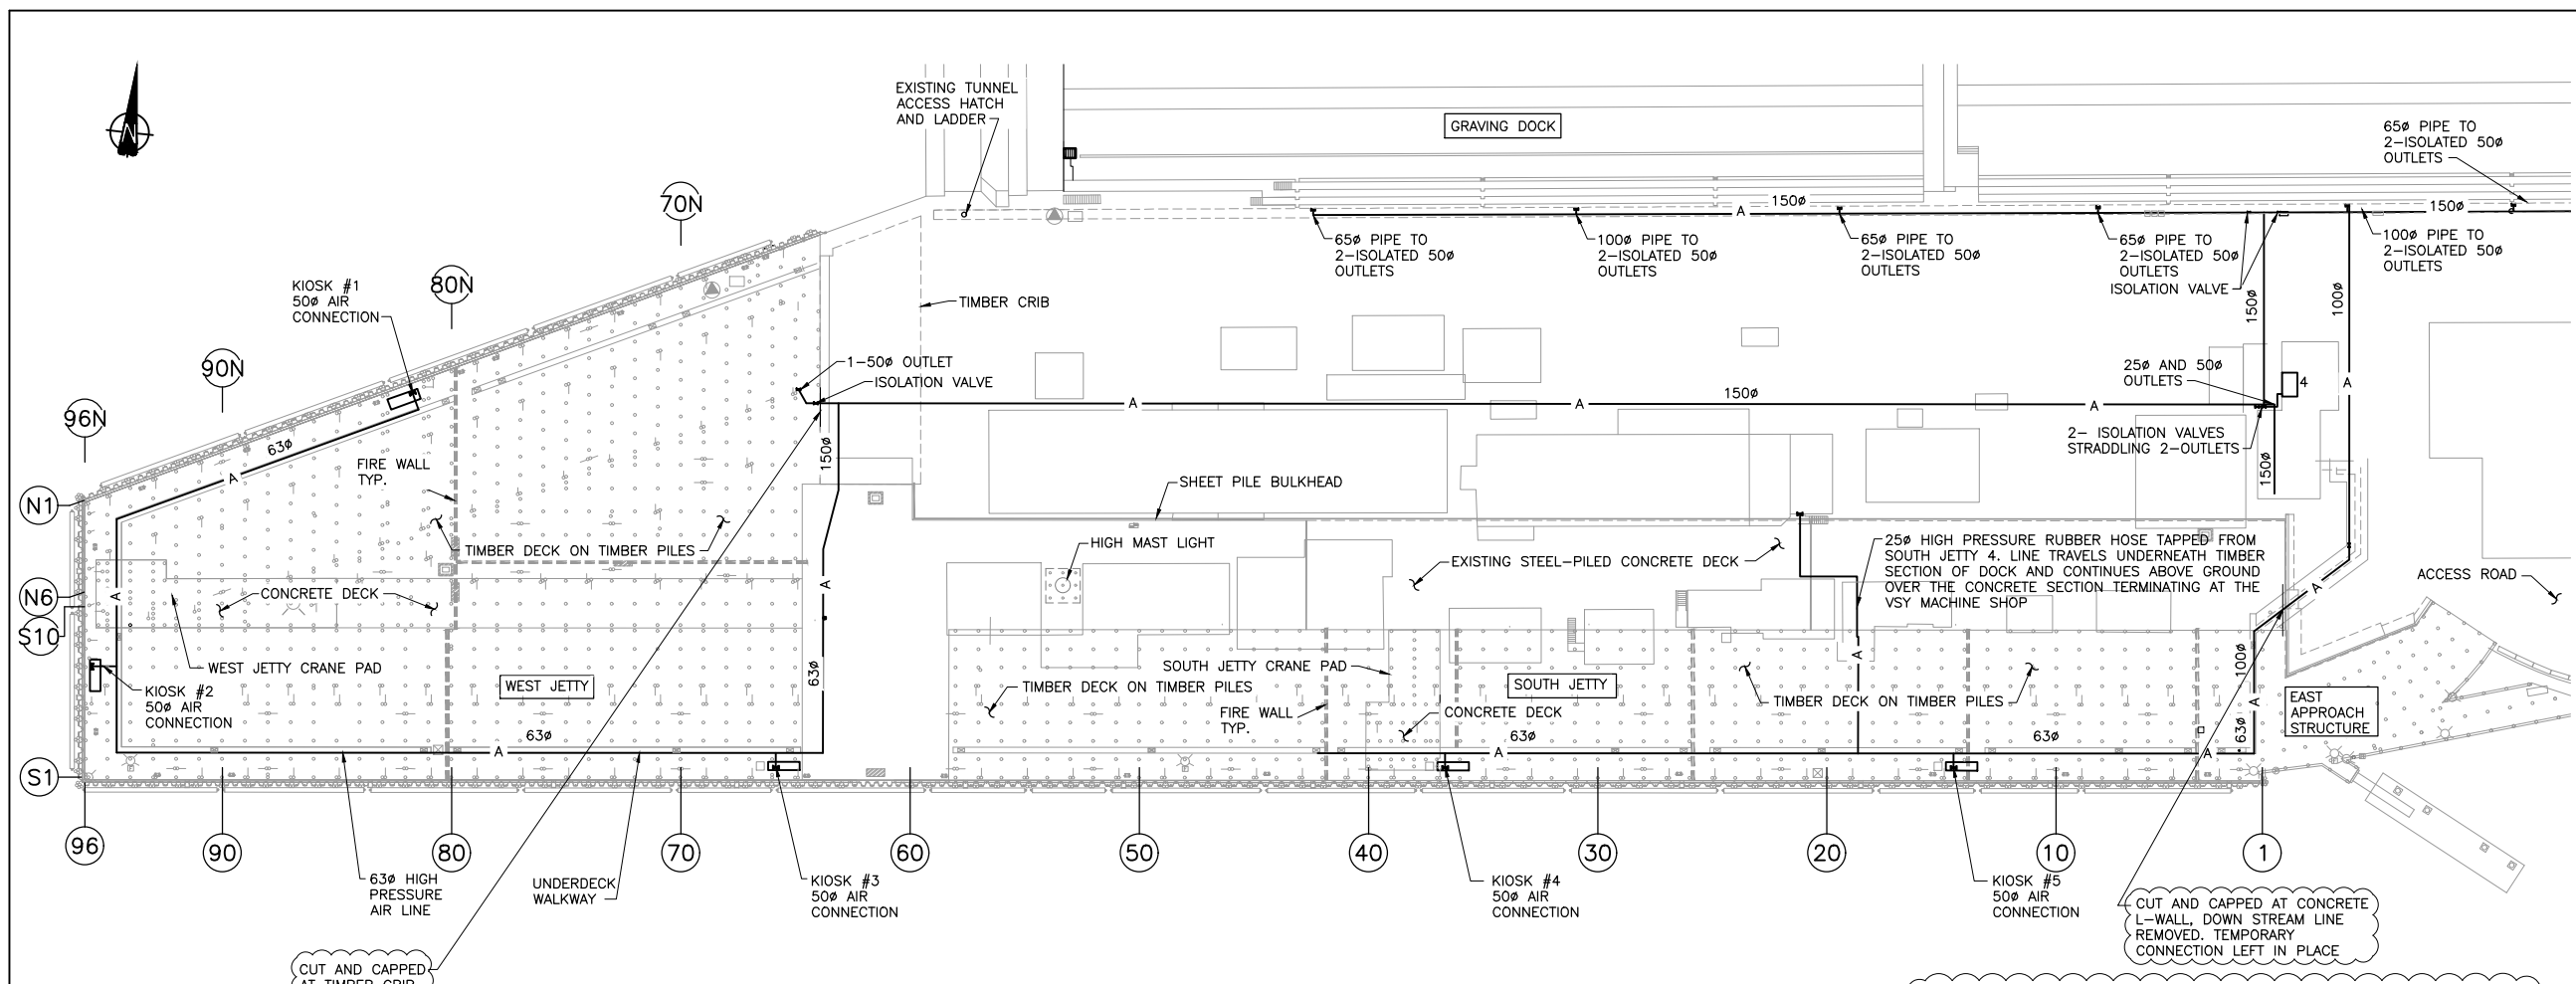

PLAN
1:500



NOTES:

1. EXACT LAYOUT MAY VARY. CONTRACTOR TO FIELD VERIFY ALL DETAILS.
2. FOR KIOSK CONNECTION DETAILS, SEE DWG. M1.
3. REFER TO DWGS. D4 & D5 FOR DEMOLITION.
4. ALL EXISTING UTILITIES ARE SHOWN ACCORDING TO AVAILABLE RECORD DRAWINGS. THE CONTRACTOR SHALL LOCATE ALL EXISTING UTILITIES PRIOR TO CONSTRUCTION, INCLUDING UNDERGROUND FIRE WATER, SANITARY SEWER, COMPRESSED AIR, POWER AND TELEPHONE SERVICE DUCTS AND SHALL NOTIFY THE DEPARTMENTAL REPRESENTATIVE OF ANY DISCREPANCIES OR CONFLICTS A MINIMUM OF 72 HOURS PRIOR TO CONSTRUCTION. ANY ADDITIONAL WORK REQUIRED AS A RESULT OF FAILING TO PRE-LOCATE KNOWN OR POTENTIAL CONFLICTS WILL BE COMPLETED AT THE CONTRACTOR'S EXPENSE.

LEGEND

—A—X— EXISTING AIR LINE / VALVE

Revision/	Description/Description	Date/Date
1	RECORD DRAWING	2017/03/28
0	ISSUED FOR TENDER	2014/12/18


Client/client
PUBLIC WORKS AND GOVERNMENT SERVICES CANADA


Project title/Titre du projet
ESQUIMALT GRAVING DOCK
 825 ADMIRALS ROAD, VICTORIA, BC
ESQUIMALT GRAVING DOCK WATERLOT PHASE 2
SOUTH JETTY UNDER-PIER SEDIMENT REMEDIATION

Consultant Signature Only
 Designed by/Concept par
 ANDREW MACK / DOUG SHARPE
 Drawn by/Desainé par
 GABE MENDES
 PWGSC Project Manager/Administrateur de Projets TPSGC
 ANDREW MYLLY
 Regional Manager, Environmental Services
 COLLIN KINGMAN



Drawing title/Titre du dessin
EXISTING SERVICES
COMPRESSED AIR
PLAN

Project No./No. du projet	Sheet/	Revision no./
R.018400.002	M3	1

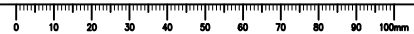

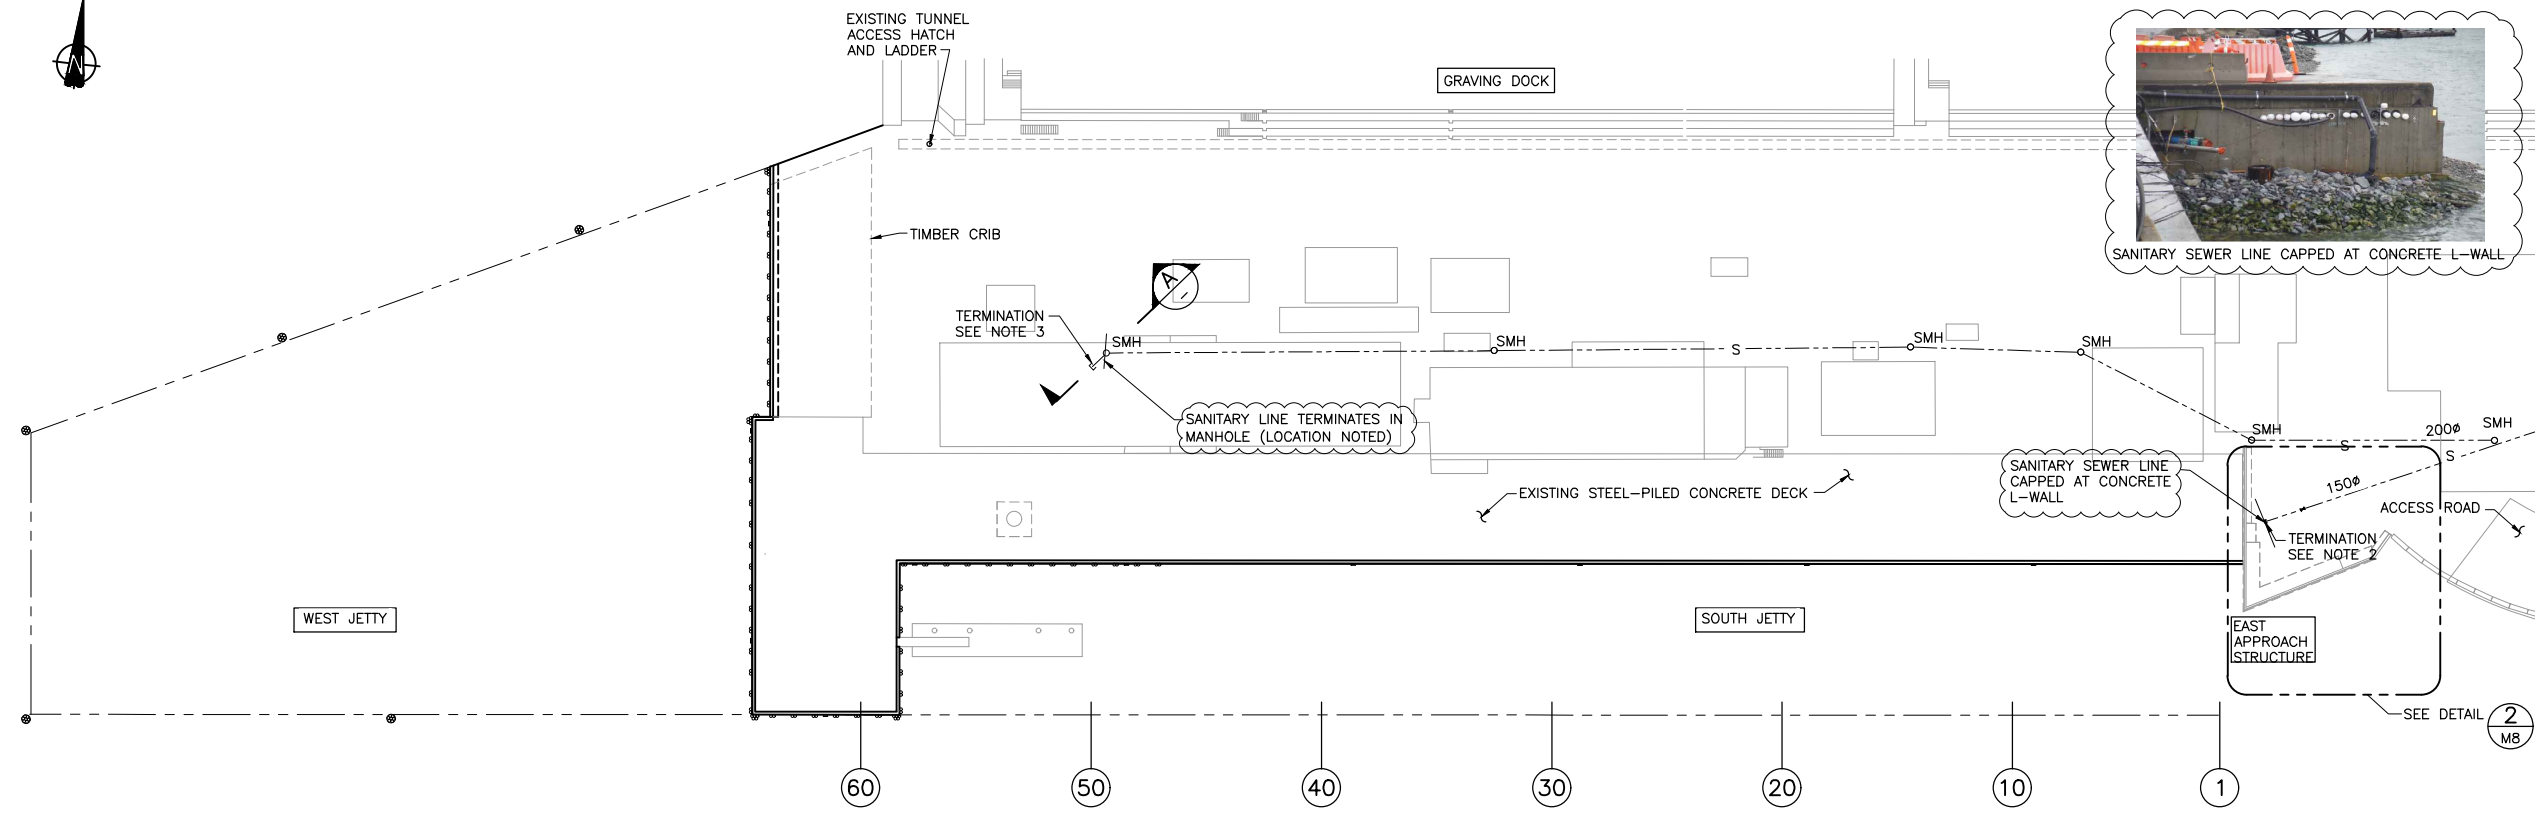

PLAN
1:500

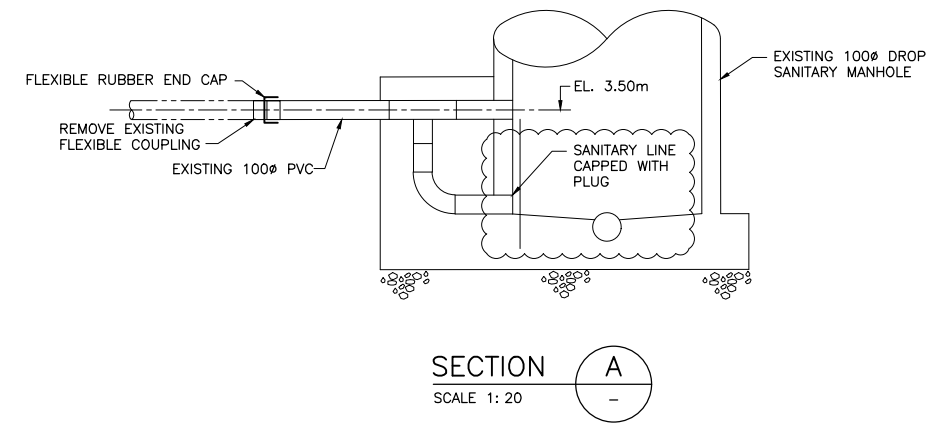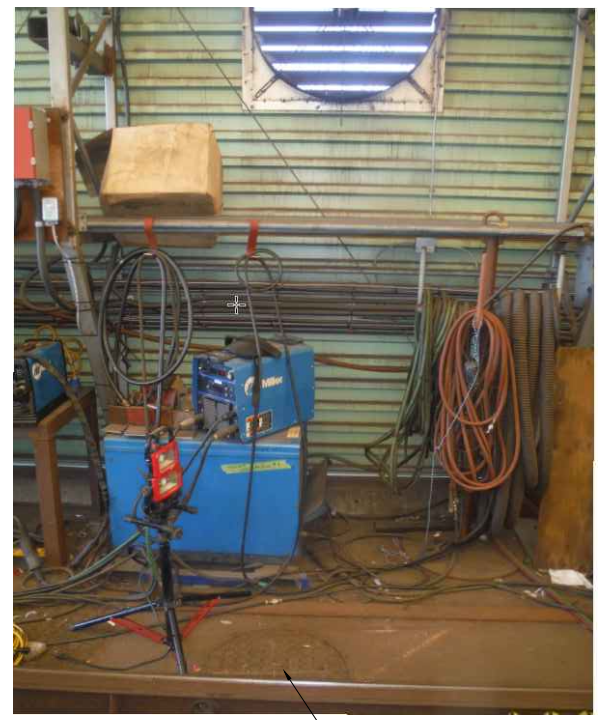

SECTION A
SCALE 1:20



SANITARY LINE PLUG

LEGEND

— S — SMH EXISTING SANITARY SEWER / MANHOLE

NOTES:

1. ALL EXISTING UTILITIES ARE SHOWN ACCORDING TO AVAILABLE RECORD DRAWINGS. THE CONTRACTOR SHALL LOCATE ALL EXISTING UTILITIES PRIOR TO CONSTRUCTION, INCLUDING UNDERGROUND FIRE WATER, SANITARY SEWER, COMPRESSED AIR, POWER AND TELEPHONE SERVICE DUCTS AND SHALL NOTIFY THE DEPARTMENTAL REPRESENTATIVE OF ANY DISCREPANCIES OR CONFLICTS A MINIMUM OF 72 HOURS PRIOR TO CONSTRUCTION. ANY ADDITIONAL WORK REQUIRED AS A RESULT OF FAILING TO PRE-LOCATE KNOWN OR POTENTIAL CONFLICTS WILL BE COMPLETED AT THE CONTRACTOR'S EXPENSE.
2. 150mm ϕ SANITARY WATER LINE TO BE TERMINATED AND CAPPED WITH FLEXIBLE RUBBER END CAP APPROXIMATELY 2.0m BEHIND THE CONCRETE L-WALL.
3. 100mm ϕ SANITARY WATER LINE RUNNING DIAGONALLY UNDER THE STEEL-PILED DECK FORMERLY SERVICING KIOSK #3 TO BE TERMINATED AND CAPPED WITH FLEXIBLE RUBBER END CAP AFTER TRANSITION FROM EXISTING DIAGONAL RUN, AT LOCATION OF EXISTING FLEXIBLE COUPLING UPSTREAM OF MANHOLE.
4. EXCAVATION LIMIT AND PAYMENT LINE FOR SANITARY SEWER TERMINATIONS SHALL EXTEND 1000mm RADIUS AROUND CAP IN PLAN.



SANITARY SEWER LINE CAPPED AT CONCRETE L-WALL

Revision/Revision	Description/Description	Date/Date
1	RECORD DRAWING	2017/03/28
0	ISSUED FOR TENDER	2014/12/18


Client/client
PUBLIC WORKS AND GOVERNMENT SERVICES CANADA


Project title/Titre du projet
**ESQUIMALT GRAVING DOCK
825 ADMIRALS ROAD, VICTORIA, BC**
**ESQUIMALT GRAVING DOCK WATERLOT PHASE 2
SOUTH JETTY UNDER-PIER
SEDIMENT REMEDIATION**

Consultant Signature Only
Designed by/Concept par
ANDREW MACK / DOUG SHARPE
Drawn by/Desainé par
GABE MENDES
PWGSC Project Manager/Administrateur de Projets TPSGC
ANDREW MYLLY
Regional Manager, Environmental Services
COLLIN KINGMAN

Drawing title/Titre du dessin
**SERVICES
SANITARY SEWER
PLAN AND SECTION**

Project No./No. du projet R.018400.002	Sheet/ M5	Revision no./ 1
--------------------------------------------------	---------------------	---------------------------

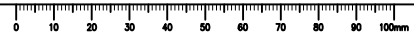


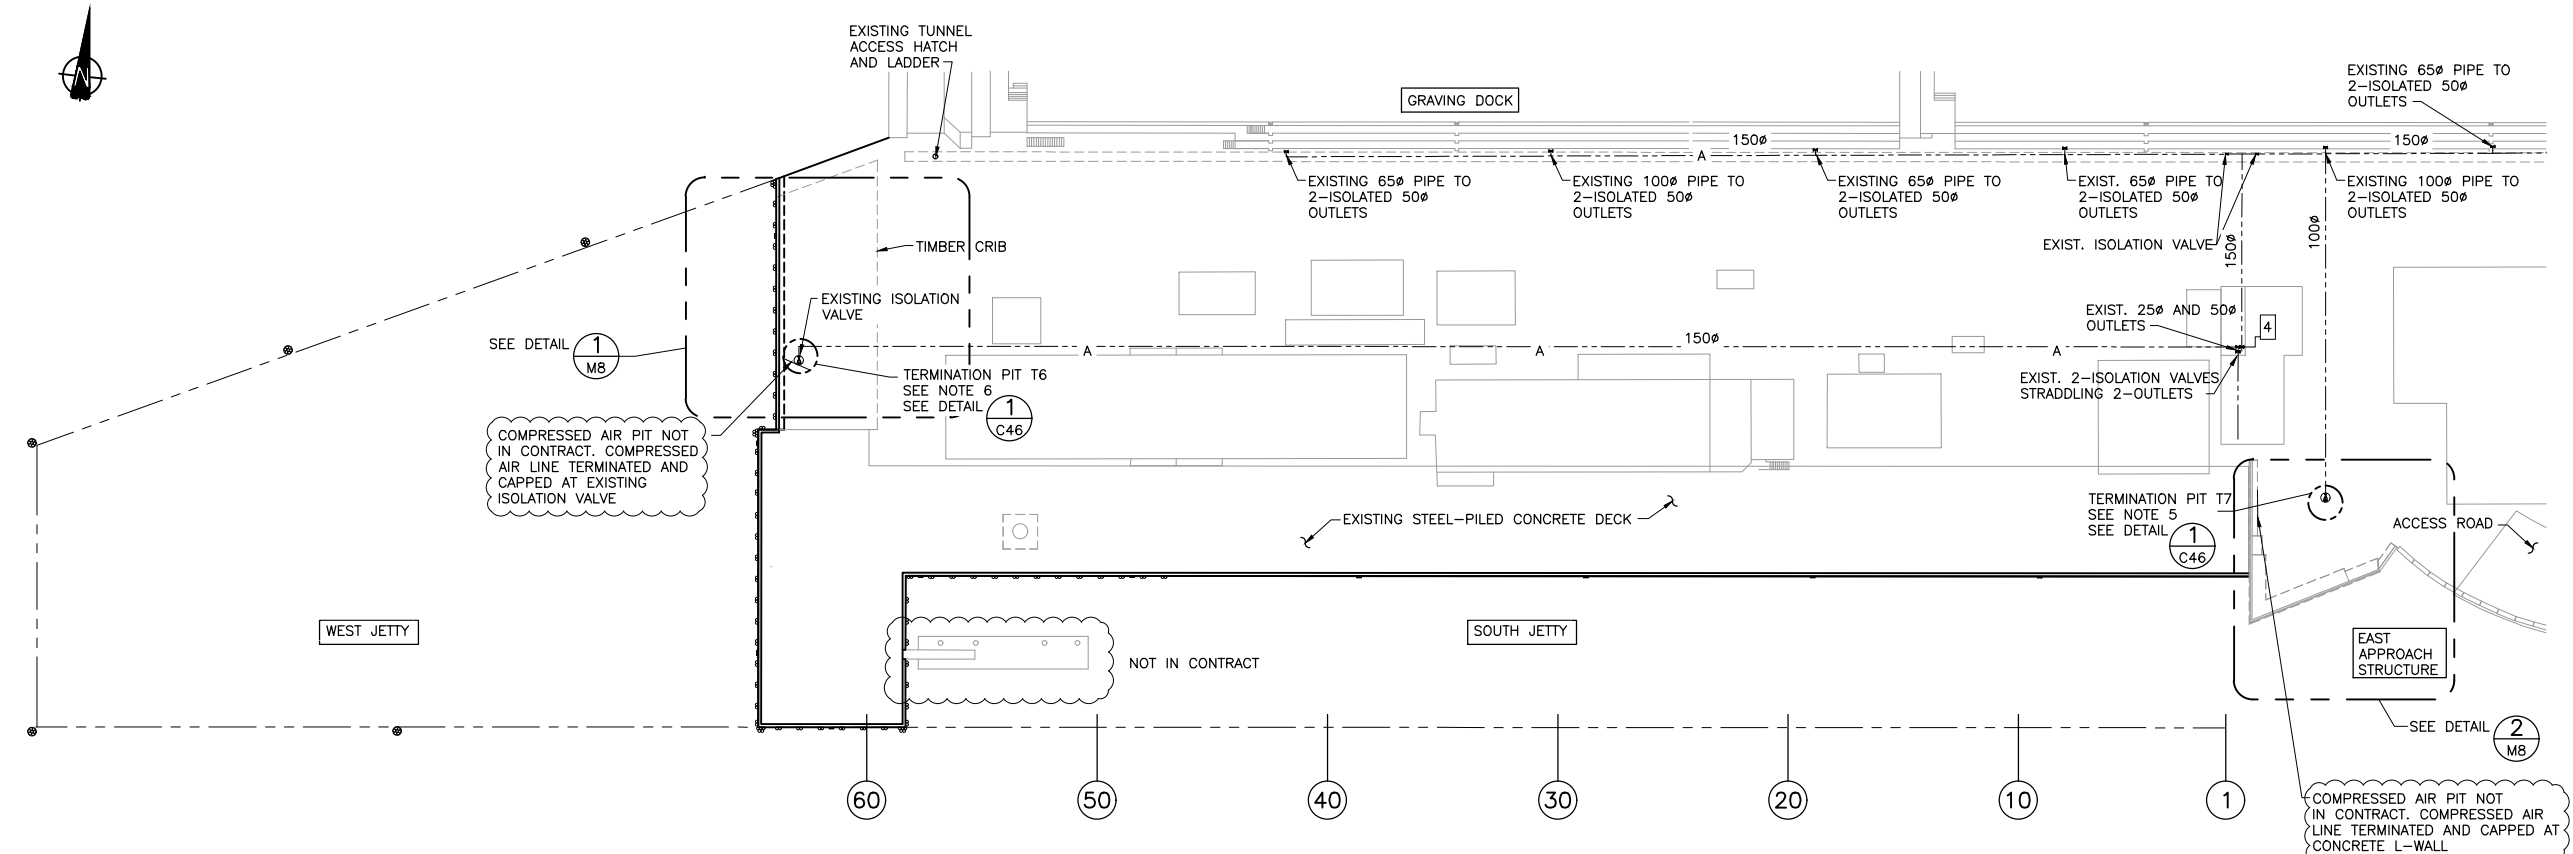

COMPRESSED AIR PIT NOT IN CONTRACT. COMPRESSED AIR LINE TERMINATED AND CAPPED AT EXISTING ISOLATION VALVE

COMPRESSED AIR PIT NOT IN CONTRACT. COMPRESSED AIR LINE TERMINATED AND CAPPED AT CONCRETE L-WALL

PLAN
1:500

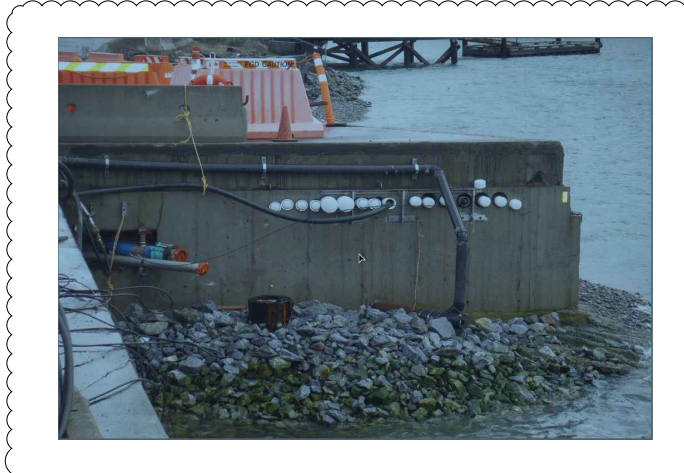

LEGEND

---A--- EXISTING AIR LINE / VALVE

NOTES:

1. SURFACE RUN PIPE TO BE SCH 40 GALVANIZED STEEL WITH GROOVED END MECHANICAL CONNECTIONS.
2. BURIED PIPE TO BE SCH 10 316 SS WITH GROOVED END MECHANICAL CONNECTIONS.
3. ALL EXISTING UTILITIES ARE SHOWN ACCORDING TO AVAILABLE RECORD DRAWINGS. THE CONTRACTOR SHALL LOCATE ALL EXISTING UTILITIES PRIOR TO CONSTRUCTION, INCLUDING UNDERGROUND FIRE WATER, SANITARY SEWER, COMPRESSED AIR, POWER AND TELEPHONE SERVICE DUCTS AND SHALL NOTIFY THE DEPARTMENTAL REPRESENTATIVE OF ANY DISCREPANCIES OR CONFLICTS A MINIMUM OF 72 HOURS PRIOR TO CONSTRUCTION. ANY ADDITIONAL WORK REQUIRED AS A RESULT OF FAILING TO PRE-LOCATE KNOWN OR POTENTIAL CONFLICTS WILL BE COMPLETED AT THE CONTRACTOR'S EXPENSE.
4. METALLIC PIPE, SUPPORTS AND OTHER MISCELLANEOUS METAL SHALL BE GROUNDED PER THE CANADIAN ELECTRICAL CODE.
5. AIR LINE TO BE TERMINATED AND CAPPED BEHIND THE CONCRETE L-WALL IN A TERMINATION PIT. INSTALL 13mm DOWNWARD FACING PIPE WITH ISOLATION VALVE AND OPEN END FOR CLEARING LINE OF CONDENSATE.
6. AIR LINE THAT CROSSES UNDER STEEL PILED DECK TO BE REMOVED AND CAPPED DOWNSTREAM OF EXISTING ISOLATION VALVE IN A TERMINATION PIT. INSTALL 13mm DOWNWARD FACING PIPE WITH ISOLATION VALVE AND OPEN END OF CLEARING LINE OF CONDENSATE.

TERMINATION PIT PROVIDED TO PWGSC. INSTALLATION OF TERMINATION PIT (T6) NOT IN CONTRACT

Revision/Revision	Description/Description	Date/Date
1	RECORD DRAWING	2017/03/28
0	ISSUED FOR TENDER	2014/12/18

Client/client
PUBLIC WORKS AND GOVERNMENT SERVICES CANADA


Project title/Titre du projet
ESQUIMALT GRAVING DOCK
 825 ADMIRALS ROAD, VICTORIA, BC

ESQUIMALT GRAVING DOCK WATERLOT PHASE 2 SOUTH JETTY UNDER-PIER SEDIMENT REMEDIATION

Consultant Signature Only
 Designed by/Concept par
 ANDREW MACK / DOUG SHARPE
 Drawn by/Desainé par
 GABE MENDES
 PWGSC Project Manager/Administrateur de Projets TPSGC
 ANDREW MYLLY
 Regional Manager, Environmental Services
 COLLIN KINGMAN


Drawing title/Titre du dessin
SERVICES COMPRESSED AIR PLAN

Project No./No. du projet	Sheet/feuille	Revision no./révision
R.018400.002	M6	1

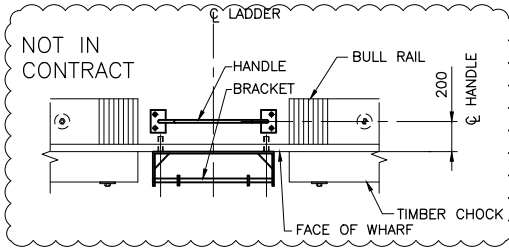


DETAIL 1
 SCALE 1: 25
 S128
 4 - TYPE 1 REQUIRED
 6 - TYPE 2 REQUIRED


19mmØ HOLES ATTACH TO T.O. DECK WITH 15.9Øx230 LONG THREAD RODS C/W WASHER & HEX NUT IN 19Øx200 DEEP HOLES. GROUT WITH EPOXY ADHESIVE.

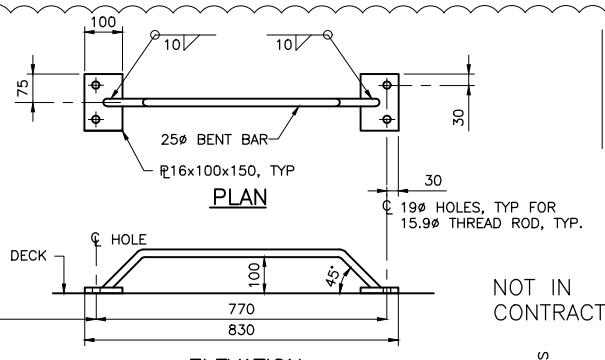


ELEVATION HANDLE
 1:10

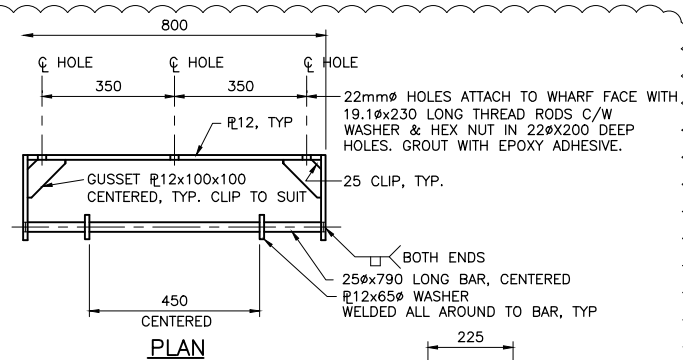


BRACKET
 1:10
 NOTE:
 ALL WELDS SHALL BE 6mm CONTINUOUS FILLET ALL AROUND U.N.O.

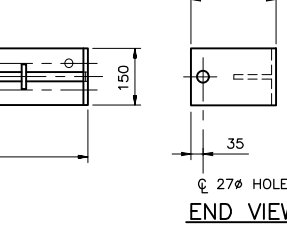


BRACKET END VIEW

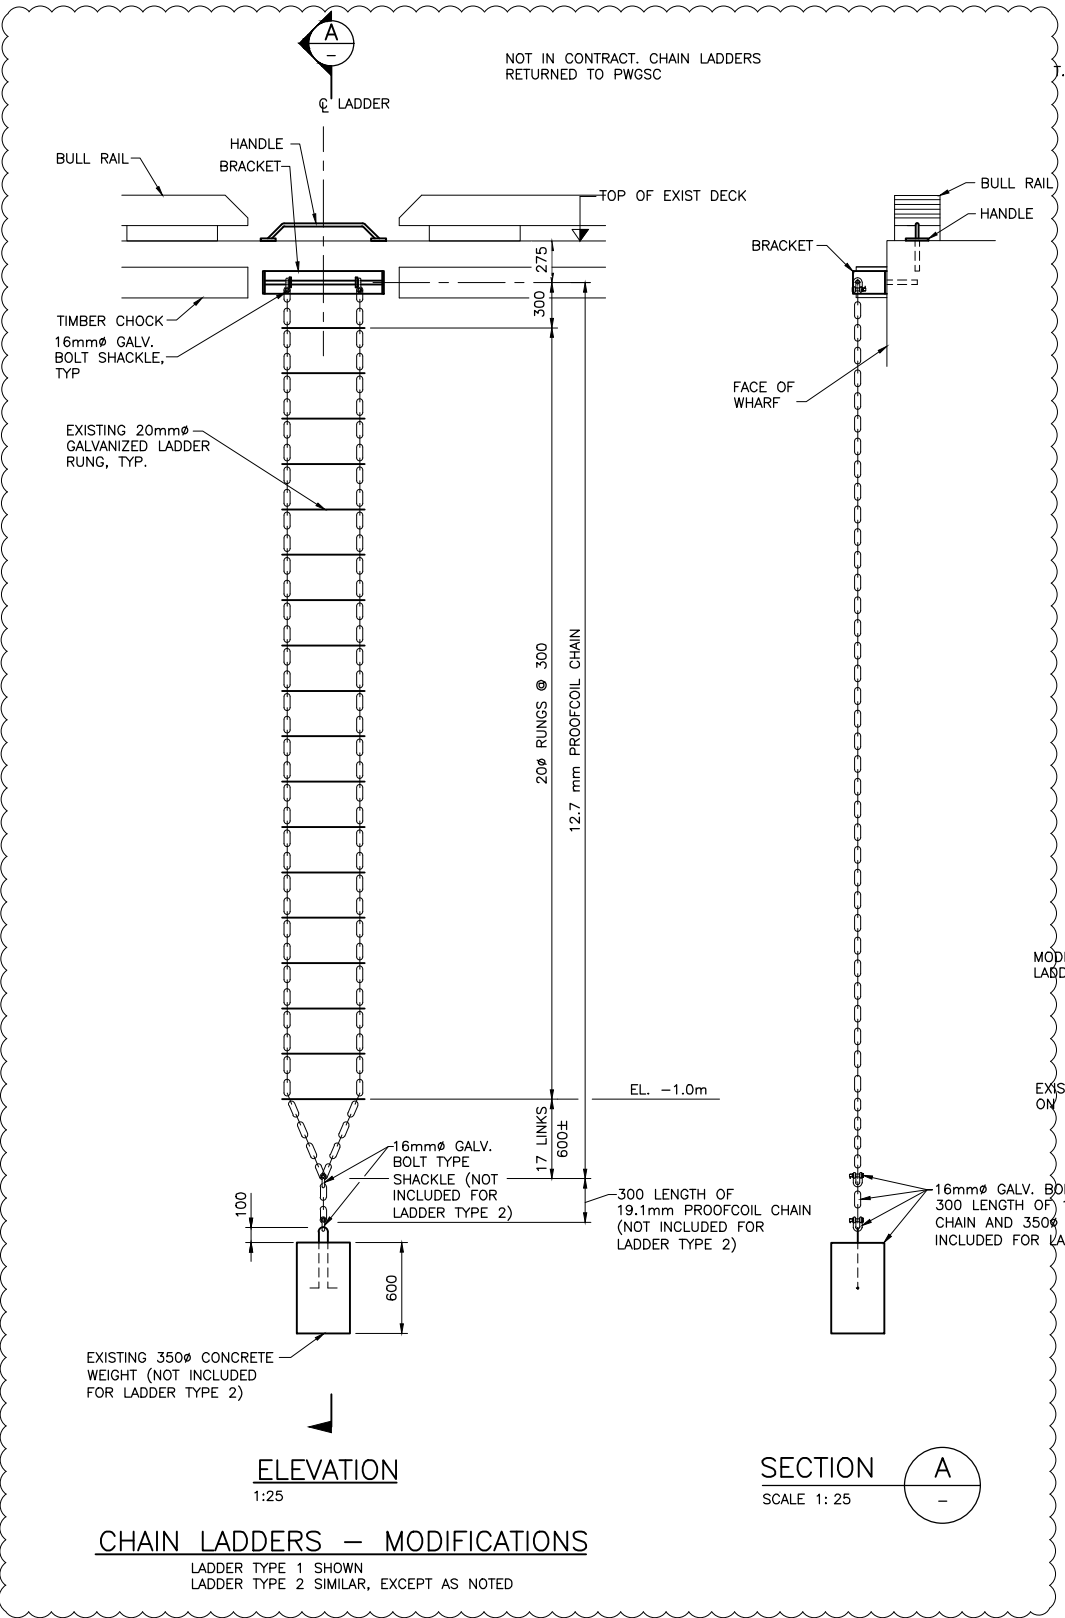

CHAIN LADDERS - MODIFICATIONS
 LADDER TYPE 1 SHOWN
 LADDER TYPE 2 SIMILAR, EXCEPT AS NOTED

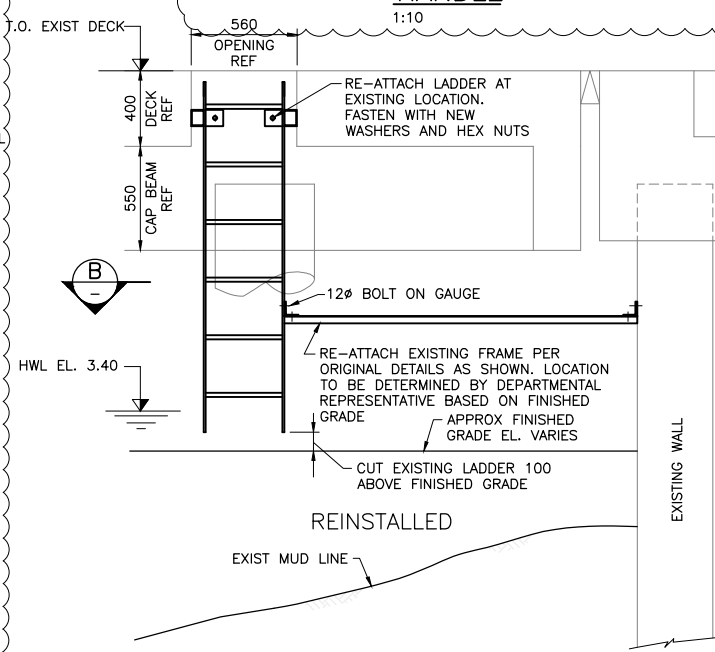


ACCESS LADDERS - MODIFICATIONS
 SCALE 1:20

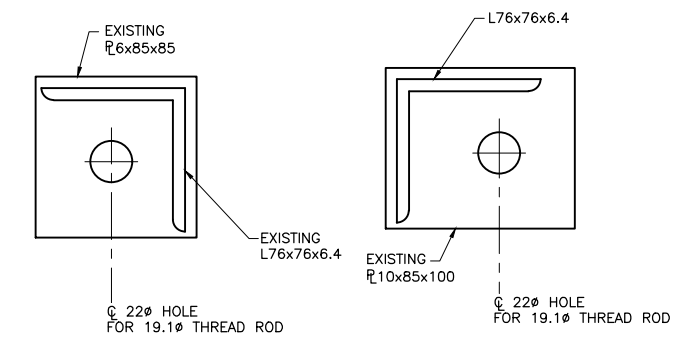


DETAIL 1 SCALE 1: 2
DETAIL 2 SCALE 1: 2

LADDER WAS NOT MODIFIED

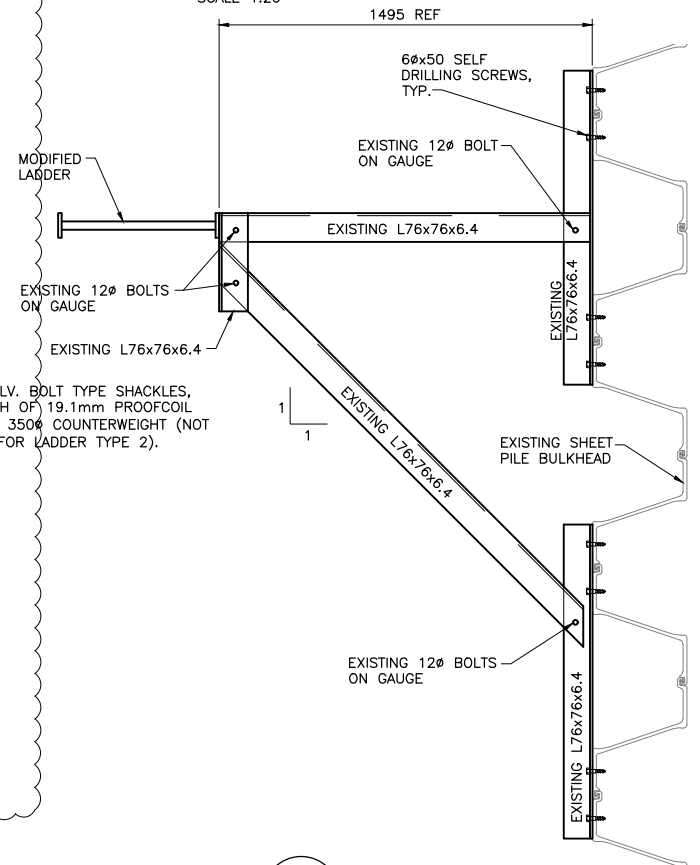

SECTION B AT SHEET PILE WALL
 SCALE 1: 10

LADDER WAS NOT MODIFIED

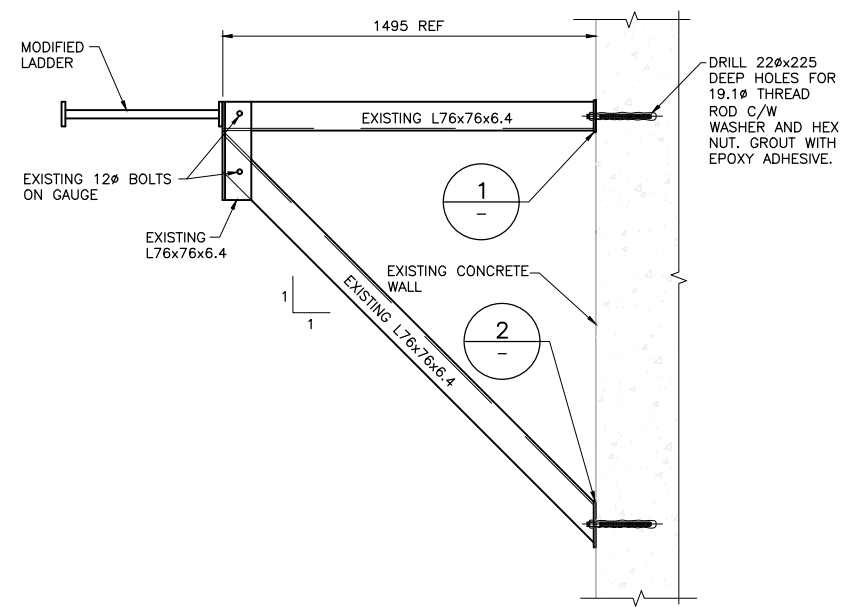

SECTION B AT CONCRETE WALL
 SCALE 1: 10

LADDER WAS NOT MODIFIED

Revision/Revision	Description/Description	Date/Date
1	RECORD DRAWING	2017/03/29
0	ISSUED FOR TENDER	2014/12/19

Client/client
PUBLIC WORKS AND GOVERNMENT SERVICES CANADA


Project title/Titre du projet
ESQUIMALT GRAVING DOCK
 825 ADMIRALS ROAD, VICTORIA, BC

ESQUIMALT GRAVING DOCK WATERLOT PHASE 2
SOUTH JETTY UNDER-PIER SEDIMENT REMEDIATION

Consultant Signature Only
 Designed by/Concept par JANET TONG
 Drawn by/Desainé par ARNIE RIST
 PWGSC Project Manager/Administrateur de Projets TPSGC ANDREW MYLLY
 Regional Manager, Environmental Services COLLIN KINGMAN

Drawing title/Titre du dessin
WEST AND SOUTH JETTY DECK CHAIN LADDER AND ACCESS LADDERS MODIFICATIONS

Project No./No. du projet	Sheet/	Revision no./
R.018400.002	S122	1

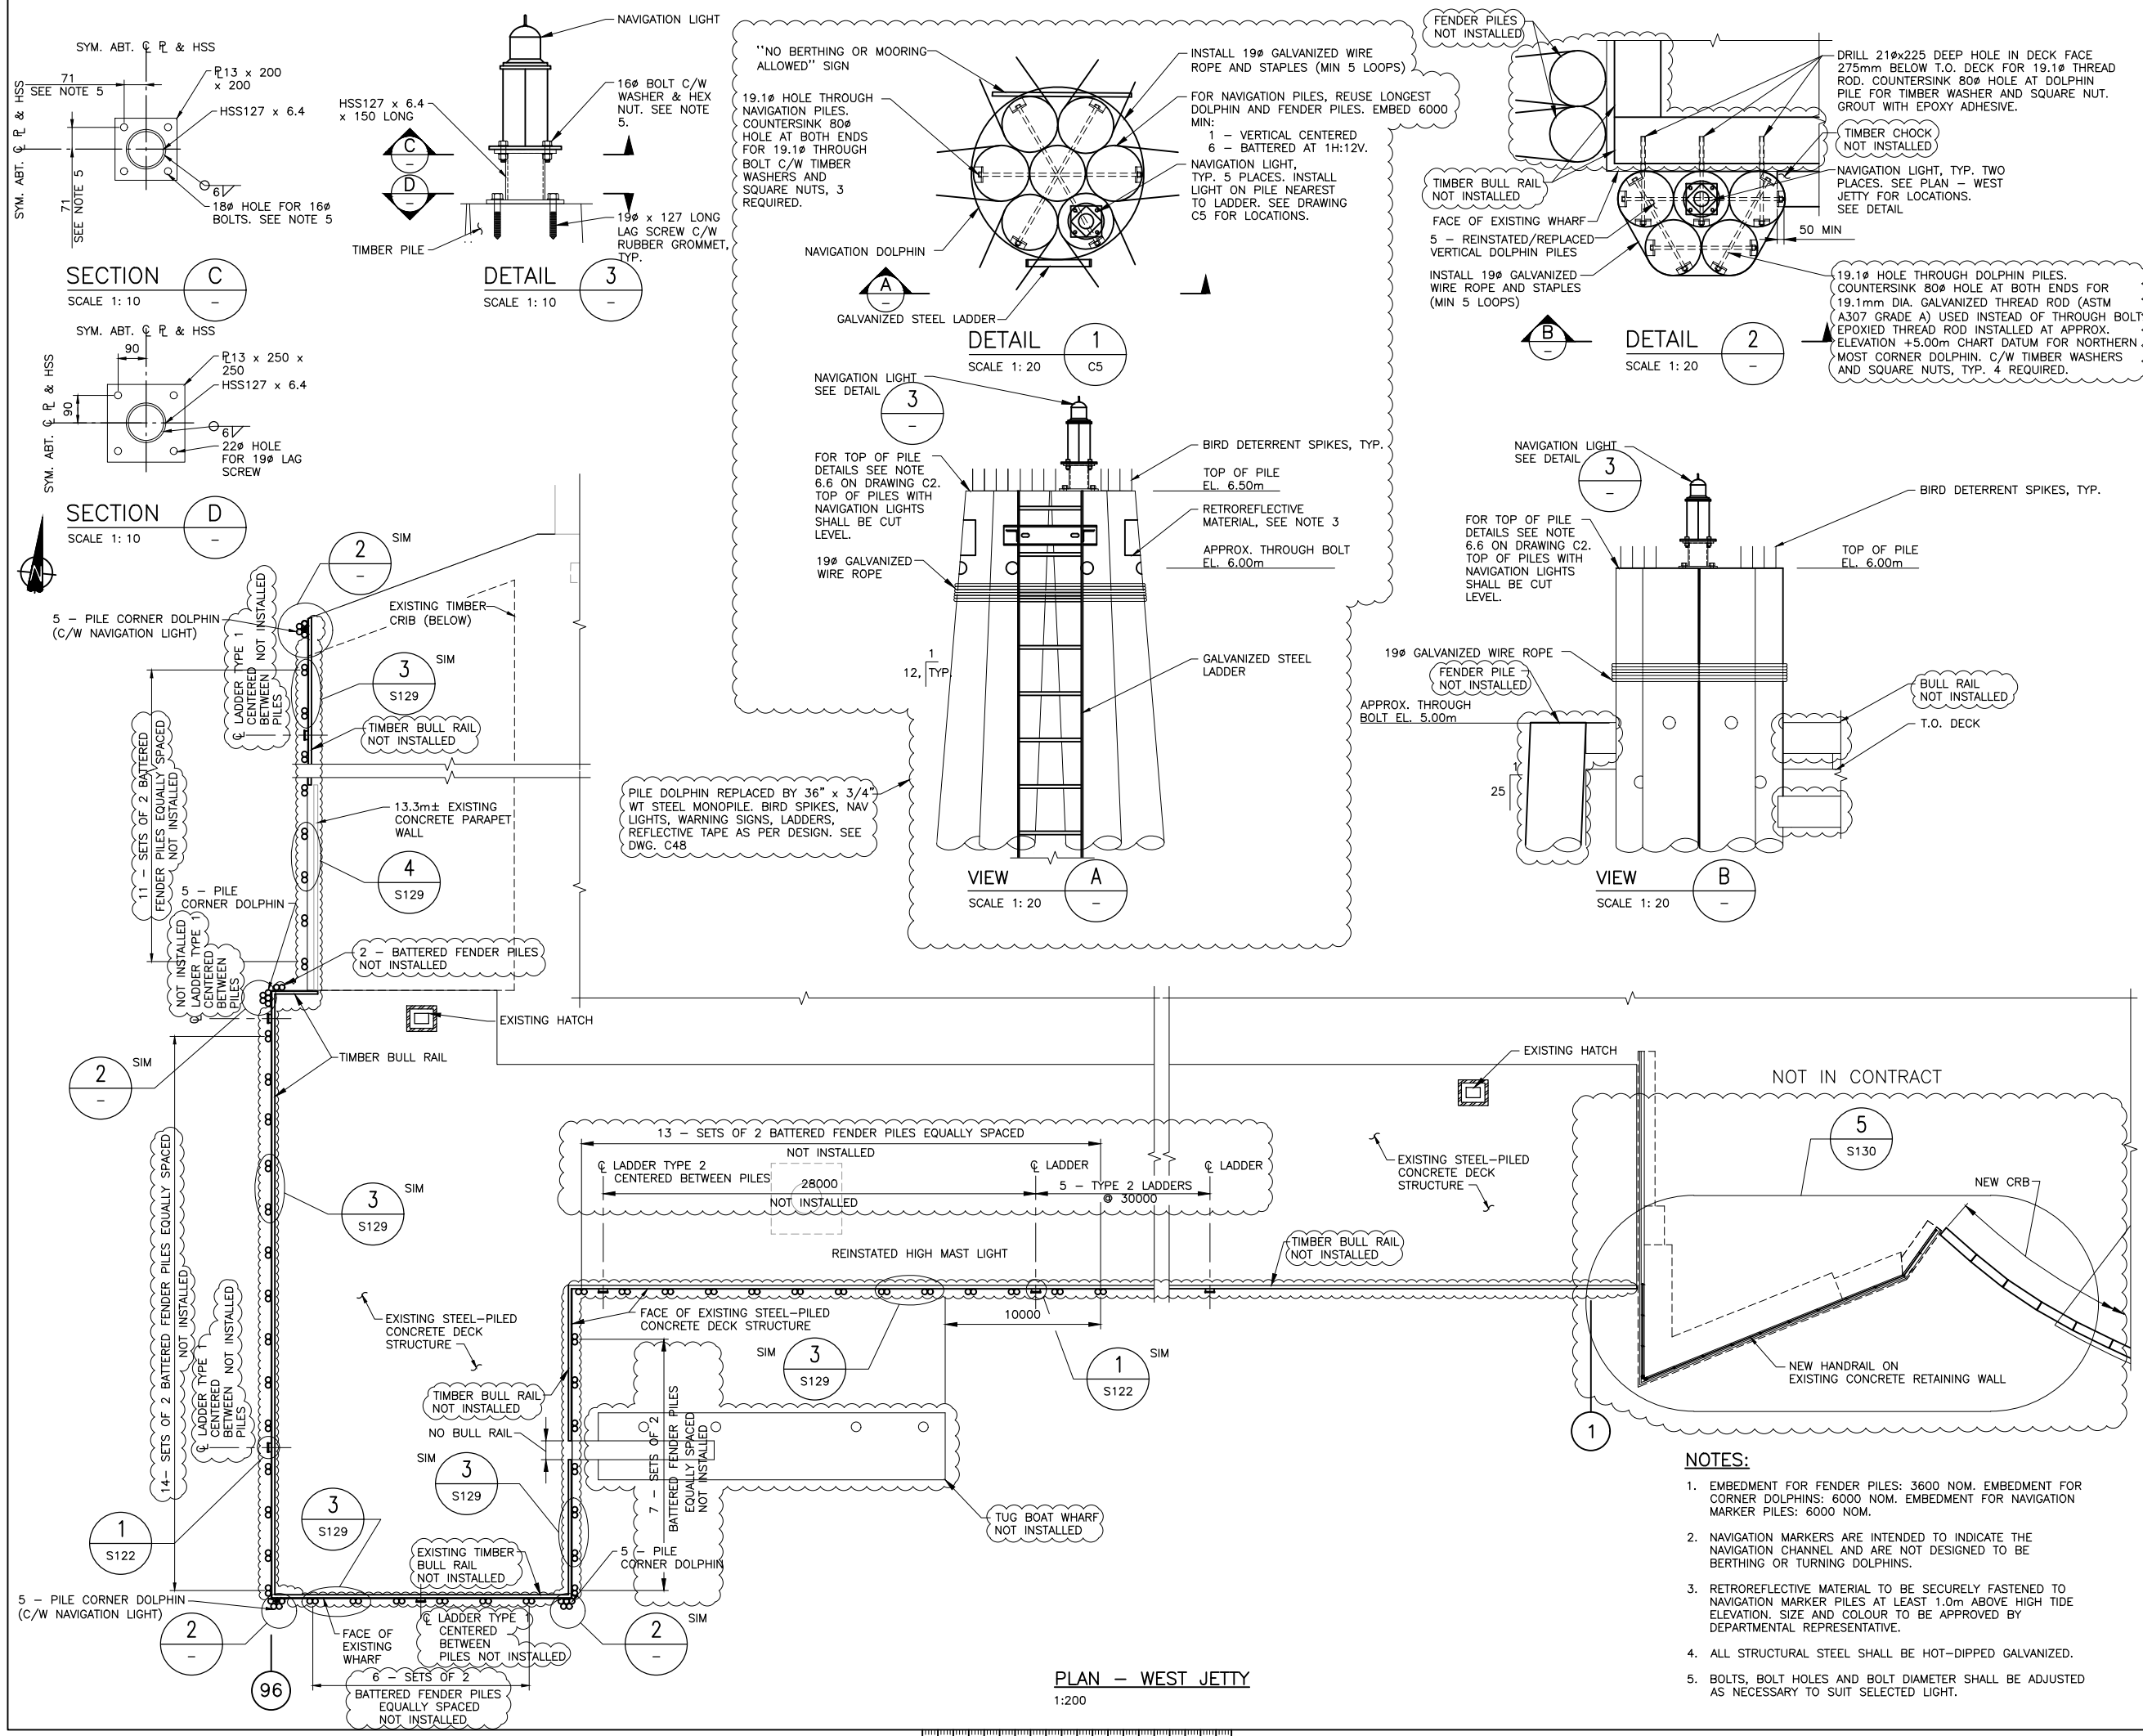

Revision/	Description/Description	Date/Date
2	RECORD DRAWING	2017/03/29
1	ADDENDUM NO. 2	2015/03/31
0	ISSUED FOR TENDER	2014/12/19

Client/client
PUBLIC WORKS AND GOVERNMENT SERVICES CANADA

Project title/Titre du projet
ESQUIMALT GRAVING DOCK
 825 ADMIRALS ROAD, VICTORIA, BC


ESQUIMALT GRAVING DOCK WATERLOT PHASE 2 SOUTH JETTY UNDER-PIER SEDIMENT REMEDIATION

Consultant Signature Only
 Designed by/Concept par
 KRISTIN GREINACHER
 Drawn by/Desainé par
 ARNIE RIST
 PWSC Project Manager/Administrateur de Projets TPSGC
 ANDREW MYLLY
 Regional Manager, Environmental Services
 COLLIN KINGMAN


Drawing title/Titre du dessin
FENDERING SHEET 1

Project No./No. du projet R.018400.002	Sheet/ S128	Revision no./ 2
--------------------------------------------------	-----------------------	---------------------------

- NOTES:**
- EMBEDMENT FOR FENDER PILES: 3600 NOM. EMBEDMENT FOR CORNER DOLPHINS: 6000 NOM. EMBEDMENT FOR NAVIGATION MARKER PILES: 6000 NOM.
 - NAVIGATION MARKERS ARE INTENDED TO INDICATE THE NAVIGATION CHANNEL AND ARE NOT DESIGNED TO BE BERTHING OR TURNING DOLPHINS.
 - RETROREFLECTIVE MATERIAL TO BE SECURELY FASTENED TO NAVIGATION MARKER PILES AT LEAST 1.0m ABOVE HIGH TIDE ELEVATION. SIZE AND COLOUR TO BE APPROVED BY DEPARTMENTAL REPRESENTATIVE.
 - ALL STRUCTURAL STEEL SHALL BE HOT-DIPPED GALVANIZED.
 - BOLTS, BOLT HOLES AND BOLT DIAMETER SHALL BE ADJUSTED AS NECESSARY TO SUIT SELECTED LIGHT.

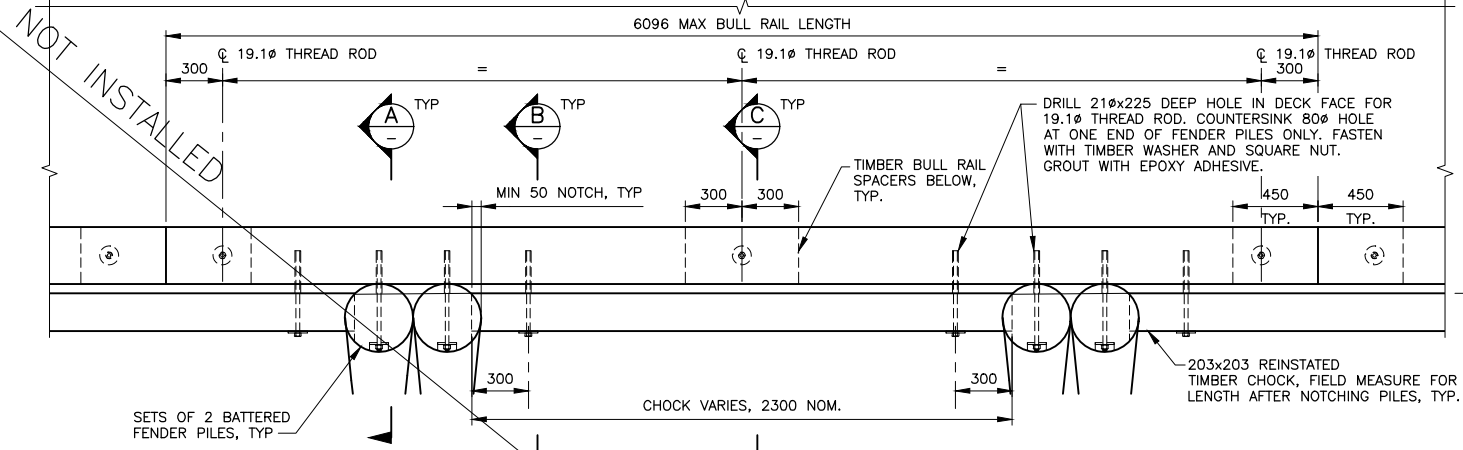


DETAIL 3 TYP BETWEEN LADDERS
 SCALE 1: 20 S128

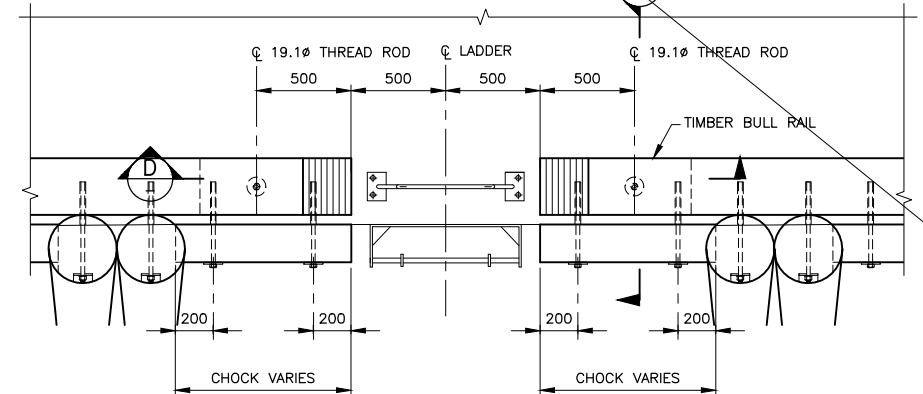


DETAIL 3 TYP AT LADDERS
 SCALE 1: 20 S128
 CONNECTIONS SIMILAR TO SECTION 'A' ABOVE EXCEPT AS SHOWN

NOT IN CONTRACT

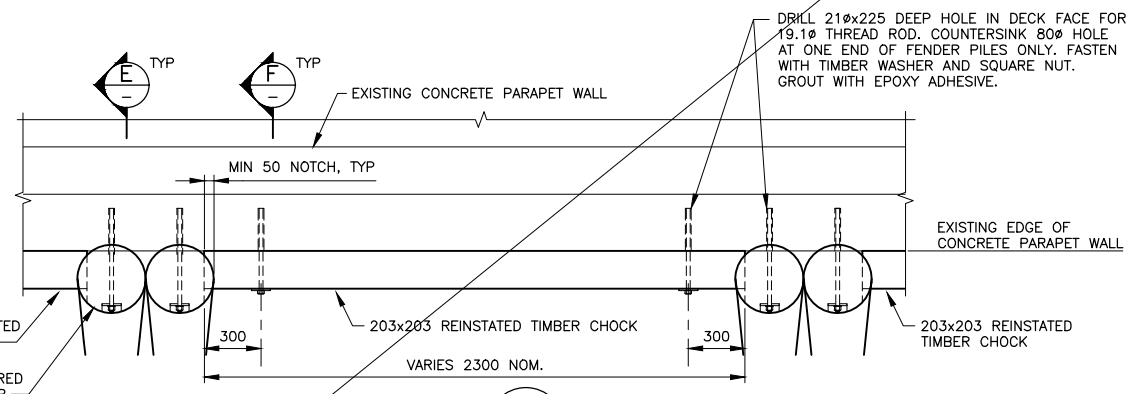


DETAIL 4
 SCALE 1: 20 S128

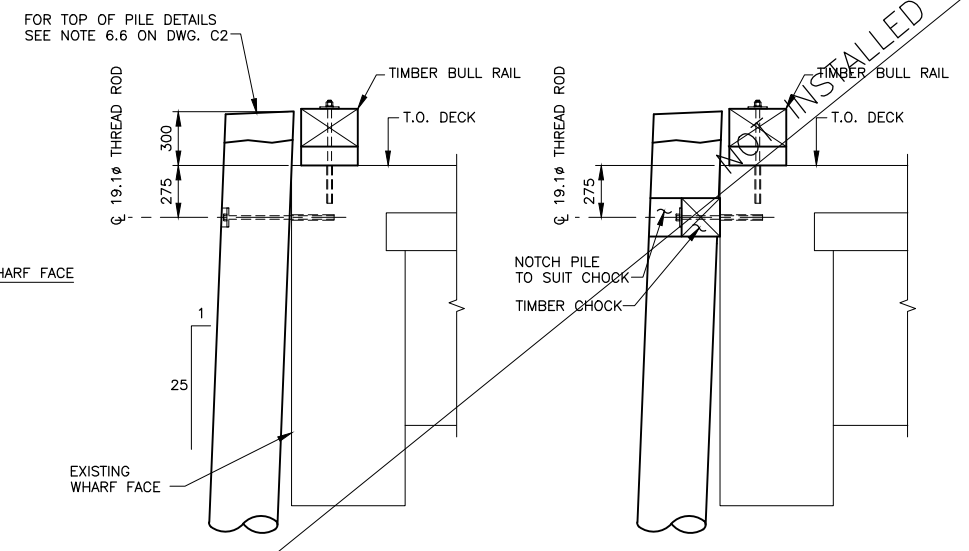


SECTION A
 SCALE 1: 20

SECTION B
 SCALE 1: 20

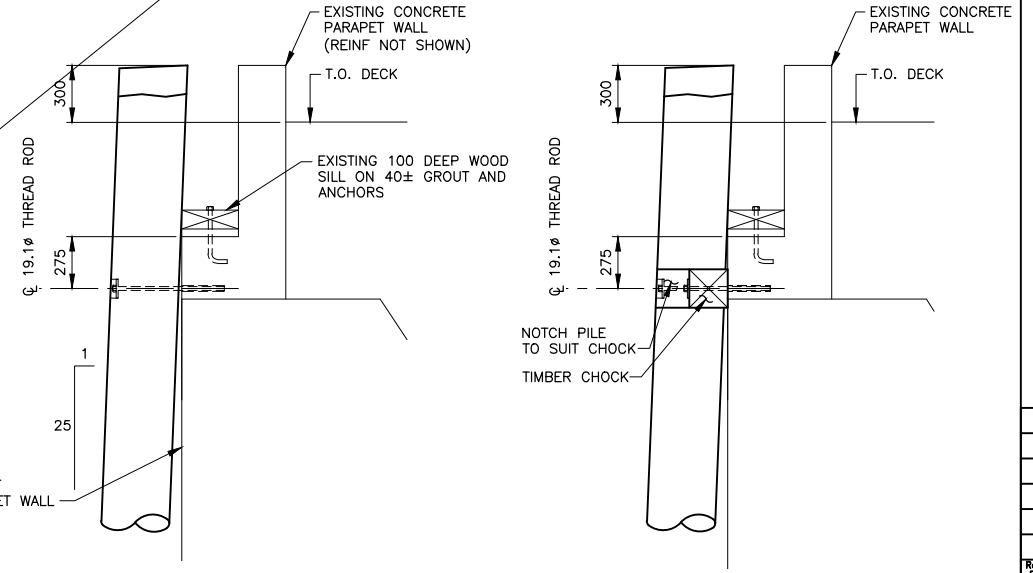


SECTION E
 SCALE 1: 20

SECTION F
 SCALE 1: 20

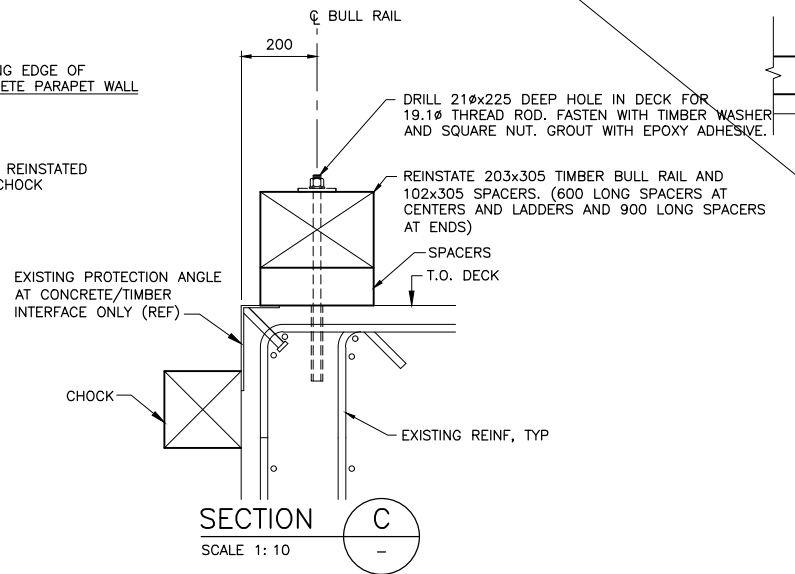

SECTION C
 SCALE 1: 10

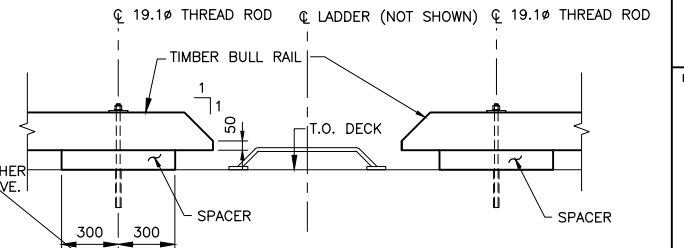

SECTION D
 SCALE 1: 20

NOTES:
 1. SEE DRAWING C2 FOR NOTES.

Revision/Revision	Description/Description	Date/Date
1	RECORD DRAWING	2017/03/29
0	ISSUED FOR TENDER	2014/12/19

PUBLIC WORKS AND GOVERNMENT SERVICES CANADA


Project title/Titre du projet
ESQUIMALT GRAVING DOCK
 825 ADMIRALS ROAD, VICTORIA, BC

ESQUIMALT GRAVING DOCK WATERLOT PHASE 2
SOUTH JETTY UNDER-PIER SEDIMENT REMEDIATION

Consultant Signature Only
 Designed by/Concept par KRISTIN GREINACHER
 Drawn by/Desain par ARNIE RIST
 PWSC Project Manager/Administrateur de Projets TPSGC ANDREW MYLLY
 Regional Manager, Environmental Services COLLIN KINGMAN

Drawing title/Titre du dessin
FENDERING SHEET 2

Project No./No. du projet R.018400.002	Sheet/ S129	Revision no./ 1
--------------------------------------------------	-----------------------	---------------------------

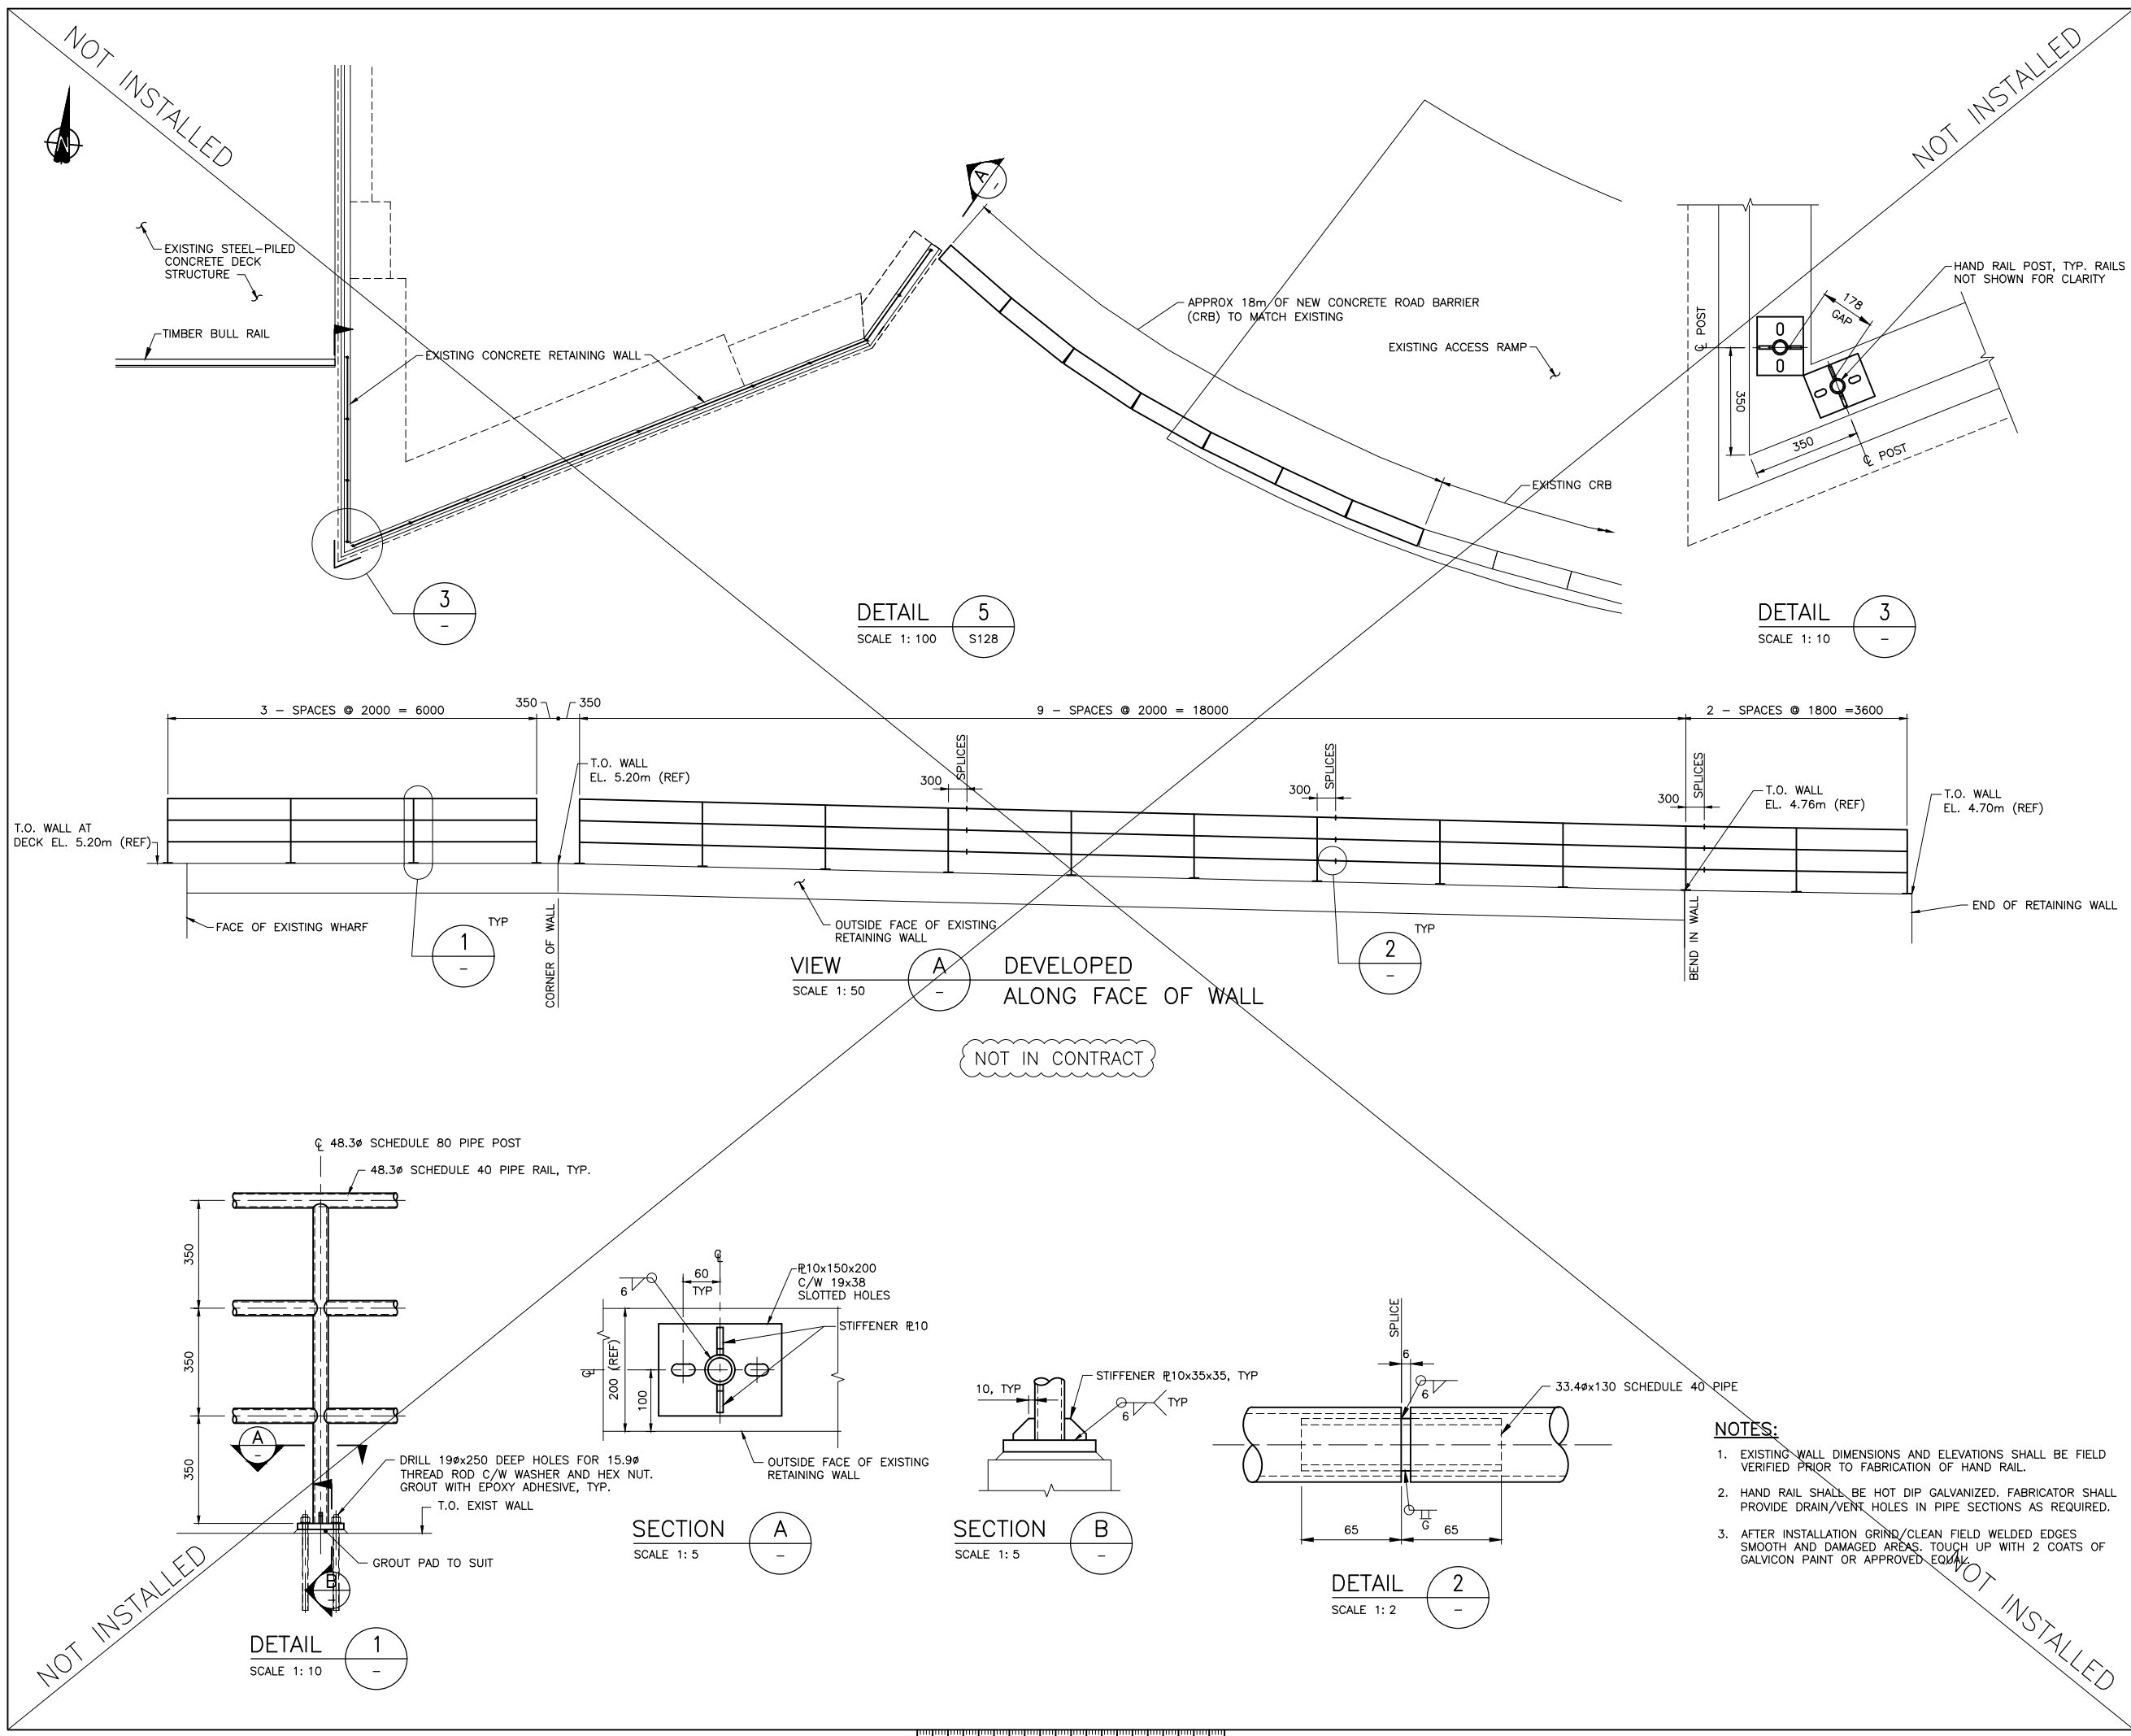

Revision/	Description/Description	Date/Date
1	RECORD DRAWING	2017/03/29
0	ISSUED FOR TENDER	2014/12/19

Client/client
PUBLIC WORKS AND GOVERNMENT SERVICES CANADA

Project title/Titre du projet
**ESQUIMALT GRAVING DOCK
 825 ADMIRALS ROAD, VICTORIA, BC**

**ESQUIMALT GRAVING DOCK
 WATERLOT PHASE 2
 SOUTH JETTY UNDER-PIER
 SEDIMENT REMEDIATION**

Consultant Signature Only

Designed by/Concept par
 KRISTIN GREINACHER

Drawn by/Desainé par
 ARNIE RIST


PWGC Project Manager/Administrateur de Projets TPSCG
 ANDREW MYLLY

Regional Manager, Environmental Services
 COLLIN KINGMAN

Drawing title/Titre du dessin
HAND RAIL

Project No./No. du projet R.018400.002	Sheet/ S130	Revision no./ 1
--------------------------------------------------	-----------------------	---------------------------

- NOTES:**
- EXISTING WALL DIMENSIONS AND ELEVATIONS SHALL BE FIELD VERIFIED PRIOR TO FABRICATION OF HAND RAIL.
 - HAND RAIL SHALL BE HOT DIP GALVANIZED. FABRICATOR SHALL PROVIDE DRAIN/VENT HOLES IN PIPE SECTIONS AS REQUIRED.
 - AFTER INSTALLATION GRIND/CLEAN FIELD WELDED EDGES SMOOTH AND DAMAGED AREAS. TOUCH UP WITH 2 COATS OF GALVICON PAINT OR APPROVED EQUIV.

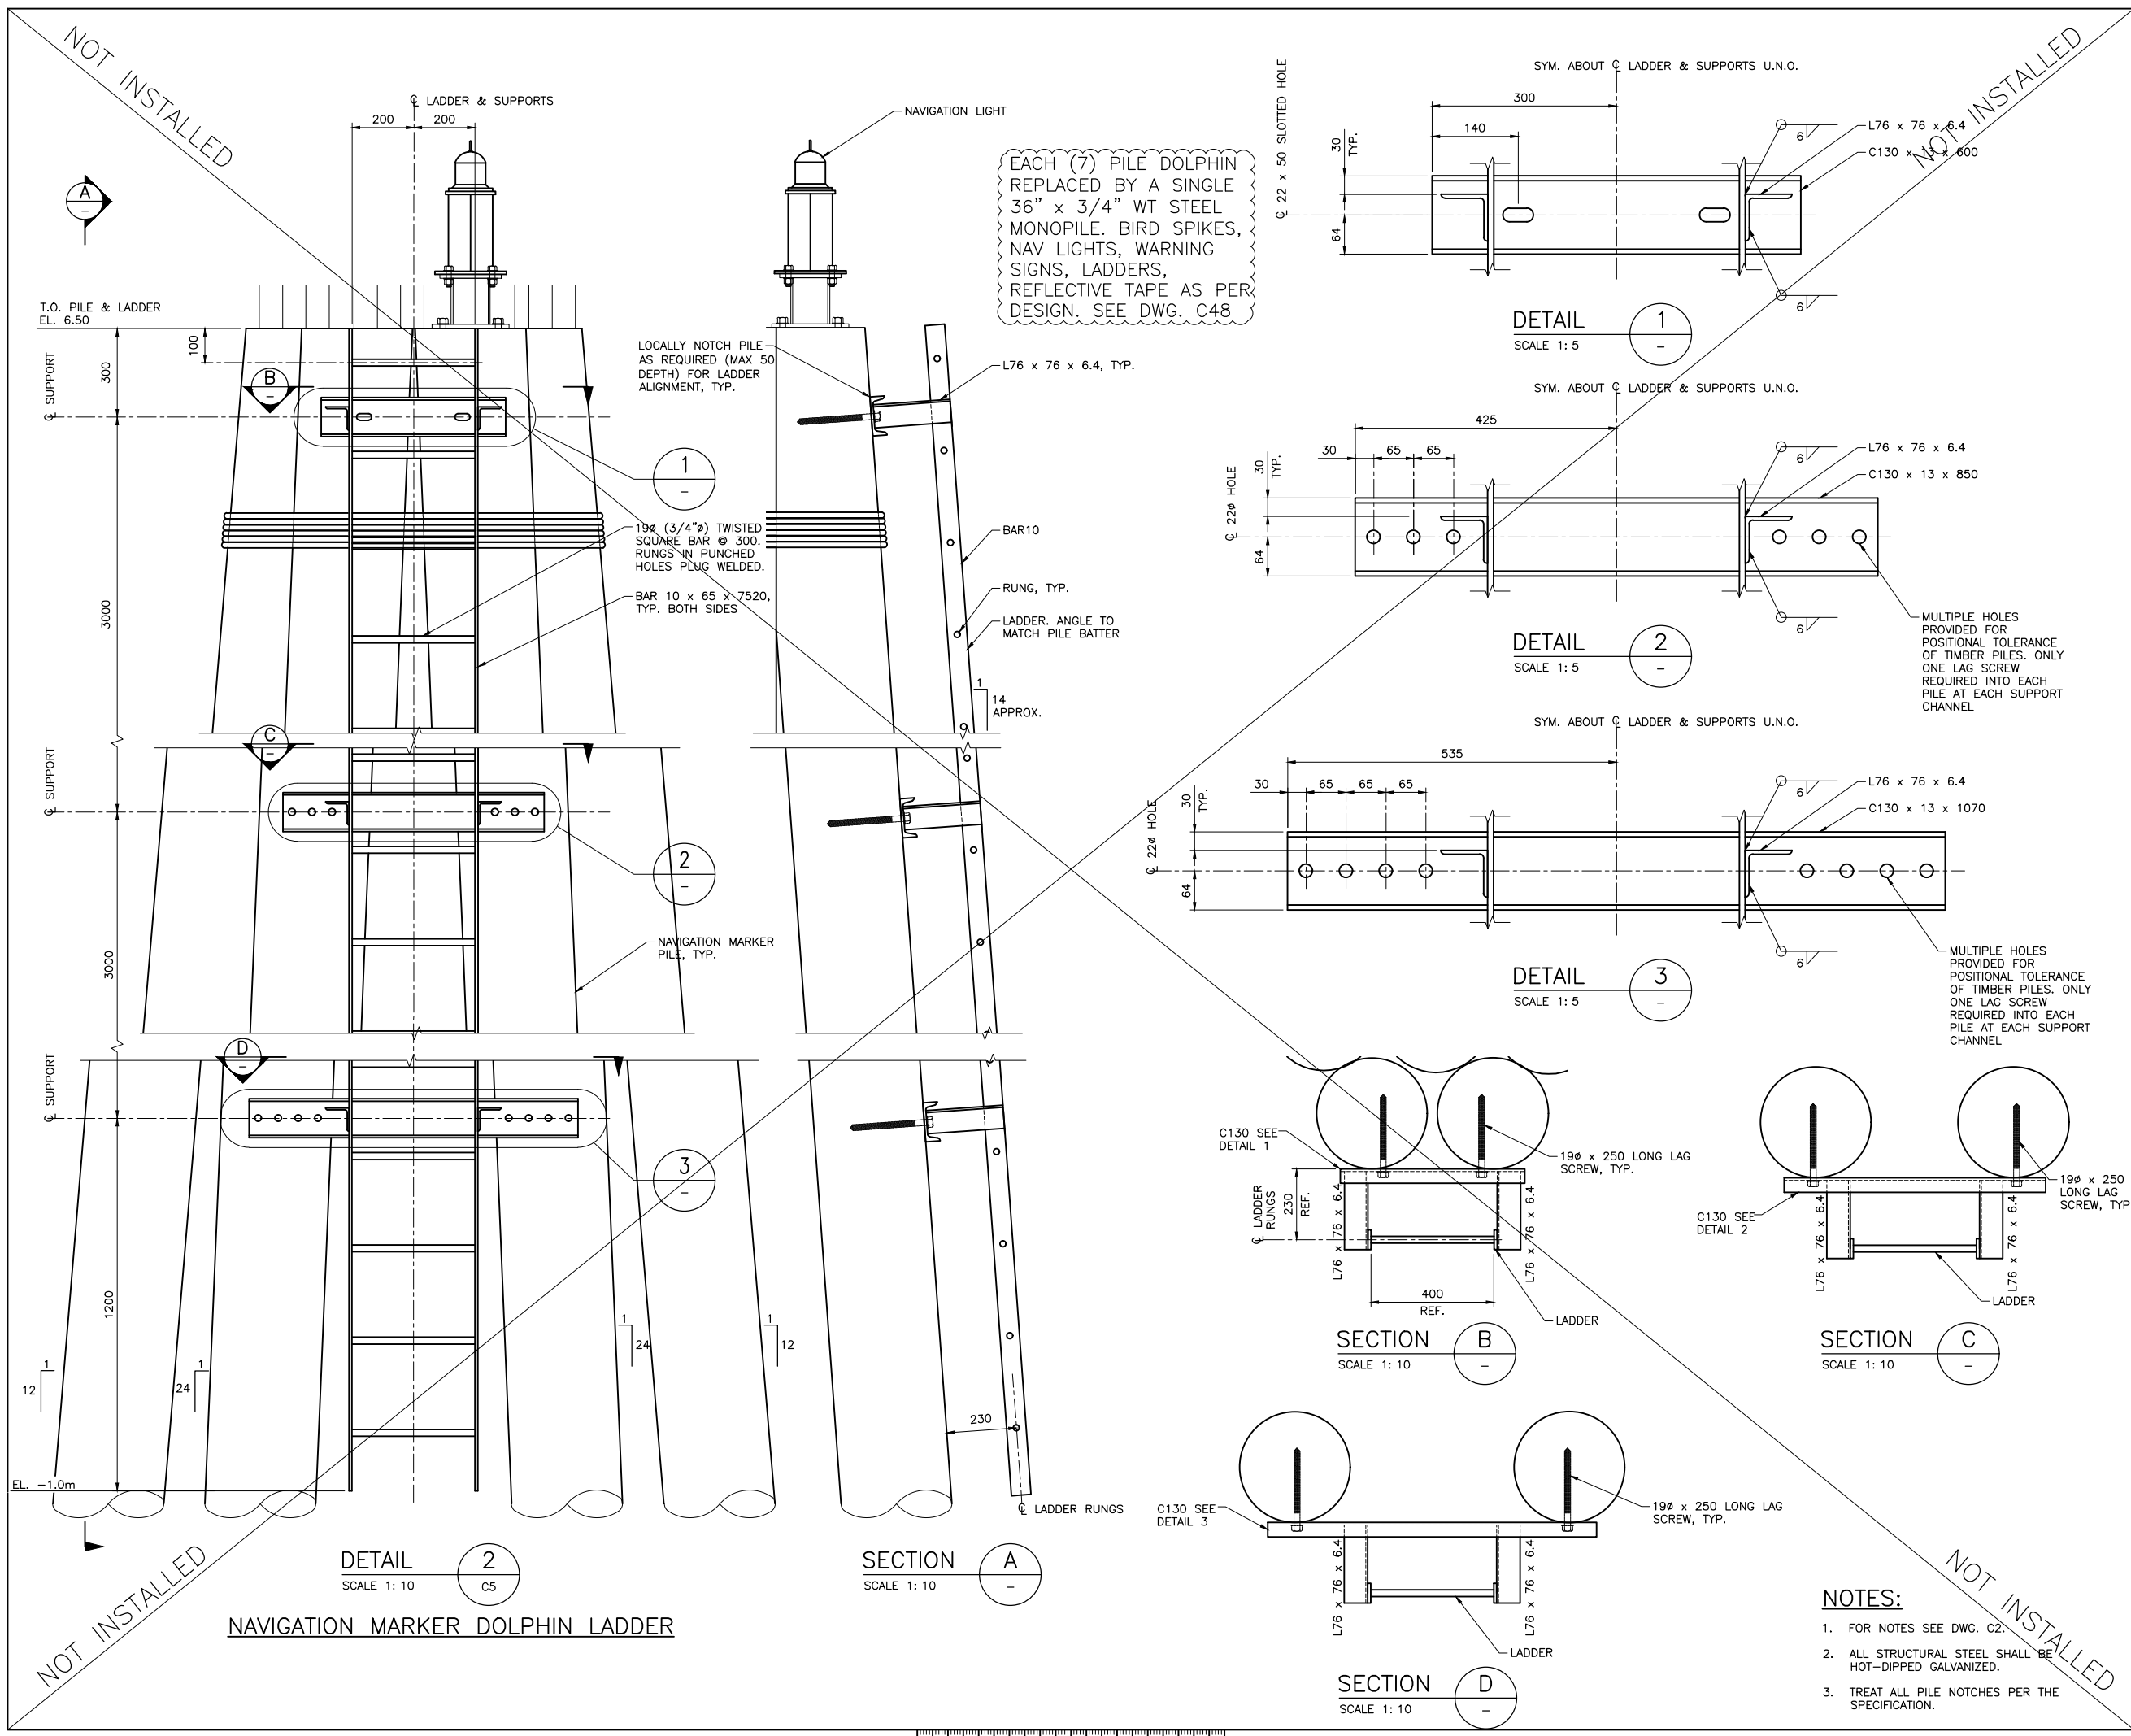

NOT INSTALLED

NOT INSTALLED

NOT INSTALLED

NOT INSTALLED

DETAIL 2
 SCALE 1: 10
 C5
NAVIGATION MARKER DOLPHIN LADDER

SECTION A
 SCALE 1: 10

SECTION B
 SCALE 1: 10

SECTION C
 SCALE 1: 10

SECTION D
 SCALE 1: 10

- NOTES:**
- FOR NOTES SEE DWG. C2.
 - ALL STRUCTURAL STEEL SHALL BE HOT-DIPPED GALVANIZED.
 - TREAT ALL PILE NOTCHES PER THE SPECIFICATION.

Revision/	Description/Description	Date/Date
1	RECORD DRAWING	2017/03/29
	ADDENDUM NO. 2	2015/03/24

PUBLIC WORKS AND GOVERNMENT SERVICES CANADA

Project title/Titre du projet
ESQUIMALT GRAVING DOCK
 825 ADMIRALS ROAD, VICTORIA, BC

ESQUIMALT GRAVING DOCK WATERLOT PHASE 2
SOUTH JETTY UNDER-PIER SEDIMENT REMEDIATION

Consultant Signature Only

Designed by/Concept par
 KRISTIN GREINACHER

Drawn by/Desainé par
 MIKE BRIDDEN

PWSC Project Manager/Administrateur de Projets TPSGC
 ANDREW MYLLY





Regional Manager, Environmental Services
 COLLIN KINGMAN

Drawing title/Titre du dessin

ACCESS LADDERS AT NAVIGATION MARKER DOLPHINS

Project No./No. du projet	Sheet/	Revision no./
R.018400.002	S131	1



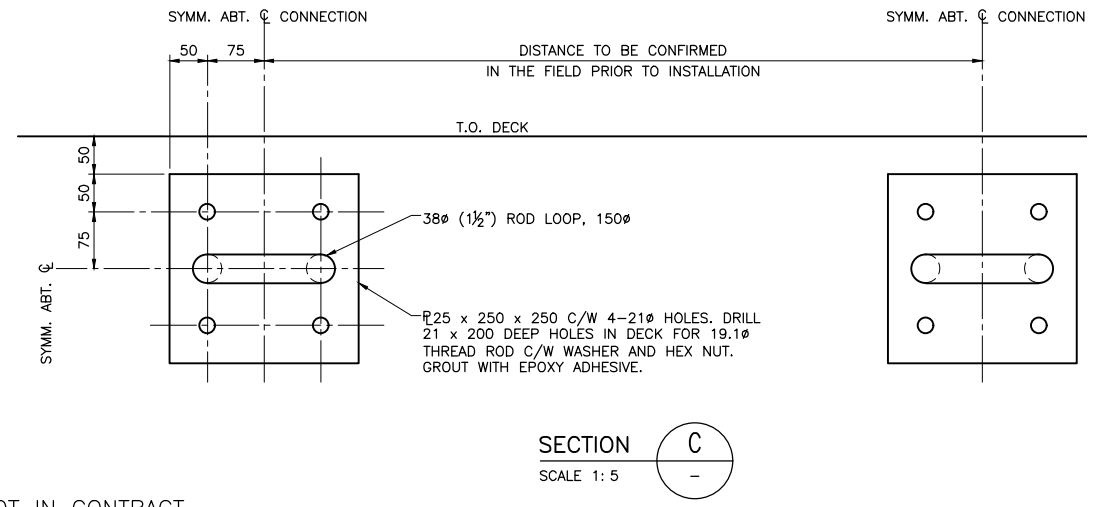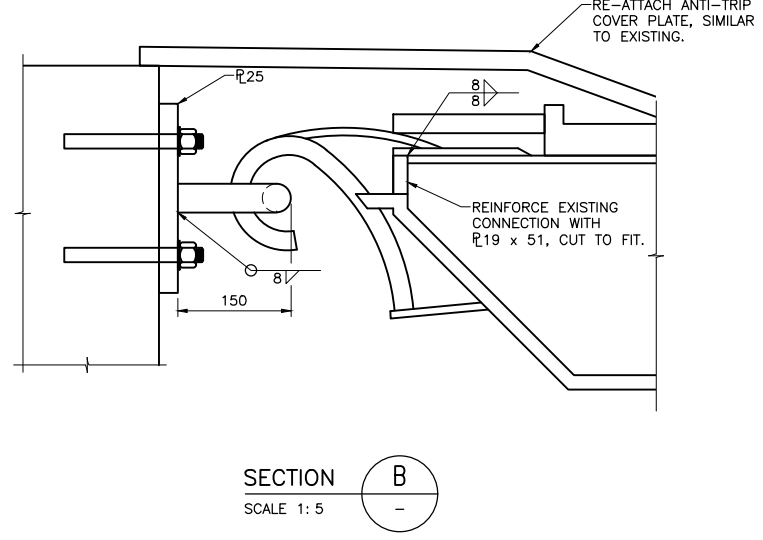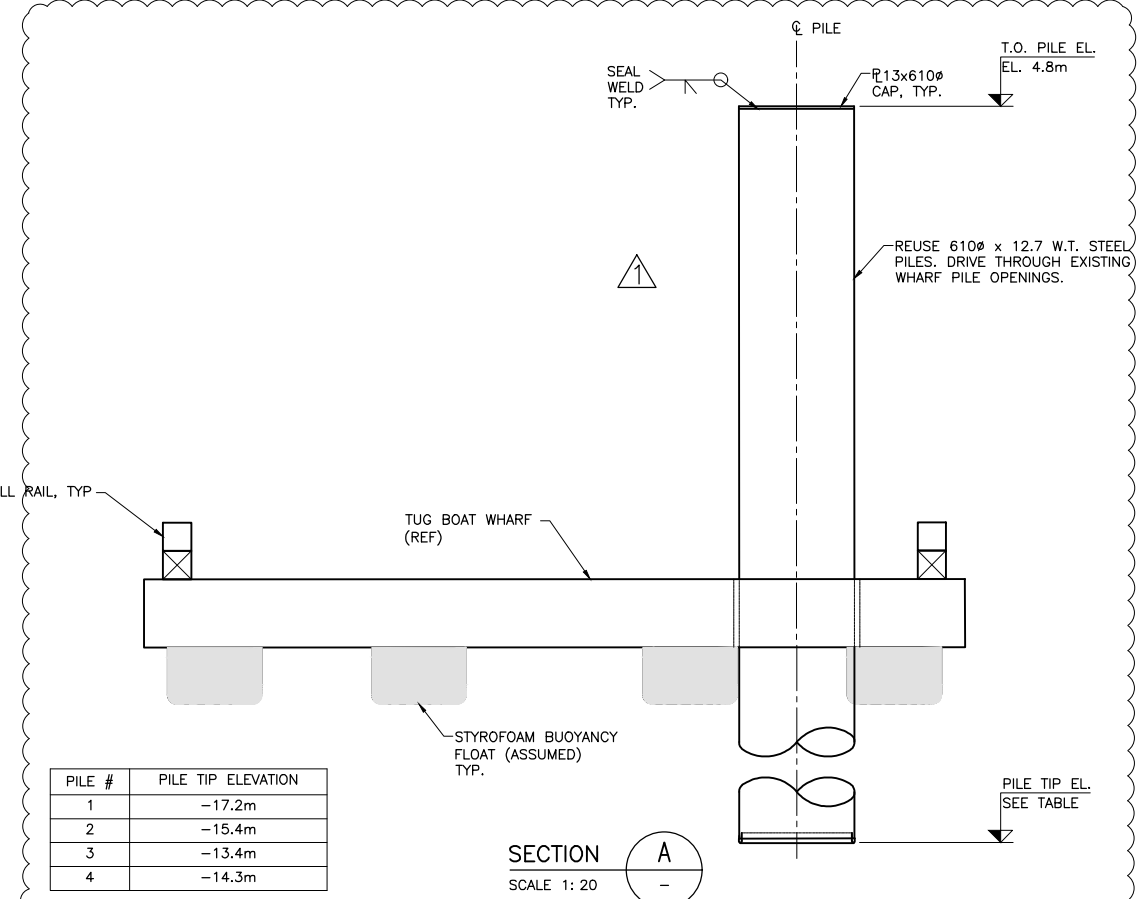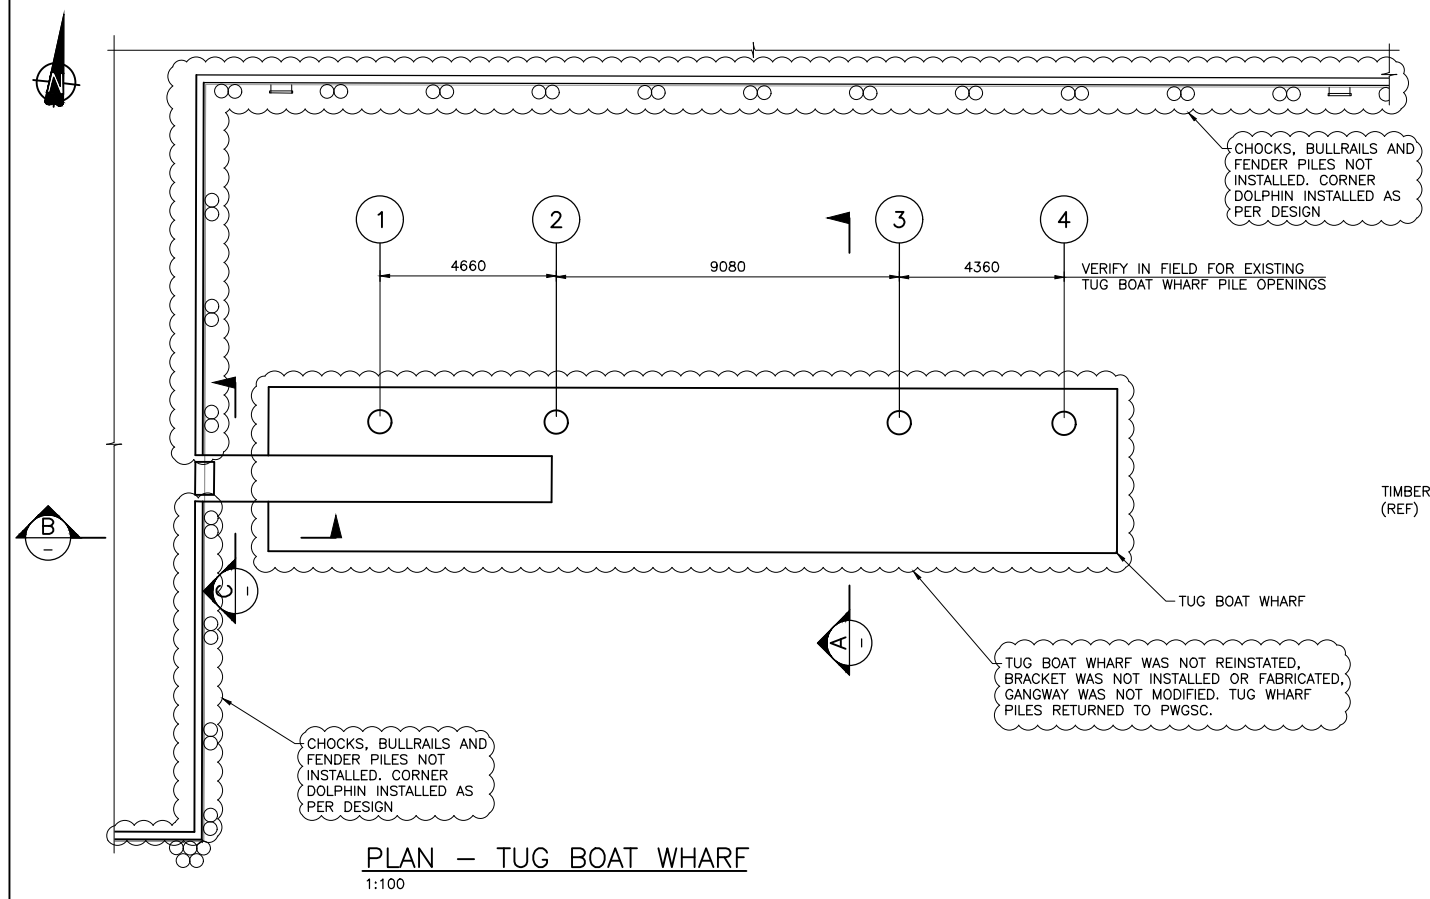

NOT IN CONTRACT



EXISTING GANGWAY HINGE DETAIL



EXISTING ANODE DETAIL



NOTES:

- FOR NOTES SEE DWG. C2.
- CONTRACTOR SHALL CONFIRM ALL CRITICAL MEASUREMENTS OF EXISTING TUG BOAT WHARF PRIOR TO RELOCATION.
- CONNECTION FOR GANGWAY DESIGNED TO CARRY A UNIFORM LIVE LOAD OF 4.8 kPa.
- REMOVE AND STORE ANODES PRIOR TO EXTRACTING PILES. REINSTALL ONE ANODE PER PILE APPROXIMATELY 0.5 - 1.5m ABOVE SEA BED.

Revision/Revision	Description/Description	Date/Date
1	RECORD DRAWING	2017/03/29
0	ISSUED FOR TENDER	2014/12/19

Client/client
PUBLIC WORKS AND GOVERNMENT SERVICES CANADA

Project title/Titre du projet
**ESQUIMALT GRAVING DOCK
825 ADMIRALS ROAD, VICTORIA, BC**

**ESQUIMALT GRAVING DOCK
WATERLOT PHASE 2
SOUTH JETTY UNDER-PIER
SEDIMENT REMEDIATION**

Consultant Signature Only
Designed by/Concept par
GEOFF COOPER
Drawn by/Desainé par
GABE MENDES
PWGSC Project Manager/Administrateur de Projets TPSGC
ANDREW MYLLY
Regional Manager, Environmental Services
COLLIN KINGMAN

Drawing title/Titre du dessin
**TUG BOAT WHARF
DETAILS**

Project No./No. du projet	Sheet/	Revision no./
R.018400.002	S151	1

