
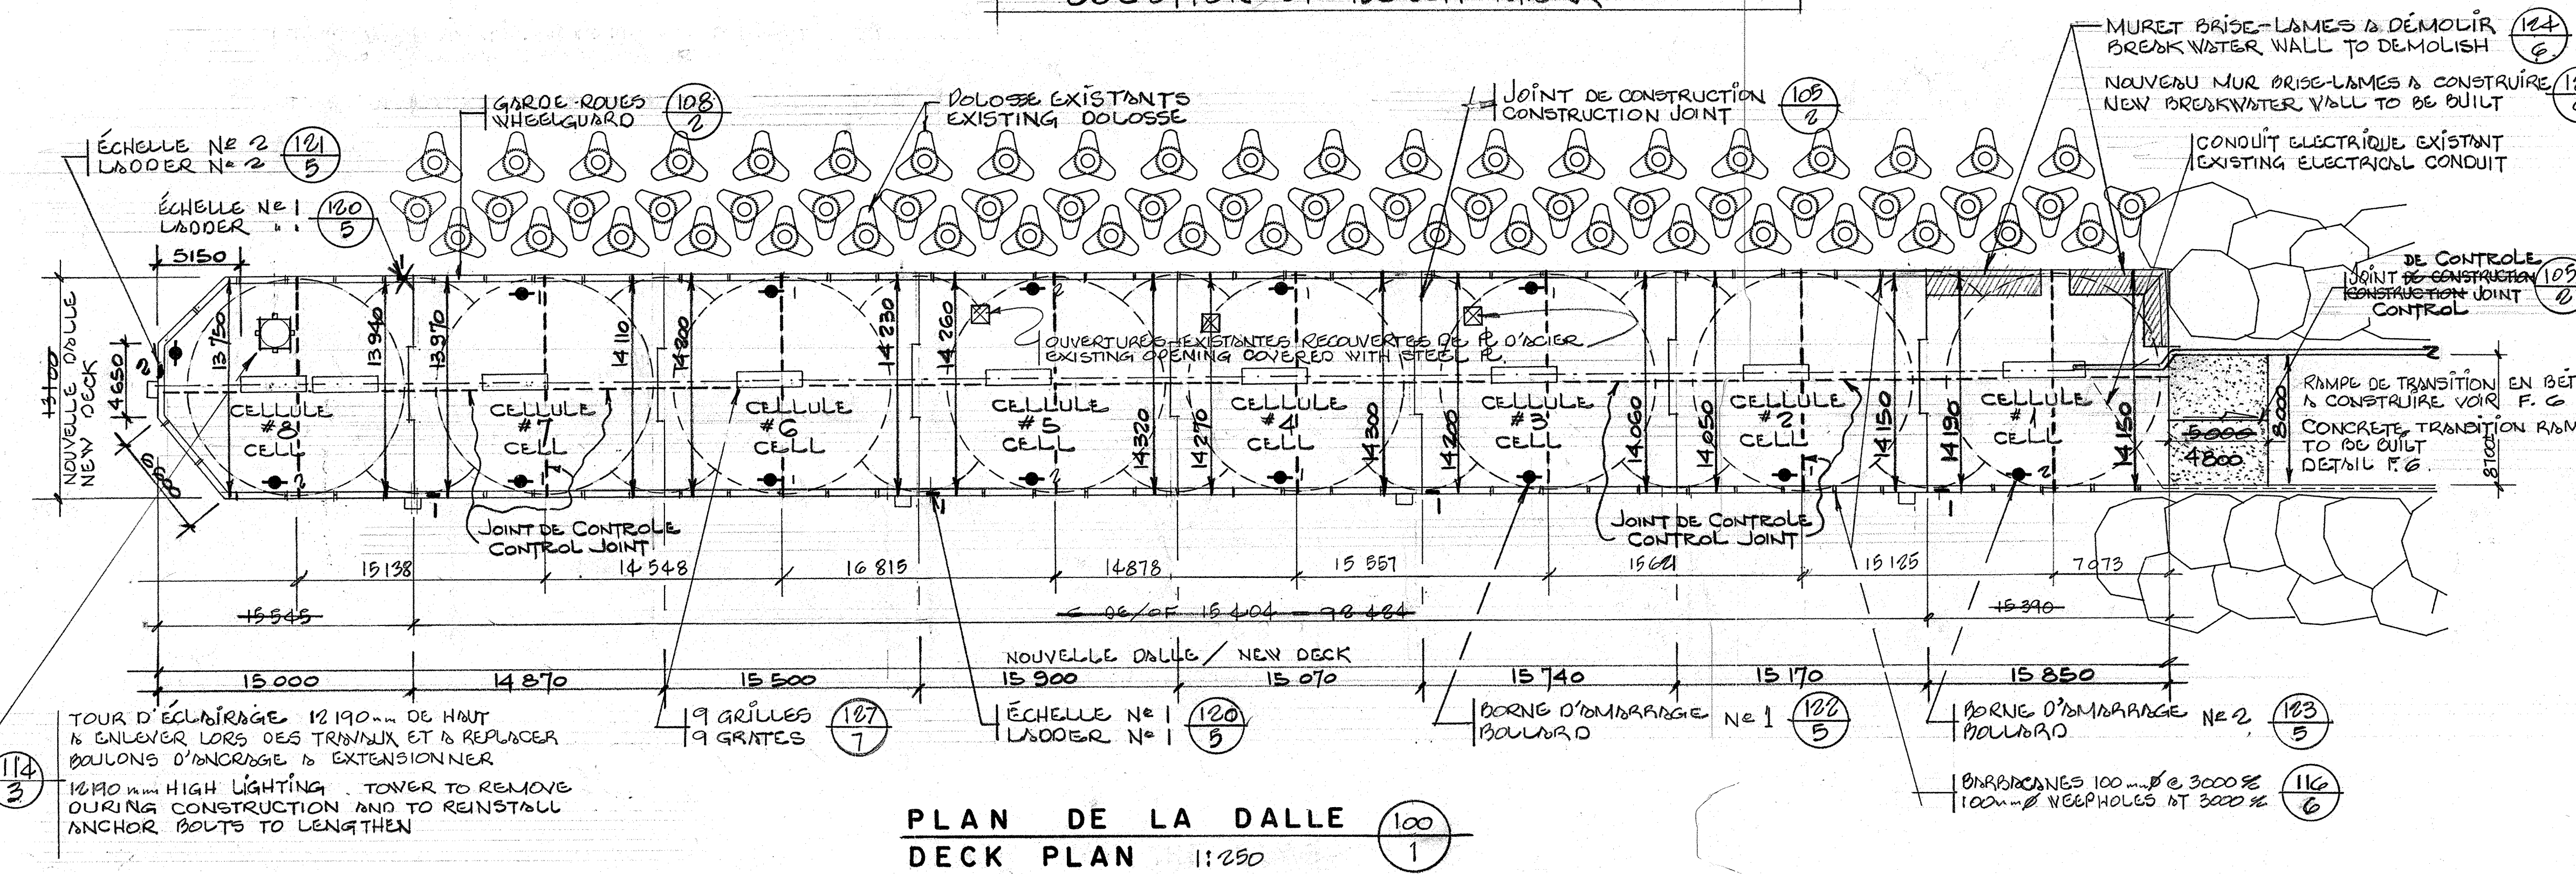
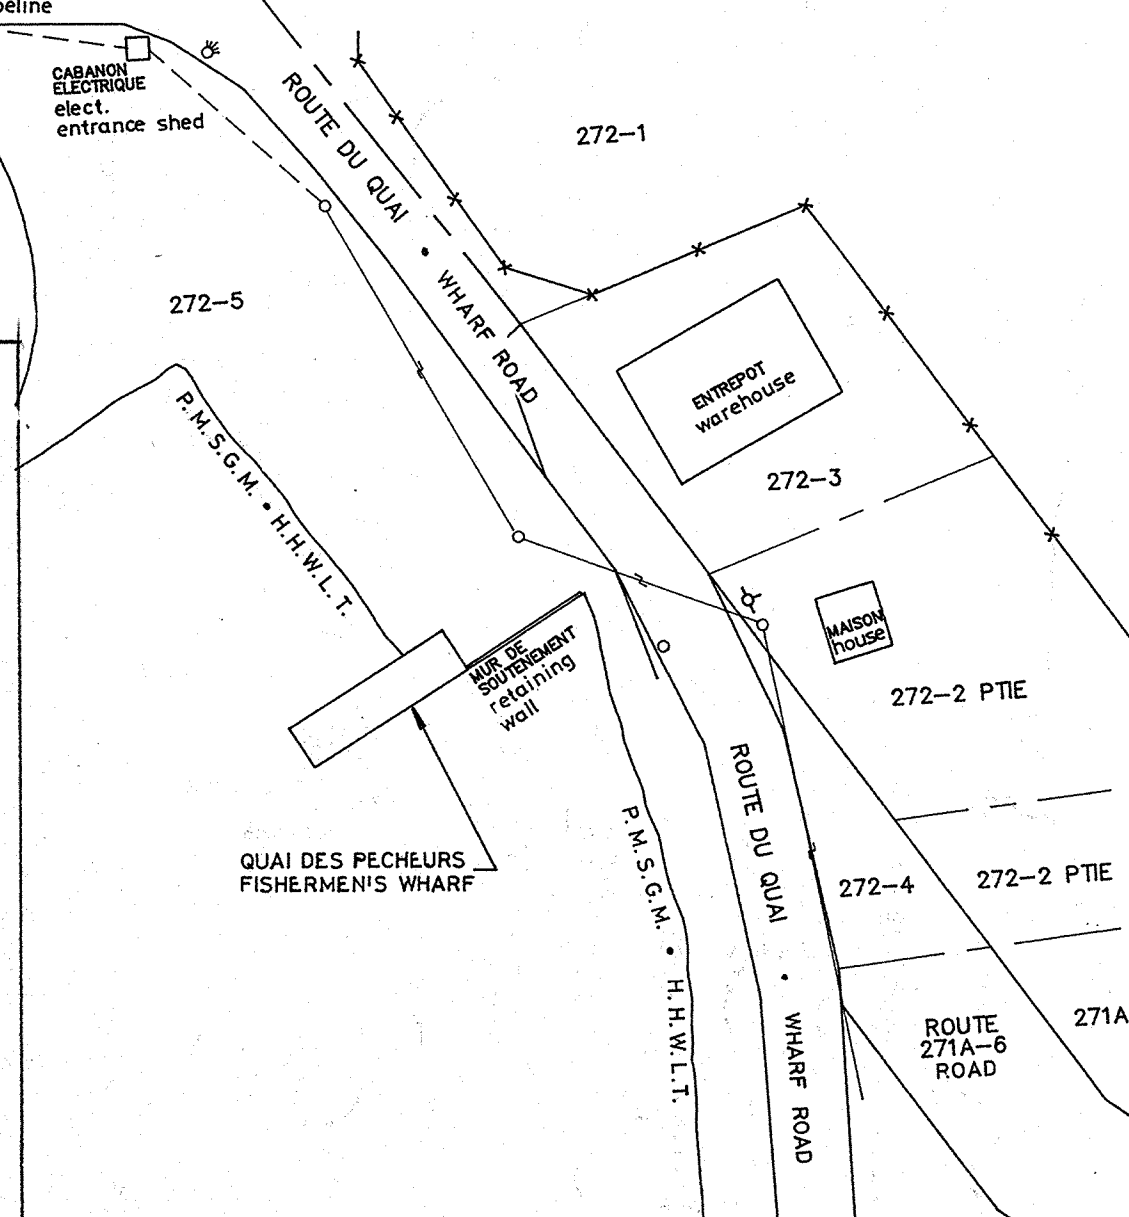


PLAN D'ENSEMBLE  
GENERAL PLAN

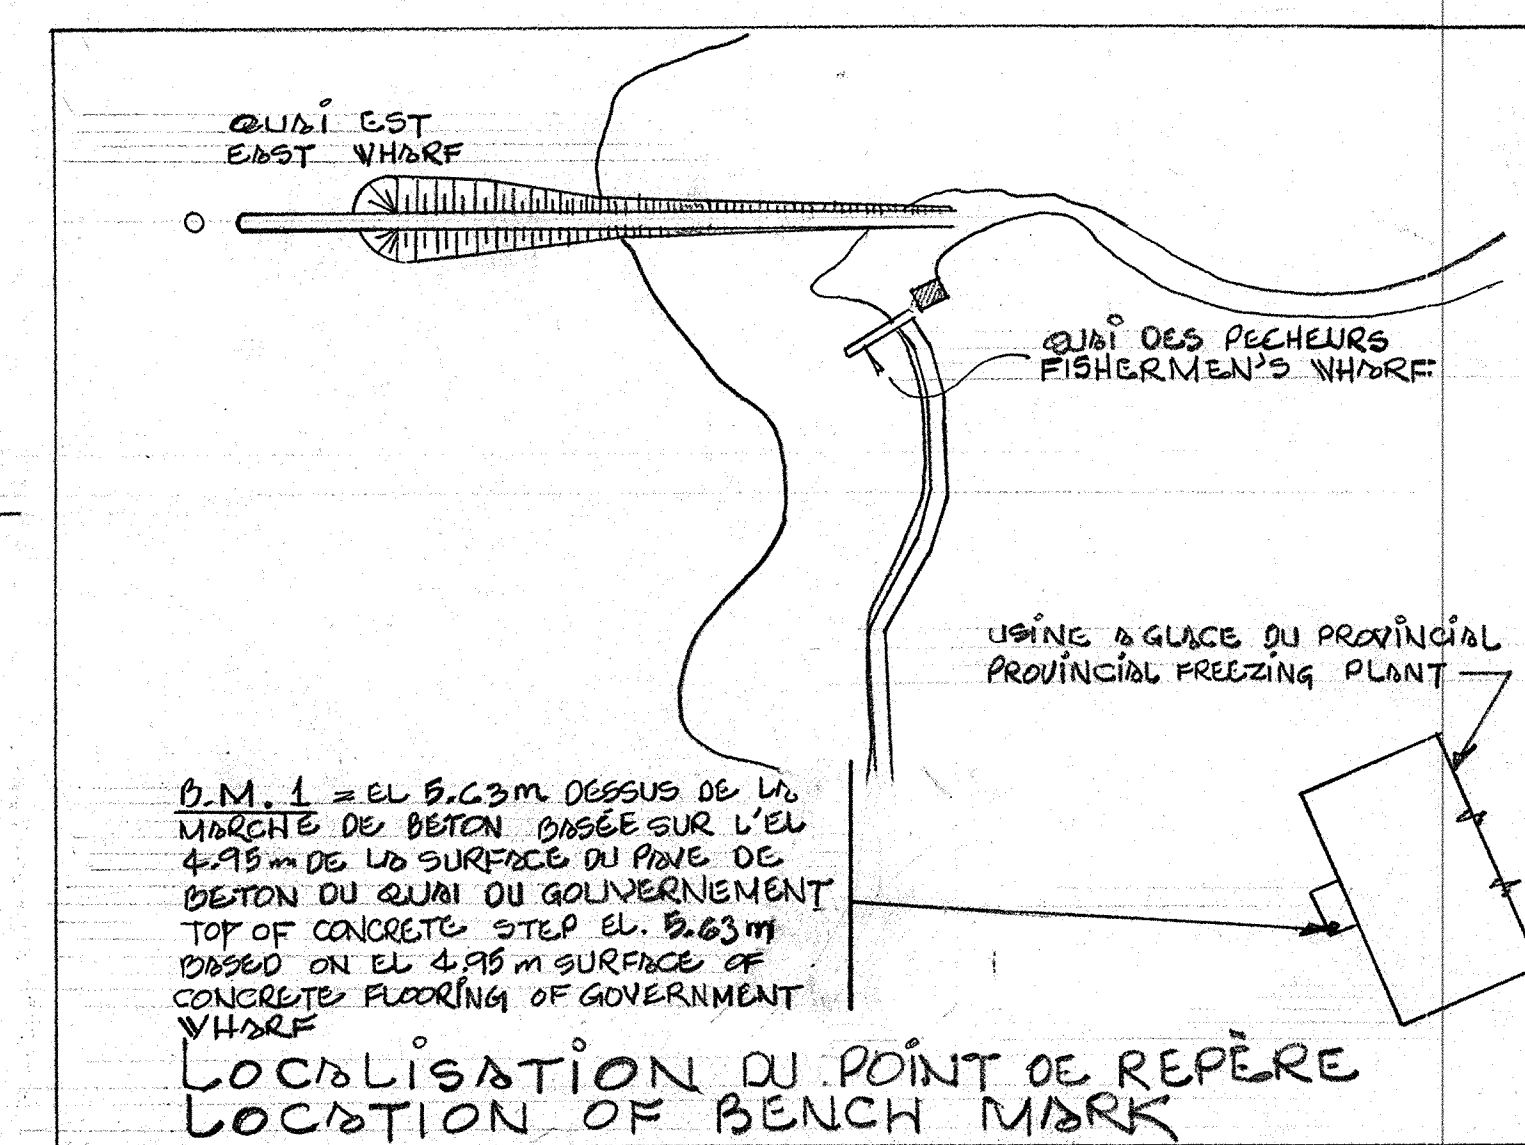

TEL QUE CONSTRUIT  
AS BUILT  
1991-11-07

revisions date

A no. du détail  
detail no.  
B sur dessin no.  
location drawing no.  
C dessin no.  
drawing no.

project  
MONT-LOUIS

REFECTION DE LA DALLE (200 mm)  
(QUAI EST)  
REFIRMS TO THE SLAB (200 mm)  
(EAST WHARF)

dessin  
CART. DE LOCALISATION  
PLAN D'ENSEMBLE  
POINT DE REPÈRE  
PLAN DE LA DALLE  
LOCATION CHART  
GENERAL LAYOUT  
BENCHMARK  
DECK PLAN

conçu  
designed

date  
15-6

dessiné  
drawn

date  
70-08-19

examine  
reviewed

date  
31.06.13

approuvé  
approved

date  
31.06.13

no. du projet  
project number

no. du dessin  
drawing no.

QUAI 213M 1/7


105

1-1906









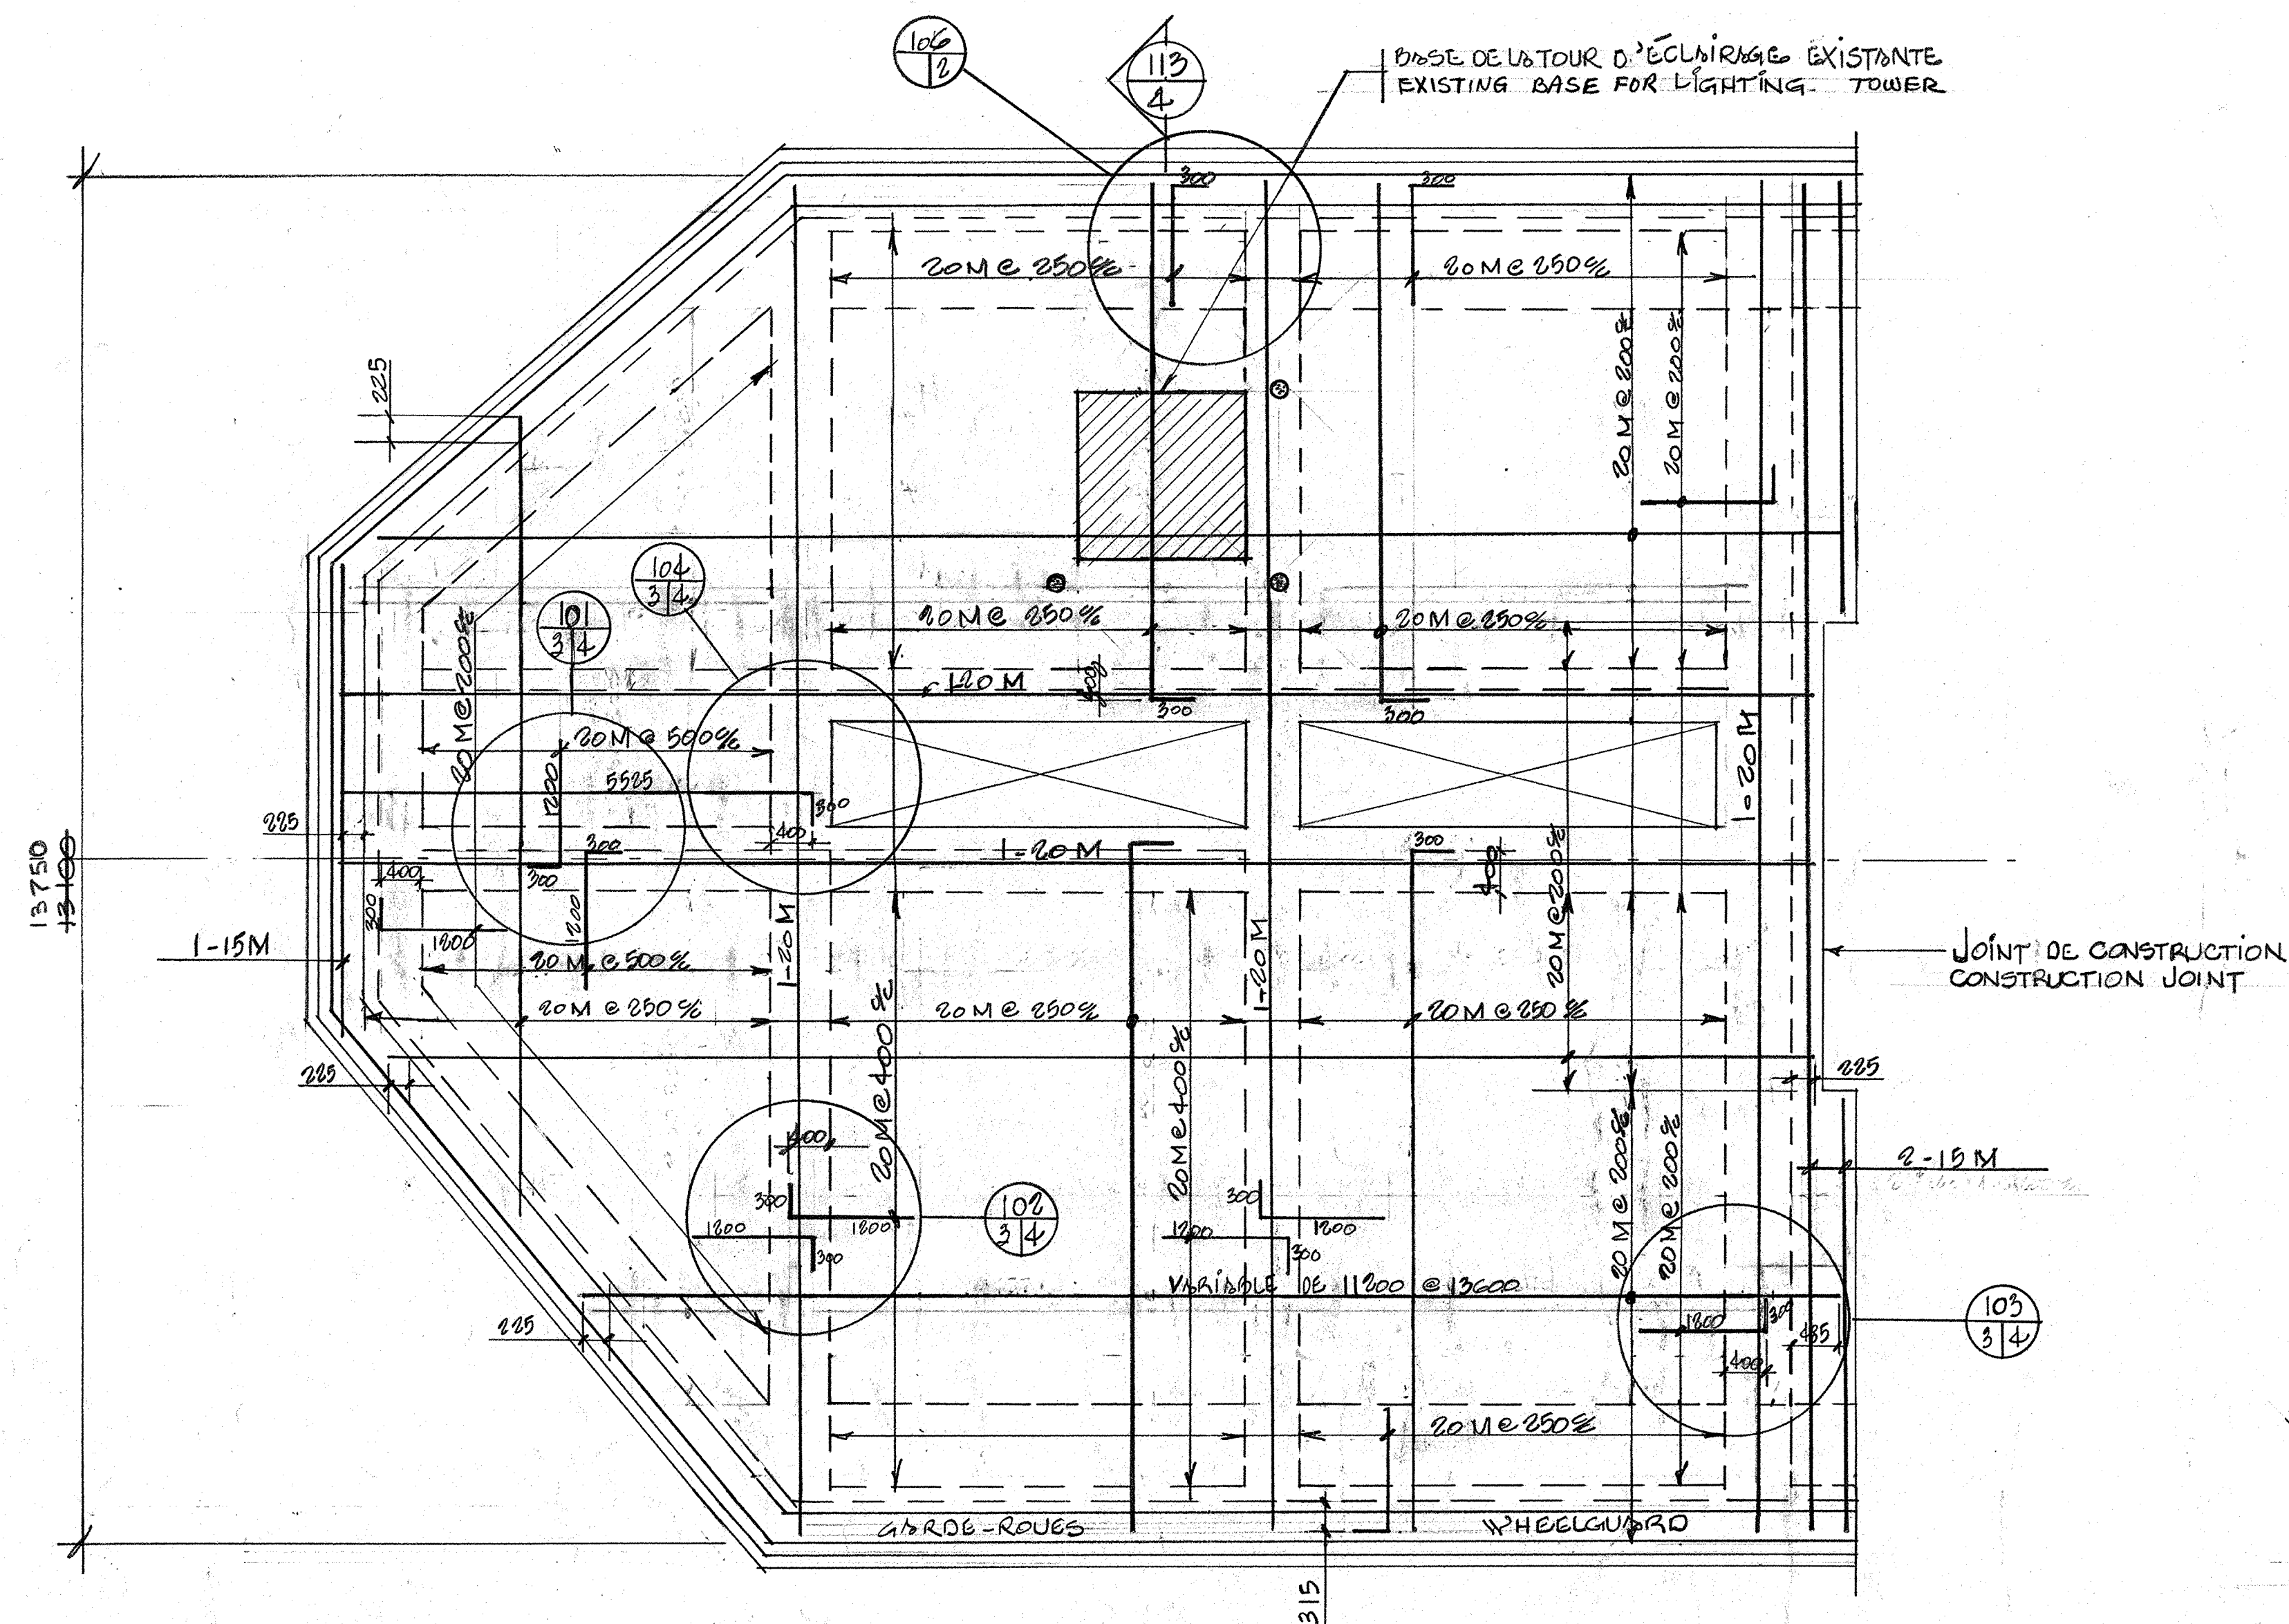

ARMATURE CELLULE N° 8  
REINFORCEMENT CELL N° 8

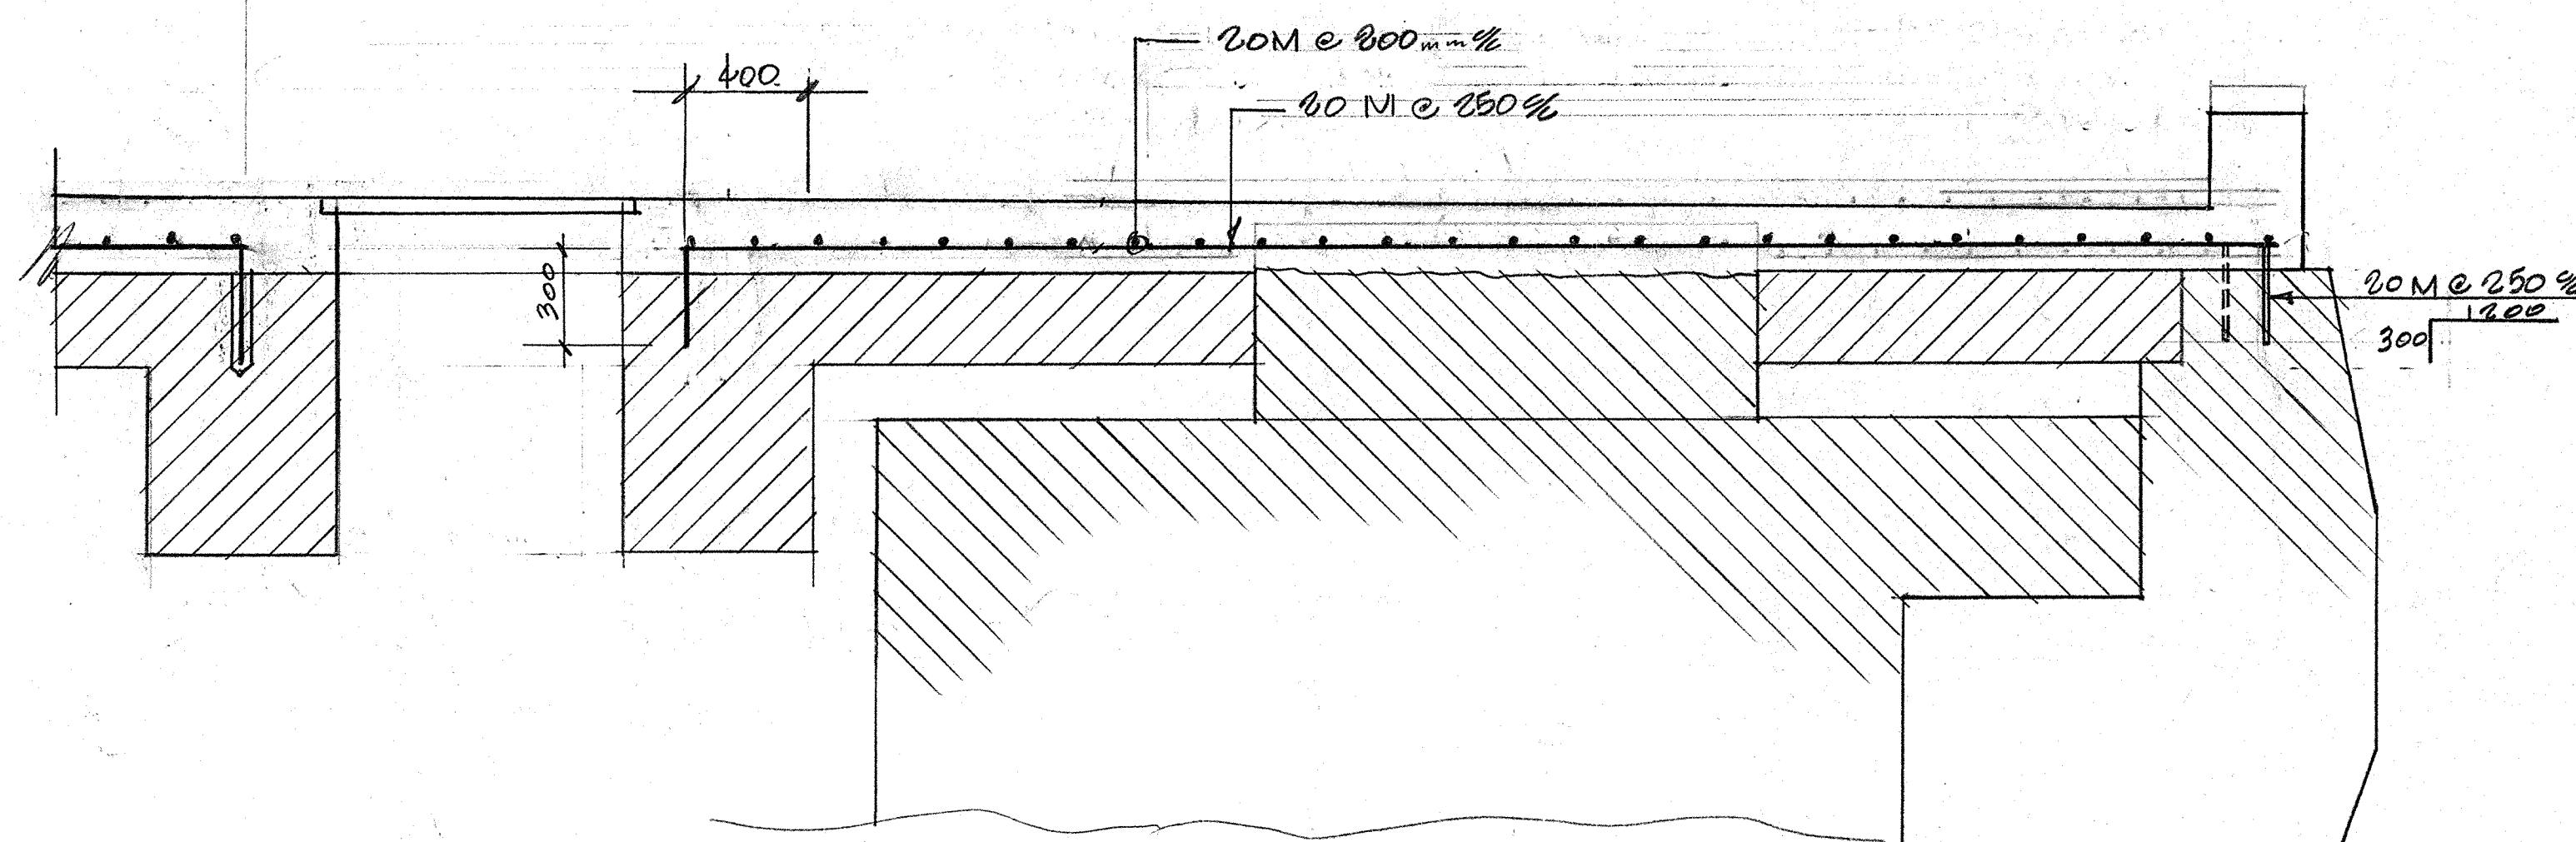

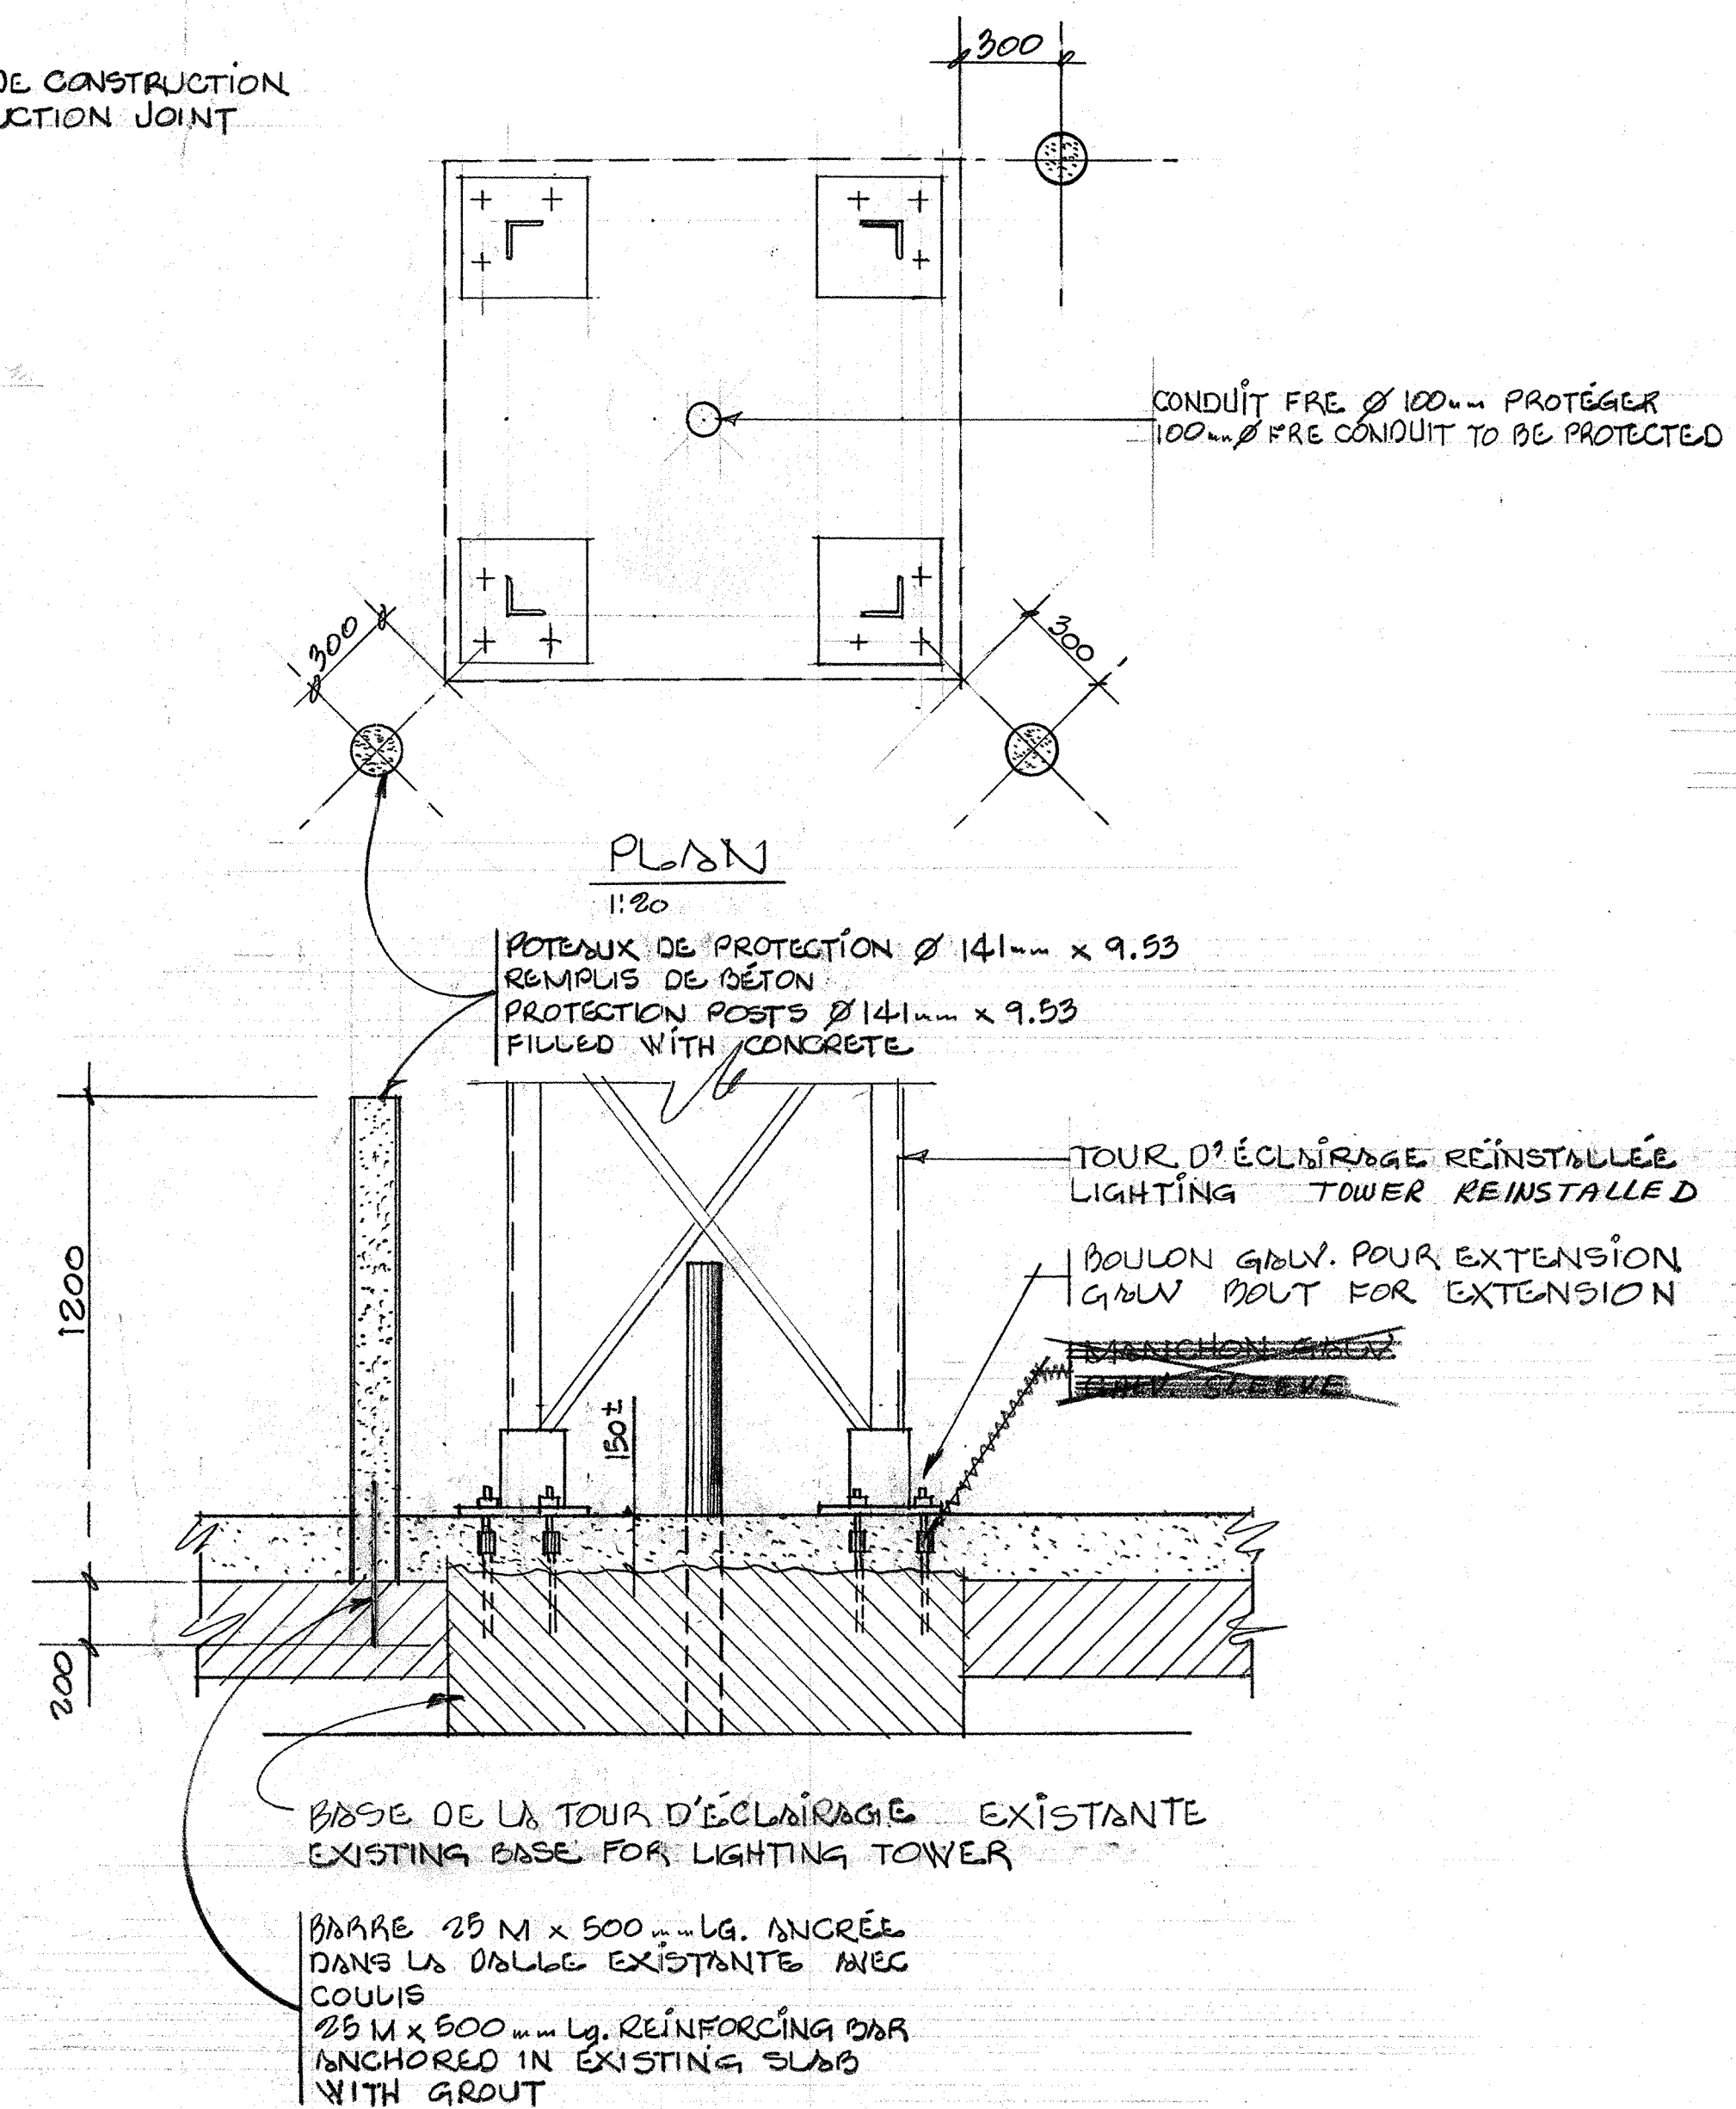

COUPE  
SECTION












ANCRAGE DE LA TOUR D'ÉCLAIRAGE  
ANCHOR OF THE LIGHTING TOWER

TEL QUE CONSTRUIT  
AS BUILT  
1991.11.07

revisions			date
 <p>A. no. du détail détail no.</p> <p>B. sur dessin no. location drawing no.</p> <p>C. dessin no. drawing no.</p>			
project	project		
<p><b>MONT-LOUIS</b></p> <p>REFECTION DE LA DALLE (200 mth) (COURB EST) REPARAS TO THE SLAB (200 mth) (EAST WHARF)</p>			
dessin	drawing		
<p>SIGNATURE DALLE CELL. # 8 TOUR D'ECLESTARGE</p>			
<p>CELL. # 8 REINFORCING STEEL IN THE SLAB LIGHT NG TOWER</p>			
conçu	designed		
<p>F.V.</p>			
date			
dessiné	drawn		
<p>R1</p>			
date			
<p>21-06-12</p>			
examiné	reviewed		
<p><i>[Signature]</i></p>			
date			
<p>21.06.12</p>			
approuvé	approved		
<p><i>[Signature]</i></p>			
date			
<p>Sourismisor</p>			
<p><i>[Signature]</i></p>		Tender	
Administrat	ur de projets TPC	PWC	Project Manager
no. du projet	project number		
<p>767358</p>			
no. du dessin	drawing no.		
<p>QU-911213-M</p>		<p>3/7</p>	






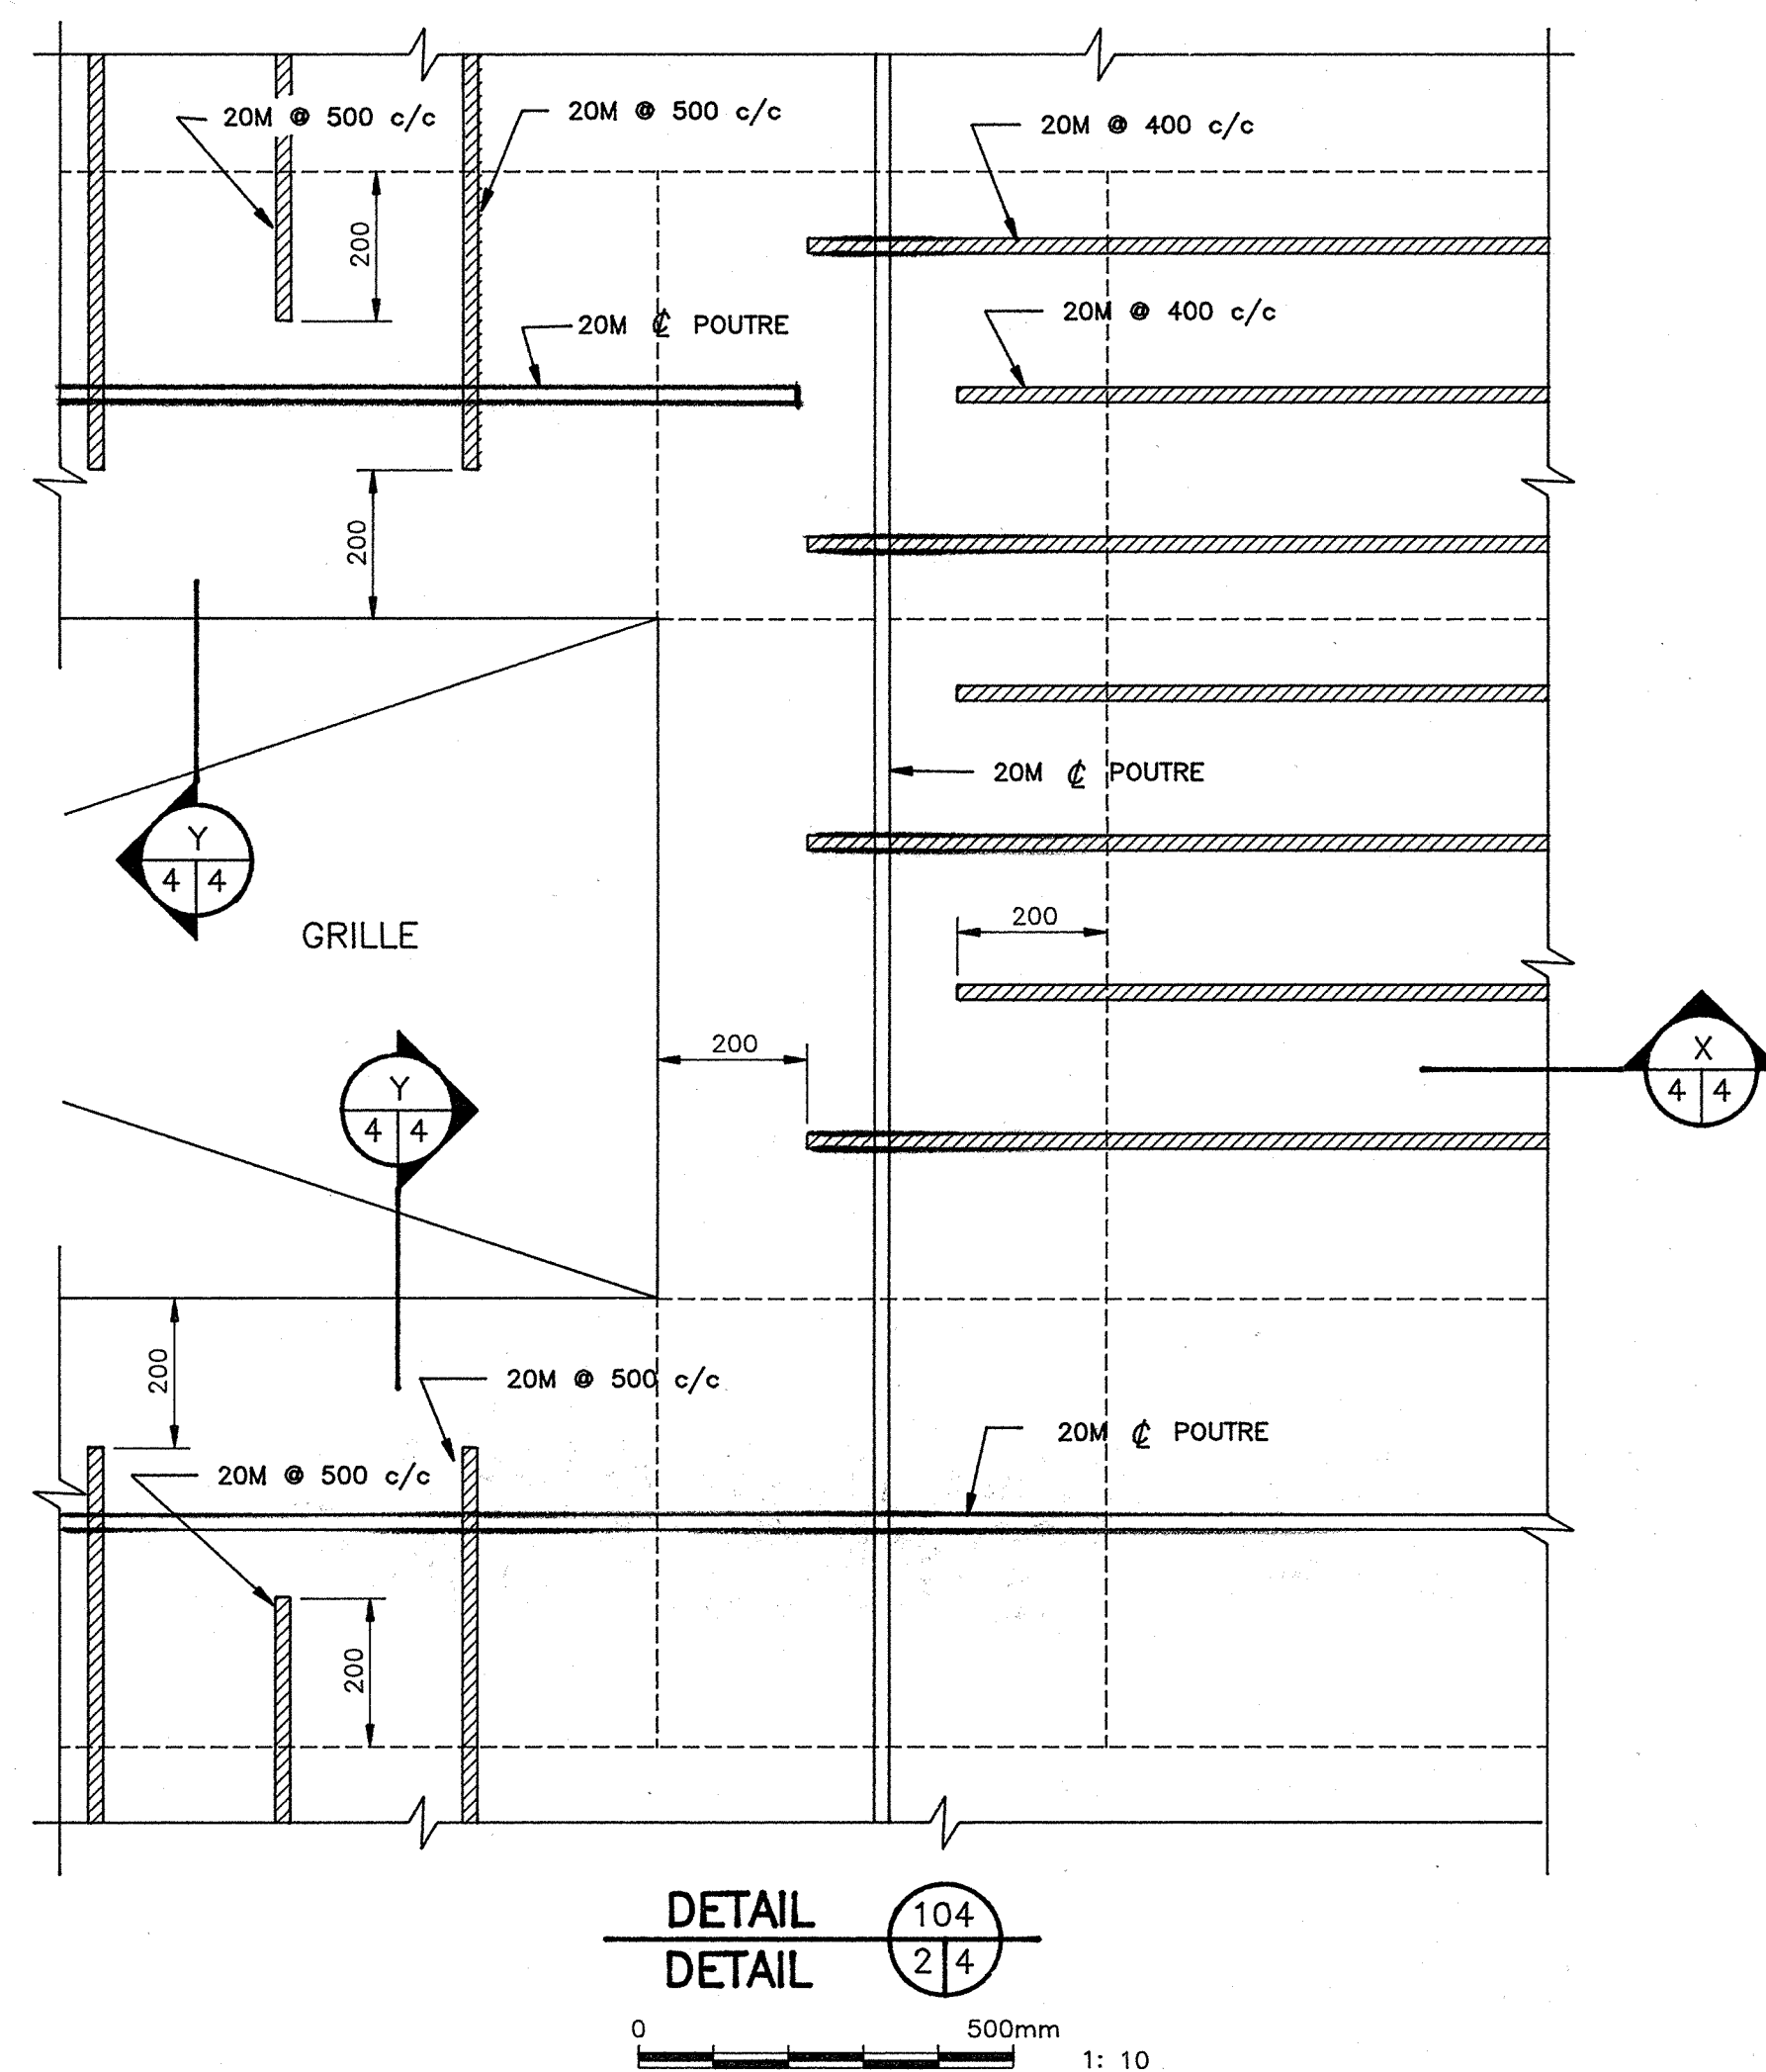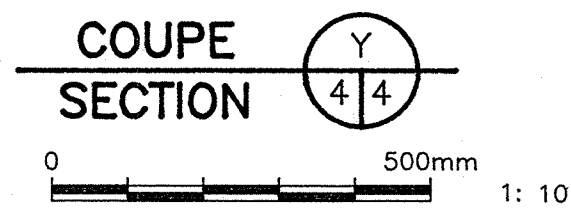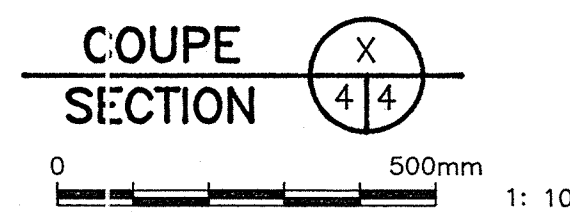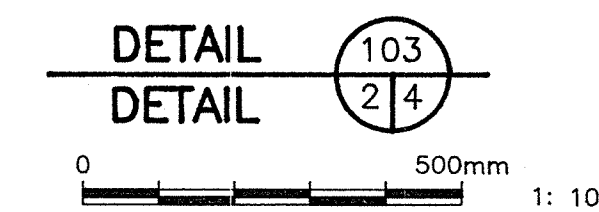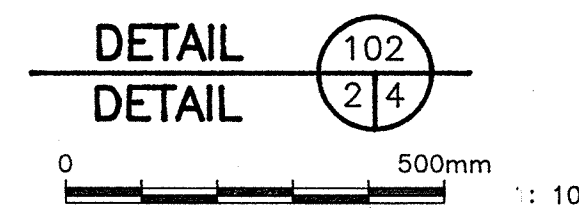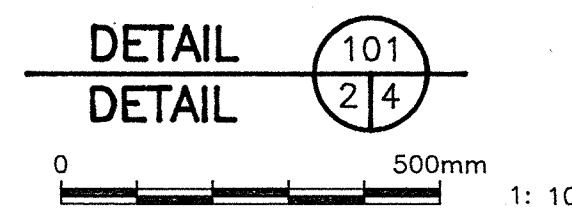

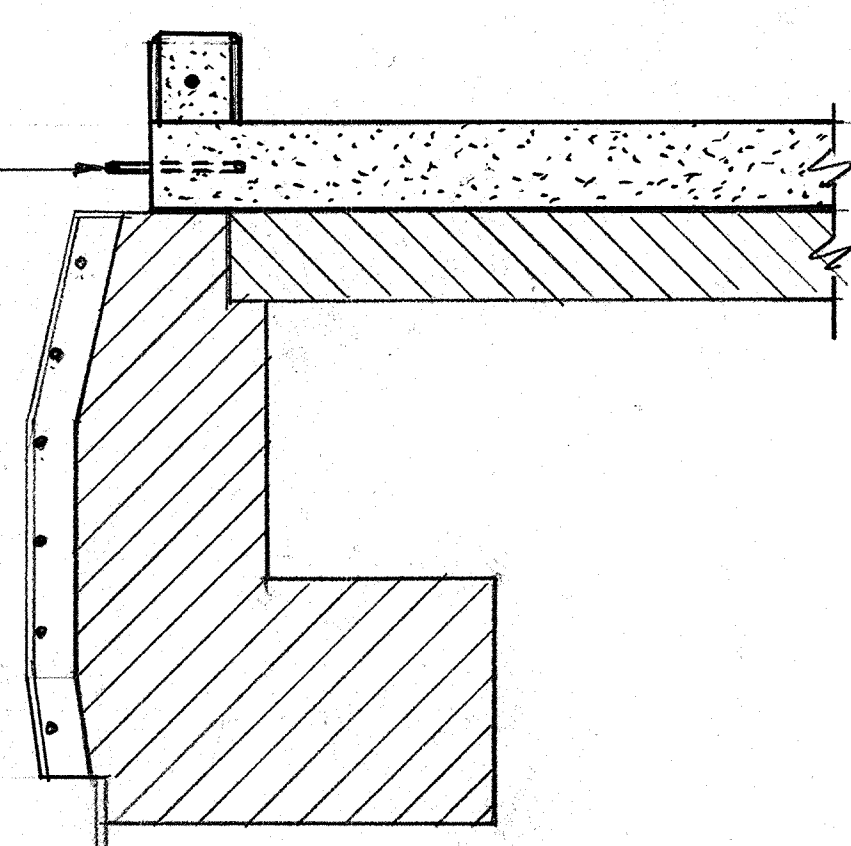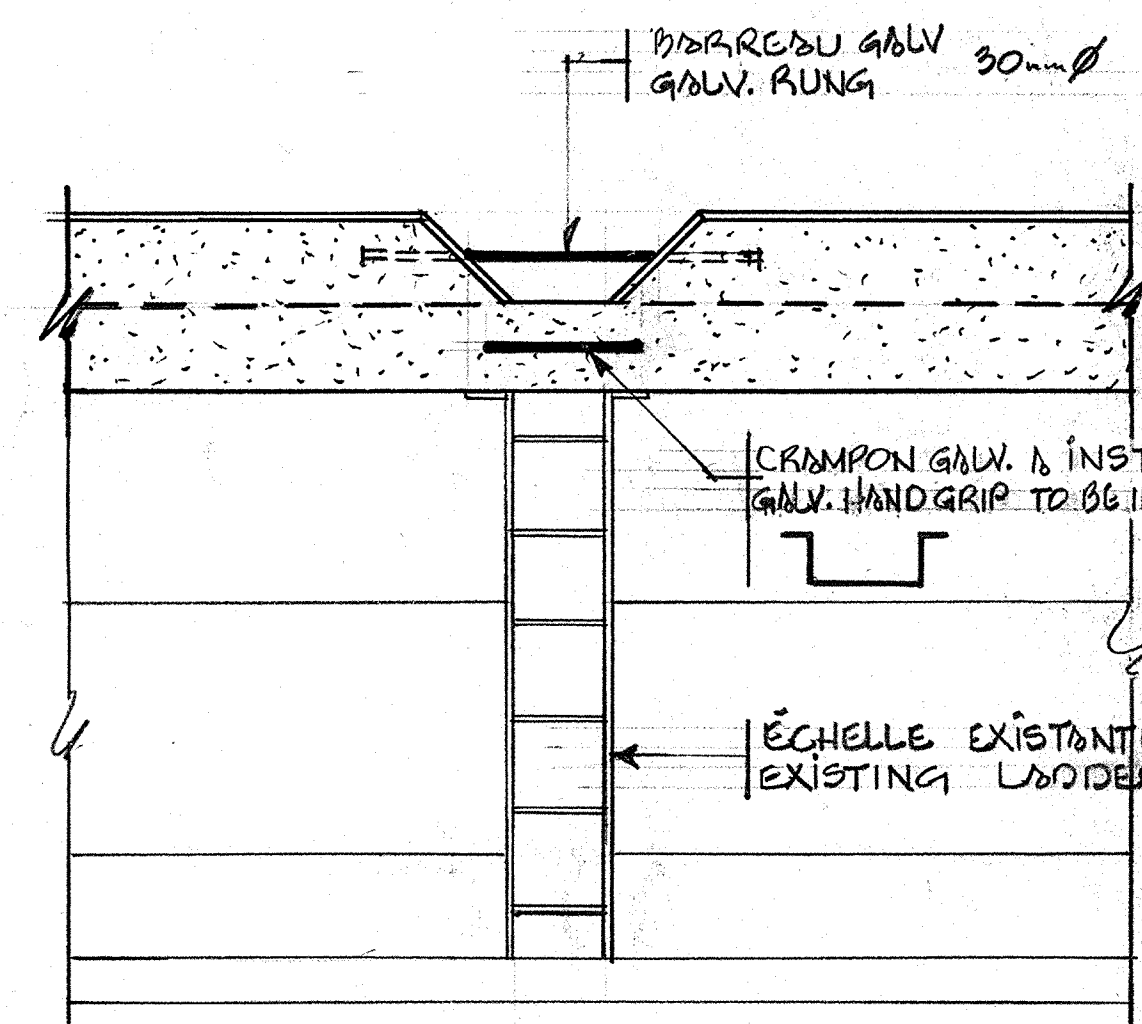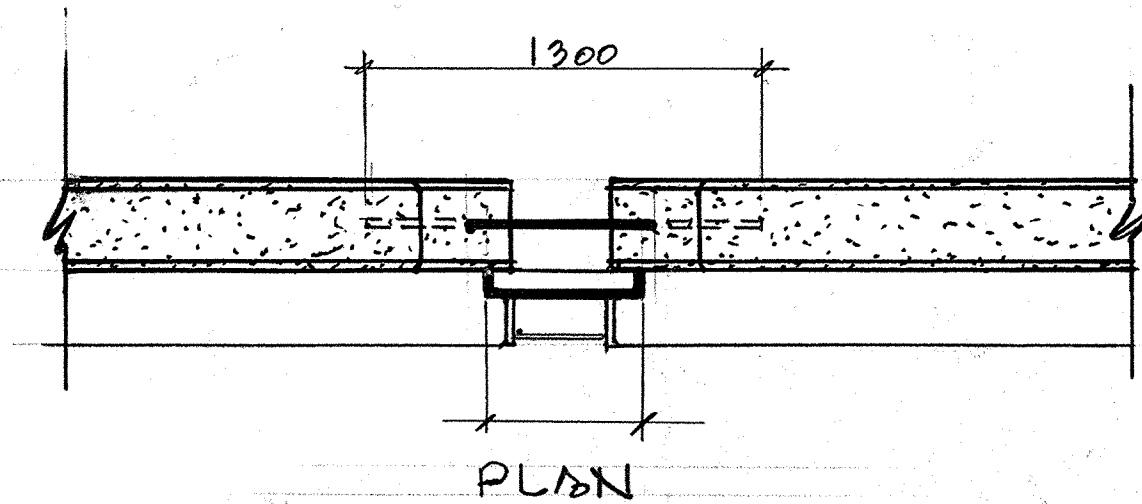



DÉTAILS DES ÉCHELLES N° 1  
DETAILS OF N° 1 LADDERS

120  
1:25

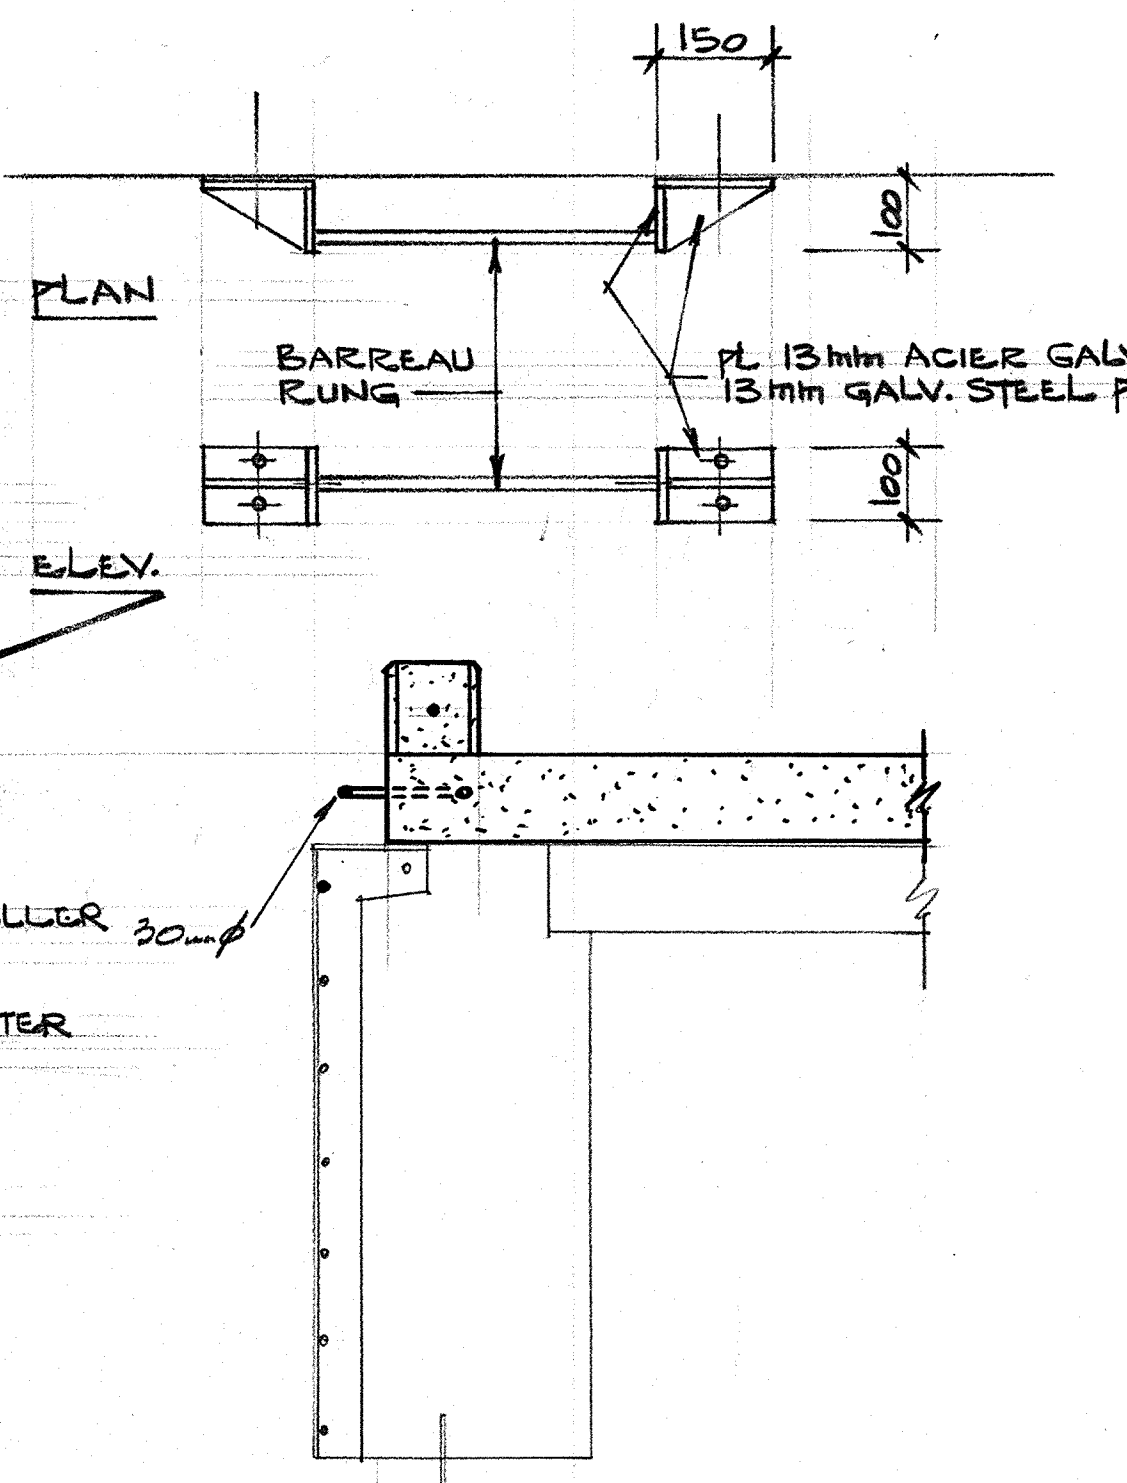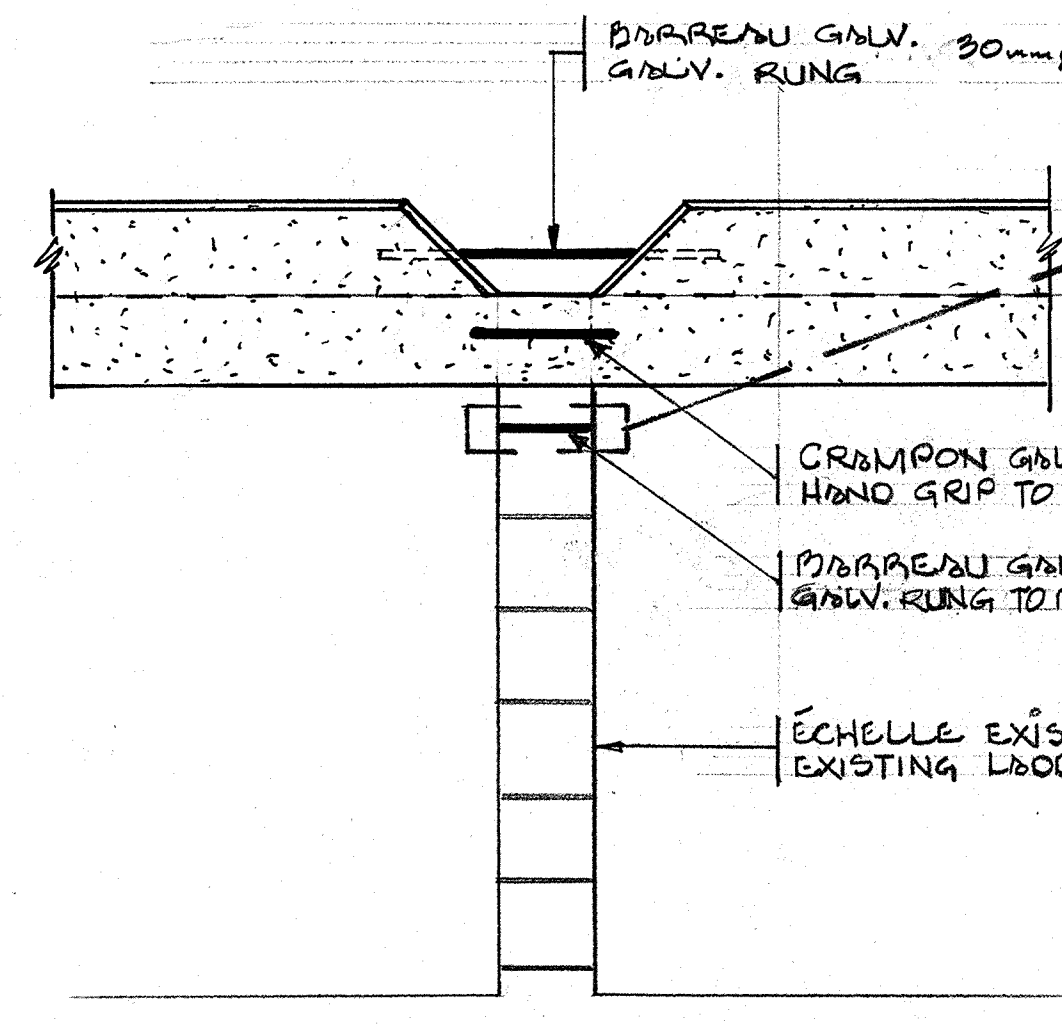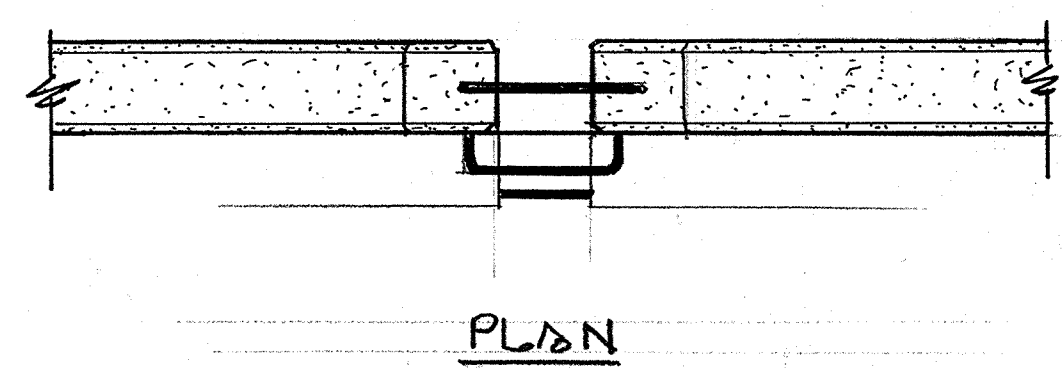


DÉTAILS DES ÉCHELLES N° 2  
DETAILS OF N° 2 LADDERS

121  
1:25



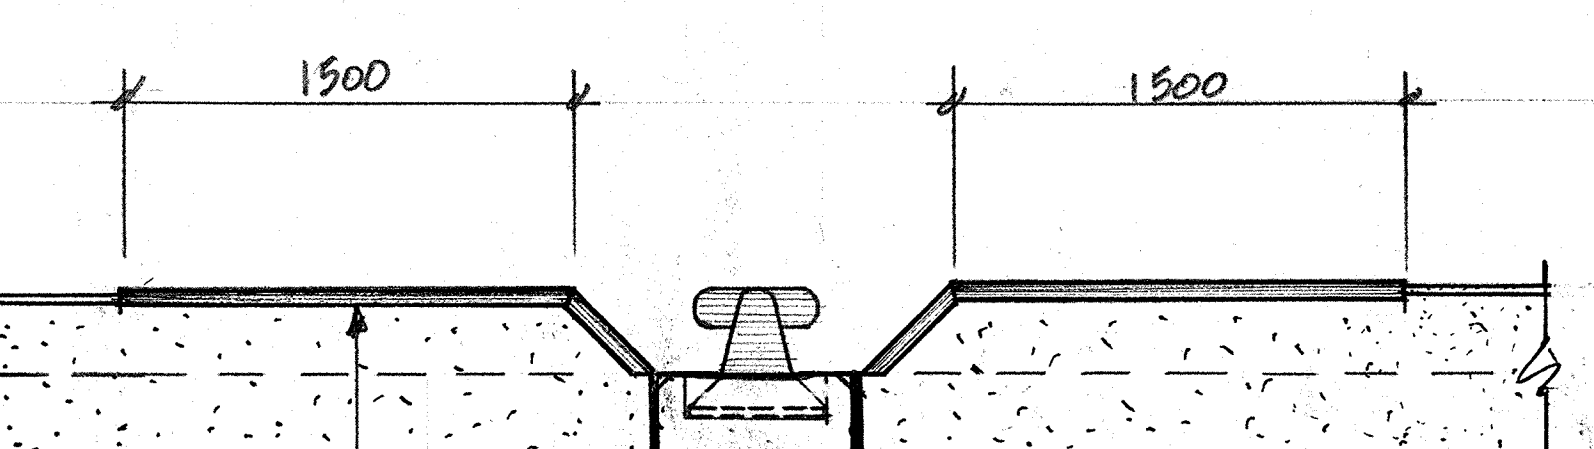
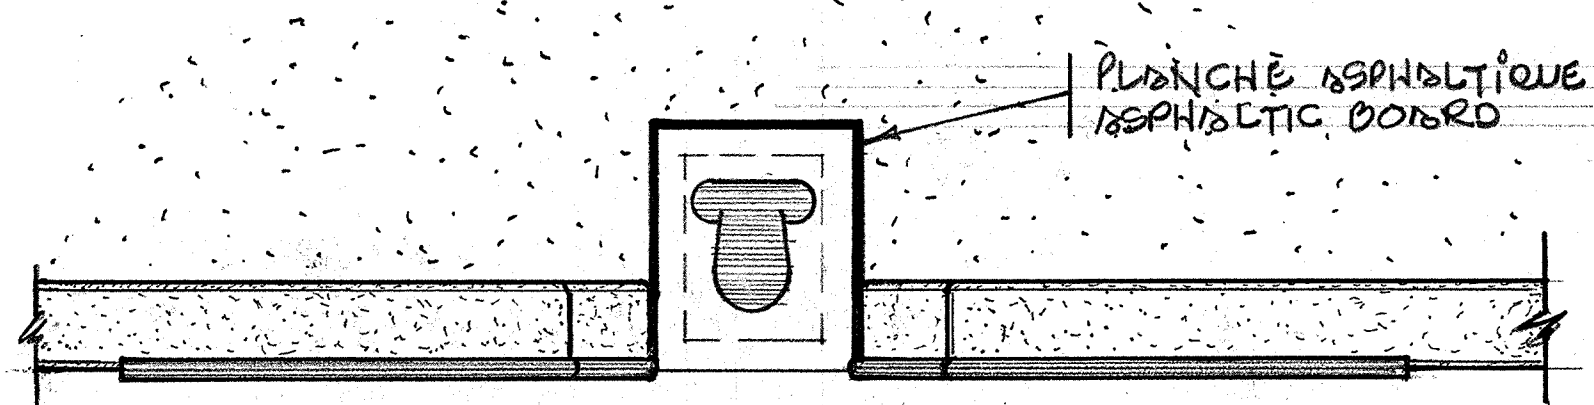


NOTE  
VEULER TOUT LES ANGLES SAILLANTS  
DES TUYAUX MÉTALLIQUES  
GRIND EVERY EDGE OF STEEL  
PIPES

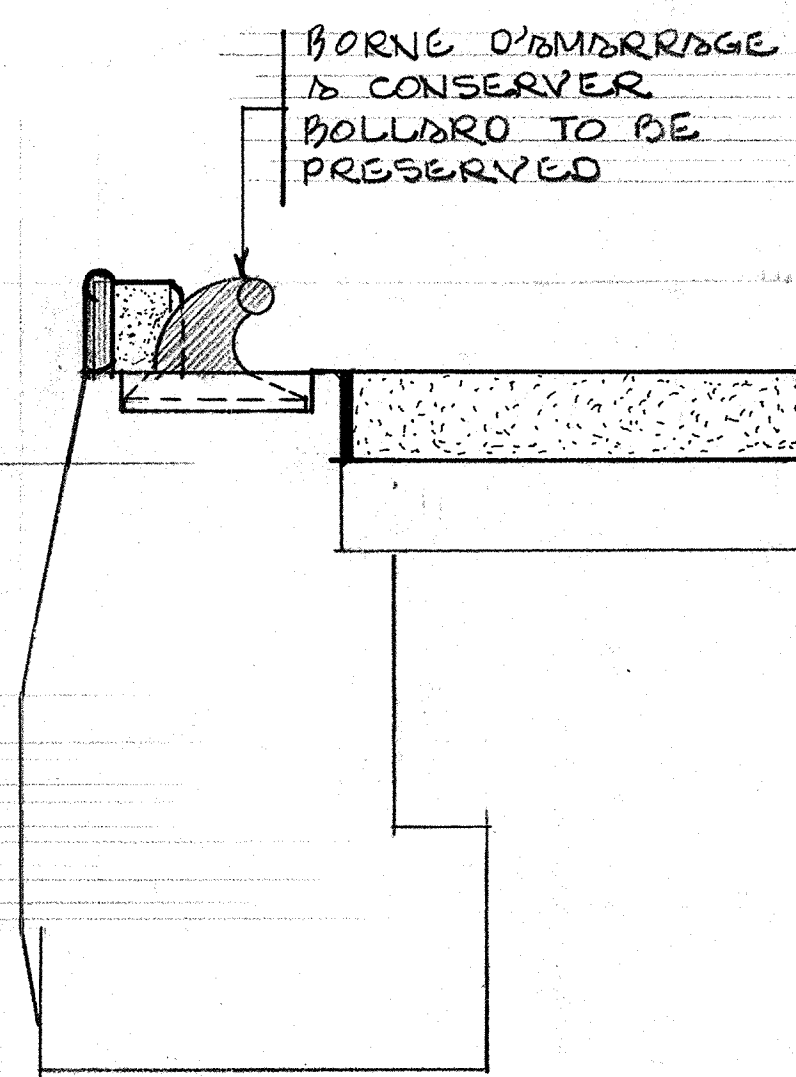

DÉTAILS DES BORNES D'AMARRAGE N° 1  
DETAILS OF N° 1 BOLLARDS

122  
1:25

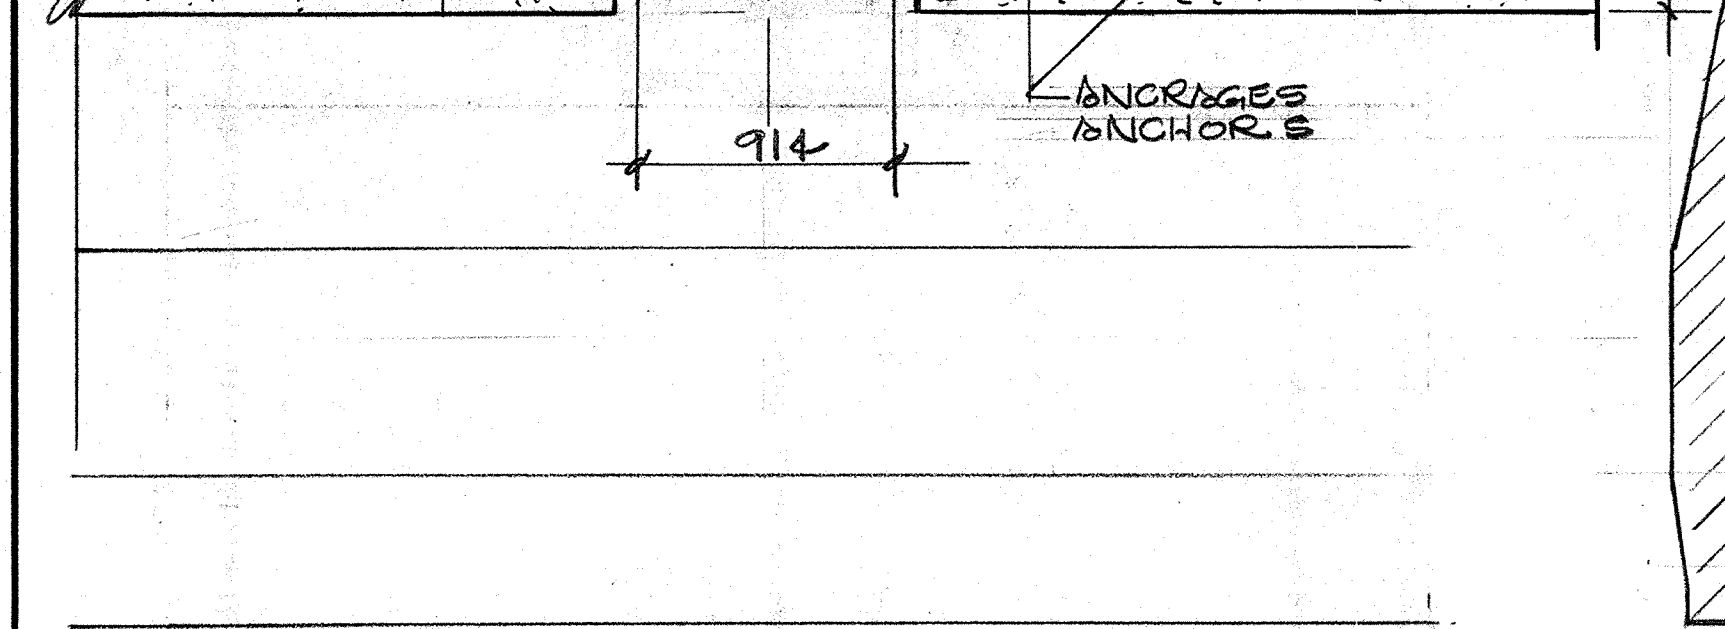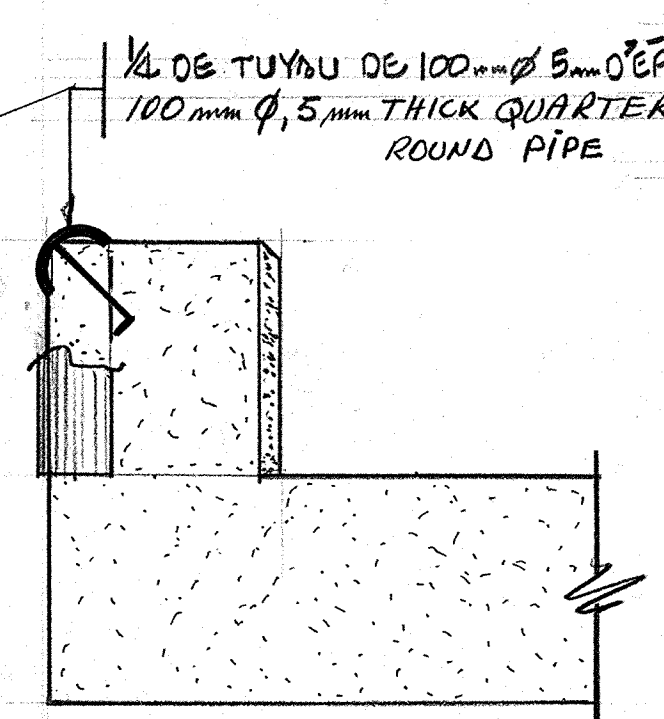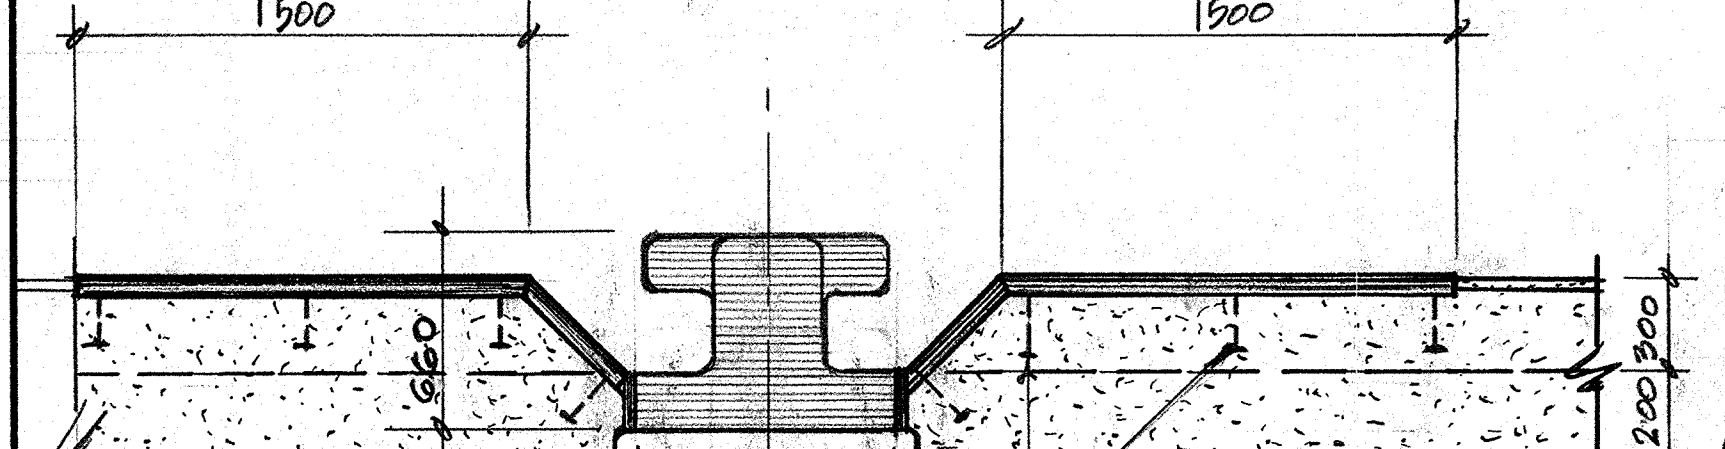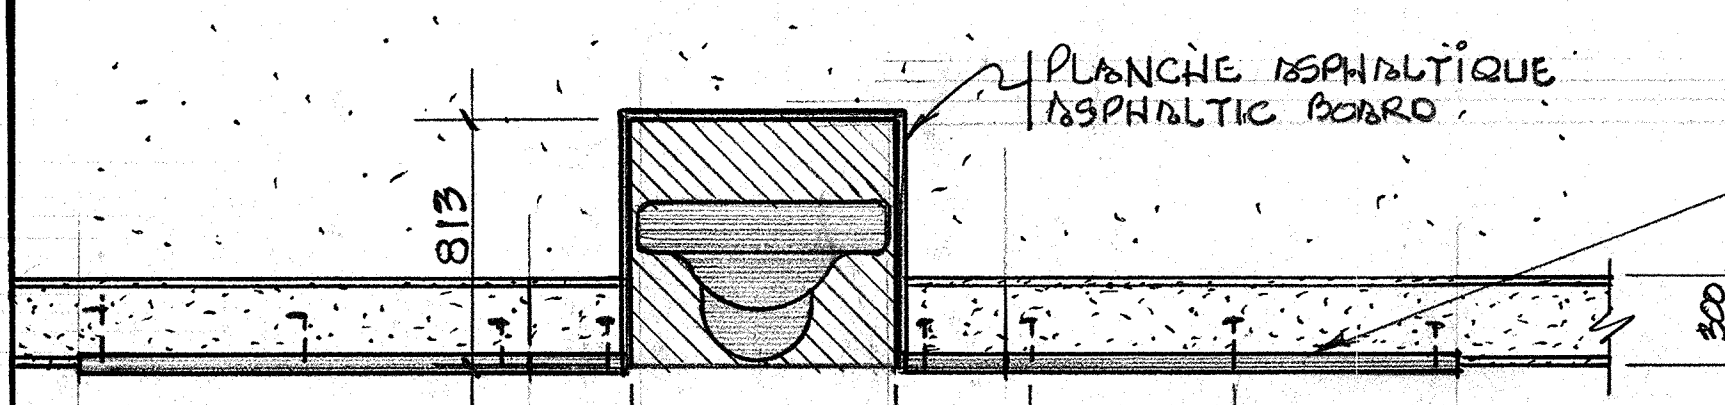

DÉTAILS DES BORNES D'AMARRAGE N° 2  
DETAILS OF N° 2 BOLLARDS

123  
1:25

TEL QUE CONSTRUIT  
As BUILT  
1991-11-07

revisions	date
A no. du détail detail no.	A
B sur dessin no. location drawing no.	B C
C dessin no. drawing no.	

projet  
MONT-LOUIS

RÉFÉCTION DE LA DALLE (200mm)  
(WHAT IS)  
REPAIRS TO THE SLAB (200mm)  
(EAST WHARF)

dessin  
ECHILLES  
BORNES D'AMARRAGES

LADDERS  
BOLLARDS

conçu E.L. designed

date

dessiné Richard drawn

date 10-06-21

examiné J.P. reviewed

date 91.6.13

approuvé B. Plante, ing. approved

date

Soumission 910613 Tender




Administratif sur des projets TPC PWC Project Manager

no. du projet 767358 project number




no. du dessin 1213-M drawing no.

5/7




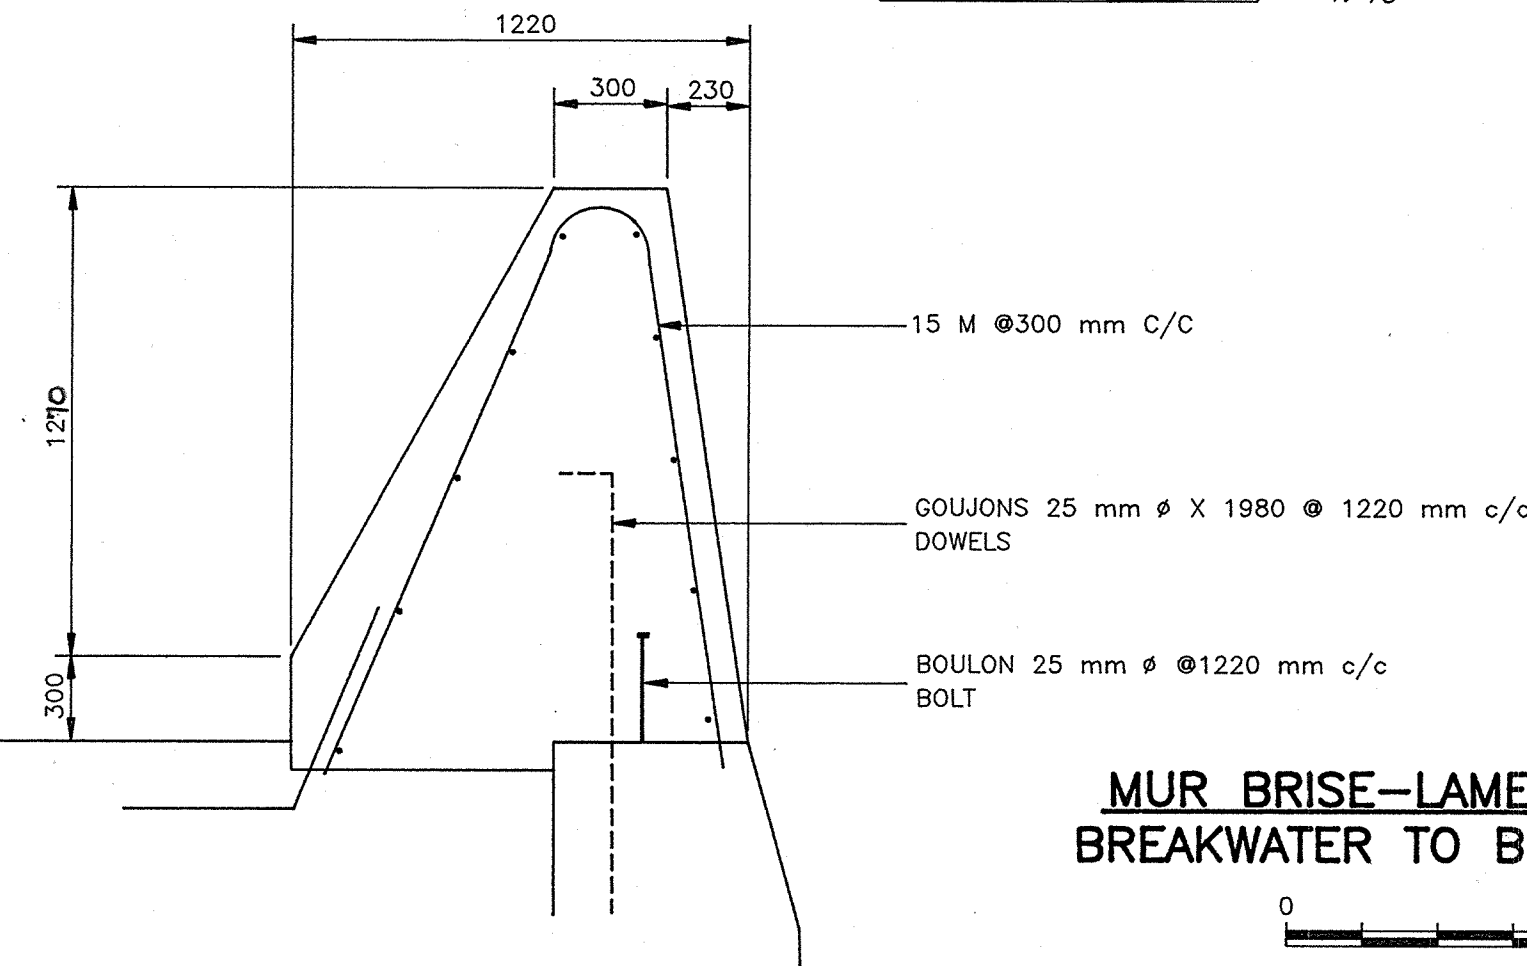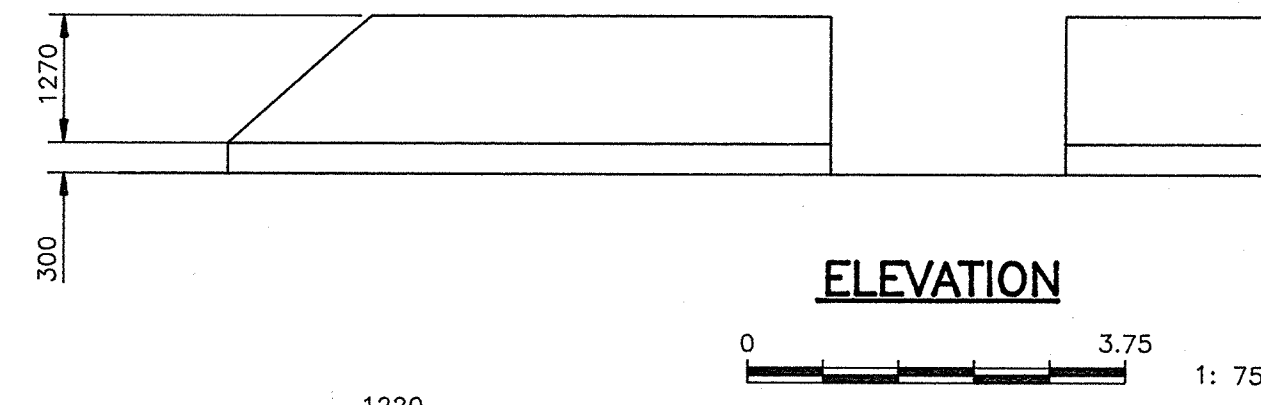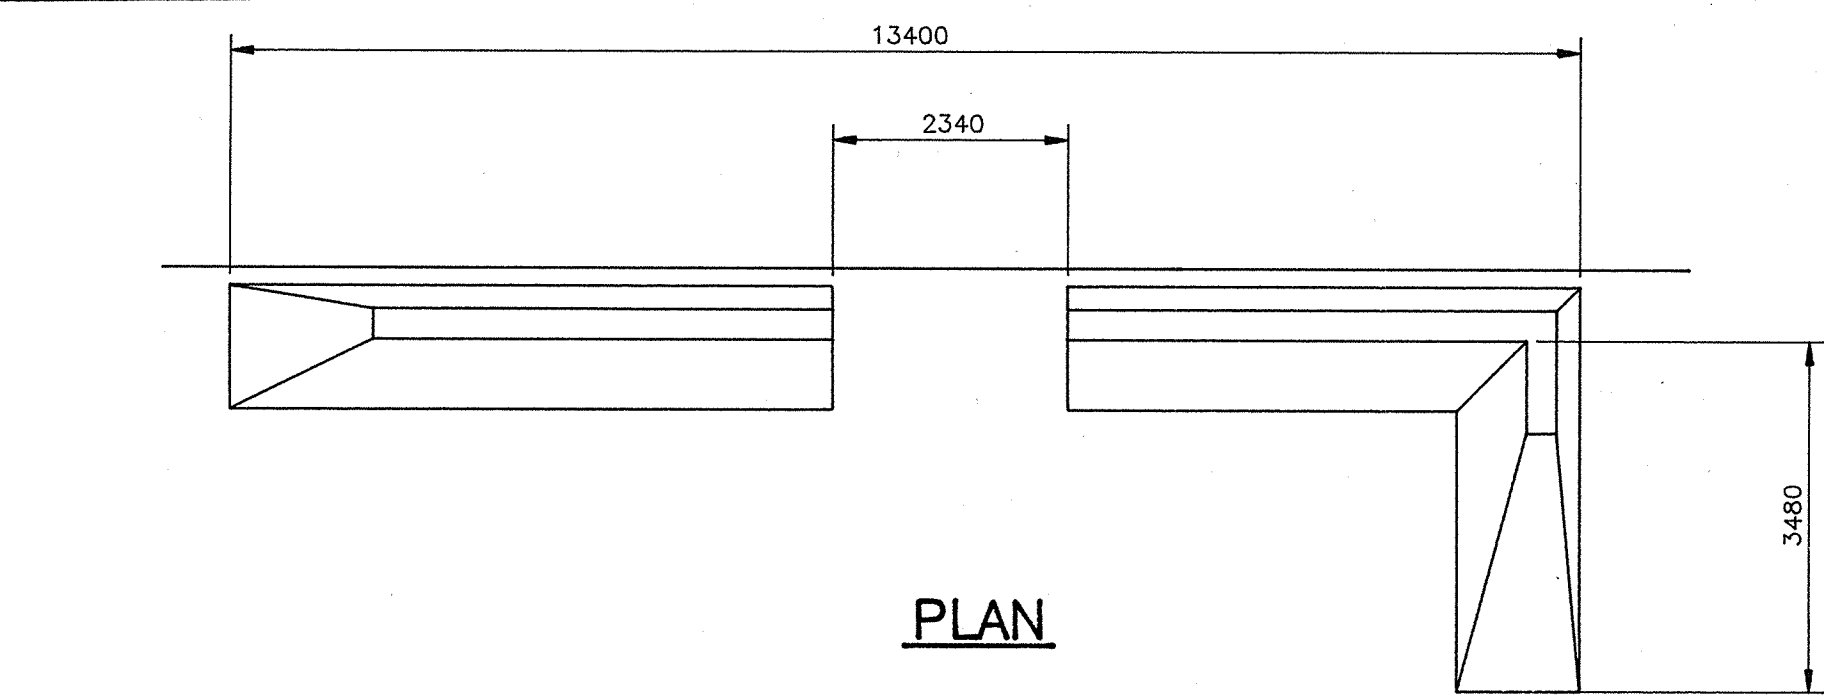


**MUR BRISE-LAMES A DEMOLIR**  
**BREAKWATER TO BE DEMOLISHED**

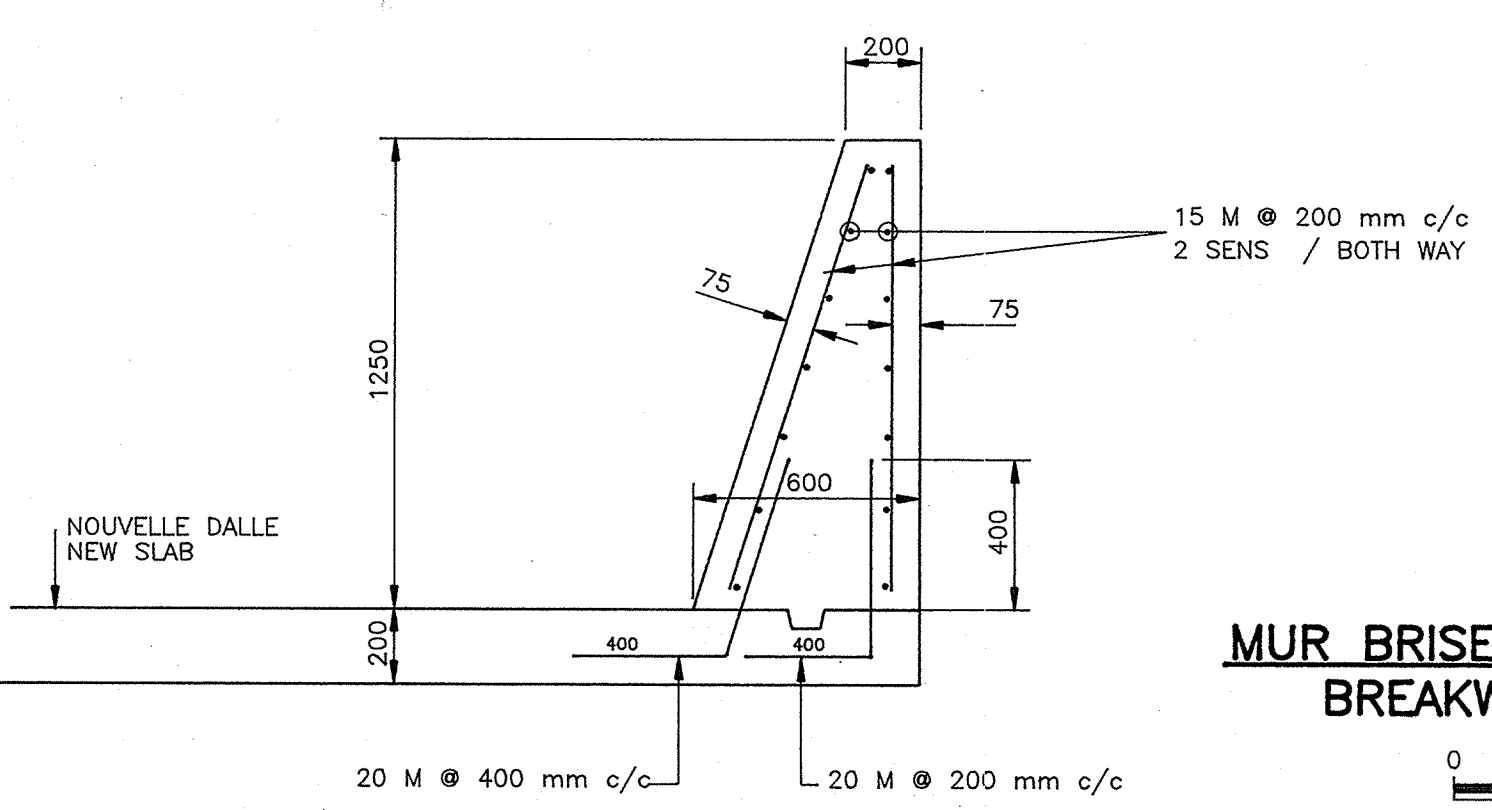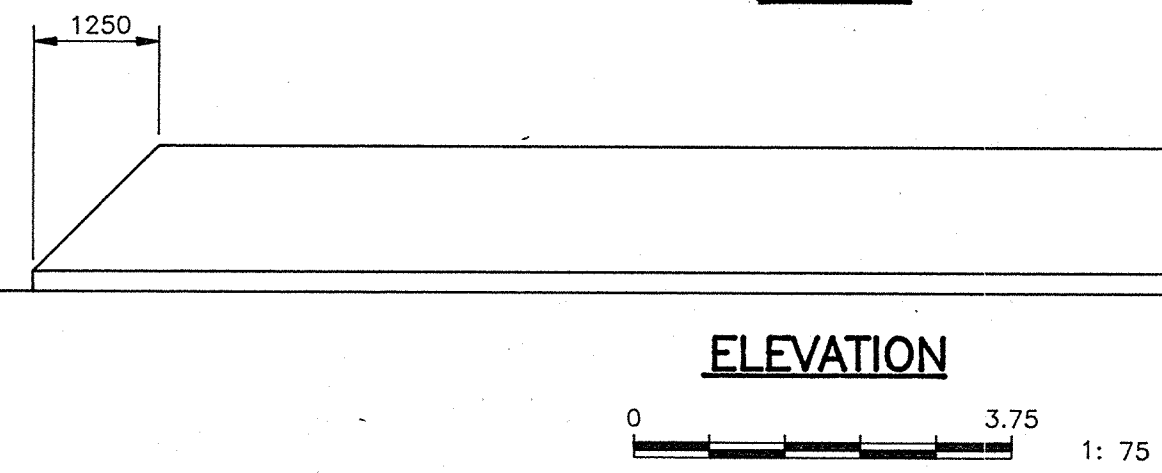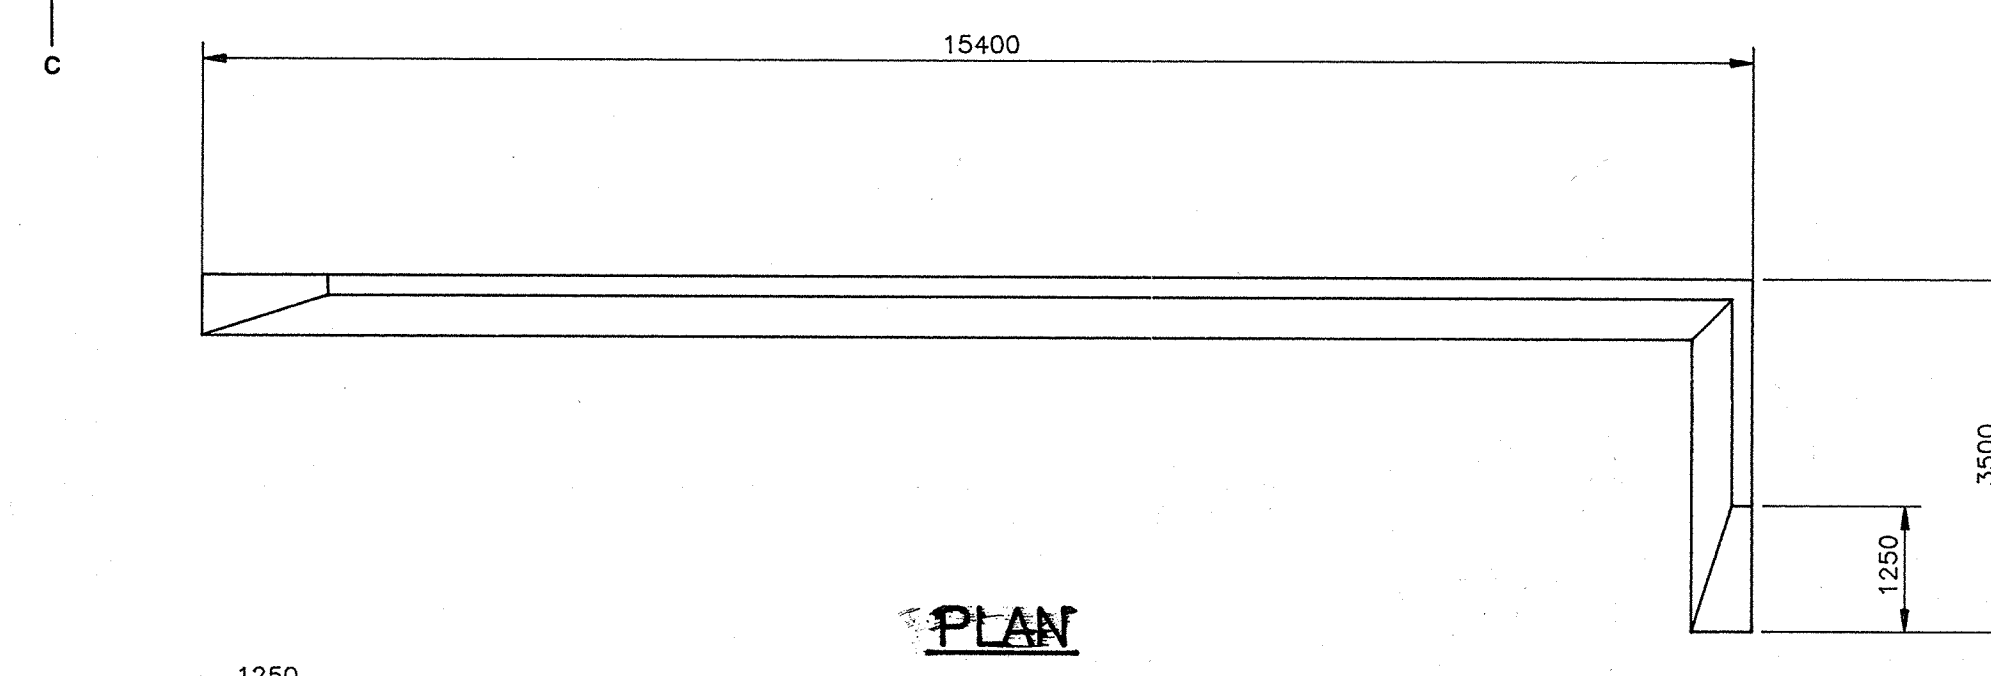

**MUR BRISE-LAMES A CONSTRUIRE**  
**BREAKWATER TO BE BUILT**

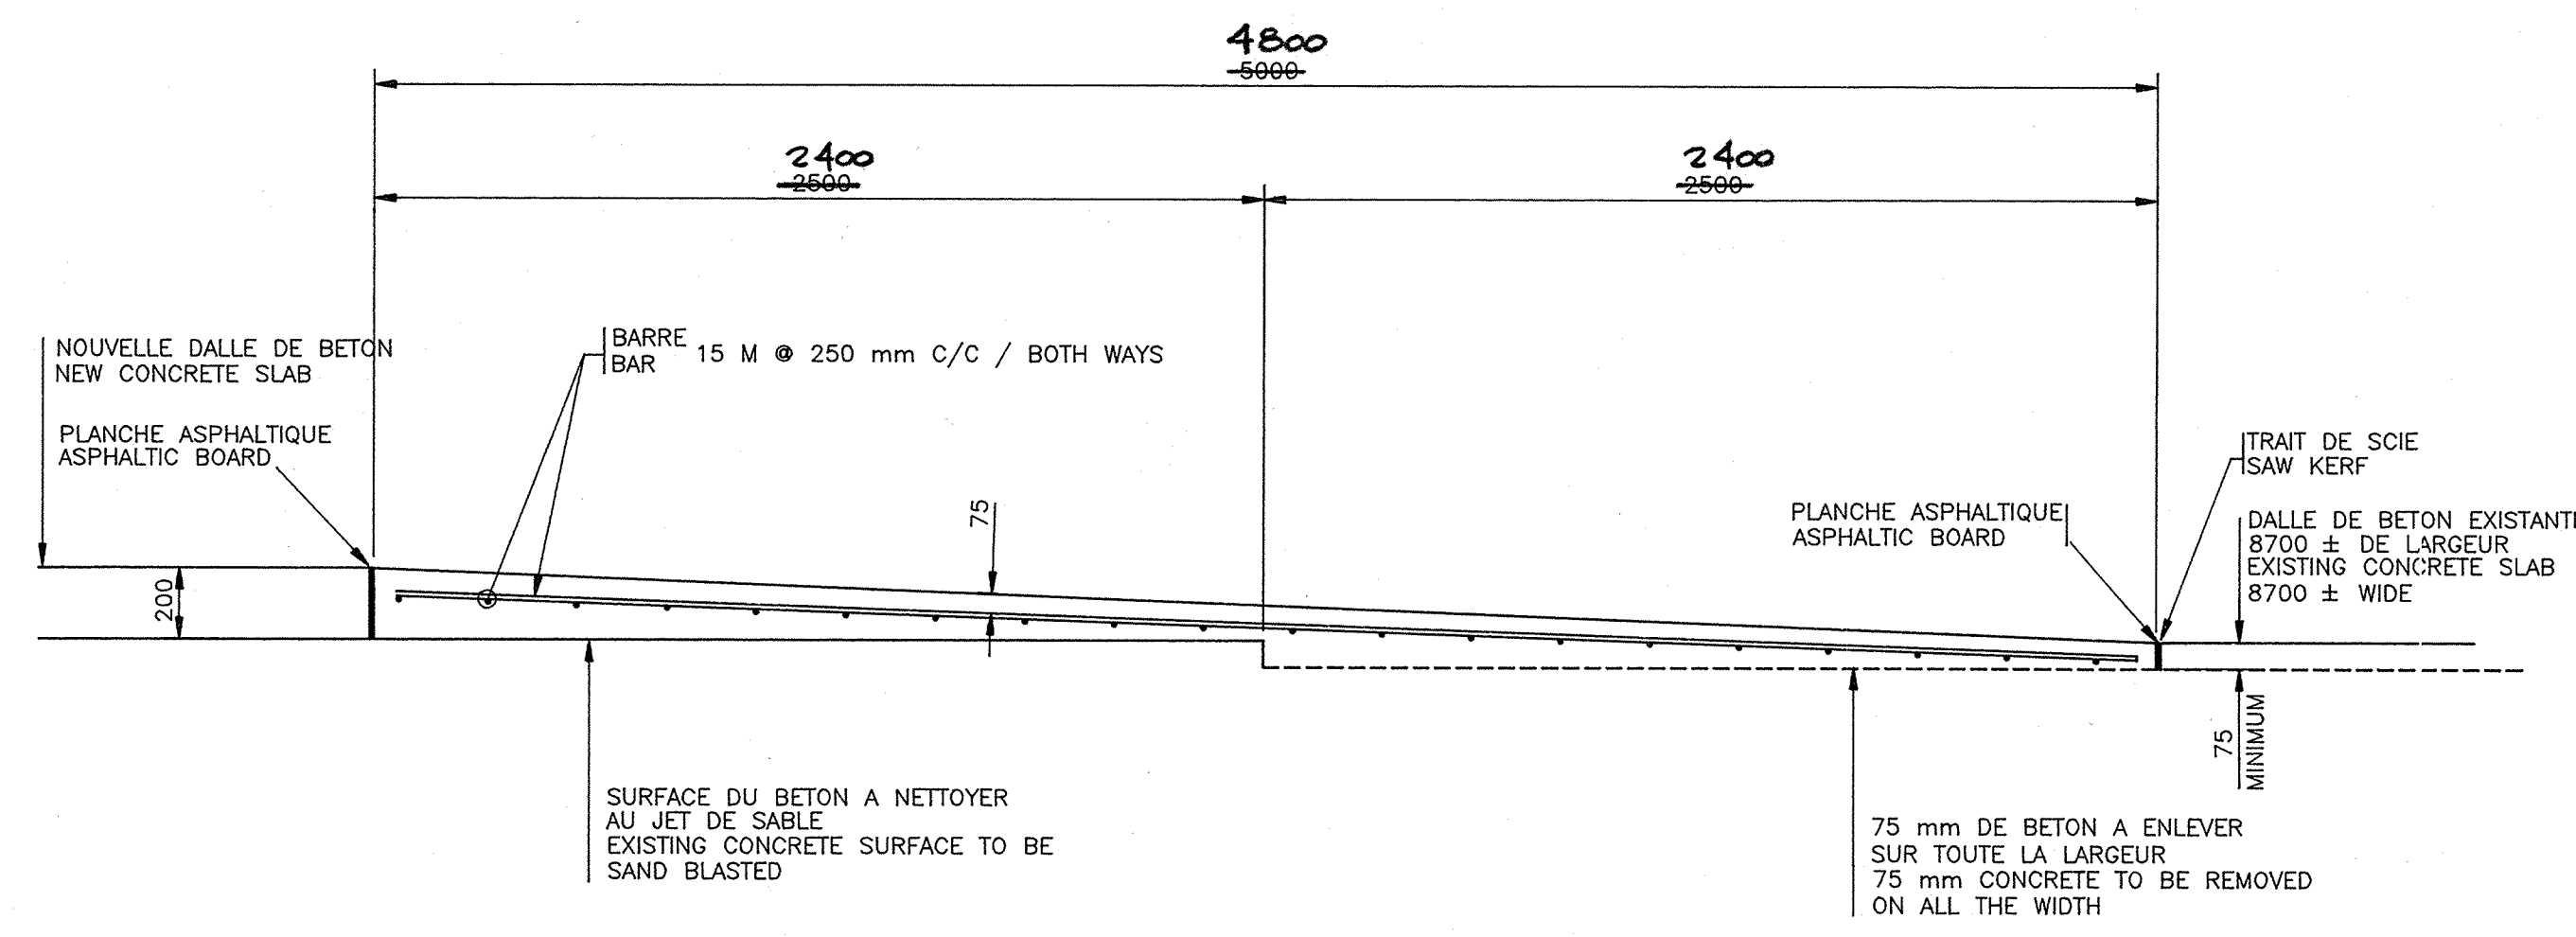

**RAMPE DE TRASITION A L'ENTREE DE LA CELLULE NO 1**  
**TRANSITION RAMP AT CELL NO 1 ENTRANCE**

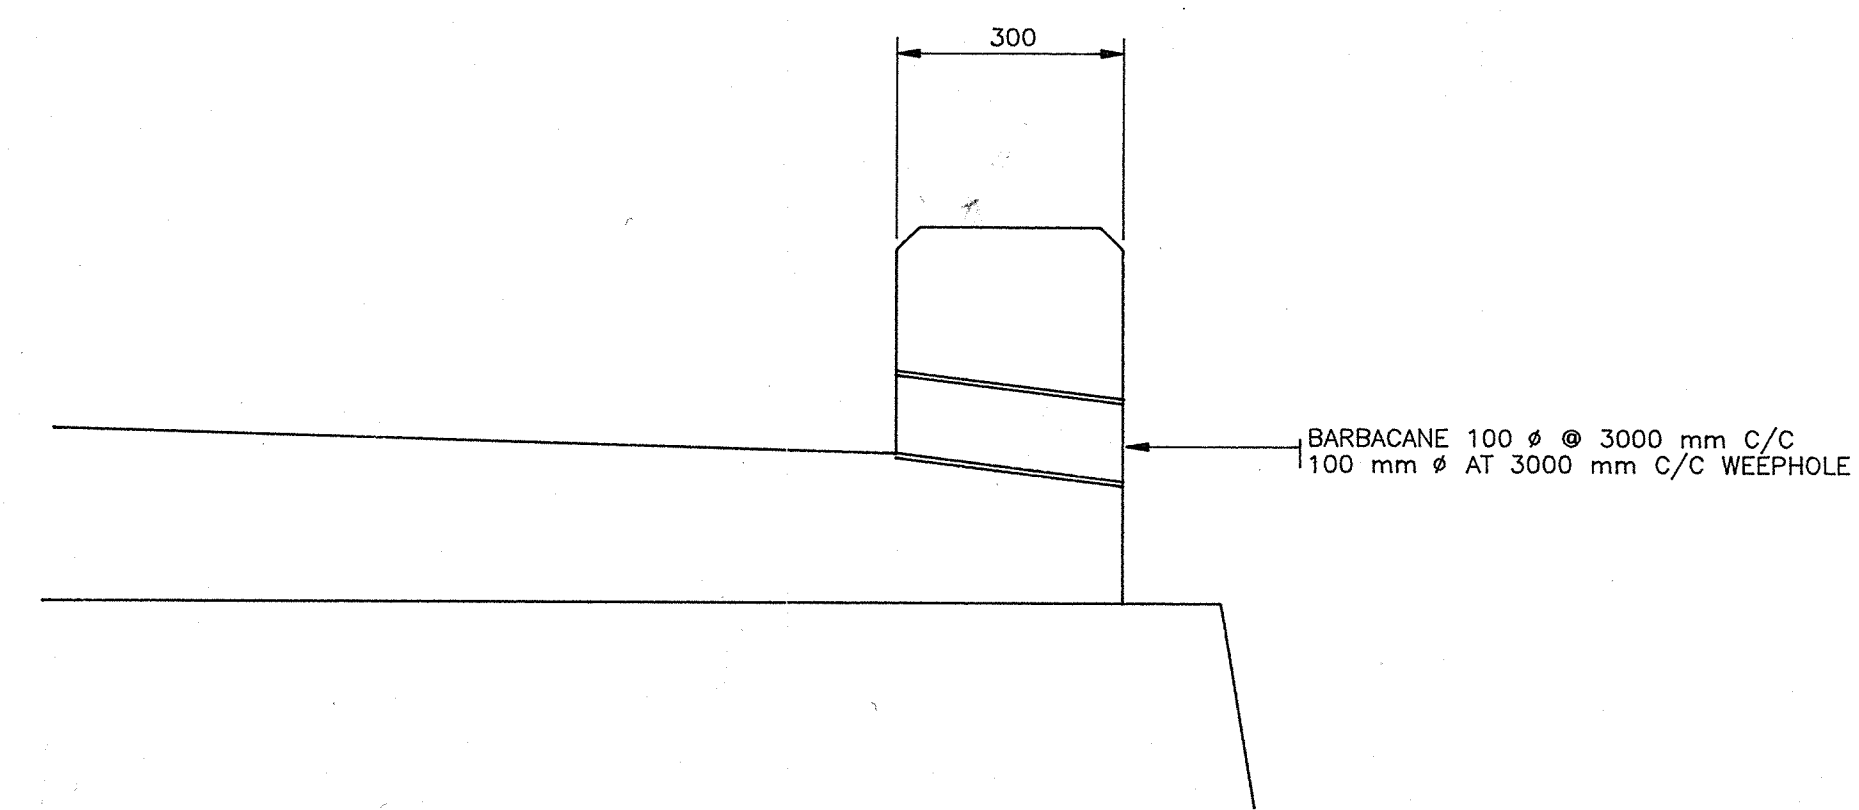

**DETAIL DES BARBACANES**  
**DETAIL OF WEEPHOLES**

TEL QUE CONSTRUIT  
As BUILT  
1991-11-07


revisions	date
A no. du détail detail no.	
B sur dessin no. location drawing no.	
C dessin no. drawing no.	

projet **MONT-LOUIS** project  
COMTE DE GASPE COUNTY  
REFECTION DE LA DALLE (200mm)  
( QUAI EST )  
REPAIRS TO THE SLAB (200 mm)  
( EAST WHARF )

dessin **MUR BRISE-LAMES EXISTANT** drawing  
**NOUVEAU MUR BRISE-LAMES**  
**RAMPE DE TRANSITION**  
**BARBACANES**  
**EXISTING BREAKWATER WALL**  
**NEW BREAKWATER WALL**  
**TRANSITION RAMP**  
**WEEPHOLES**


conçu date	F. VEILLETTE ing. jr.	designed
dessiné		drawn
date R. M. HAUD	1991-06-12	reviewed
examiné		approved
date	9/6/13	
approuvé		
date		
Soumission		Tender
Administrateur de projets TPC		PWC Project Manager
no. du projet	767358	project number
no. du des. in		drawing no.

135 QU-1213-M 6/7

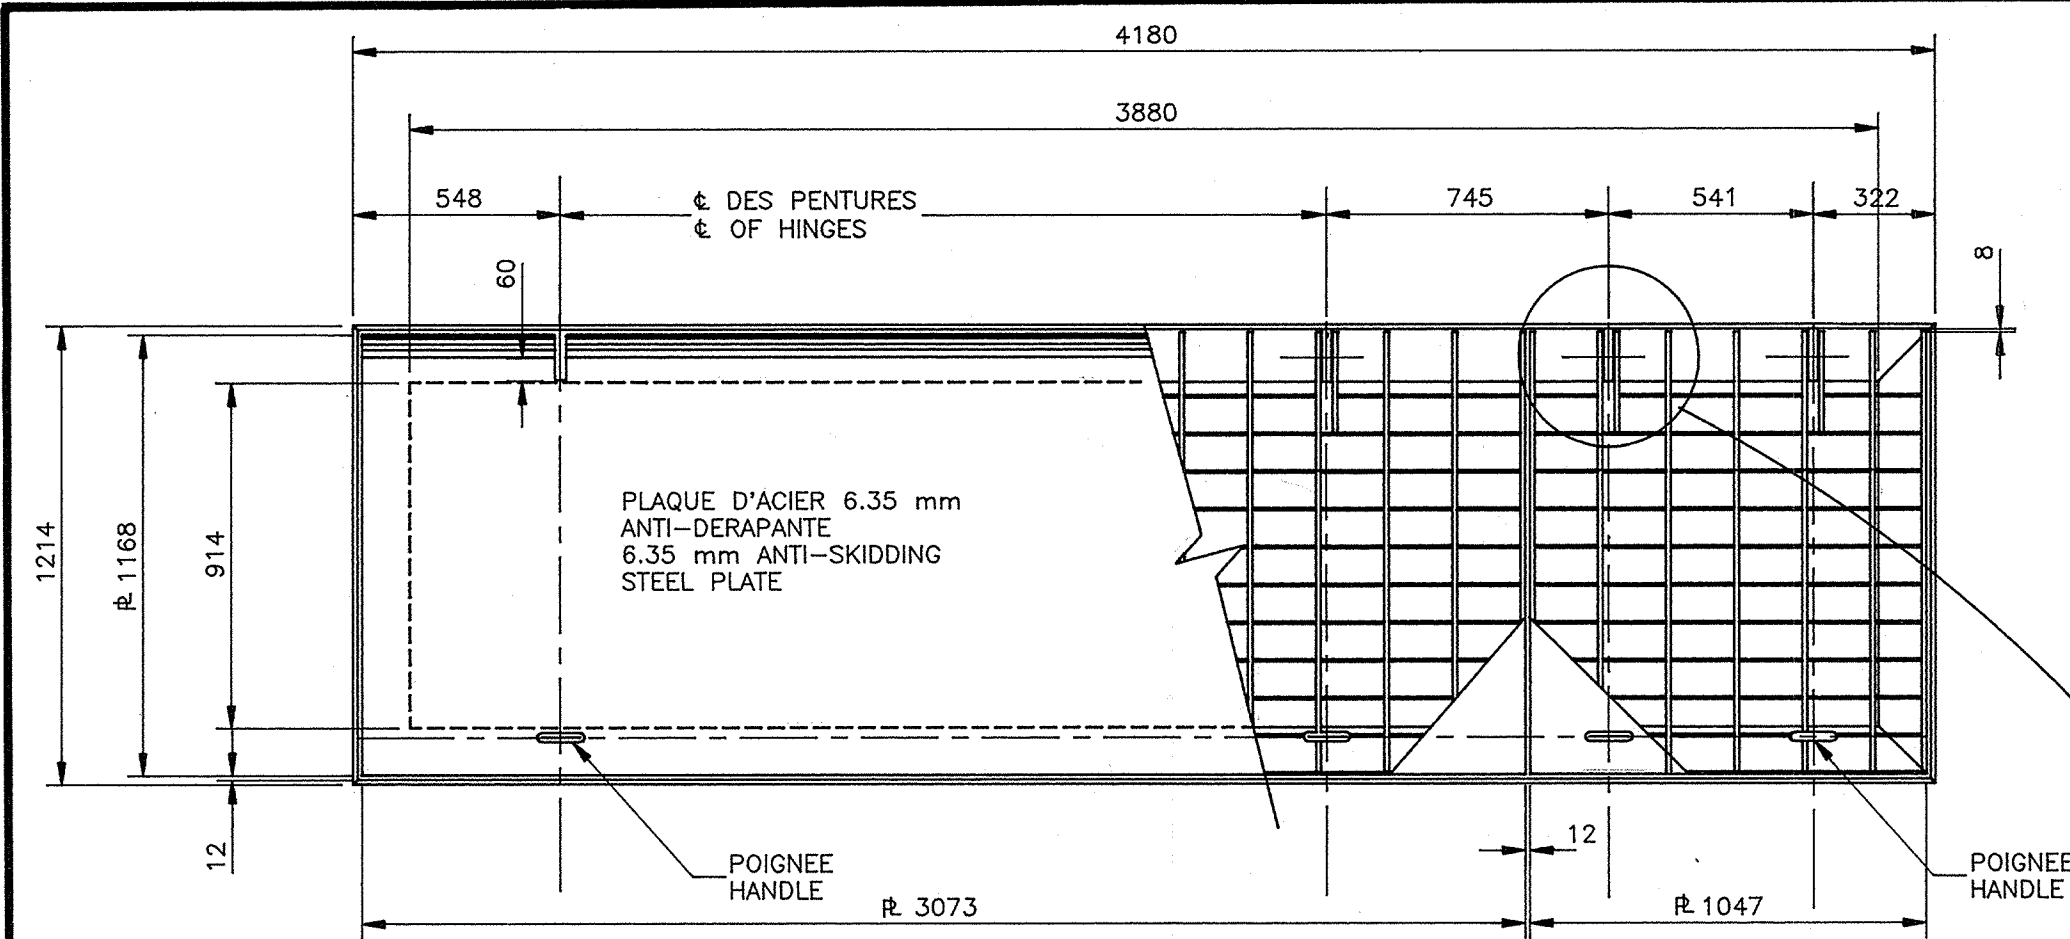


PLAN DE LA TRAPPE D'ACCES  
PLAN OF THE ACCESS DOOR

0 1000 1: 20

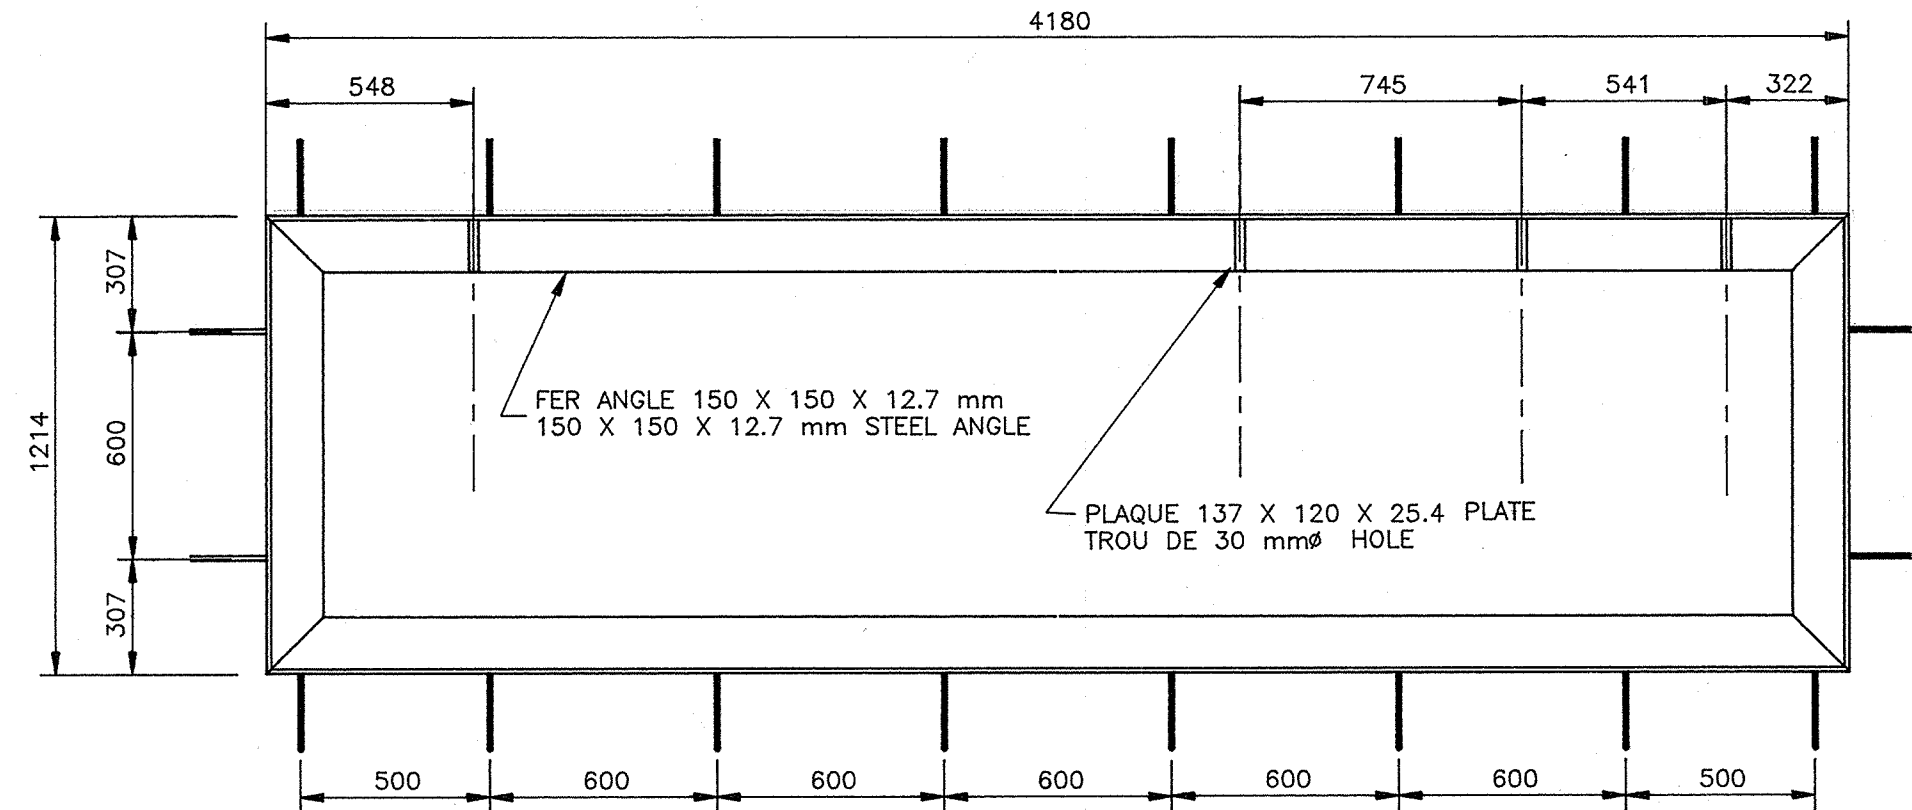


PLAN DU CADRE DE METAL  
PLAN OF METAL FRAME

0 1000 1: 20

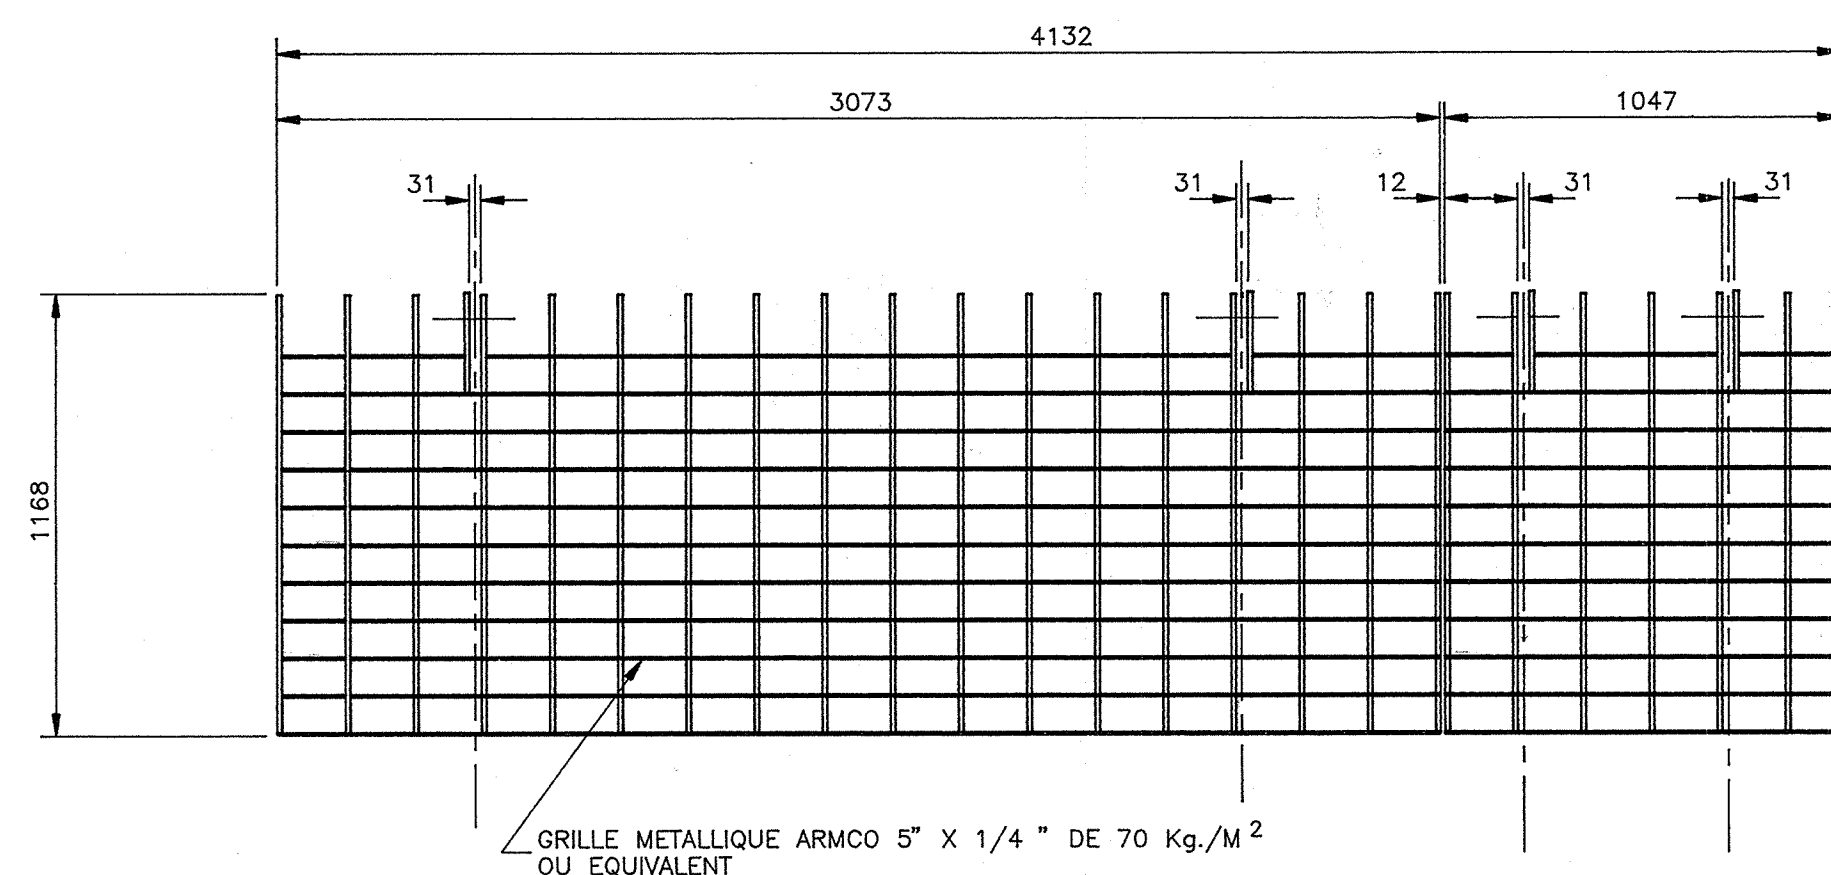

PLAN DE LA GRILLE  
PLAN OF THE GRATE


0 1000 1: 20

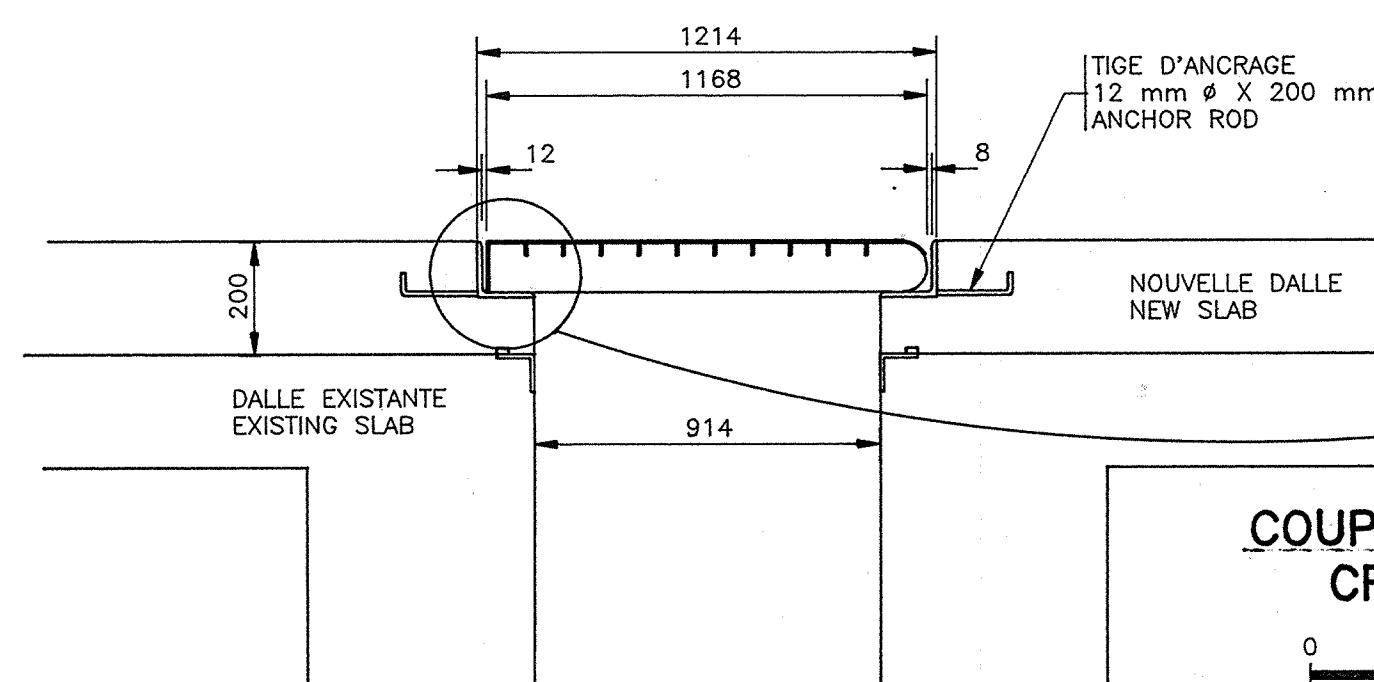

COUPE TRANSVERSALE  
CROSS SECTION

0 1000 1: 20



SUR LES CELLULES NO #1 A #5 LES PENTURES SONT POSEES CÔTÉ "SUD" / ON CELLS NO #1 TO #5 HINGE DEVICES ARE PLACED ON SOUTH SIDE.

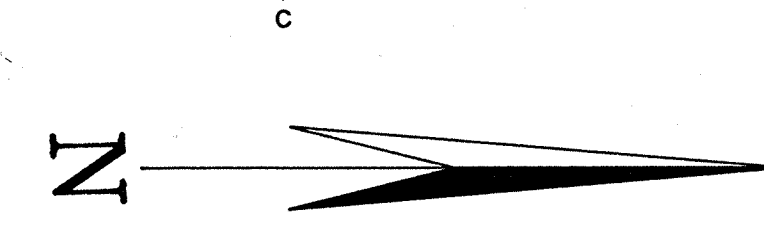


5 50-200 5 50-200  
SUR BARRE PRINCIPALE / ON MAIN BAR

DETAIL DES PENTURES " B "  
DETAIL OF HINGES

0 0.1 1: 2

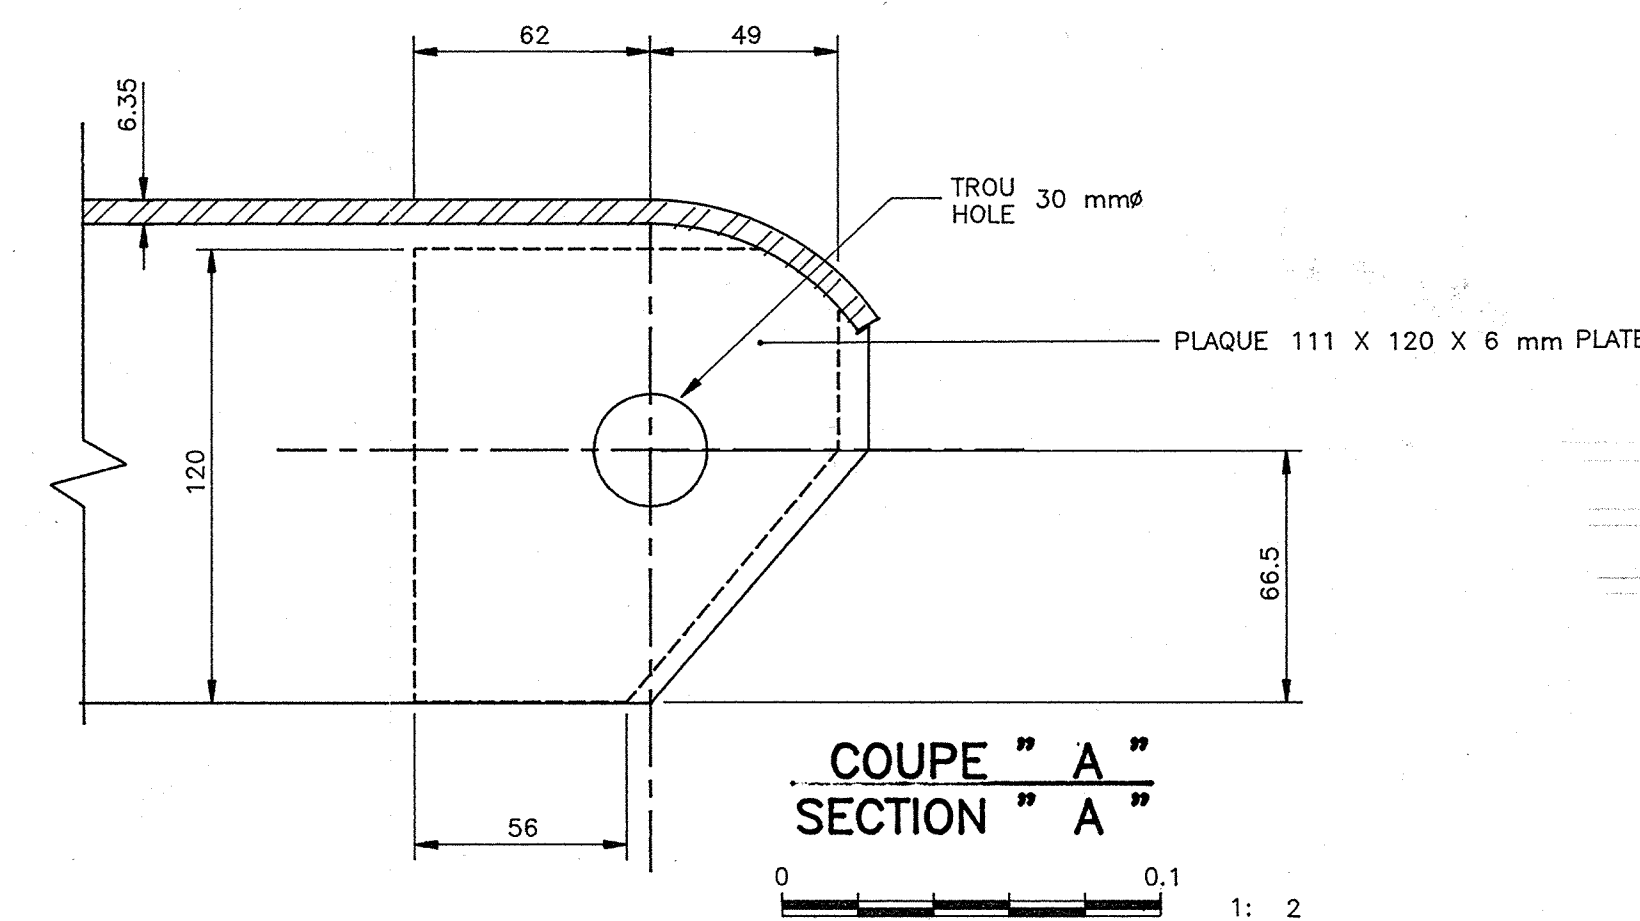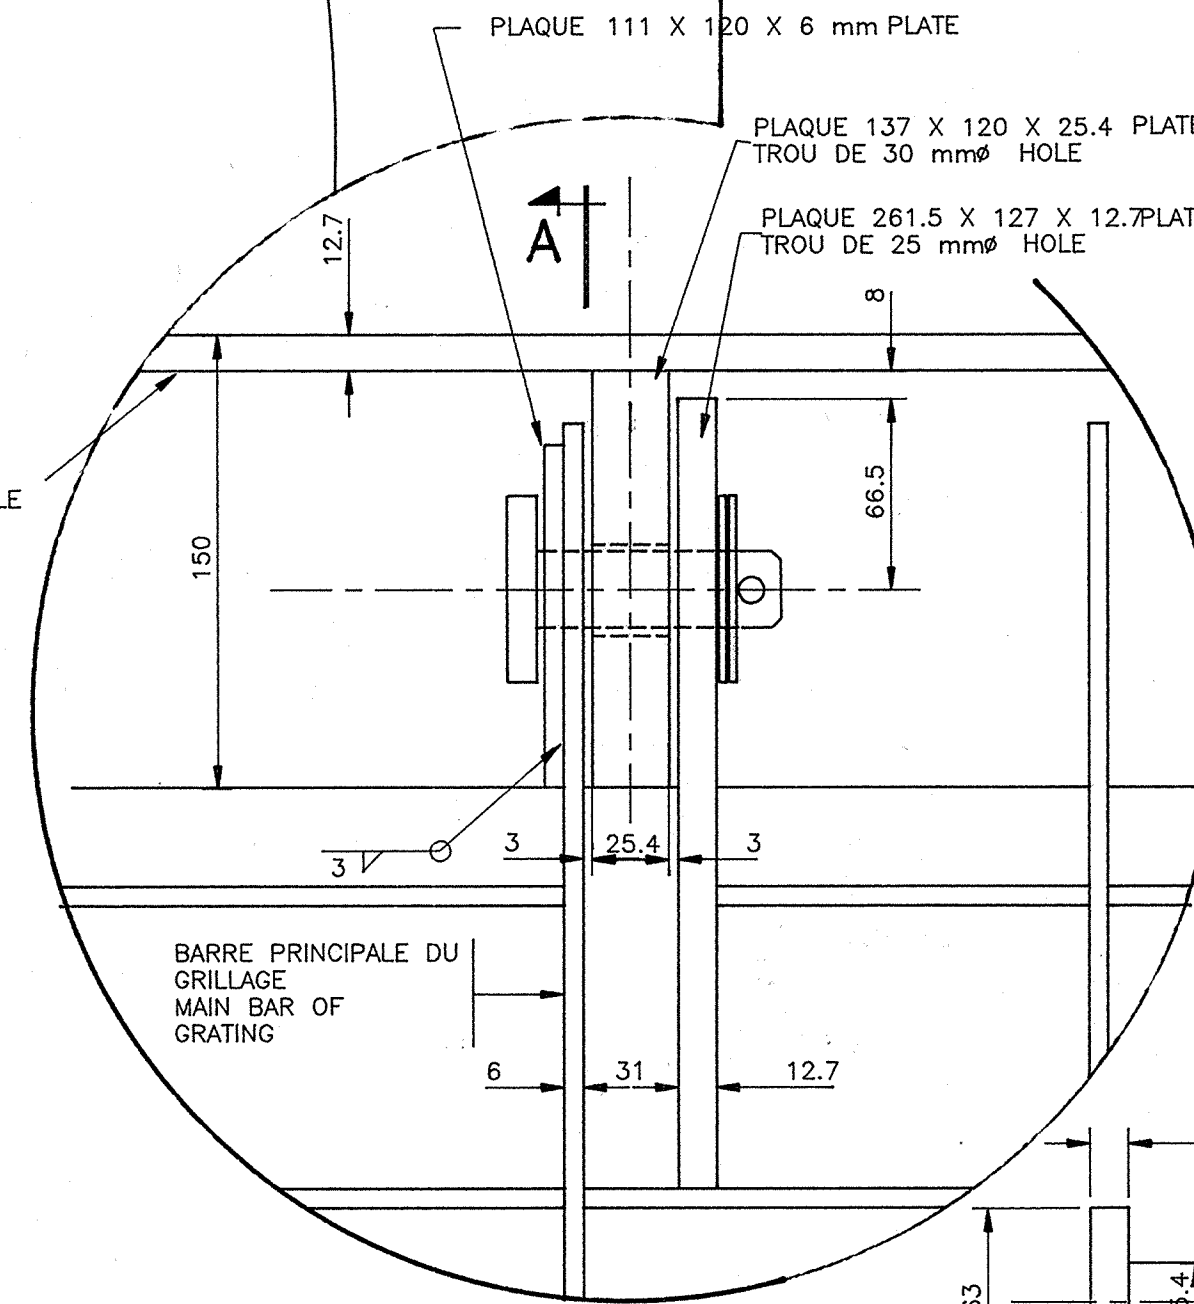

0 0.1 1: 2

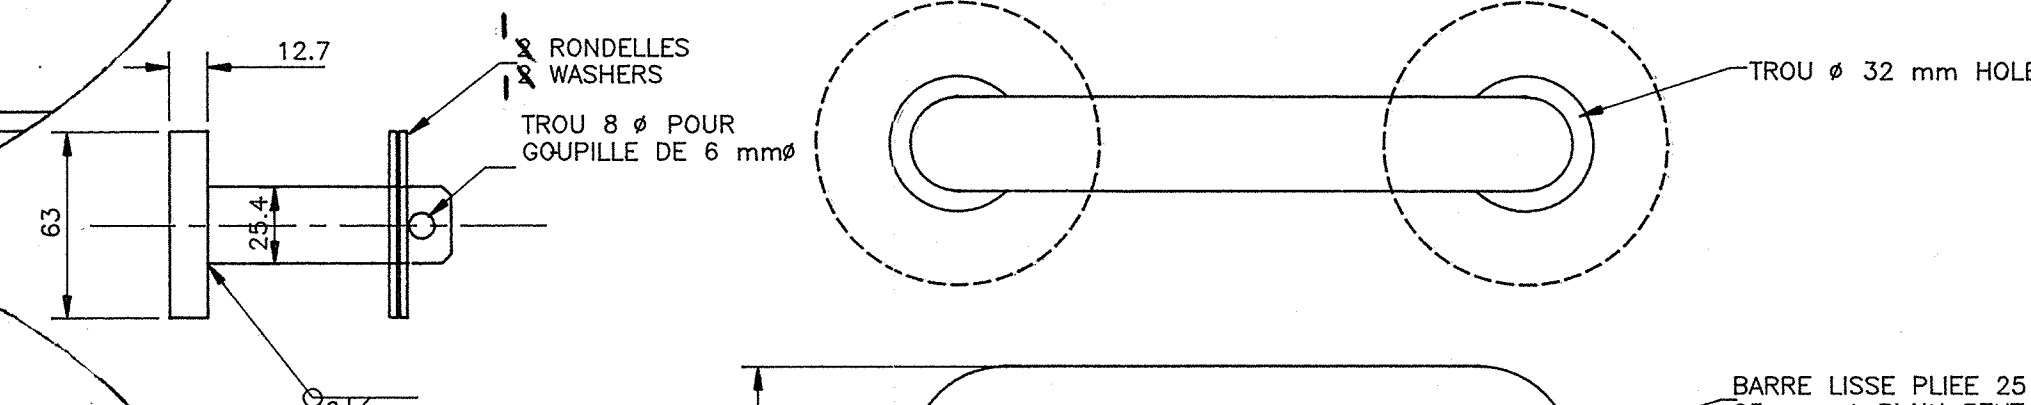

DETAIL DES POIGNEES  
DETAIL OF HANDHOLD

0 0.1 1: 2

TEL QUE CONSTRUIT  
AS BUILT  
1991-11-07

revisions date

A no. du détail detail no.  
B sur dessin no. location drawing no.  
C dessin no. drawing no.

projet MONT-LOUIS projet

COMTE DE GASPE COUNTY  
REFECTION DE LA DALLE (200mm)  
( QUAI EST )  
REPAIRS TO THE SLAB (200mm)  
( EAST WHARF )

dessin drawing

GRILLES GRATES

conçu designed

date J.P. ?

dessiné drawn

date R.M CHAUD 1991-06-12

examiné reviewed

date 9.6.13

approuvé approved

date

Soumission Tender

Administrateur de projets TPC PWC Project Manager

no. du projet project number

767358

no. des in drawing no.

185 QU-E1213-M 7/7