

A detail no.  
no. du détail

B location drawing no.  
sur dessin no.

C drawing no.  
dessin no.

project: **G.O.C.B.  
BEDFORD ROW  
HALIFAX, N.S.**


# BOILER ROOM LAYOUT and PIPING DIAGRAM

designed	P. DUARESAQ	conçu
date		
drawn	L. DEVEAU	dessiné
date		
reviewed	<i>R. P. [signature]</i>	examiné
date	9/15/16	
approved		approuvé

Tender	Submission
PWC Project Manager	Administrateur de projets PWC
project number	no. du projet
	614362
drawing no.	no. du dessin



SCALE 1/4" = 1'-0"

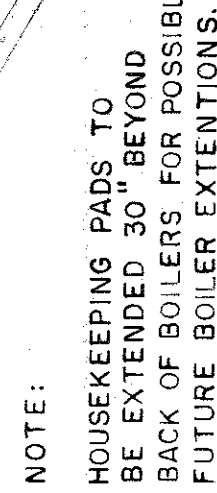

N. T. S.

NOTE: SEE SPECIFICATIONS FOR REQUIRED LOCATIONS OF THERMOMETERS, PRESSURE GAUGE, ETC.

92/03/4

# AS BUILT DRAWING

100