


# PLAN BRIDGE / LOUNGE 7<sup>TH</sup> FLOOR

SCALE: 1/8" = 1'-0"

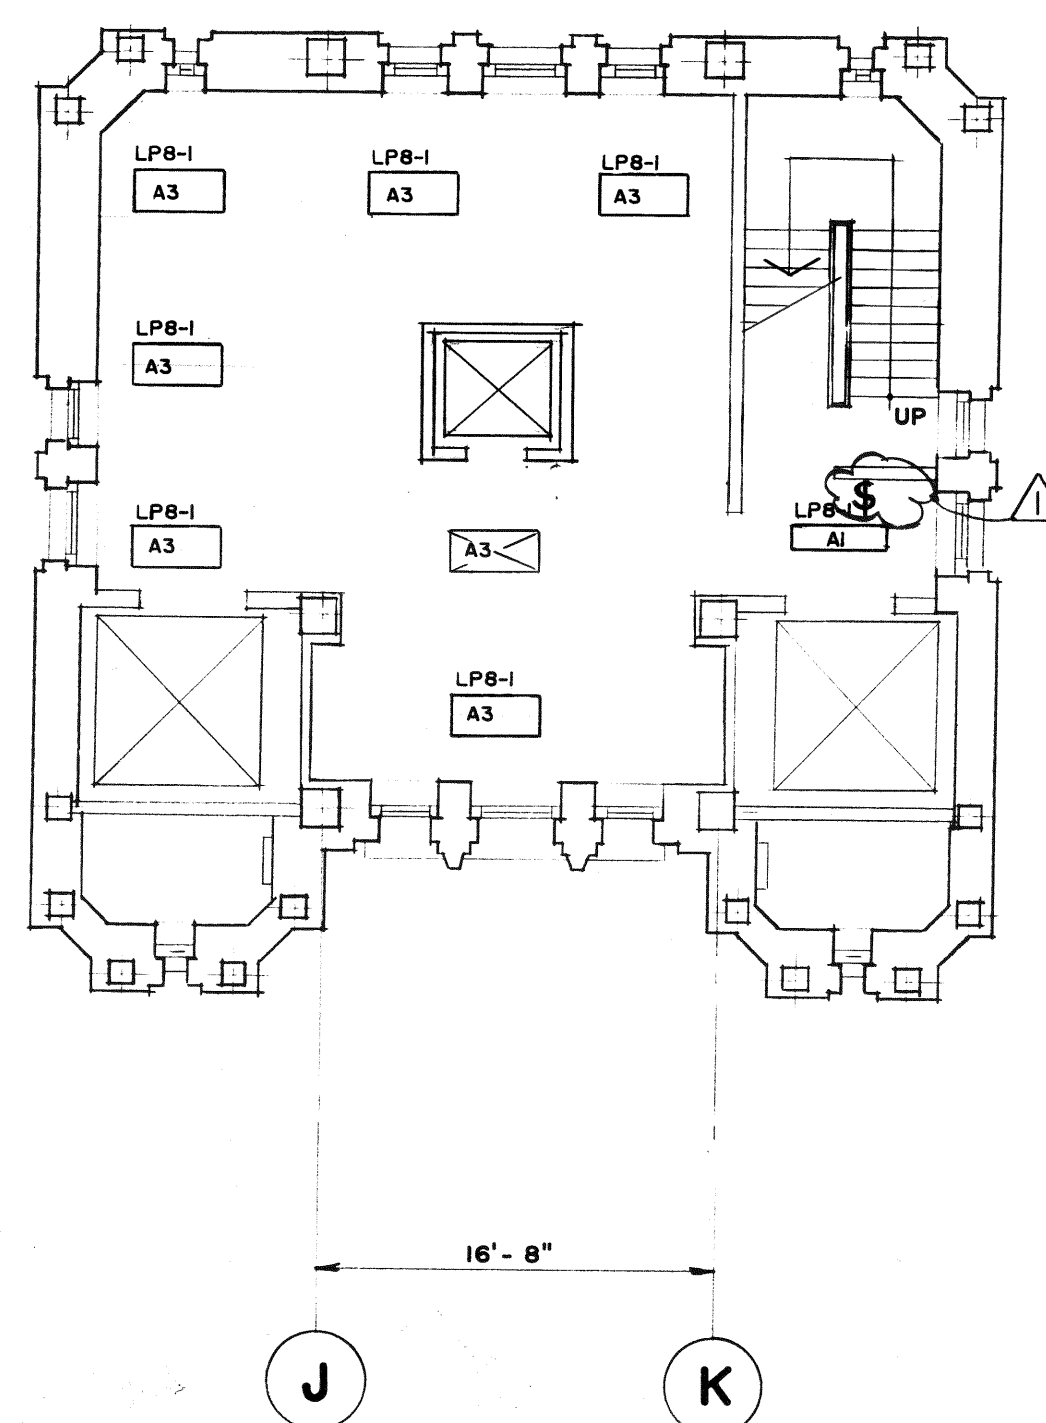

## EIGHTH FLOOR PLAN

SCALE: 1/8" = 1'-0"

### LIGHTING LEGEND:

(REFER TO MAIN LEGEND ON DRAWING E-31)

- A1 - 1-LAMP, 4' X 5", SURFACE MOUNTED FLUORESCENT FIXTURE. C/W 1 TYPE F1 LAMP AND WRAP AROUND LENS.
- A3 - 3-LAMP, 4' X 14", SURFACE MOUNTED FLUORESCENT FIXTURE. C/W 3 TYPE F1 LAMPS AND WRAP AROUND LENS. CHAIN SUSPENDED.
- A4 - 3-LAMP, 4' X 2'; SURFACE MOUNTED FLUORESCENT FIXTURE. C/W 3 TYPE F1 LAMPS AND A DEEP CELL PARABOLIC LENS. PENDANT MOUNTED.
- A6 - 3-LAMP, 4' X 2'; SURFACE MOUNTED FLUORESCENT FIXTURE. C/W 3 TYPE F1 LAMPS AND A DEEP CELL PARABOLIC LENS. PENDANT MOUNTED.
- B4 - RECESSED; 3-LAMP, FLUORESCENT FIXTURE C/W 3 TYPE F1 LAMPS AND FRAMED LENS.
- B6 - RECESSED; 3-LAMP, FLUORESCENT FIXTURE C/W 3 TYPE F1 LAMPS AND A DEEP CELL PARABOLIC LENS.

- C1 - 4'; SINGLE TUBE, FLUORESCENT STRIP LIGHT. C/W 1 TYPE F1 LAMPS.
- C2 - 4'; 2-LAMP FLUORESCENT STRIP LIGHT. C/W 2 TYPE F1 LAMPS.
- C3 - 2'; SINGLE LAMP, FLUORESCENT STRIP LIGHT. C/W 1 TYPE F1 LAMPS.
- D1 - SURFACE MOUNTED, FLUORESCENT WALL SCONCE C/W PL-13 LAMPS. (FOUNTAIN)
- D2 - RECESSED CEILING MOUNTED WALL WASHER FIXTURE. C/W 2 PL-7 LAMPS. MOUNTED ABOVE FOUNTAIN.
- E5 - WALL MOUNTED (SURFACE), 4' X 8" FLUORESCENT FIXTURE C/W 2 TYPE F1 LAMPS. MOUNTED 1'-0" BELOW CEILING.
- F1 - PENDANT MOUNTED; INDUSTRIAL TYPE 2-LAMP, FLUORESCENT FIXTURE C/W 2 TYPE F1 LAMPS AND A SLOTTED REFLECTOR.
- V1 - 2-LAMP, SURFACE MOUNTED VAPOUR PROOF FLUORESCENT FIXTURE C/W 2 TYPE F1 LAMPS.
- I4 - RECESSED, 2 LAMP FLUORESCENT FIXTURE C/W 2-13W PL LAMPS.
- X - WALL OR CEILING MOUNTED EXIT LIGHT. RESPECTIVELY.
- S1 - 200W, 347V SURFACE MOUNTED. METAL HALIDE FIXTURE.

## SEVENTH FLOOR PLAN

SCALE: 1/8" = 1'-0"

- A5 - 2x4 2-LAMP FLUORESCENT FIXTURE. RECESSED IN GYPSED CEILING.
- D3 - SAME AS D2 EXCEPT DOWNLIGHT ONLY

### NOTES:

1. ALL EMERGENCY AND EXIT LIGHTING FOR THIS FLOOR ON CIRCUIT ELP2-8.
2. SEE DRAWING E-7 FOR INSTALLATION DETAIL OF BRIDGE AND ATRIUM LIGHTING.
3. ALL LIGHTING TO BE INSTALLED USING MODULAR WIRING SYSTEM. (SEE SPECIFICATION)
4. EACH PAIR OF 3-LAMP FIXTURES SHALL HAVE 3-2 LAMP-BALLASTS. WIRE ACCORDINGLY.
5. DIV.6 CONTRACTOR TO CONFIRM EXACT LOCATION OF ALL FIXTURES ON SITE WITH DIV.1 CONTRACTOR AND ENGINEER PRIOR TO INSTALLATION.
6. SWITCHES SHOWN IN ROOMS 705, 706, 708, 709 AS WELL AS THE MASTER SWITCH SHOWN IN THE ELEVATOR LOBBY 731 HAVE BEEN SUPPLIED UNDER CCN I-E.

### NOTES CONT'D:

7. TYPE C2 FIXTURES TO BE MOUNTED IN VALANCE. SUPPLY TYPE K-12 LENS. CUT LENS TO SUIT.

REVISIONS	DATE
1. FIT-UP REQUIREMENTS, DELETIONS, ADDITIONS AND RELOCATIONS OF SWITCHES AND LIGHT FIXTURES.	NOV. 1991

A	A
C	B
	C

PROJECT: G.O.C.B. BEDFORD ROW HALIFAX, N.S.

## SEVENTH FLOOR PLAN LIGHTING

### ELECTRICAL

DESIGNED: G.C. HICKS	CONC'D:
DRAWN: W. SZUBIELSKI	DESIGN:
DATE: 11/12/91	EXAMINE:
APPROVED: [Signature]	APPROVE:
TENDER: [Signature]	SUBMISSION:
PWC PROJECT MANAGER: [Signature]	ADMINISTRATEUR DE PROJETS TPC:
PROJECT NUMBER: 800769	NO. DU PROJET:
DRAWING NO: E-9	NO. DU DESSIN: