




RAIN CAP

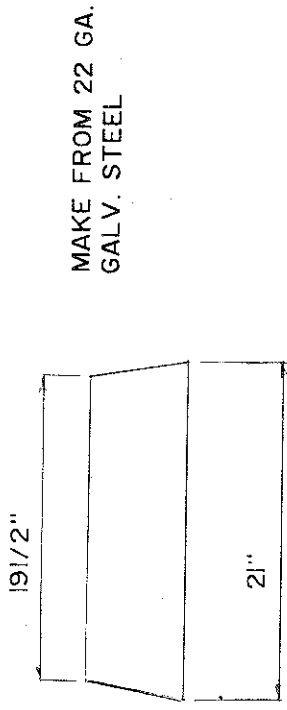


STORM COLLAR

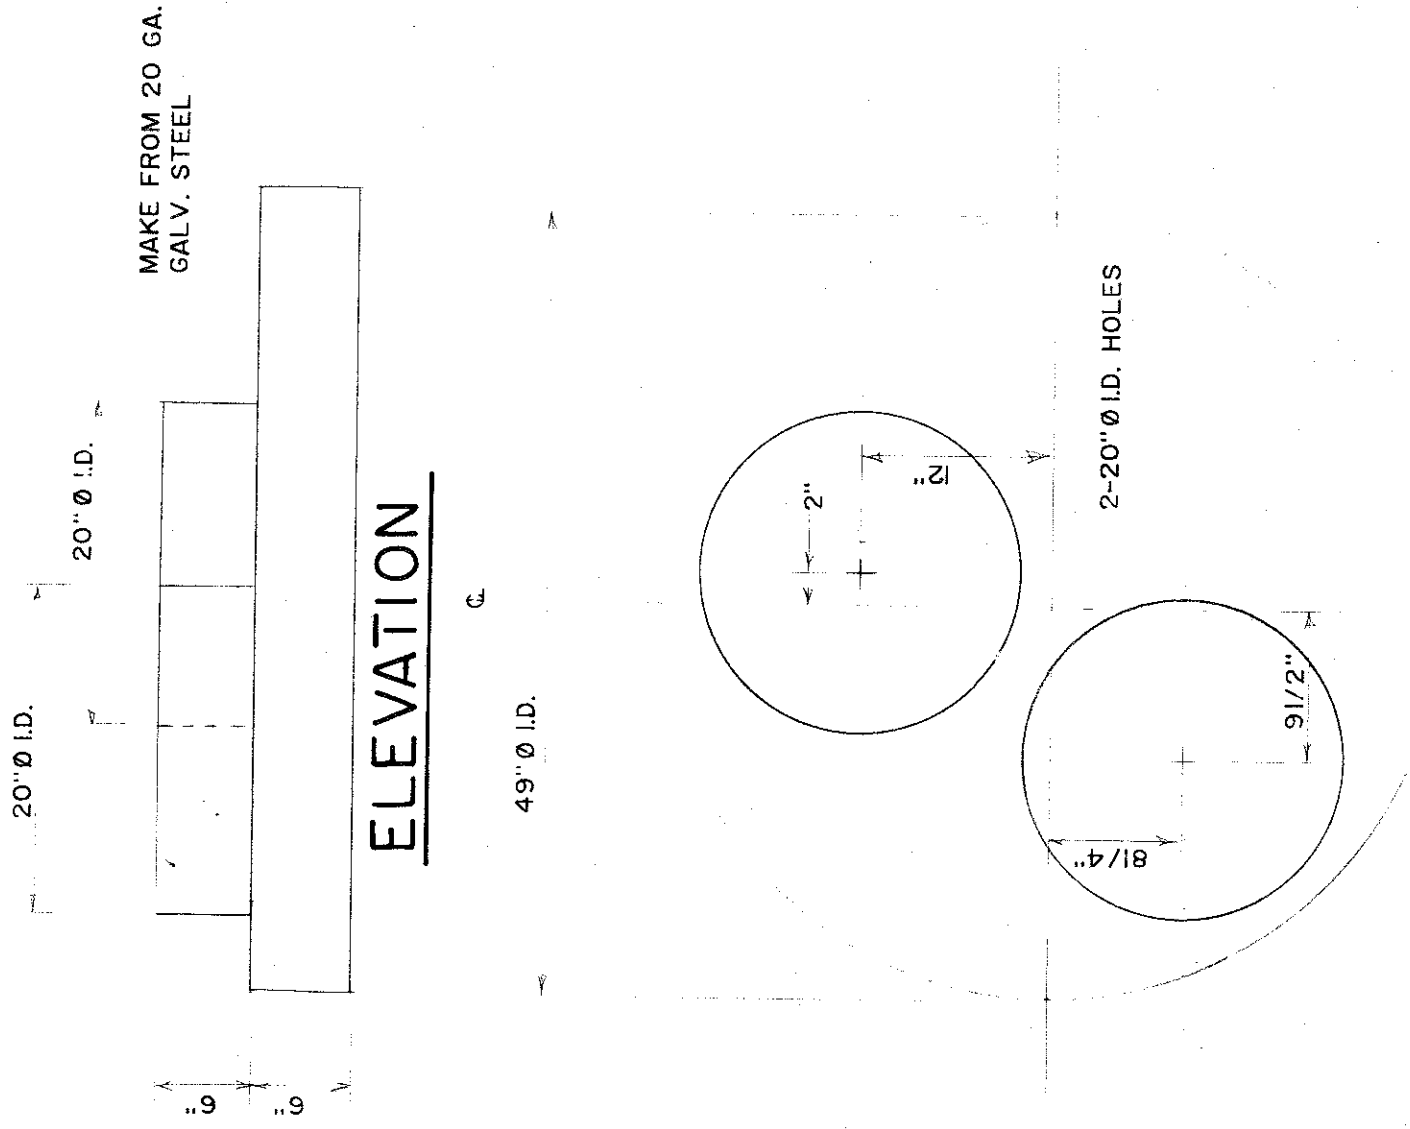


PLAN
CHIMNEY FLASHING

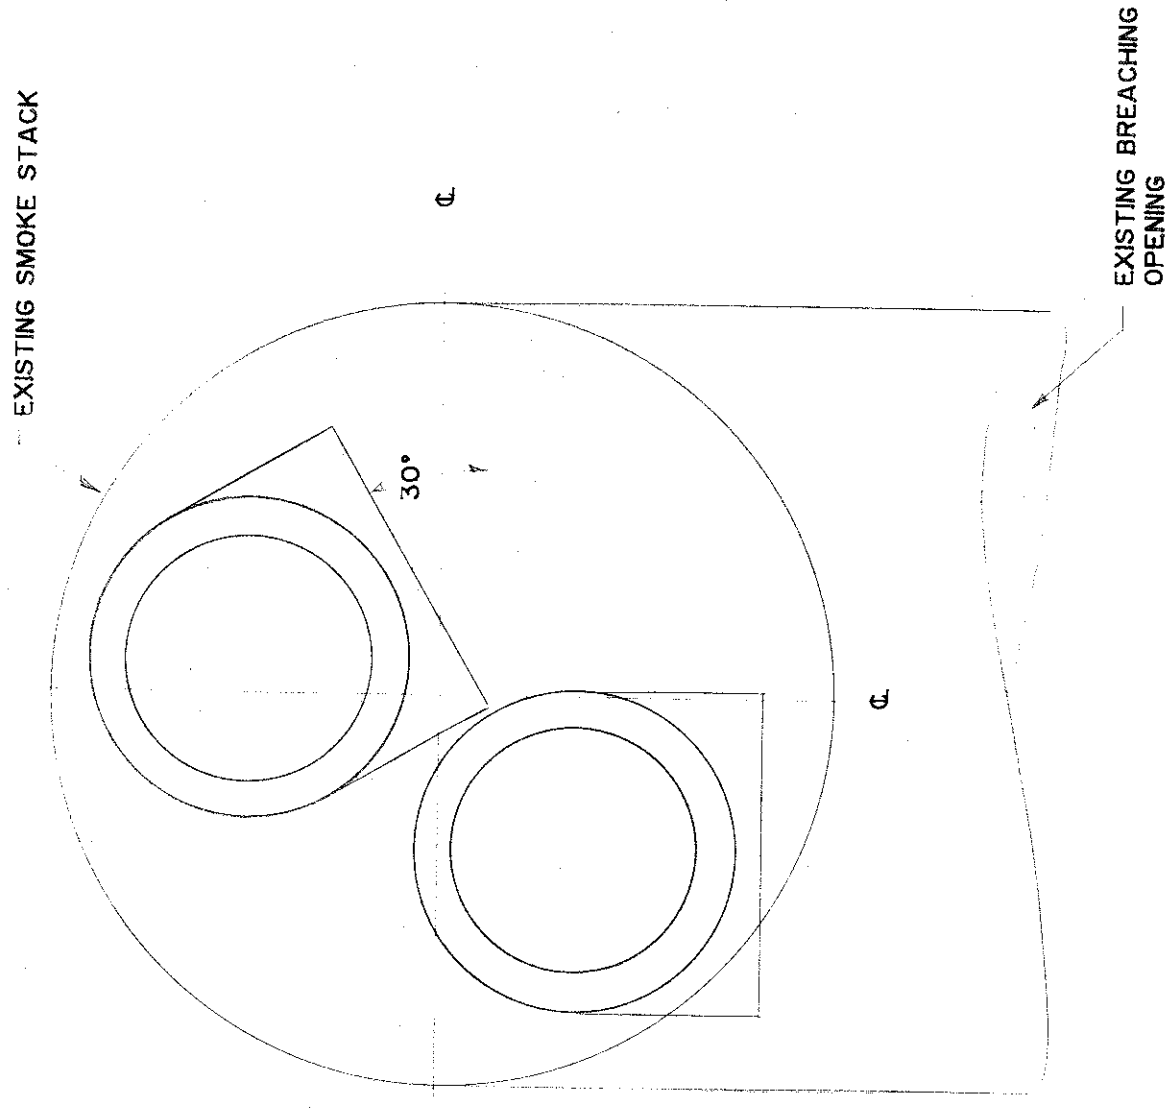

SECTION ABOVE
EXIST. BREECHING

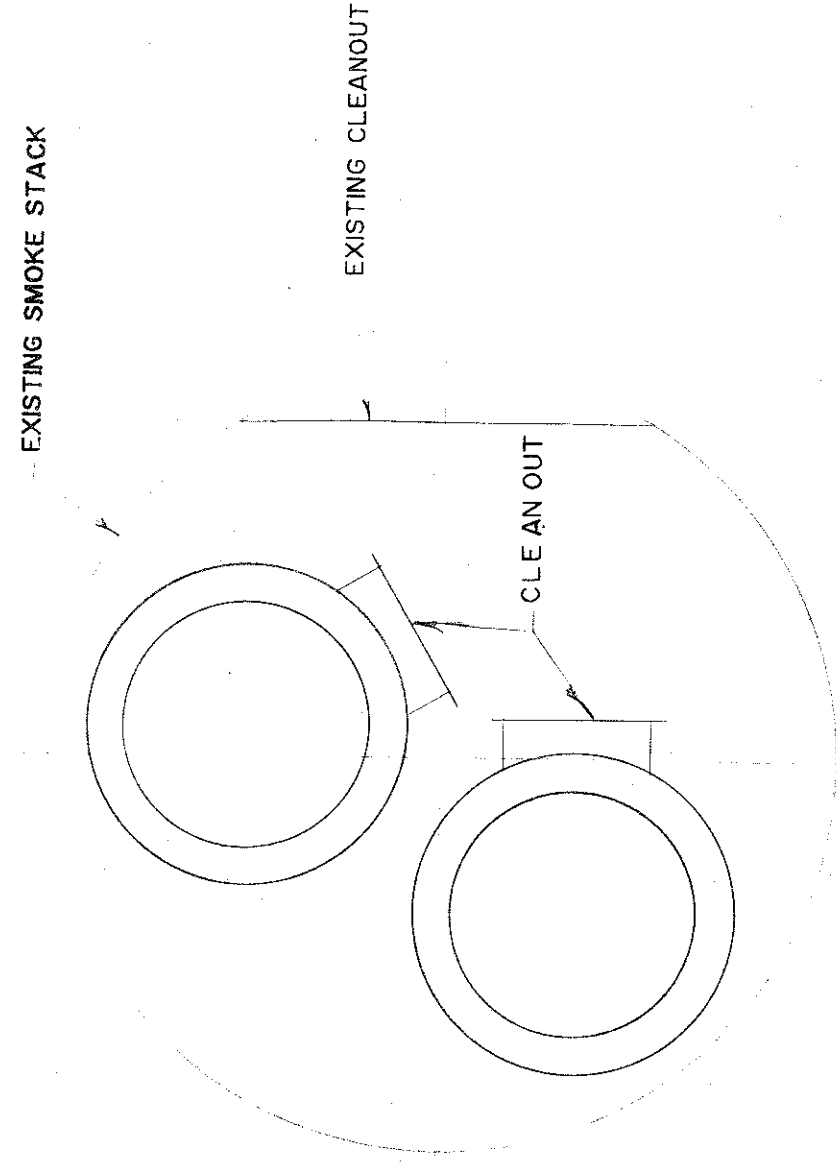

SECTION ABOVE EXIST. CLEANOUT
TO SHOW PEIR SECTION POSITIONS

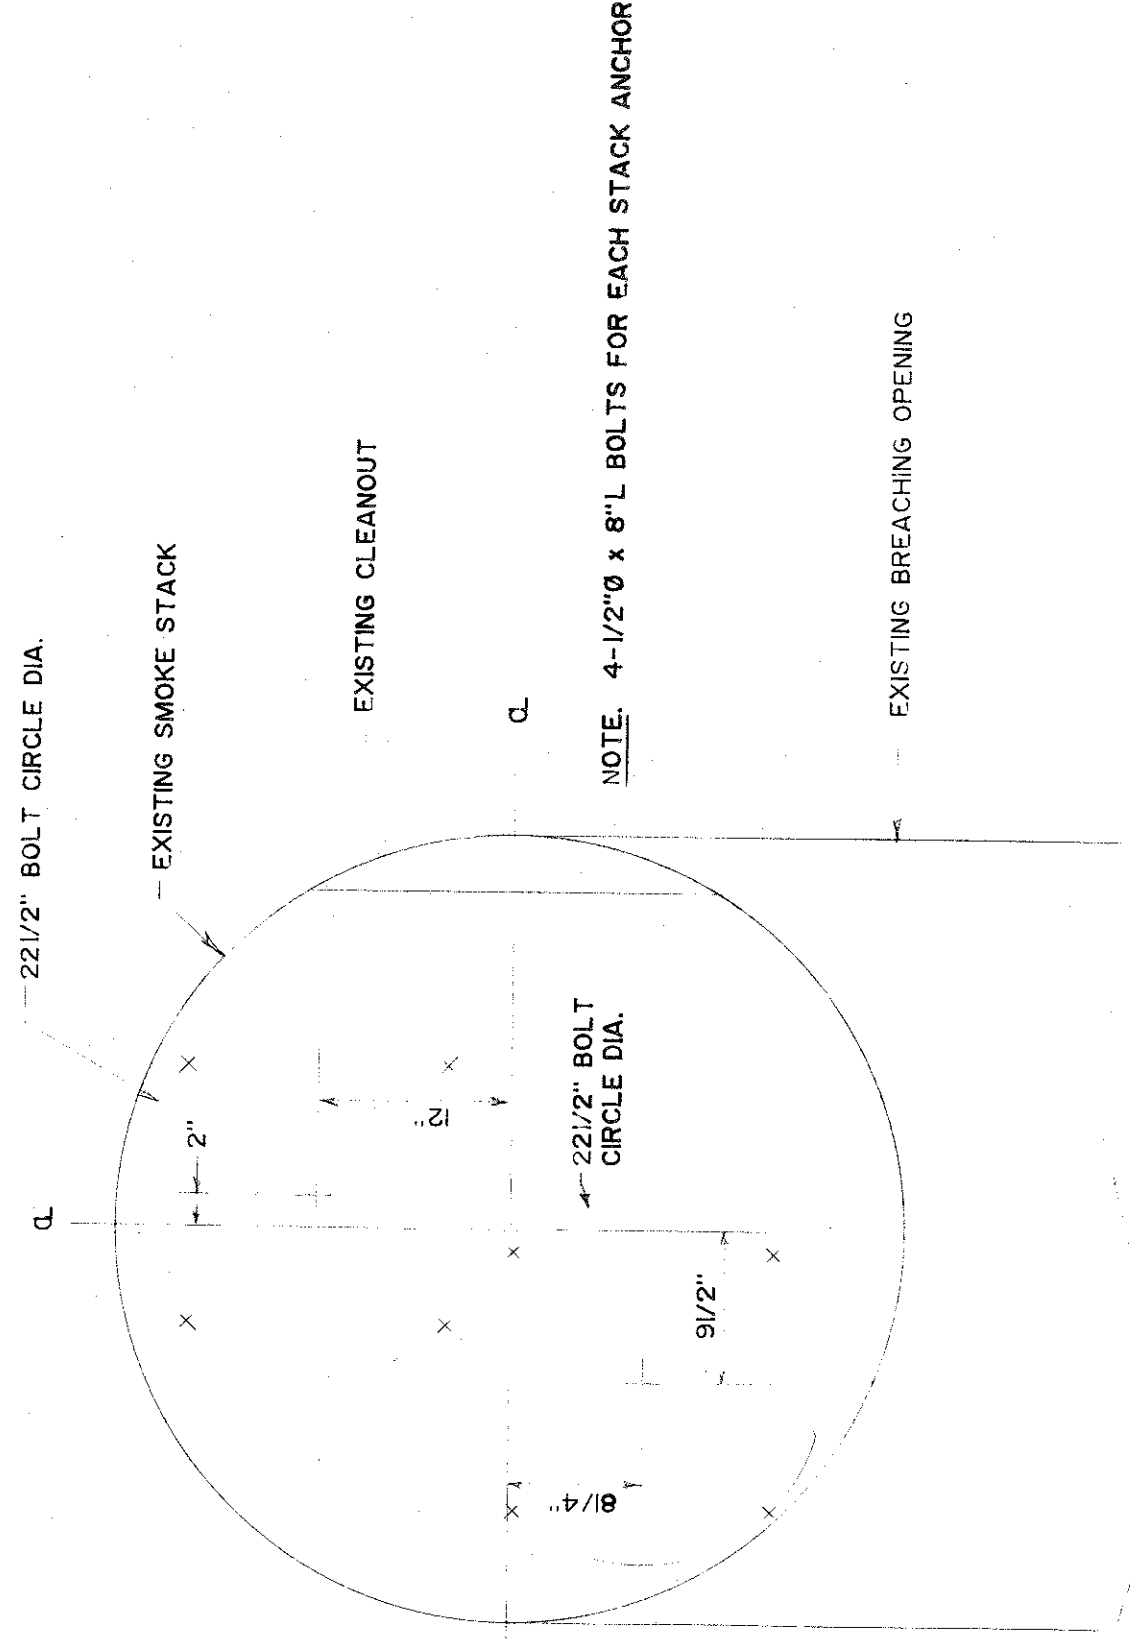

NEW 8" REINFORCED CONC. PAD TO BE POURED INSIDE
EXIST. CHIMNEY, ANCHOR BOLTS: 4 PER STACK
1/2" Ø x 8" L

SECTION SHOWING POSITION OF
ANCHOR BOLTS

DETAILS OF NEW CHIMNEY

SCALE : 1" = 1'-0"