


SIXTH FLOOR PLAN

SCALE 1/8" = 1'-0"

92/03/4
AS BUILT
DRAWING

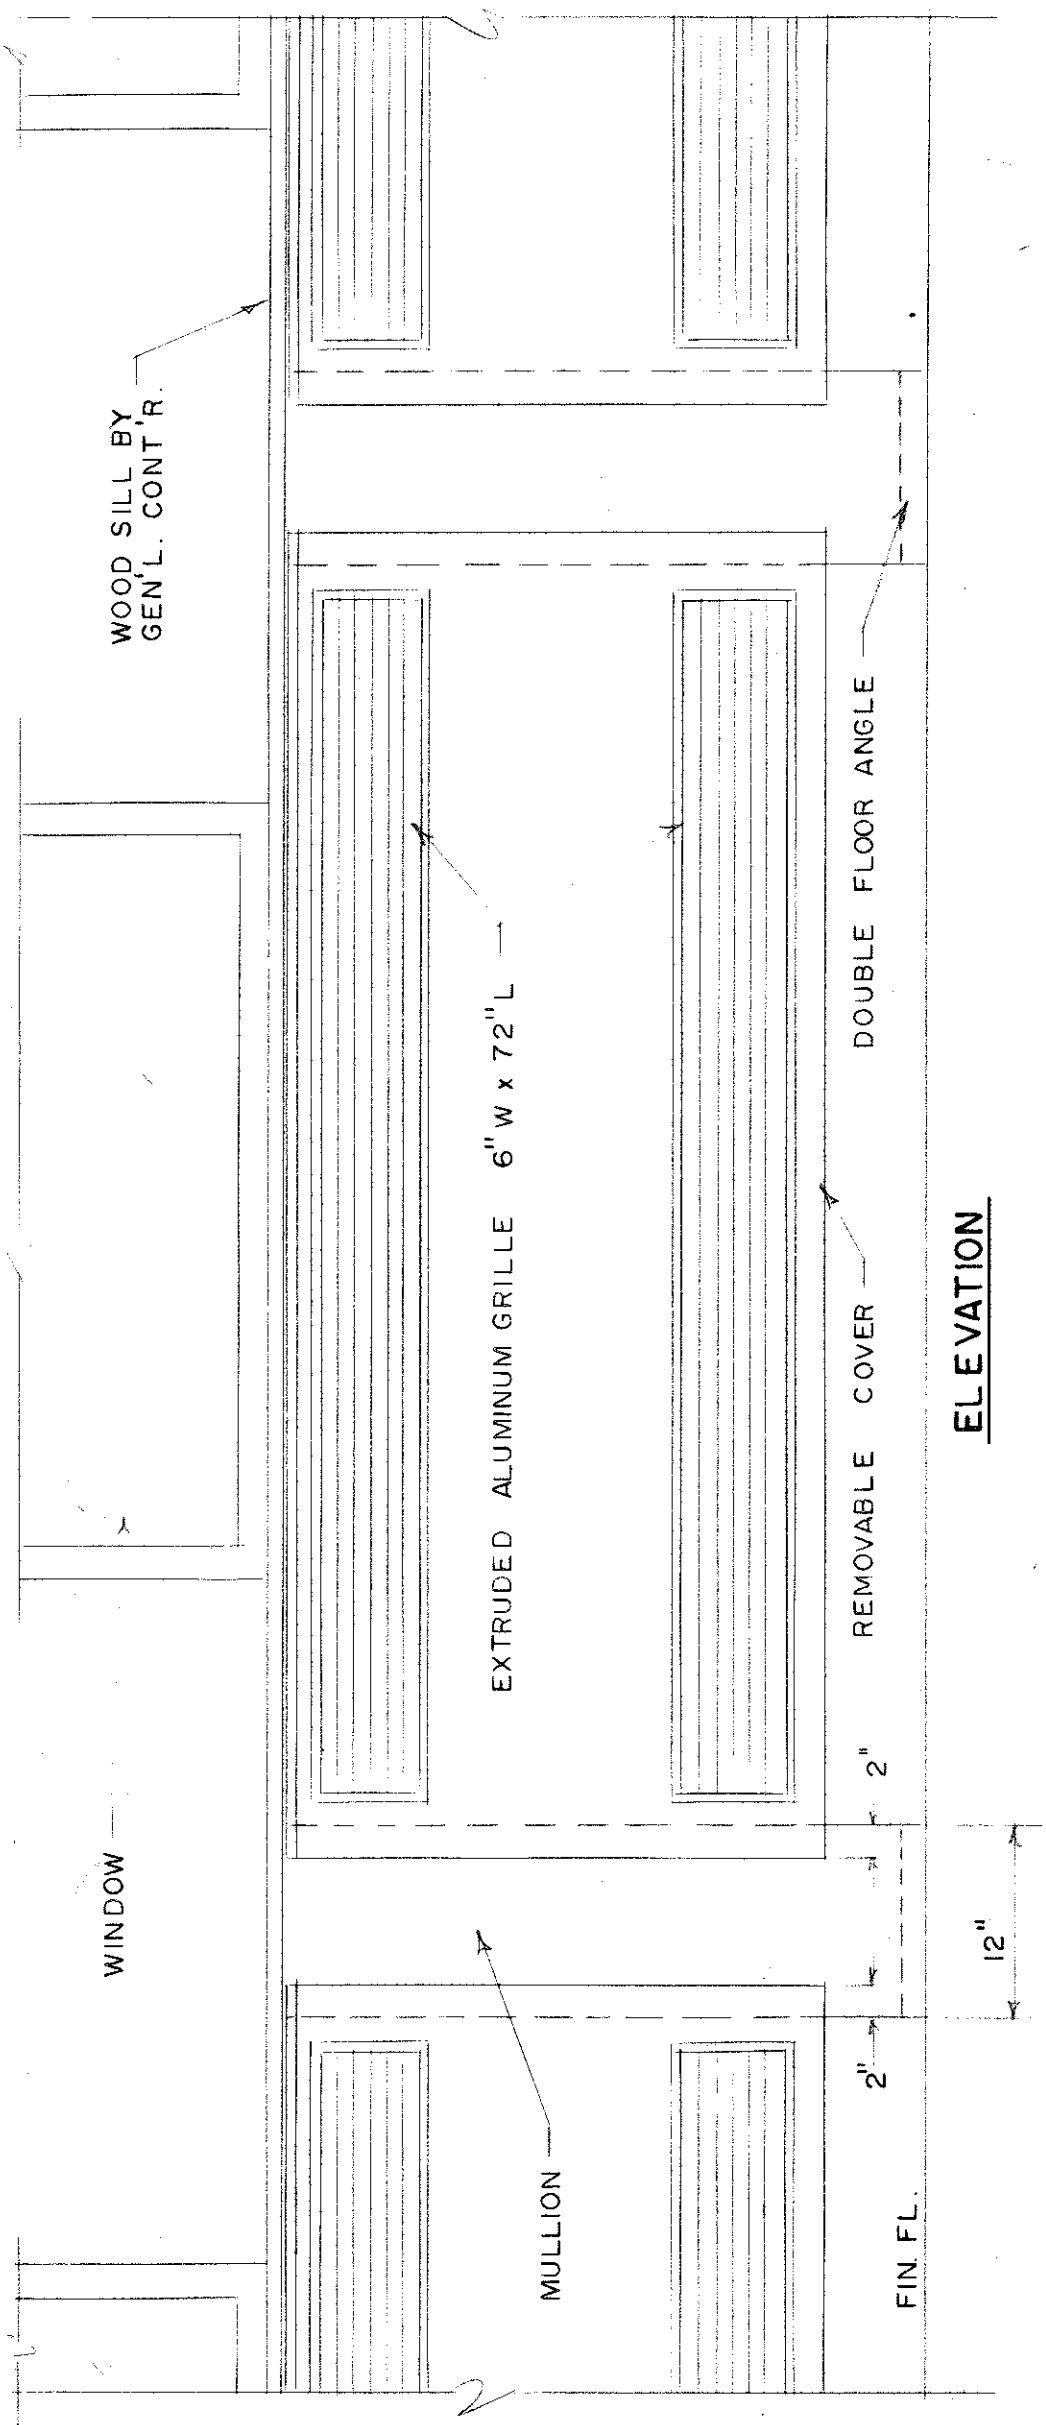

TYPICAL RADIATION DETAIL

SCALE 1/4\"/>