


ATRIUM LIGHTING - ELEVATION

SCALE: 1/32" = 1'-0"

E-7,8,9

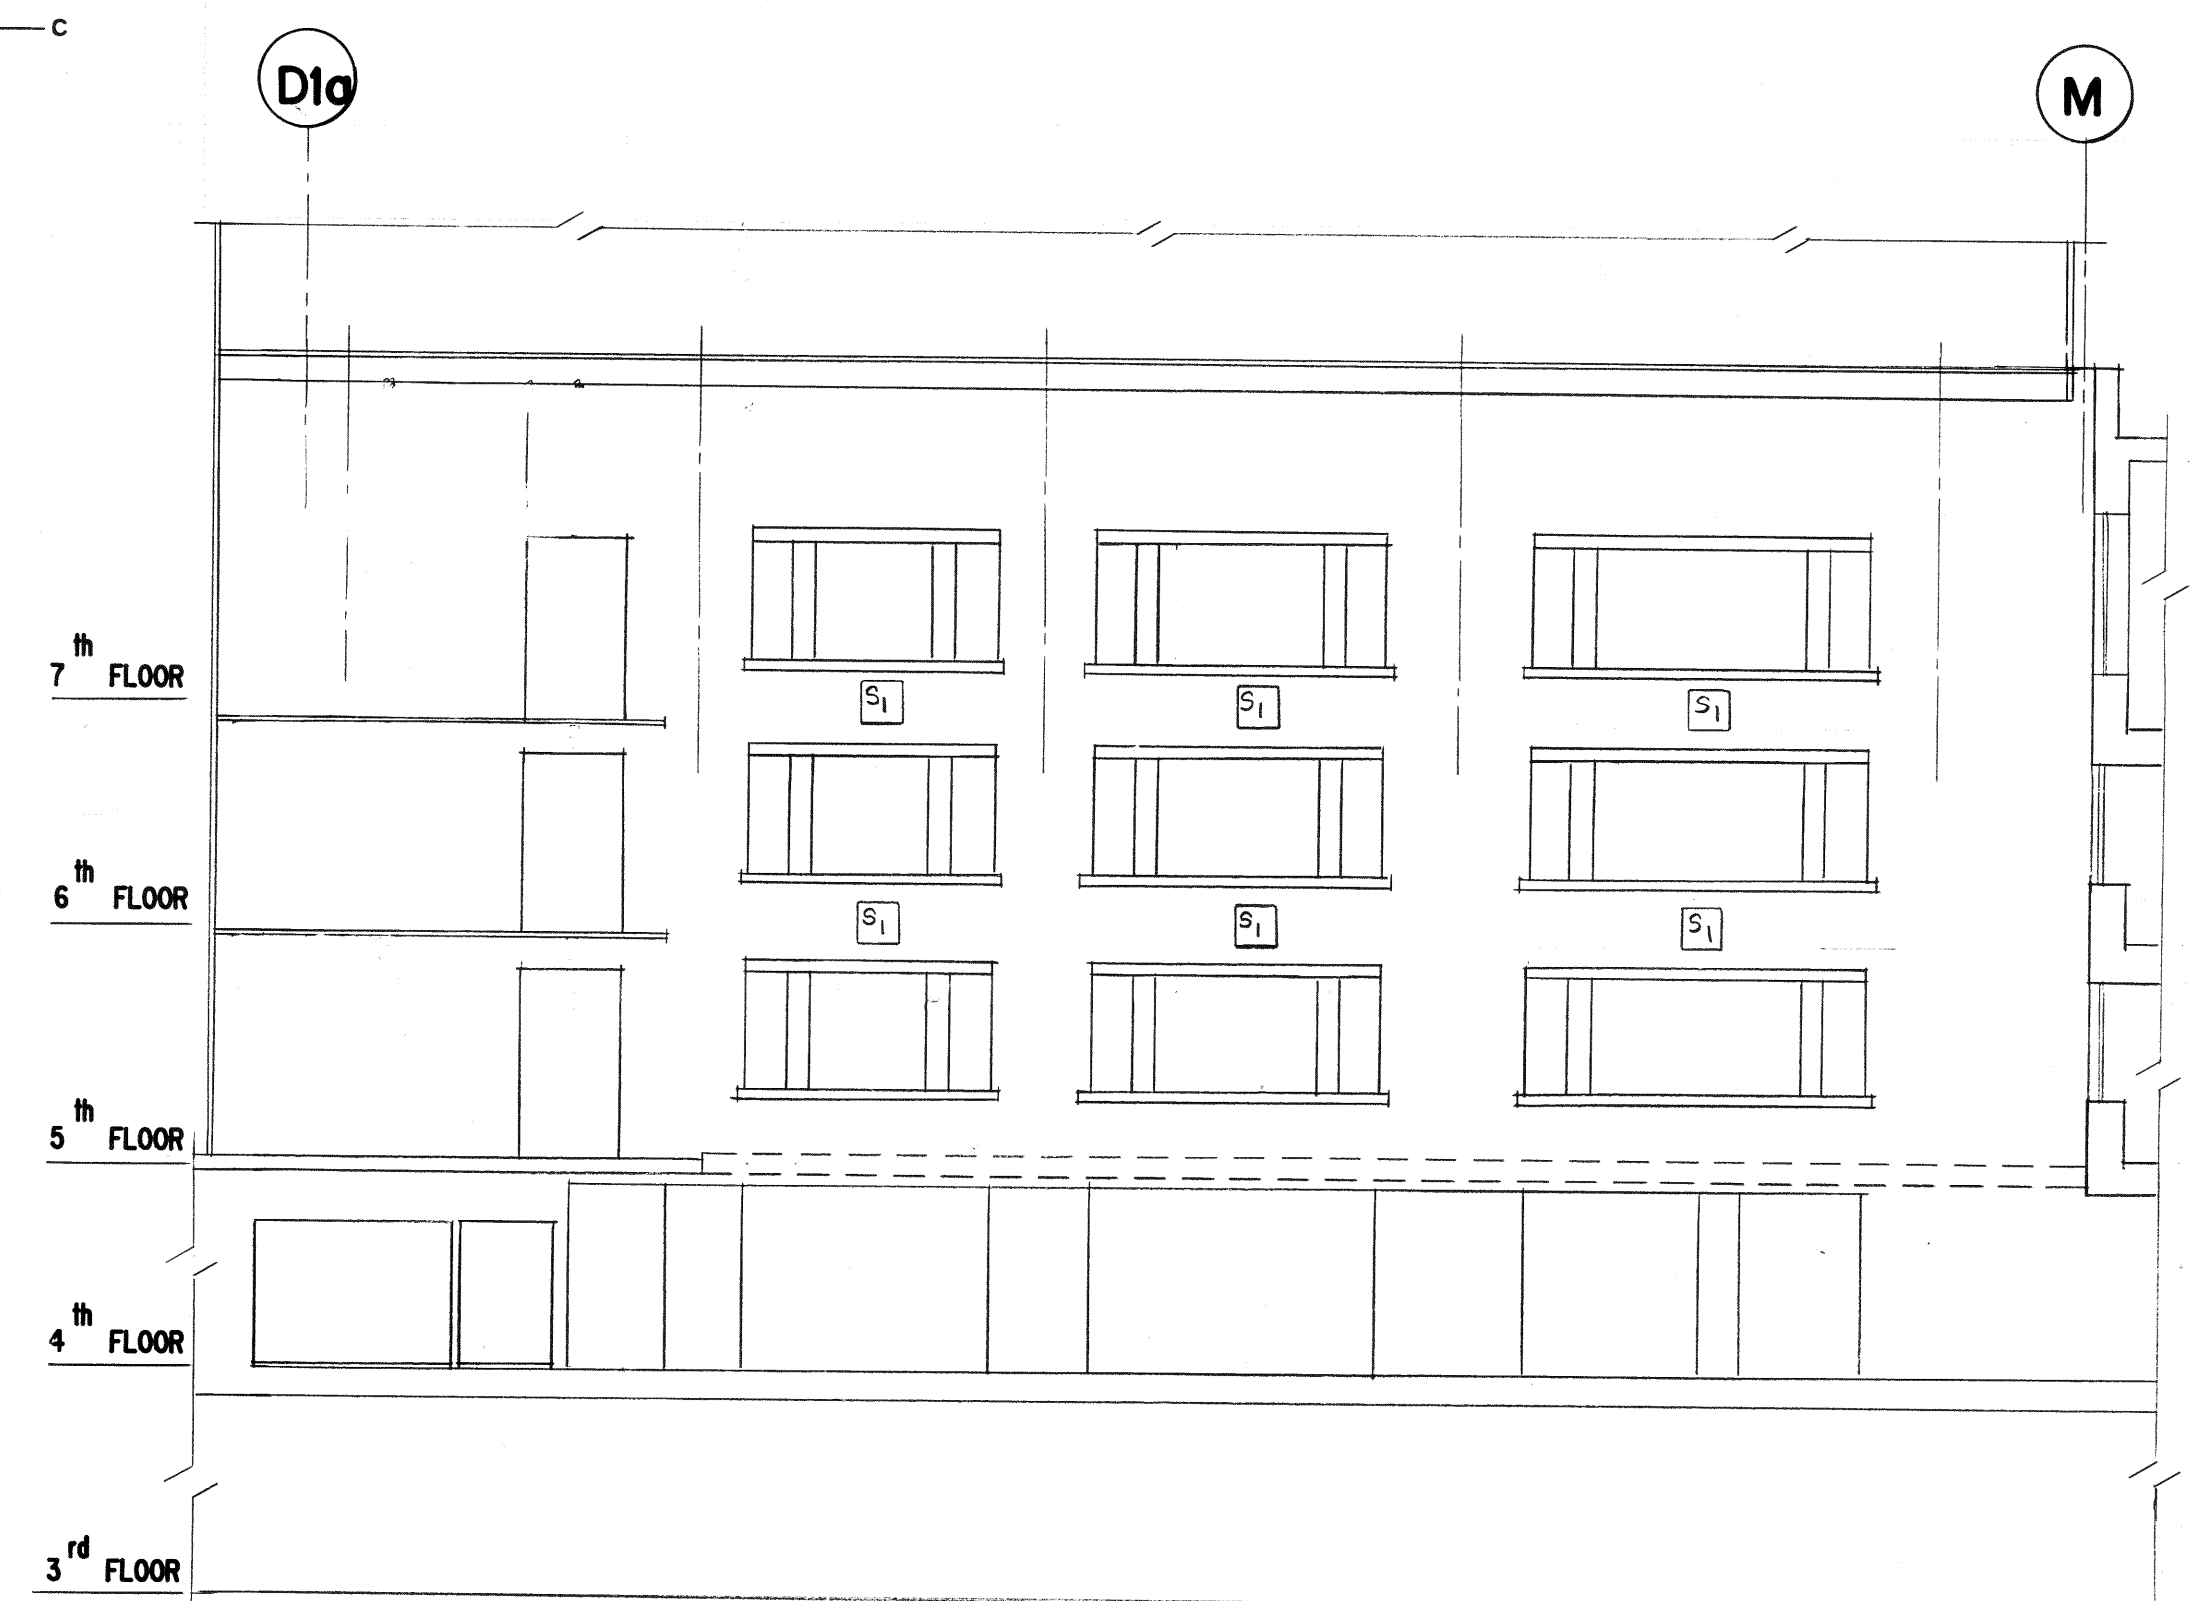

ATRIUM LIGHTING - ELEVATION

SCALE: 1/32" = 1'-0"


E-7,8,9

LIGHTING LEGEND:

(REFER TO MAIN LEGEND ON DRAWING E-31)

- |    |  |
|----|--|
| A1 | 1-LAMP, 4' X 5", SURFACE MOUNTED FLUORESCENT FIXTURE. C/W 1 TYPE F1 LAMP AND WRAP AROUND LENS.                             |
| A3 | 3-LAMP, 4' X 14", SURFACE MOUNTED FLUORESCENT FIXTURE. C/W 3 TYPE F1 LAMPS AND WRAP AROUND LENS. CHAIN SUSPENDED.          |
| A4 | 3-LAMP, 4' X 2'; SURFACE MOUNTED FLUORESCENT FIXTURE. C/W 3 TYPE F1 LAMPS AND A FRAMED LENS. PENDANT MOUNTED.              |
| A6 | 3-LAMP, 4' X 2'; SURFACE MOUNTED FLUORESCENT FIXTURE. C/W 3 TYPE F1 LAMPS AND A DEEP CELL PARABOLIC LENS. PENDANT MOUNTED. |
| B4 | RECESSED; 3-LAMP, FLUORESCENT FIXTURE C/W 3 TYPE F1 LAMPS AND FRAMED LENS.   |
| B6 | RECESSED; 3-LAMP, FLUORESCENT FIXTURE C/W 3 TYPE F1 LAMPS AND A DEEP CELL PARABOLIC LENS.                                  |

- |    |   |
|----|---|
| C1 | 4'; SINGLE TUBE, FLUORESCENT STRIP LIGHT. C/W 1 TYPE F1 LAMP.   |
| C2 | 4'; 2-LAMP FLUORESCENT STRIP LIGHT. C/W 2 TYPE F1 LAMPS.  |
| C3 | 2'; SINGLE LAMP, FLUORESCENT STRIP LIGHT. C/W 1 TYPE F1 LAMP.   |
| D1 | SURFACE MOUNTED, FLUORESCENT WALL SCONCE C/W PL-13 LAMPS. (FOUNTAIN)                                      |
| D2 | RECESSED CEILING MOUNTED WALL WASHER FIXTURE. C/W 2 PL-7 LAMPS. MOUNTED ABOVE FOUNTAIN.                   |
| E5 | WALL MOUNTED (SURFACE), 4' X 8" FLUORESCENT FIXTURE C/W 2 TYPE F1 LAMPS. MOUNTED 1'-0" BELOW CEILING.     |
| F1 | PENDANT MOUNTED; INDUSTRIAL TYPE 2-LAMP, FLUORESCENT FIXTURE C/W 2 TYPE F1 LAMPS AND A SLOTTED REFLECTOR. |
| V1 | 2-LAMP, SURFACE MOUNTED VAPOUR PROOF FLUORESCENT FIXTURE C/W 2 TYPE F1 LAMPS.                             |
| I4 | RECESSED, 2 LAMP FLUORESCENT FIXTURE C/W 2-13W PL LAMPS.  |
| S1 | WALL OR CEILING MOUNTED EXIT LIGHT. RESPECTIVELY.   |
| C  | 200W, 347V SURFACE MOUNTED. METAL HALIDE FIXTURE.   |

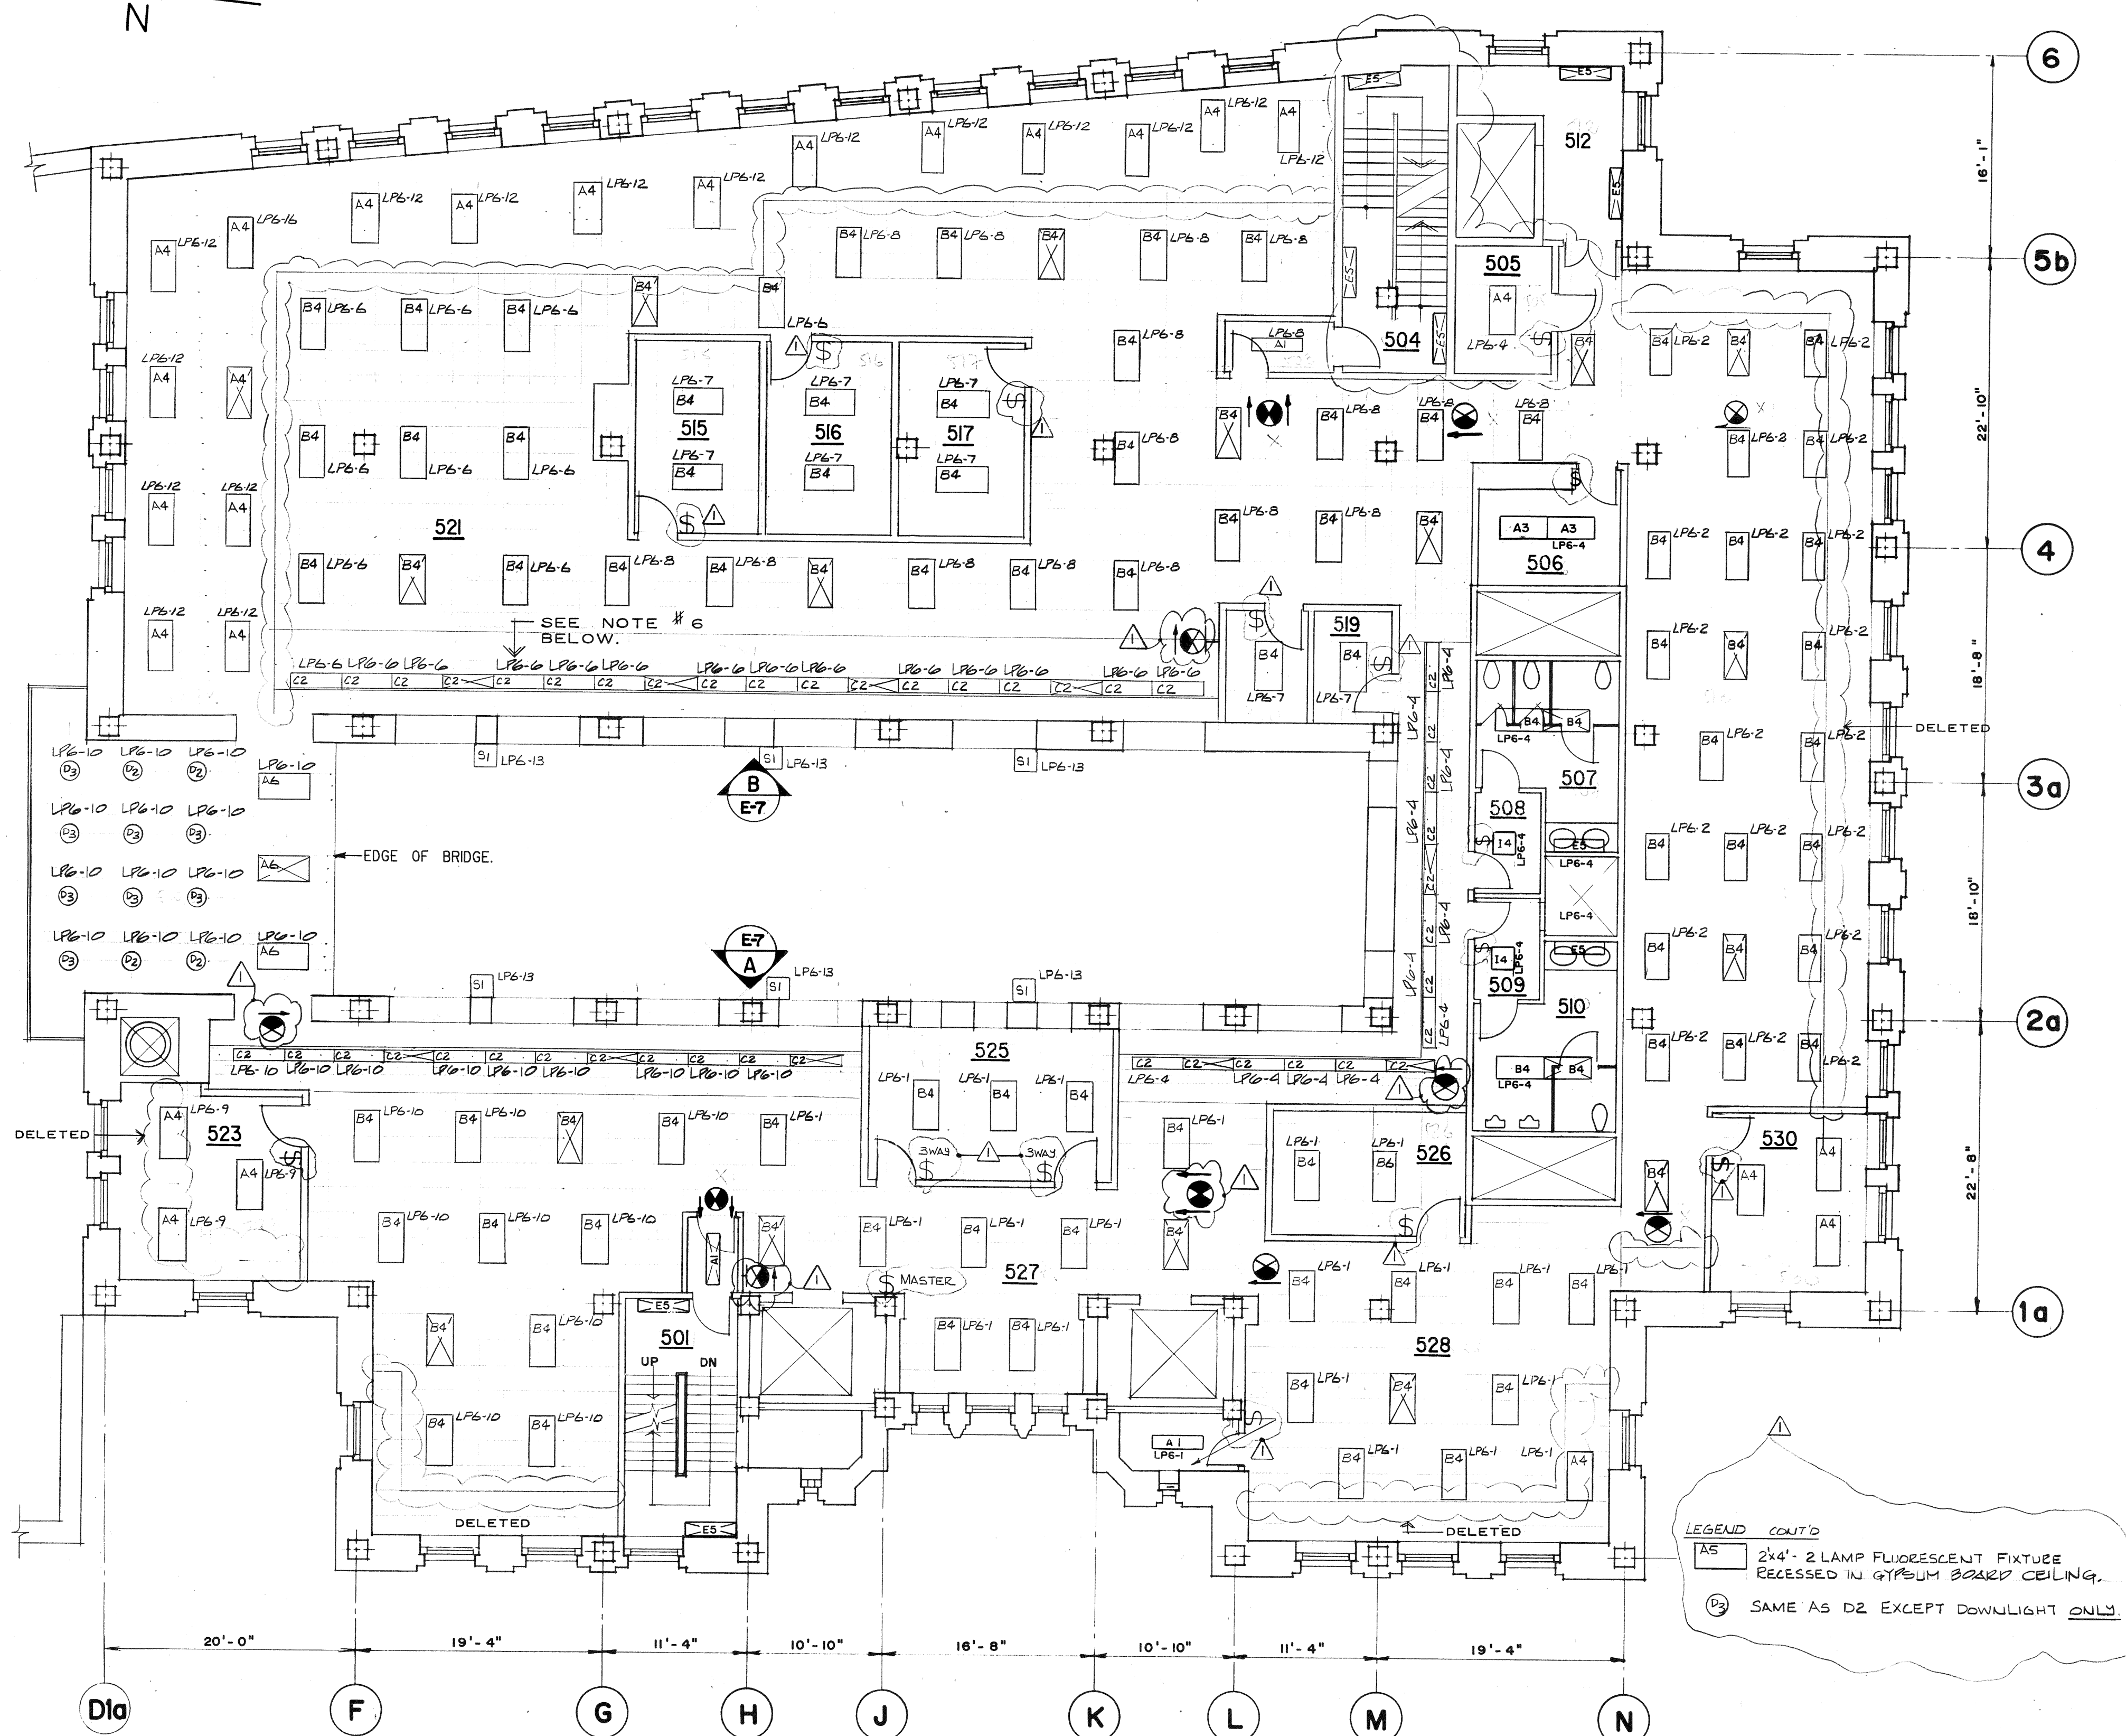

FIFTH FLOOR PLAN

SCALE: 1/8" = 1'-0"

NOTES:

- ALL EMERGENCY AND EXIT LIGHTING FOR THIS FLOOR ON CIRCUIT ELP2-6.
- ALL LIGHTING TO BE INSTALLED USING MODULAR WIRING SYSTEM. (SEE SPECIFICATION)
- EACH PAIR OF 3-LAMP FIXTURES SHALL HAVE 3-2 LAMP BALLASTS-WIRE ACCORDINGLY.
- DIV.16 CONTRACTOR TO CONFIRM EXACT LOCATION OF ALL FIXTURES ON SITE WITH DIV.1 CONTRACTOR AND ENGINEER PRIOR TO INSTALLATION.
- SWITCHES SHOWN IN ROOMS 505, 506, 508, 509, AS WELL AS THE MASTER SWITCH SHOWN IN THE ELEVATOR LOBBY 527 HAVE BEEN SUPPLIED UNDER CCN I-E.
- TYPE C2 FIXTURES TO BE MOUNTED IN VALANCE. SUPPLY TYPE K-12 LENS. CUT LENS TO SUIT.

revisions	date

A	A detail no. no. du détail
B	B location drawing no. sur dessin no.
C	C drawing no. dessin no.

project  
G.O.C.B.  
BEDFORD ROW  
HALIFAX, N.S.

drawing  
FIFTH FLOOR PLAN  
LIGHTING

ELECTRICAL

designed	G.C. HICKS	conçu
drawn	W. SZUBIELSKI	dessiné
date		
reviewed	J. J. J. J.	examiné
date	Apr. 12/91	
approved		approuvé
date		
Tender		Soumission
PWC Project Manager		Administrateur de projets TPC
project number	800769	no. du projet
drawing no.	E-7	no. du dessin