
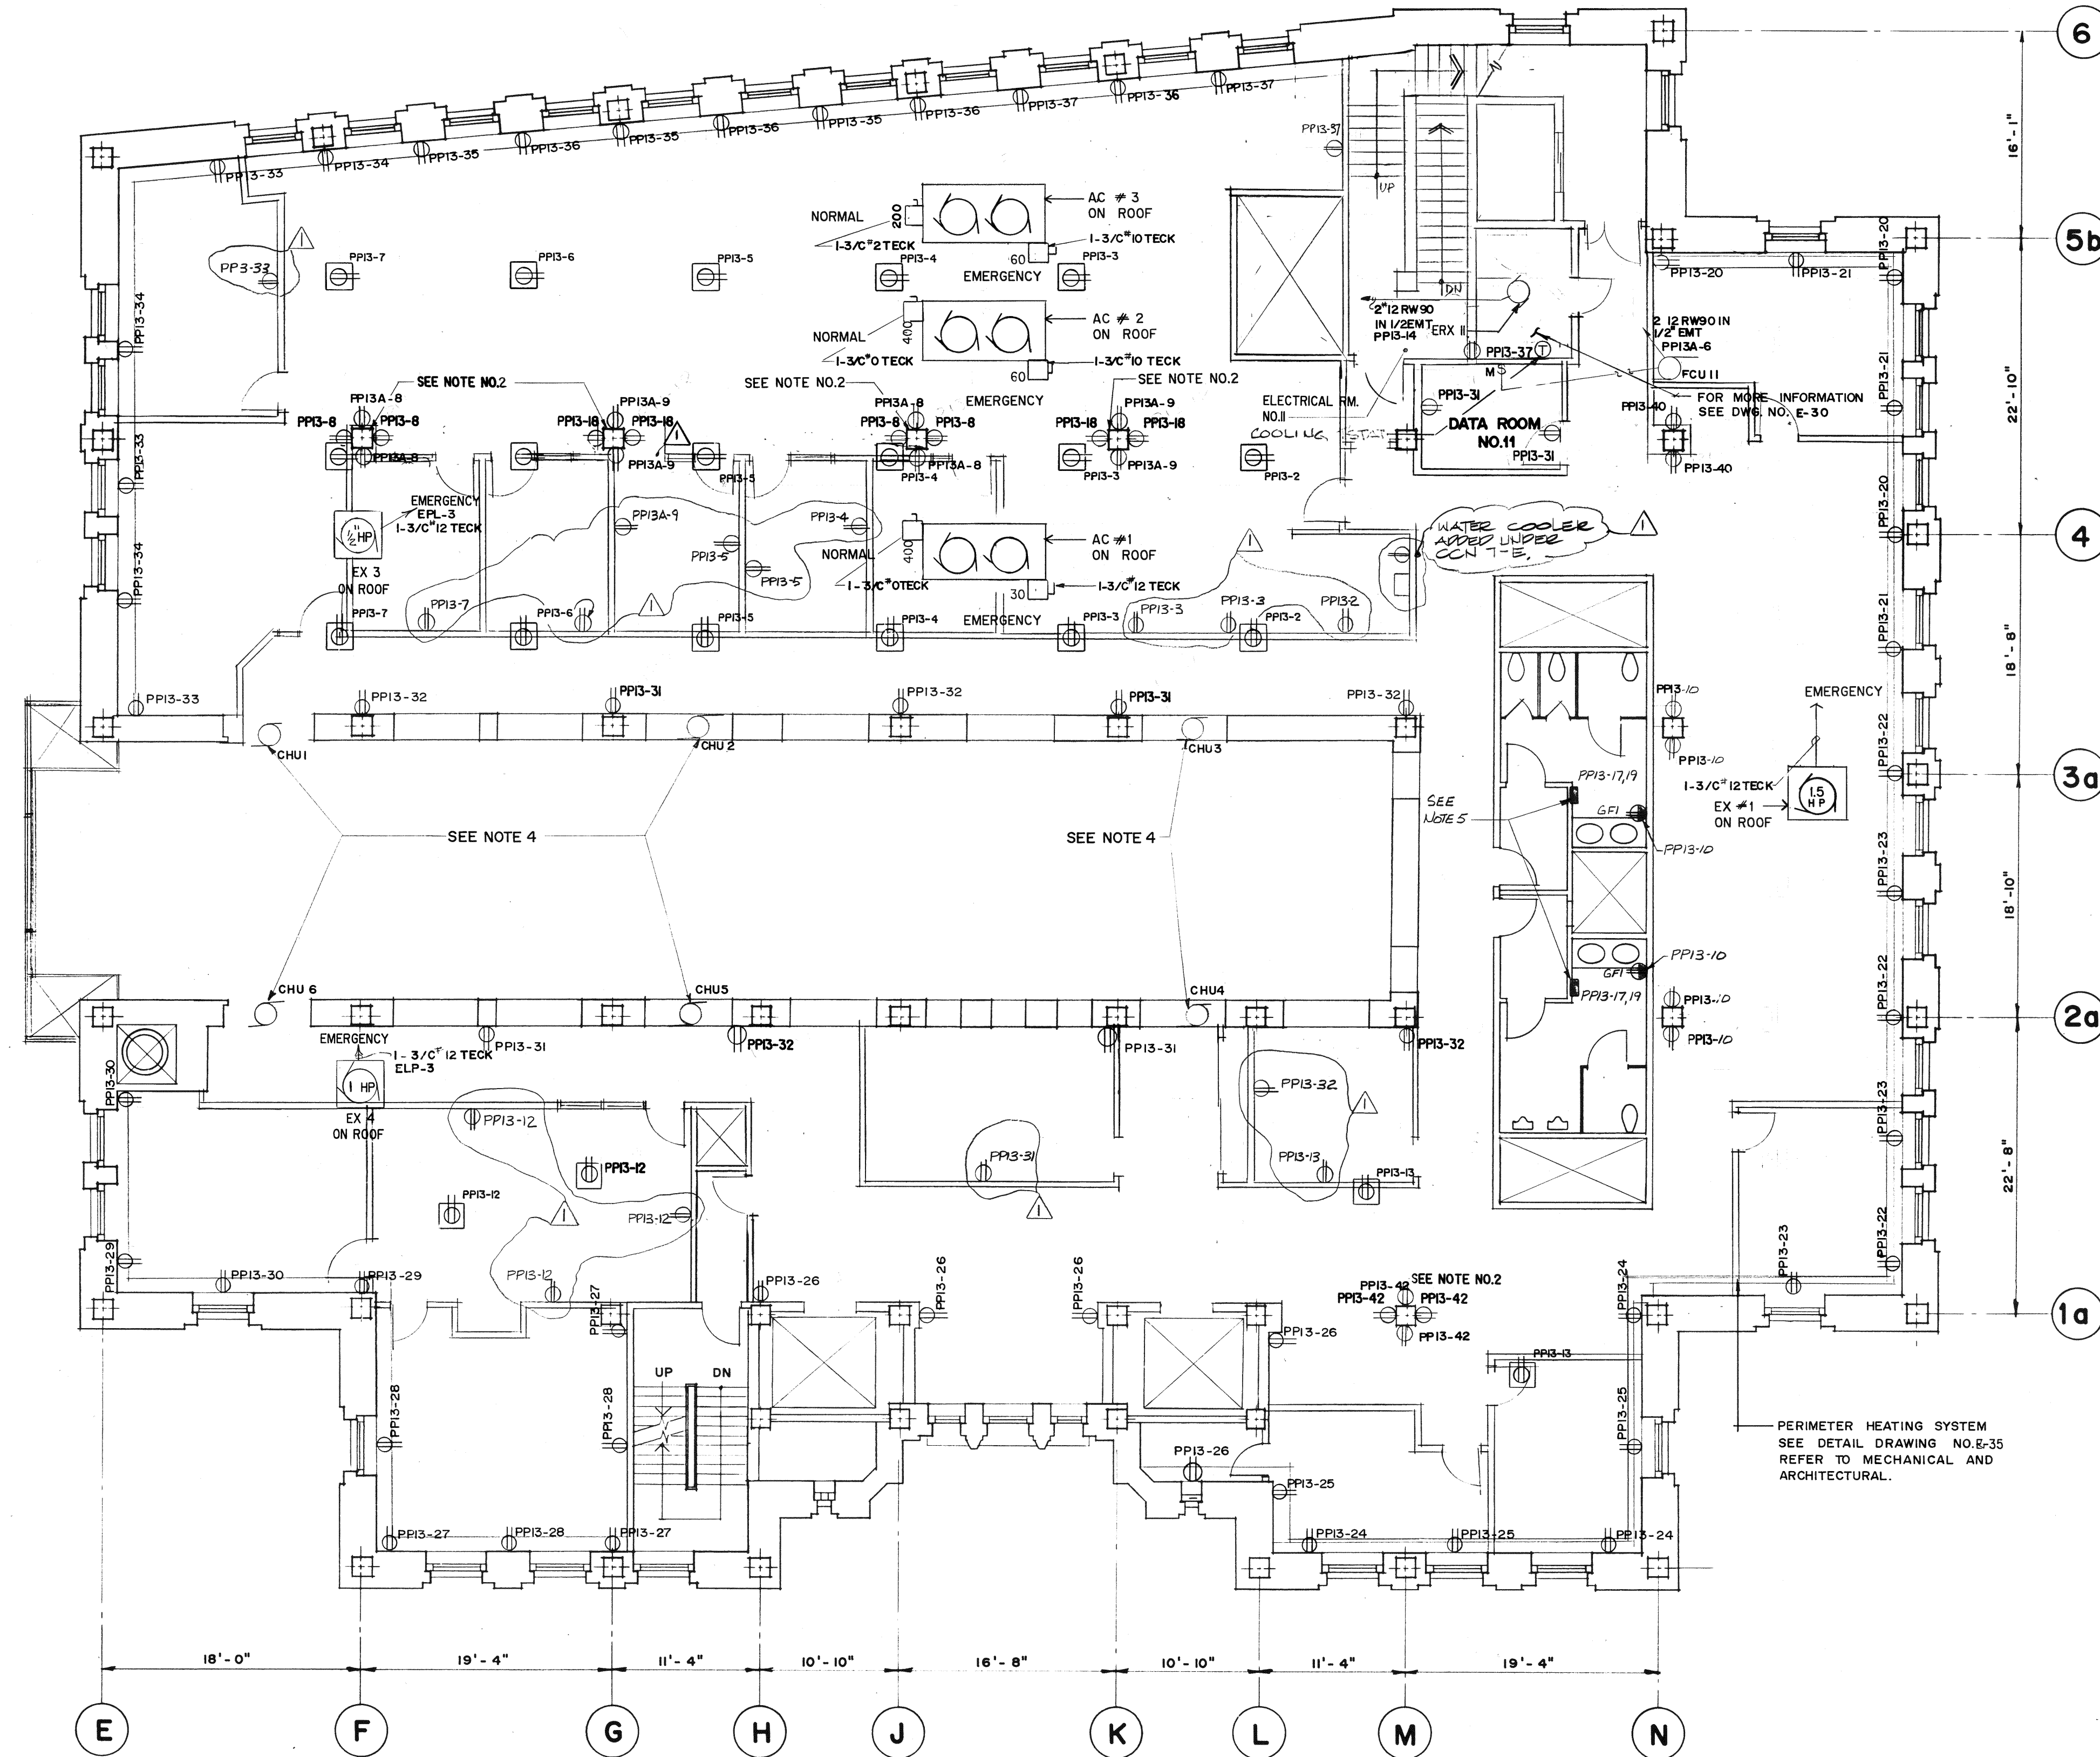



NOTES:

1. USE OF COMMON NEUTRALS NOT PERMITTED.
2. INSTALL 4 POWER OUTLETS ON THESE COLUMNS SEE DETAILS ON DRAWING NO. E-26
3. INSTALL 3 POWER OUTLET ON THESE COLUMNS SEE DETAILS ON DRAWING NO. E-26
4. ALL CABINET UNIT HEATERS, CHU 1 THRU 6 ARE WIRED WITH 2"12 RW90 XPLE IN 1/2" EMT. TO CIRCUIT PPI3A-10. MOUNT MOTOR STARTER NEXT TO THE UNIT HTR.
5. DEVICE BOX AND CIRCUITS FOR HAND DEVICES. HAND DEVICES BY DIV. 1.

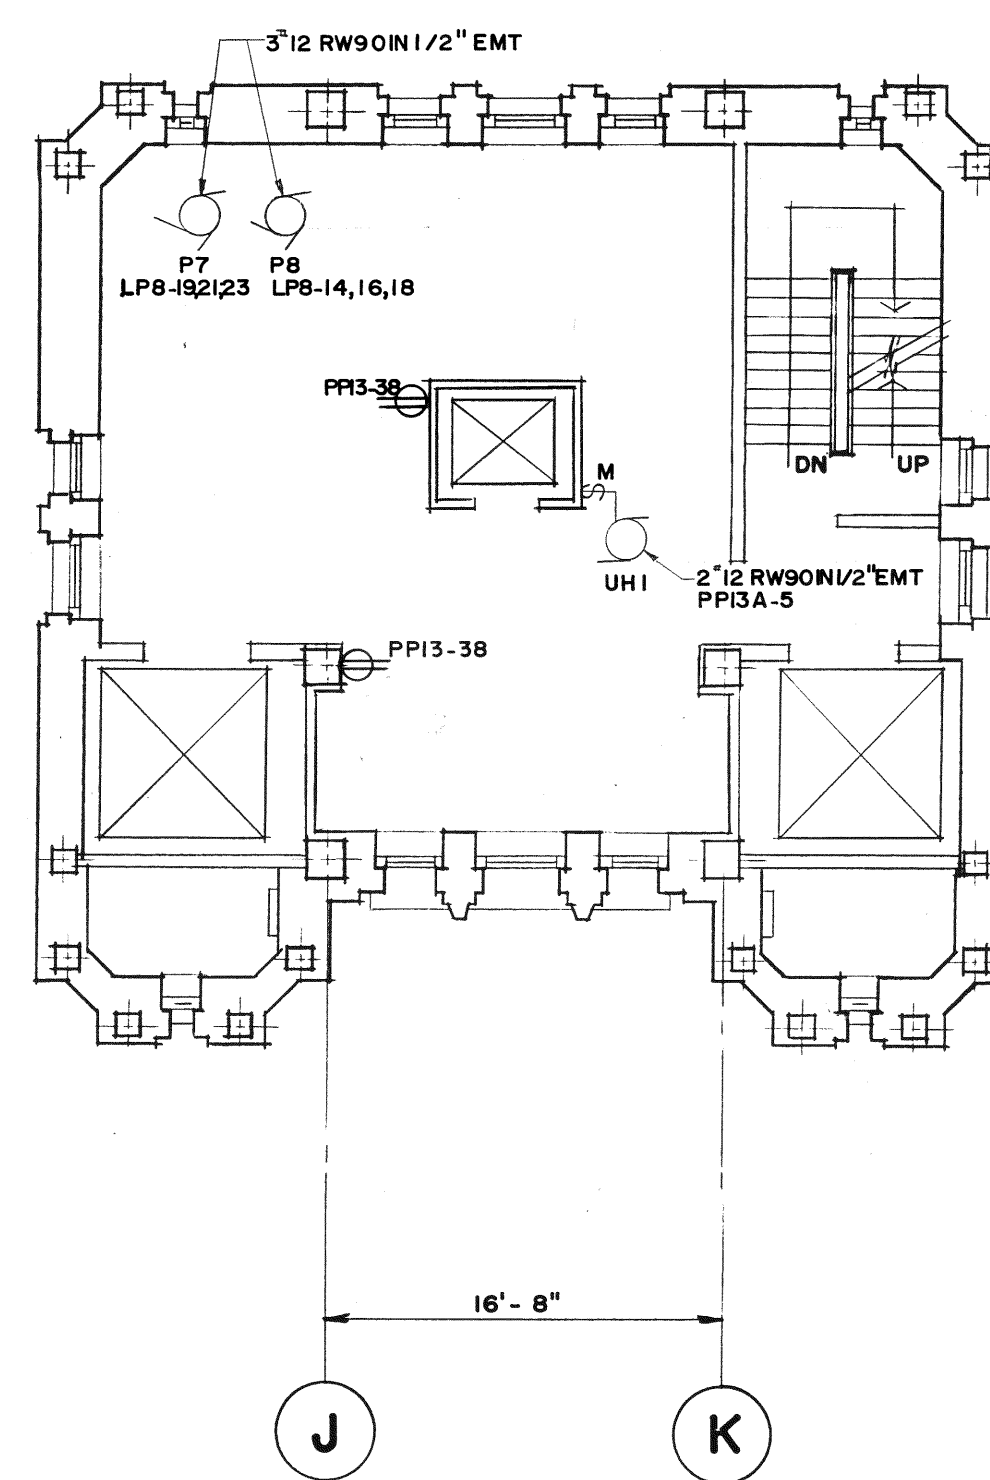

NOTE:

ALL CUTTING, PATCHING, FIRE PROOFING AND SUPPORTS REQUIRED IN MULLIONS BY DIVISION 1 CONTRACTOR.

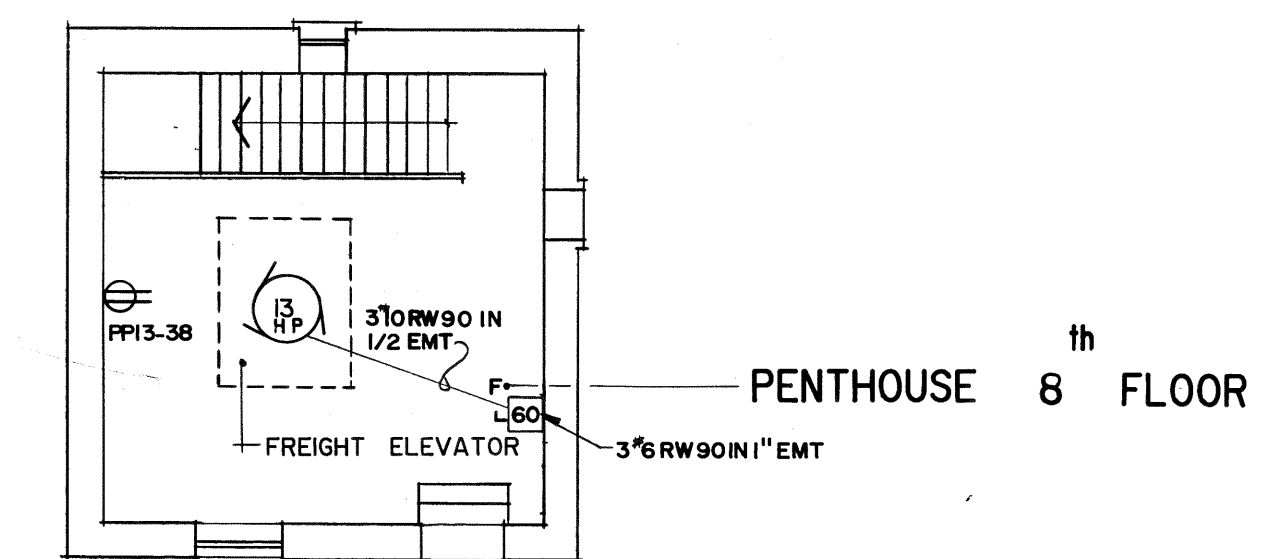

revisions	date
1	9/10

A	A detail no. no. du détail	A
C	B location drawing no. sur dessin no.	B
	C drawing no. dessin no.	C

project G.O.C.B. BEDFORD ROW HALIFAX, N.S.

drawing SEVENTH FLOOR PLAN POWER

ELECTRICAL

designed G.C.HICKS compu

drawn W.SZUBIELSKI dessin

date

revised

date

approved

date

Tender

PWC Project Manager Administrateur de projets TPC

project number 800769 no. du projet

drawing no. E-18 no. du dessin