

A detail no.  
no. du détail

B location drawing no.  
sur dessin no.

C drawing no.  
dessin no.

G.O.C.B.  
BEDFORD ROW  
HALIFAX, N.S.


drawing

classin

SEVENTH FLOOR PLAN

## HEATING

assigned	P. DUMARESQ	compu
res		
name	L. DEVEAU	descrip
stan		
deviated	9/10/58	examining
date	9/10/58	
approved		approved
into		
order		Submission
	WMD Project Manager	Administrateur de projets WMD
project number	614362	no. du projet
drawing no.		no. du dessin

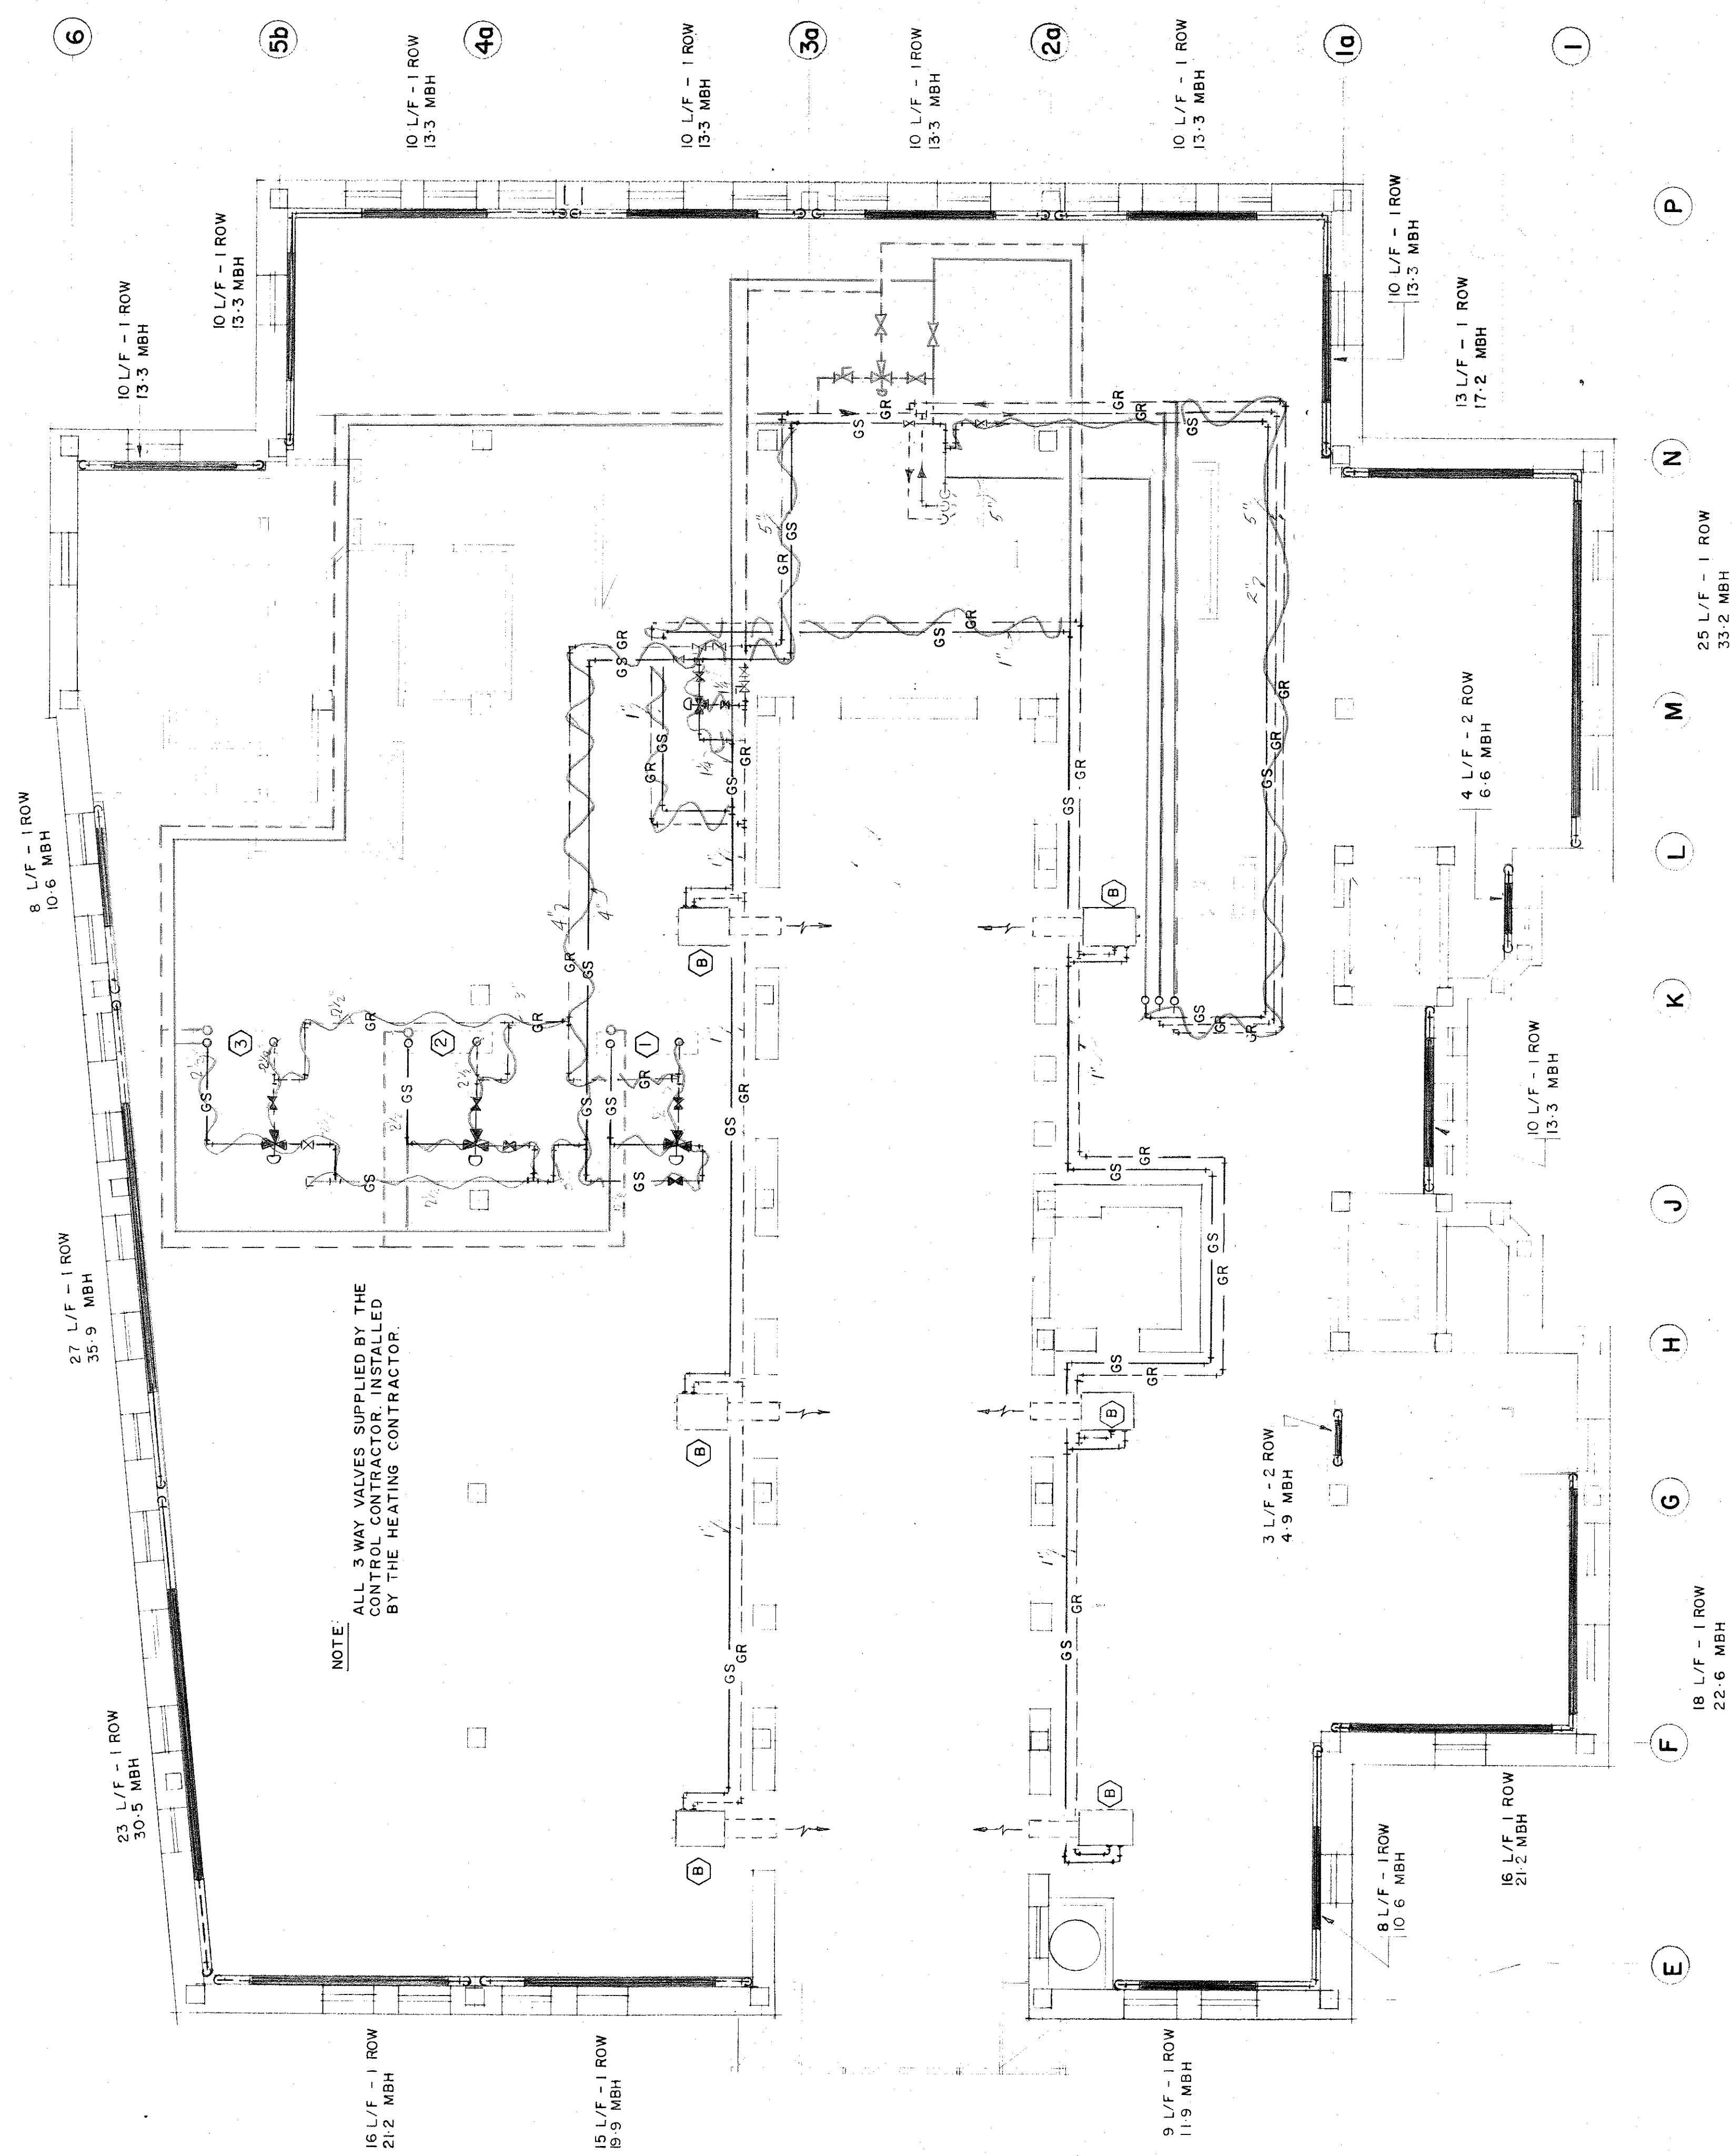

WESTERN PLUMBING  
& HEATING LIMITED

92/03/4

# AS BUILT DRAWING

## SEVENTH FLOOR PLAN

SCALE 1/8" = 1'-0"

