




NINTH FLOOR PLAN

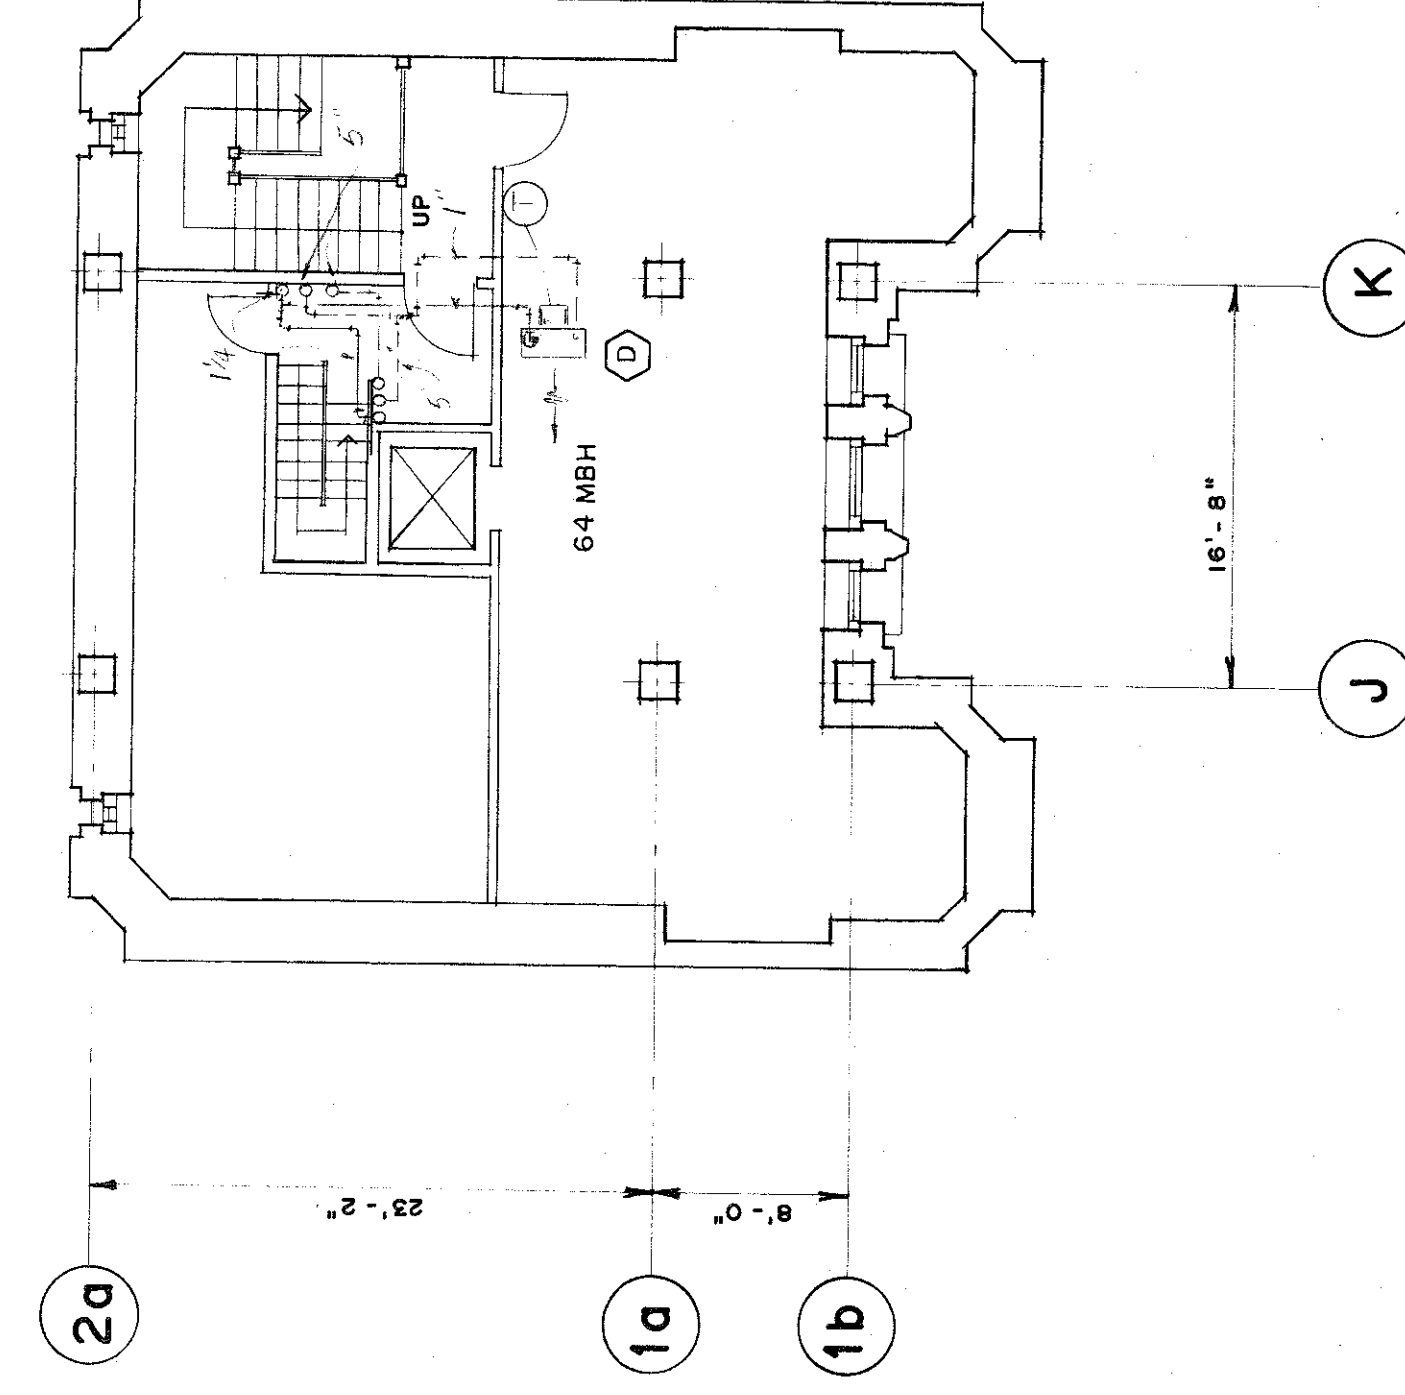


TENTH FLOOR PLAN

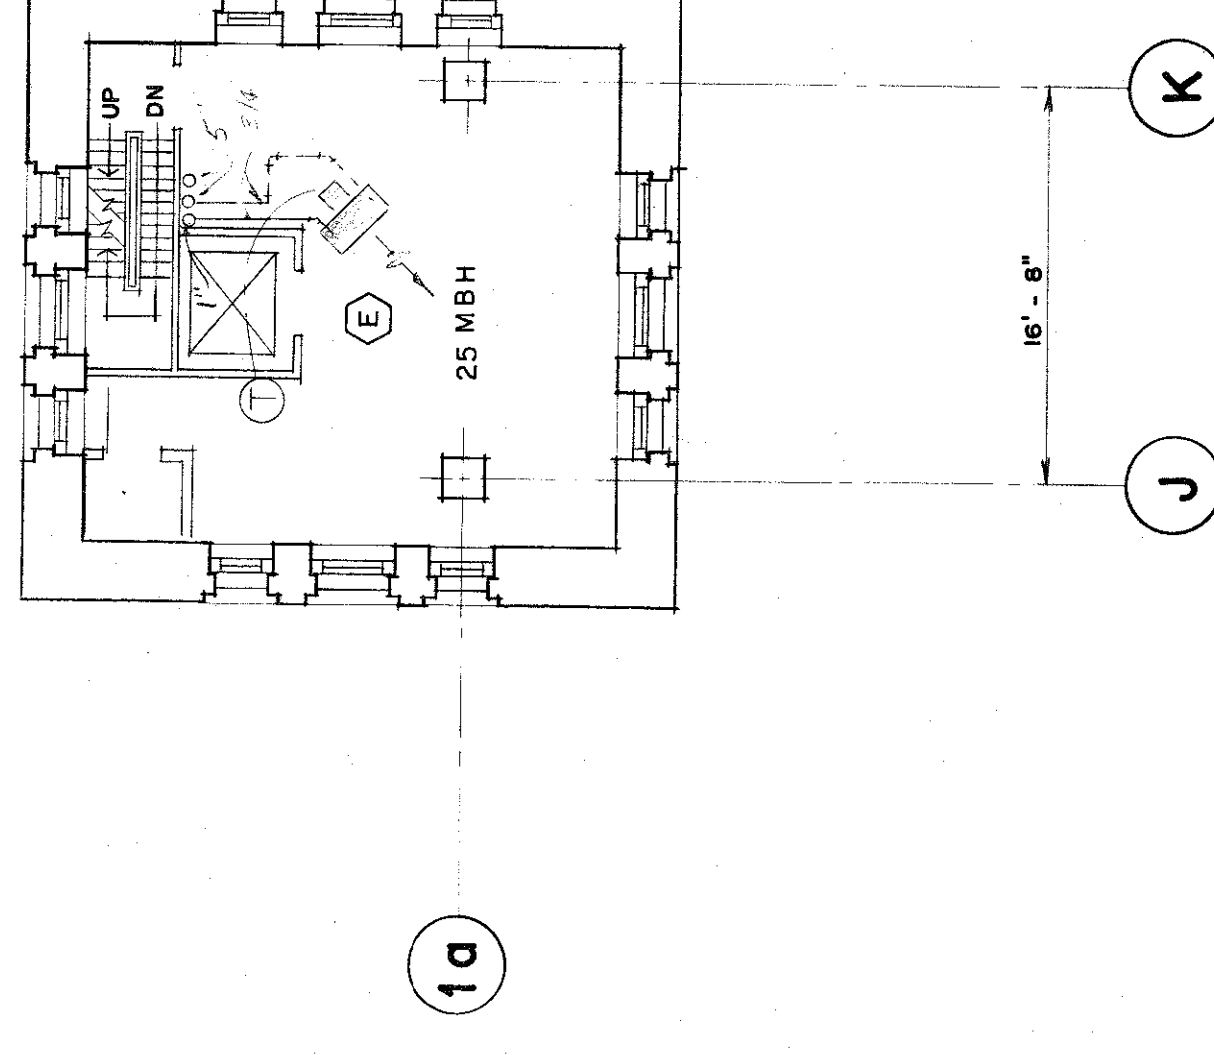


ELEVENTH FLOOR PLAN

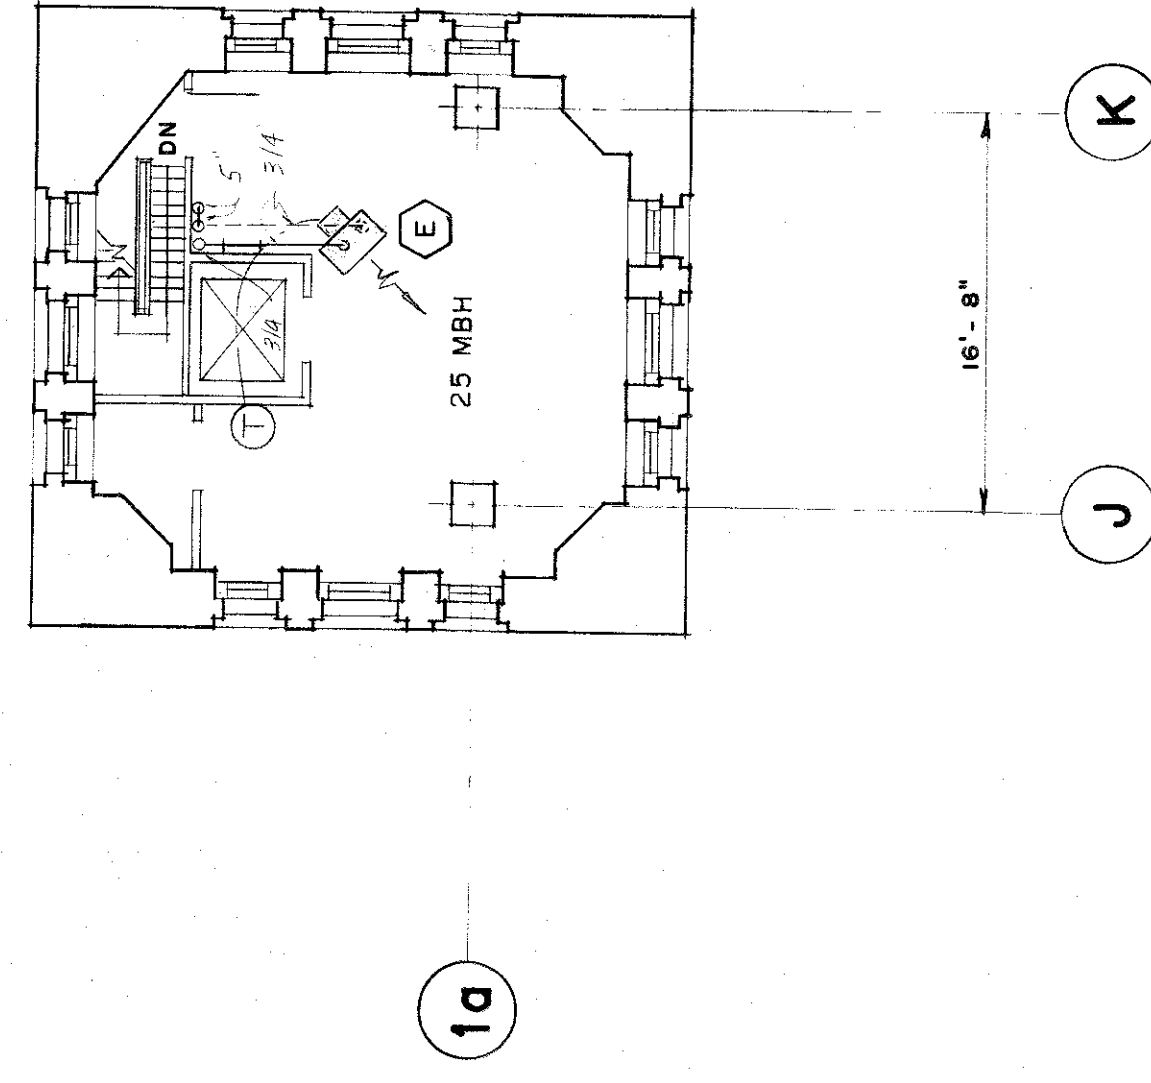


TWELFTH FLOOR PLAN

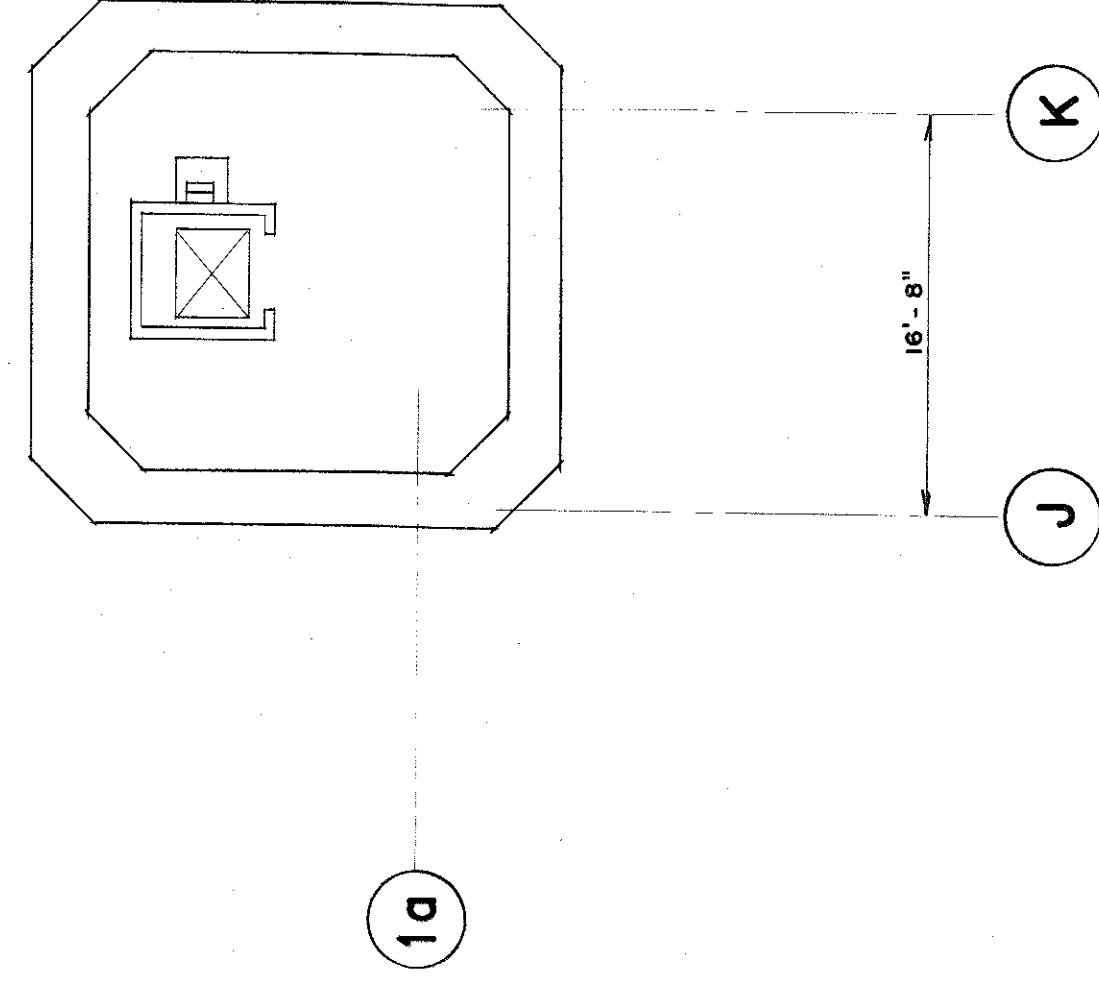


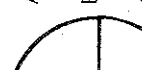
THIRTEENTH FLOOR PLAN

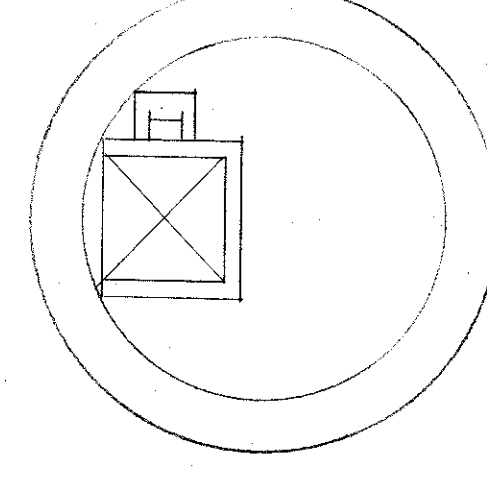

FOURTEENTH FLOOR PLAN

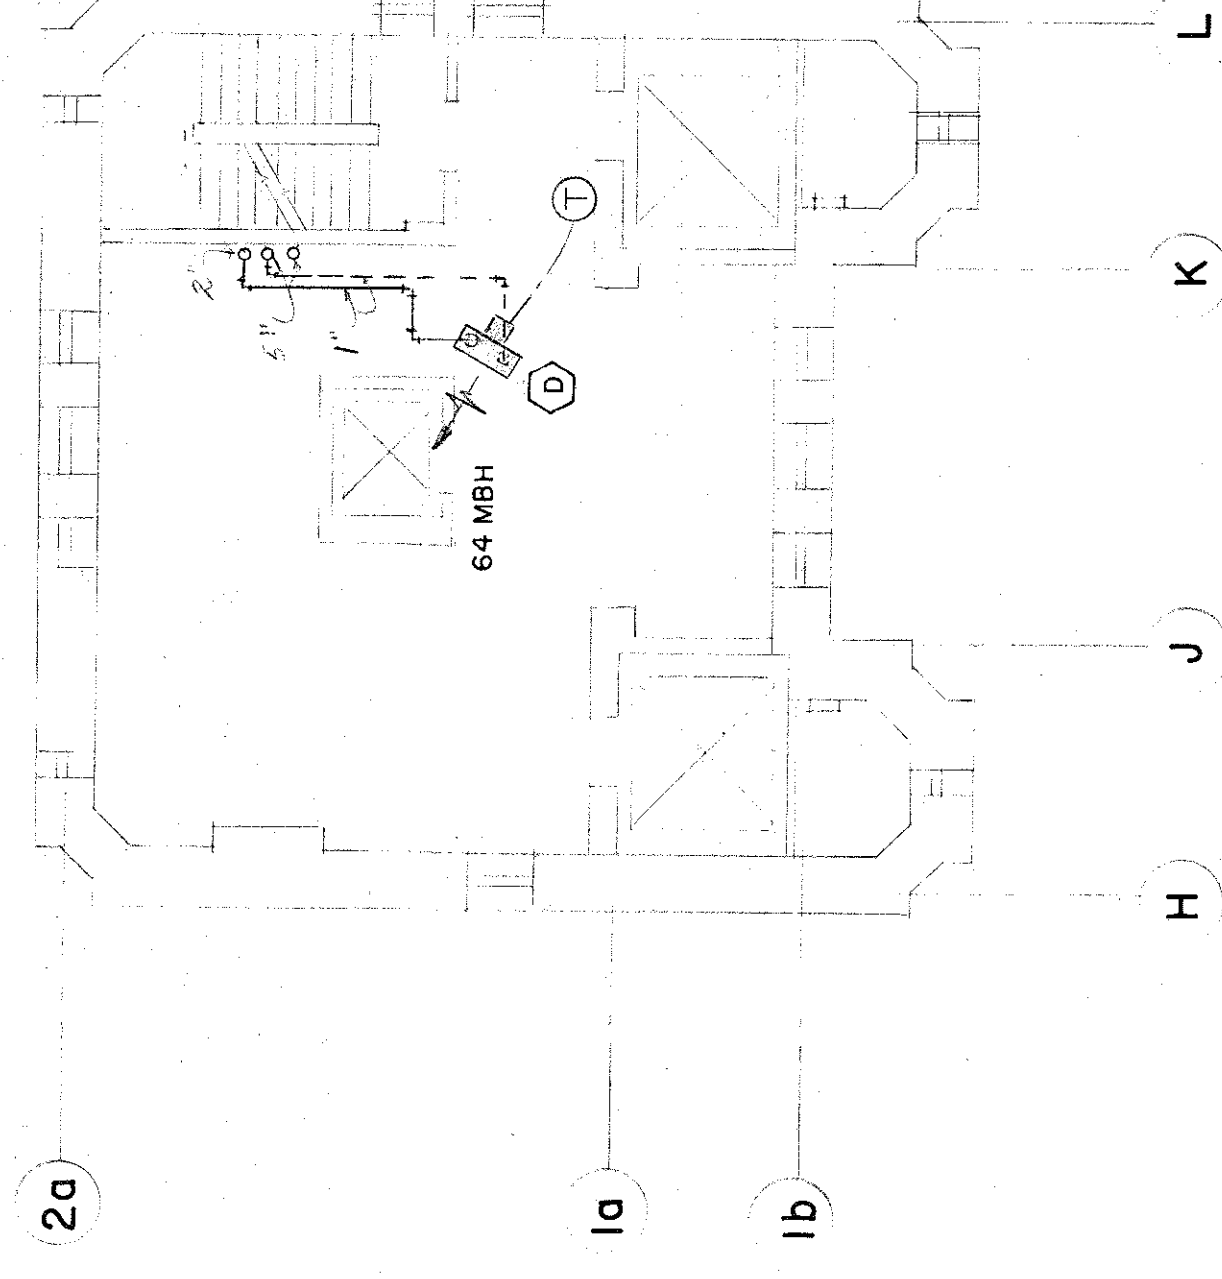

EIGHT FLOOR PLAN

revisions		date	
			
A dessin no. B location drawing no. sur dessin no. C dessin no.		A dessin no. B location drawing no. sur dessin no. C dessin no.	
projet GOC-B BEDFORD HALIFAX, N. S.		projet 	
drawing FLOOR PLANS 8th. to 14th.		dessin 	
HEATING			
designed	P DUMARESO		copied
date			
drawn	L. DEVEAU		dessiné
date			
reviewed	<i>RLH</i>		examined
date	9/10/11/6		
approved			approuvé
date			
under	<i>Heaton</i>		Scoutlation
PNC Project Manager	Administrateur de projets TTC		
project number	614362		no. du projet
drawing no.			no. du dessin