



NINTH FLOOR PLAN

SCALE: 1/8" = 1'-0"

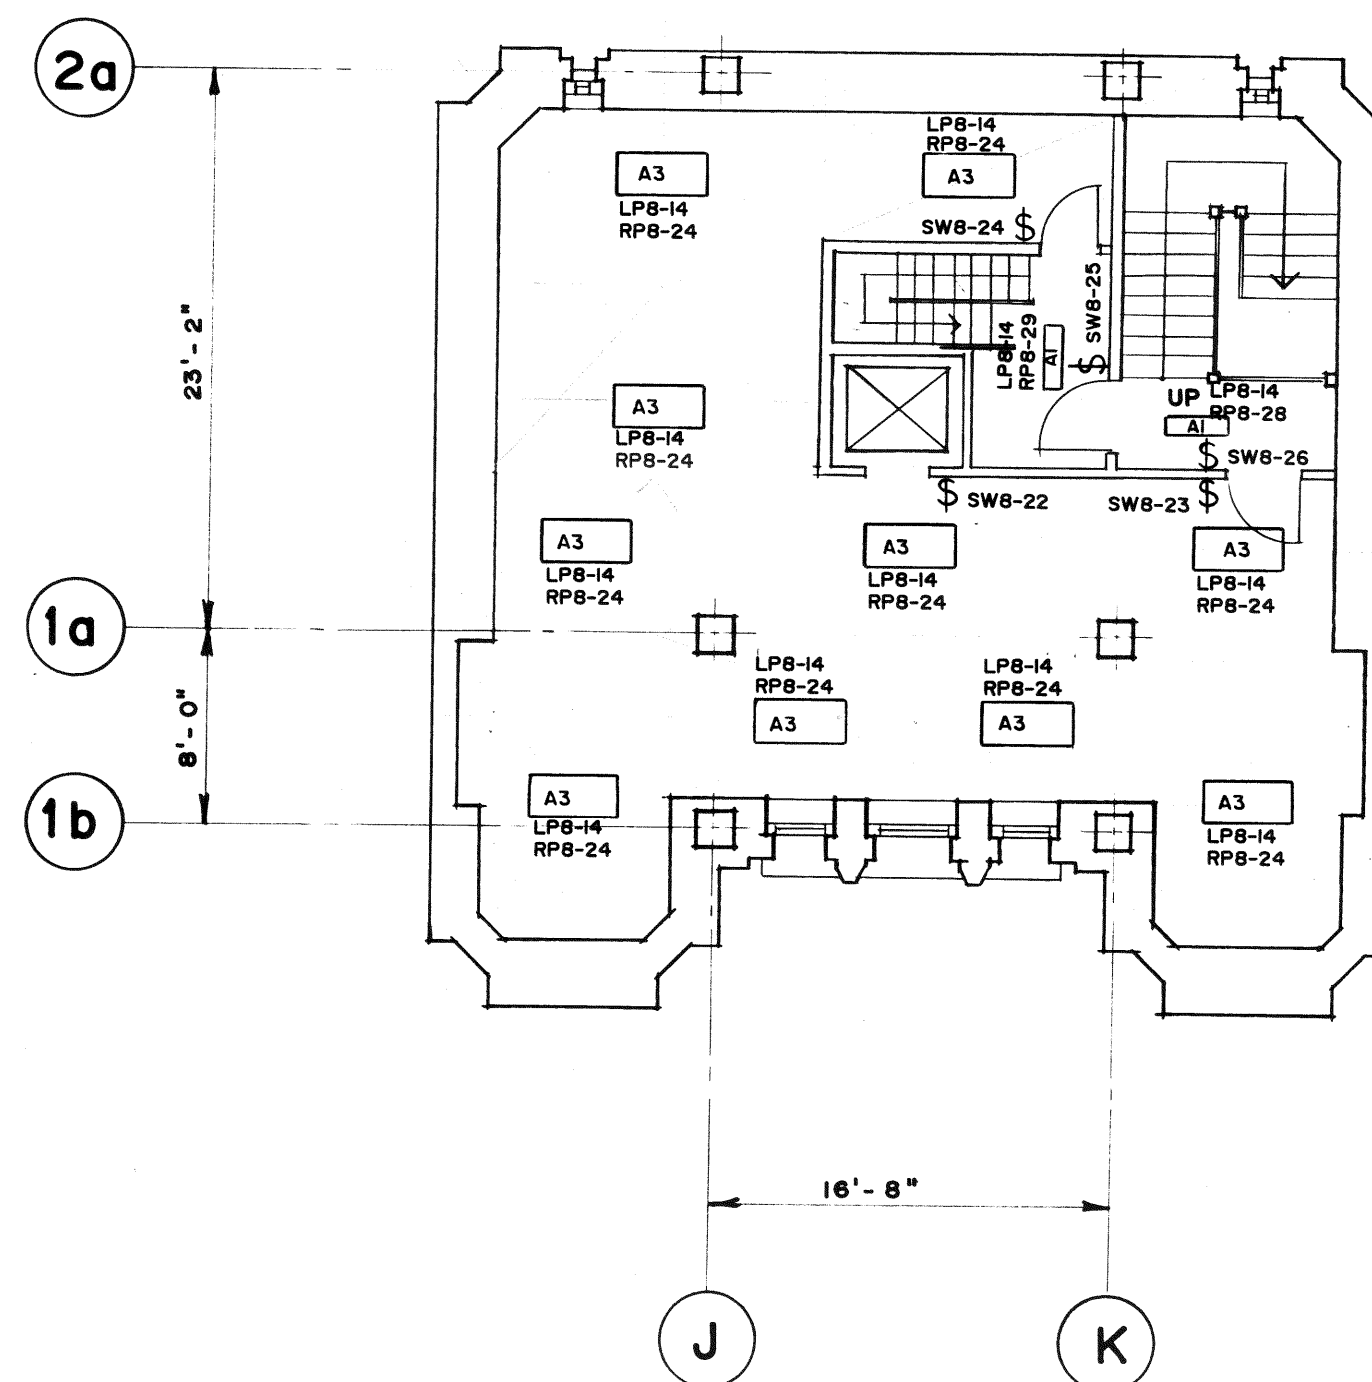


TENTH FLOOR PLAN

SCALE: 1/8" = 1'-0"

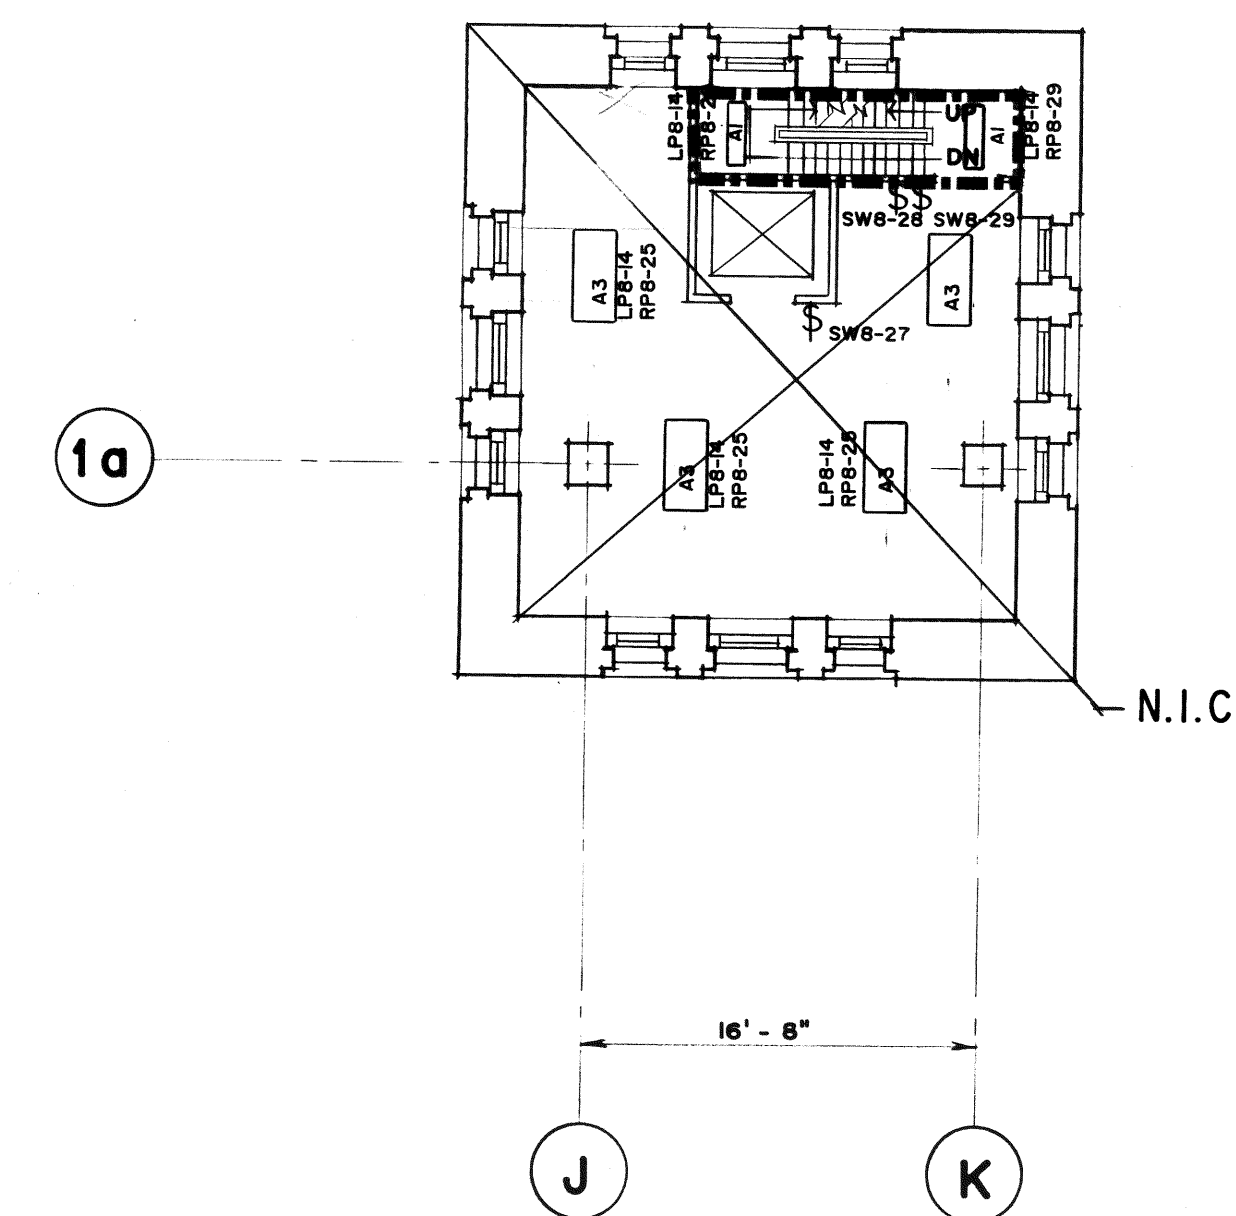


ELEVENTH FLOOR PLAN

SCALE: 1/8" = 1'-0"

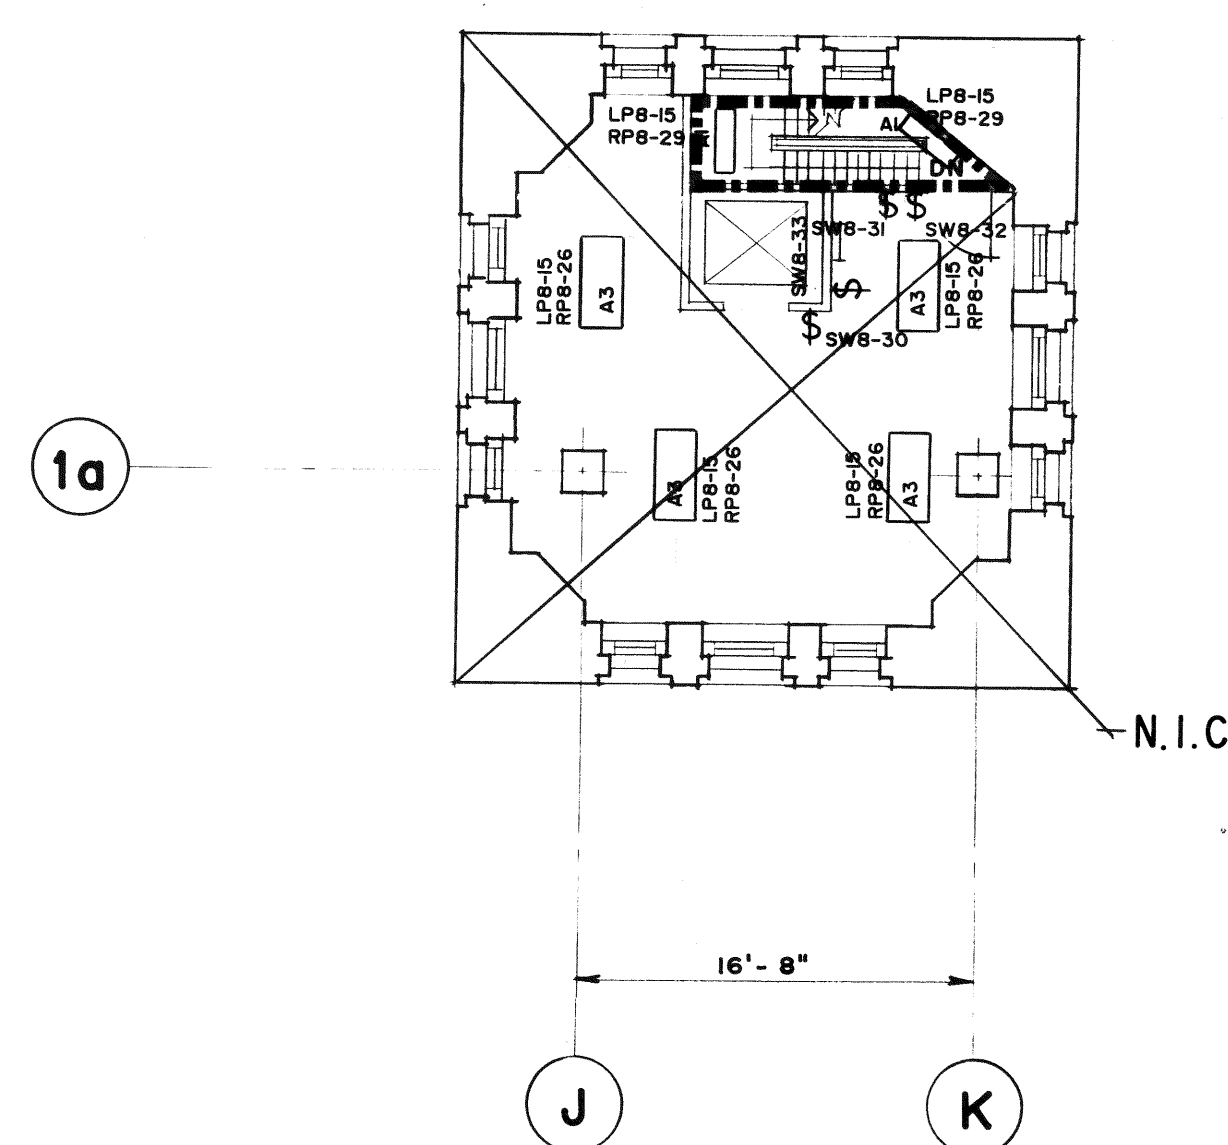


TWELFTH FLOOR PLAN

SCALE: 1/8" = 1'-0"

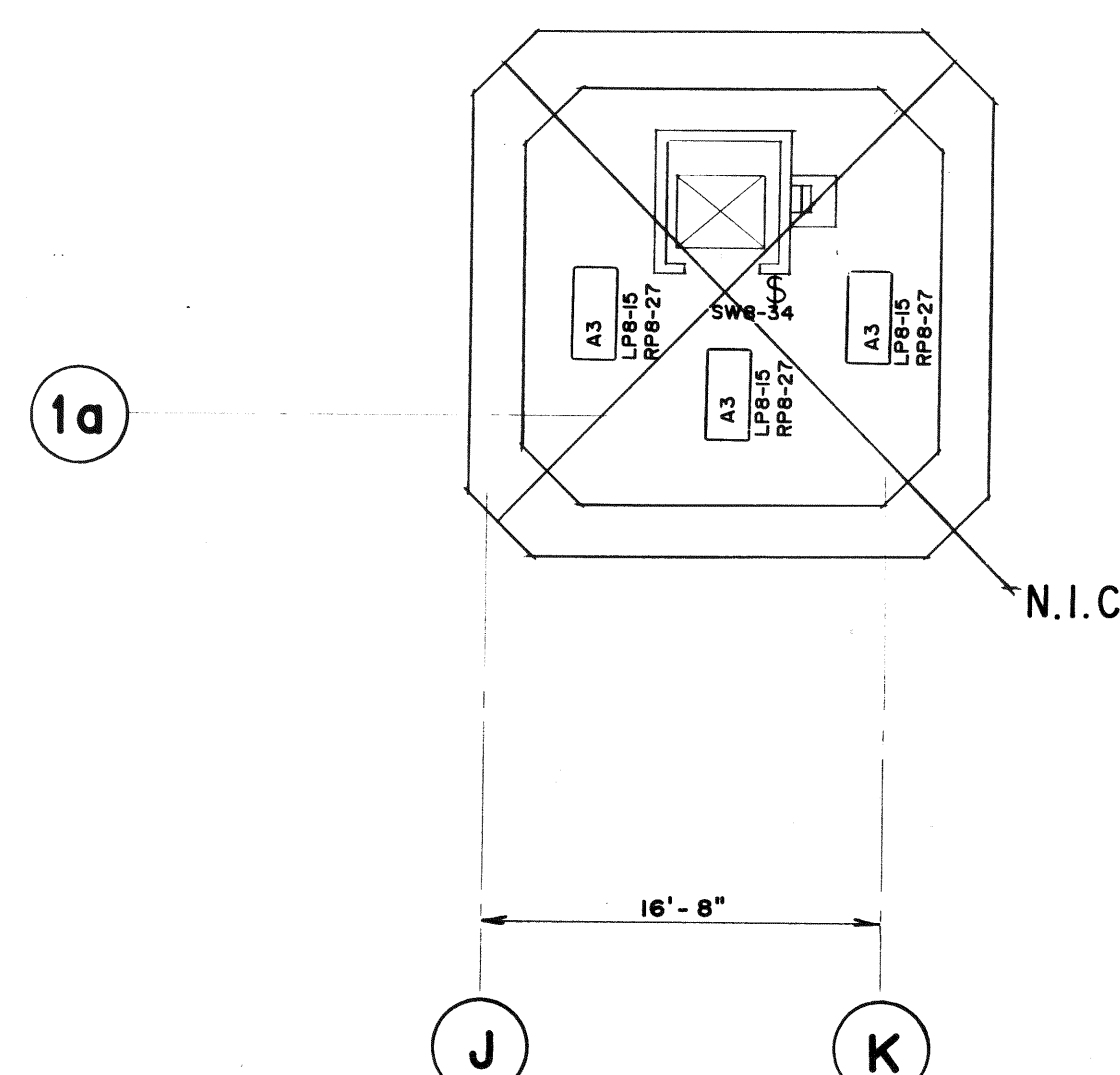

THIRTEENTH FLOOR PLAN

SCALE: 1/8" = 1'-0"

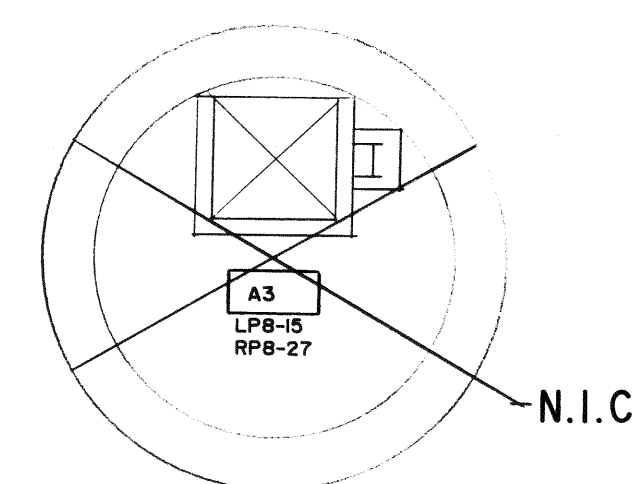

FOURTEENTH FLOOR PLAN

SCALE: 1/8" = 1'-0"

LIGHTING LEGEND

(REFER TO MAIN LEGEND ON DRAWING E-31)

- A1 - 1-LAMP, 4' X 5", SURFACE MOUNTED FLUORESCENT FIXTURE. C/W 1 TYPE F1 LAMP AND WRAP AROUND LENS.
- A3 - 3-LAMP, 4' X 14", SURFACE MOUNTED FLUORESCENT FIXTURE. C/W 3 TYPE F1 LAMPS AND WRAP AROUND LENS. CHAIN SUSPENDED.
- A4 - 3-LAMP, 4' X 2'; SURFACE MOUNTED FLUORESCENT FIXTURE. C/W 3 TYPE F1 LAMPS AND A FRAMED LENS. PENDANT MOUNTED.
- A6 - 3-LAMP, 4' X 2'; SURFACE MOUNTED FLUORESCENT FIXTURE. C/W 3 TYPE F1 LAMPS AND A DEEP CELL PARABOLIC LENS. PENDANT MOUNTED.
- B4 - RECESSED; 3-LAMP, FLUORESCENT FIXTURE C/W 3 TYPE F1 LAMPS AND FRAMED LENS.
- B6 - RECESSED; 3-LAMP, FLUORESCENT FIXTURE C/W 3 TYPE F1 LAMPS AND A DEEP CELL PARABOLIC LENS.
- C1 - 4'; SINGLE TUBE, FLUORESCENT STRIP LIGHT. C/W 1 TYPE F1 LAMPS.
- C2 - 4'; 2-LAMP FLUORESCENT STRIP LIGHT. C/W 2 TYPE F1 LAMPS.
- C3 - 2'; SINGLE LAMP, FLUORESCENT STRIP LIGHT. C/W 1 TYPE F1 LAMPS.
- D1 - SURFACE MOUNTED, FLUORESCENT WALL SCONCE C/W PL-13 LAMPS. (FOUNTAIN)
- D2 - RECESSED CEILING MOUNTED WALL WASHER FIXTURE. C/W 2 PL-7 LAMPS. MOUNTED ABOVE FOUNTAIN.
- E5 - WALL MOUNTED (SURFACE), 4' X 8" FLUORESCENT FIXTURE C/W 2 TYPE F1 LAMPS. MOUNTED 1'-0" BELOW CEILING.
- F1 - PENDANT MOUNTED; INDUSTRIAL TYPE 2-LAMP, FLUORESCENT FIXTURE C/W 2 TYPE F1 LAMPS AND A SLOTTED REFLECTOR.
- V1 - 2-LAMP, SURFACE MOUNTED VAPOUR PROOF FLUORESCENT FIXTURE C/W 2 TYPE F1 LAMPS.
- I4 - RECESSED, 2 LAMP FLUORESCENT FIXTURE C/W 2-13W PL LAMPS.
- S1 - WALL OR CEILING MOUNTED EXIT LIGHT. RESPECTIVELY.
- S1 - 200W, 347V SURFACE MOUNTED. METAL HALIDE FIXTURE.

revisions: date

A detail no. no. du détail
B location drawing no. sur dessin no.
C drawing no. dessin no.

project
G.O.C.B. BEDFORD ROW
HALIFAX, N. S.

drawing
FLOOR PLANS
LIGHTING

ELECTRICAL

designed G. C. HICKS conçu

date

drawn W. SZUBIELSKI dessiné

date

reviewed 9/1/91 examiné

date 9/1/91

approved approuvé

date

Tender Soumission

PWC Project Manager Administrateur de projets TPC

project number no. du projet

614362

drawing no. no. du dessin

E-10