




NINTH FLOOR PLAN
SCALE: 1/8" = 1'-0"

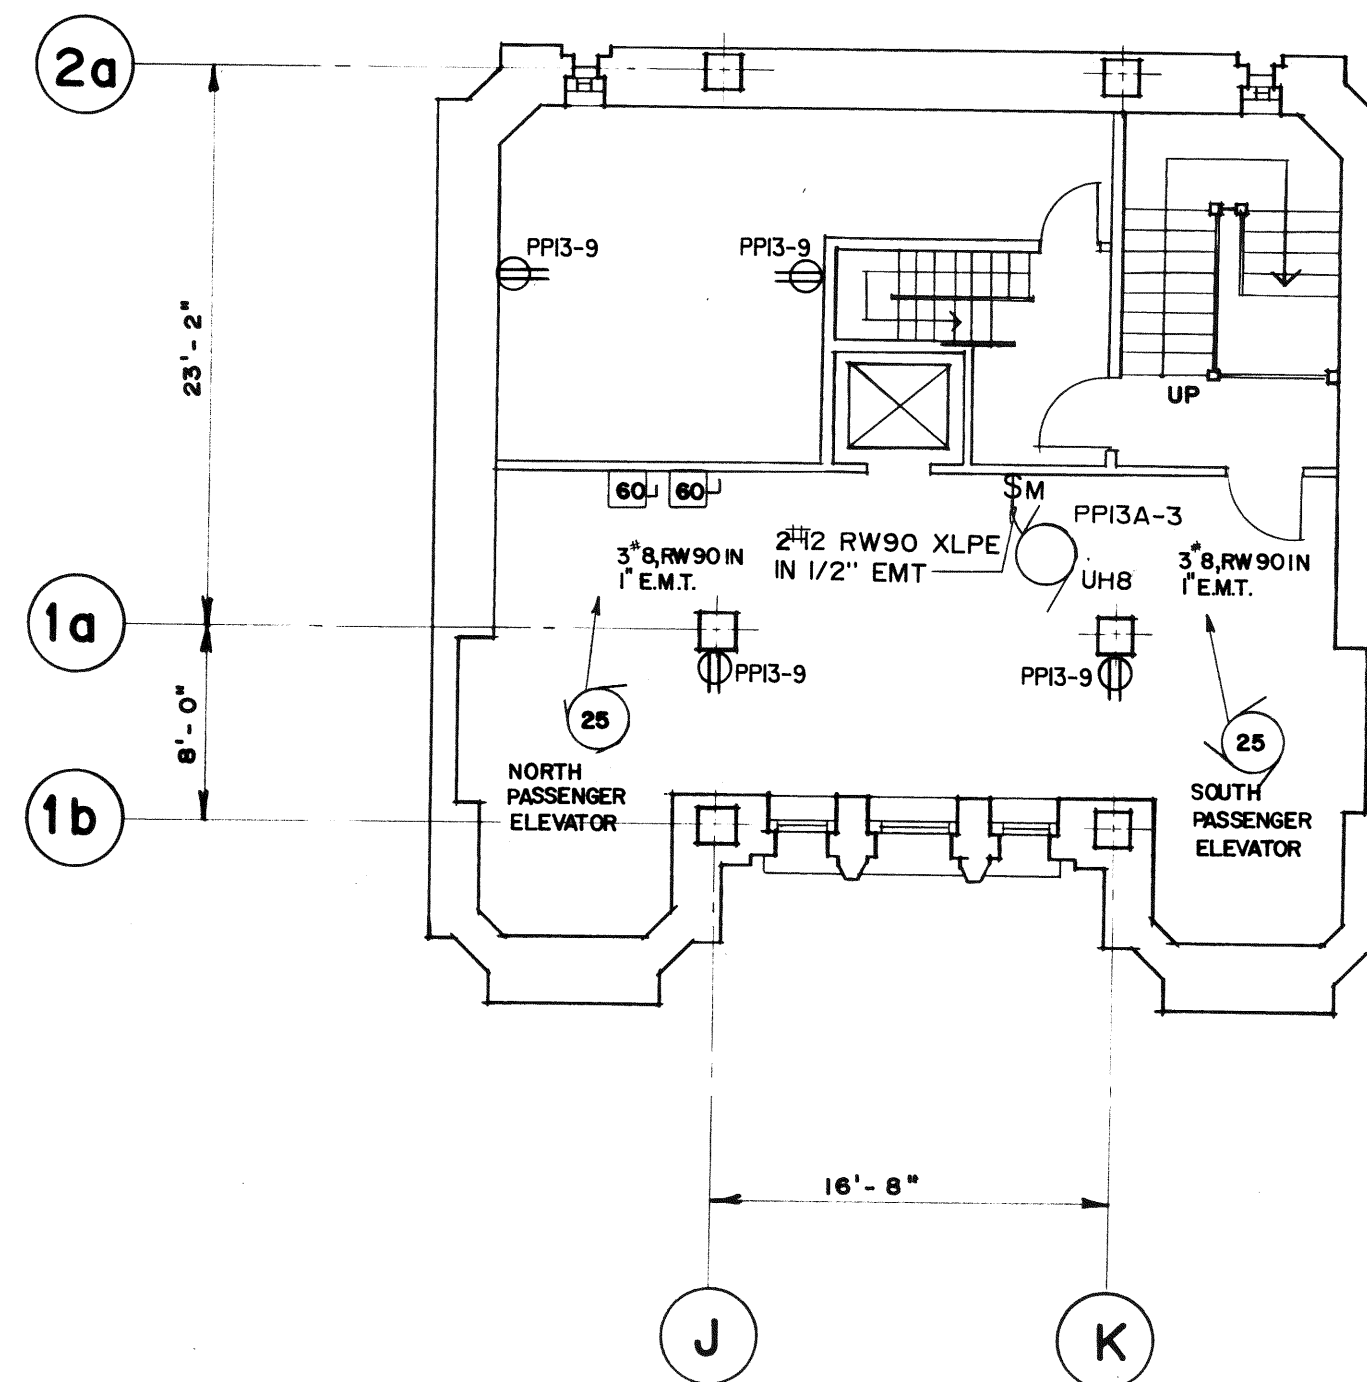


TENTH FLOOR PLAN
SCALE: 1/8" = 1'-0"

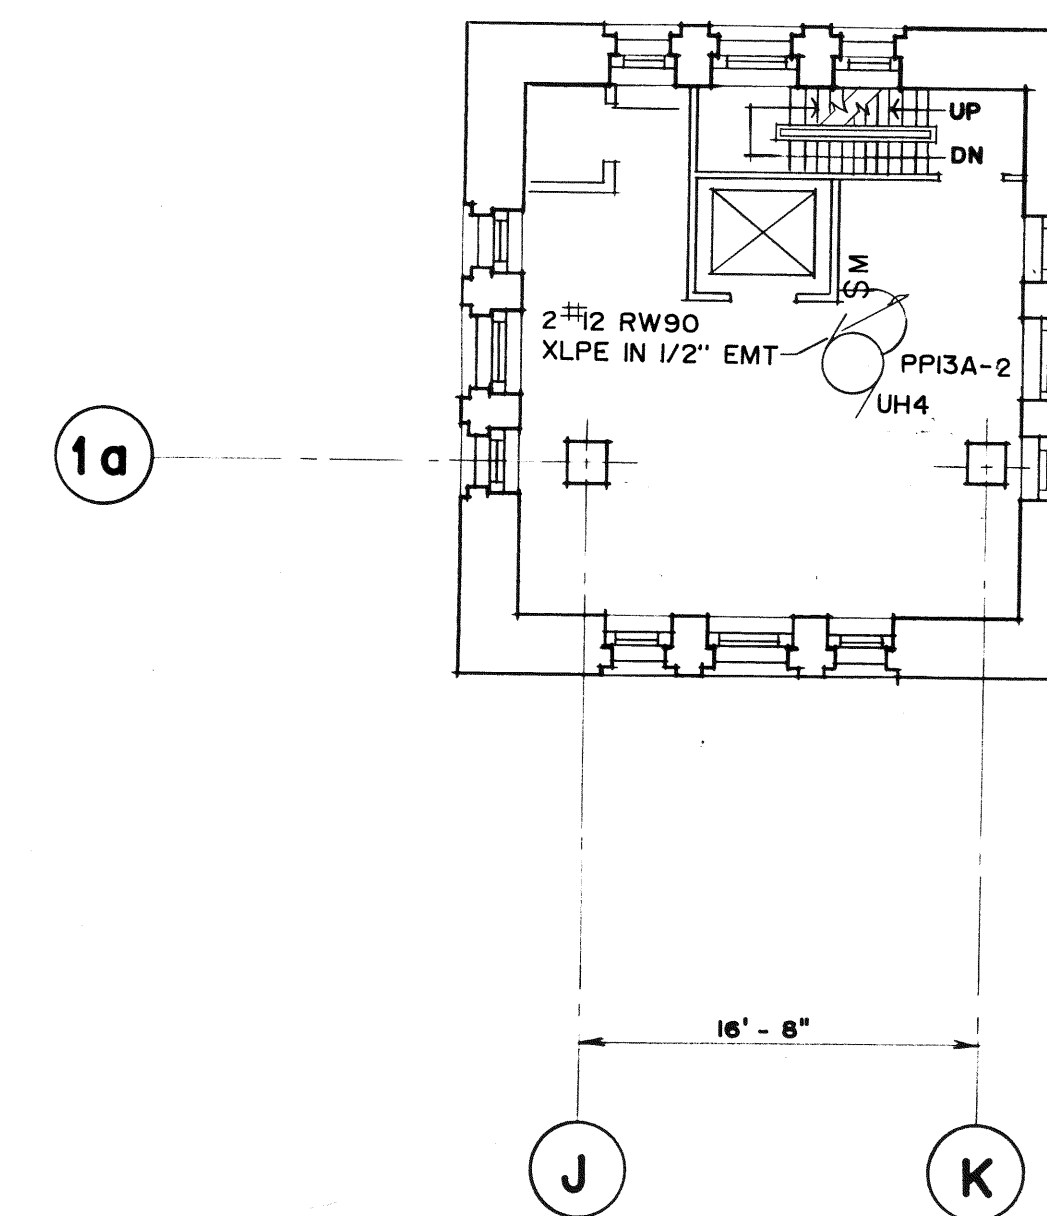


ELEVENTH FLOOR PLAN
SCALE: 1/8" = 1'-0"

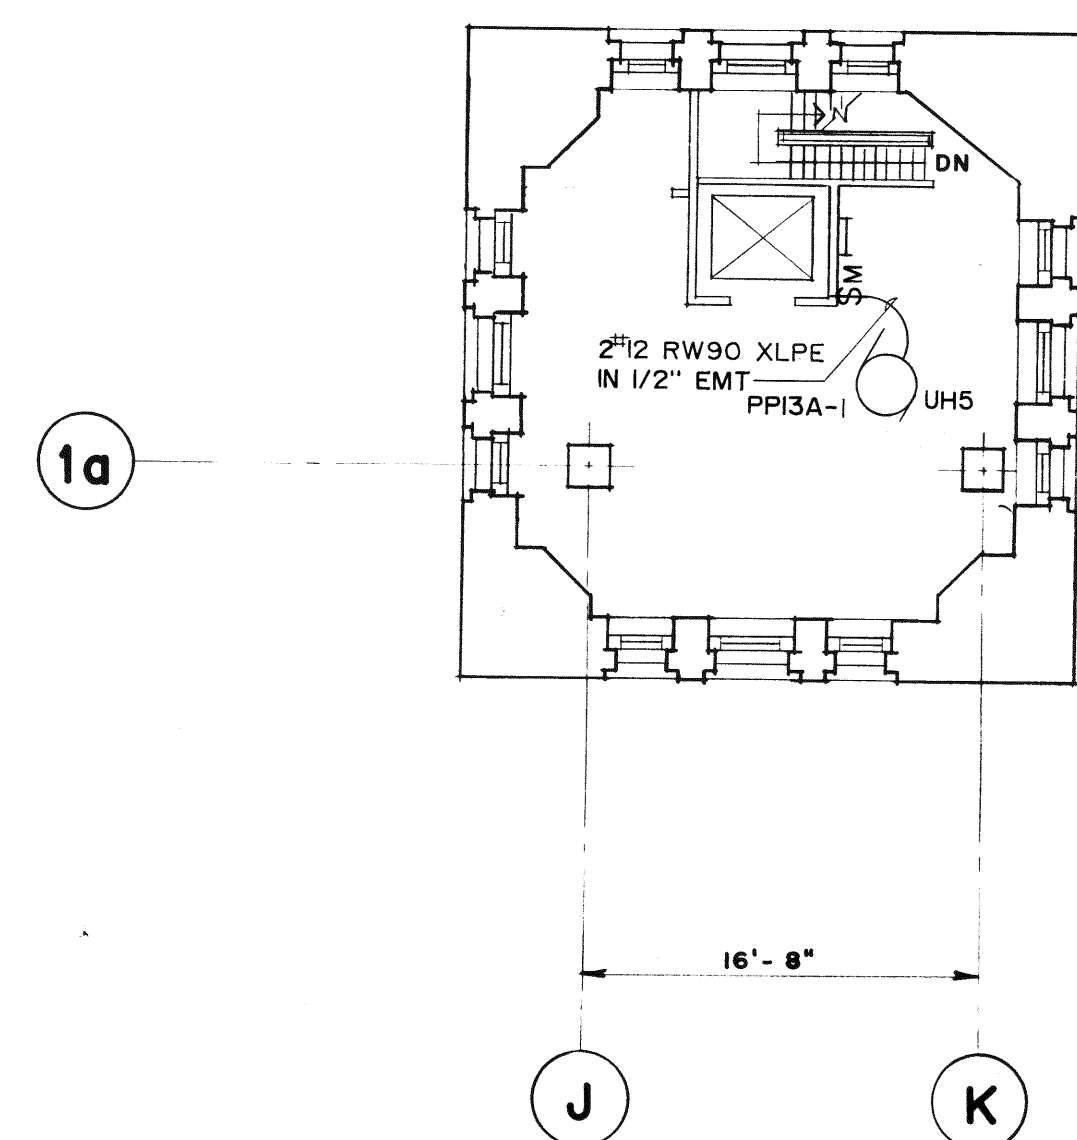

TWELFTH FLOOR PLAN
SCALE: 1/8" = 1'-0"

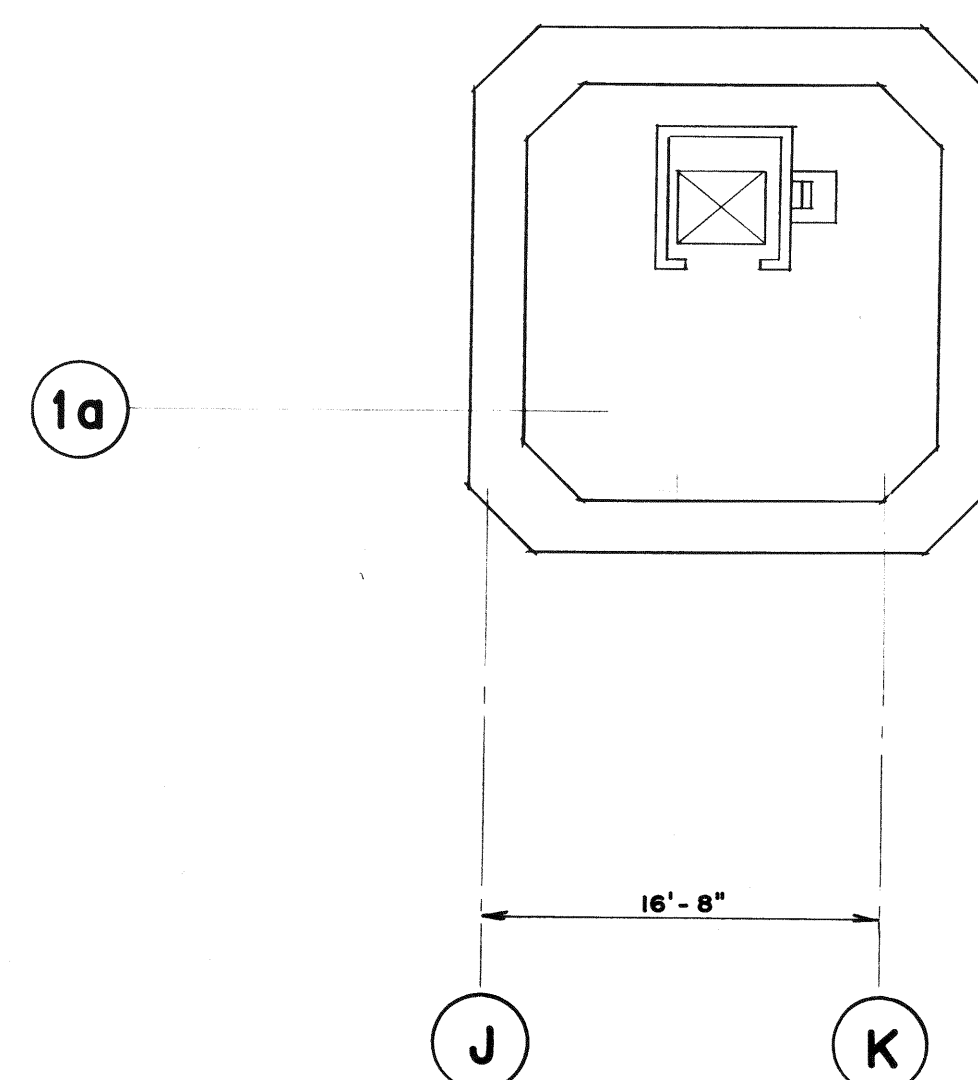

THIRTEENTH FLOOR PLAN
SCALE: 1/8" = 1'-0"

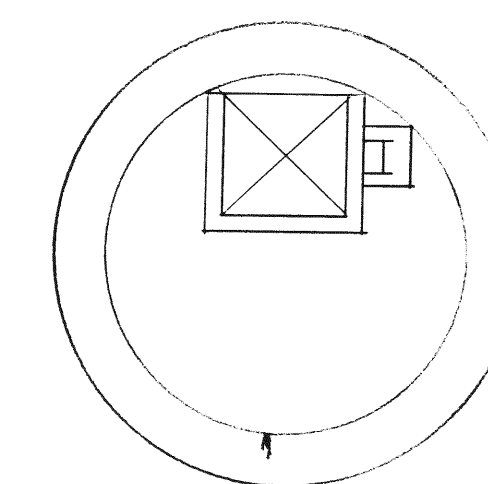

FOURTEENTH FLOOR PLAN
SCALE: 1/8" = 1'-0"

revisions date

A detail no. no. du détail
B location drawing no. sur dessin no.
C drawing no. dessin no.

project
G.O.C.B. BEDFORD ROW HALIFAX, N. S.

drawing
FLOOR PLANS POWER

ELECTRICAL

designed **G. C. HICKS** conçu

date

drawn **W. SZUBIELSKI** dessiné

date

reviewed **W. Szubielski** examiné

date **Apr 9/91**

approved

date

Tender **Shaw** Soumission

PWC Project Manager Administrateur de projets TPC

project number **614362** no. du projet

drawing no. **E-19** no. du dessin