
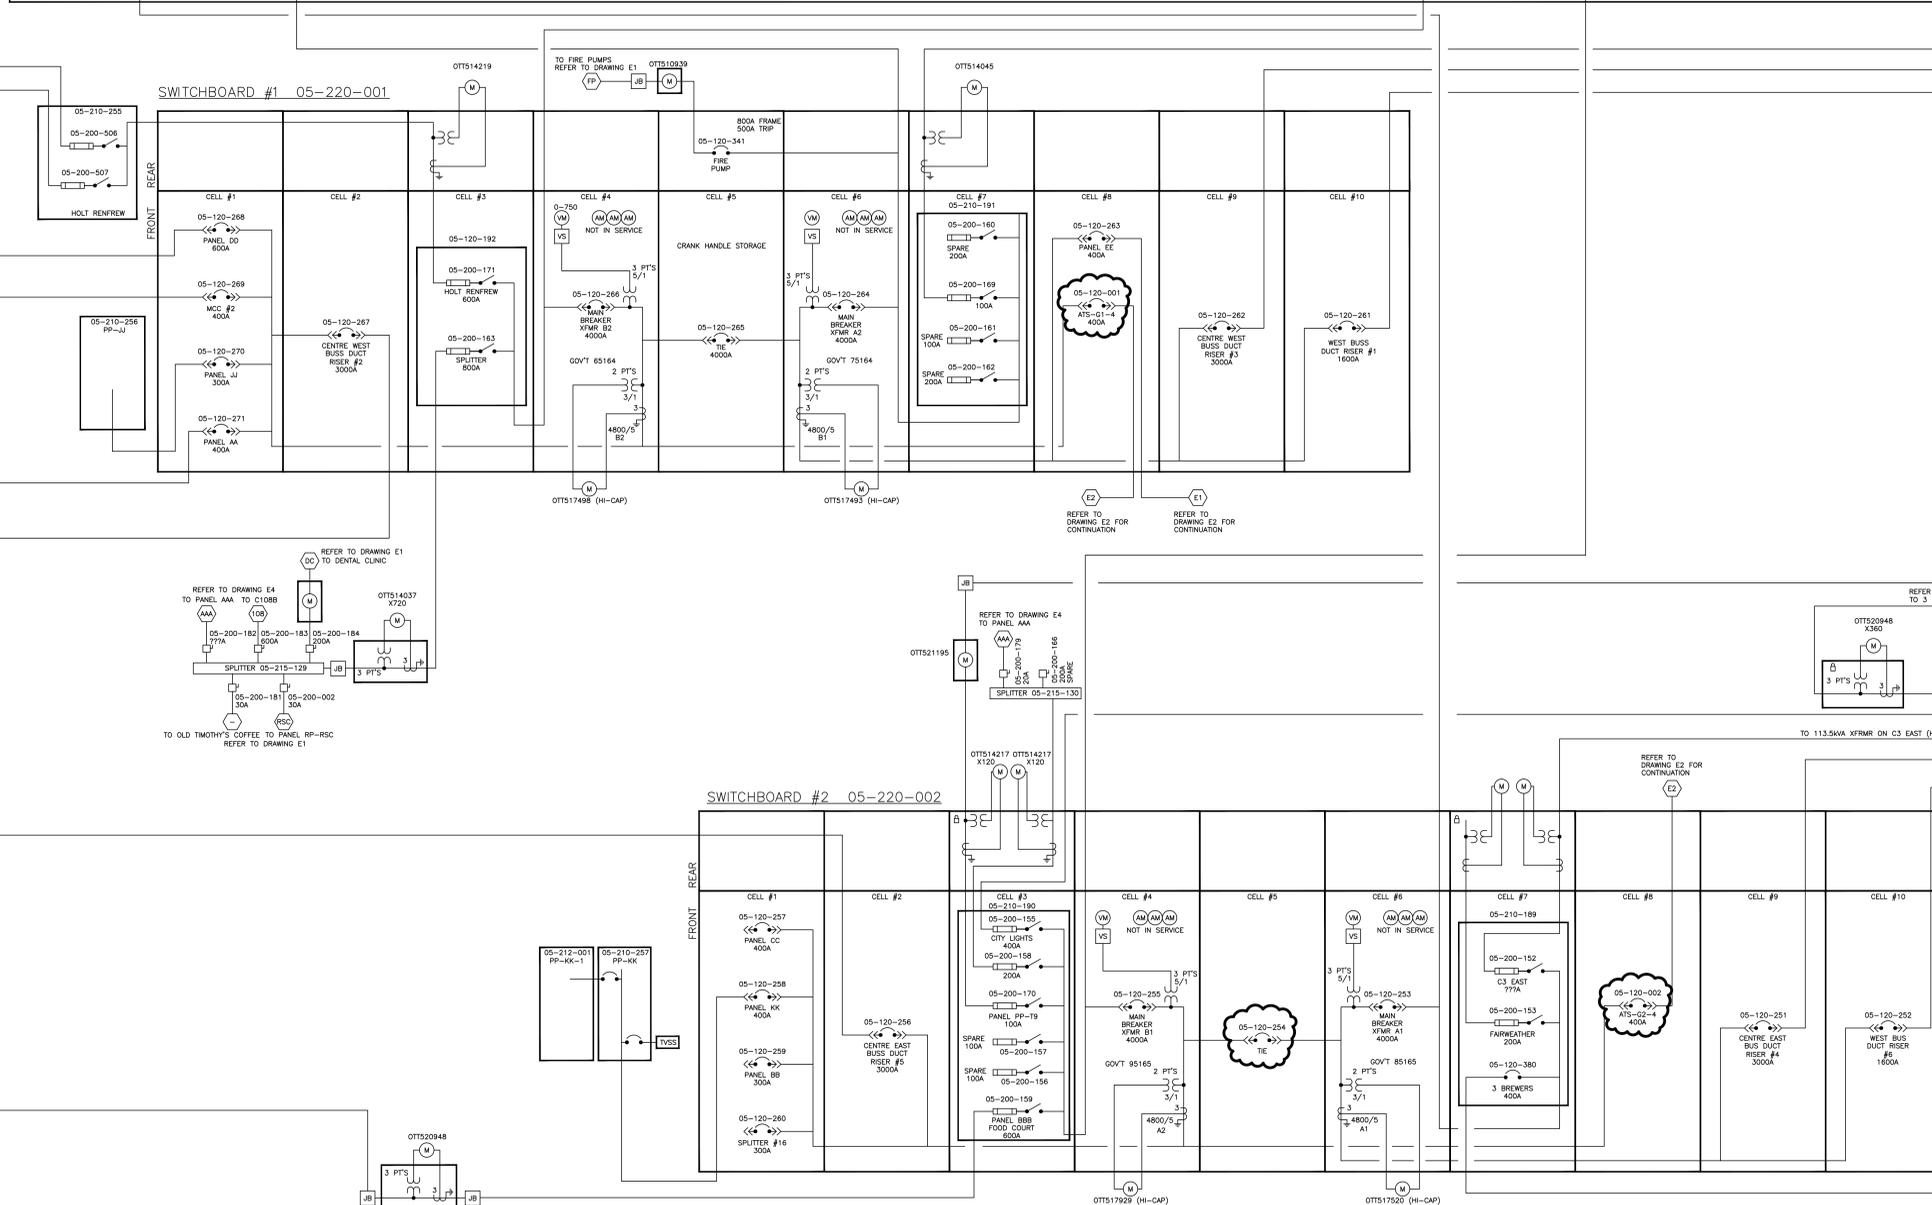


O.H.E.C. VAULT VT-307 (ROOM S-136) 06-500-001

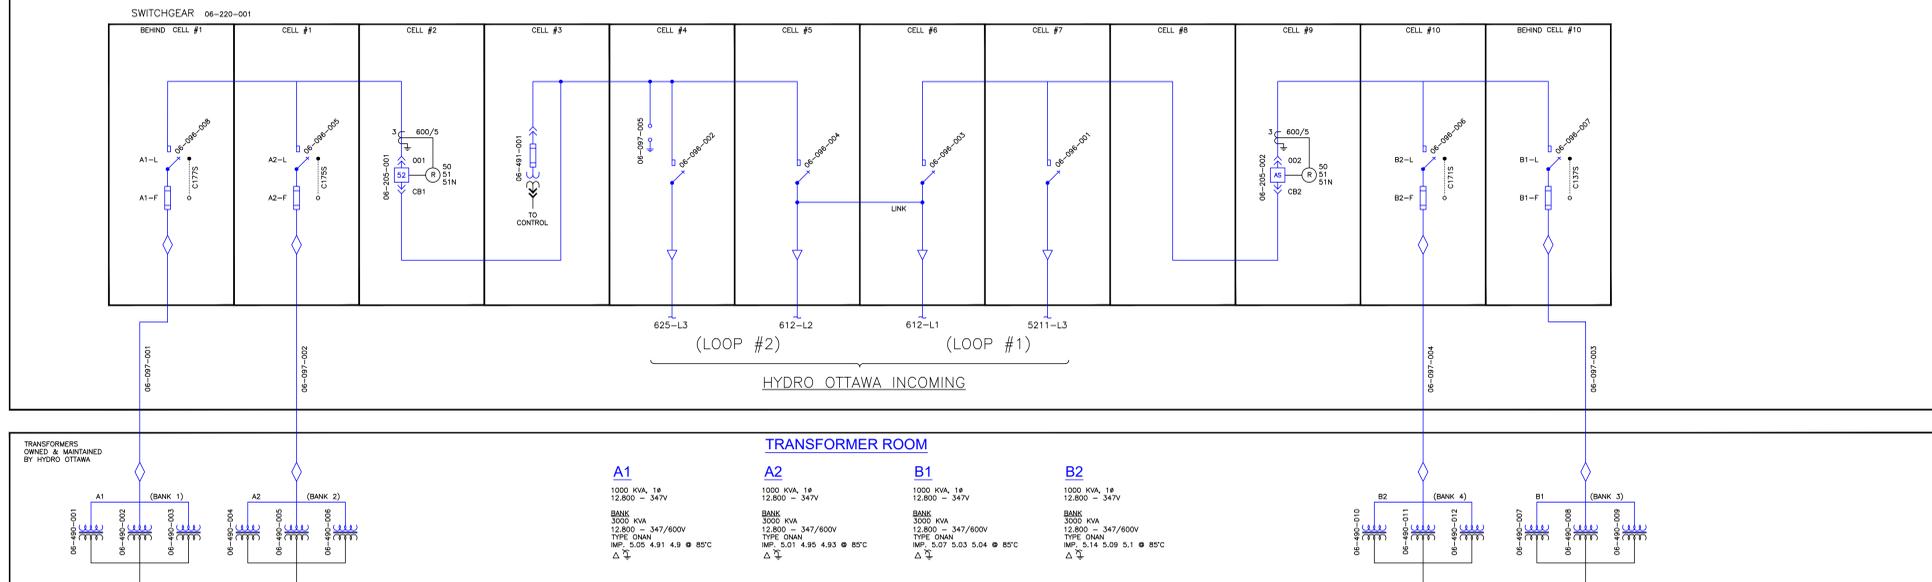

**ELECTRICAL SINGLE LINE DIAGRAM LEGEND**

| SYMBOL / SYMBOLE             | DESCRIPTION                                  |
|------------------------------|----------------------------------------------|
| HIGH VOLTAGE EQUIPMENT       |                                              |
|                              | HAUTE TENSION CÂBLE                          |
|                              | CÔNE DE DÉTENTE                              |
|                              | INTERRUPTEUR DE CHARGE                       |
|                              | INTERRUPTEUR HAUTE TENSION                   |
|                              | CONDENSATEUR                                 |
|                              | TRANSFORMATEUR DE TENSION                    |
|                              | TRANSFORMATEUR DE TENSION AMOVIBLE A FUSIBLE |
|                              | PARAFODRE                                    |
|                              | FUSIBLE                                      |
| NON - HIGH VOLTAGE EQUIPMENT |                                              |
|                              | RELAY DE SURTENSION                          |
|                              | AMPÈREMETRE                                  |
|                              | VOLTMÈTRE                                    |
|                              | INTERRUPTEUR DE VOLTMÈTRE                    |
|                              | VERROUILLAGE A CLE KIRK                      |
|                              | DISJONCTEUR                                  |
|                              | CAMION DE FUSIBLES                           |
|                              | DISJONCTEUR ENFICHABLE                       |
|                              | COUPE-CIRCUIT                                |
|                              | TRANSFORMATEUR                               |
|                              | COMMUTATEUR DE TRANSFERT                     |
|                              | GÉNÉRATEUR DIESEL                            |
|                              | MÈTRE                                        |
|                              | DÉMARREUR                                    |
|                              | DÉMARREUR COMBINÉ                            |
|                              | CONTACTEUR                                   |
|                              | BOÎTE DE JONCTION                            |
|                              | PANNEAU ÉLECTRIQUE                           |
|                              | REPARTITEUR                                  |
|                              | S.G.                                         |
|                              | S.B.                                         |
|                              | MCC                                          |
|                              | UPS                                          |
|                              | VAULT                                        |

**LINETYPE LEGEND**

|  |                                          |
|--|------------------------------------------|
|  | RED ITEMS ARE FED BY EMERGENCY POWER     |
|  | BLUE ITEMS ARE FED BY HIGH VOLTAGE POWER |
|  | BLACK ITEMS ARE FED BY NORMAL POWER      |

**DRAWING DIMENSIONS**

FULL SIZE 762 MM X 1067 MM



5430 Canotek Road  
Ottawa, Ontario  
K1J 9G2  
Tel: (613) 842-3434  
Website: www.IRL.ca  
Fax: (613) 842-4338



**REVISIONS**

| revision | description             | date       |
|----------|-------------------------|------------|
| 1        | ISSUED FOR REVIEW (REV) | 27/11/2015 |
| 1        | ISSUED FOR TENDER       | 07/12/2015 |
| 1        | AS-BUILT DRAWING        | 04/03/2014 |

Prepared by the

C.D.HOWE BUILDING  
240 SPARKS STREET  
OTTAWA (ONTARIO)

drawing title  
OPERATION DRAWING  
SINGLE LINE DIAGRAM  
HIGH VOLTAGE  
DISTRIBUTION  
GOC325874

|             |              |
|-------------|--------------|
| designed by | conçu par    |
| drawn by    | dessiné par  |
| reviewed by | révisé par   |
| approved by | approuvé par |
| Dwg no.     | Dessin no.   |