

The following changes in the tender documents are effective immediately. This addendum will form part of the contract documents




1. Reference Issued for Tender Drawings, Sheet 5 of 11

Replace Sheet 5, “Issued for Tender” dated August 21, 2017 with attached Sheet 5 “Addenda #1” dated October 6, 2017.

2. Reference Issued for Tender Drawings, Sheet 7 of 11

Replace Sheet 7, “Issued for Tender” dated August 21, 2017 with attached Sheet 7 “Addenda #1” dated October 6, 2017.

---End of Addendum---

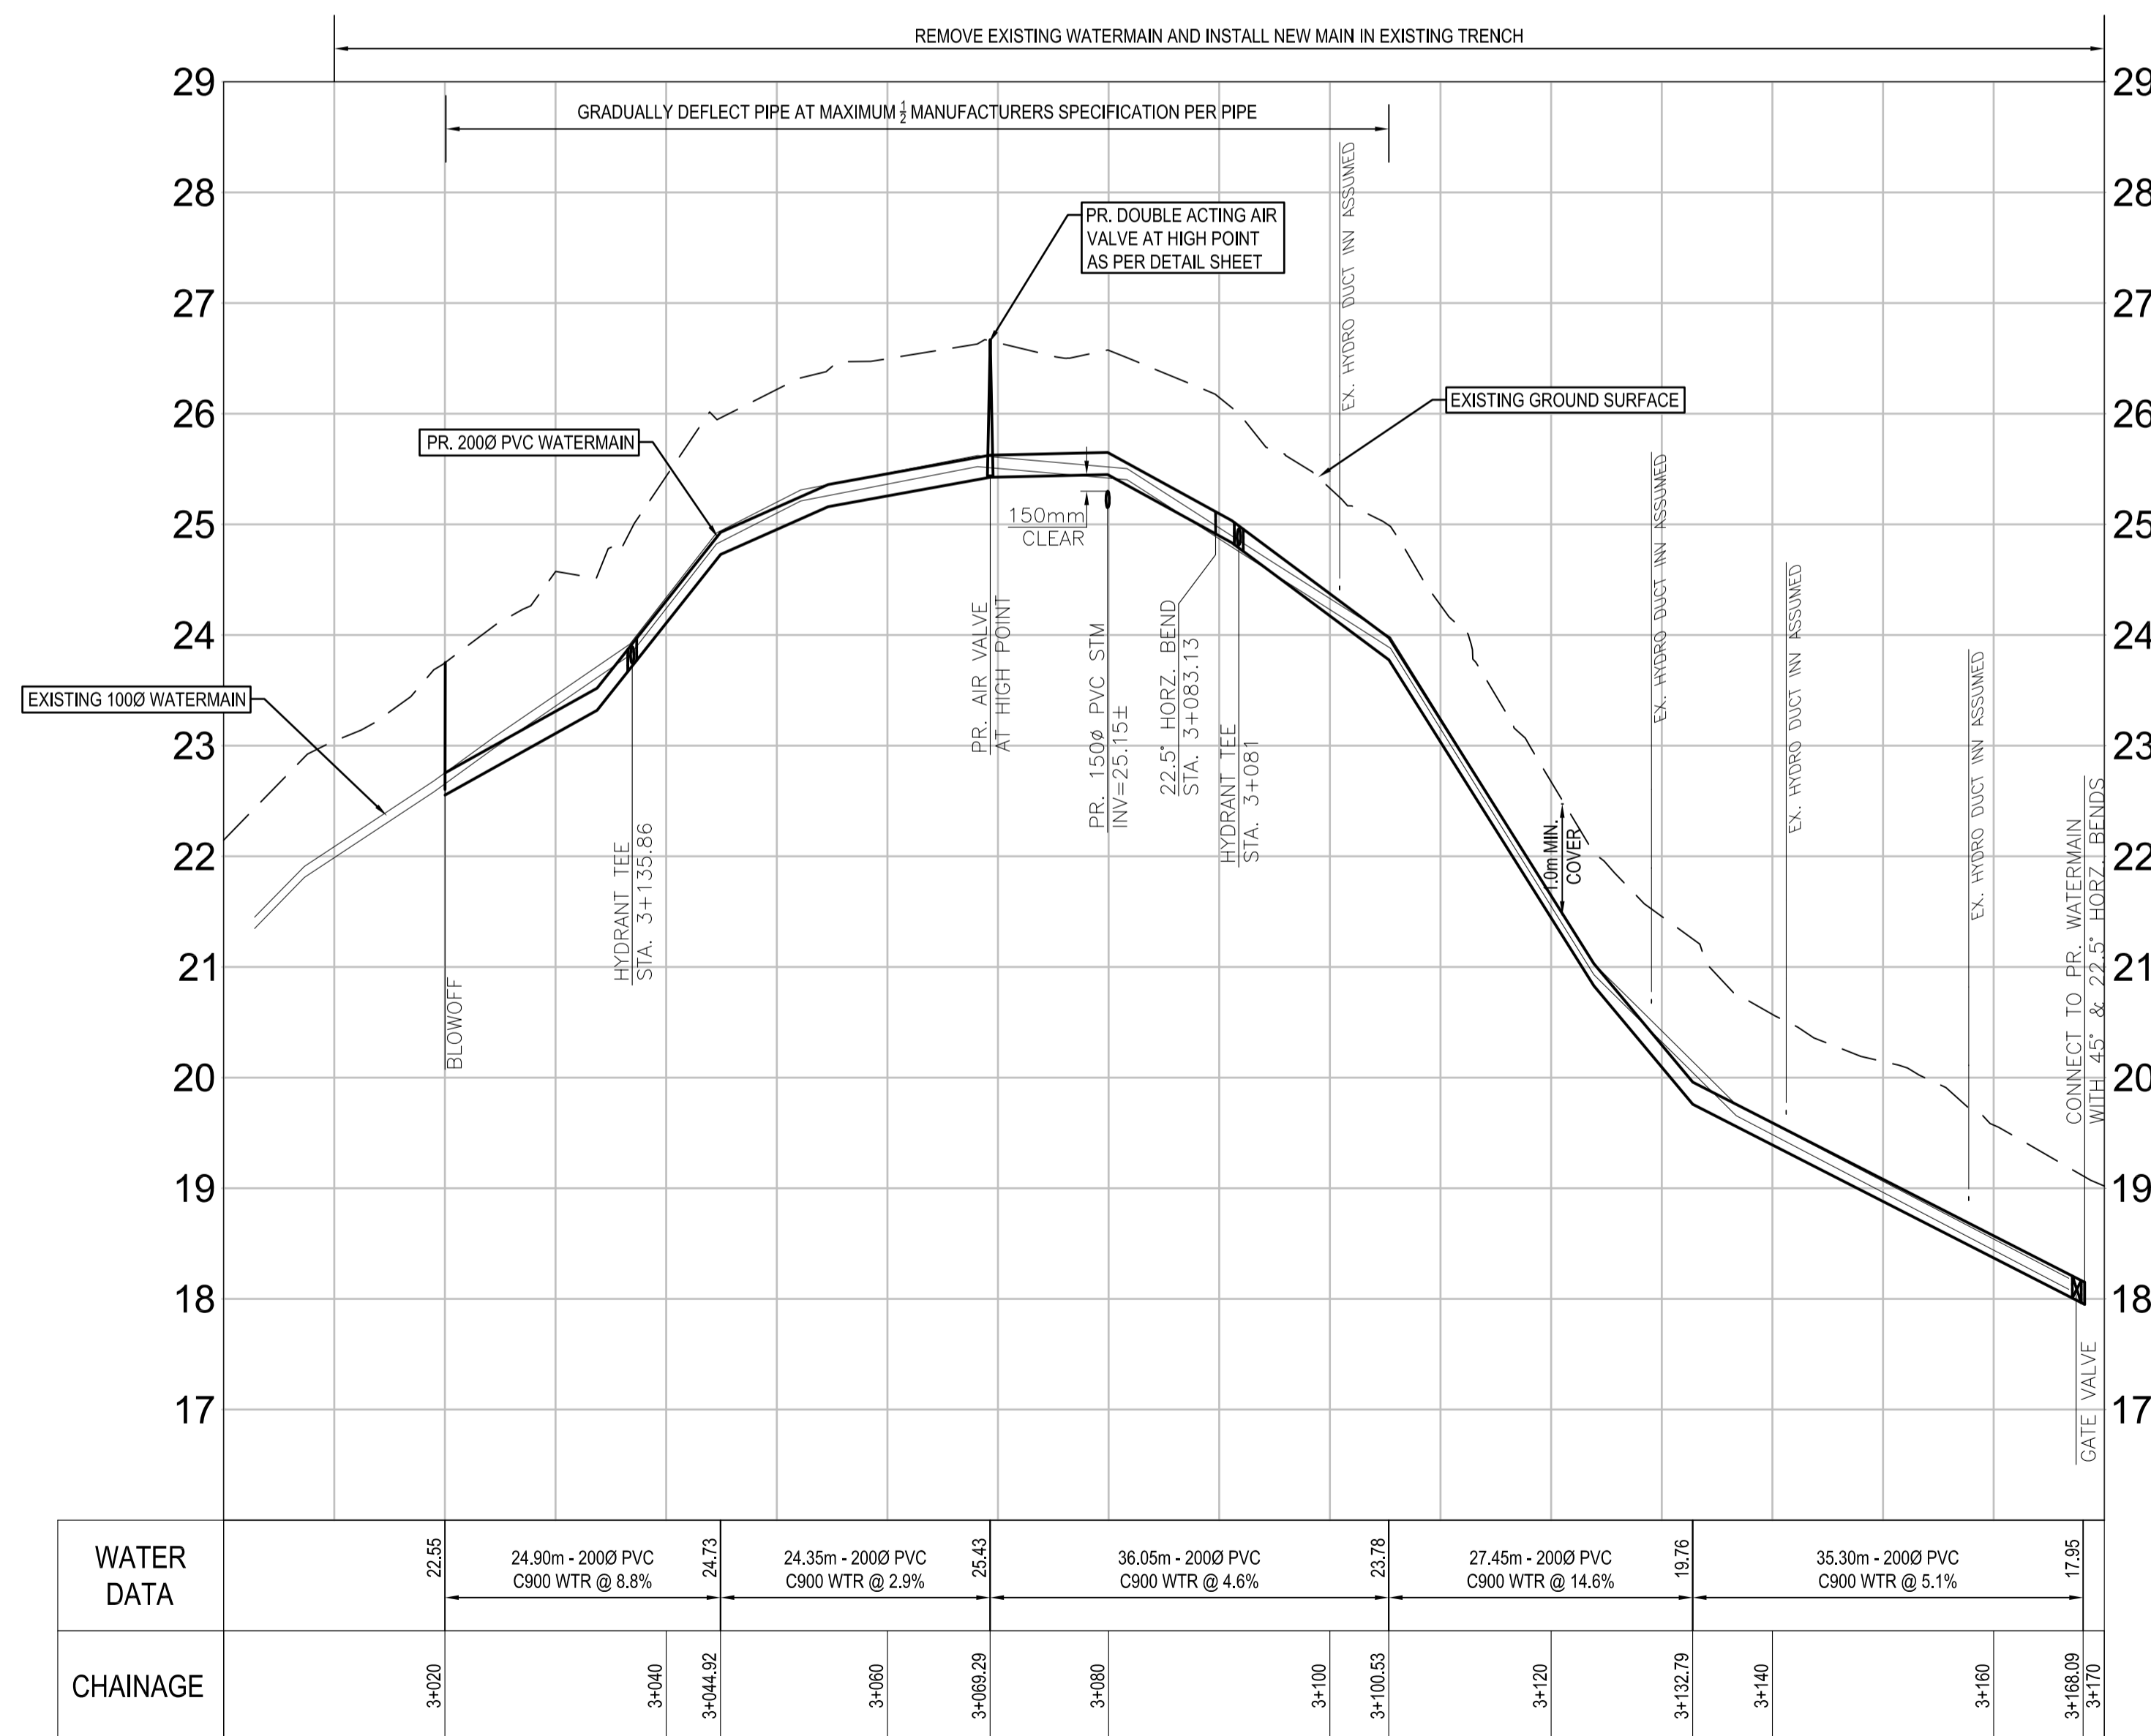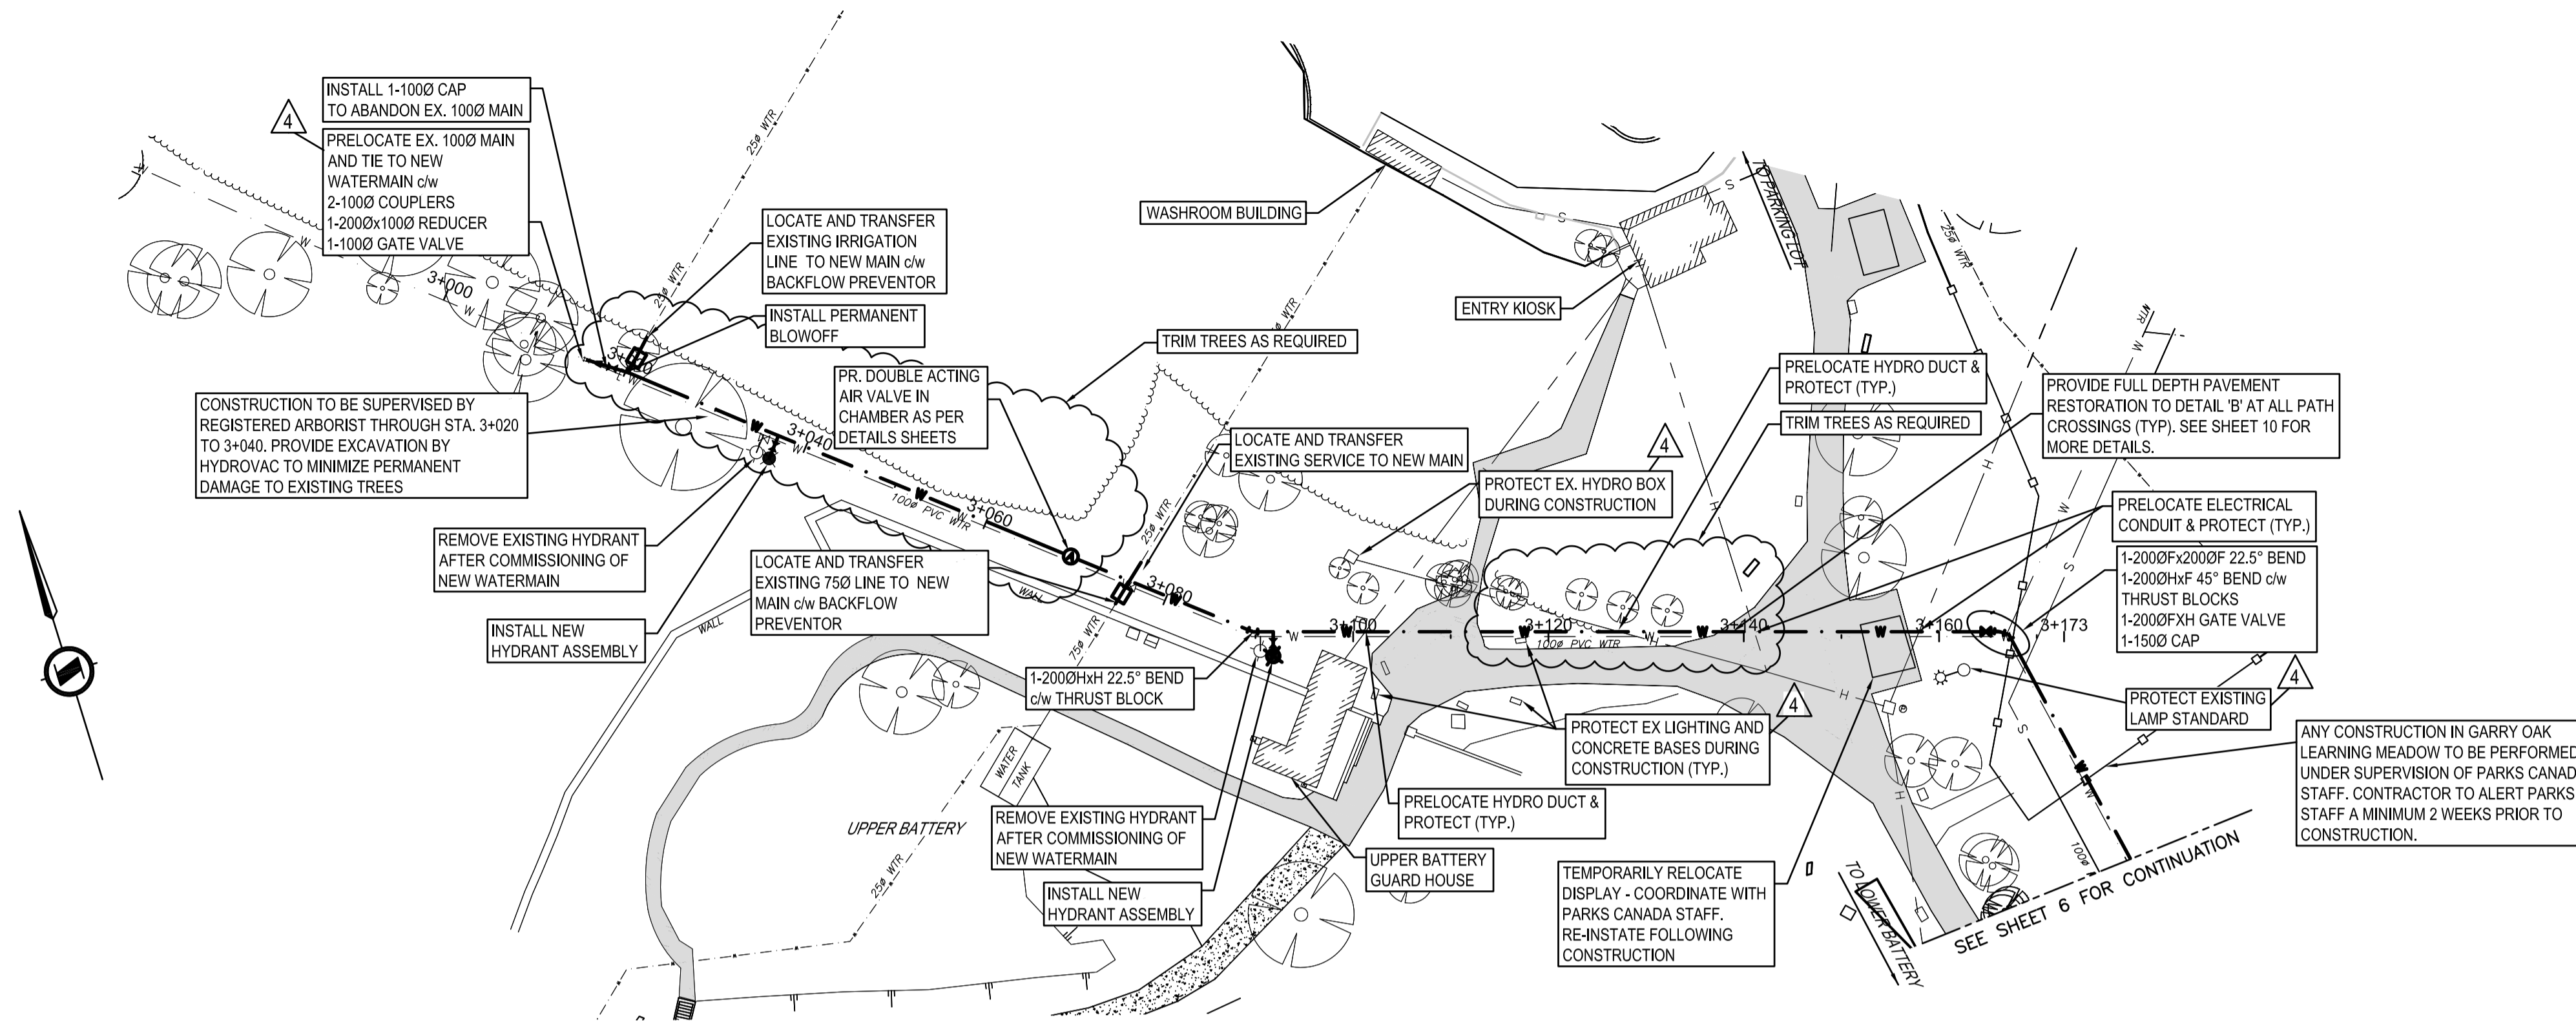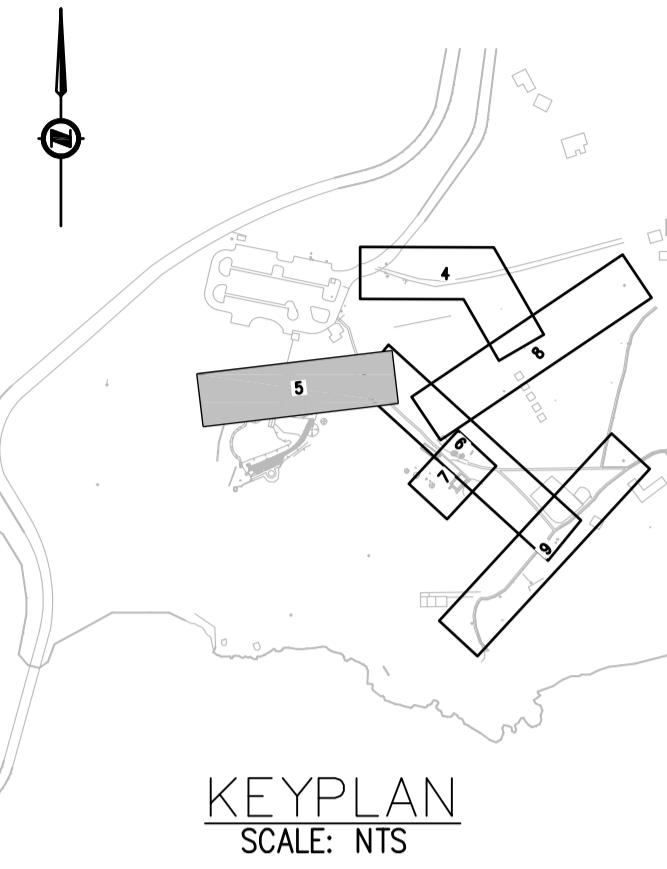

NOTES

- CONTRACTOR TO PRE-LOCATE ALL EXISTING UTILITIES AND ADVISE DEPARTMENTAL REPRESENTATIVE OF ANY CONFLICTS A MINIMUM OF 72 HOURS PRIOR TO CONSTRUCTION.
- EXISTING PROFILE OF SANITARY ASSUMED / UNKNOWN. TO BE CONFIRMED BY CONTRACTOR.
- EXISTING WATERMAIN PROFILE INTERPRETED FROM AVAILABLE RECORD DRAWINGS.
- CONTRACTOR TO PROVIDE ABOVE GROUND 1500 DR11 HDPE TEMPORARY BYPASS TO MAINTAIN CONTINUOUS WATER SERVICE.



0 5 1:500 25m

Revision/	Description/Description	Date/Date
5		
4	ADDENDA 1	17/10/06
3	TENDER ISSUE	17/08/21
2	ISSUED FOR 100% REVIEW	17/07/27
1	ISSUED FOR 99% REVIEW	17/07/14
0	ISSUED FOR 66% REVIEW	17/05/03

PUBLIC SERVICES AND PROCUREMENT CANADA


219 - 800 BARRARD STREET
VANCOUVER, BC, V6Z 0B9




FORT RODD HILL NHS EXISTING UTILITY REHABILITATION

Consultant Signature Only R. ROSIN
Designed by/Concept par S. CLARK
Drawn by/Dessiné par S. CLARK
PWSSC Project Manager/Administrateur de Projets TPSOC TOM DUNPHY
Regional Manager, Architectural and Engineering Services Gestionnaire régionale, Services d'architectural et de génie, TPSOC TOM DUNPHY
Drawing Title/Titre du dessin

PROPOSED WATER UPPER BATTERY 3+000 TO 3+150

Project No./No. du projet R.081111.001	Sheet/Feuille 5 OF 11	Revision no./La Révision no. 4
--	------------------------------------	--

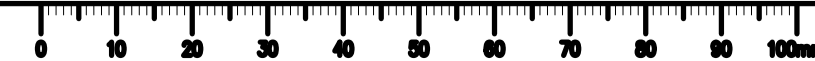

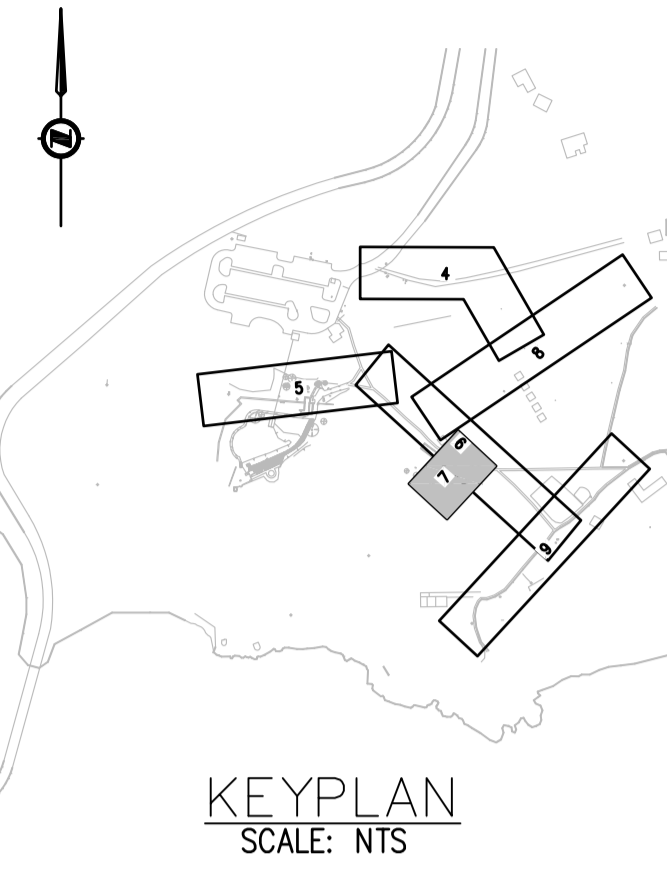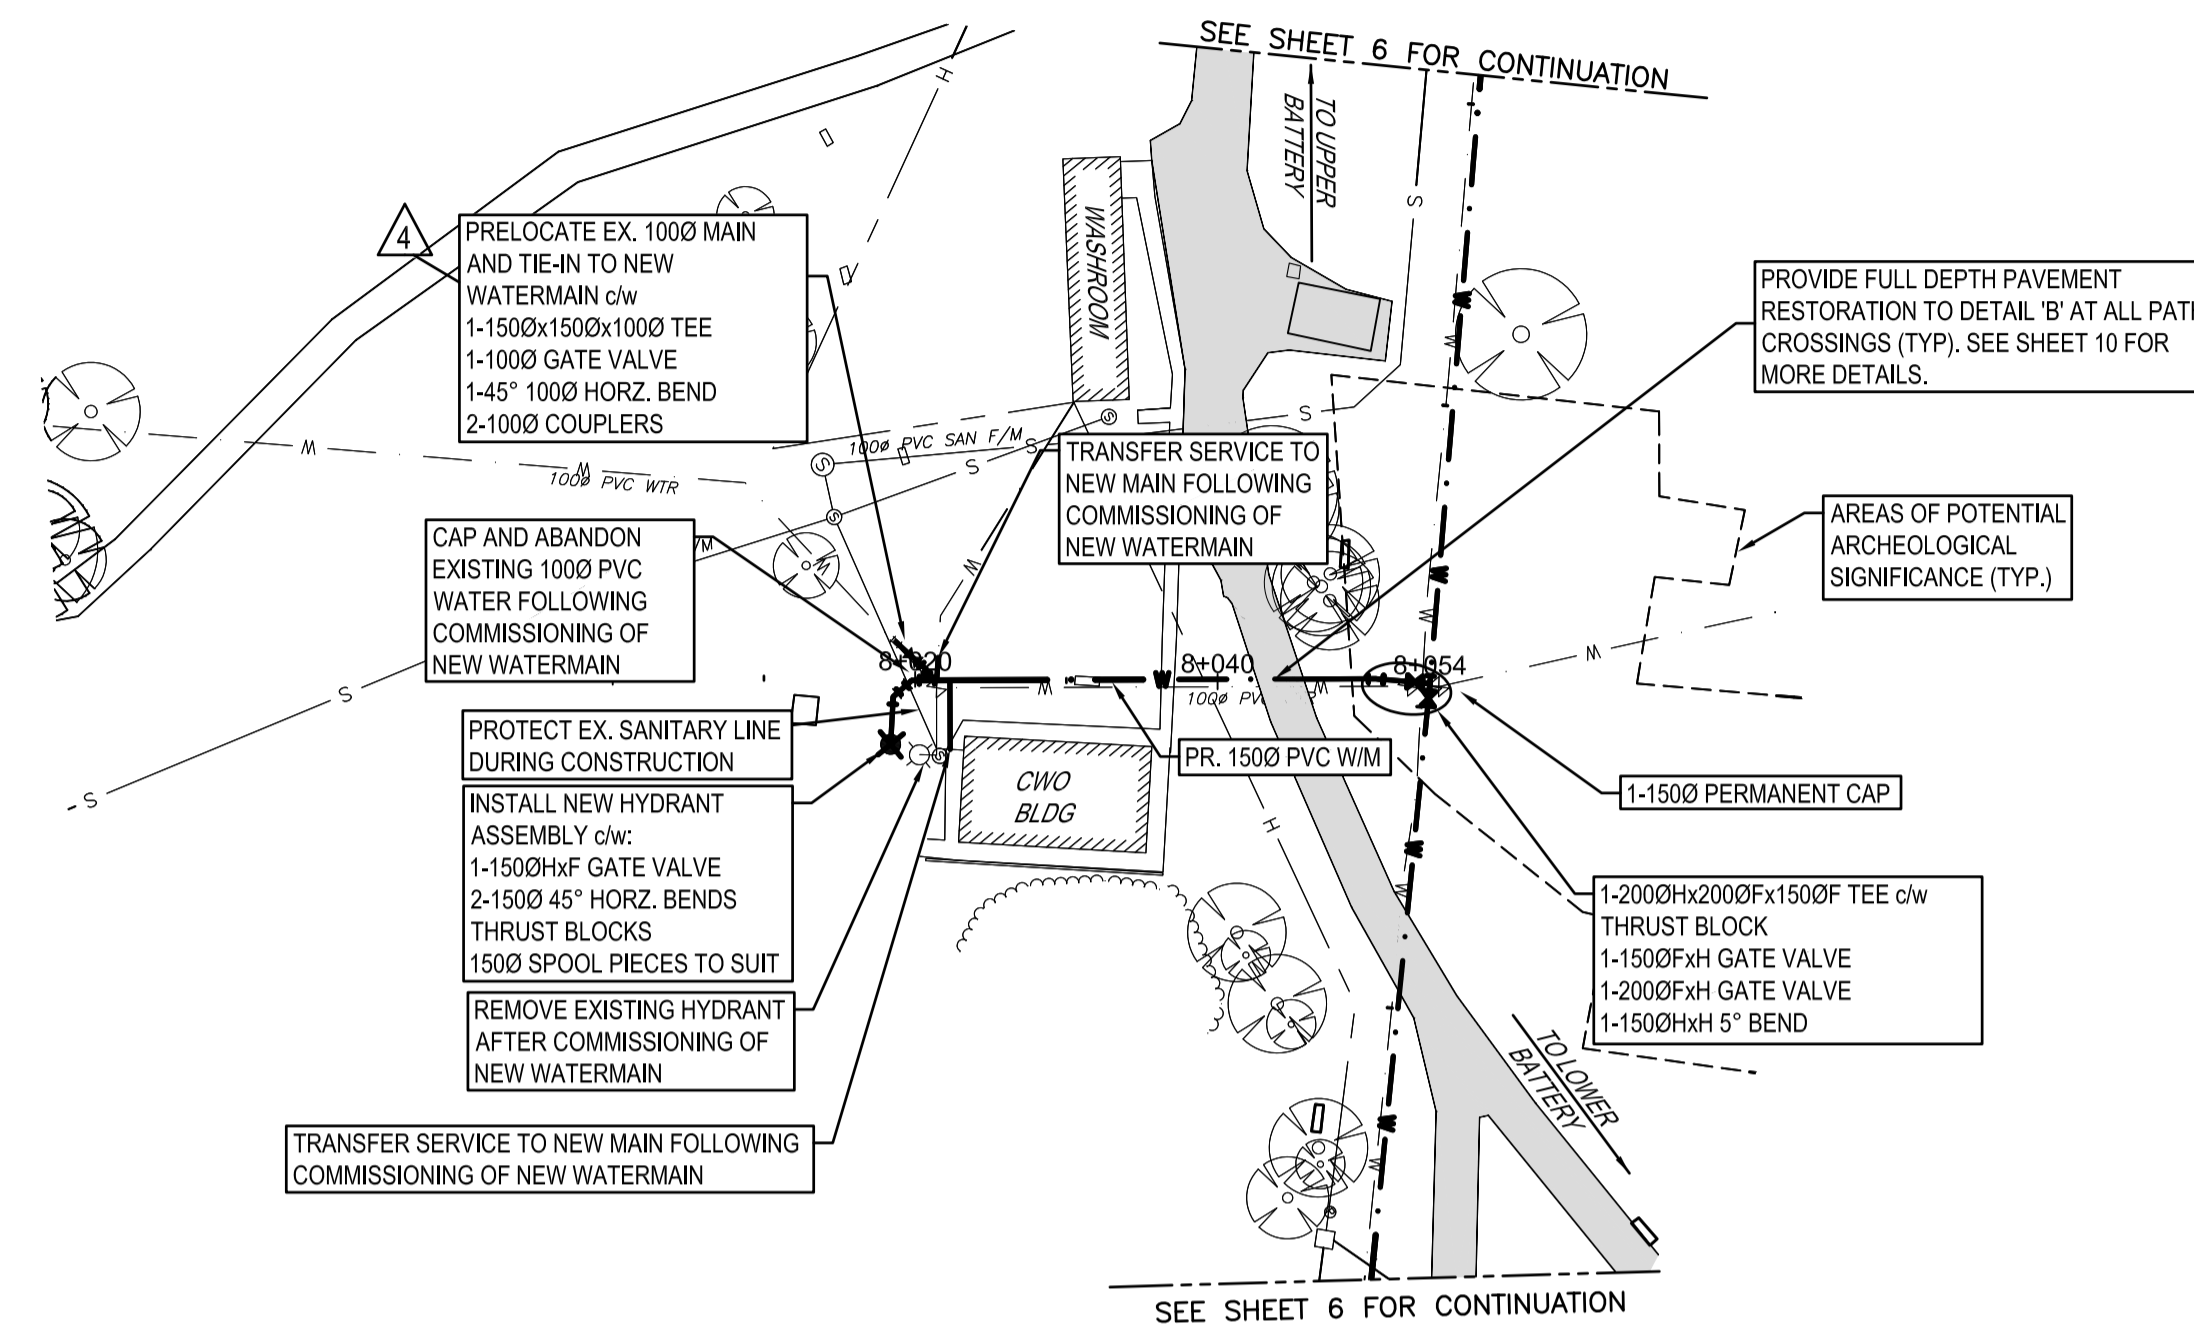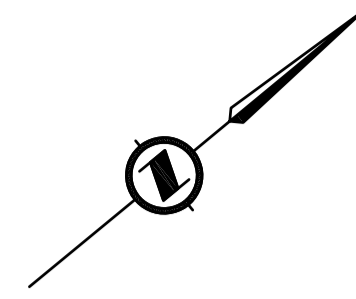

0 5 1:500 25m

5		
4	ADDENDA #1	17/10/06
3	TENDER ISSUE	17/08/21
2	ISSUED FOR 100% REVIEW	17/07/27
1	ISSUED FOR 99% REVIEW	17/07/14
0	ISSUED FOR 66% REVIEW	17/05/03
Revision/Revisions	Description/Description	Date/Date

Client/client

PUBLIC SERVICES AND PROCUREMENT CANADA

219 - 800 BARRARD STREET
 VANCOUVER, BC, V6Z 0B9

Project title/Titre du projet

FORT RODD HILL NHS EXISTING UTILITY REHABILITATION

Consultant Signature Only

R. ROSIN

Designed by/Concept par

S. CLARK

Drawn by/Dessiné par

S. CLARK

PWSSC Project Manager/Administrateur de Projets TPSOC

TOM DUNPHY

Regional Manager, Architectural and Engineering Services/Gestionnaire régionale, Services d'architectural et de génie, TPSOC

TOM DUNPHY

Drawing title/Titre du dessin


PROPOSED WATER BELMONT TRAIL 8+000 TO 8+060

Project No./No. du projet
R.081111.001

Sheet/Feuille
7

Revision no./La Révision no.
4

OF 11

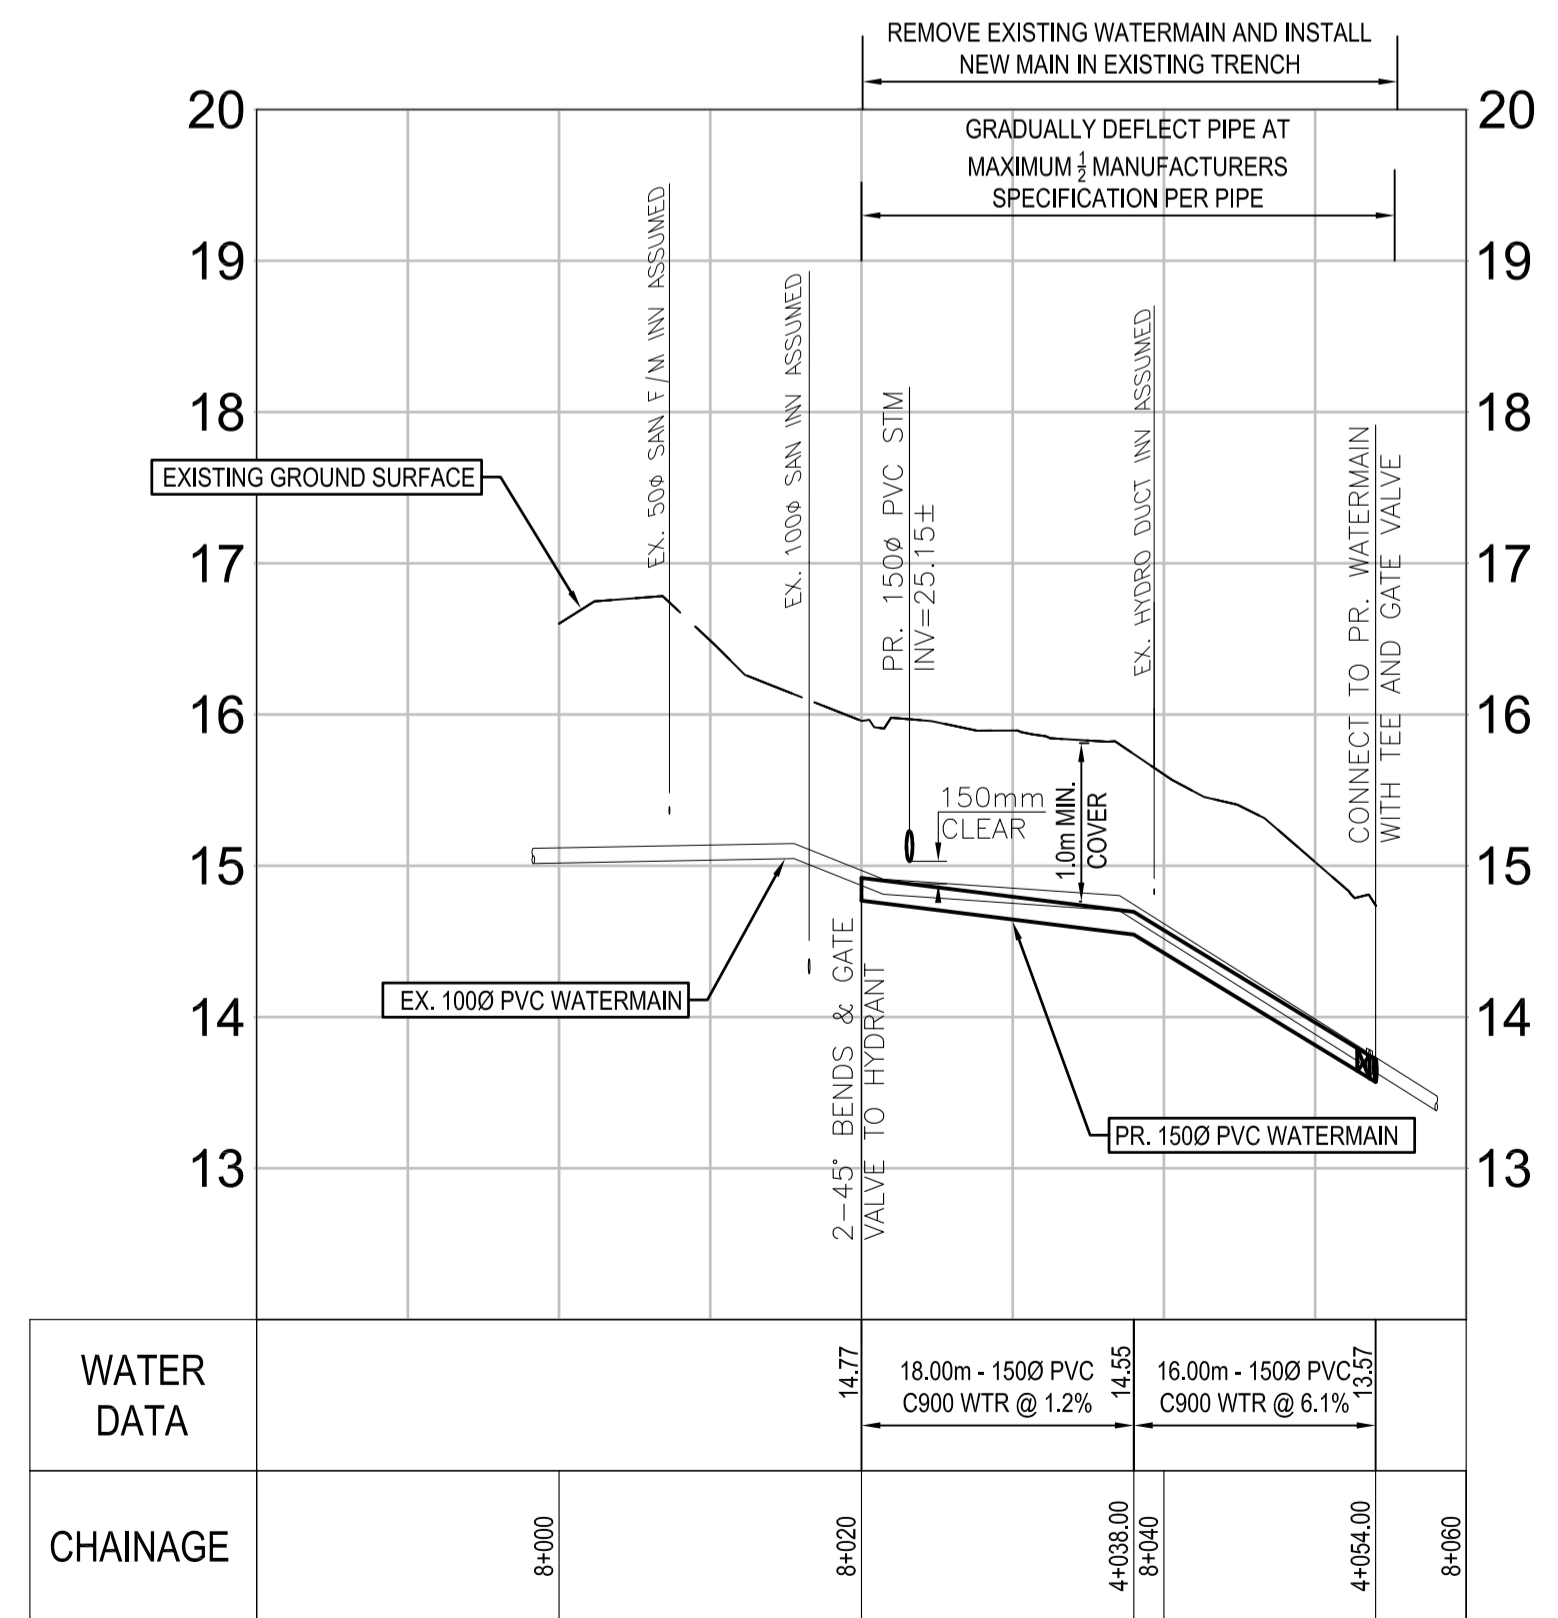

- NOTES**
- CONTRACTOR TO PRE-LOCATE ALL EXISTING UTILITIES AND ADVISE DEPARTMENTAL REPRESENTATIVE OF ANY CONFLICTS A MINIMUM OF 72 HOURS PRIOR TO CONSTRUCTION.
 - EXISTING PROFILE OF SANITARY ASSUMED / UNKNOWN. TO BE CONFIRMED BY CONTRACTOR.
 - EXISTING WATERMAIN PROFILE INTERPRETED FROM AVAILABLE RECORD DRAWINGS.
 - CONTRACTOR TO PROVIDE ABOVE GROUND 1500 DR11 HDPE TEMPORARY BYPASS TO MAINTAIN CONTINUOUS WATER SERVICE.

2017/04/04, 2:28pm, bamaes PR, WTR, H:\projects\1563 FT Road Hill & Ft Langley NHS\02_CADD\20_Drawing\20_Sheets\1163-FortRoddHill-Water-Storm.dwg

