



RETURN BIDS TO:

RETOURNER LES SOUMISSIONS À:

Public Works and Government Services Canada
ATB Place North Tower
10025 Jasper Ave./10025 ave. Jasper
5th floor/5e étage
Edmonton
Alberta
T5J 1S6
Bid Fax: (780) 497-3510

**SOLICITATION AMENDMENT
MODIFICATION DE L'INVITATION**

The referenced document is hereby revised; unless otherwise indicated, all other terms and conditions of the Solicitation remain the same.

Ce document est par la présente révisé; sauf indication contraire, les modalités de l'invitation demeurent les mêmes.

Comments - Commentaires

Vendor/Firm Name and Address
Raison sociale et adresse du
fournisseur/de l'entrepreneur

Issuing Office - Bureau de distribution
Public Works and Government Services Canada
ATB Place North Tower
10025 Jasper Ave./10025 ave Jasper
5th floor/5e étage
Edmonton
Alberta
T5J 1S6

Title - Sujet Mechanical Upgrades	
Solicitation No. - N° de l'invitation EW038-181191/A	Amendment No. - N° modif. 005
Client Reference No. - N° de référence du client CSC-EW038-181191	Date 2017-10-26
GETS Reference No. - N° de référence de SEAG PW-\$PWU-201-11191	
File No. - N° de dossier PWU-7-40117 (201)	CCC No./N° CCC - FMS No./N° VME
Solicitation Closes - L'invitation prend fin at - à 02:00 PM on - le 2017-10-31	Time Zone Fuseau horaire Mountain Daylight Saving Time MDT
F.O.B. - F.A.B. Plant-Usine: <input type="checkbox"/> Destination: <input type="checkbox"/> Other-Autre: <input type="checkbox"/>	
Address Enquiries to: - Adresser toutes questions à: Ho (RPC), Hector	Buyer Id - Id de l'acheteur pwu201
Telephone No. - N° de téléphone (780) 901-0989 ()	FAX No. - N° de FAX (780) 497-3510
Destination - of Goods, Services, and Construction: Destination - des biens, services et construction:	

Instructions: See Herein

Instructions: Voir aux présentes

Delivery Required - Livraison exigée	Delivery Offered - Livraison proposée
Vendor/Firm Name and Address Raison sociale et adresse du fournisseur/de l'entrepreneur	
Telephone No. - N° de téléphone Facsimile No. - N° de télécopieur	
Name and title of person authorized to sign on behalf of Vendor/Firm (type or print) Nom et titre de la personne autorisée à signer au nom du fournisseur/ de l'entrepreneur (taper ou écrire en caractères d'imprimerie)	
Signature	Date

Solicitation No. - N° de l'invitation
EW038-181191/A

Amd. No. - N° de la modif.
005

Buyer ID - Id de l'acheteur
pwu201

Client Ref. No. - N° de réf. du client
CSC EW038-181191

File No. - N° du dossier
PWU-7-40117 (201)

CCC No./N° CCC - FMS No./N° VME

This Amendment #005/Addendum #003 has been raised to make the following changes and to extend the closing date:

On Page 1 of 19, under section Solicitation Closes

DELETE:

2017-10-27

INSERT:

2017-10-31

The following changes to the tender documents are effective immediately and will form part of the contract documents:

1. GENERAL

1.1	This Addendum is issued prior to bid closing to incorporate revisions noted herein. Include in the Bid price all such revisions which will become part of the Work. Perform all such Work in accordance with the Contract Documents.
1.2	All affected drawings, schedules and panel changes shall be reflected in final as-built and manual submissions.

2. CLARIFICATIONS

	None
--	------

3. ANSWERS TO BIDDERS' QUESTIONS

	None
--	------

4. SPECIFICATIONS

	None
--	------

5. Drawings

5.1	Revision: M61 – SECTIONS 2 1. Add Section as shown in attachment “ADD3-MSK01”
-----	--

Solicitation No. - N° de l'invitation
EW038-181191/A

Amd. No. - N° de la modif.
005

Buyer ID - Id de l'acheteur
pwu201

Client Ref. No. - N° de réf. du client
CSC EW038-181191

File No. - N° du dossier
PWU-7-40117 (201)

CCC No./N° CCC - FMS No./N° VME



5.2

Revision:

M67 – SCHEDULES 2, DIFFUSER & GRILLE SCHEDULE

1. Add "TAG: S-3A,
TYPE: SUPPLY
SIZE: ON DWG
OPTIONS/NOTES: FULLY ADJUSTABLE DOUBLE DEFLECTION
LOUVERED SUPPLY FACE GRILLE WITH 150mm DUCT
MOUNTED FRAME, STEEL CONSTRUCTION, WHITE POWDER
COATED."

End of Amendment

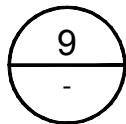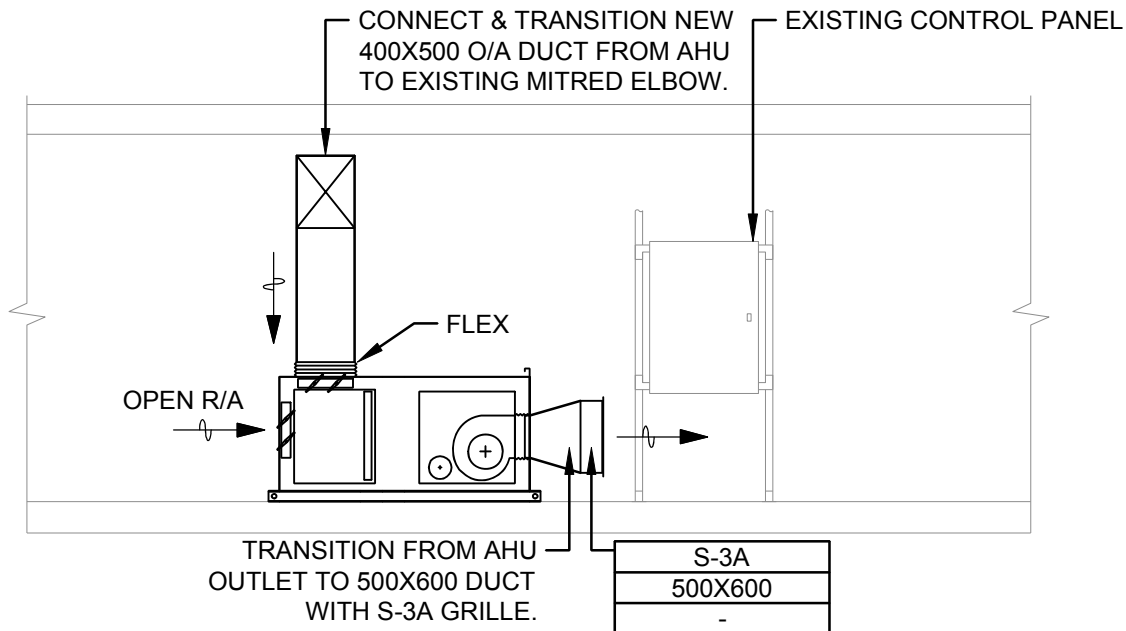

SECTION

AHU-6/9/12/15

DO NOT SCALE DRAWINGS

Project title/Titre du projet

**EDMONTON MAXIMUM
SECURITY INSTITUTION**

Drawing title/Titre du dessin

AIR HANDLER SECTION

Approved by/Approuvé par

JM

PWGSC Project Manager/Administrateur
de Projets TPSGC ANDREW GILLESE

Scale/Echelle

1:50

Designed by/Concept par

JC

PWGSC, Architectural and Engineering Resources Manager/
Ressources Architectural et de Directeur d'ingénierie, TPSGC

Date/Date

2017.10.26

Drawn by/Dessiné par

JC

Project No./No. du
projet R.078013.001

Sheet/Feuille

ADD3-MSK01

Revision/
Révision

