
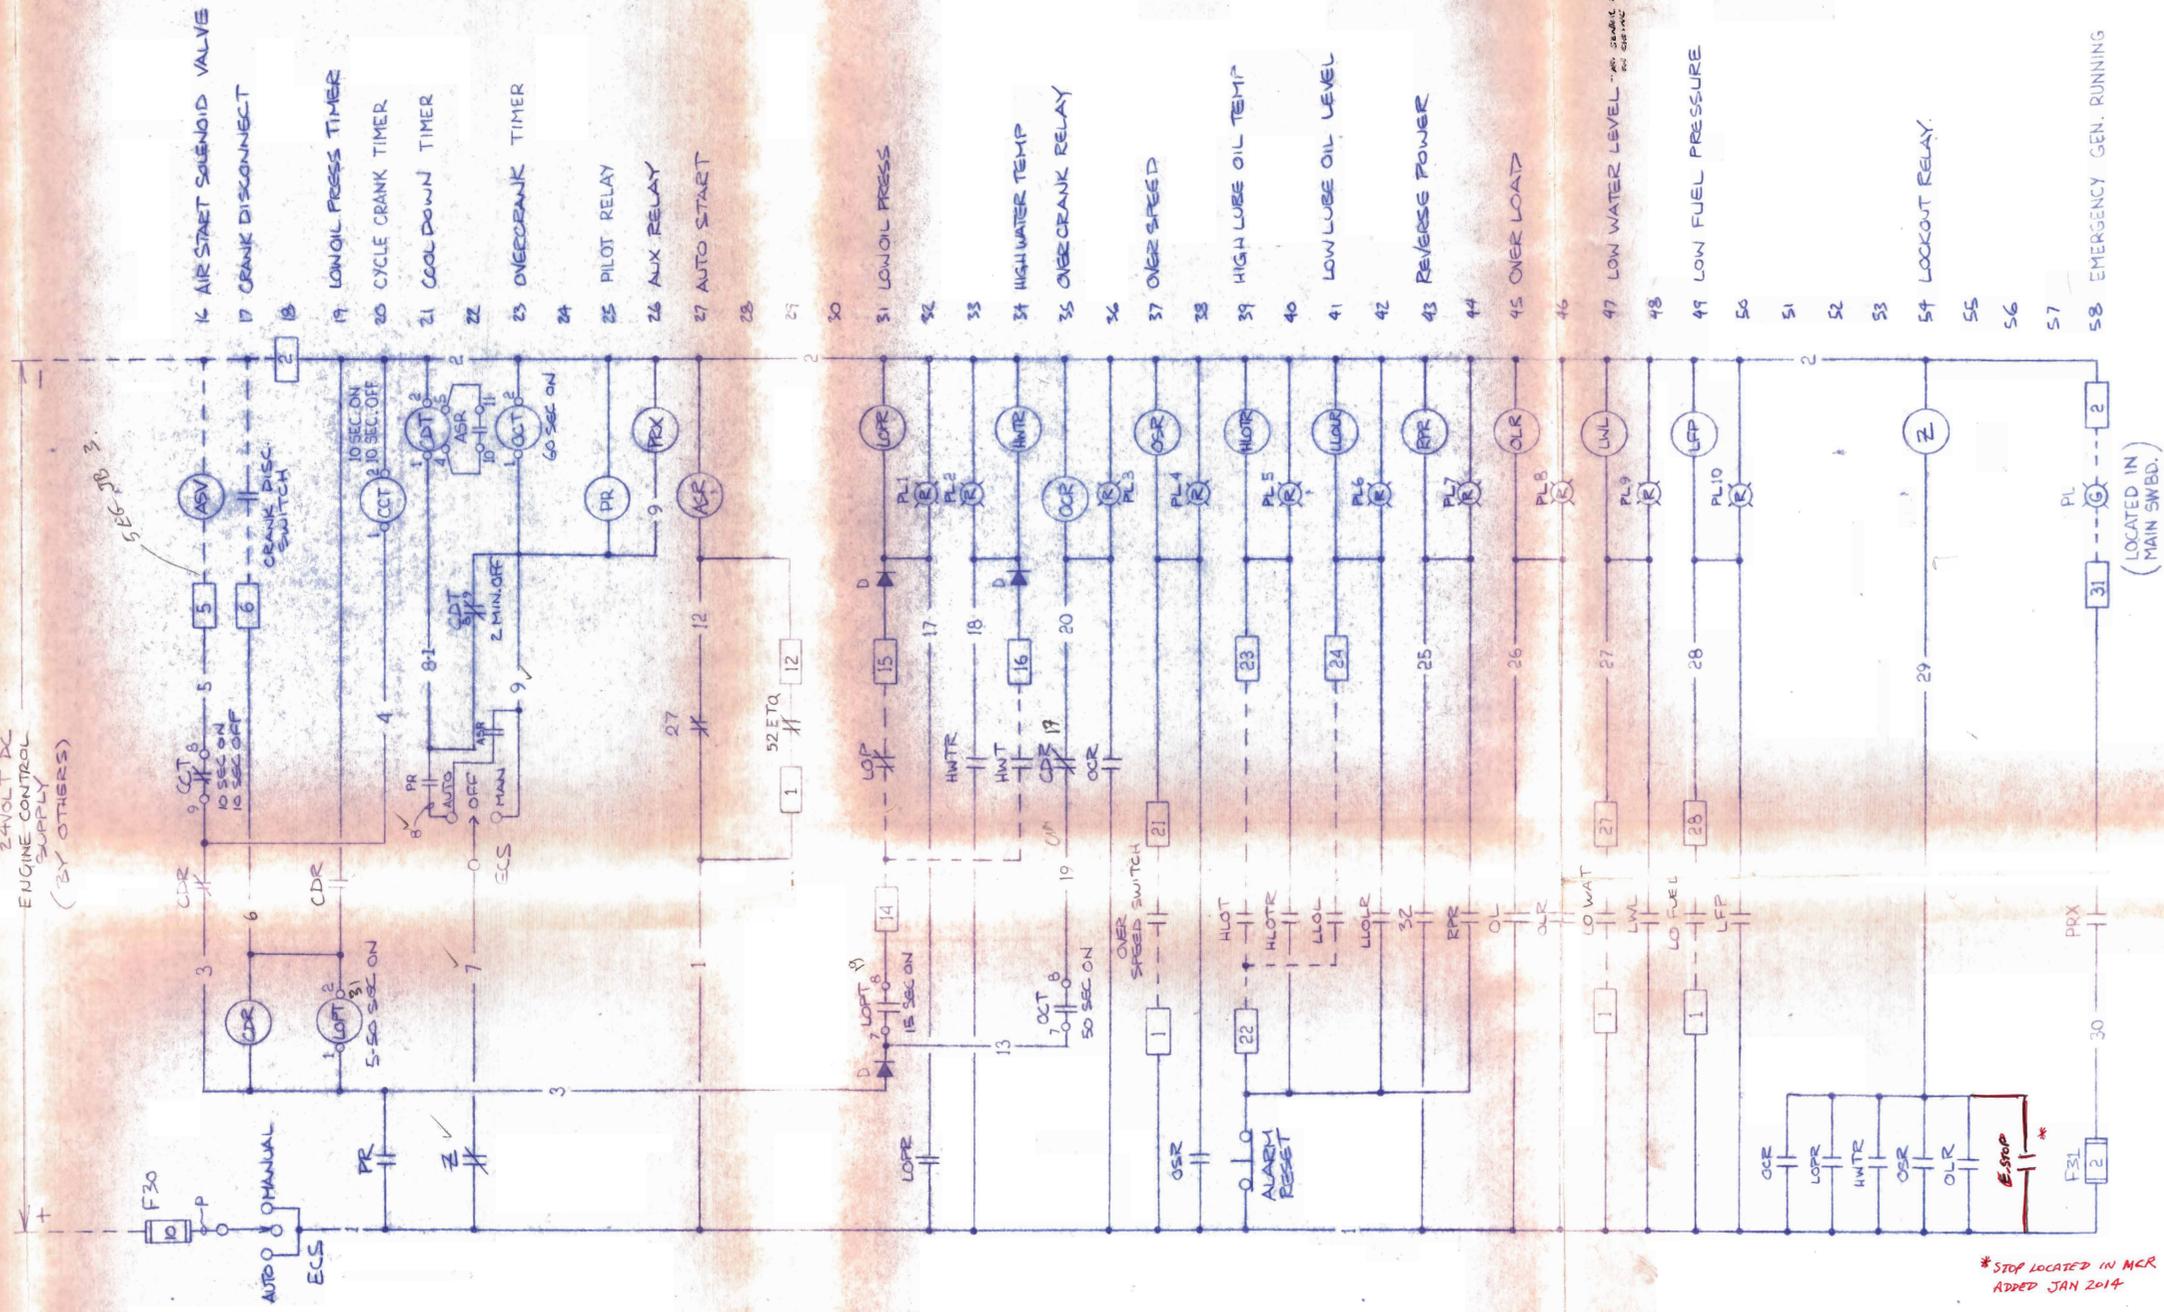



24VOLT DC
ENGINE CONTROL
SUPPLY
(BY OTHERS)

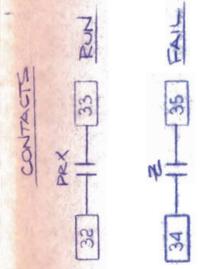

TIMER SWITCHES

TIMER	1	2	3	4	5
LOPT	B	B	B	A	A
CCT	B	A	B	A	B
CDT	B	B	B	B	A
OCT	B	B	B	B	A

*STOP LOCATED IN MCR
ADDED JAN 2014

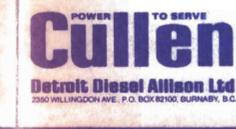

REV.	DESCRIPTION	DATE	APP'D
4	SHOW POLARITY	04/7/90	JL
3	AS BUILT	13/2/90	
2	MOVE 27 TO E-BUS	25/9/89	JL
1	ADDED EM. GEN. LIGHT	31/8/89	JL

TITLE EMERGENCY GENERATOR ENGINE CONTROL SCHEMATIC MARKUP	
SCALE NTS DATE 89-05-17	USED ON "E00" SAR CUTTER
DR'N BY JFG	DWG. No. 148667-31D
APP'R'D BY	REV. 4