



RETURN BIDS TO:

RETOURNER LES SOUMISSIONS À:

Bid Receiving Public Works and Government
Services Canada/Réception des soumissions Travaux
publics et Services gouvernementaux Canada
800 Burrard Street, Room 219
800, rue Burrard, pièce 219
Vancouver
British Columbia
V6Z 0B9
Bid Fax: (604) 775-9381

**SOLICITATION AMENDMENT
MODIFICATION DE L'INVITATION**

The referenced document is hereby revised; unless otherwise
indicated, all other terms and conditions of the Solicitation
remain the same.

Ce document est par la présente révisé; sauf indication contraire,
les modalités de l'invitation demeurent les mêmes.

Comments - Commentaires

**Vendor/Firm Name and Address
Raison sociale et adresse du
fournisseur/de l'entrepreneur**

Issuing Office - Bureau de distribution
Public Works and Government Services Canada - Pacific
Region
800 Burrard Street, Room 219
800, rue Burrard, pièce 219
Vancouver
British C
V6Z 0B9

Title - Sujet Sand Shed Recladding	
Solicitation No. - N° de l'invitation EZ899-181525/A	Amendment No. - N° modif. 002
Client Reference No. - N° de référence du client	Date 2017-11-15
GETS Reference No. - N° de référence de SEAG PW-\$PWY-036-8204	
File No. - N° de dossier PWY-7-40238 (036)	CCC No./N° CCC - FMS No./N° VME
Solicitation Closes - L'invitation prend fin at - à 02:00 PM on - le 2017-11-21	
F.O.B. - F.A.B. Plant-Usine: <input type="checkbox"/> Destination: <input checked="" type="checkbox"/> Other-Autre: <input type="checkbox"/>	
Address Enquiries to: - Adresser toutes questions à: Martin (PWY), Delia	Buyer Id - Id de l'acheteur pwy036
Telephone No. - N° de téléphone (778) 707-2139 ()	FAX No. - N° de FAX (604) 775-6633
Destination - of Goods, Services, and Construction: Destination - des biens, services et construction: PWGSC - Port Hardy Airport - Port Hardy, BC	

Instructions: See Herein

Instructions: Voir aux présentes

Delivery Required - Livraison exigée	Delivery Offered - Livraison proposée
Vendor/Firm Name and Address Raison sociale et adresse du fournisseur/de l'entrepreneur	
Telephone No. - N° de téléphone Facsimile No. - N° de télécopieur	
Name and title of person authorized to sign on behalf of Vendor/Firm (type or print) Nom et titre de la personne autorisée à signer au nom du fournisseur/ de l'entrepreneur (taper ou écrire en caractères d'imprimerie)	
Signature	Date

Solicitation. - N° de l'off. à comm.
EZ899-181525/A

Amd. No. - N° de la modif.
002

Buyer ID - Id de l'acheteur
pwy036

Client Ref. No. - N° de réf. du client

File No. - N° du dossier
PWY-7-40238

CCC No./N° CCC - FMS No/ N° VME

This Amendment #002 is raised to issue Addendum #01.

Please see Addendum #01 herein.

The addendum will form part of the contract documents.

All other terms and conditions remain unchanged.

The following changes in the tender documents are effective immediately. This addendum will form part of the contract documents

This Addendum forms part of the Bid Documents and modifies as stated herein:

1.0 SPECIFICATIONS

1.1 Section 08 11 00 Insulated Steel Doors and Frames, insert the following:

1.1.1 Article 2.1 MATERIALS

.10 Glazing: safety glass, fire rated to match door.

1.1.2 Article 2.2 DOOR TYPE

.2 Door size to be 36" x 80", complete with 22" x 30" tempered lite 43" above sill height. Right hand reverse.

1.2 Section 01 11 55 General Instructions, insert the following:

1.2.1 Article 1.2 DESCRIPTION OF WORK

.8 Provision of separate dedicated circuits for new overhead doors at existing panel.

2.0 DRAWINGS

2.1 Replace Drawing R-1.3 dated September 8, 2017 – ISSUED FOR BID with the attached Drawing R-1.3 dated November 9, 2017 – ISSUED FOR ADDENDUM #1.

2.2 Replace Drawing R-2.1 dated September 8, 2017 – ISSUED FOR BID with the attached Drawing R-2.1 dated November 9, 2017 – ISSUED FOR ADDENDUM #1.

2.3 Replace Drawing R-3.1 dated September 8, 2017 – ISSUED FOR BID with the attached Drawing R-3.1 dated November 9, 2017 – ISSUED FOR ADDENDUM #1.

2.4 Replace Drawing R-3.2 dated September 8, 2017 – ISSUED FOR BID with the attached Drawing R-3.2 dated November 9, 2017 – ISSUED FOR ADDENDUM #1.

2.5 Replace Drawing R-5.1 dated September 8, 2017 – ISSUED FOR BID with the attached Drawing R-5.1 dated November 9, 2017 – ISSUED FOR ADDENDUM #1.

2.6 Replace Drawing R-5.2 dated September 8, 2017 – ISSUED FOR BID with the attached Drawing R-5.2 dated November 9, 2017 – ISSUED FOR ADDENDUM #1.

2.7 Replace Drawing R-5.3 dated September 8, 2017 – ISSUED FOR BID with the attached Drawing R-5.3 dated November 9, 2017 – ISSUED FOR ADDENDUM #1.

3.0 CLARIFICATIONS

- 3.1 Contractor is to provide Hazardous Materials Abatement as required by WorksafeBC regulations. Hazmat report is provided to meet Owner's obligation of providing an inventory of existing hazardous materials.

4.0 TENDER QUESTIONS

- 4.1 *"Regarding the Port Hardy - Sand Shed Recladding - Solicitation No. EZ899-181525/A project closing on November 15th, I am enquiring if the Abatement of hazardous materials as listed in Appendix Attachment B: Northwest Environmental Hazardous Material Report is part of this contract or by others; please confirm."*

"Hazmat: There is a report but nothing in Division 2 of the specification. When I circulated the tender documents to our Hazmat contractor the below was his response:

Only asbestos identified is mastic debris on the ground outside the shed... from what I don't know. I don't see anything in the specs in regards to cleaning this material up... let me know if you need a price for this all paint samples provided are below lead threshold"

- 4.1.1 Abatement of hazardous materials impacted by the Work is part of the contract. Abatement activities are to be in accordance WorksafeBC regulations.

- 4.2 *"There is no information on the existing electrical power. Power will be needed for the door operators. Any information on the available power? "*

- 4.2.1 Power is available. Section 01 11 55 General Instructions, insert the following:

Article 1.2 DESCRIPTION OF WORK

- .8 Provision of separate dedicated circuits for new overhead doors at existing panel.

- 4.3 *"Nowhere can I find size of the door height or headroom available. Also I see job is calling for polycarbonate full view doors. This is a traditional overhead door not a rolling steel." There is a mezzanine but no information on the build- up of the existing."*

- 4.3.1 Overhead door sizes to suit existing rough openings. Doors to be polycarbonate overhead doors.

- 4.4 *"Concrete repairs/ splices: Detail information on how this work is to be done/ tie -into exiting??"*

- 4.4.1 Reference Detail 2 on the attached Drawing R-5.1 dated November 9, 2017 – ISSUED FOR ADDENDUM #1.

- 4.5** *“Drawing R-1.3, identifies a 4.8 high security fencing. This does not match into field information. Is this new?”*
- 4.5.1** Provide a new temporary security fence. Reference Site Plan on the attached Drawing R-1.3 dated November 9, 2017 – ISSUED FOR ADDENDUM #1.
- 4.6** *“Drawing R-2.1, shows a drain but there is no detail on the works? Depth? Existing drain? Asphalt or concrete surface cover?”*
- 4.6.1** There is an existing drain. Reference Existing Floor Plan on the attached Drawing R-2.1 dated November 9, 2017 – ISSUED FOR ADDENDUM #1.
- 4.7** *“Drawing R-2.1, shows steel bollards. Any information on depth of bury? Type of bury? Surface treatment?”*
- 4.7.1** Reference Existing Floor Plan on the attached Drawing R-2.1 dated November 9, 2017 – ISSUED FOR ADDENDUM #1.
- 4.8** *“Drawing R-3.2/ 3.1, shows no light fixtures. Existing light fixtures are they to be re- installed or?”*
- 4.8.1** All existing exterior wall fixtures, lights, appurtenances, etc. to be removed and reinstated. Reference East Elevation on the attached Drawing R-3.1 dated November 9, 2017 – ISSUED FOR ADDENDUM #1 and South Elevation on the attached Drawing R-3.2 dated November 9, 2017 – ISSUED FOR ADDENDUM #1.

End of Addendum 1

Project No. 1786-00-0001
 Drawing Title: EXISTING FLOOR PLAN
 Drawing Date: 03/13/2017
 Drawing By: [Signature]
 Drawing Check: [Signature]

PUBLIC WORKS AND GOVERNMENT SERVICES CANADA
PORT HARDY AIRPORT
 3875 BRYAN ROAD, PORT HARDY, BC

RJC PROJECT NO. MAA11381.0005
 Consultant: [Signature]
 Date: 03/13/2017
 Project Manager: [Signature]


No.	Revision	Date	By
1	ISSUED FOR ARCHITECTURAL REVIEW	2017.03.13	TB
2	ISSUED FOR 80% REVIEW	2017.03.13	TB
3	ISSUED FOR 90% REVIEW	2017.03.13	TB
4	ISSUED FOR BID	2017.03.13	BR
5	ISSUED FOR ADDENDUM #1	2017.03.13	MC

CREATIVE THINKING PRACTICAL RESULTS
 REAL ESTATE SERVICES
 SERVICES IMMOBILIERS
 Real Estate Services
 Real Estate Services

Project No. 1786-00-0001
 Drawing Title: EXISTING FLOOR PLAN
 Drawing Date: 03/13/2017
 Drawing By: [Signature]
 Drawing Check: [Signature]

PUBLIC WORKS AND GOVERNMENT SERVICES CANADA
PORT HARDY AIRPORT
 3875 BRYAN ROAD, PORT HARDY, BC

RJC PROJECT NO. MAA11381.0005
 Consultant: [Signature]
 Date: 03/13/2017
 Project Manager: [Signature]

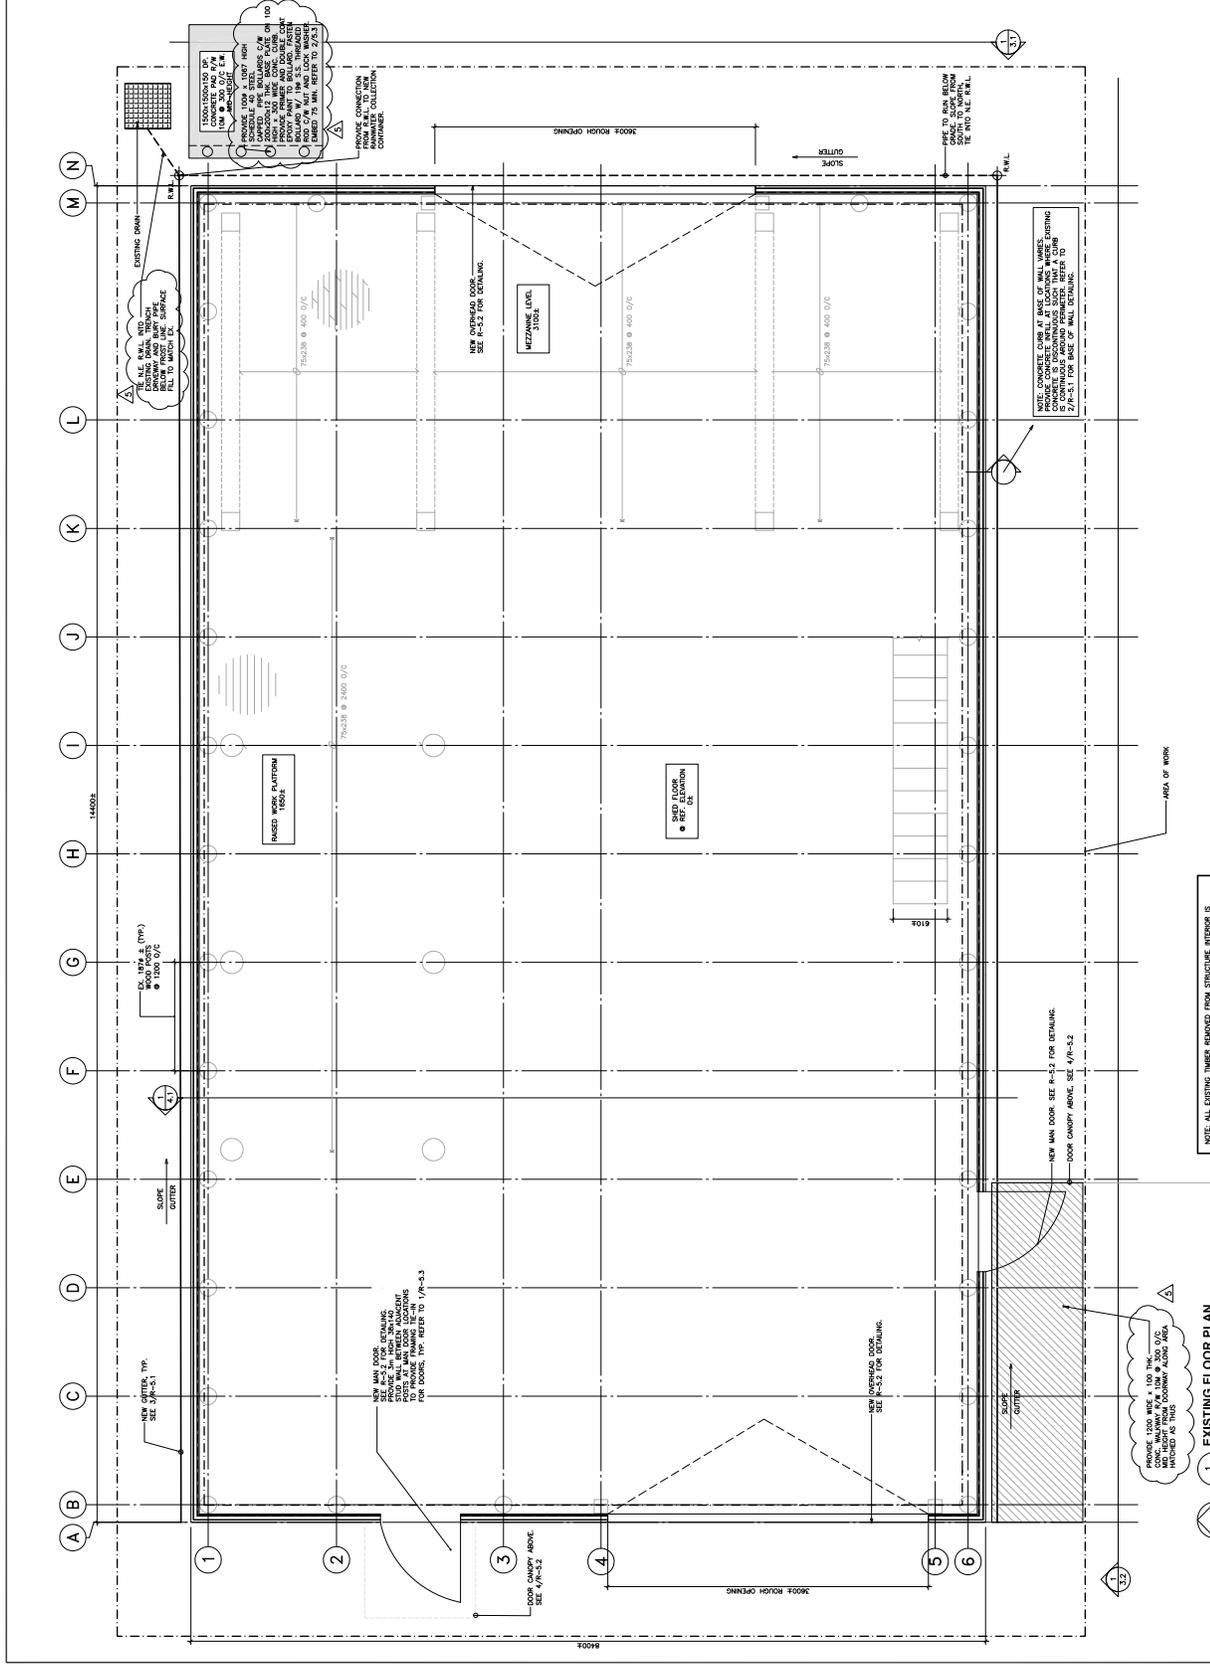

EXISTING FLOOR PLAN
 1. EXISTING FLOOR PLAN
 2.1 F-25

NOTE: ALL EXISTING DIMENSIONS SHOWN FROM STRUCTURE CENTERLINE UNLESS NOTED OTHERWISE. DIMENSIONS TO BE DETERMINED ON SITE AT LOCATION TO BE DETERMINED BY THE OWNER.

Client: PUBLIC WORKS AND GOVERNMENT SERVICES CANADA
Project: PORT HARDY AIRPORT
Location: 3825 BYNG ROAD, PORT HARDY, BC
Project No.: MAL11181.0005
Sheet / Feuille: R-3.1
Scale: 1" = 20'
Date: 2017

Revisions

No.	Revision	Date	By
1	ISSUED FOR ARCH. REVIEW	2015.09.10	TB
2	ISSUED FOR 60% REVIEW	2015.10.15	TB
3	ISSUED FOR 80% REVIEW	2016.01.20	JK
4	ISSUED FOR BID	2017.08.01	BR
5	ISSUED FOR ADDENDUM #1	2017.11.09	MC


Client/Client: PUBLIC WORKS AND GOVERNMENT SERVICES CANADA
Project/Projet: PORT HARDY AIRPORT
Location/Lieu: 3825 BYNG ROAD, PORT HARDY, BC
Project No./No. du projet: MAL11181.0005
Sheet / Feuille: R-3.1
Scale/Echelle: 1" = 20'
Date: 2017

Project/Projet: PORT HARDY AIRPORT
Location/Lieu: 3825 BYNG ROAD, PORT HARDY, BC
Project No./No. du projet: MAL11181.0005
Sheet / Feuille: R-3.1
Scale/Echelle: 1" = 20'
Date: 2017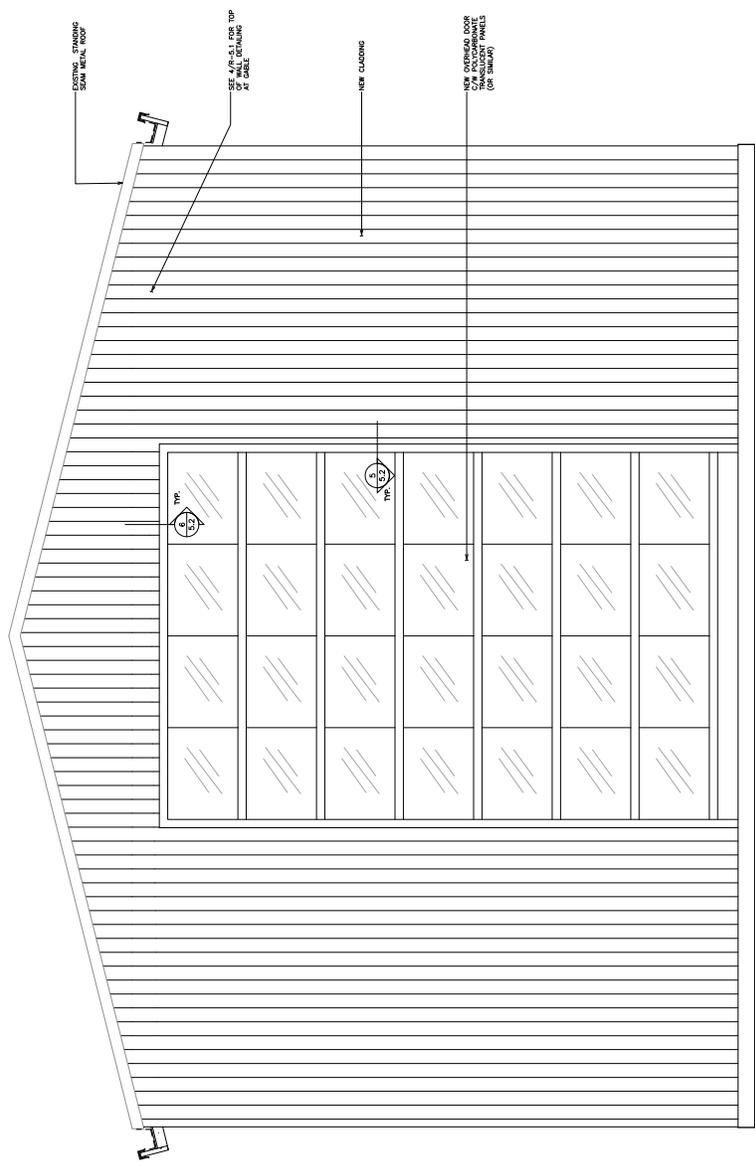

NOTE:
 ALL DIMENSIONS TO FACE UNLESS OTHERWISE SPECIFIED. THIS DRAWING IS NOT TO BE USED FOR CONSTRUCTION.

1 EAST ELEVATION
 1" = 20'

Drawing Notes

- All dimensions shall be in metric units, unless otherwise specified. All dimensions shall be in millimeters unless otherwise specified. All dimensions shall be in millimeters unless otherwise specified. All dimensions shall be in millimeters unless otherwise specified.
- These drawings are "best practice" only. They may not be suitable for other projects. The contractor shall verify all dimensions and materials before construction. The contractor shall verify all dimensions and materials before construction.
- Use of these drawings by parties not identified in the title block is prohibited. The contractor shall verify all dimensions and materials before construction. The contractor shall verify all dimensions and materials before construction.

No.	Revision	Date	By
1	ISSUED FOR ARCHITECT REVIEW	2017.09.20	TB
2	ISSUED FOR 60% REVIEW	2017.10.10	TB
3	ISSUED FOR 80% REVIEW	2017.10.20	JK
4	ISSUED FOR BID	2017.11.01	BR
5	ISSUED FOR ADDENDUM #1	2017.11.01	MC


PUBLIC WORKS AND GOVERNMENT SERVICES CANADA

CLADDING REPLACEMENT
 PORT HARDY AIRPORT
 3625 BYNG ROAD, PORT HARDY, BC

RJC PROJECT NO. MAH111361.0005
 Consultant Signature: [Signature]
 Date: 8. 2017
 Drawn by: [Name]
 Checked by: [Name]

Drawing Title: SOUTH ELEVATION

Project No.: R-077018.0001
 Sheet / Total: R-3.2 / 5

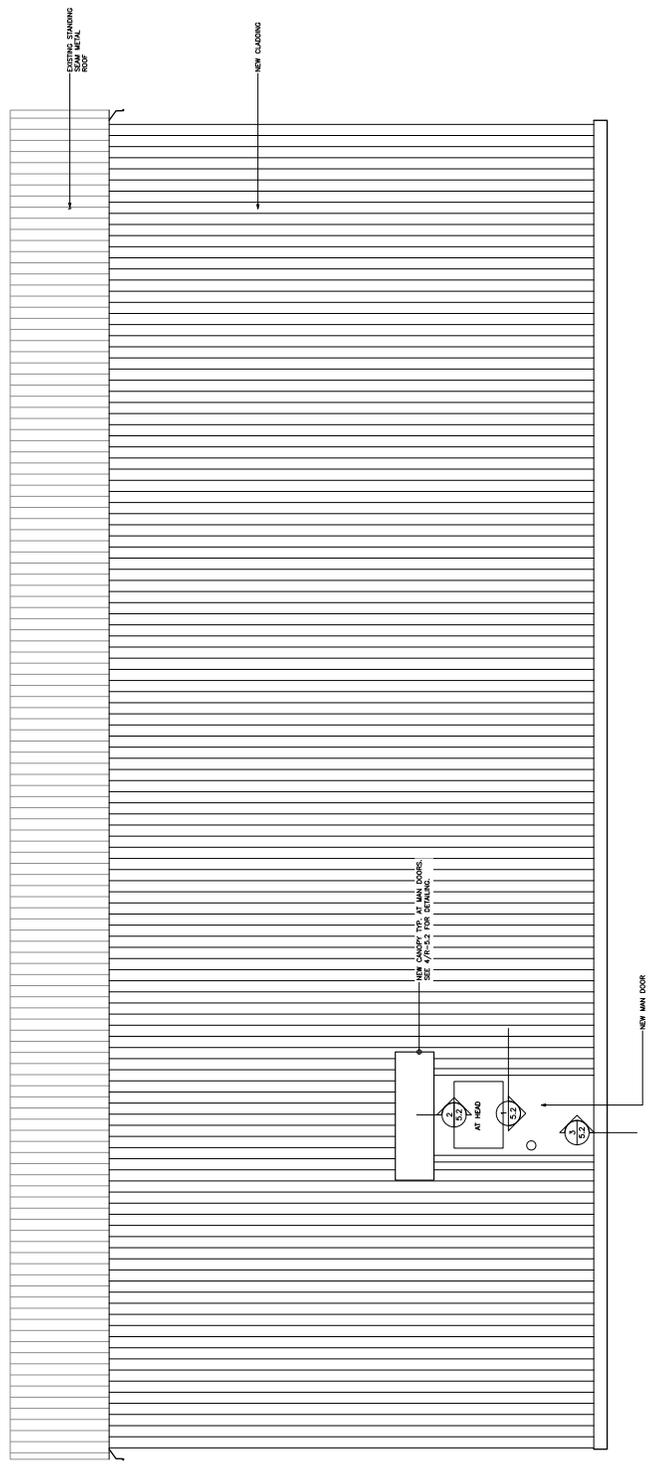

NEW CANOPY TO BE AT MAIN DOORS.
 SEE 3.2 FOR DETAILS.

SOUTH ELEVATION
 1:25

NEW MAIN DOOR




Drawing Title: SOUTH ELEVATION
 Project No.: R-077018.0001
 Sheet / Total: R-3.2 / 5

No.	Revision	Date	By
1	ISSUED FOR ARCHITECT REVIEW	2010.09.10	TB
2	ISSUED FOR 60% REVIEW	2010.10.30	TB
3	ISSUED FOR 80% REVIEW	2010.10.30	JK
4	ISSUED FOR BID	2011.09.08	BR
5	ISSUED FOR ADDENDUM #1	2011.11.09	MC


Drawing Notes:

1. Refer to the door, window, and glazing schedule for door and window details. All door and window openings are to be finished with the same material as the existing structure. The door and window frames are to be finished with the same material as the existing structure. The door and window frames are to be finished with the same material as the existing structure.
2. These drawings are "As-Built" drawings. They may not be suitable for construction. The contractor is to verify the dimensions and details of the existing structure before construction. The contractor is to verify the dimensions and details of the existing structure before construction.
3. Use of these drawings is limited to the project in the location shown. The contractor is to verify the dimensions and details of the existing structure before construction. The contractor is to verify the dimensions and details of the existing structure before construction.

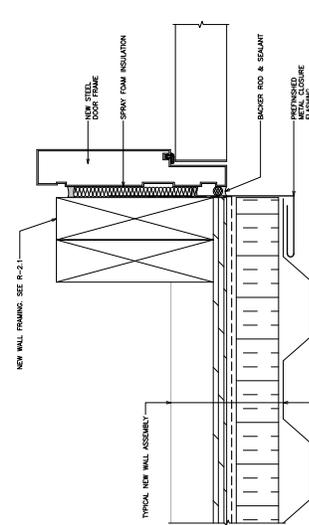


1 MAN DOOR JAMB

 5.2 / 1:2

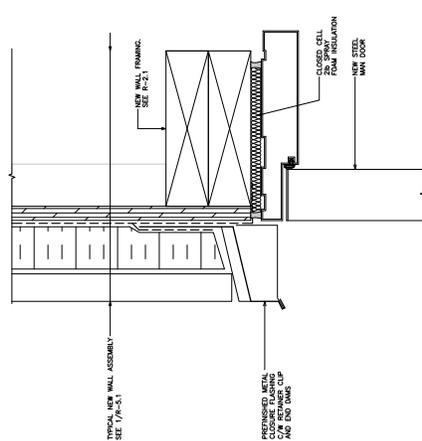


2 MAN DOOR HEAD

 5.2 / 1:2

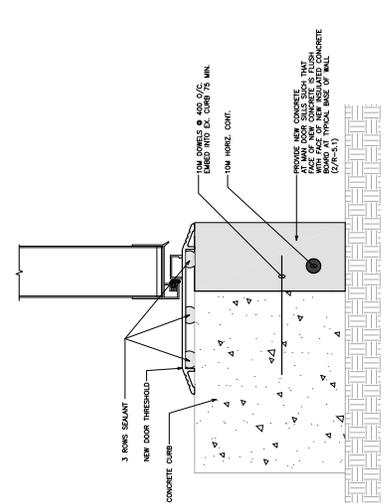


3 MAN DOOR SILL

 5.2 / 1:2

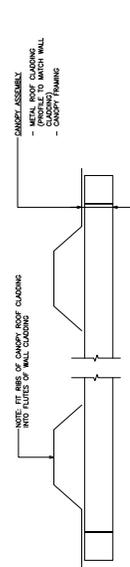


4 NEW DOOR CANOPY

 5.2 / 1:10

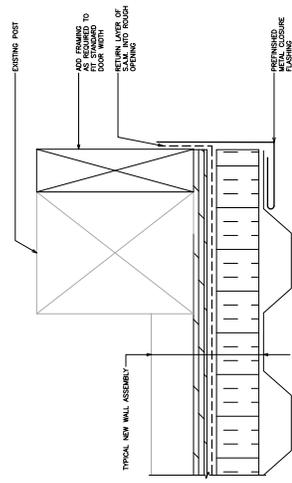

5 OVERHEAD DOOR JAMB

 5.2 / 1:2

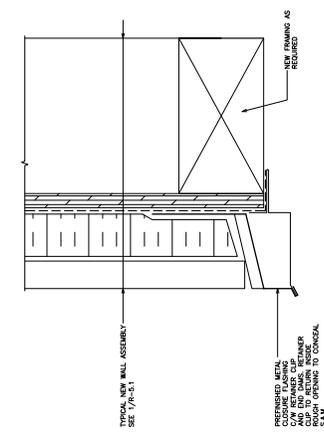

6 OVERHEAD DOOR HEAD

 5.2 / 1:2

