



0 1 2 3 4 5 6 7 8 9 10 11 12 13 14 15 16 17 18 19 20 21 22 23 24 INCHES

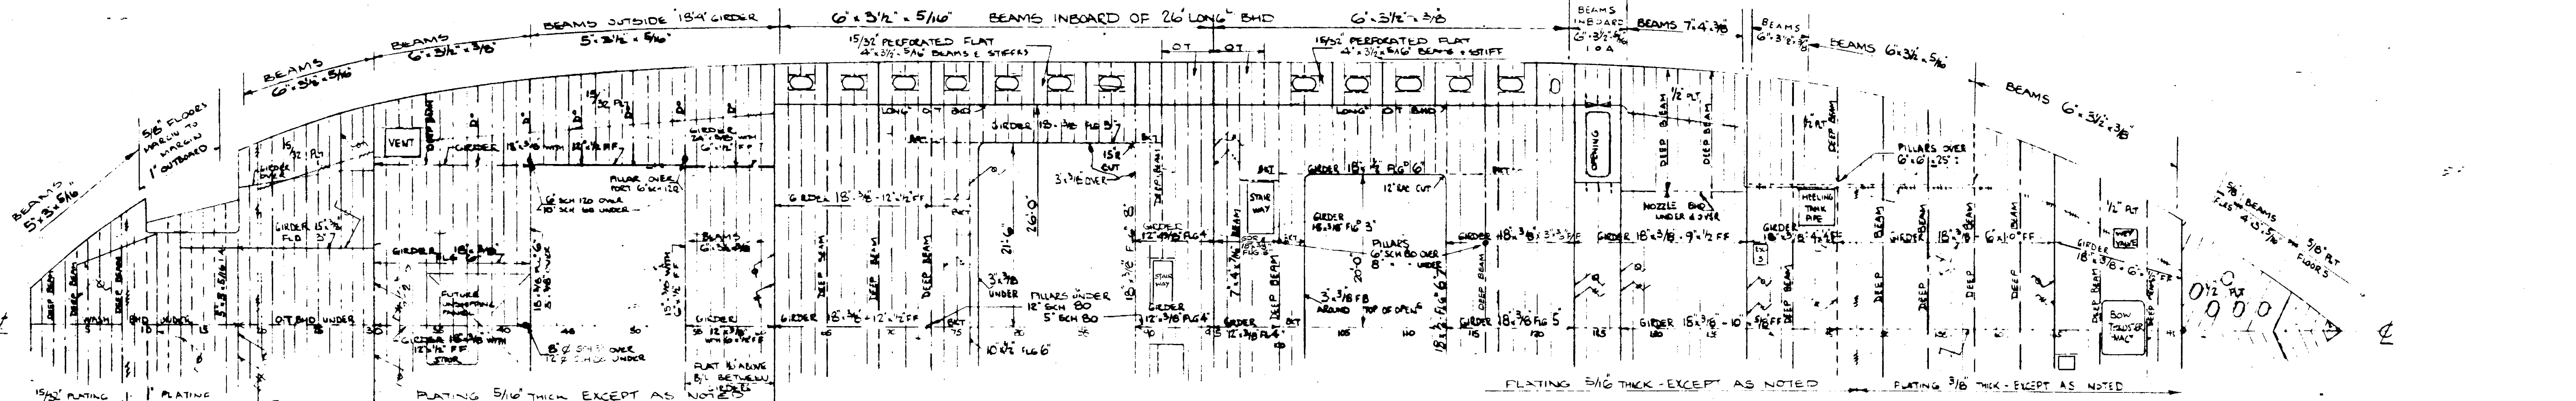

17'-0" FLAT

~~✓~~ DENOTES STEEL BHD OVER.
~~✓~~ DENOTES STEEL BHD UNDER.
 OVERFLOW OF TANKS 3'-0"
 ABOVE UPPER DECK EXCEPT
 HELICOPTER FUEL TANK.

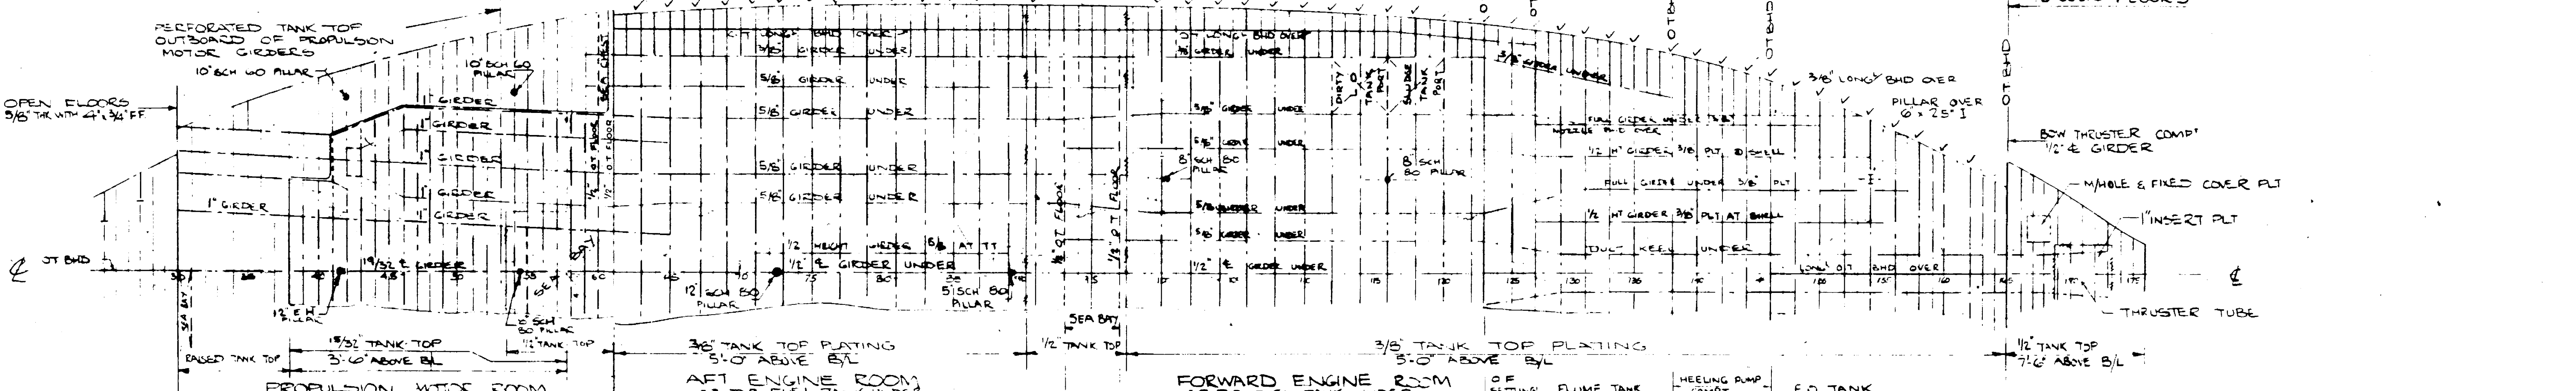

Hand-drawn schematic of a fuel tank assembly. The diagram shows a central rectangular tank with various components and dimensions labeled. At the top, a horizontal line is labeled "TANK TOP". Below this, the tank is divided into sections. On the left side, there is a label "4 DB RESERVE FUEL TANK UNDER". On the right side, there is a label "2 DB FUEL TANK UNDER". In the center, there is a label "2 DB FUEL TANK UNDER". Below the tank, there is a label "16' SPACING". At the bottom, there is a label "MAIN FRAME SP". On the right side, there is a label "16' TANK SUPPORT" and "1 DB FUEL TANK UNDER".

TITLE: "AS FITTED"

PROFILE AND DECKS


SHEET 2 OF 2.

SCALE: 1/8" = 1 FOOT. DATE:

HULL 68

R' CLASS ICEBREAKER

C.C.G.S. "DES GROSEILLIERS"



PORT WELLER DRY DOCK
A DIVISION OF UPPER LAKES SHIPPING LTD.
ST. CATHARINES, ONTARIO L2R 7C1

DRG No.	60-H-2/2
---------	----------