


CE PLAN EST BASÉ SUR LE PLAN NO. 209-028. IL A ÉTÉ DÉVELOPPÉ UNIQUEMENT PAR MERIDIEN MARITIME À DES FINS DE PRODUCTION AVEC LA PERMISSION ÉCRITE DE ROBERT ALLAN LTÉE. ROBERT ALLAN LTÉE N'ASSUME AUCUNE RESPONSABILITÉ QUELLE QU'ELLE SOIT POUR CE PLAN MODIFIÉ. LA PROPRIÉTÉ INTELLECTUELLE DU PLAN CI-DÉCRIT APPARTIENT UNIQUEMENT À ROBERT ALLAN LTÉE ET AU CANADA. IL EST DÉFENDU DE REPRODUIRE LES PLANS ET LES DEVIS, CI-INCLUS, EN ENTIER OU EN PARTIE, OU DE LES PARTAGER AVEC UN TIERS SANS LA PERMISSION ÉCRITE DES PROPRIÉTAIRES.


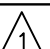



COMPANY :
MÉRIDIEN MARITIME
RÉPARATION

TITLE :
HEATING DISTRIBUTION PLAN


© THIS DRAWING IS BASED ON ROBERT ALLAN Ltd. DESIGN NO. 209-028 AND HAS BEEN DEVELOPED BY MERIDIEN MARITIME FOR PRODUCTION PURPOSES ONLY, WITH THE WRITTEN CONSENT OF ROBERT ALLAN LTD. ROBERT ALLAN LTD ASSUME NO RESPONSIBILITY WHATSOEVER FOR THIS ALTERED DRAWING.
THE INTELLECTUAL PROPERTY RIGHTS TO THE DESIGN DESCRIBED HEREIN BELONG EXCLUSIVELY TO ROBERT ALLAN LTD. AND CANADA. THE DRAWINGS AND SPECIFICATIONS CONTAINED HEREIN SHALL NOT BE REPRODUCED IN WHOLE OR IN PART, NOR SHALL THEY BE GIVEN TO ANY THIRD PARTIES WITHOUT WRITTEN PERMISSION FROM THE OWNERS *(POUR LA TRADUCTION FRANCAISE, VOIR LA PREMIERE PAGE)*

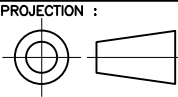

1	AS CONSTRUCTED	MM	JAN 2012
REV.	REVISIONS	BY	DATE
	Garde côtière canadienne Canadian Coast Guard		
NAVIRE 22M VESSEL COQUE # / HULL # 009-010	PROJECT TITLE : Navire semi-hauturier de recherche halieutique Near Shore Fisheries Research Vessels		
PROJECT # : MRO9-1113	DRAWING FILE : ISV22-80500RMM1.DWG	DATE : JAN 2012	
DRAWN BY : MV	DRAWING # : 80500	REV : 	SHEET : 1 OF 6

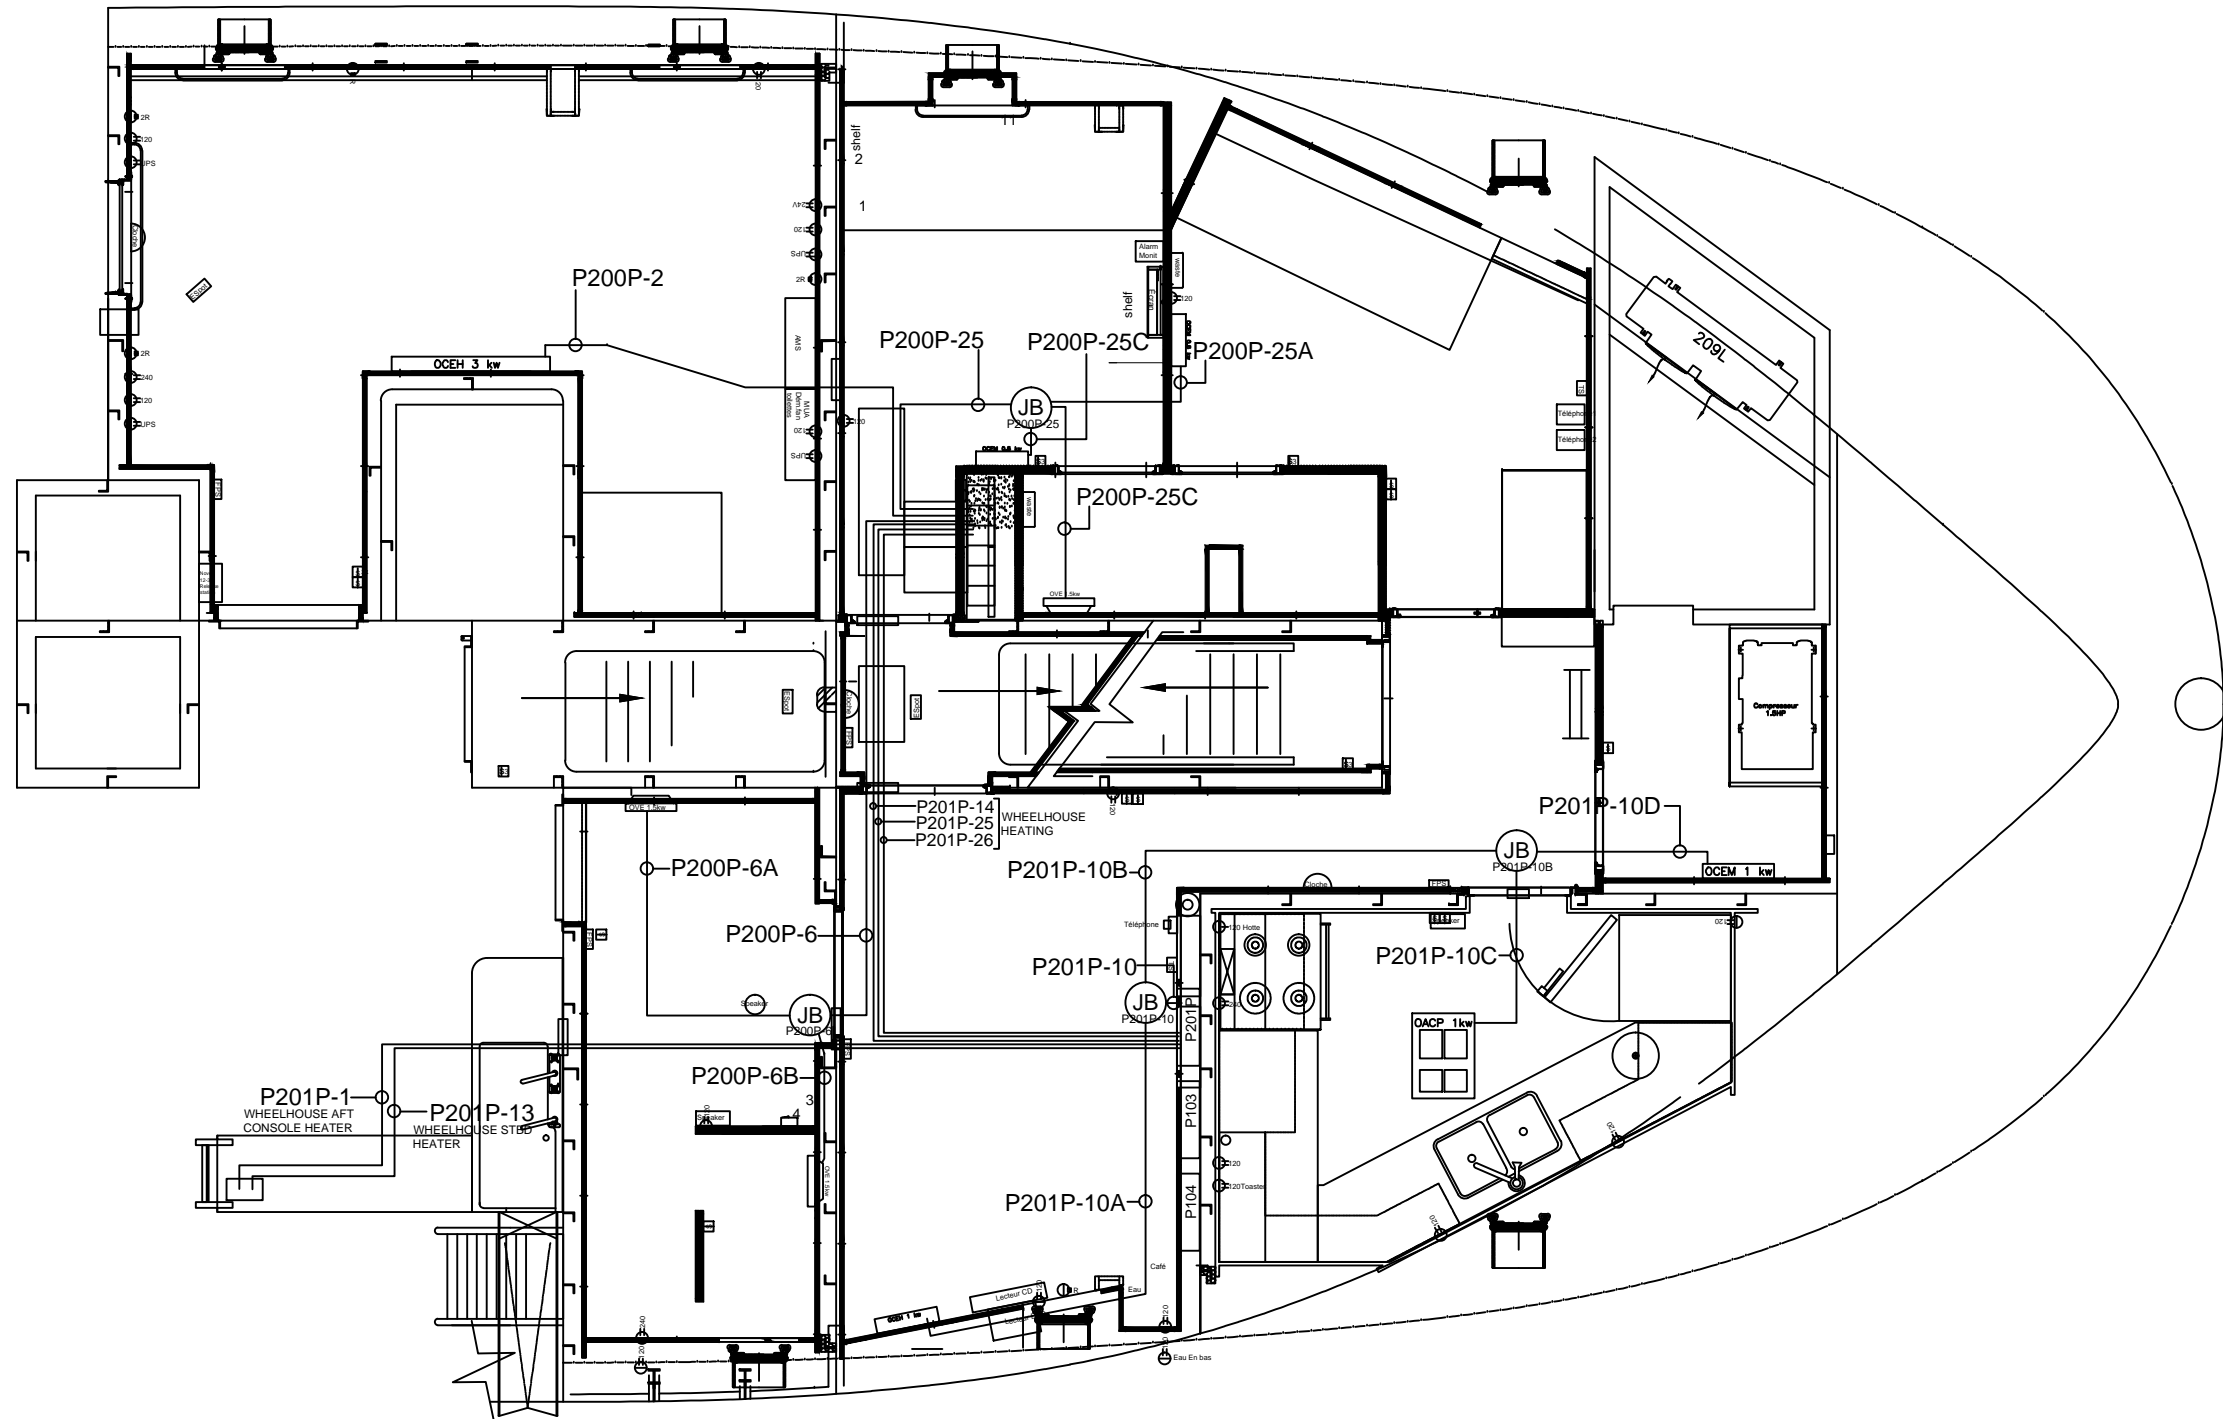

MAIN DECK


	Garde côtière canadienne Canadian Coast Guard		
NAVIRE 22M VESSEL COQUE # / HULL # 009-010	PROJECT TITLE : Navire semi-hauturier de recherche halieutique Near Shore Fisheries Research Vessels		
PROJECT # : MR09-1113	DRAWING FILE : ISV22-80500RMM1.DWG	DATE : JAN 2012	SHEET : 3 OF 6
DRAWN BY : MV	DRAWING # : 80500	REV : 1	




COMPANY :
MÉRIDIEN MARITIME
RÉPARATION

TITLE :
HEATING DISTRIBUTION PLAN

© THIS DRAWING IS BASED ON ROBERT ALLAN Ltd. DESIGN NO. 209-028 AND HAS BEEN DEVELOPED BY MERIDIEN MARITIME FOR PRODUCTION PURPOSES ONLY, WITH THE WRITTEN CONSENT OF ROBERT ALLAN LTD. ROBERT ALLAN LTD ASSUME NO RESPONSIBILITY WHATSOEVER FOR THIS ALTERED DRAWING.
THE INTELLECTUAL PROPERTY RIGHTS TO THE DESIGN DESCRIBED HEREIN BELONG EXCLUSIVELY TO ROBERT ALLAN LTD. AND CANADA. THE DRAWINGS AND SPECIFICATIONS CONTAINED HEREIN SHALL NOT BE REPRODUCED IN WHOLE OR IN PART, NOR SHALL THEY BE GIVEN TO ANY THIRD PARTIES WITHOUT WRITTEN PERMISSION FROM THE OWNERS (POUR LA TRADUCTION FRANCAISE, VOIR LA PREMIERE PAGE)

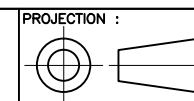

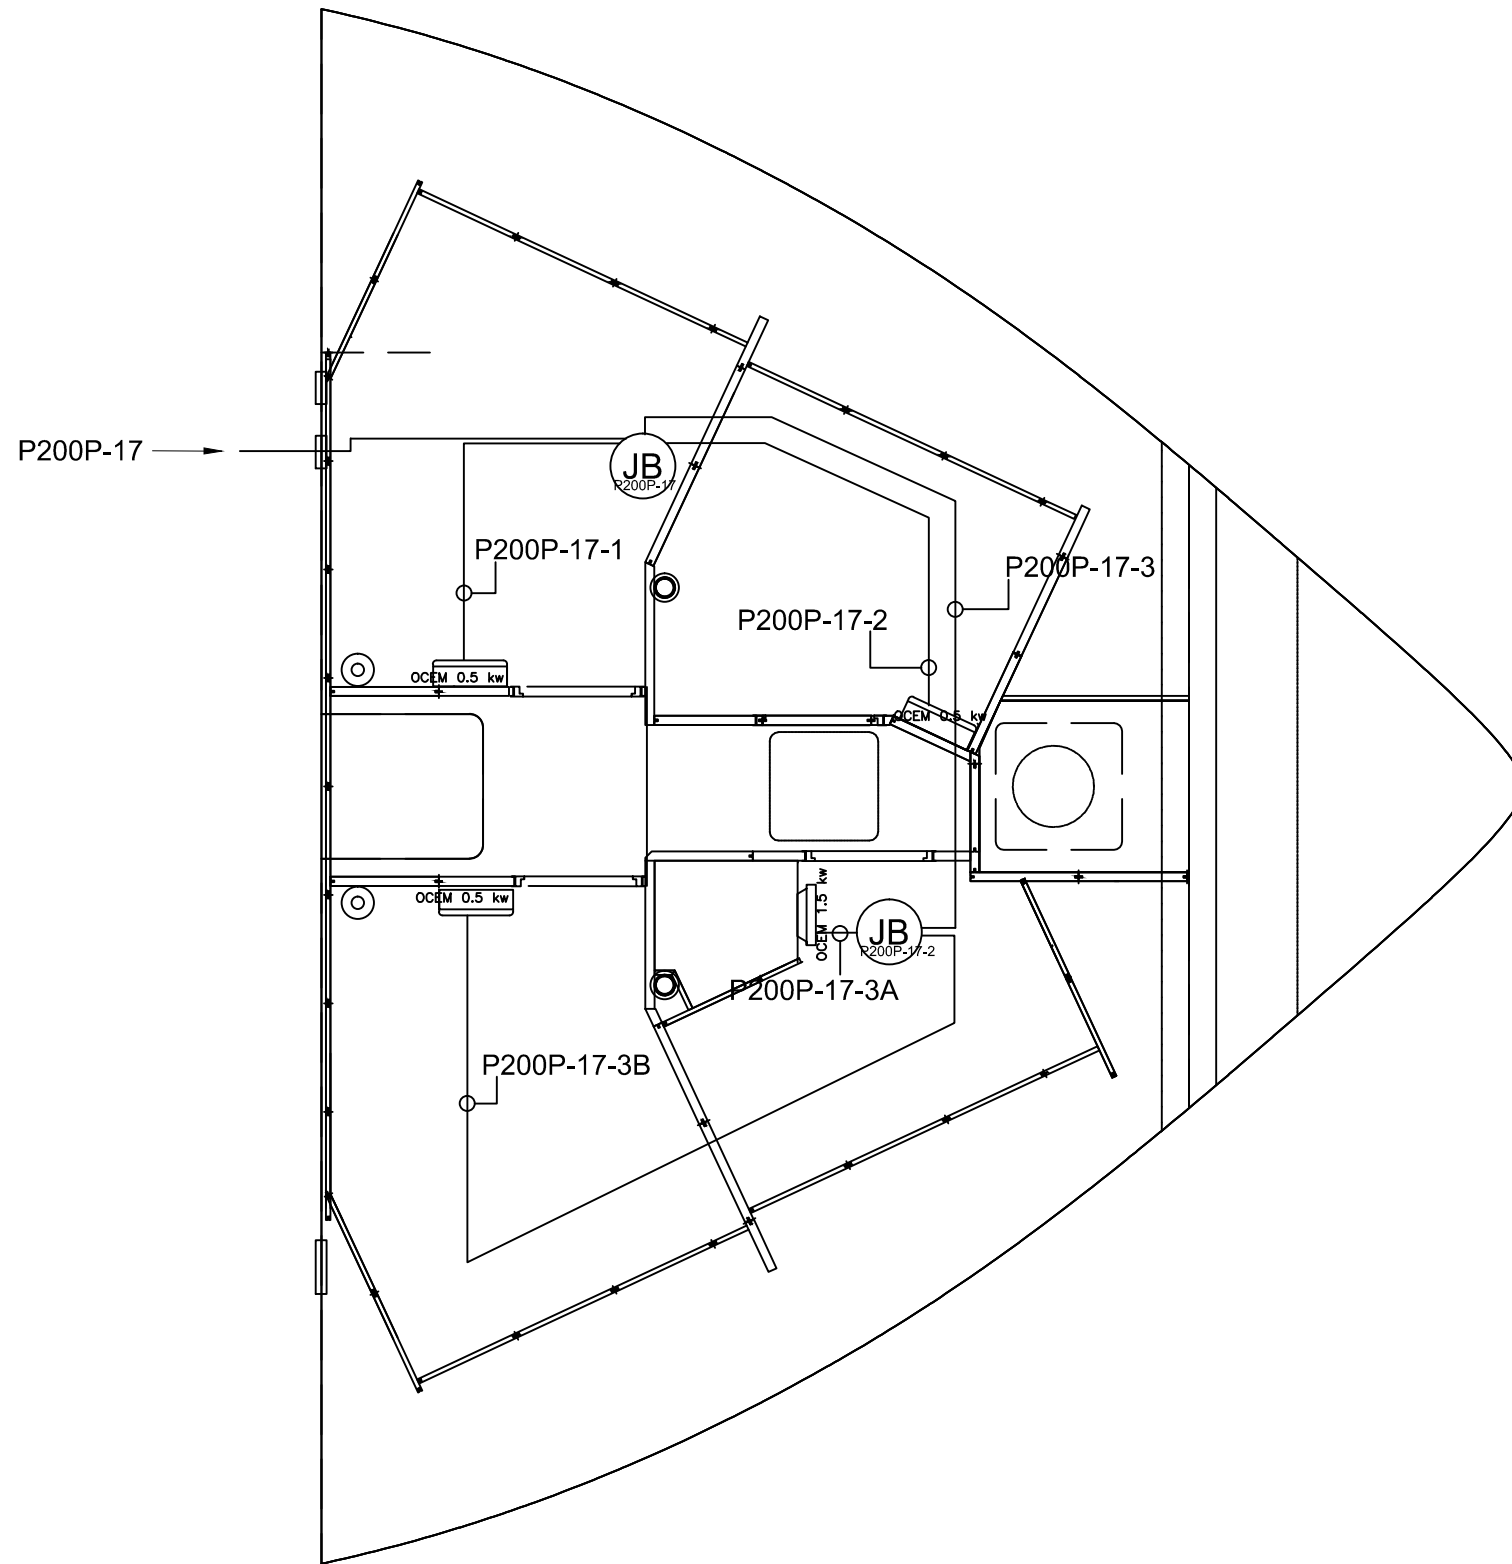


LOWER ACCOMODATION




COMPANY :
MÉRIDIEN MARITIME
RÉPARATION


TITLE :
HEATING DISTRIBUTION PLAN

© THIS DRAWING IS BASED ON ROBERT ALLAN Ltd. DESIGN NO. 209-028 AND HAS BEEN DEVELOPED BY MERIDIEN MARITIME FOR PRODUCTION PURPOSES ONLY, WITH THE WRITTEN CONSENT OF ROBERT ALLAN LTD. ROBERT ALLAN LTD ASSUME NO RESPONSIBILITY WHATSOEVER FOR THIS ALTERED DRAWING.
THE INTELLECTUAL PROPERTY RIGHTS TO THE DESIGN DESCRIBED HEREIN BELONG EXCLUSIVELY TO ROBERT ALLAN LTD. AND CANADA. THE DRAWINGS AND SPECIFICATIONS CONTAINED HEREIN SHALL NOT BE REPRODUCED IN WHOLE OR IN PART, NOR SHALL THEY BE GIVEN TO ANY THIRD PARTIES WITHOUT WRITTEN PERMISSION FROM THE OWNERS (POUR LA TRADUCTION FRANCAISE, VOIR LA PREMIERE PAGE)

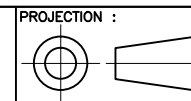


PROJECTION :

		Garde côtière canadienne Canadian Coast Guard	
NAVIRE 22M VESSEL COQUE # / HULL # 009-010		PROJECT TITLE : Navire semi-hauturier de recherche halieutique Near Shore Fisheries Research Vessels	
PROJECT # : MR09-1113	DRAWING FILE : ISV22-80500RMM1.DWG	DATE : JAN 2012	
DRAWN BY : MV	DRAWING # : 80500	REV : 1	SHEET : 4 OF 6

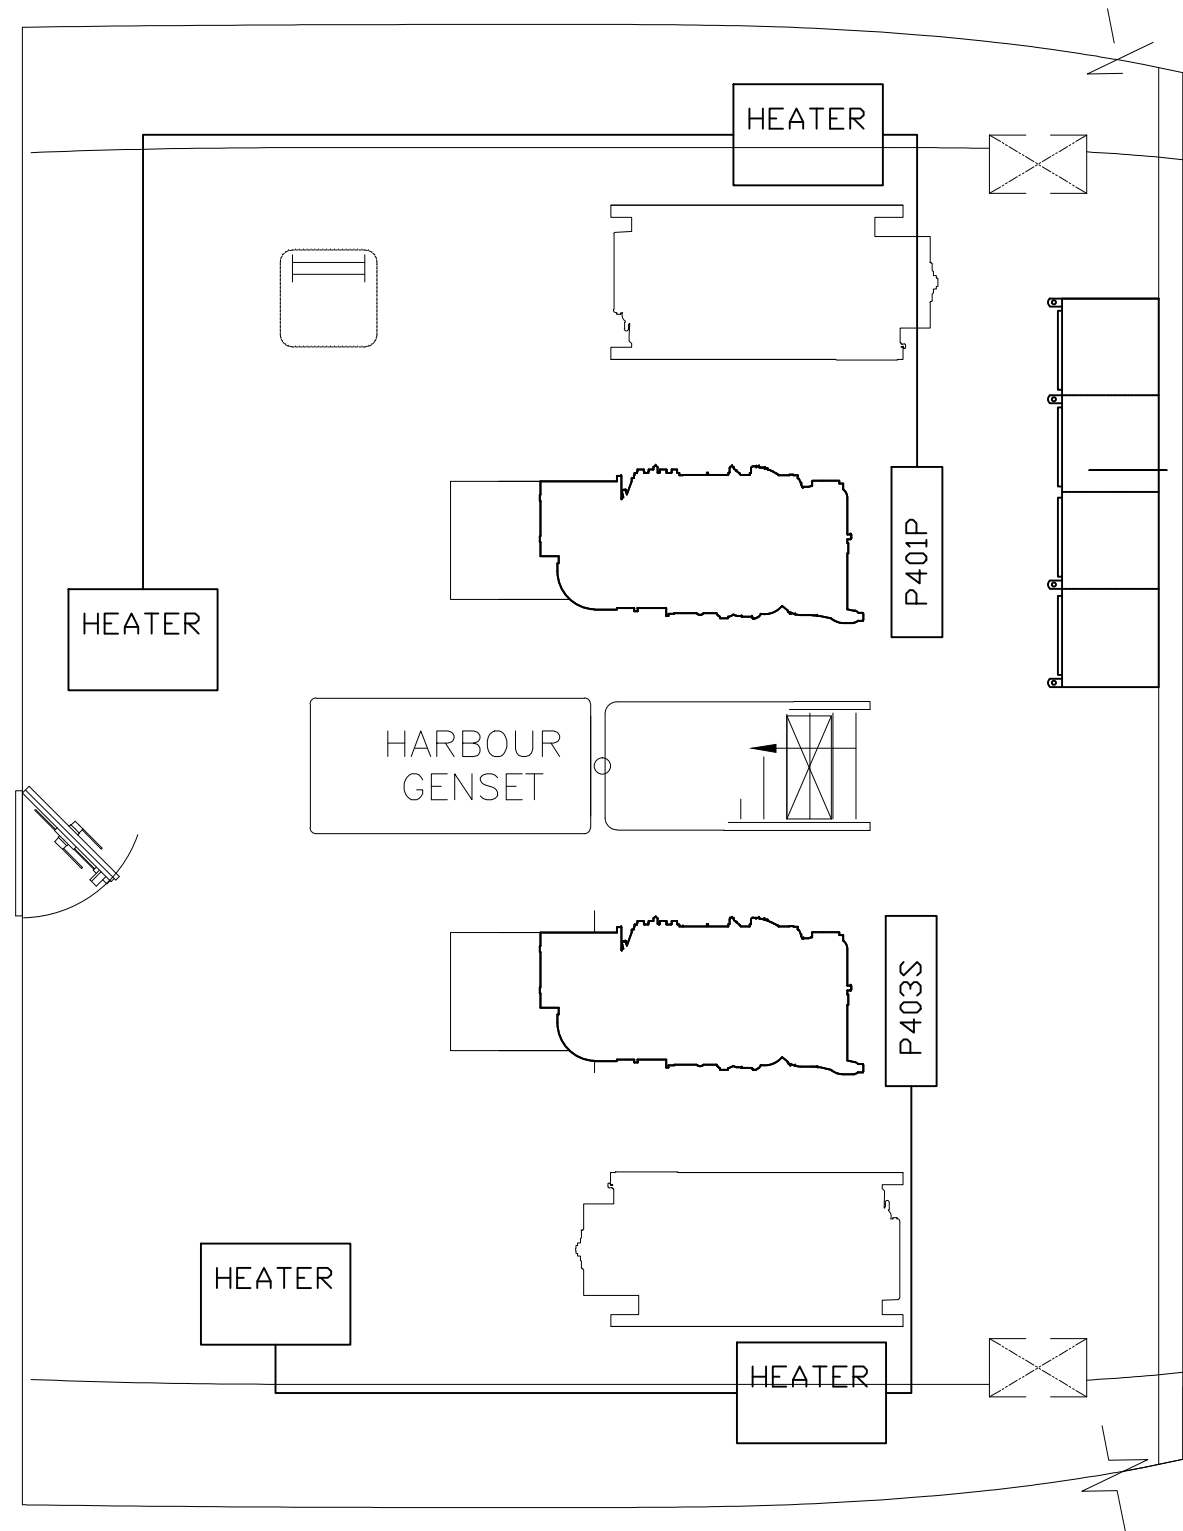


ENGINE ROOM

		Garde côtière canadienne Canadian Coast Guard	
NAVIRE 22M VESSEL COQUE # / HULL # 009-010		PROJECT TITLE : Navire semi-hauturier de recherche halieutique Near Shore Fisheries Research Vessels	
PROJECT # : MR09-1113	DRAWING FILE : ISV22-80500RMM1.DWG	DATE : JAN 2012	
DRAWN BY : MV	DRAWING # : 80500	REV : 1	SHEET : 5 OF 6

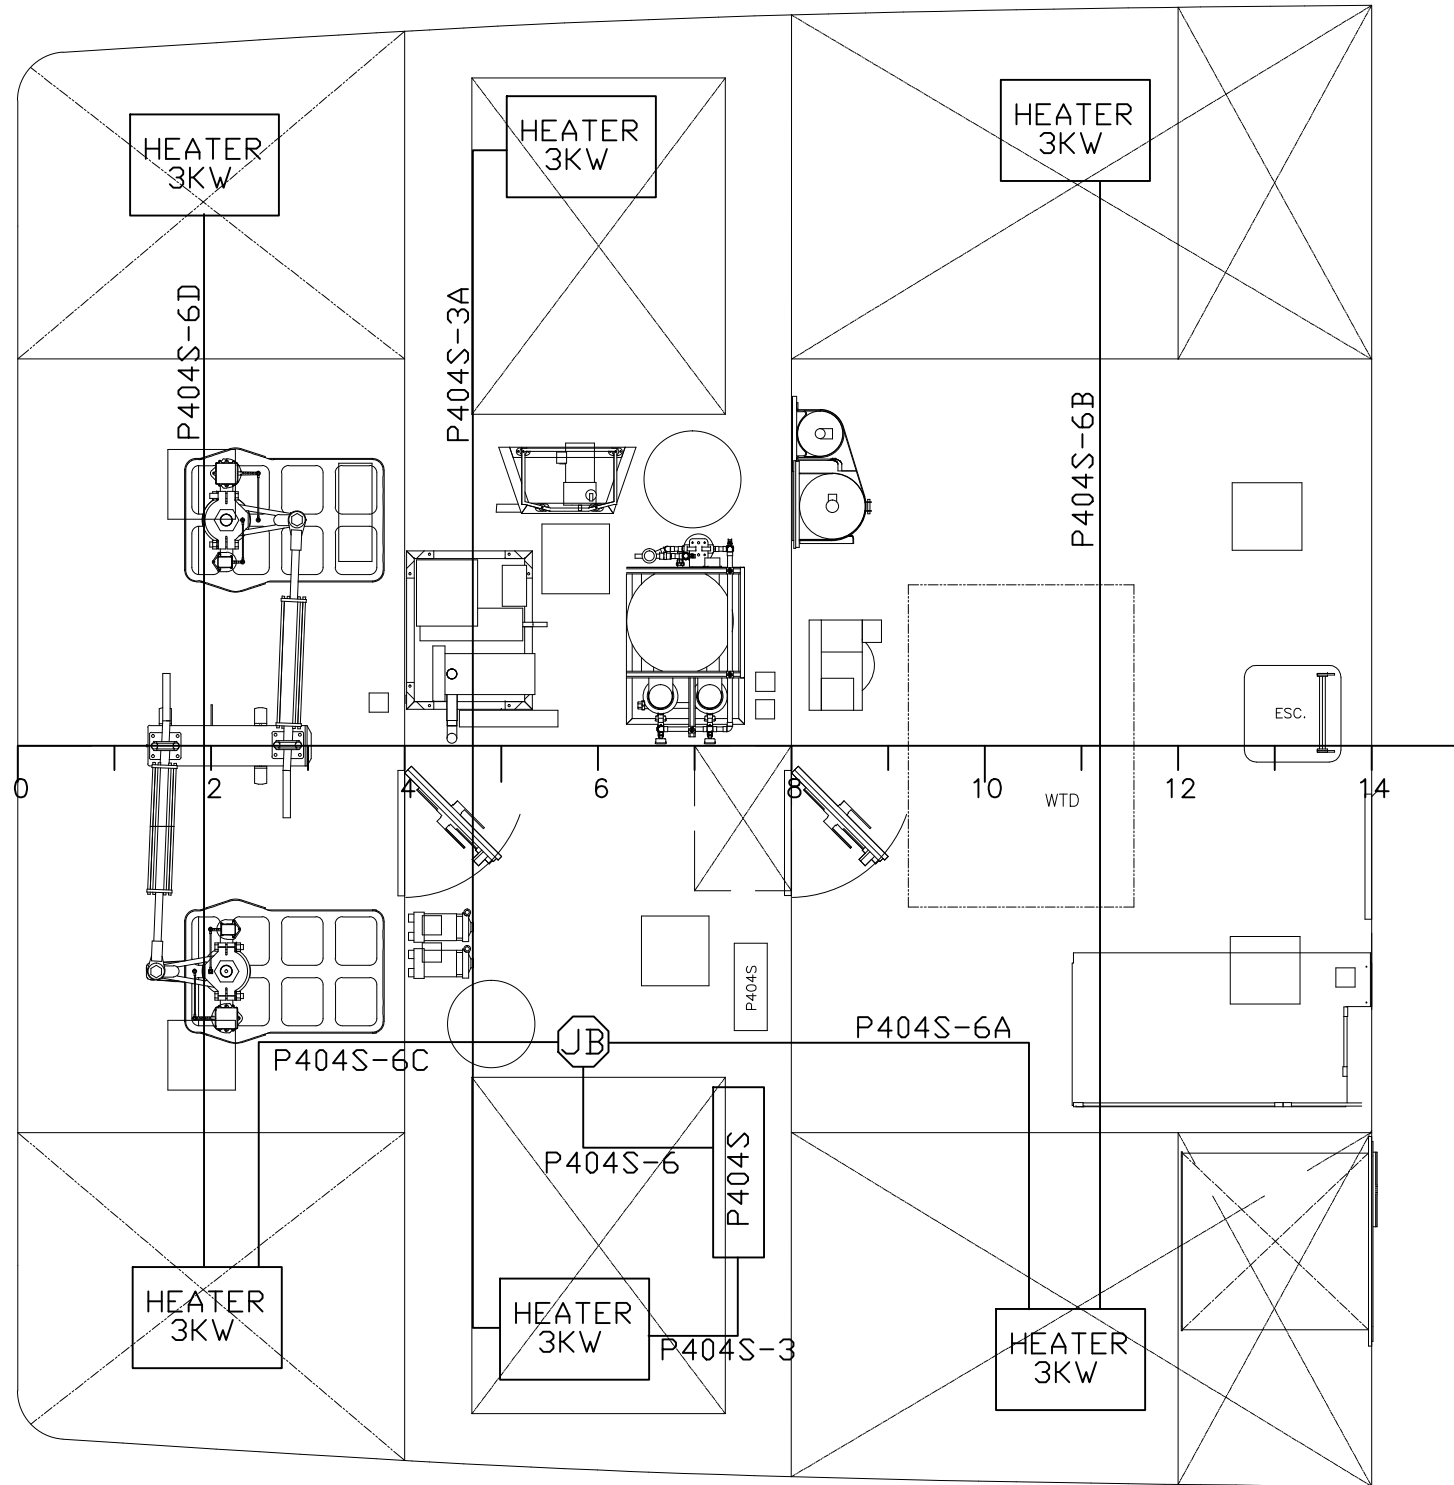

AUXILIARY MACHINERY SPACE

		Garde côtière canadienne Canadian Coast Guard	
NAVIRE 22M VESSEL COQUE # / HULL # 009-010		PROJECT TITLE : Navire semi-hauturier de recherche halieutique Near Shore Fisheries Research Vessels	
PROJECT # : MR09-1113	DRAWING FILE : ISV22-80500RMM1.DWG	DATE : JAN 2012	
DRAWN BY : MV	DRAWING # : 80500	REV : 1	SHEET : 6 OF 6



COMPANY :
**MÉRIDIEN MARITIME
RÉPARATION**

TITLE :
HEATING DISTRIBUTION PLAN

© THIS DRAWING IS BASED ON ROBERT ALLAN Ltd. DESIGN NO. 209-028 AND HAS BEEN DEVELOPED BY MERIDIEN MARITIME FOR PRODUCTION PURPOSES ONLY, WITH THE WRITTEN CONSENT OF ROBERT ALLAN LTD. ROBERT ALLAN LTD ASSUME NO RESPONSIBILITY WHATSOEVER FOR THIS ALTERED DRAWING.
THE INTELLECTUAL PROPERTY RIGHTS TO THE DESIGN DESCRIBED HEREIN BELONG EXCLUSIVELY TO ROBERT ALLAN LTD. AND CANADA. THE DRAWINGS AND SPECIFICATIONS CONTAINED HEREIN SHALL NOT BE REPRODUCED IN WHOLE OR IN PART, NOR SHALL THEY BE GIVEN TO ANY THIRD PARTIES WITHOUT WRITTEN PERMISSION FROM THE OWNERS (POUR LA TRADUCTION FRANCAISE, VOIR LA PREMIERE PAGE)

