


13	-	UPDATED TO OWNER'S COMMENTS		09.06.25
12	-	'AS BUILT' - 2009 REFIT VDD		09.05.07
11	-	UPDATED TO OWNER'S COMMENTS		08.06.13
10	-	'AS BUILT'-MID LIFE, REFIT PHASE 2		08.03.19
9	-	'AS BUILT'-MID LIFE, REFIT		07.04.10
8	-	RASTER SCANNED & TRACED		98.01.30
7	-	GENERAL REVISION		96.02.15
6	-	REMOVABLE SECTION OF BULWARK		93.06.28
5	-	STROBE LIGHT ADDED		93.02.23
4	-	STRAKES REMOVED (P&S)		91.10.15
3	-	GENERAL REVISION		90.09.17
2	-	STRAKES ADDED (P&S)		90.01.22
1	-	GENERAL REVISION		88.08.31

Rev. No.	Zone	Revisions	App'd/App'n	Date
App'd/App'n				
Date				


Contractor/Entrepreneur	Victoria Shipyards Co. Ltd., 825 Admirals Road, Victoria, BC, V8A 2P1. Tel: (250) 380-1602. Fax: (250) 995-6559.
Contractor Drg. No.	07106-550-040-001
Entrepreneur dess. No	

Vessel Name	SIR WILFRID LAURIER
Drg. Title	GENERAL ARRANGEMENT PROFILE & END VIEWS


Dwn. Ver.	AW	Qtd. Ver.	LG	App'd Ver.	PW
Date	10/20/06	Scale/Echelle	1:100	Sheet/Feuille	1 Of 3
C.C.C. Drg. No.	230-301	Reference Drgs/Dess Reference			Rev. 13
G.C.C. dess. No					

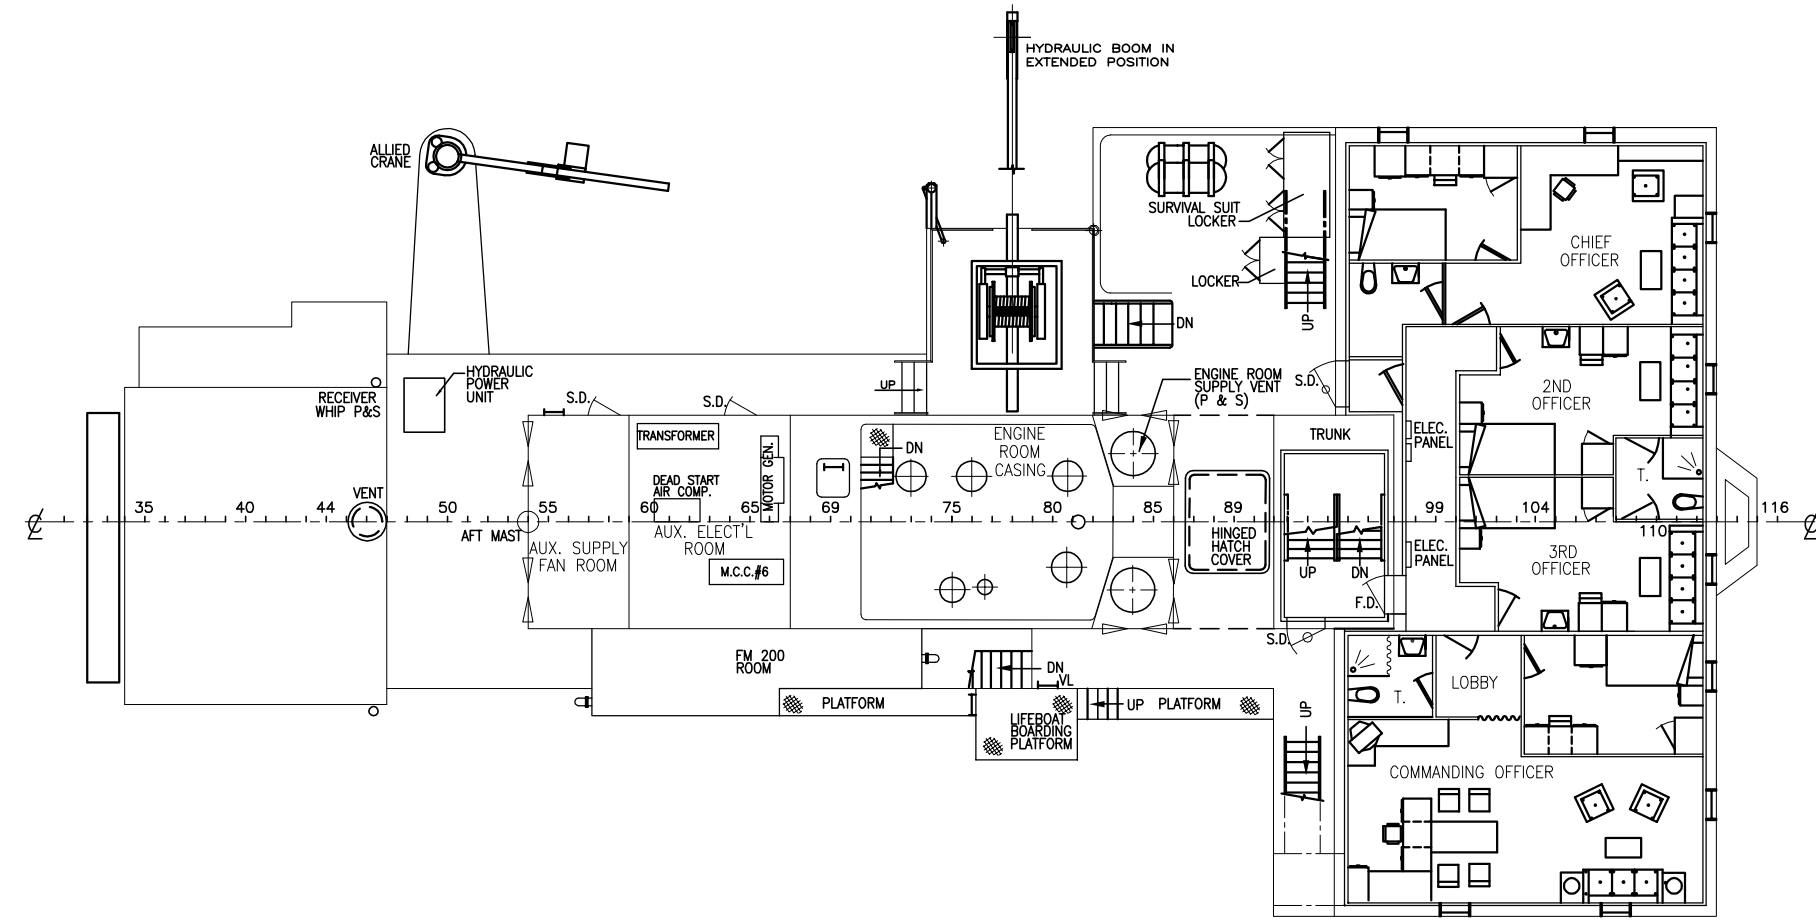


OFFICERS DECK

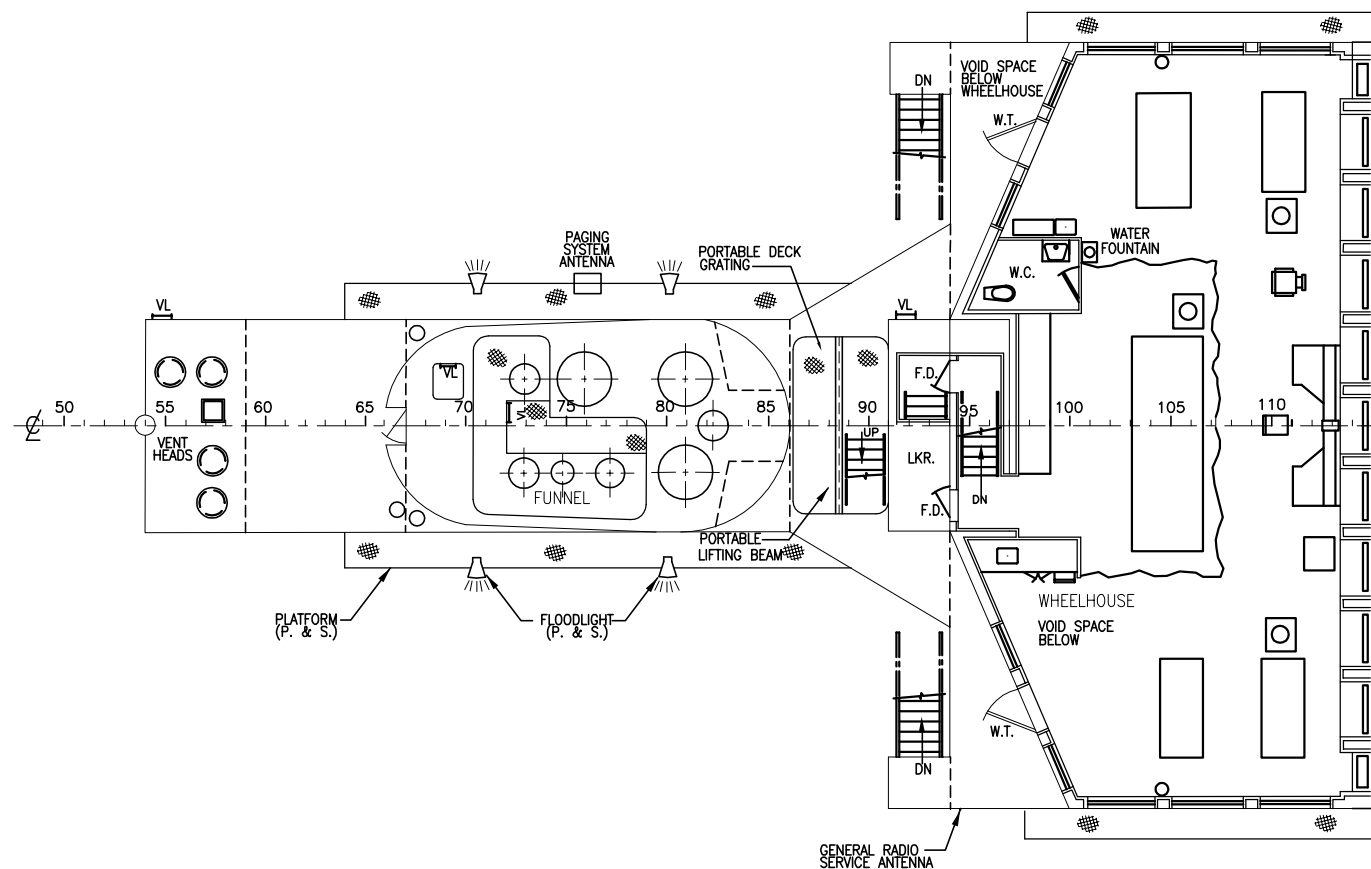


WHEELHOUSE FLOOR

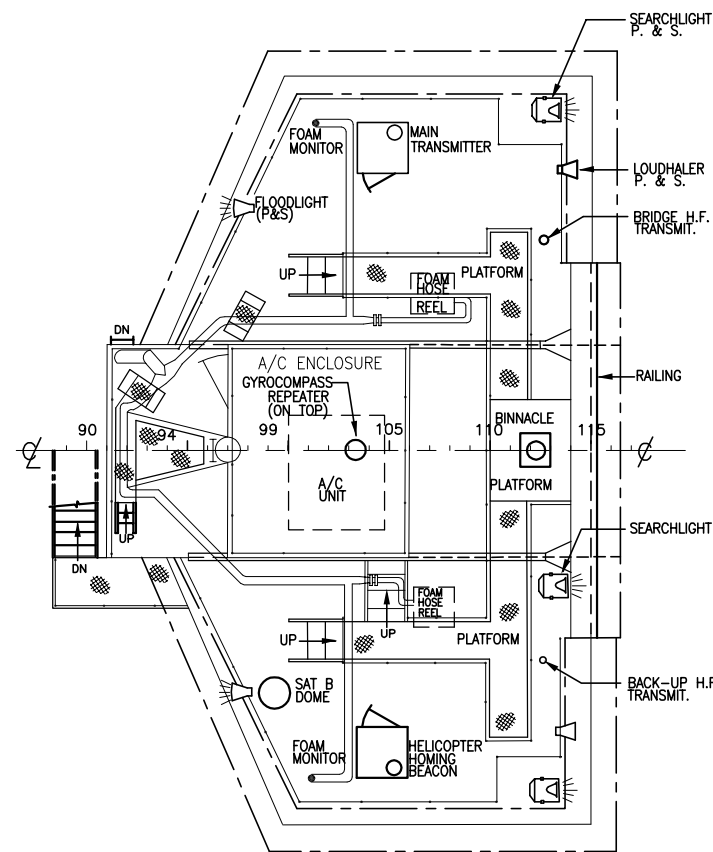

WHEELHOUSE TOP

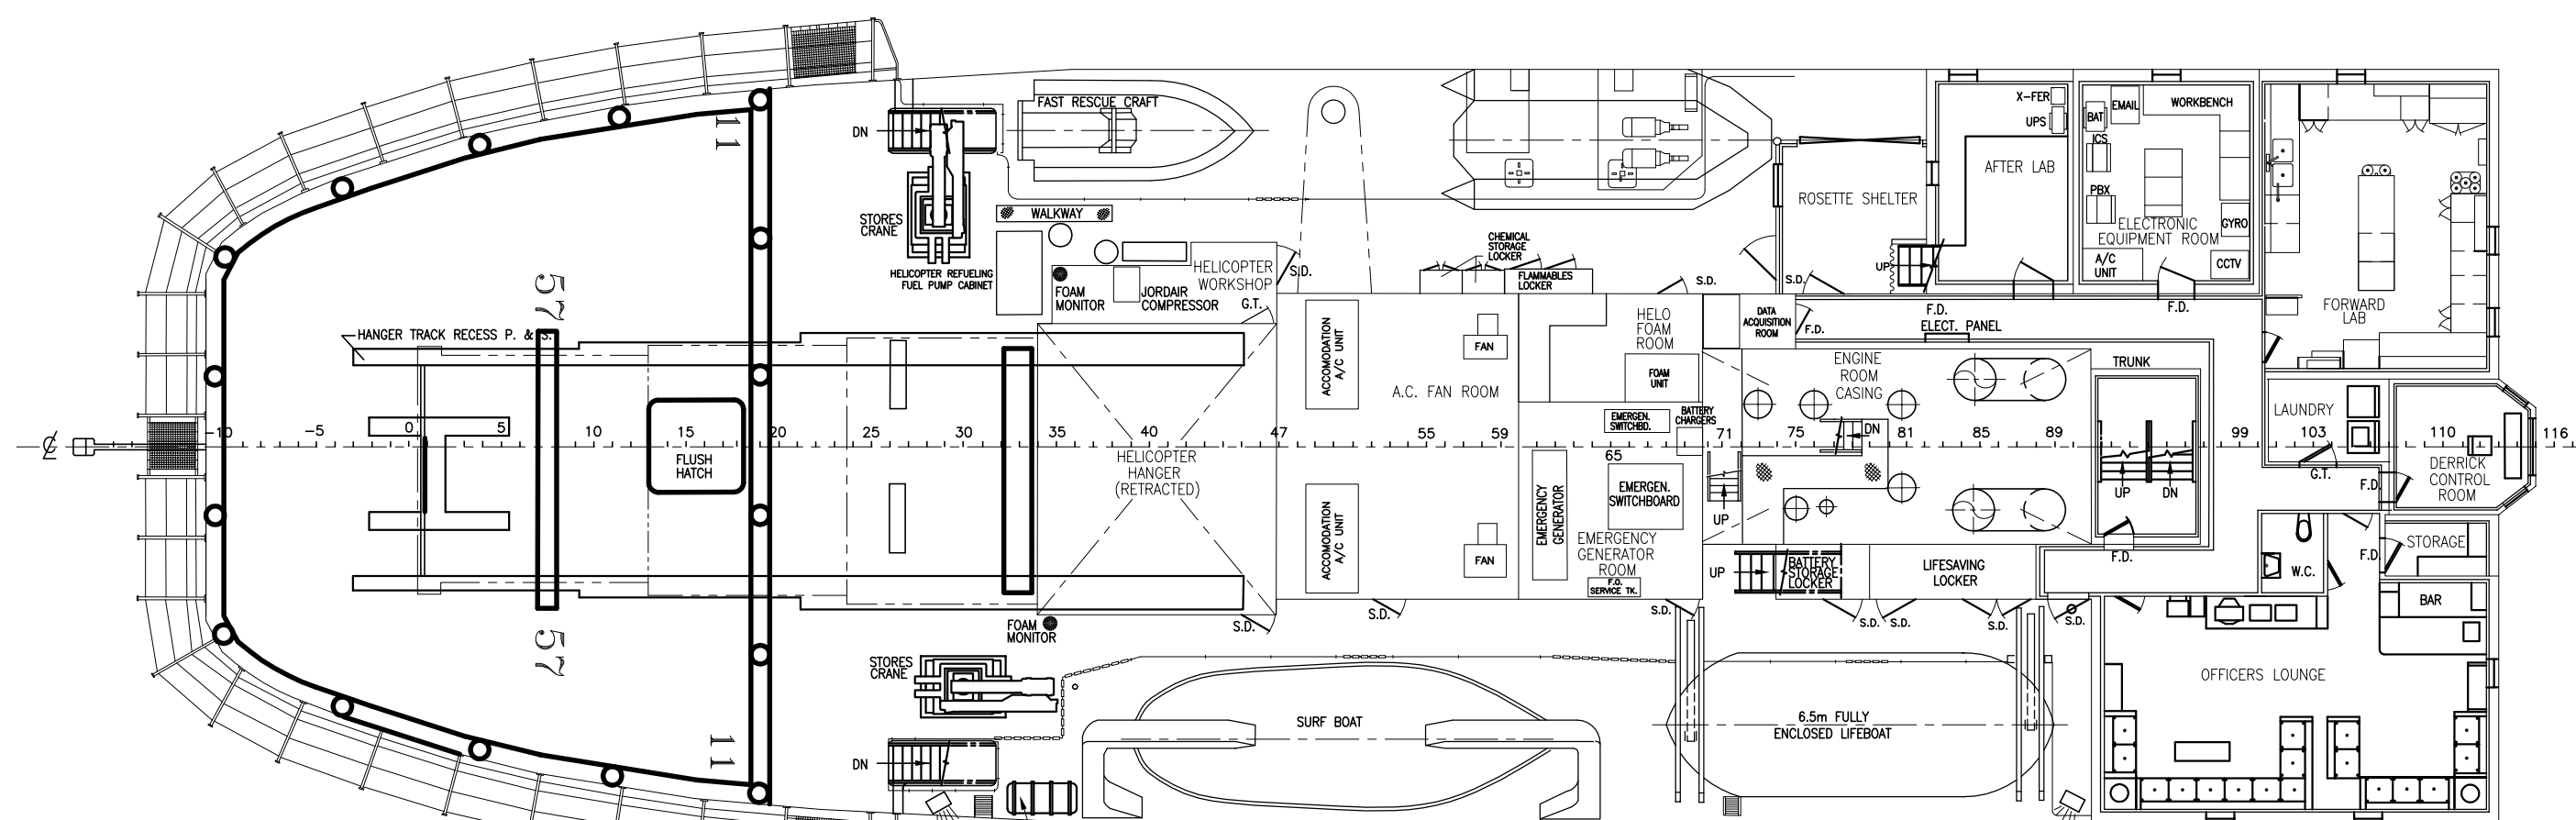

BOAT DECK

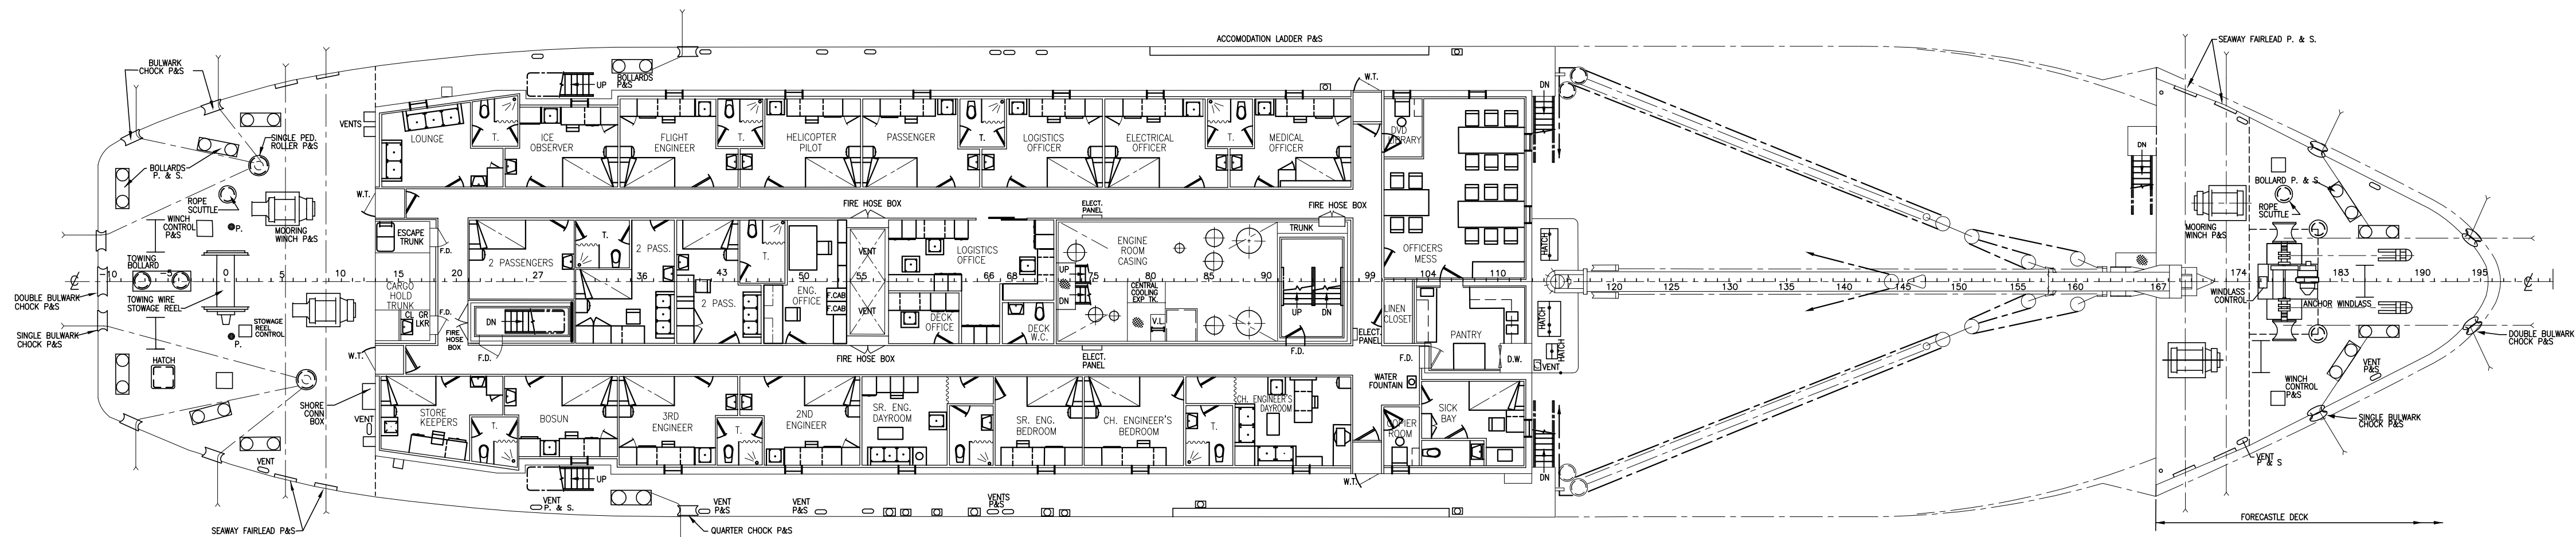

UPPER DECK




13	-	UPDATED TO OWNER'S COMMENTS	09.06.25
12	-	'AS BUILT' - 2009 REFIT VDD	09.05.07
11	-	UPDATED TO OWNER'S COMMENTS	08.06.13
10	-	'AS BUILT'-MID LIFE REFIT PHASE 2	08.03.19
9	-	'AS BUILT'-MID LIFE REFIT	07.04.10
8	-	RASTER SCANNED & TRACED	98.01.30
7	-	GENERAL REVISION	96.02.15
6	-	REMOVABLE SECTION OF BULKWARK	93.06.28
5	-	STROBE LIGHT ADDED	93.02.23
4	-	STRAKES REMOVED (P&S)	91.10.15
3	-	GENERAL REVISION	90.09.17
2	-	STRAKES ADDED (P&S)	90.01.22
1	-	GENERAL REVISION	88.08.31

Rev. No.	Zone	Revisions	App'd/APP'n	Date
App'd/APP'n				
Date				

Contractor/Entrepreneur	Victoria Shipyards Co. Ltd., 825 Admirals Road, Victoria, BC, V8A 2P1. Tel: (250) 380-1602. Fax: (250) 995-6599.
Contractor Drg. No.	07106-550-040-001
Entrepreneur dess. No.	

	GOVERNMENT OF CANADA DEPARTMENT OF FISHERIES AND OCEANS				
Vessel Name	SIR WILFRID LAURIER				
Drg. Title	GENERAL ARRANGEMENT W'HOUSE TOP, W'HOUSE FLOOR OFFICERS, BOAT & UPPER DECKS				
Dwn. Ver.	AW	Dwn. Ver.	LG	App'd Ver.	PW
Date	10/20/06	Scale/ Echelle	1:100	Sheet/ Feuille	2 Of 3
C.C.C. Drg. No.	230-301	Rev.	13		
C.C.C. dess. No.					

Dwg No. de dess	Title/Titre
Reference Dwg/Dess Reference	

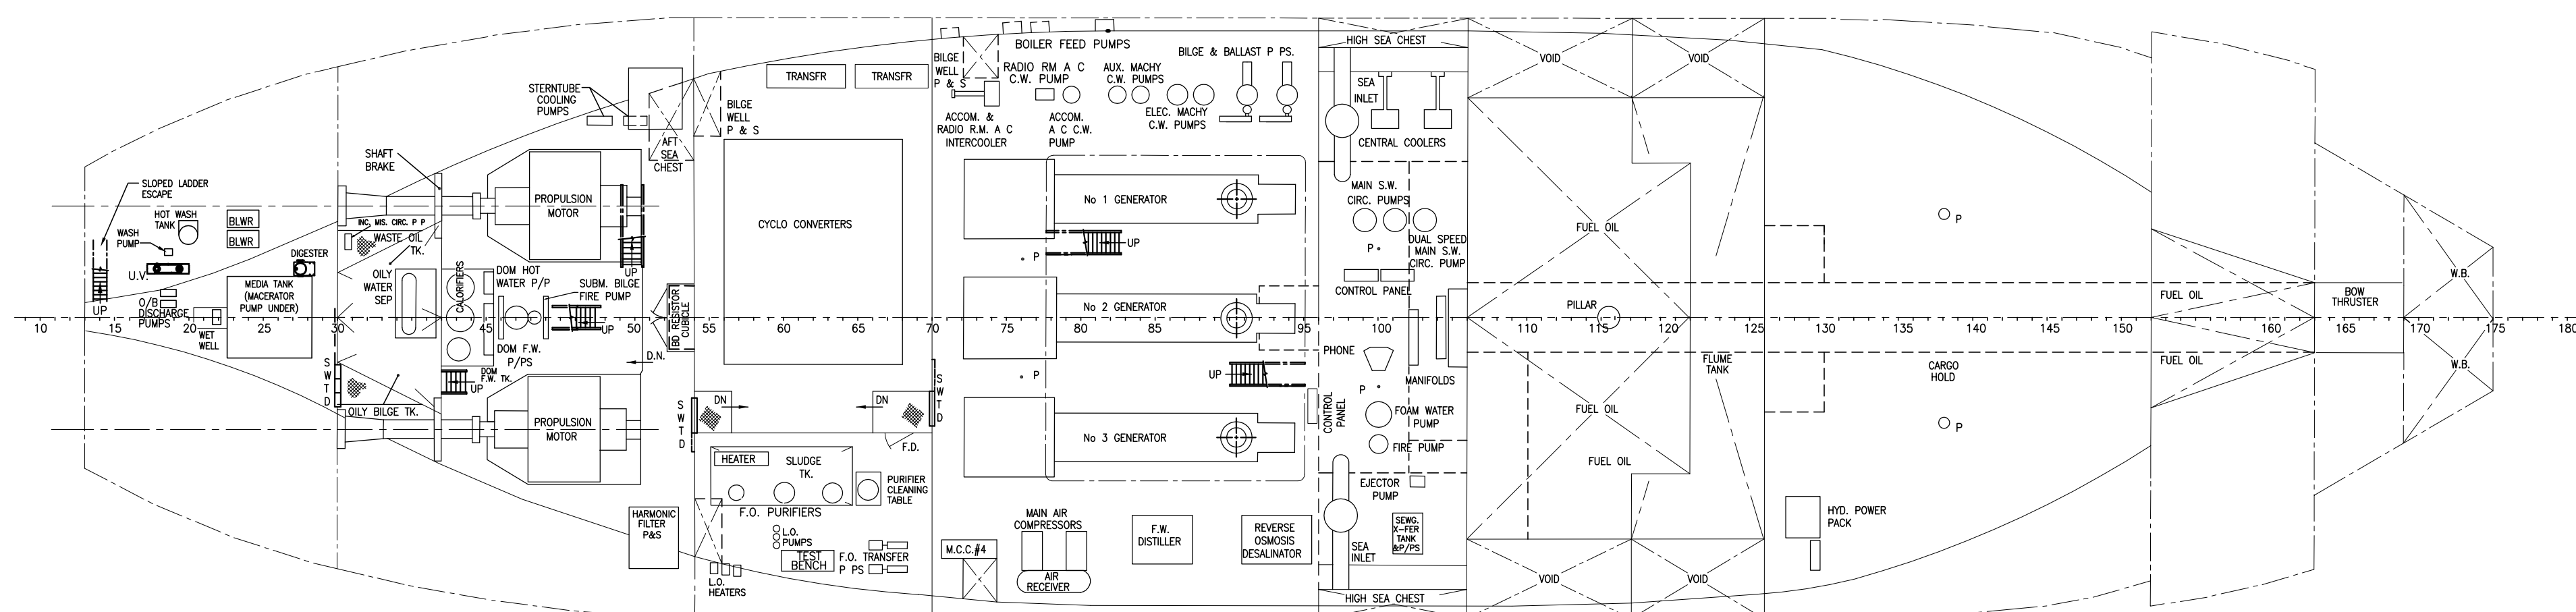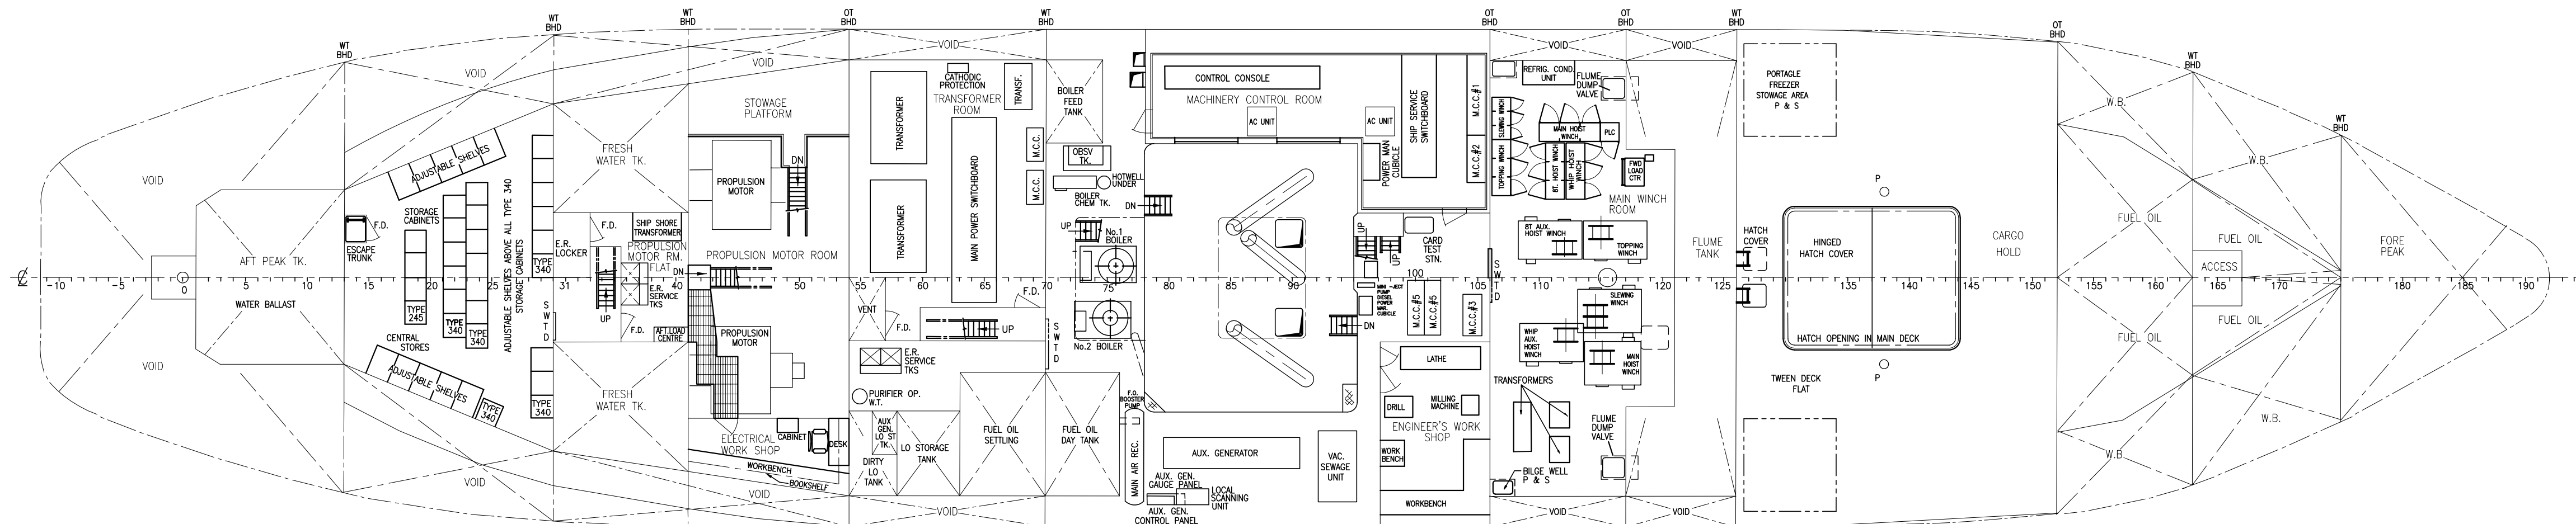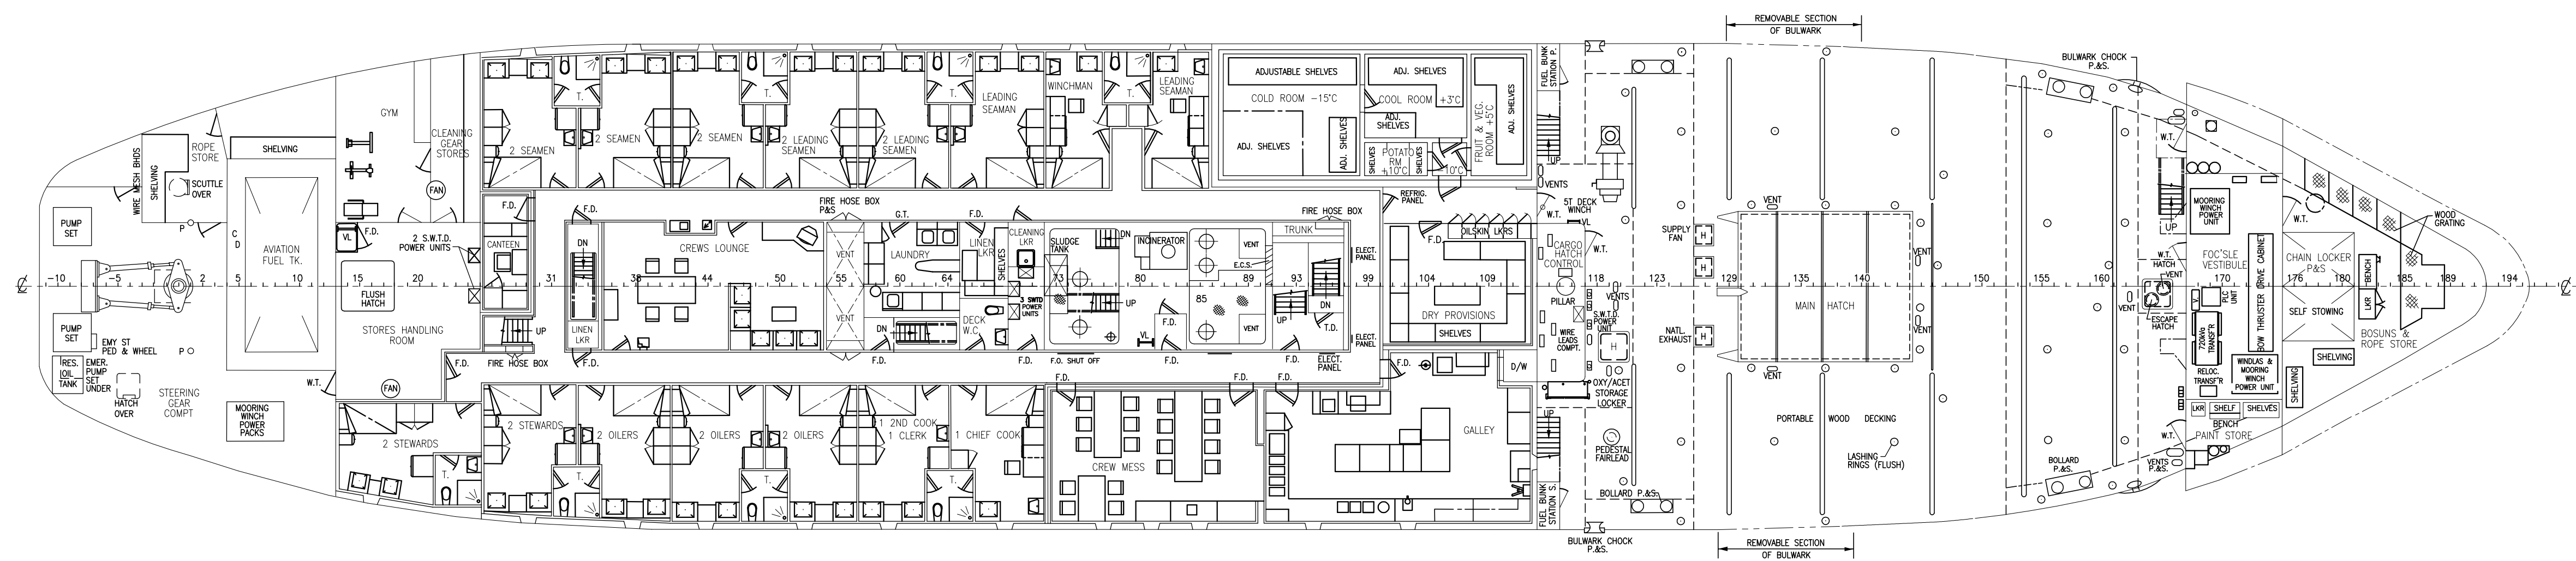

13	-	UPDATED TO OWNER'S COMMENTS		09.06.25
12	-	"AS BUILT" - 2009 REPT VDD		09.05.07
11	-	UPDATED TO OWNER'S COMMENTS		08.06.13
10	-	"AS BUILT"-MID LIFE REFIT PHASE 2		08.03.19
9	-	"AS BUILT"-MID LIFE REFIT		07.04.10
8	-	RASTER SCANNED & TRACED		98.01.30
7	-	GENERAL REVISION		96.02.15
6	-	REMOVABLE SECTION OF BULWARK		93.06.28
5	-	STROBE LIGHT ADDED		93.02.23
4	-	STRAKES REMOVED (P&S)		91.10.15
3	-	GENERAL REVISION		90.09.17
2	-	STRAKES ADDED (P&S)		90.01.22
1	-	GENERAL REVISION		88.08.31
Rev. No.	Zone	Revisions	App'd/App'n	Date
App'd/App'n	Date			
Contractor/Entrepreneur VICTORIA SHIPYARDS Victoria Shipyards Co. Ltd., 825 Admirals Road, Victoria, BC, V8A 2P1 Tel: (250) 380-1602 Fax: (250) 995-6599				
Contractor Drg. No. 07106-550-040-001 Entrepreneur dess. NP				
GOVERNMENT OF CANADA DEPARTMENT OF FISHERIES AND OCEANS				
Vessel Name SIR WILFRID LAURIER				
Drg. Title GENERAL ARRANGEMENT MAIN DECK E.R. FLAT, TANK TOP				
Dwn. Des.	AW	Old. Ver.	LG	App'd PW
Date:	10/20/06	Scale/ Echelle:	1:100	Sheet/ Feuille 3 Of 3
C.C.G. Drg. No.	230-301			Rev 13
G.C.C. dess. No.				

Dwg No. de dess	Title/Titre
Reference Dwg/Dess Reference	