




WILLIAM JORDAN ARCHITECT LTD.
 PERMIT No. 38
 ISSUED PURSUANT TO THE
 ARCHITECTS ACT

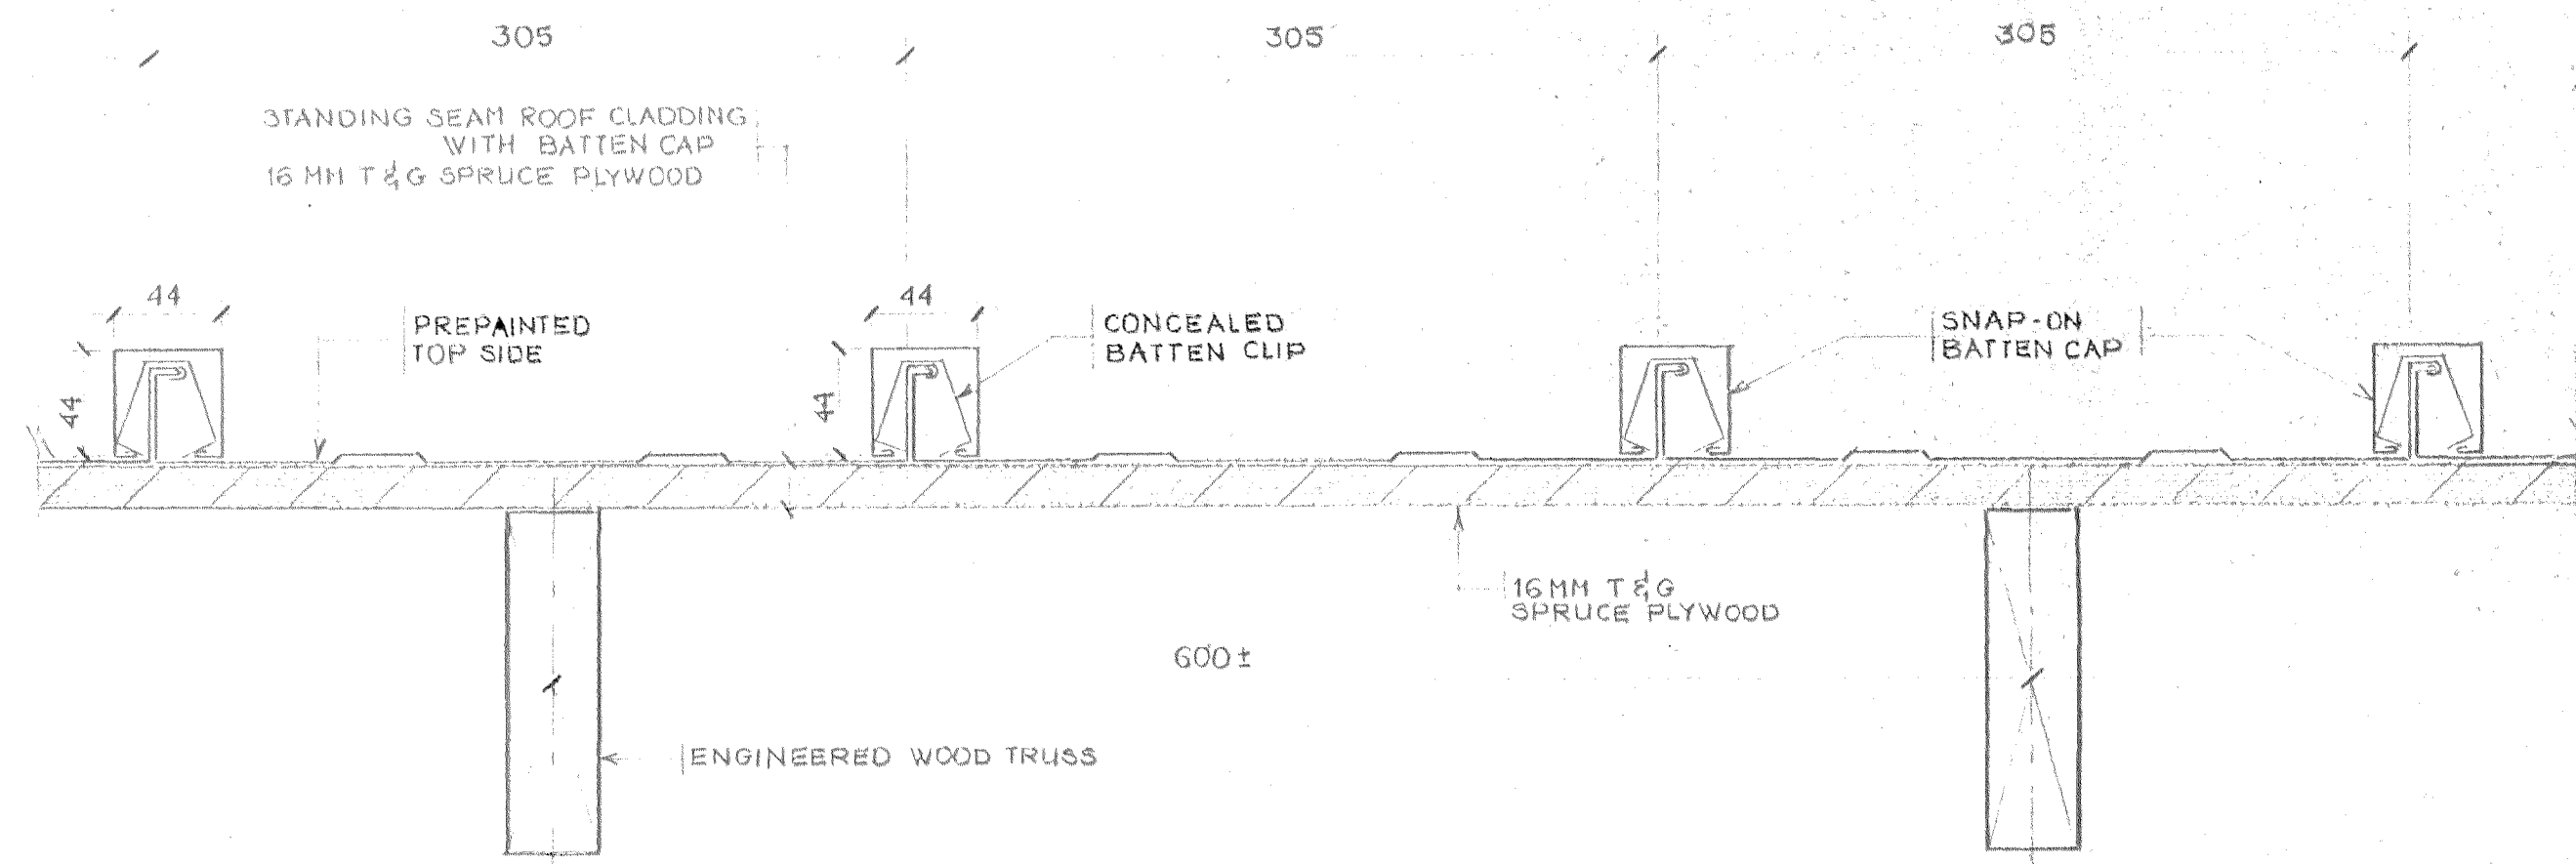


ROOF SECTION DETAIL
 SCALE 1 : 3

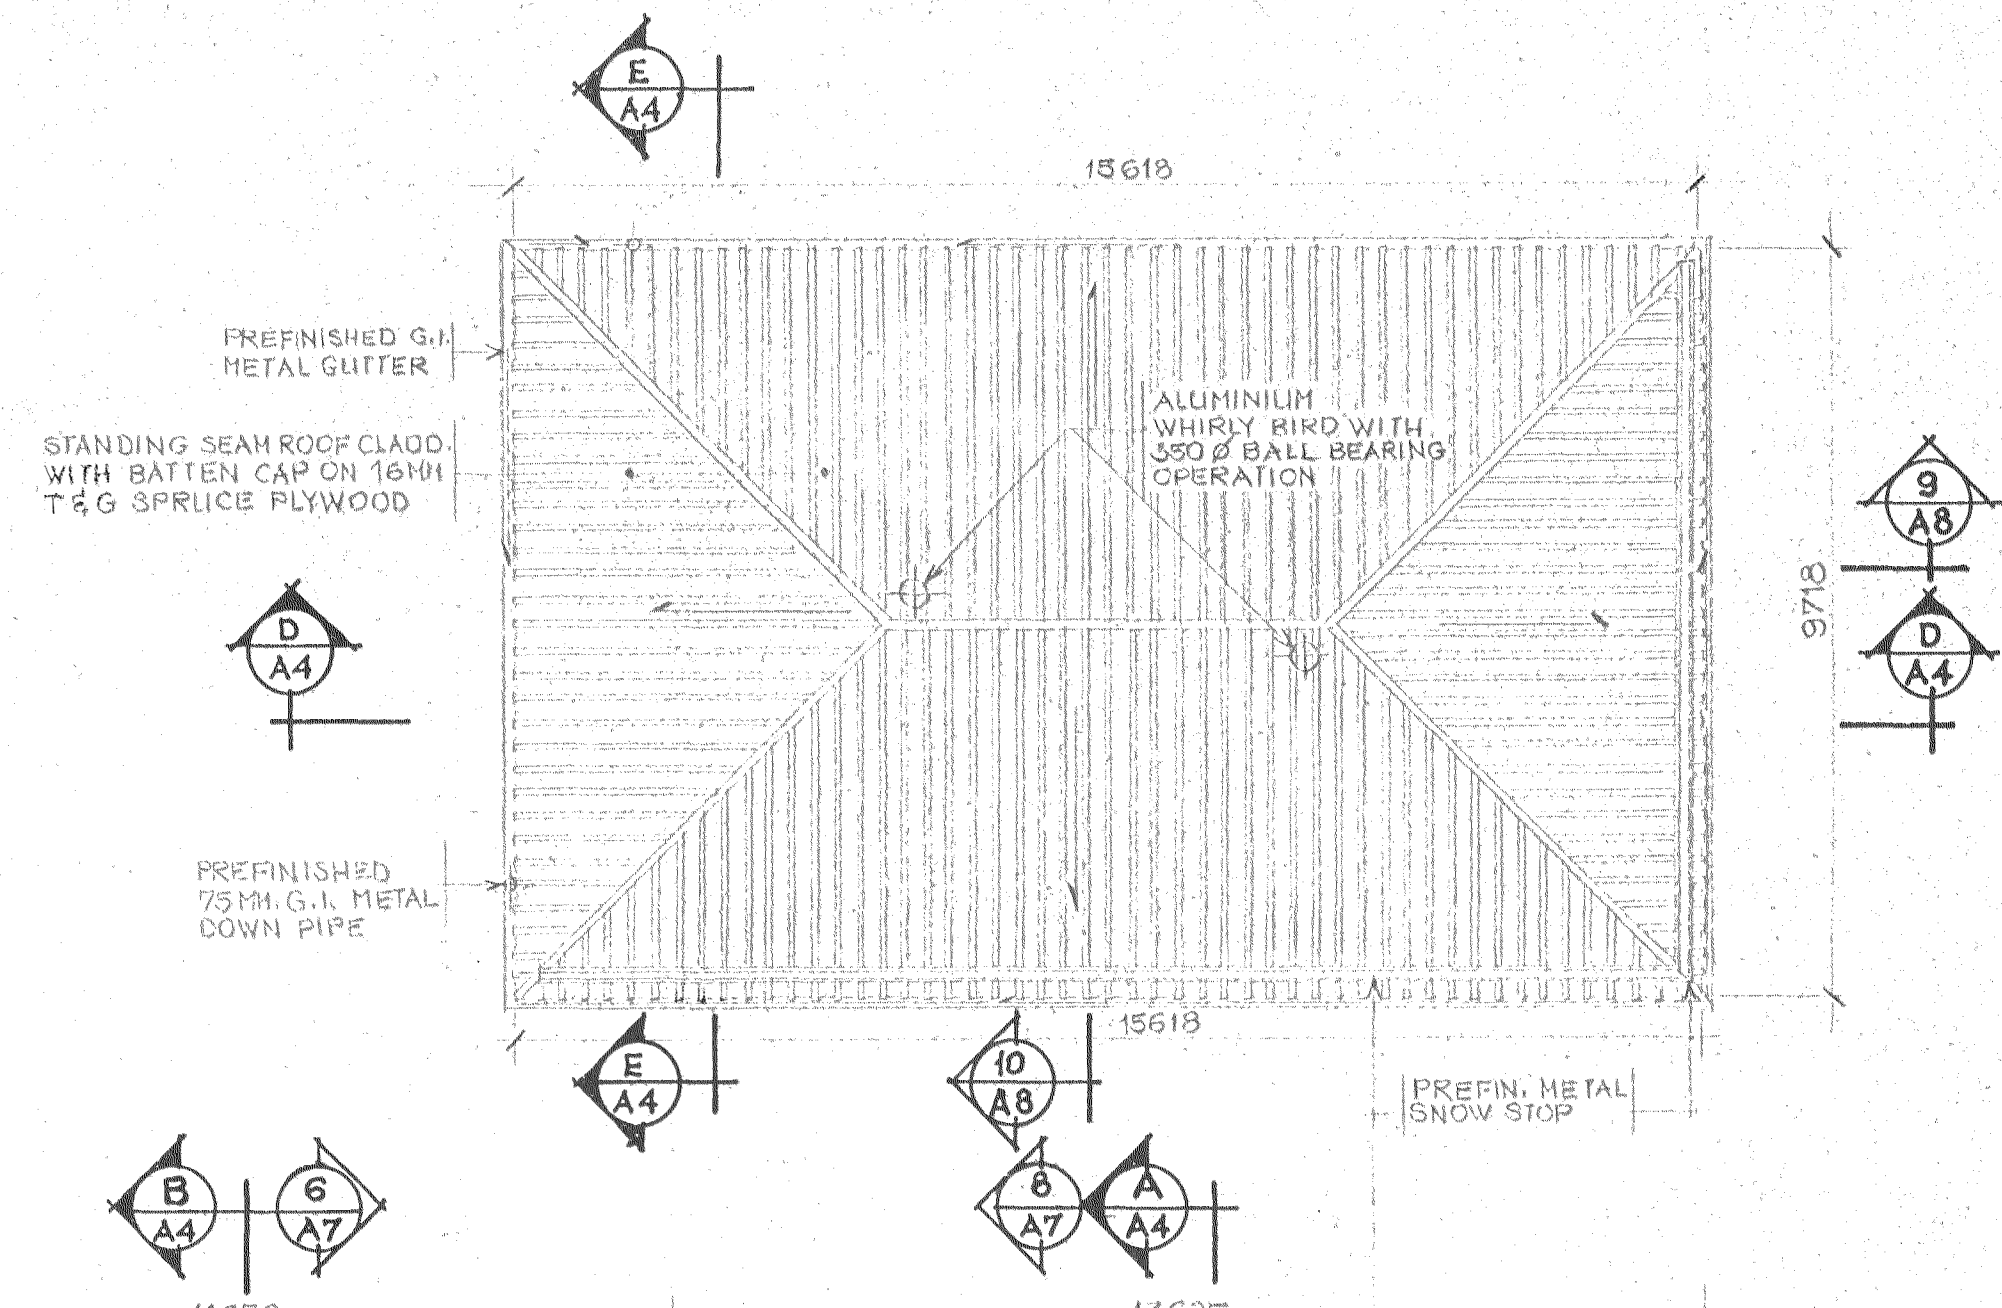

ROOF PLAN
 SCALE 1 : 100

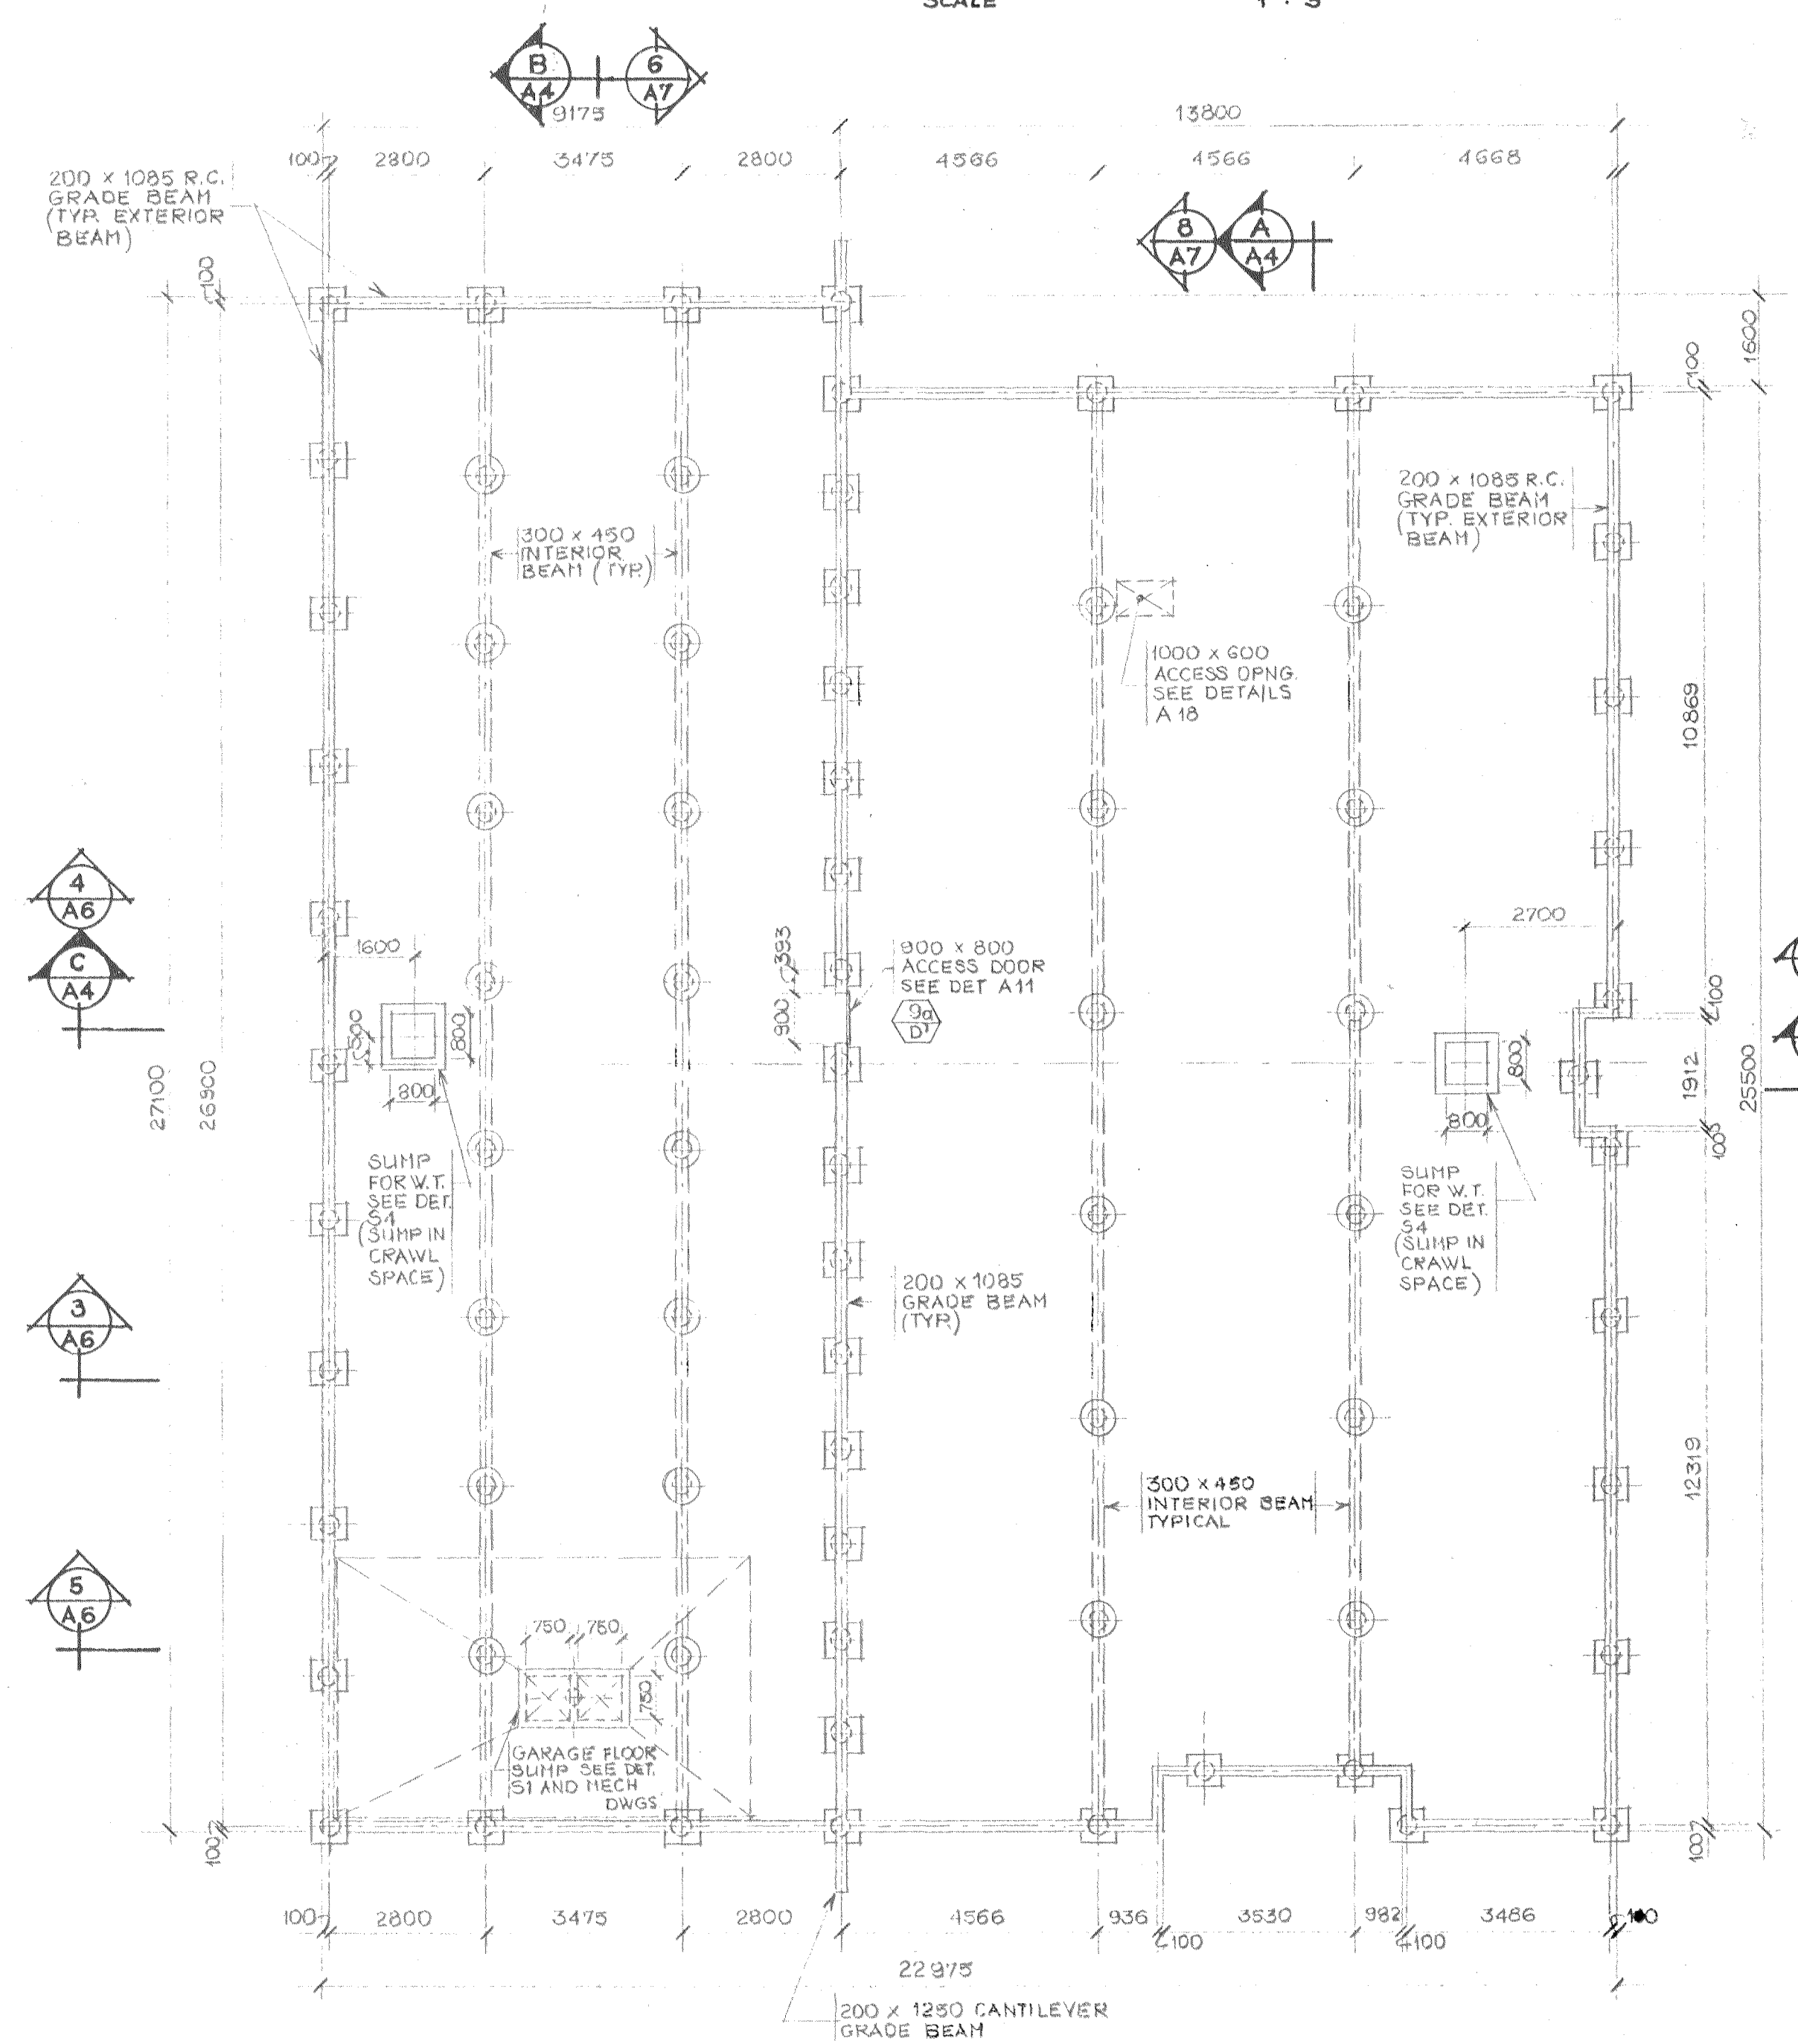

CRAWL SPACE FLOOR PLAN
 SCALE 1 : 100

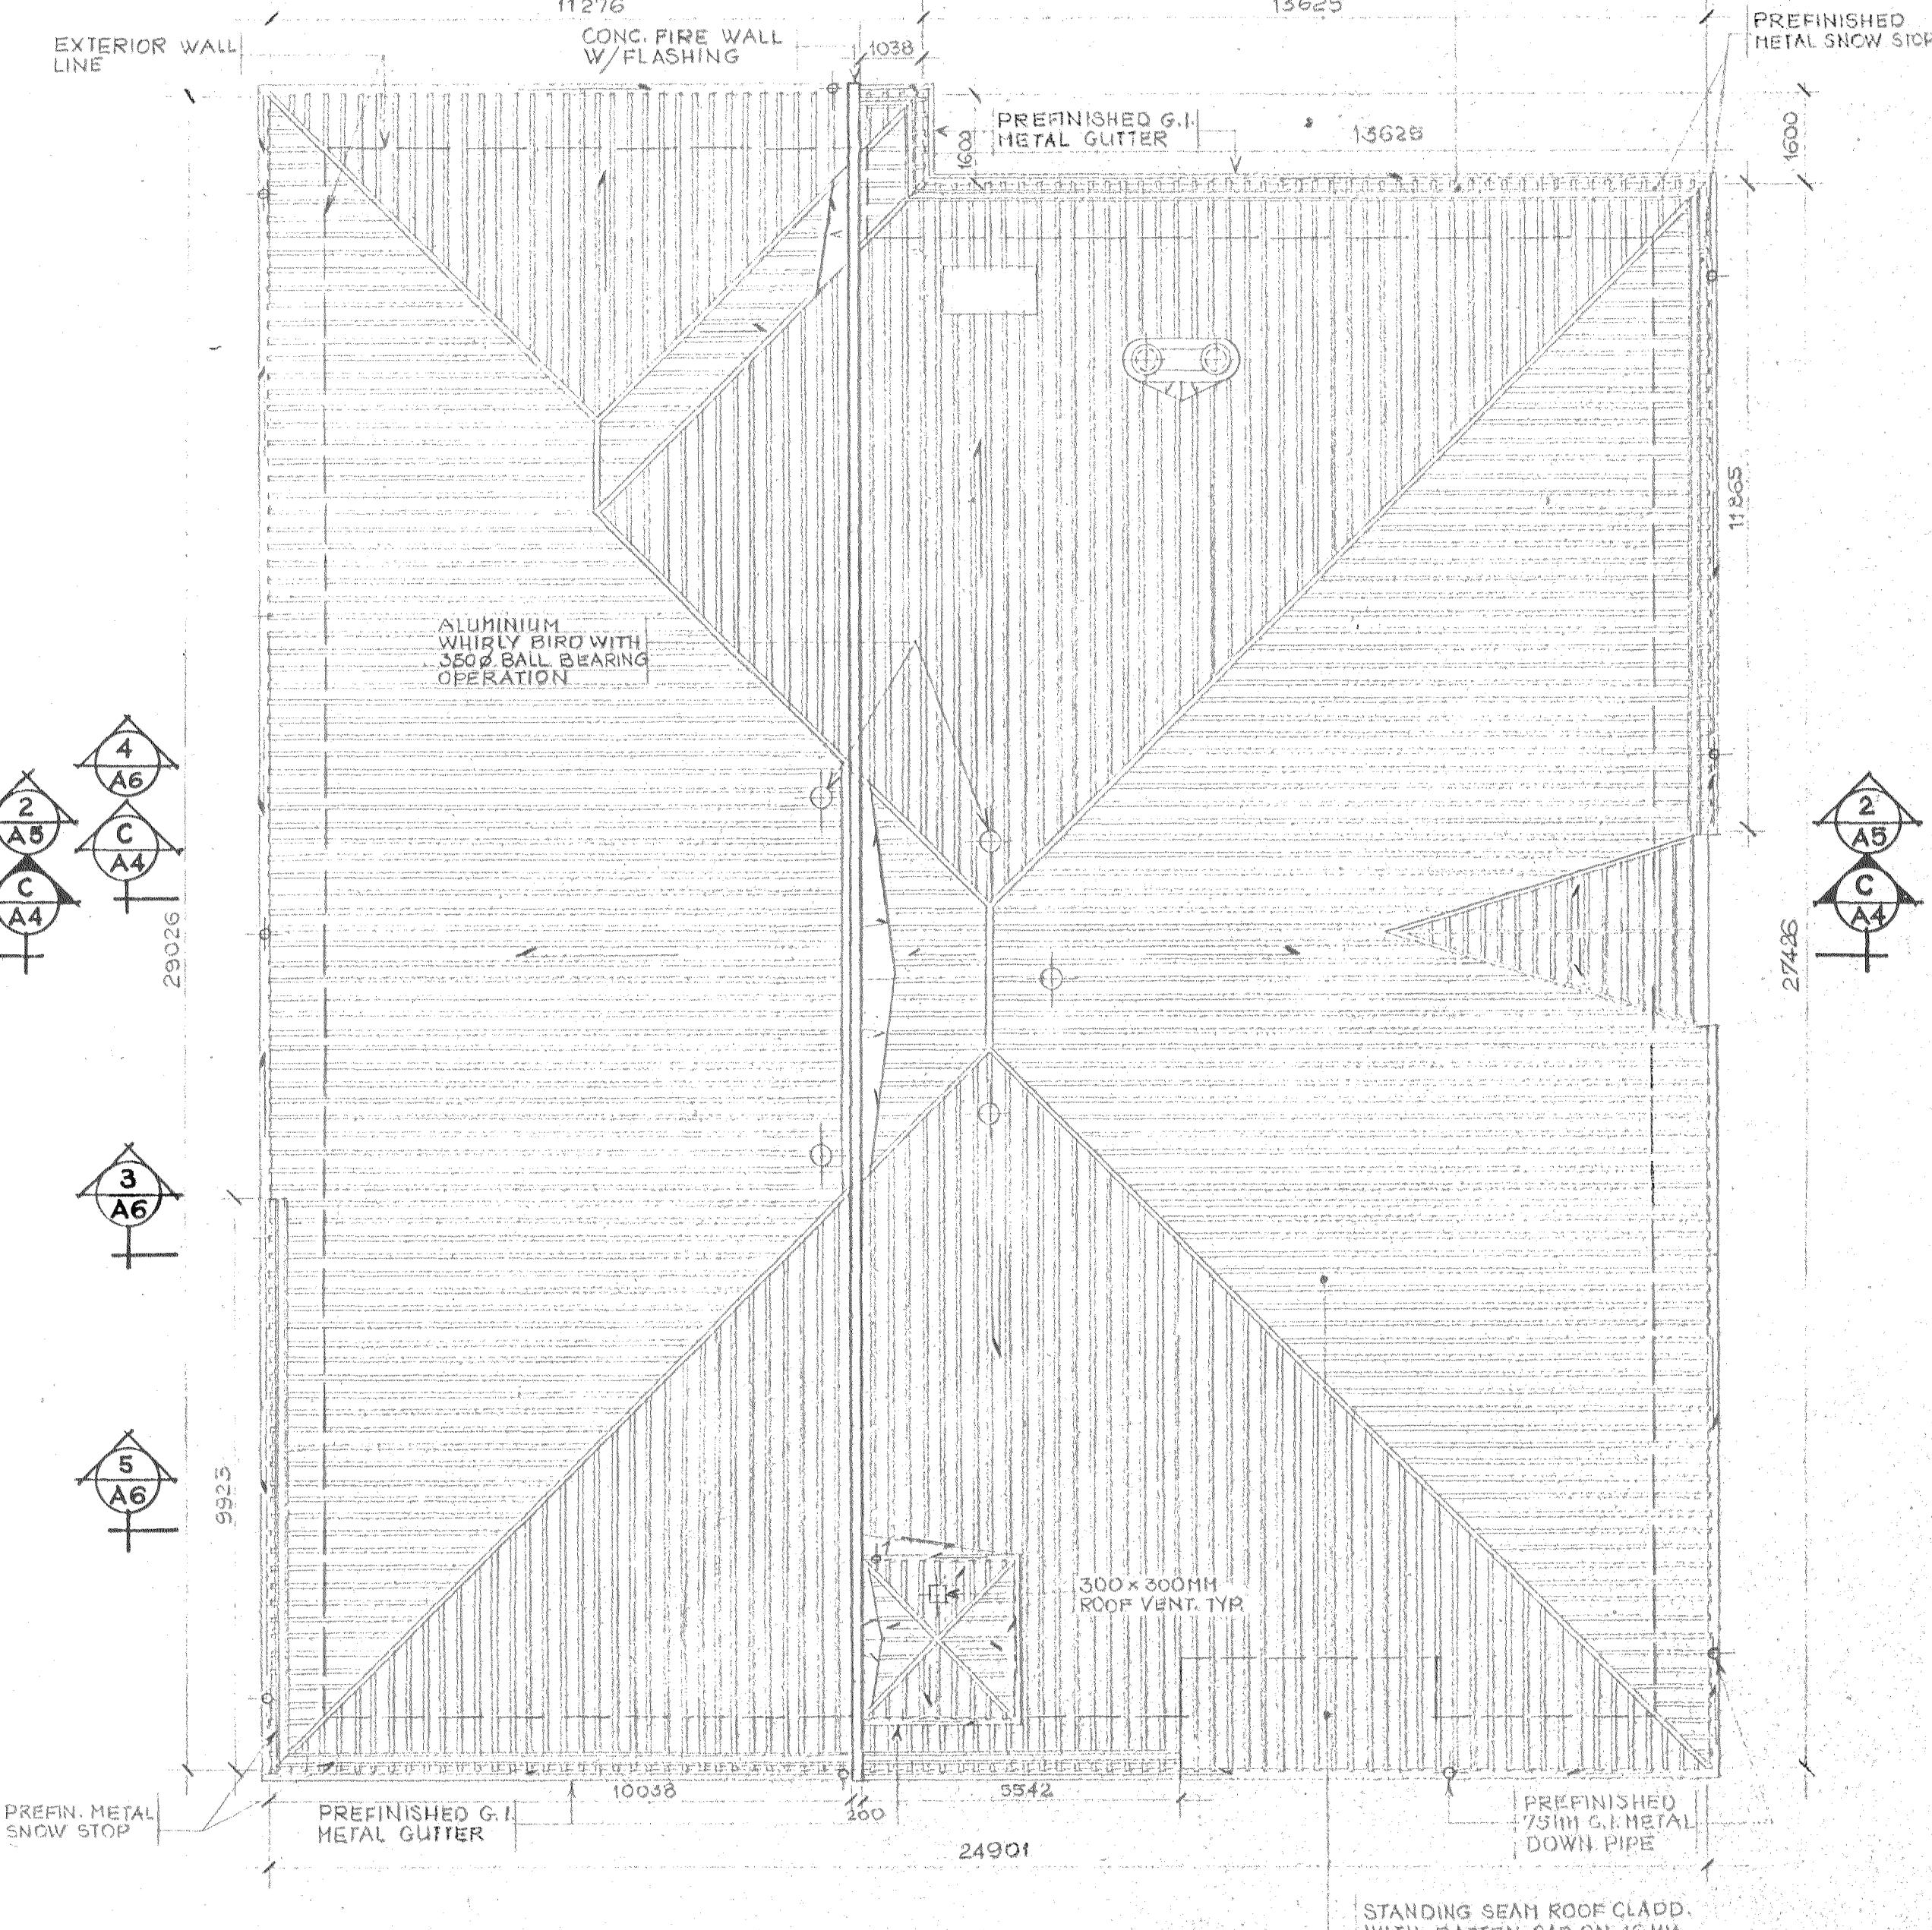

ROOF PLAN
 SCALE 1 : 100

AS BUILT OCT. 1993

revisions	date												
<table border="1"> <tr> <td>A</td> <td>A detail no.</td> </tr> <tr> <td>B</td> <td>location drawing no.</td> </tr> <tr> <td>C</td> <td>drawing no.</td> </tr> </table>	A	A detail no.	B	location drawing no.	C	drawing no.	<table border="1"> <tr> <td>A</td> <td>project</td> </tr> <tr> <td>B</td> <td>location</td> </tr> <tr> <td>C</td> <td>drawing no.</td> </tr> </table>	A	project	B	location	C	drawing no.
A	A detail no.												
B	location drawing no.												
C	drawing no.												
A	project												
B	location												
C	drawing no.												

project ASSUMPTION ALBERTA

drawing CRAWL SPACE & ROOF PLANS

designed	conçu
date	
drawn	dessiné
date	
reviewed	examiné
date	
approved	approuvé
date	

Tender Soumission
 PWC Project Manager Administrateur de projets TPC
 project number 623910 no. du projet
 drawing no. W-A21 no. du dessin

