






WILLIAM HNIIDIAN ARCHITECT LTD.  
 PERMIT No. 35  
 ISSUED PURSUANT TO THE ARCHITECTS ACT

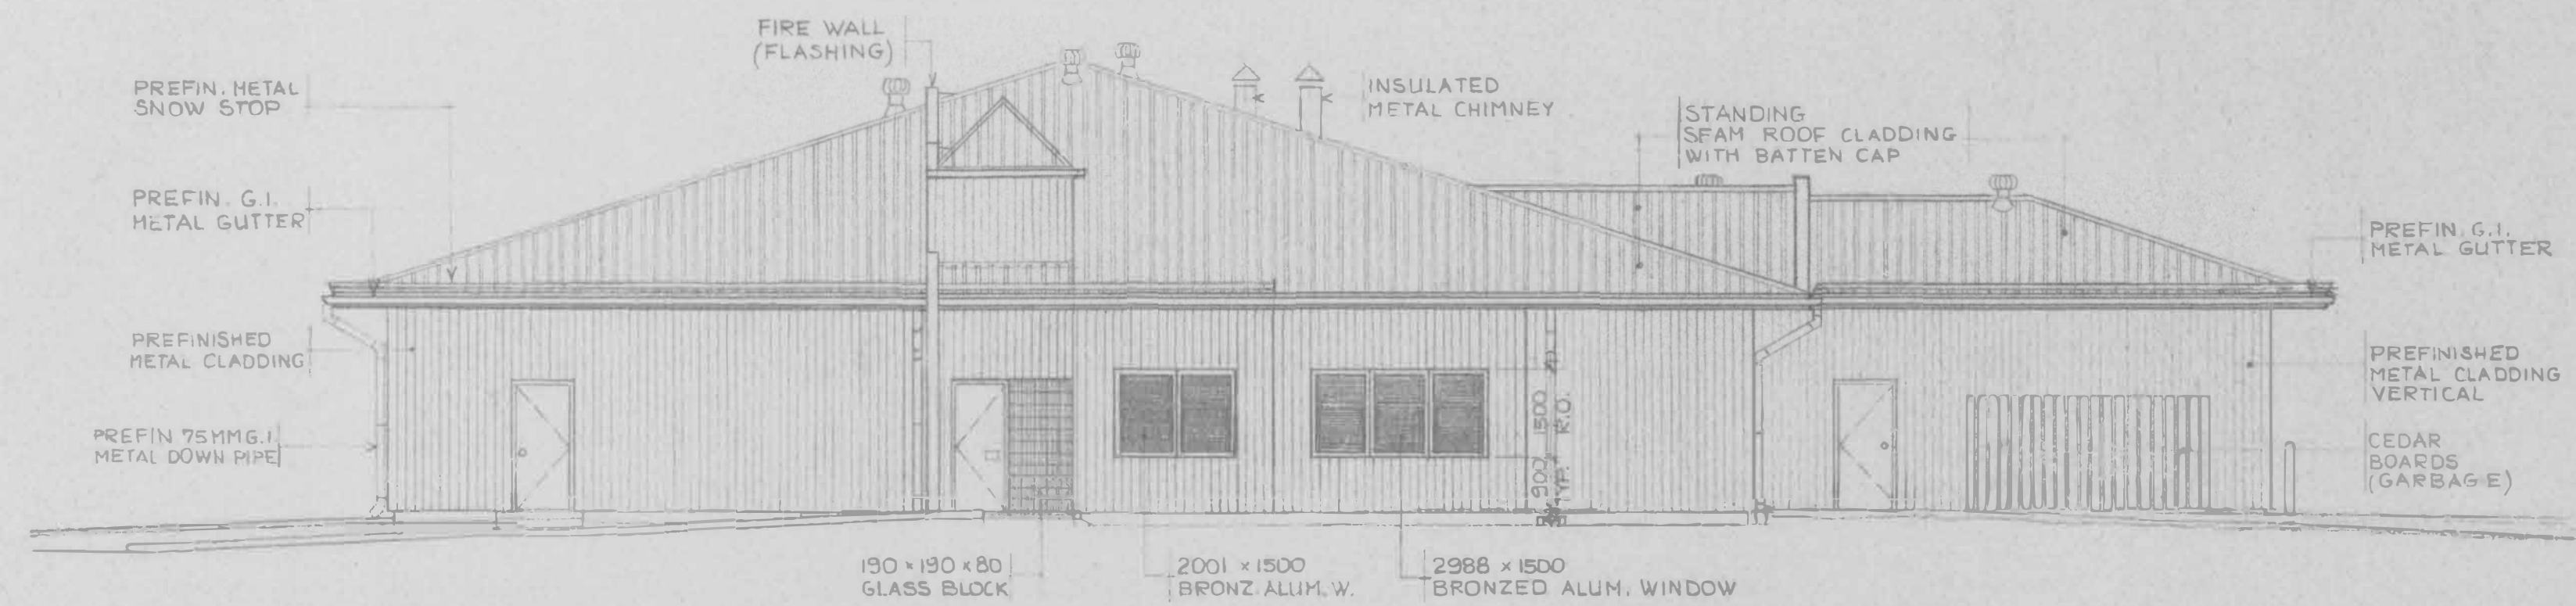


**SOUTH ELEVATION**  
 SCALE 1:100

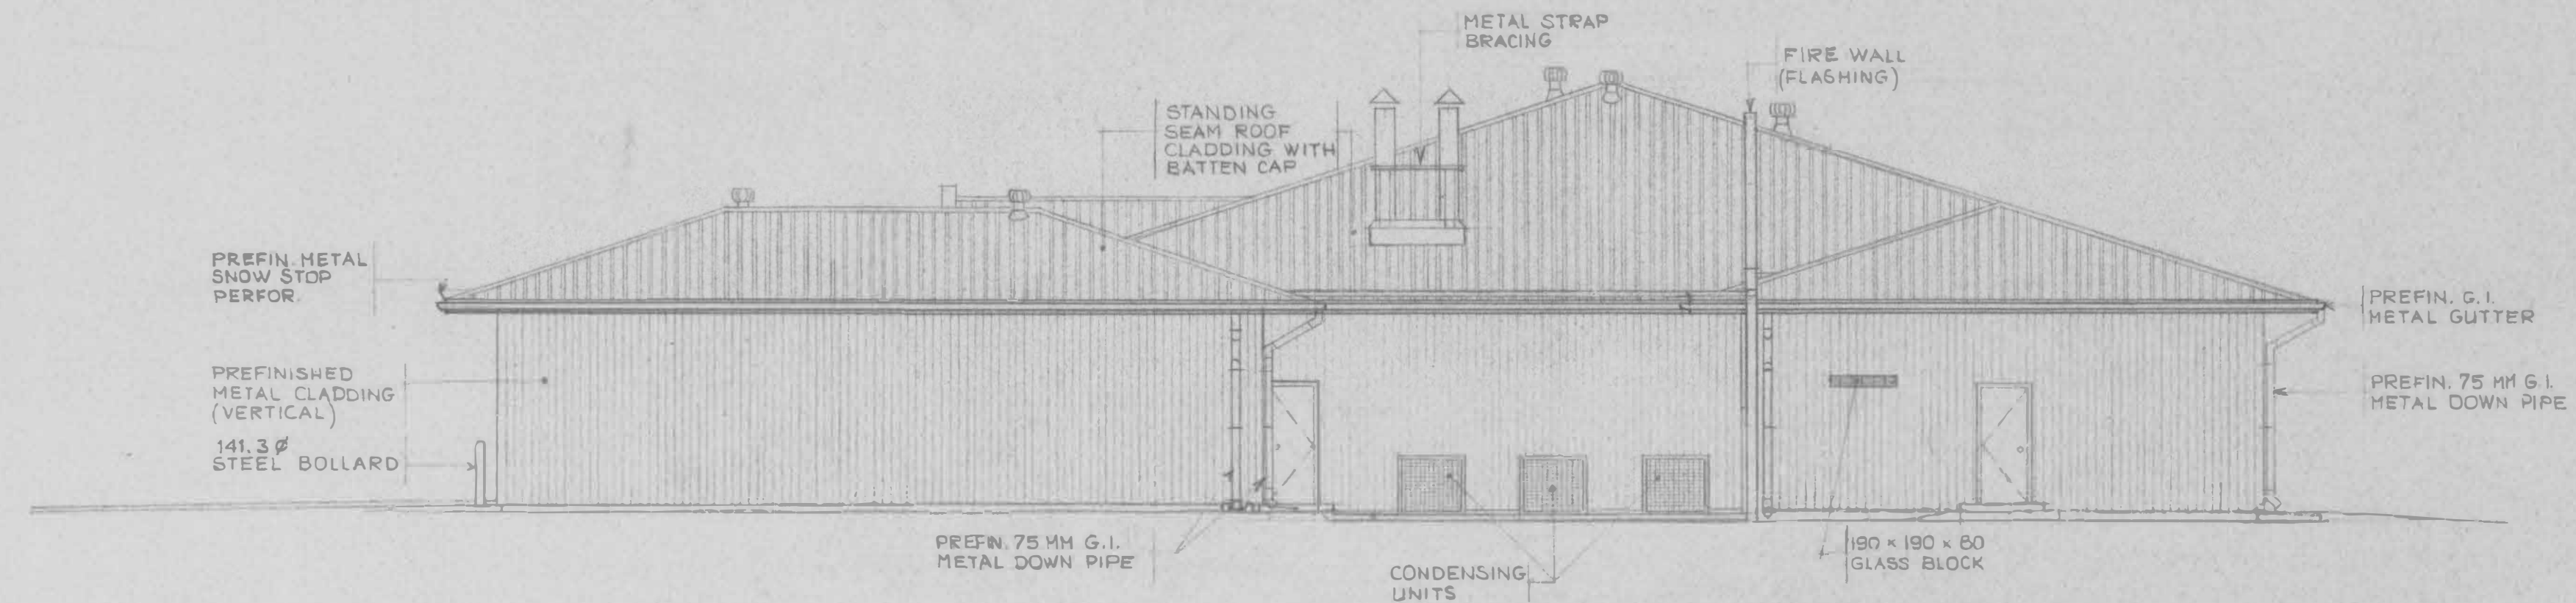

**NORTH ELEVATION**  
 SCALE 1:100

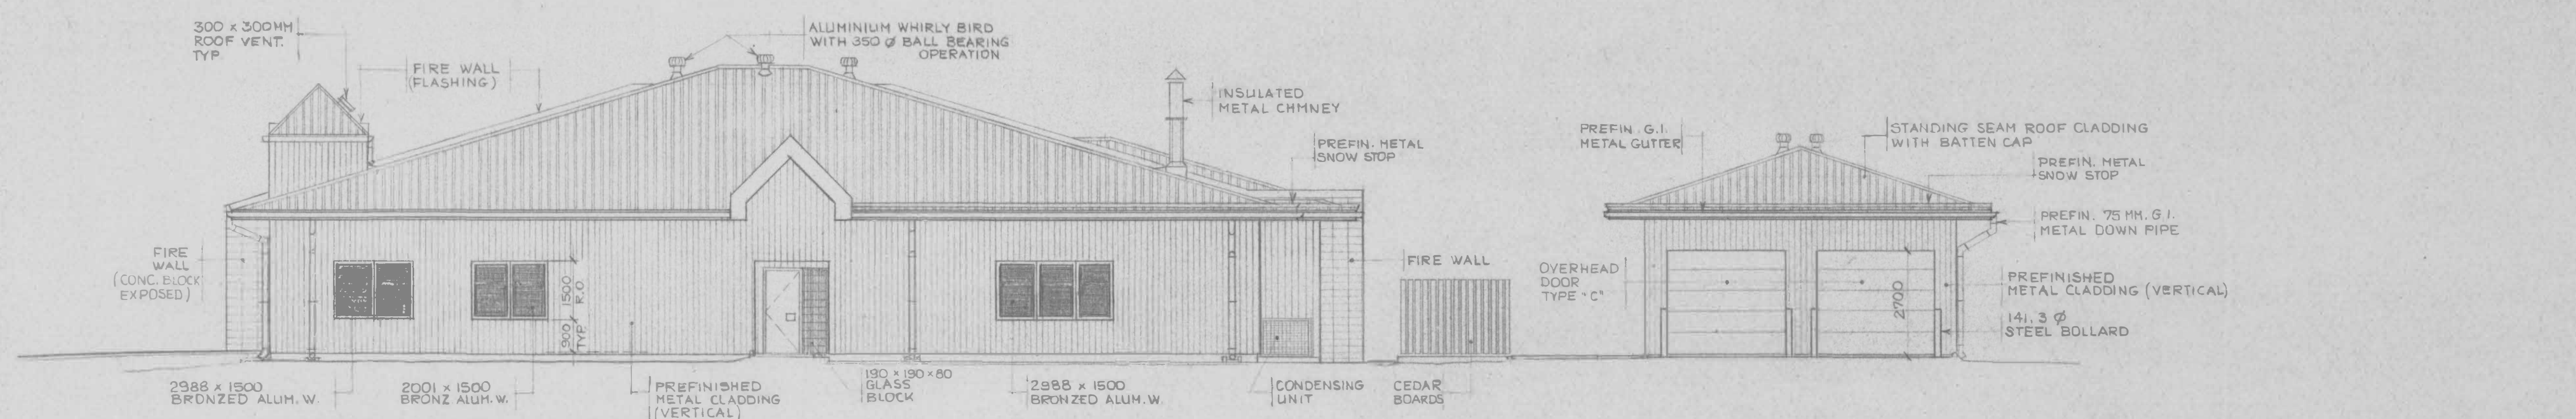

**EAST ELEVATION**  
 SCALE 1:100

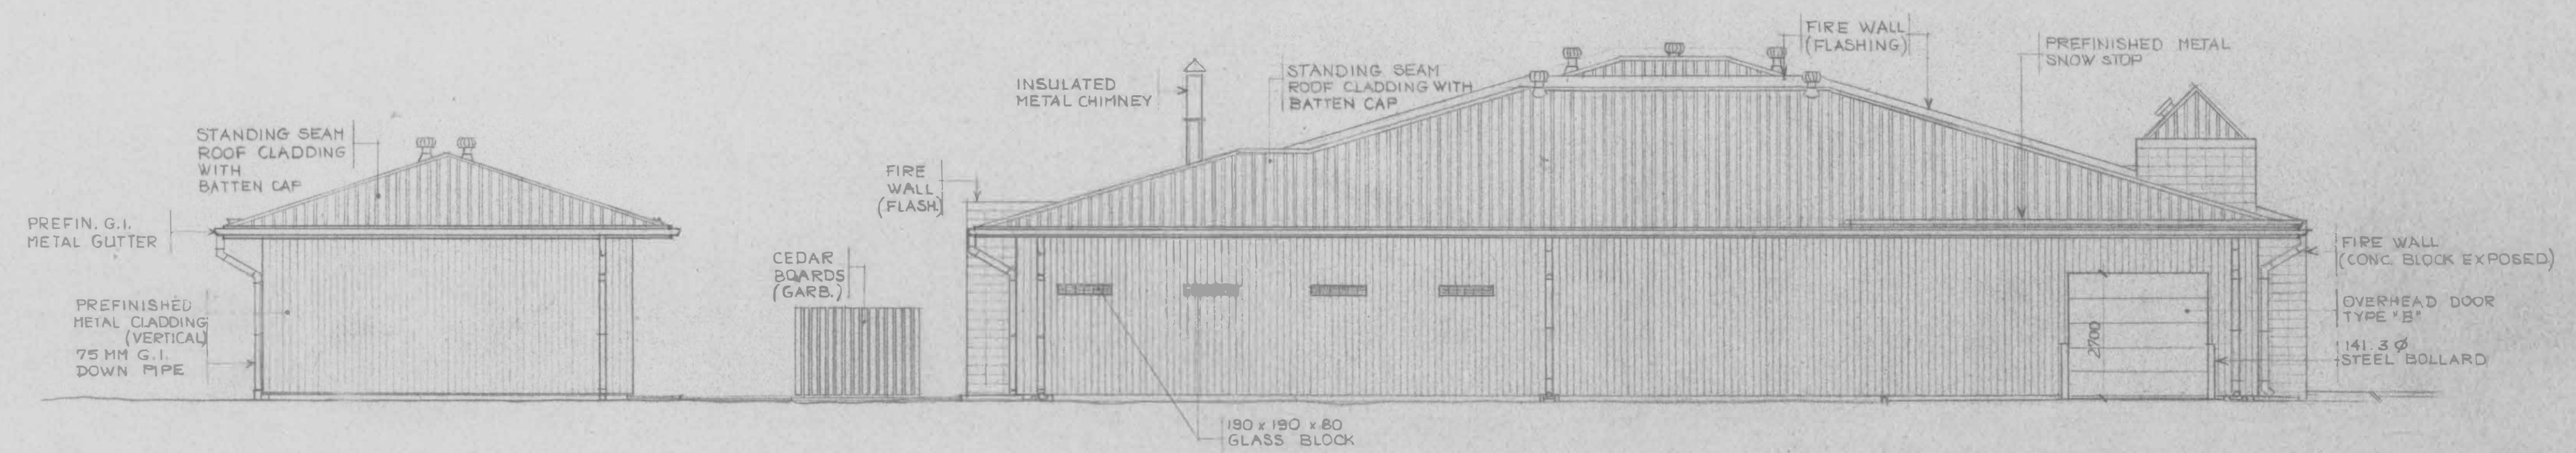

**WEST ELEVATION**  
 SCALE 1:100

AS BUILT OCT. 1993

revisions	date

A detail no. no. du détail	A
B location drawing no. sur dessin no.	BC
C drawing no. dessin no.	

project ASSUMPTION project ALBERTA

drawing BUILDING ELEVATIONS dessin

designed	conçu
date	
drawn	dessiné
date	
reviewed	examiné
date	
approved	approuvé
date	
Tender	Soumission
PWC Project Manager	Administrateur de projets TPC
project number 623910	no. du projet
drawing no. W-A-3	no. du dessin

