







GENERAL CHARACTERISTICS



LENGTH, MOLDED ..... 47'-11 7/8"  
LENGTH OVER FENDERS..... 48.27'  
LENGTH, WATERLINE ..... 42'-11'  
BEAM, MOLDED ..... 14'-0"  
DRAFT APPENDED ..... 4.71'  
HOISTING WEIGHT ..... 38 398 LBS  
MAXIMUM SPEED, SEA STATE 0 ..... 25 KTS. MINIMUM  
CONTINUOUS SPEED, FULL LOAD, SEA STATE 2 ..... 22 KTS.  
RANGE AT MAXIMUM SPEED, SEA STATE 0 ..... 200 NM  
PROPULSION MACHINERY ..... TWIN MARINE DIESELS, 450 BHP/EACH  
PROPELLERS ..... TWIN, FIXED PITCH, 4-BLADE  
ACCOMMODATION: CREW ..... 4  
SURVIVORS ..... 5

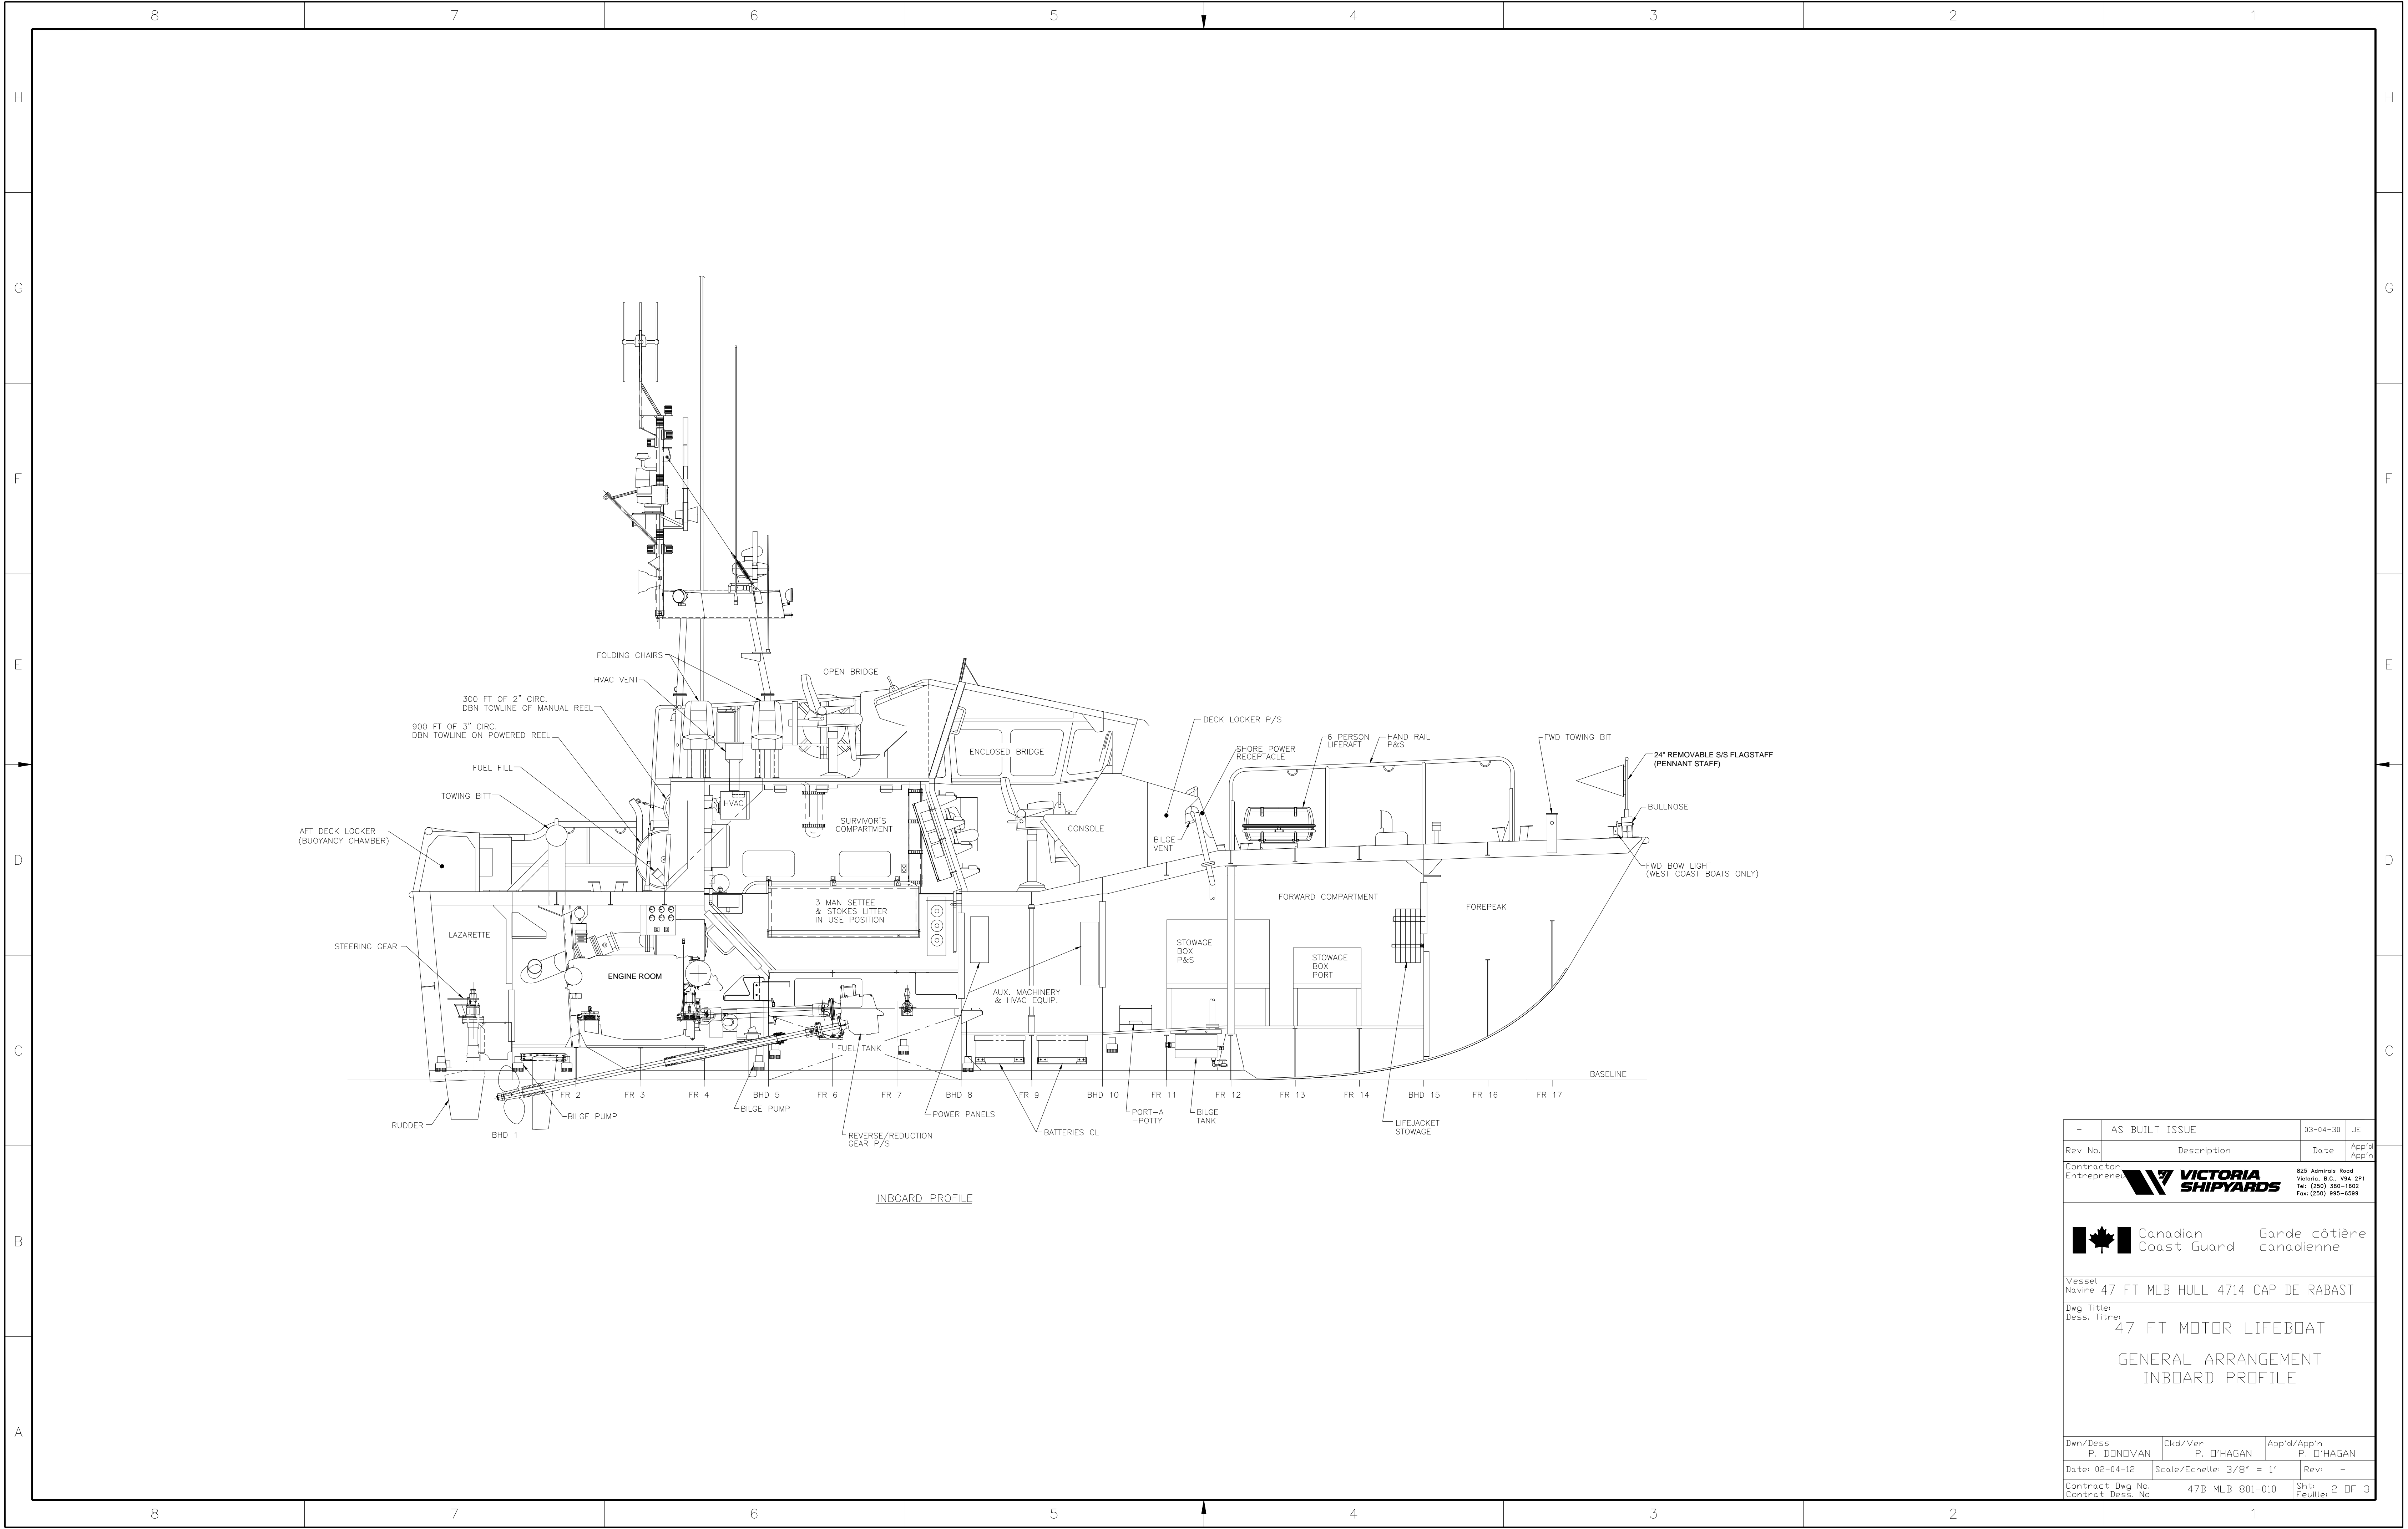-	AS BUILT ISSUE	03-04-30	JJC
Rev No.	Description	Date	App'd
Contractor Entrepreneur		825 Admirals Road Victoria, B.C. V8A 2P1 Tel: (250) 360-1602 Fax: (250) 995-4599	App'n
 Canadian Coast Guard    Garde côtière canadienne			
Vessel Navire 47 FT MLB HULL 4714 CAP DE RABAST			
Dwg Title: Dess. Titre: 47 FT MOTOR LIFEBOAT			
GENERAL ARRANGEMENT GENERAL CHARACTERISTICS OUTBOARD PROFILE			
Dwn/Dess P. DONOVAN	Ckd/Ver P. O'HAGAN	App'd/App'n P. O'HAGAN	
Date: 02-04-12	Scale/Echelle: 3/8" = 1'	Revi: -	
Contract Dwg No. Contract Dess. No	47B MLB 801-010	Sh't Feuille: 1 OF 3	

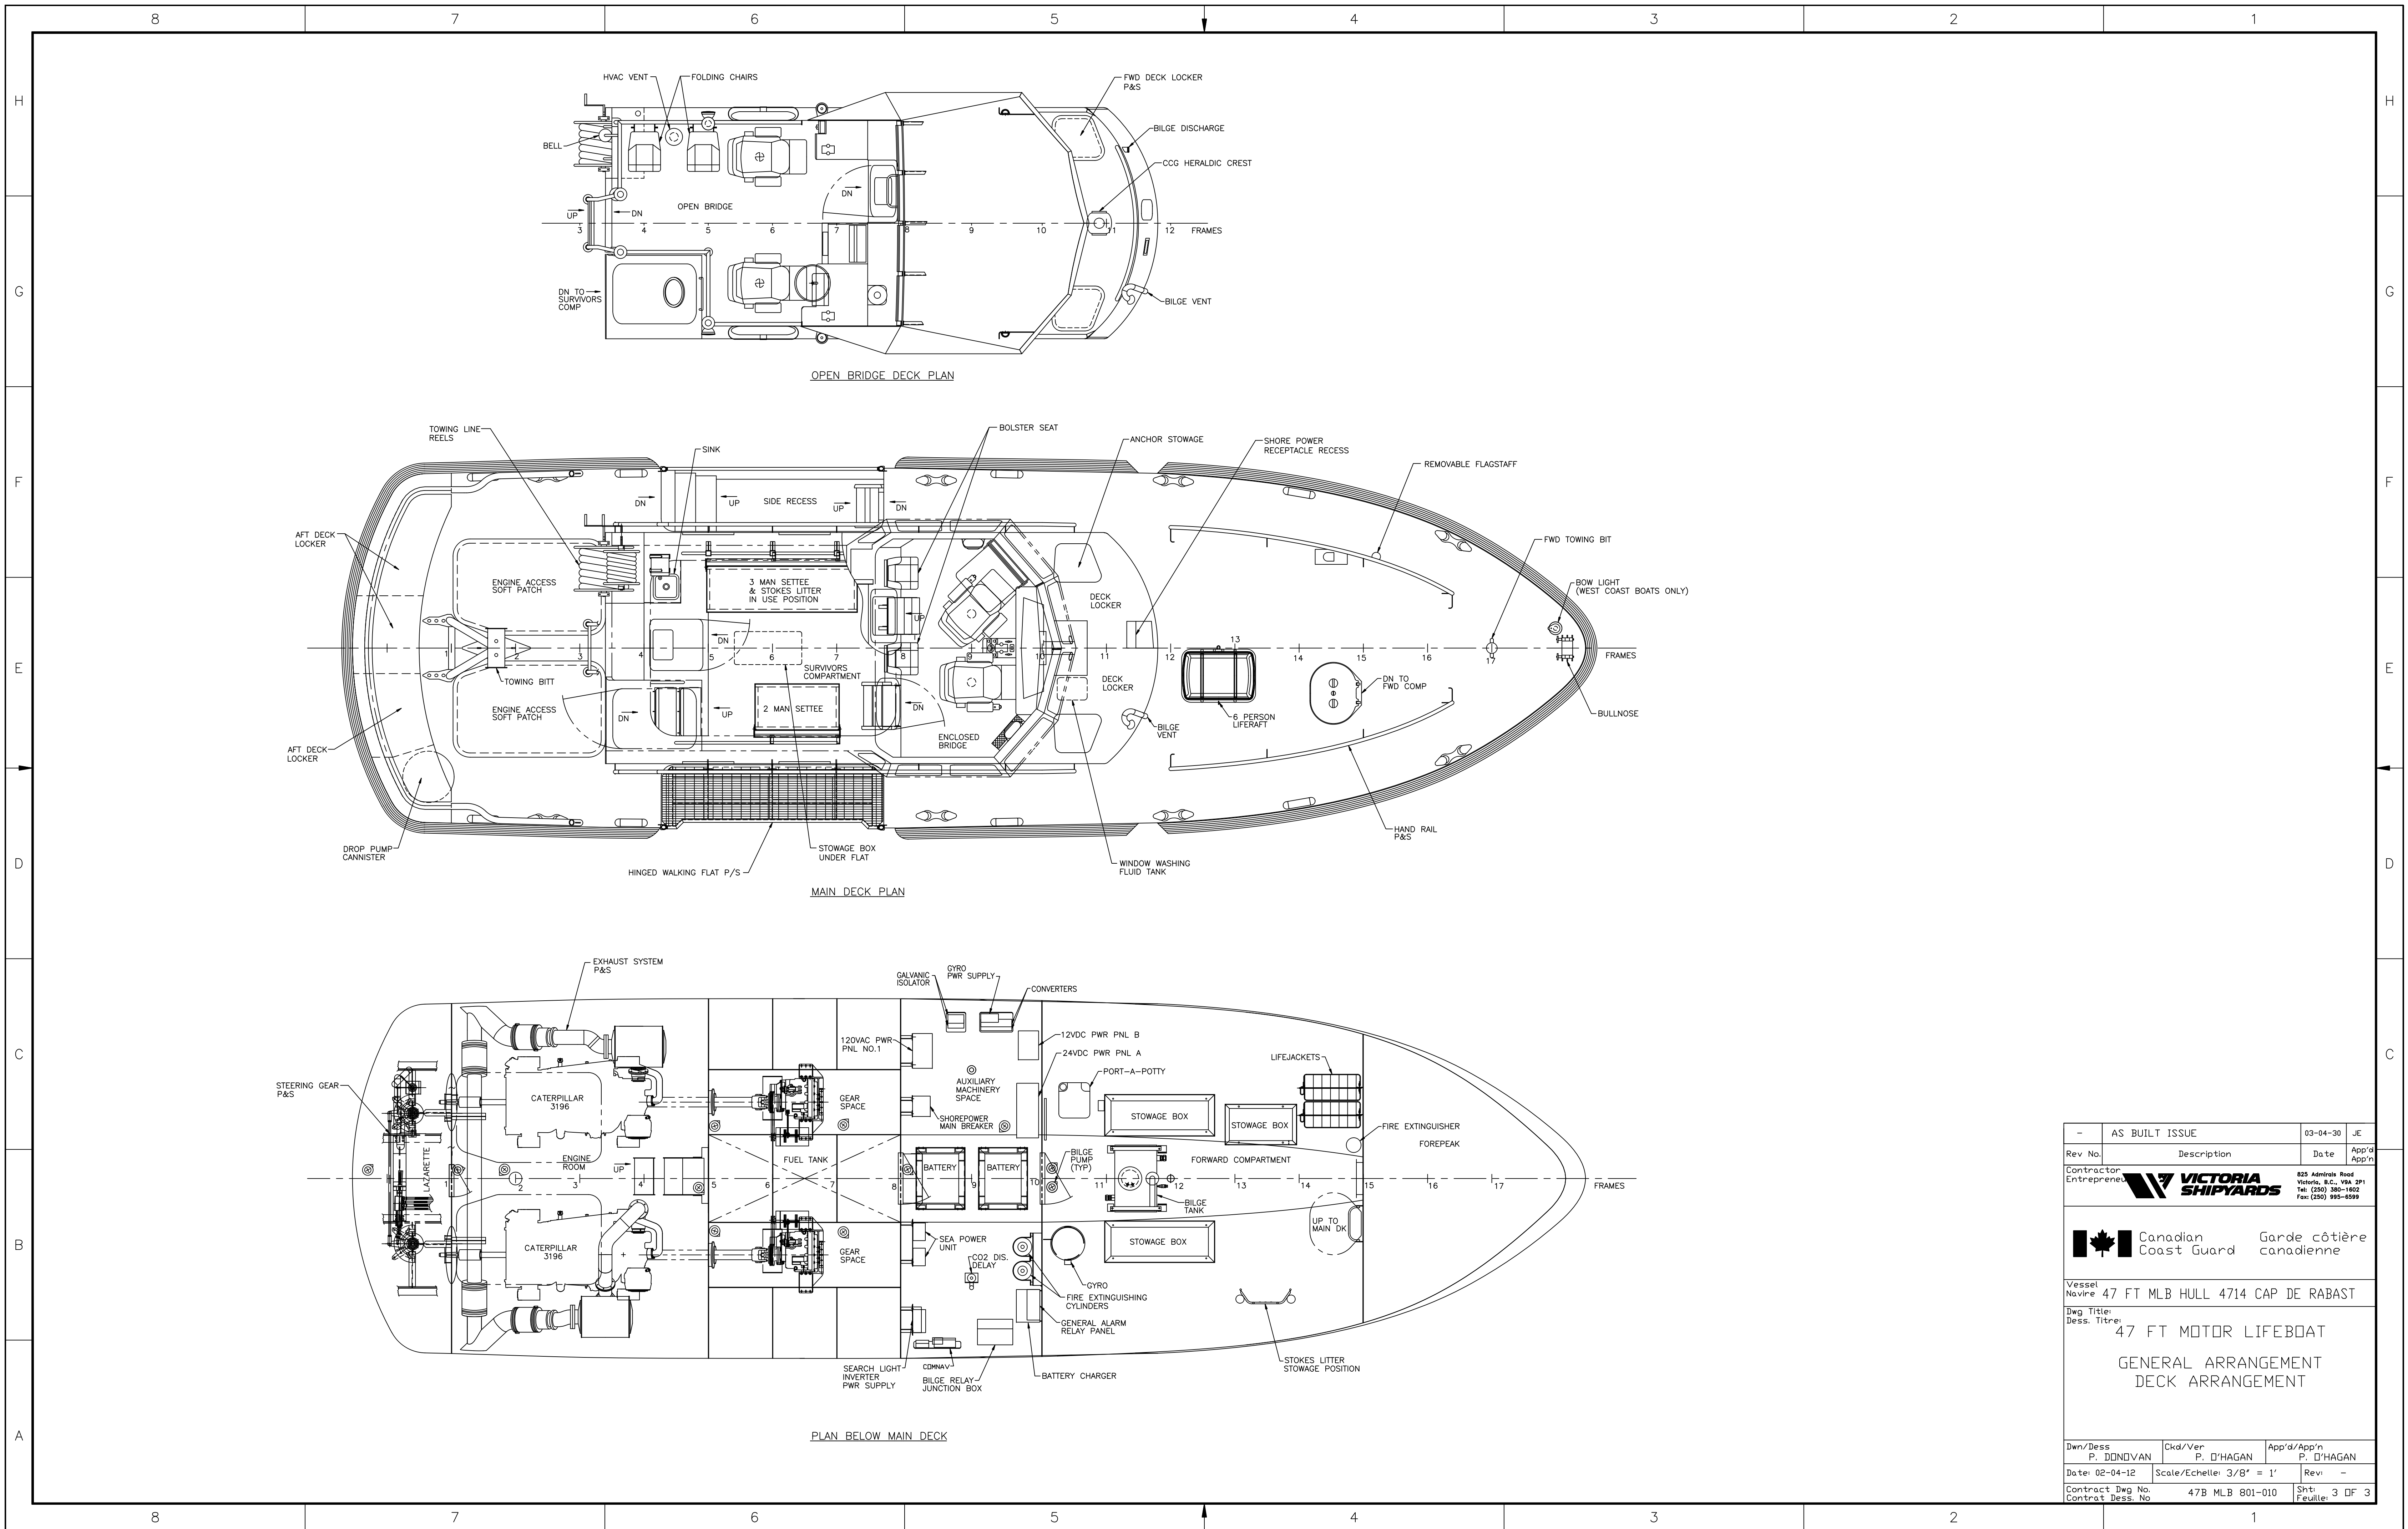

-	AS BUILT ISSUE	03-04-30	JE
Rev No.	Description	Date	App'd App'n
<div>Contractor Entrepreneur</div> <div> <b>VICTORIA SHIPYARDS</b></div> <div>825 Admirals Road Victoria, B.C., V8A 2P1 Tel: (250) 385-1602 Fax: (250) 995-6599</div>			
<div> Canadian Coast Guard</div> <div>Garde ctiere canadienne</div>			
Vessel Navire 47 FT MLB HULL 4714 CAP DE RABAST			
Dwg Title: Dess. Titre: 47 FT MOTOR LIFEBOAT			
GENERAL ARRANGEMENT INBOARD PROFILE			
Dwn/Dess P. DONOVAN	Ckd/Ver P. O'HAGAN	App'd/App'n P. O'HAGAN	
Date: 02-04-12	Scale/Echelle: 3/8" = 1'	Rev: -	
Contract Dwg No. Contract Dess. No.	47B MLB 801-010	Sht. Feuille: 2 OF 3	



-	AS BUILT ISSUE	03-04-30	JC
Rev No.	Description	Date	App'd
Contractor Entrepreneur	 VICTORIA SHIPYARDS	825 Admirals Road Victoria, B.C. V8A 2P1 Tel: (250) 360-1602 Fax: (250) 995-6599	App'n
 Canadian Coast Guard Garde ctire canadienne			
Vessel Navire 47 FT MLB HULL 4714 CAP DE RABAST			
Dwg Title: Dess. Titre: 47 FT MOTOR LIFEBOAT			
GENERAL ARRANGEMENT DECK ARRANGEMENT			
Dwn/Dess P. DONOVAN	Ckd/Ver P. O'HAGAN	App'd/App'n P. O'HAGAN	
Date: 02-04-12	Scale/Echelle: 3/8" = 1'	Rev: -	
Contract Dwg No. Contract Dess. No	47B MLB 801-010	Sh't Feuille: 3 OF 3	