




RV DAVID THOMPSON
FIRE PROTECTION PLAN

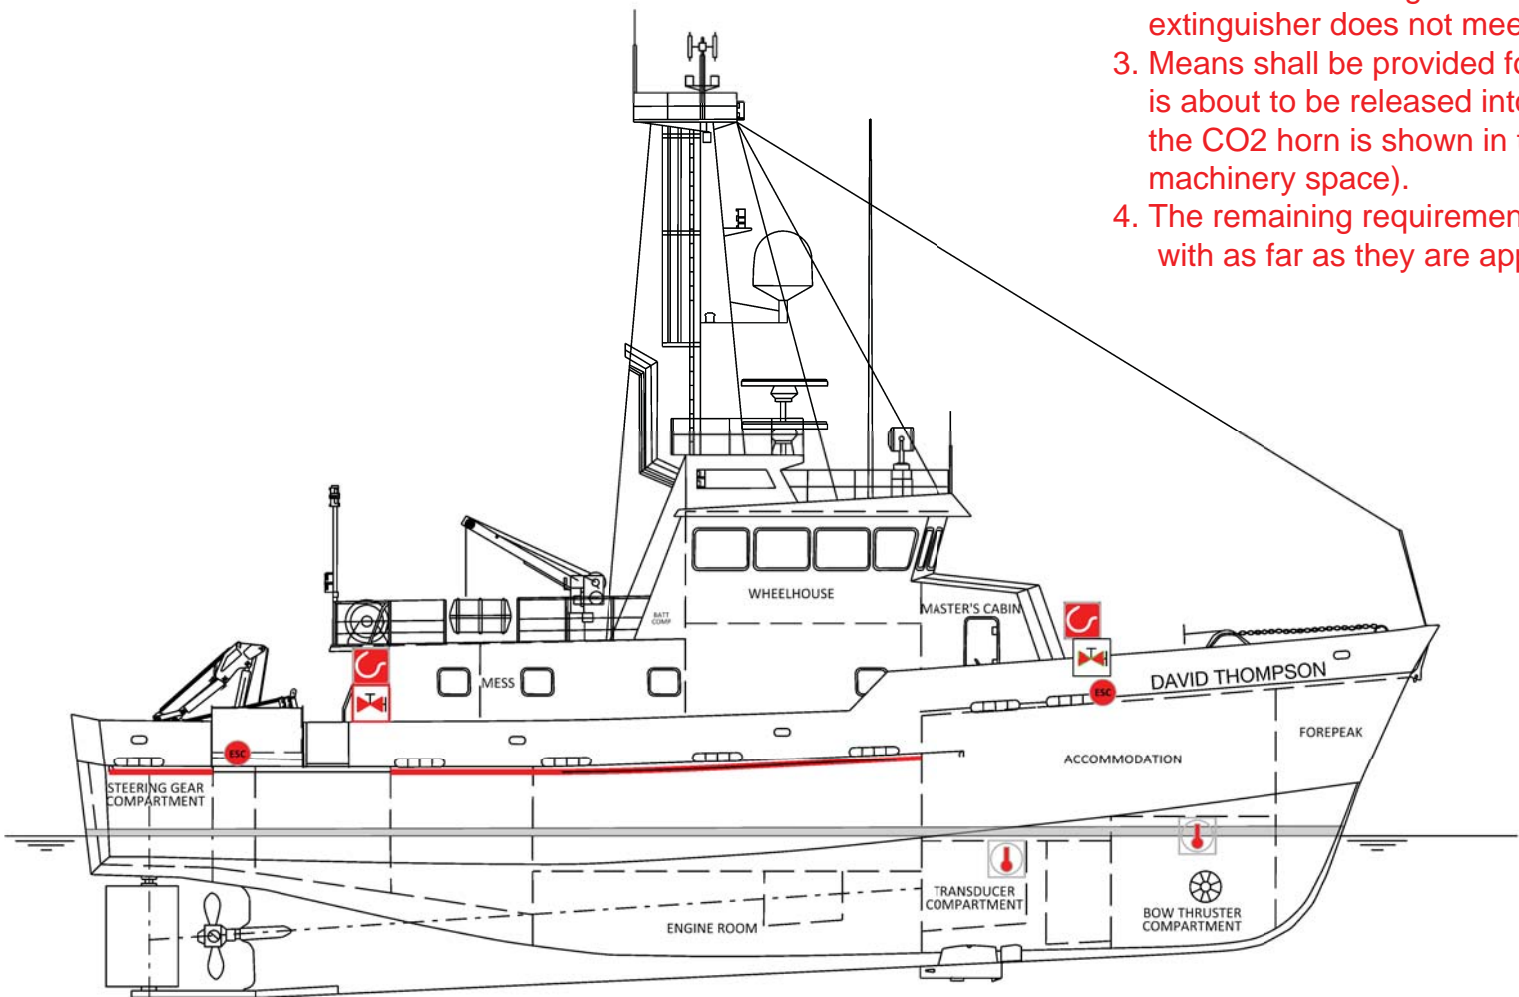


PROFILE STARBOARD SIDE

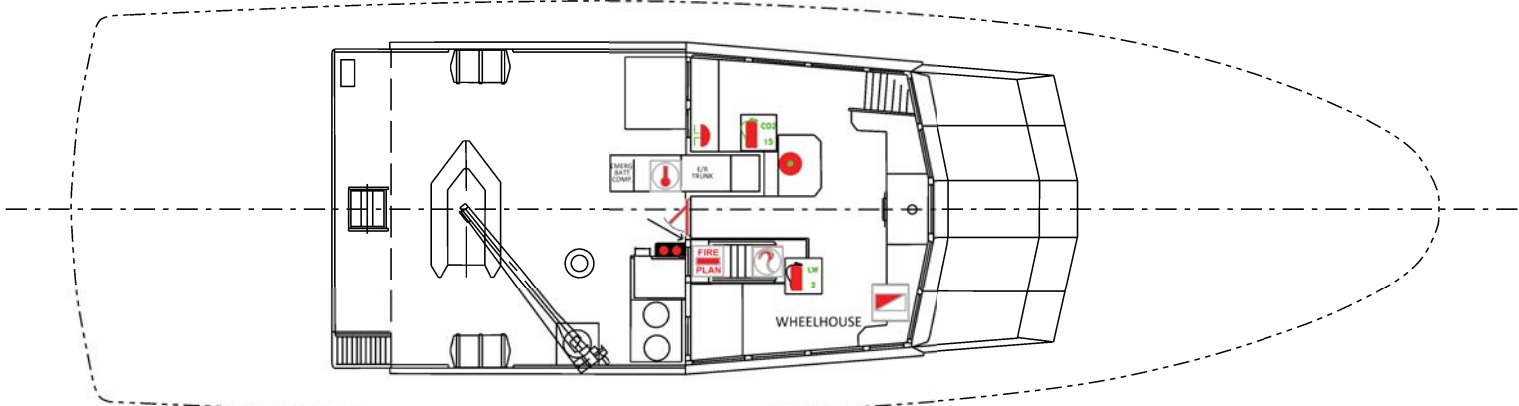

WHEELHOUSE DECK

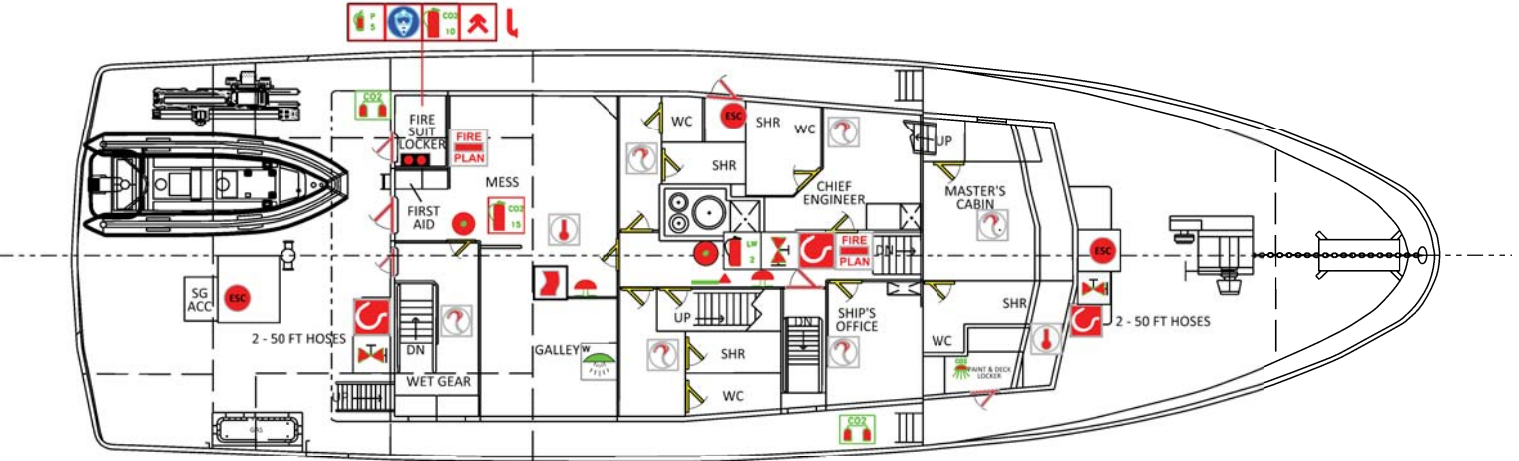

MAIN DECK

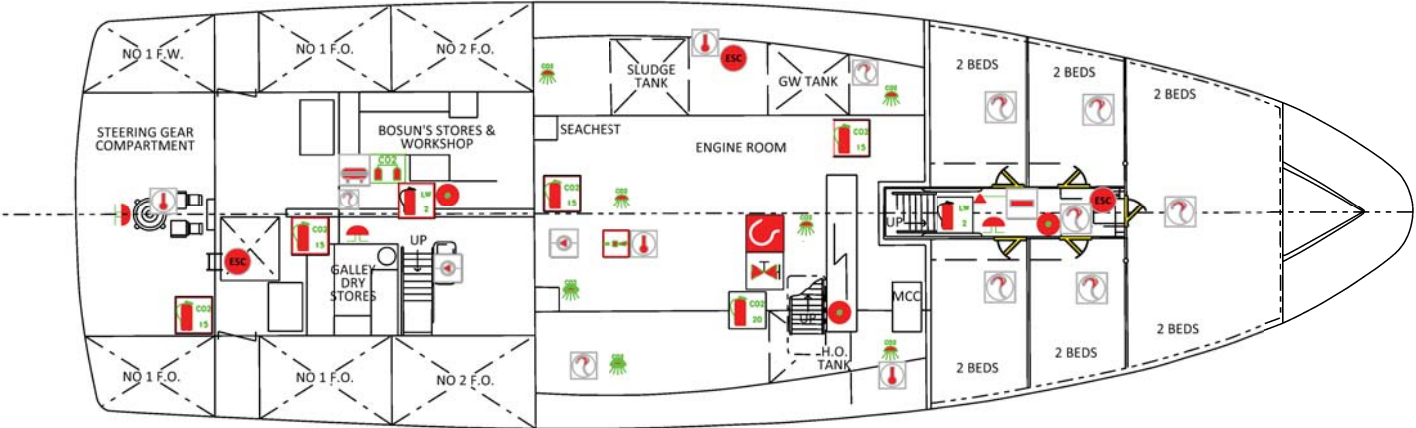

BELOW DECK

FIRE PROTECTION EQUIPMENT

	FIRE HYDRANT W/ADAPTOR & SPINNER
	FIRE HOSE - REINFORCED FAB. W/NCZZLE
	FIRE HOSE - OIL & CHEMICAL RESISTANT
	CO ₂ FIRE EXTINGUISHER
	AFFF EXTINGUISHER
	DRY CHEMICAL EXTINGUISHER
	CO ₂ BULK CYLINDERS
	CO ₂ BULK RELEASE STATION
	CO ₂ BULK RELEASE HORN
	CO ₂ BULK OUTLETS
	RANGE HOOD SUPPRESSION SYSTEM
	2 FIRE BUCKETS WITH LANYARDS
	2 FOG EXTENSION NOZZLES
	FIRE AND LIFE SAVING PLAN POSTER
	MASTER CONTROL PANEL
	HEAT DETECTOR
	SMOKE DETECTOR - IONIZATION TYPE
	FIRE AXE
	PULL STATION - MANUAL
	FIRE ALARM BELL
	2 FIRE SUITS WITH LIFE LINE
	2 SCOTTS BA'S WITH EXTRA BOTTLES
	TYPE A FIRE DOOR
	TYPE B FIRE DOOR
	STEEL RATING A - O DECKHEAD
	FIRE PUMP
	FIRE BLANKET
	ESCAPE

RECEIVED
MARINE SAFETY
DATE: 2017- 09- 08
FILE: 8562-50026
TRANSPORT CANADA
PACIFIC REGION TMG

SUBJECT TO NOTATION IN RED | SOUS RESERVE DES ANNOTATIONS EN ROUGE



Transport Canada | Transports Canada

APPROVED - | APPROUVÉ

ON THE AUTHORITY OF THE CANADA SHIPPING ACT AND REGULATIONS MADE THEREUNDER. | EN VERTU DE LA LOI SUR LA MARINE MARCHANDE DU CANADA ET DES RÈGLEMENTS CONNEXES.

Peter Scolt

ON BEHALF OF THE MINISTER OF TRANSPORT. | POUR LE COMPTE DU MINISTRE DES TRANSPORTS.

11 SEP 2017

DATE

This document has been processed electronically and it is therefore valid without signature.
Ce document a été traité par voie électronique et il est par conséquent valide sans signature.

SUBJECT TO THE COMPLETED INSTALLATION BEING TO THE SATISFACTION OF THE ATTENDING MARINE SAFETY INSPECTOR

SOUS RÉSERVE DE L'INSTALLATION COMPLÉTÉE À LA SATISFACTION DE L'INSPECTEUR DE LA SÉCURITÉ MARITIME DÉSIGNANT

AS ARRANGEMENT ONLY

COMME UNE DISPOSITION D'EMSEMBLE SUELEMENT

AS AN EXISTING VESSEL

COMME NAVIRE EXISTANT

TRANSPORT CANADA | TRANSPORTS CANADA

RDIMS # 13301998

SGDDI #

SEE LETTER DATED

VOIR LA LETTRE DU

11 SEP 2017 RDIMS# 13306369