



115VAC & 24VDC PLC & GENIUS I/O POWER DISTRIBUTION

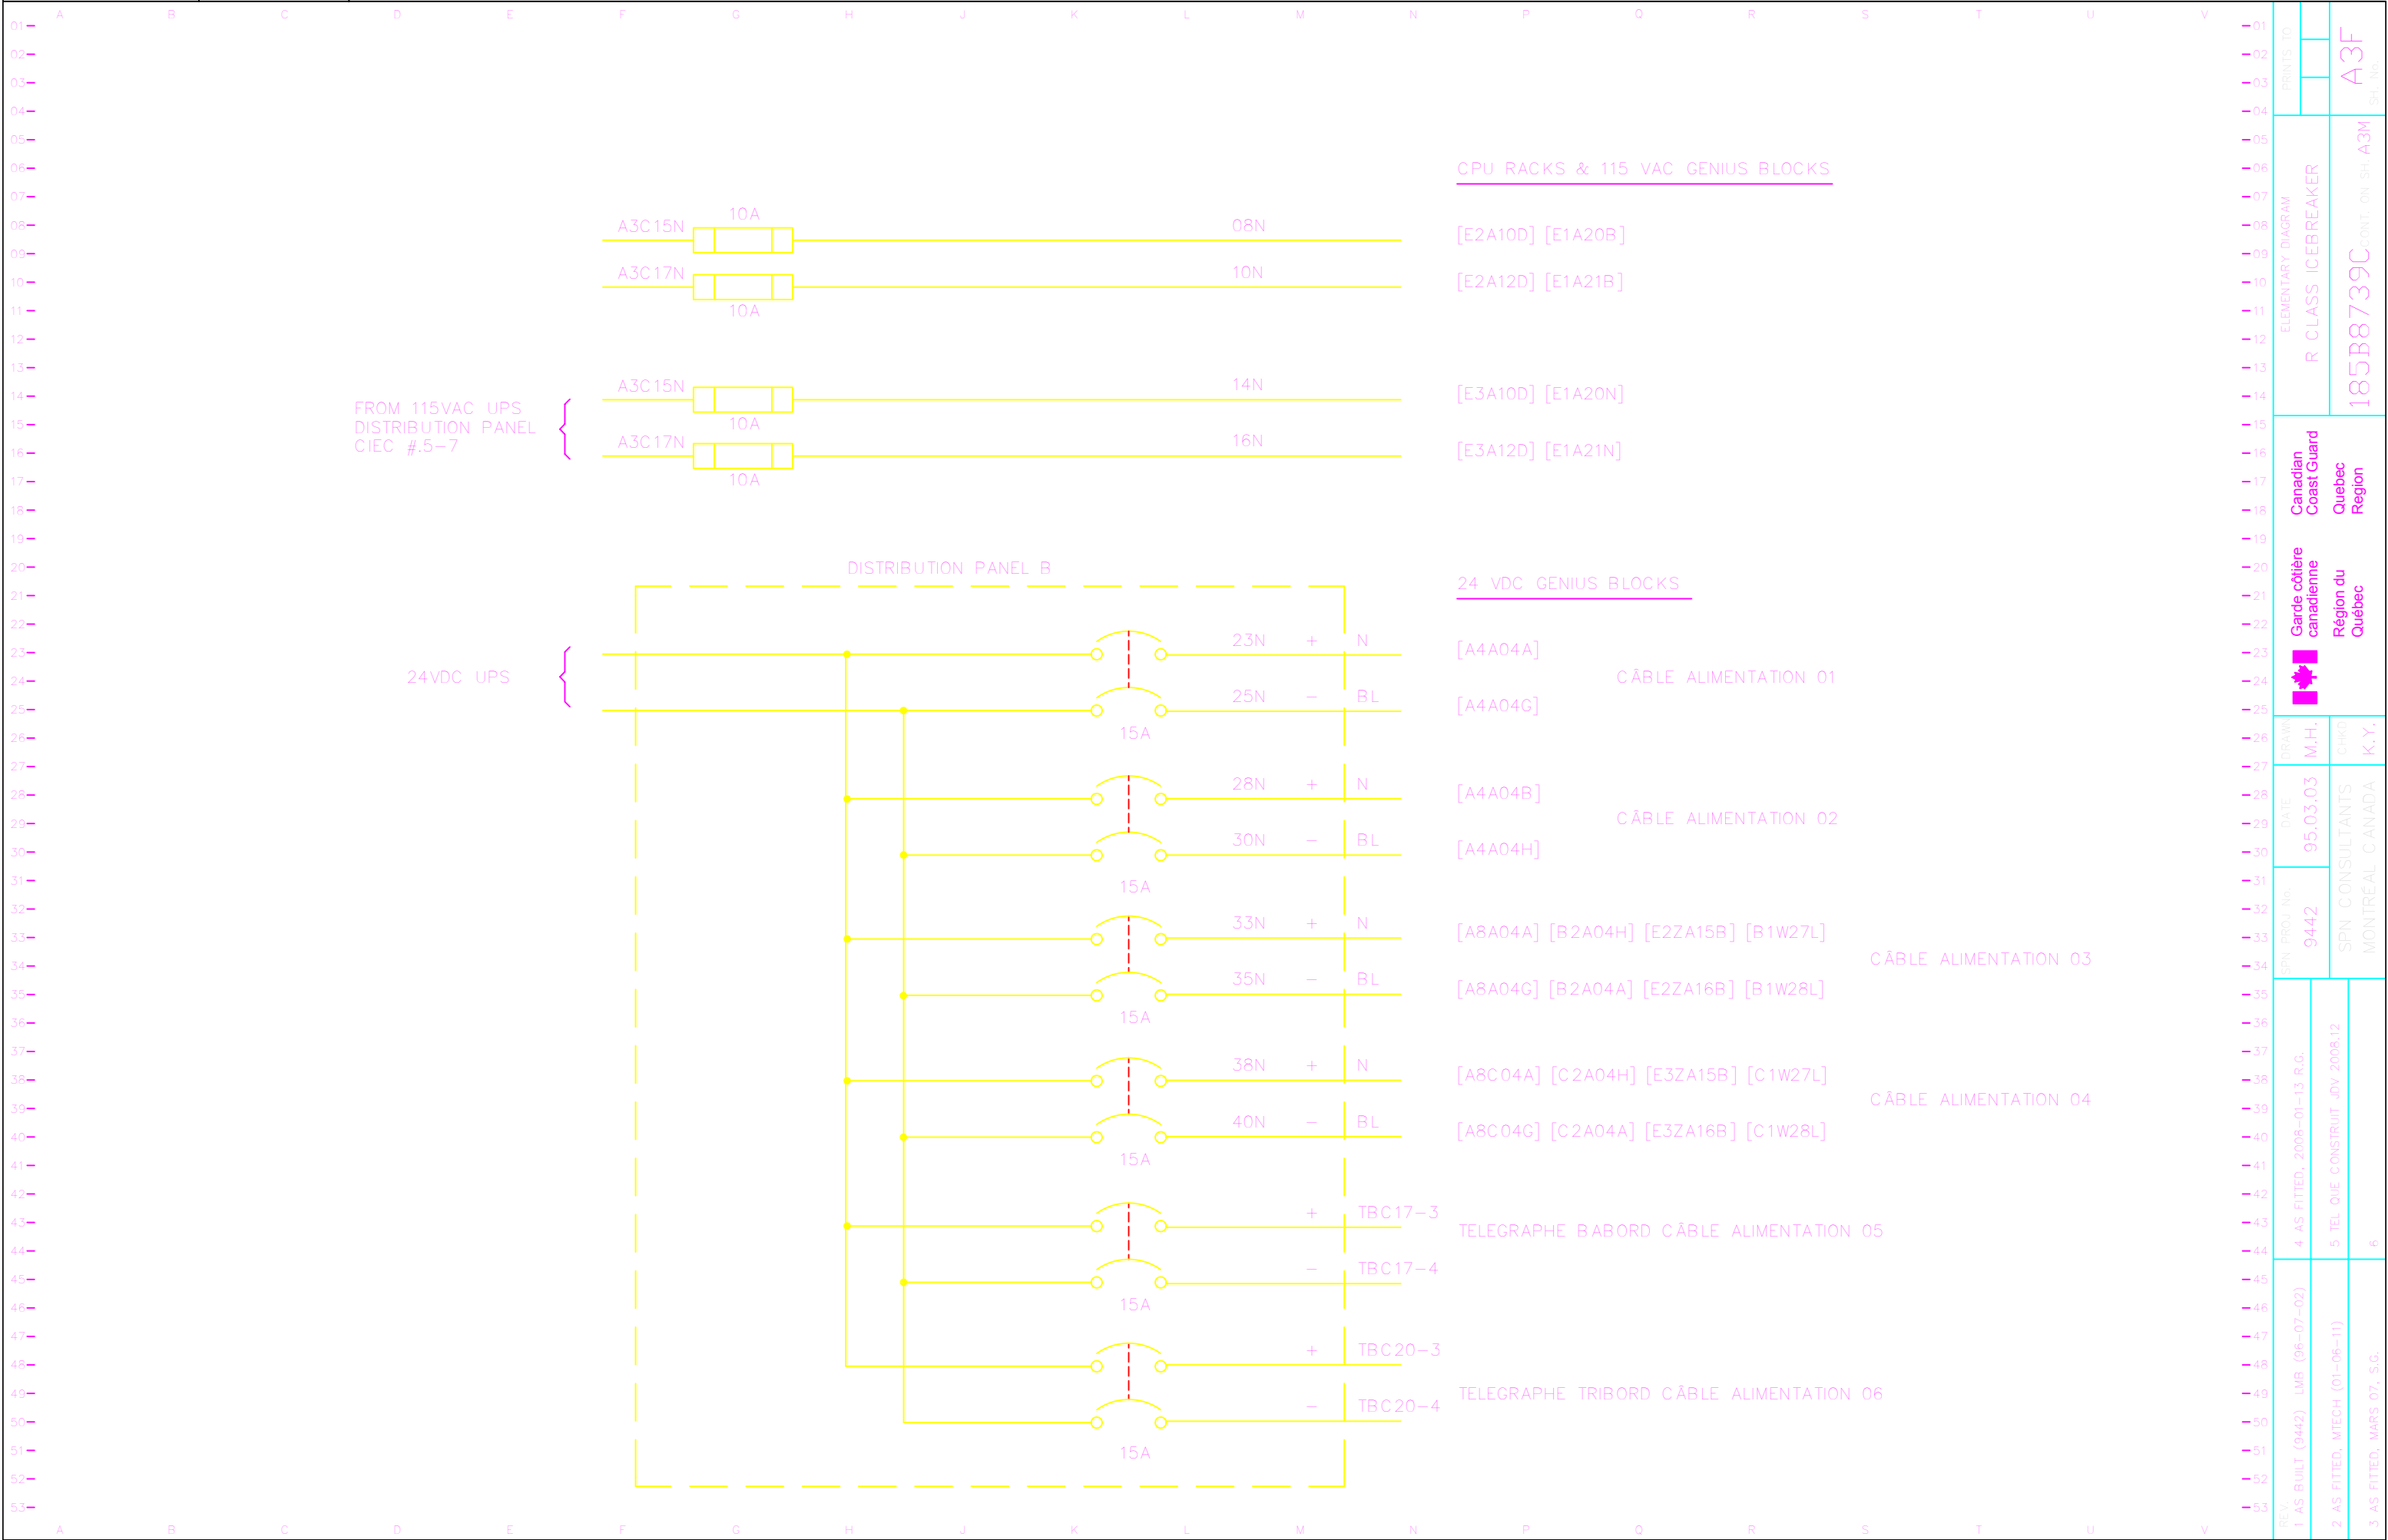

115VAC & 24VDC PLC & GENIUS I/O POWER DISTRIBUTION

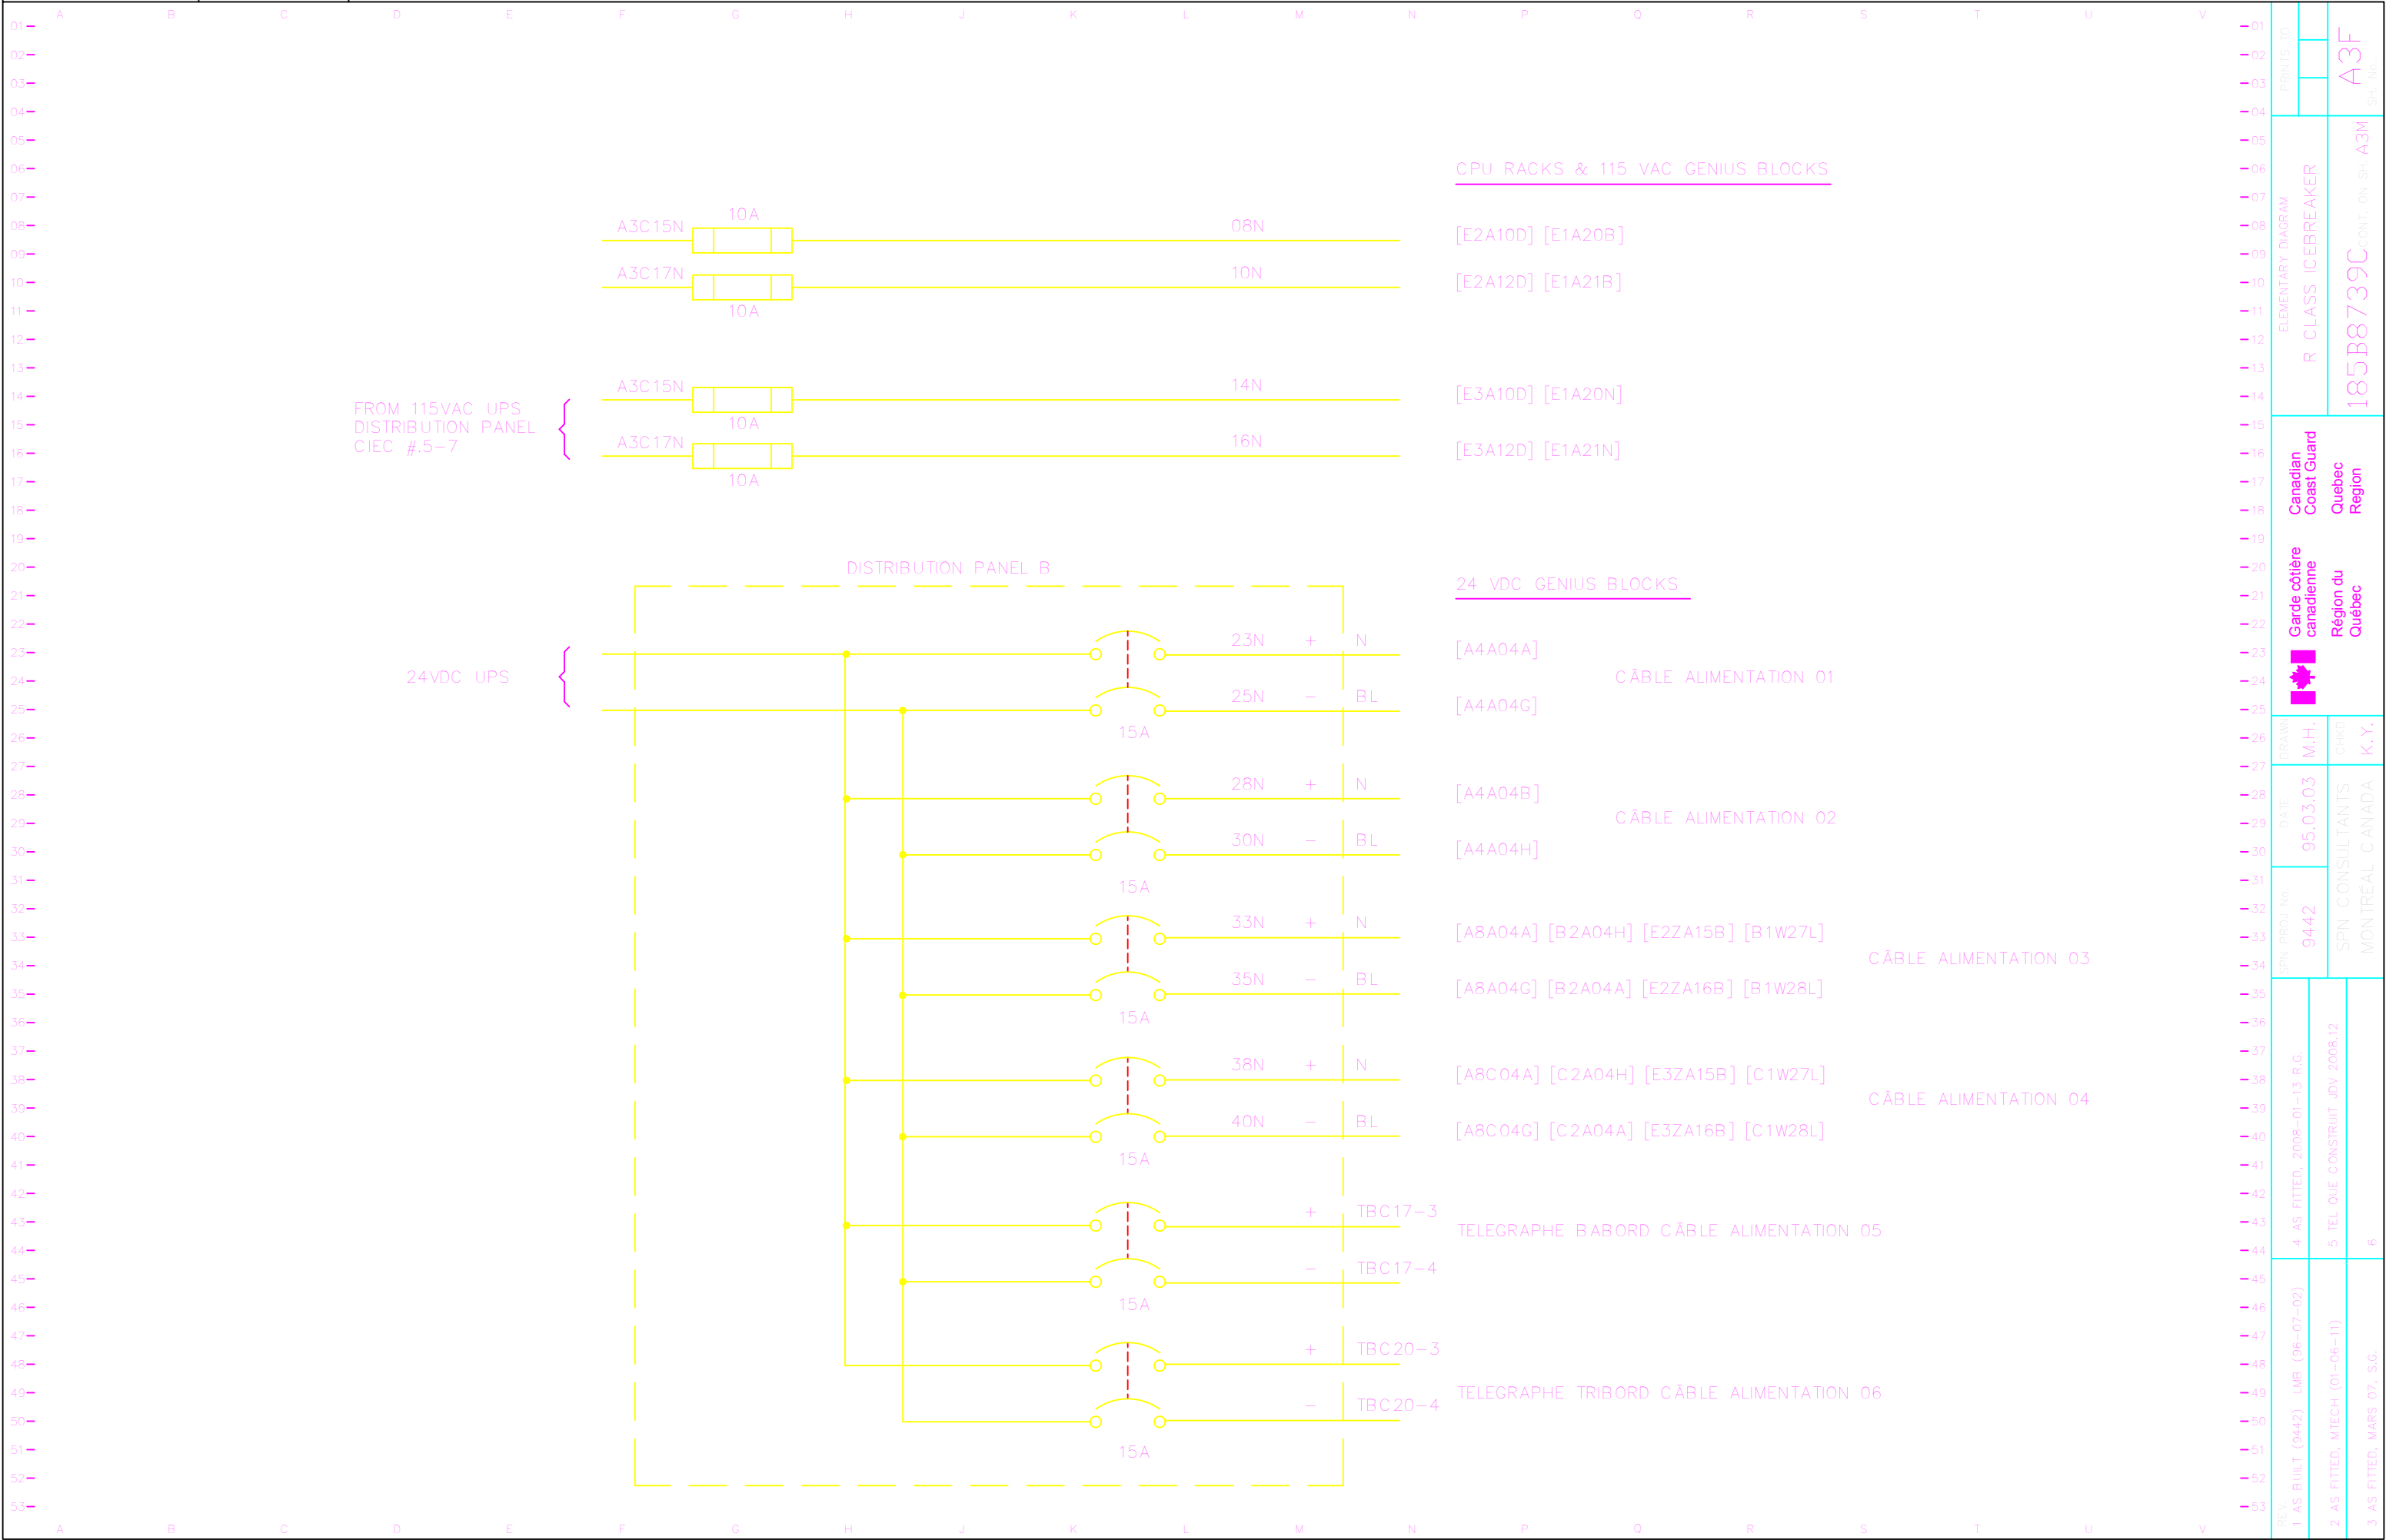

24VDC UPS

23N

+

N

25N

-

BL

15A

28N

+

N

30N

-

BL

15A

33N

+

N

35N

-

BL

15A

38N

+

N

40N

-

BL

15A

TBC17-3

+

TBC17-4

-

15A

TBC20-3

+

TBC20-4

-

15A

CÂBLE ALIMENTATION 01

[A4A04A]

[A4A04G]

CÂBLE ALIMENTATION 02

[A4A04B]

[A4A04H]

CÂBLE ALIMENTATION 03

[A8A04A] [B2A04H] [E2ZA15B] [B1W27L]

[A8A04G] [B2A04A] [E2ZA16B] [B1W28L]

CÂBLE ALIMENTATION 04

[A8C04A] [C2A04H] [E3ZA15B] [C1W27L]

[A8C04G] [C2A04A] [E3ZA16B] [C1W28L]

TELEGRAPHE BABORD CÂBLE ALIMENTATION 05

[A8C04A] [C2A04H] [E3ZA15B] [C1W27L]

[A8C04G] [C2A04A] [E3ZA16B] [C1W28L]

TELEGRAPHE TRIBORD CÂBLE ALIMENTATION 06

[A8C04A] [C2A04H] [E3ZA15B] [C1W27L]

[A8C04G] [C2A04A] [E3ZA16B] [C1W28L]

PRINTS TO

ELEMENTARY DIAGRAM

R CLASS ICEBREAKER

185B8739C

CONT. ON SH. A3M

CANADIAN
COAST GUARD

QUEBEC
REGION

Garde côtière
canadienne

Région du
Québec

DRAWN

M.H.

DATE

95.03.03

SPN PROJ No.

9442

4 AS FITTED, 2008-01-13 R.G.

5 TEL QUE CONSTRUIT JDV 2008.12

6

3 AS FITTED, MARS 07, S.G.