



OTTAWA RIVER PARKWAY


STRUCTURES CONTRACT

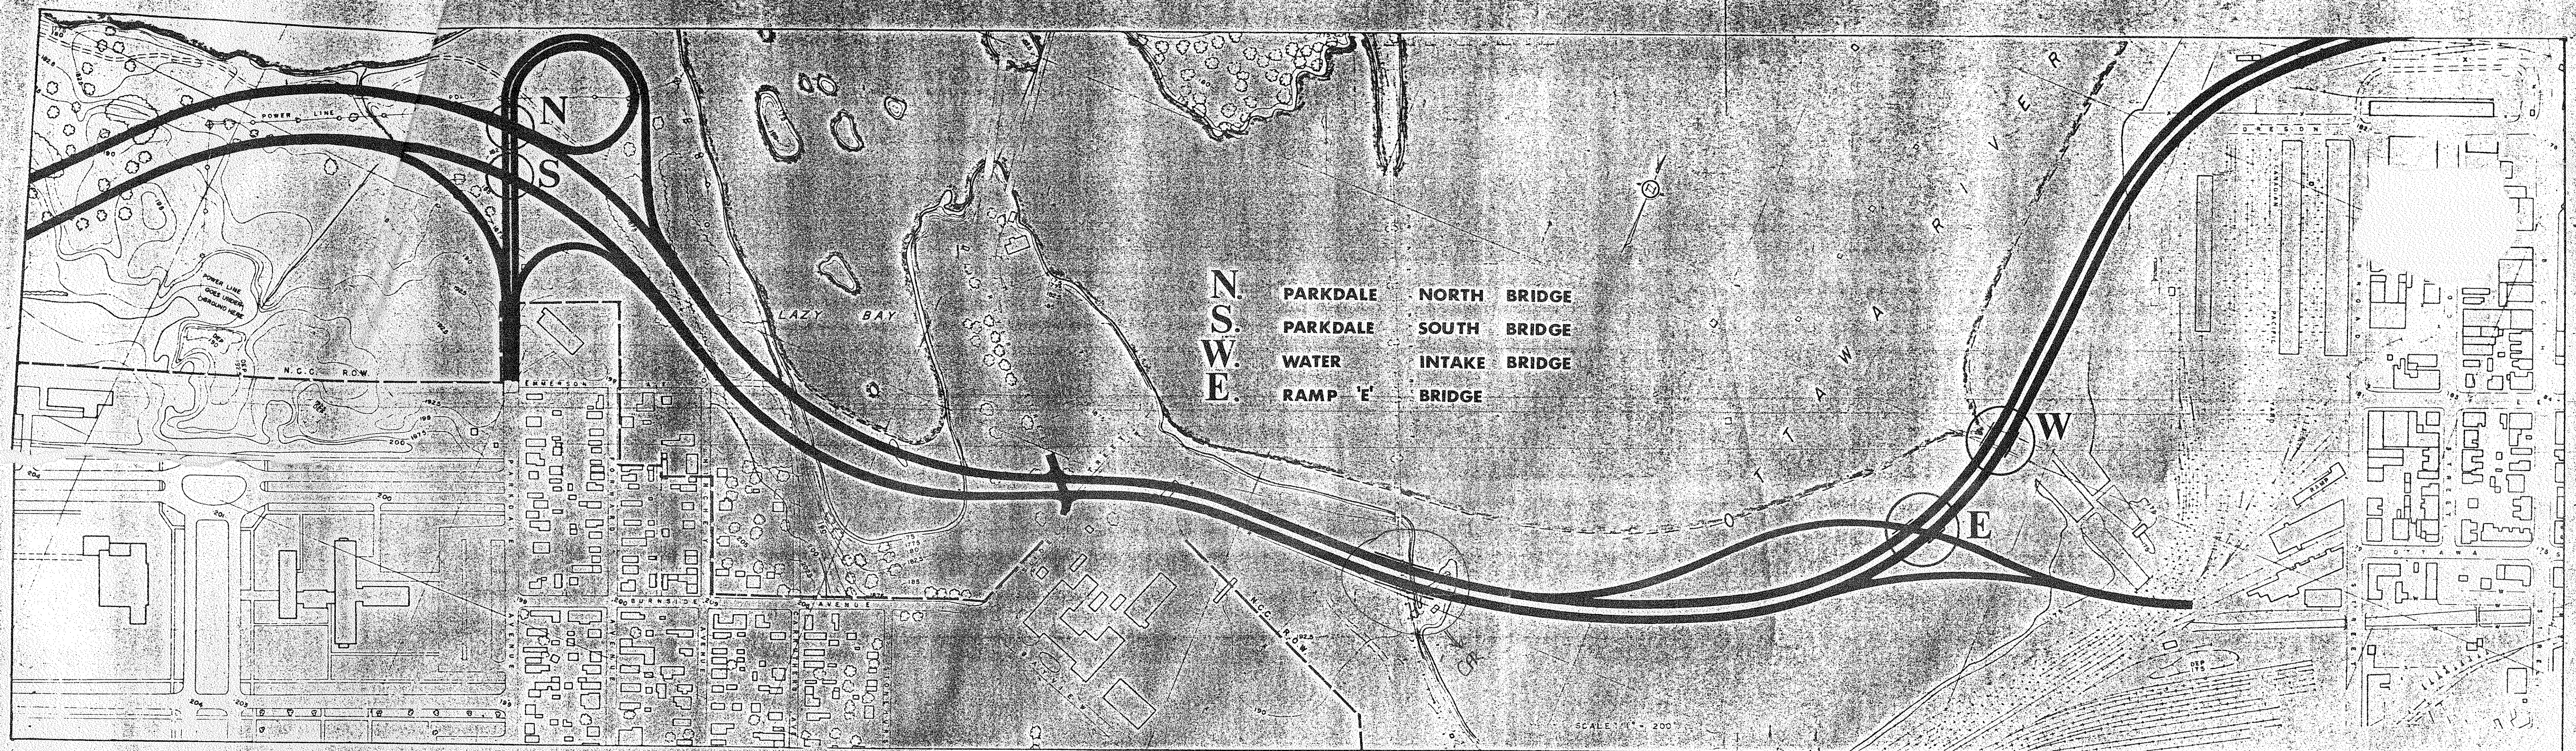


NATIONAL CAPITAL COMMISSION
OTTAWA

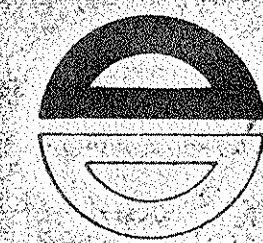

M.M. DILLON LIMITED
CONSULTING ENGINEERS
OTTAWA

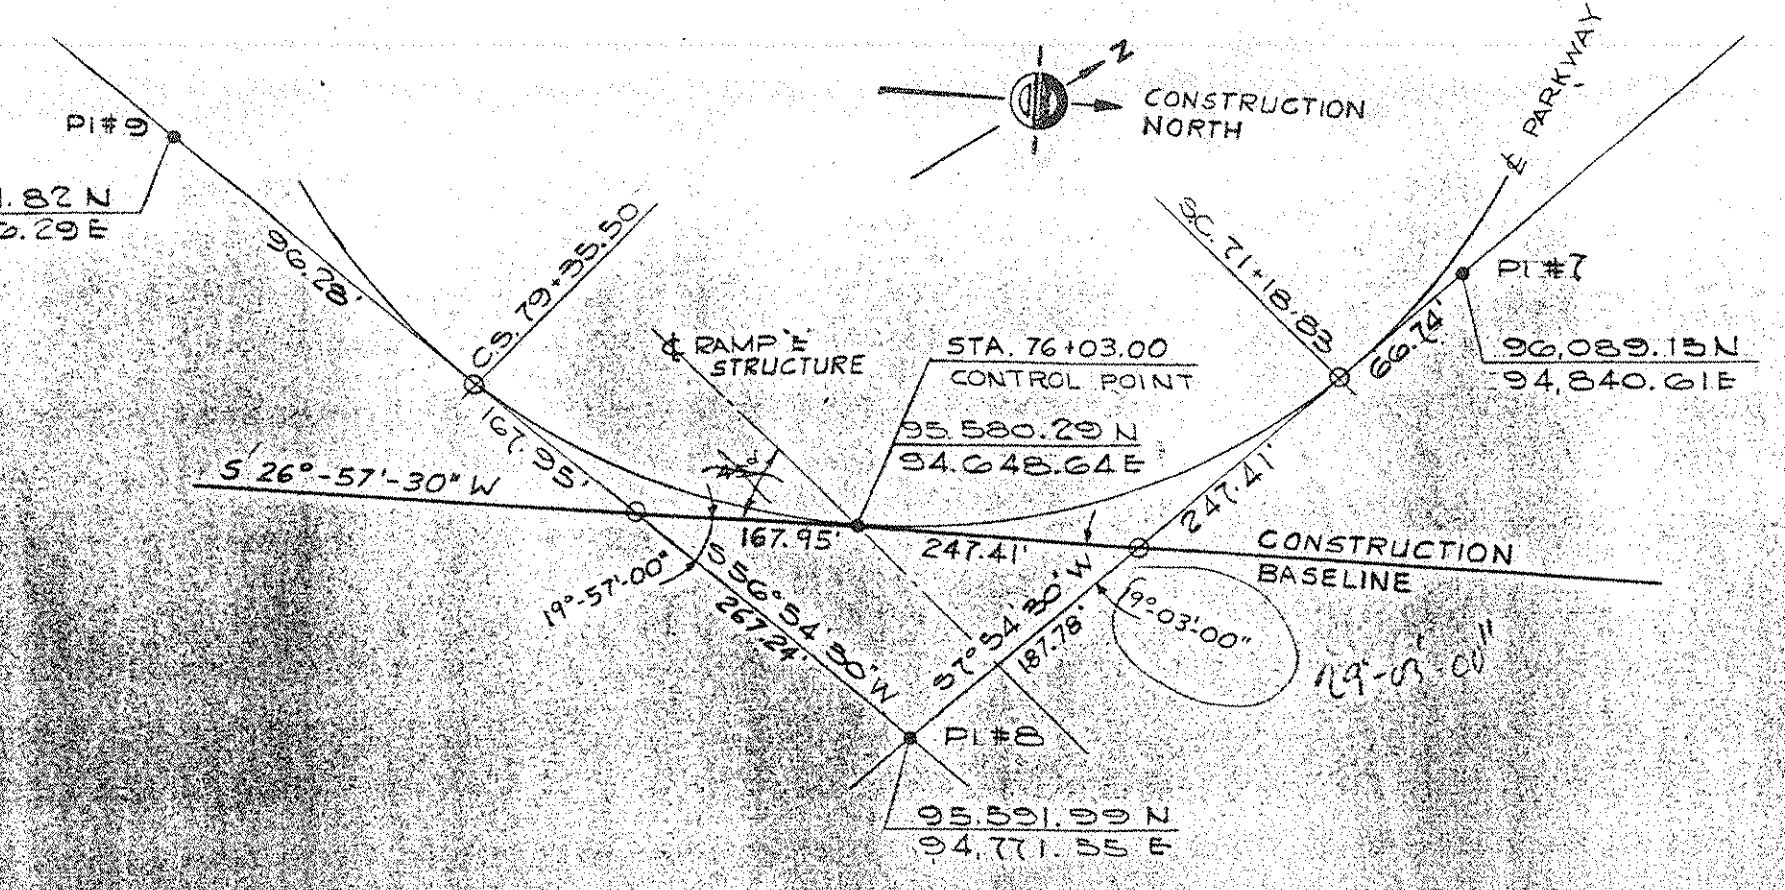


3. BACKFILL BEHIND NORTH ABUTMENT & SOUTH ABUTMENT
WALKWAY IS ERECTED & IS SUPPORTED ON FILL. SOUTH ABUTMENT IS CONCRETED
4. FALSEWORK FOR PIERS & LEGS IS ERECTED. PIERS & LEGS ARE CONCRETED
DECK FALSEWORK IS ERECTED. DECK IS CONCRETED 95.5
94.5
5. DECK CABLES ARE STRESSED. FALSEWORK IS SCAFFERED. PILE CABLES ARE
INITIALLY STRESSED. SIDEWALK FLEEWALK IS ERECTED. MONOTON ARE FORMED
6. SOUTH SIDEWALKS ARE CAST TO UNDERSIDE OF
SIDEWALK.
7. FILL IS PLACED BEHIND SOUTH ABUTMENT
8. ADDITION TO GENERAL NOTES C AS BUILT
4. DESIGN STRENGTH OF CONCRETE AT 60 DAYS FOR
APPROACH SLABS 4000 PSI.

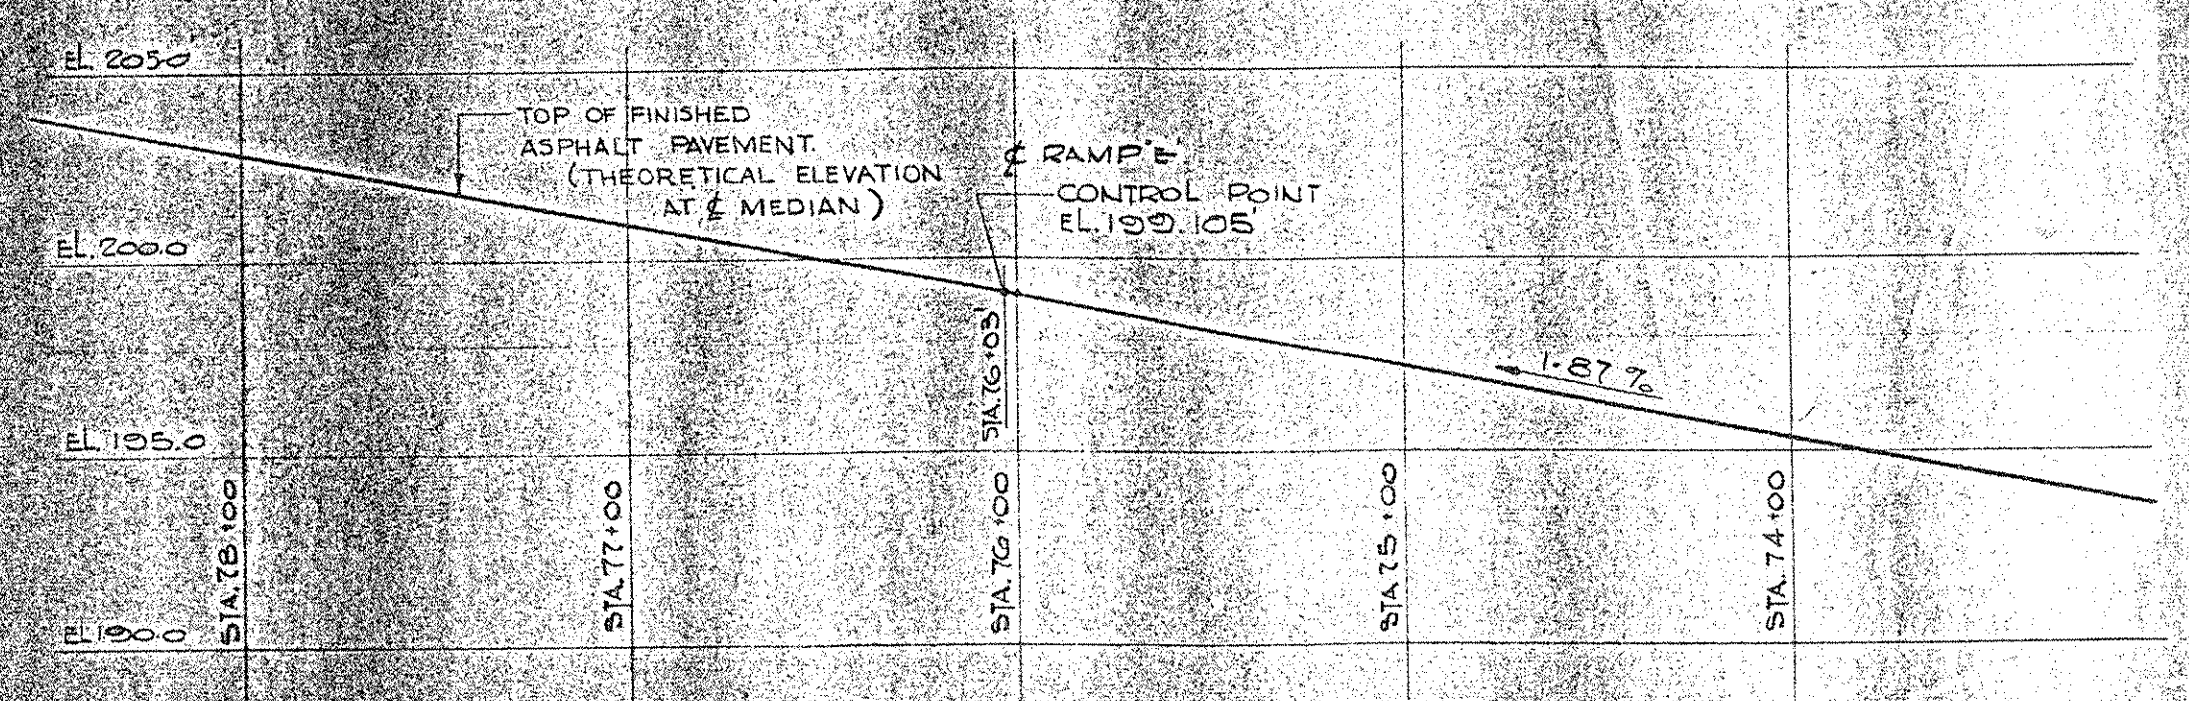[illegible]

LOGICAL ORDER)
LLED THROUGH ROCK HILL AND INTO
DROPPED IN ON DRAWING. A STEEL PIPE
FLOWED DOWN TO SOLID ROCK. HOLES
HOLE AND STRAND CABLE TO BE LOWERED
TO BE CONCRETED. TILES NUMBER
STRESSING CABLE IS TO BE GROUTED
FOOTINGS TO BE CONCRETED.
STRUCTURE TO BE ERECTED, AND FORMWORK
MENT IS SUPPORTED ON PALMWORK
INDICATIVE OF THE EXTENT AND THE
BETWEEN LONGITUDINAL CONSTRUCTION
WITHOUT THE SIDEWALK MEDIAN OR
THE SOUTH APARTMENT) ARE CONNECTED.
APPROVED CONSTRUCTION JOINS
CONTRACTOR.
DESIGNED, THE DECK POUR COMPLETED TO UNDER
PALMWORK THEN STRUCK. THE CABLES
PARTIALLY STRESSED AT THE TOP OF THE DECK,
SEE 2, 3, 4, 5. AFTER SEALING OFF THE
WITH DRY GROUT, THE CABLES OF
FULLY STRESSED.
SIDE OF SIDEWALKS.
THE DECK ARE CAST AND STRESSED, AND
NOT GROUTED.
MENTS.
AND APPROX SLABS ARE CAST.

1. ROCK ELEVATIONS SHOWN ON THE DRAWING HAVE BEEN DERIVED FROM A ROCK REPORT, COPIES OF WHICH ARE AVAILABLE FOR EXAMINATION AT M. M. DILLON LTD., OTTAWA. M. M. DILLON LTD. IN NO WAY GUARANTEES THE ACCURACY OF THESE REPORTS.
2. THE CONTRACTOR SHALL TAKE ADEQUATE PRECAUTIONS TO PREVENT RAIN OR SURFACE WATER FROM COLLECTING IN THE EXCAVATION UNTIL THE BACKFILL IS PLACED AND COMPACTED TO THE TOP OF FOOTING.
3. LIVE LOAD: AASHO HPO-316
4. CONCRETE CLASS: DESIGN STRENGTH OF CONCRETE AT 28 DAYS
FILES, FOOTINGS & NORTH ABUTMENT WITH WINGWALLS 4000 P.S.I.
NUMBER 4 4000 P.S.I.
STRENGTH AT TRANSFER OF PRESTRESS 4500 P.S.I.
5. CONCRETE COVER:
FOOTINGS 3"
DECK & SIDEWALKS 2"
HORIZONTAL 2"
6. CHAMFER: ALL EXPOSED EDGES, UNLESS OTHERWISE NOTED 14"
7. REINFORCING STEEL: UNLESS OTHERWISE NOTED, TO BE INTERMEDIATE GRADE DEFORMED BARS.
8. DIMENSIONS, WHICH VARY WITH TEMPERATURE, ARE GIVEN AT 60° F
9. DECK ELEVATIONS ARE GIVEN TO TOP OF CONCRETE SURFACE.
10. TOP OF SIDEWALK OR CURB TO BE SET BY ELEVATIONS.

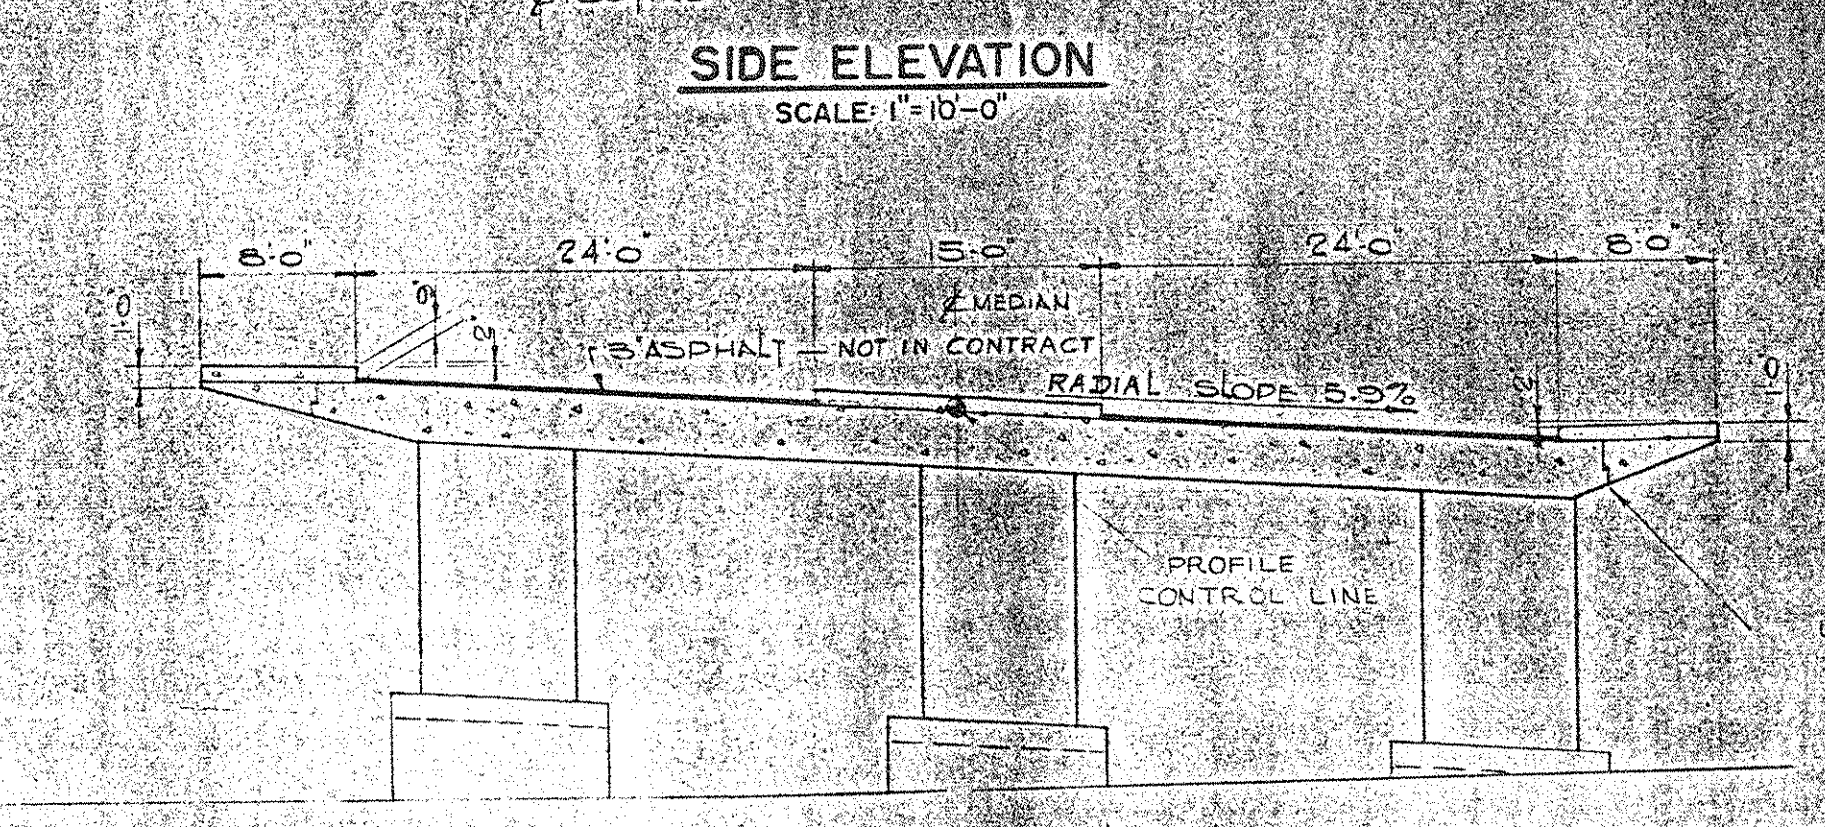

SECTION 

NOTE:
ALL DIMENSIONS ARE
AT RIGHT ANGLES TO
C OF PARKWAY


LIST OF DRAWINGS	
DWG. NO.	DESCRIPTION
E - 1	GENERAL ARRANGEMENT
E - 2	FOUNDATION LAYOUT & PILE DETAILS
E - 3	FOUNDATION REINFORCING
E - 4	LAYOUT OF ABUTMENTS AND MINOWALLS
E - 5	ABUTMENT & MINOWALL REINFORCING
E - 6	PIER & LEG LAYOUT & REINFORCING
E - 7	DECK & APPROACH SLAB LAYOUT
E - 8	DECK & APPROACH SLAB REINFORCING
E - 9	DECK CABLE LAYOUT
E - 10	DECK CABLE PROFILES
E - 11	MISCELLANEOUS DETAILS
E - 12	REINFORCING STEEL SCHEDULE
E - 13	REINFORCING STEEL SCHEDULE
E - 14	REINFORCING STEEL SCHEDULE
E - 15	REINFORCING STEEL SCHEDULE

1. HOLES FOR PILE TO BE DRILLED THROUGH ROCK FILL AND INTO SOLID ROCK FOR LENGTHS SPECIFIED ON DRAWINGS. STEEL PILE TO BE PLACED IN HOLE AND LOWERED DOWN TO SOLID ROCK. HOLES TO BE REINFORCED, REINFORCEMENT TO BE PLACED AND CABLE TO BE LOWERED WITH DROUT PILE, AND PILES TO BE CONCRETED. PILES NUMBER 2,3,4,5 TO BE STRESSED. STRESSING CABLE IS TO BE GROUTED.
2. NORTH ABUTMENT AND CENTRE FOOTINGS TO BE CONCRETED.
3. FALSEWORK TO COMPLETE STRUCTURE TO BE ERECTED, AND FORMWORK ERECTED THEREON. SOUTH ABUTMENT IS SUPPORTED ON FALSEWORK WITH A GAP BETWEEN THE UNDERSIDE OF THE ABUTMENT AND THE TOPS OF PILES NO. 2,3,4,5.
4. THE DECK, SIDWALK AND DECK BETWEEN LONGITUDINAL CONSTRUCTION JOINTS AND TIE-RODS AND TIE-RODS AND TIE-RODS AND TIE-RODS OF VINYLMADE (BUT INCLUDING THE SOUTH ABUTMENT) ARE CONCRETED. THIS MAY BE DONE IN STAGES WITH APPROVED CONSTRUCTION JOINTS TO BE SUGGESTED IN THE CONTRACTOR.
5. THE DECK CABLES ARE STRESSED, THE DECK FOUR COMPLETED TO UNDER-SIDE OF SIDEWALK, AND THEN STRESSING OF THE CABLES OF SIDEWALKS AND DECK ARE PARTIALLY STRESSED AT THE TOP OF THE DECK, THE GAP AT THE TOP OF PILES 2,3,4,5, AFTER SEALING OFF THE CABLEDROPS, IS TO BE FILLED WITH CONCRETE, THE CABLES OF PILES 2,3,4,5 ARE THEN REMAIN STRESSED.
6. VINYLMADE ARE CAST TO UNDERSIDE OF SIDEWALKS.
7. SIDEWALKS AND MEDIAN TO THE DECK ARE CAST AND STRESSED, AND ANCHOR BOLTS TIGHTENED AND GROUTED.
8. FILL IS PLACED BEHIND ABUTMENTS.
9. SIDEWALKS TO WING WALLS AND APPROACH SLABS ARE CAST.

PROJECT NO.
5877-20-4


SHEET NO.
E-1


OF 15


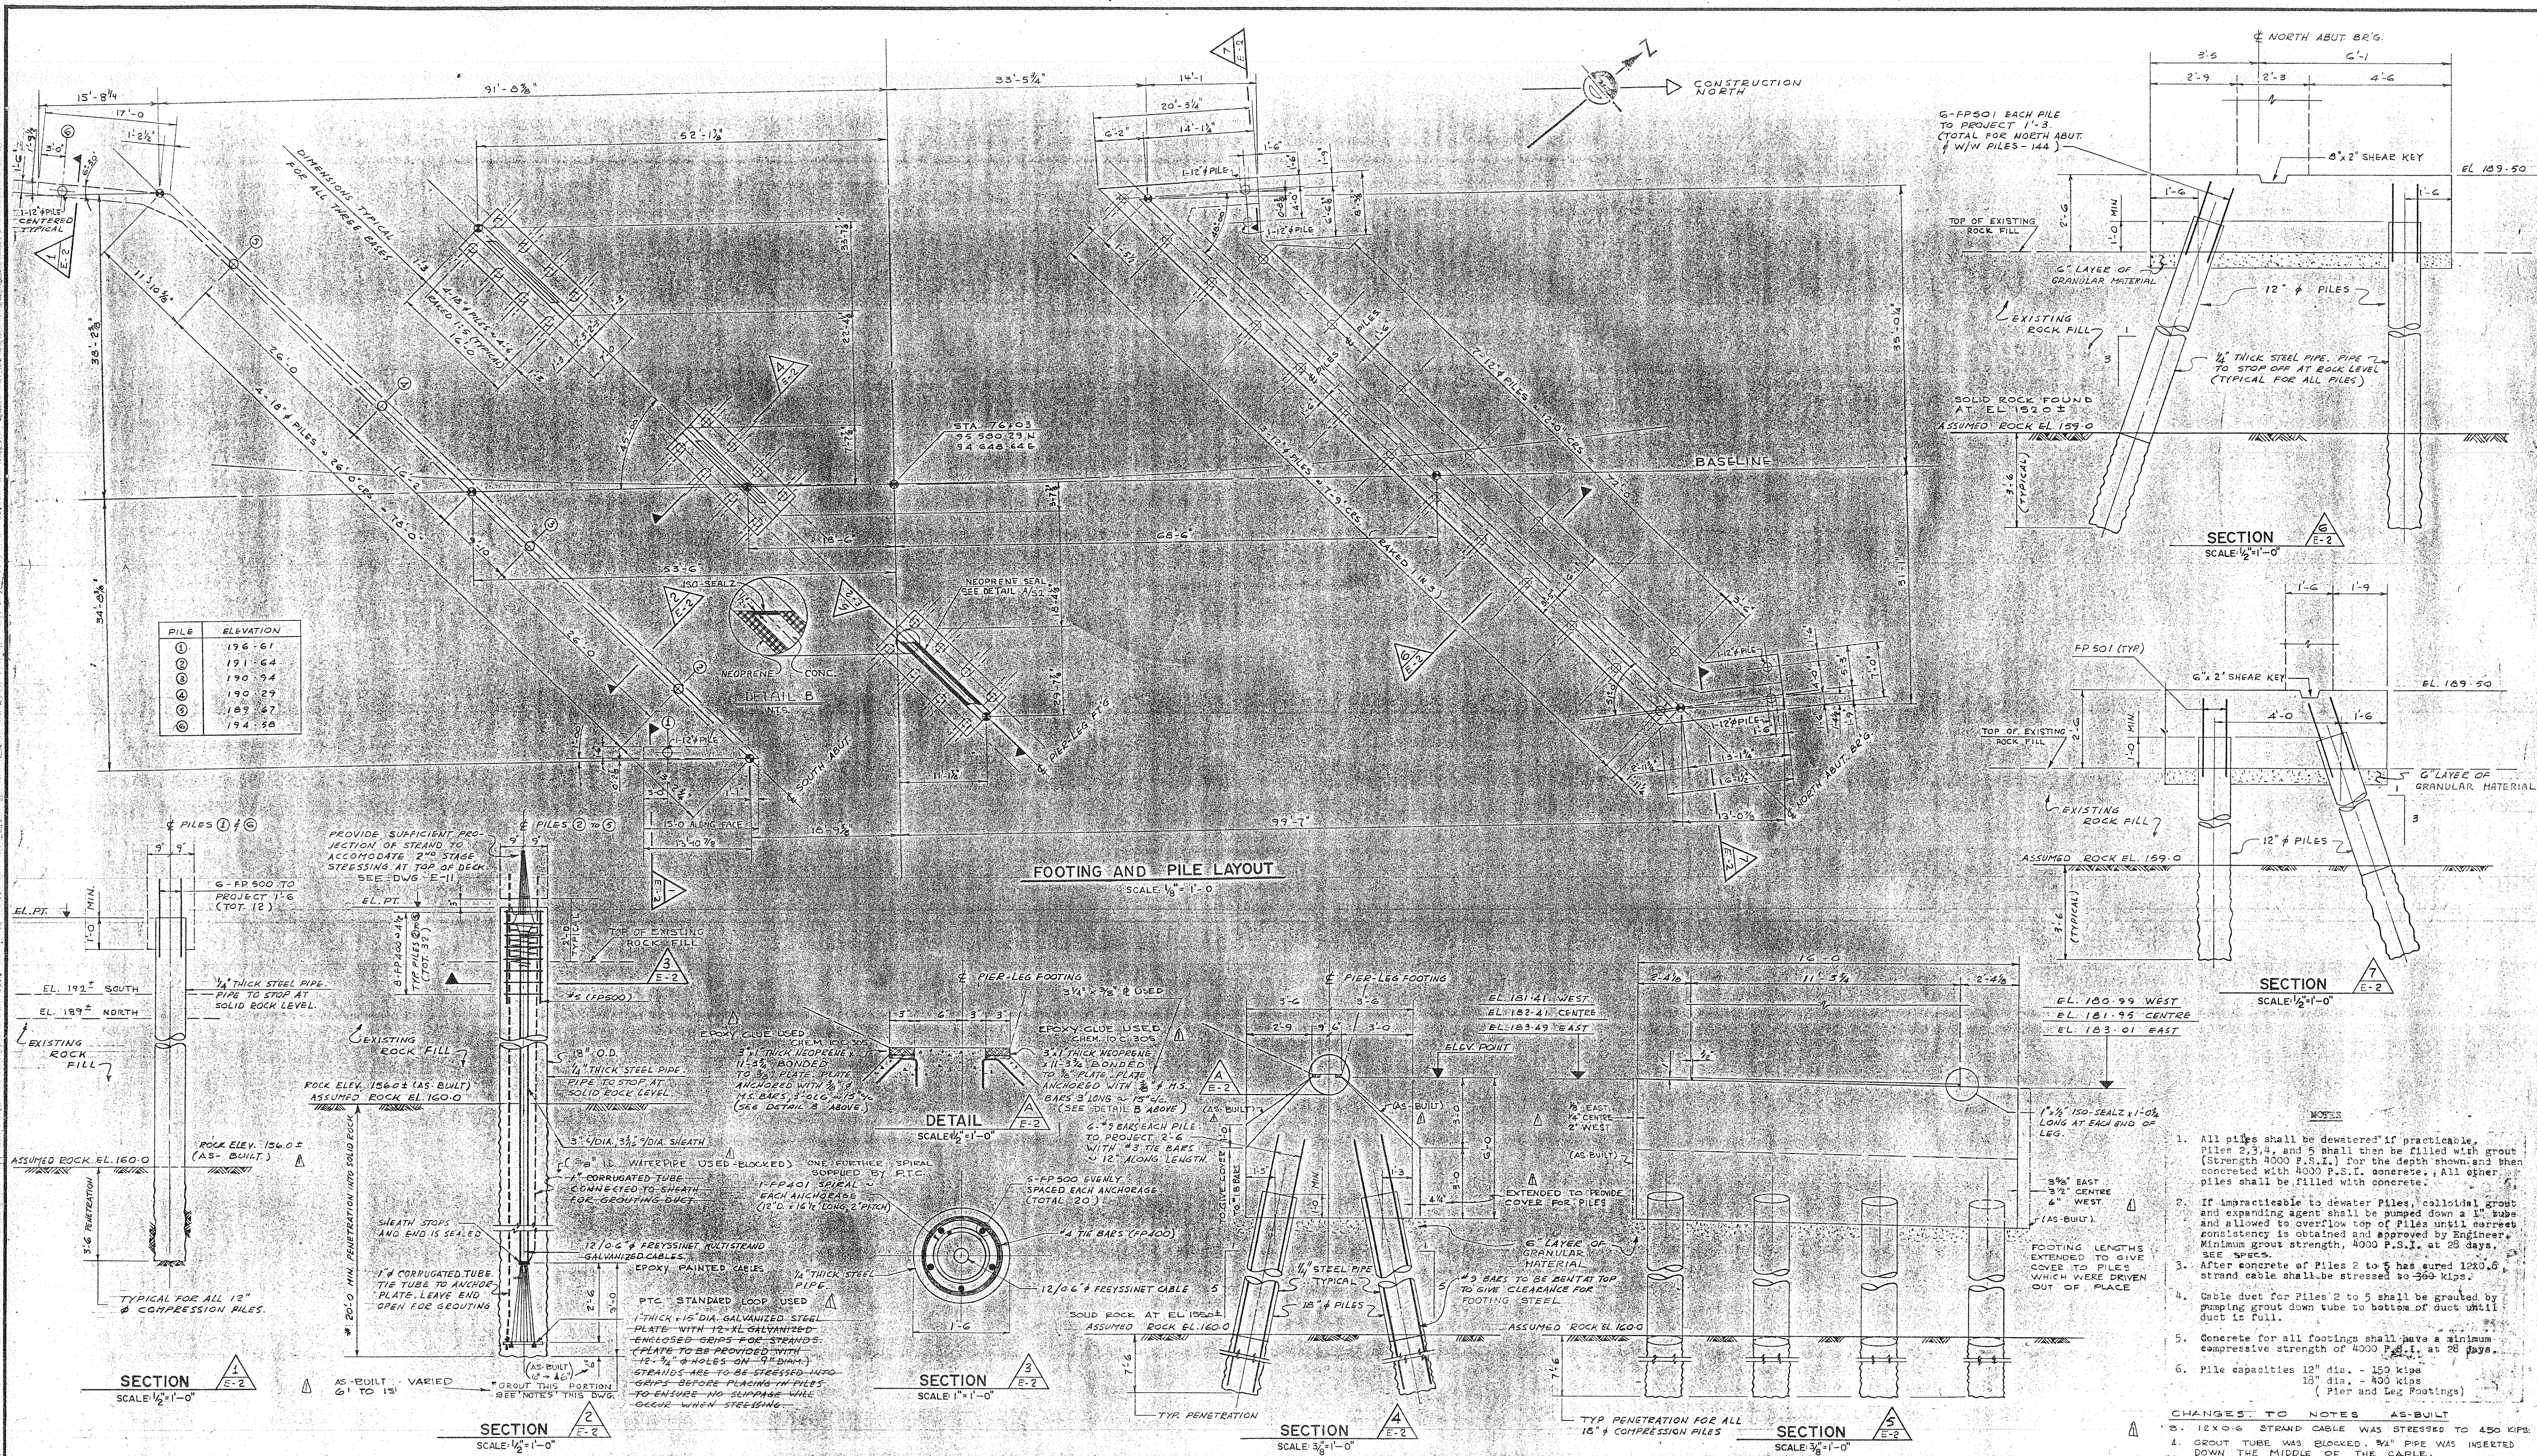



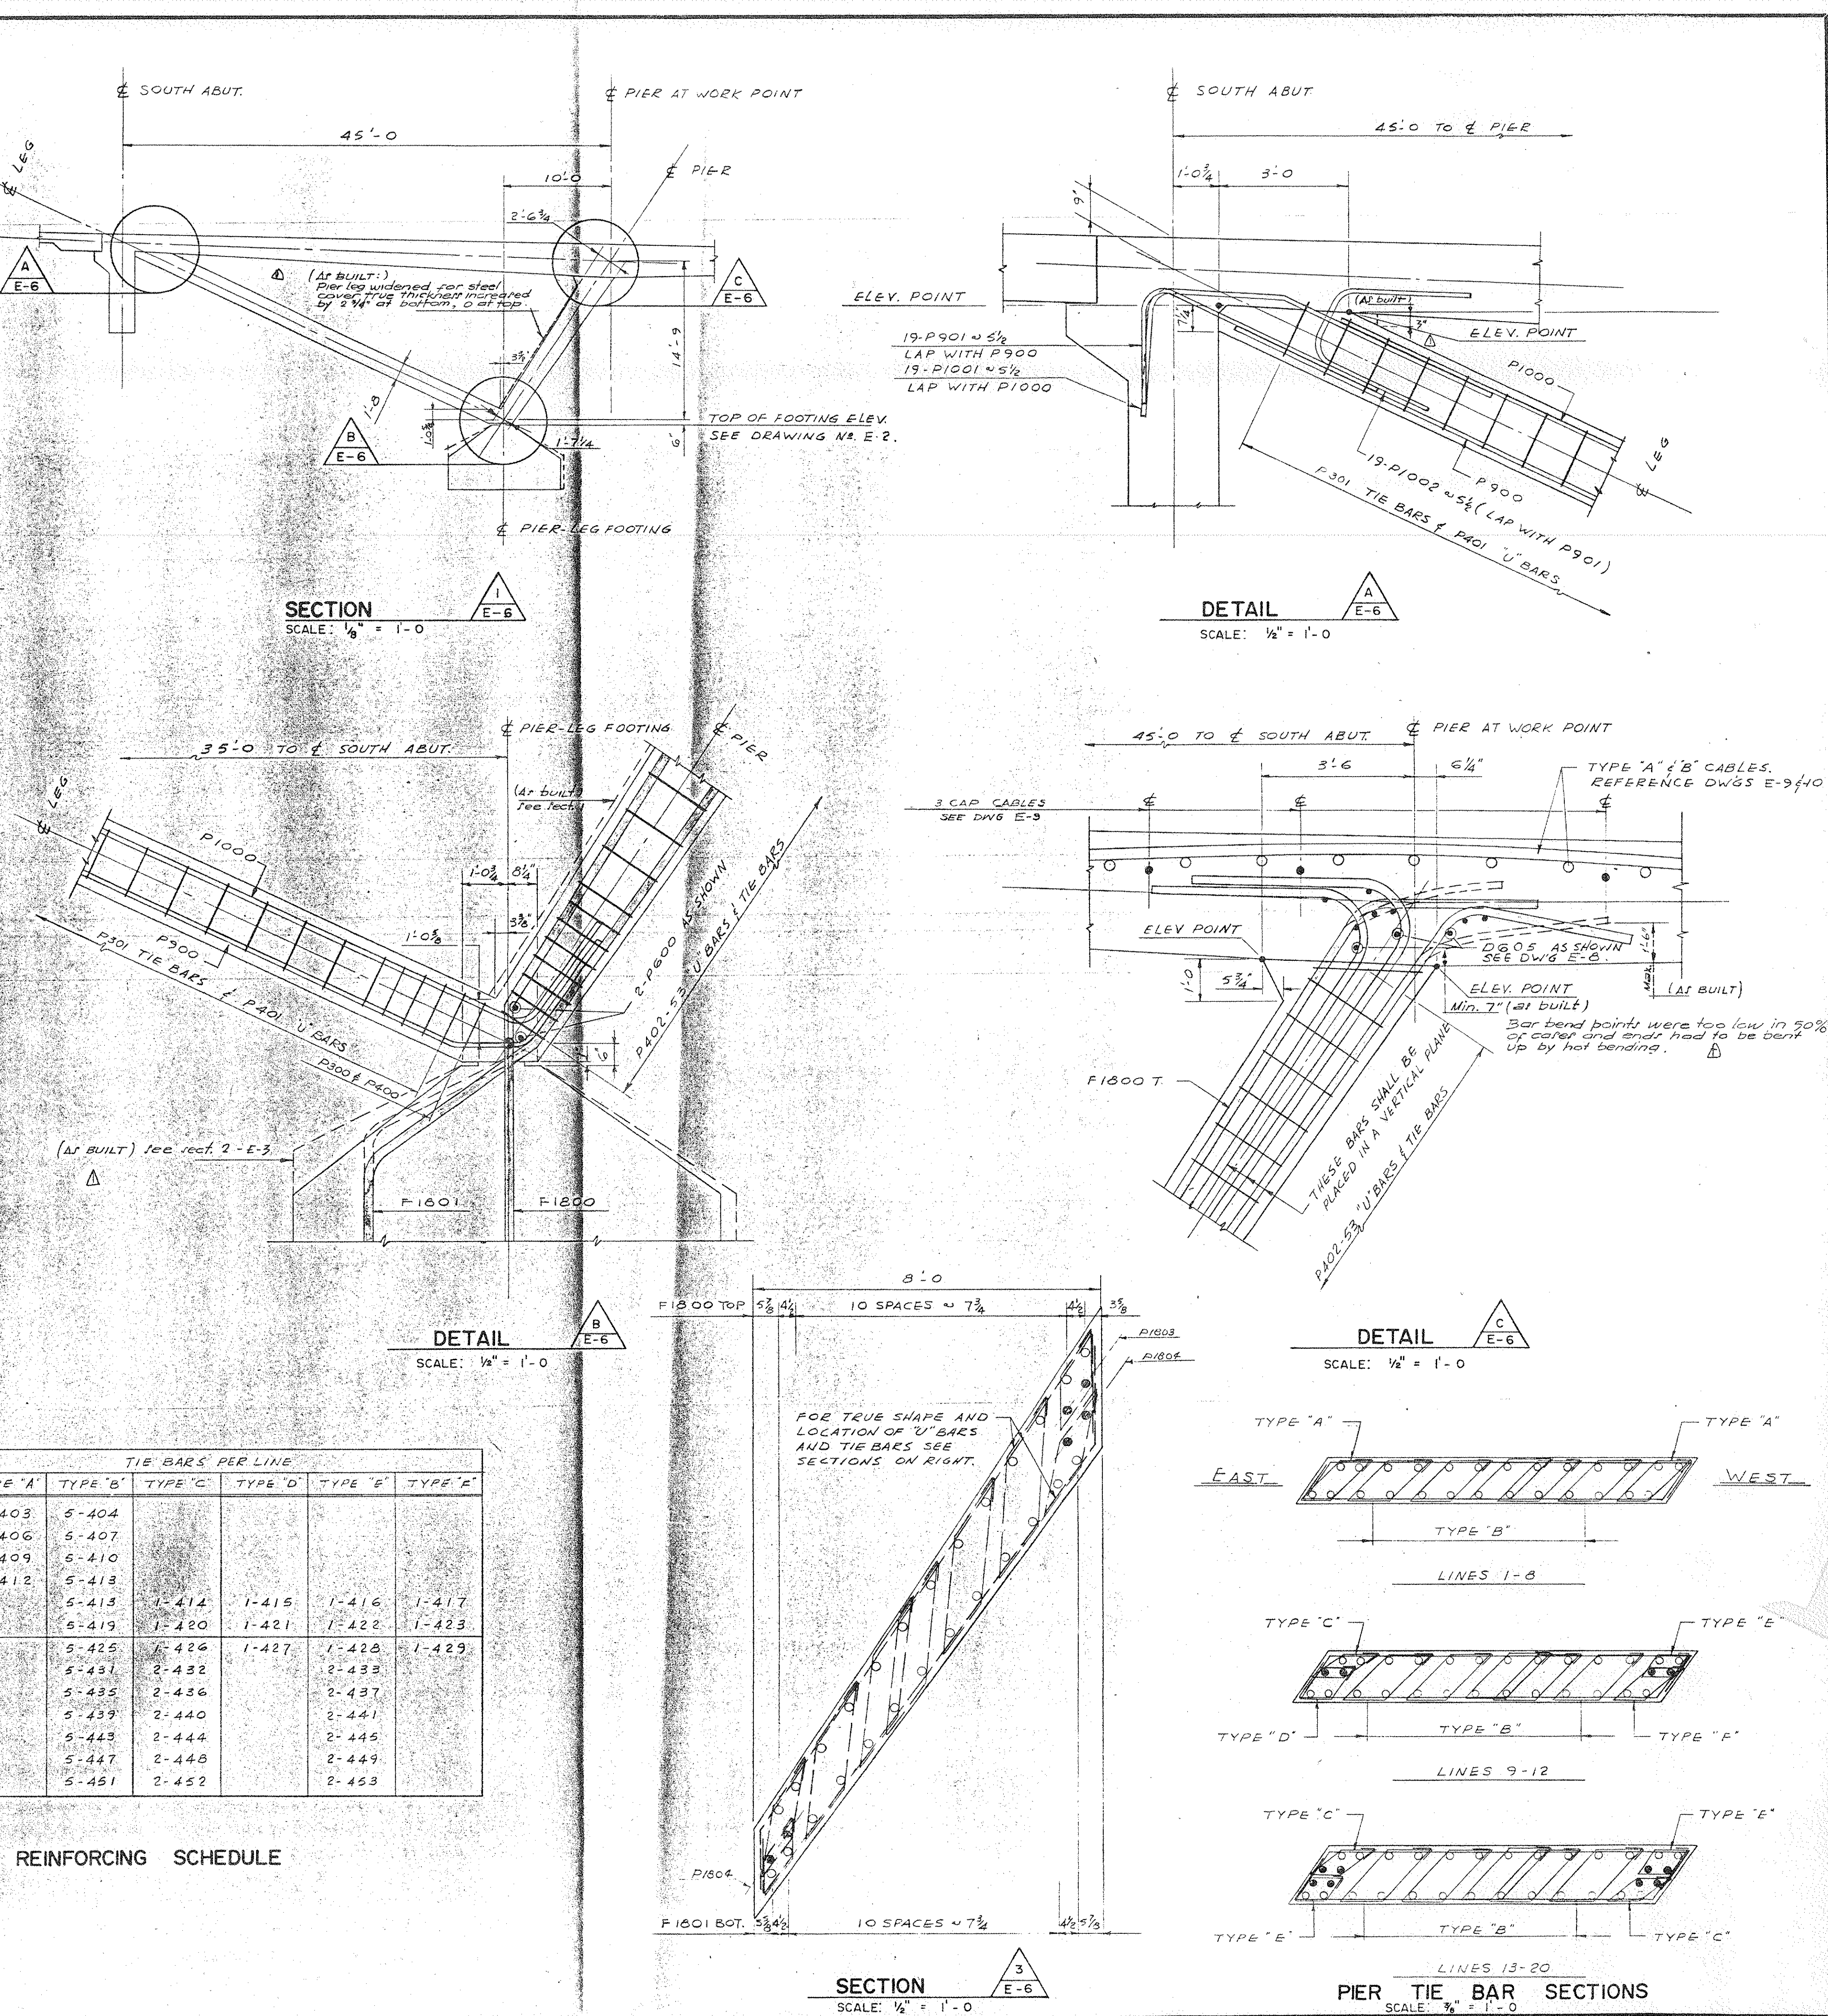
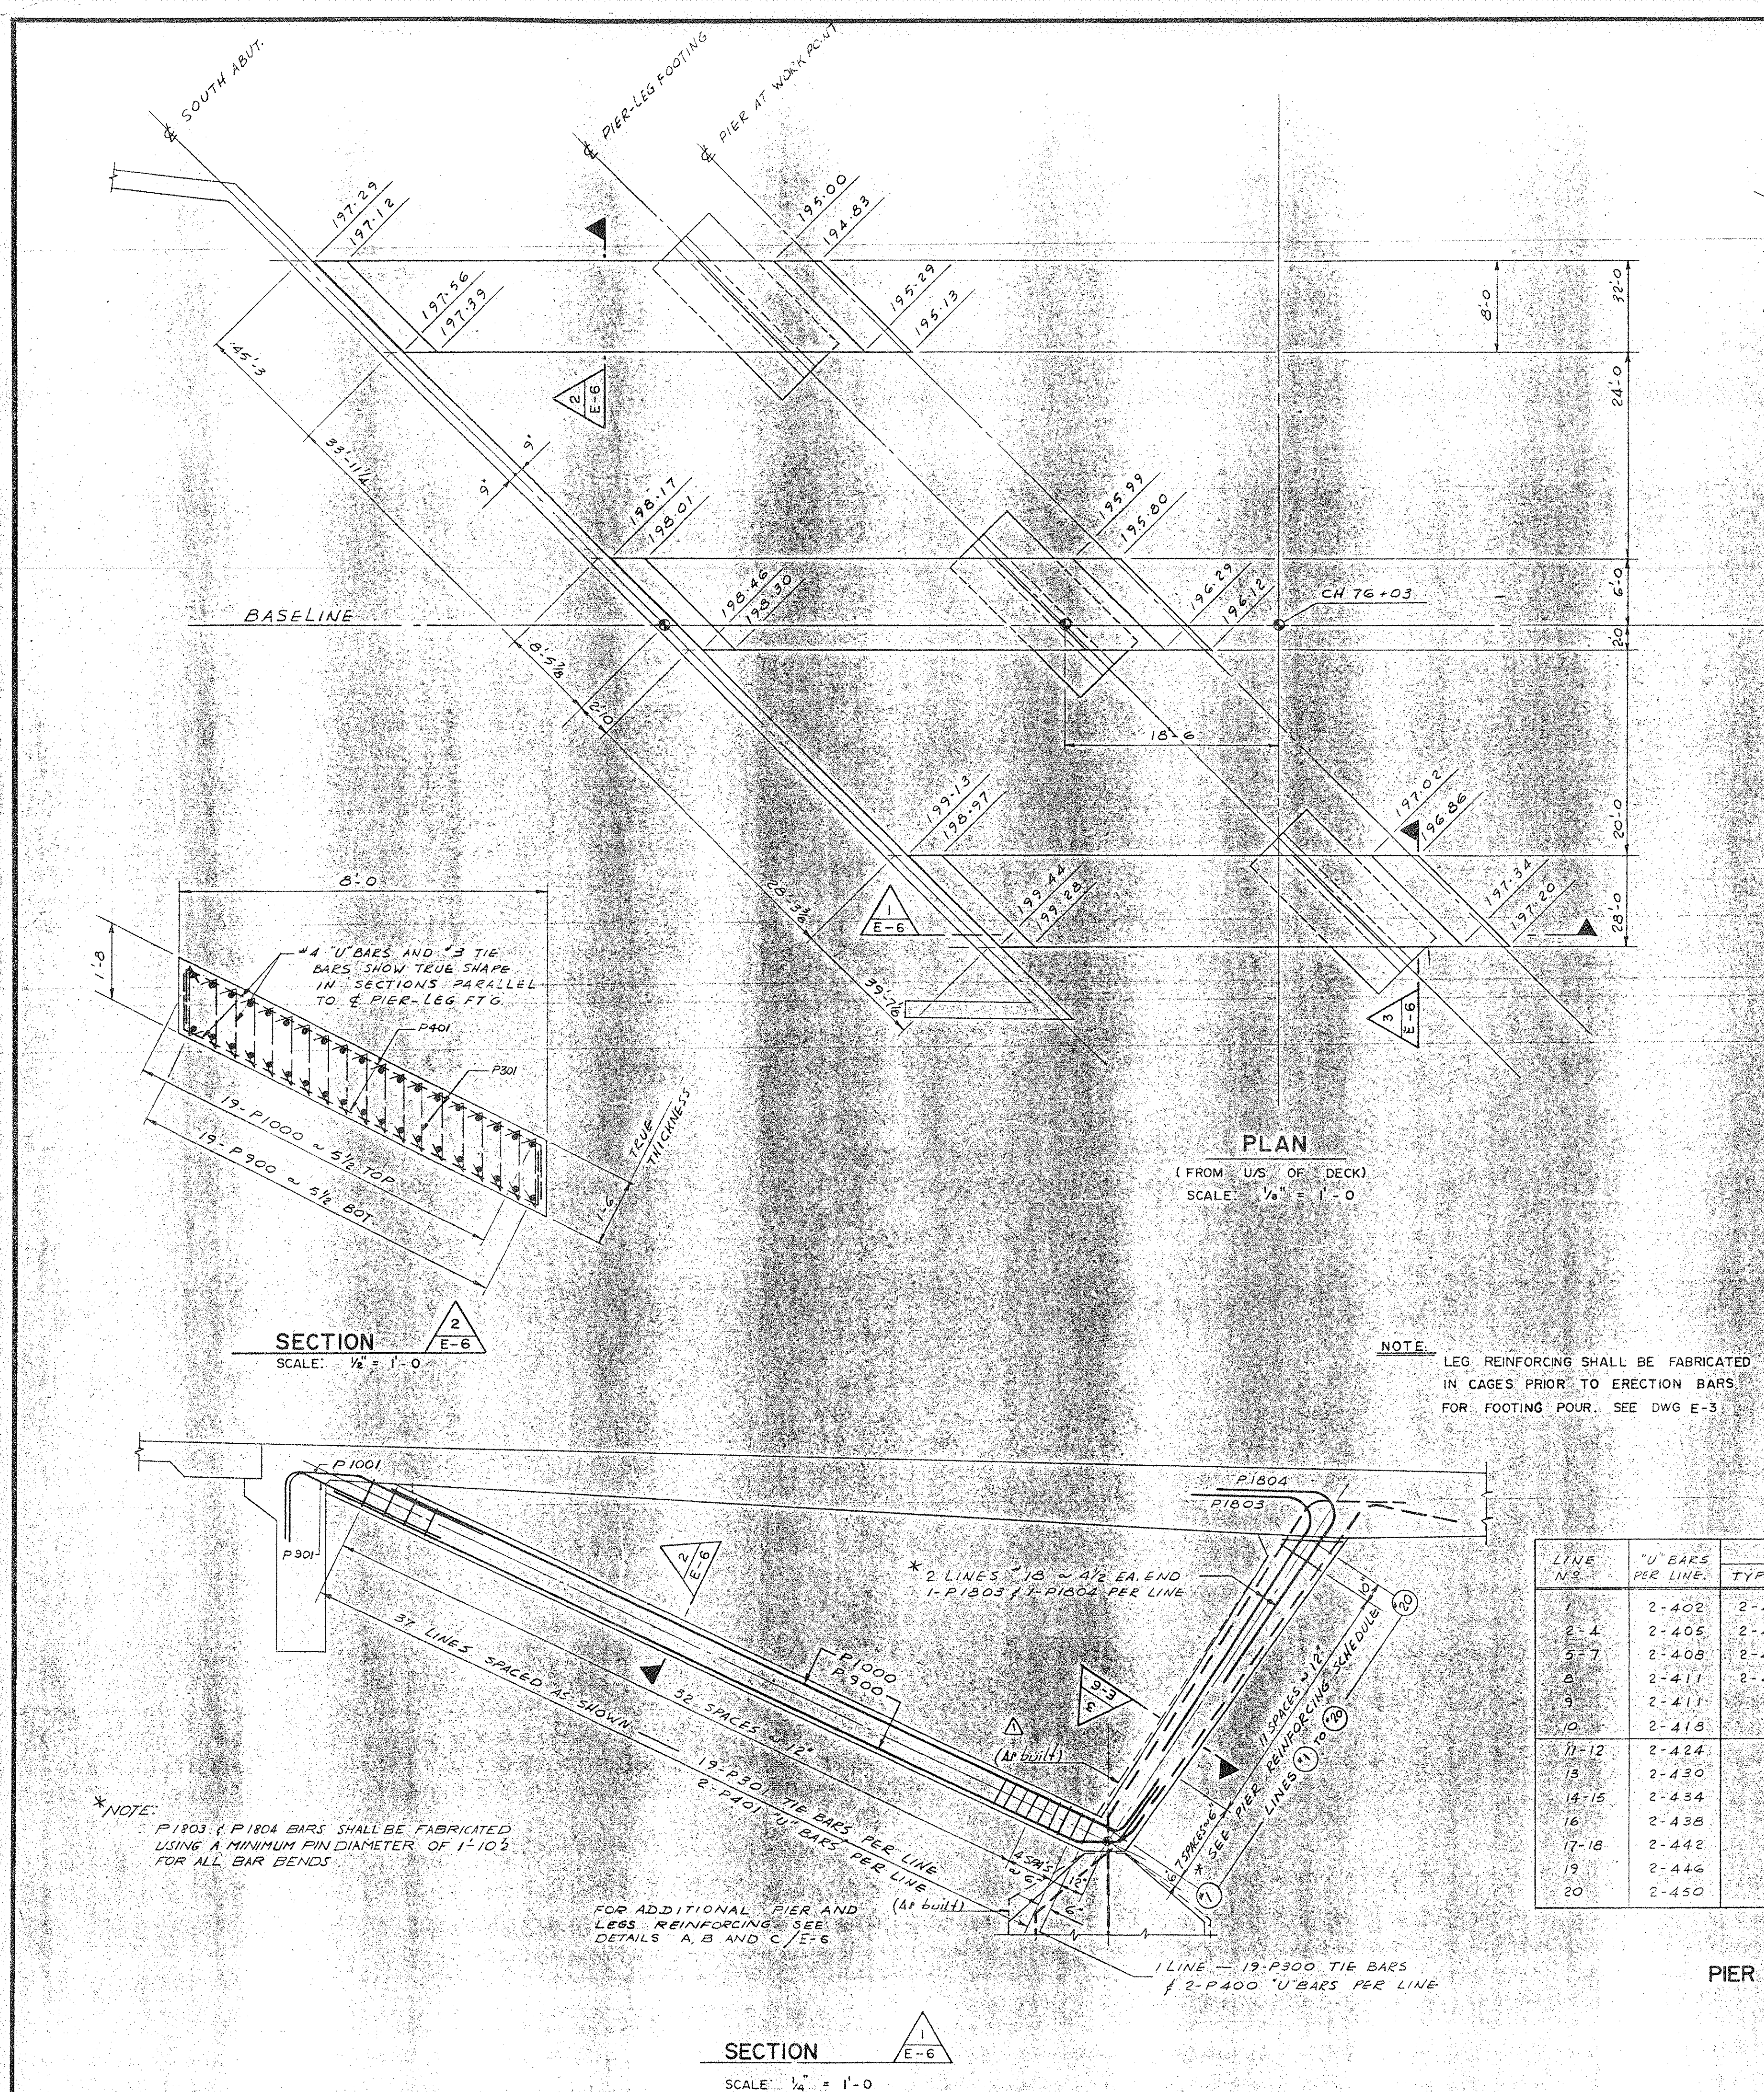
<p>PRINT RECORD</p> <p>DATE</p> <p>NO.</p>	<p>SPECIFICATIONS</p>	<p>CIVIL ENGINEER</p> <p>J. H. KEARNEY</p> <p>REGISTERED PROFESSIONAL ENGINEER</p> <p>PROVINCE OF ONTARIO</p>	<p>M. M. DILLON LIMITED</p> <p>LONDON - TORONTO - OTTAWA - WINNIPEG - SASKATOON - WINDSOR</p> <p>CONSULTING ENGINEERS</p> <p>PROJECT OFFICE: OTTAWA</p>	<p>NATIONAL CAPITAL COMMISSION</p>	<p>DESIGN: V. J. B.</p> <p>DRAWN: J. ON.</p> <p>CHECKED: A. I. W.</p> <p>APPROVED:</p> <p>DATE: FEB. 66.</p> <p>SCALE: AS SHOWN.</p>	<p>FOUNDATION LAYOUT AND PILE DETAILS</p> <p>OTTAWA RIVER PARKWAY</p> <p>RAMP "E" STRUCTURE</p> <p>PROJECT NO. 5877-20-4</p> <p>SHEET NO. E-2</p> <p>OF 15</p>
--	------------------------------	--	--	---	--	---

- NOTES**
- All piles shall be dewatered if practicable. Piles 2, 3, 4, and 5 shall then be filled with grout (Strength 4000 P.S.I.) for the depth shown, and then concreted with 4000 P.S.I. concrete. All other piles shall be filled with concrete.
 - If impracticable to dewater Piles, colloidal grout and expanding agent shall be pumped down a 1" tube and allowed to overflow top of Piles until correct consistency is obtained and approved by Engineer. Minimum grout strength, 4000 P.S.I. at 28 days. SEE SPEC.
 - After concrete of Piles 2 to 5 has cured 1200 lb strand cable shall be stressed to 360 kips.
 - Cable duct for Piles 2 to 5 shall be grouted by pumping grout down tube to bottom of duct until duct is full.
 - Concrete for all footings shall have a minimum compressive strength of 4000 P.S.I. at 28 days.
 - Pile capacities 12" dia. - 150 kips
18" dia. - 400 kips
(Pier and Leg Footings)
- CHANGES TO NOTES**
- AS-BUILT
- 12x0-6 STRAND CABLE WAS STRESSED TO 450 KIIPS.
 - GROUT TUBE WAS BLOCKED. 5/8" PIPE WAS INSERTED DOWN THE MIDDLE OF THE CABLE.

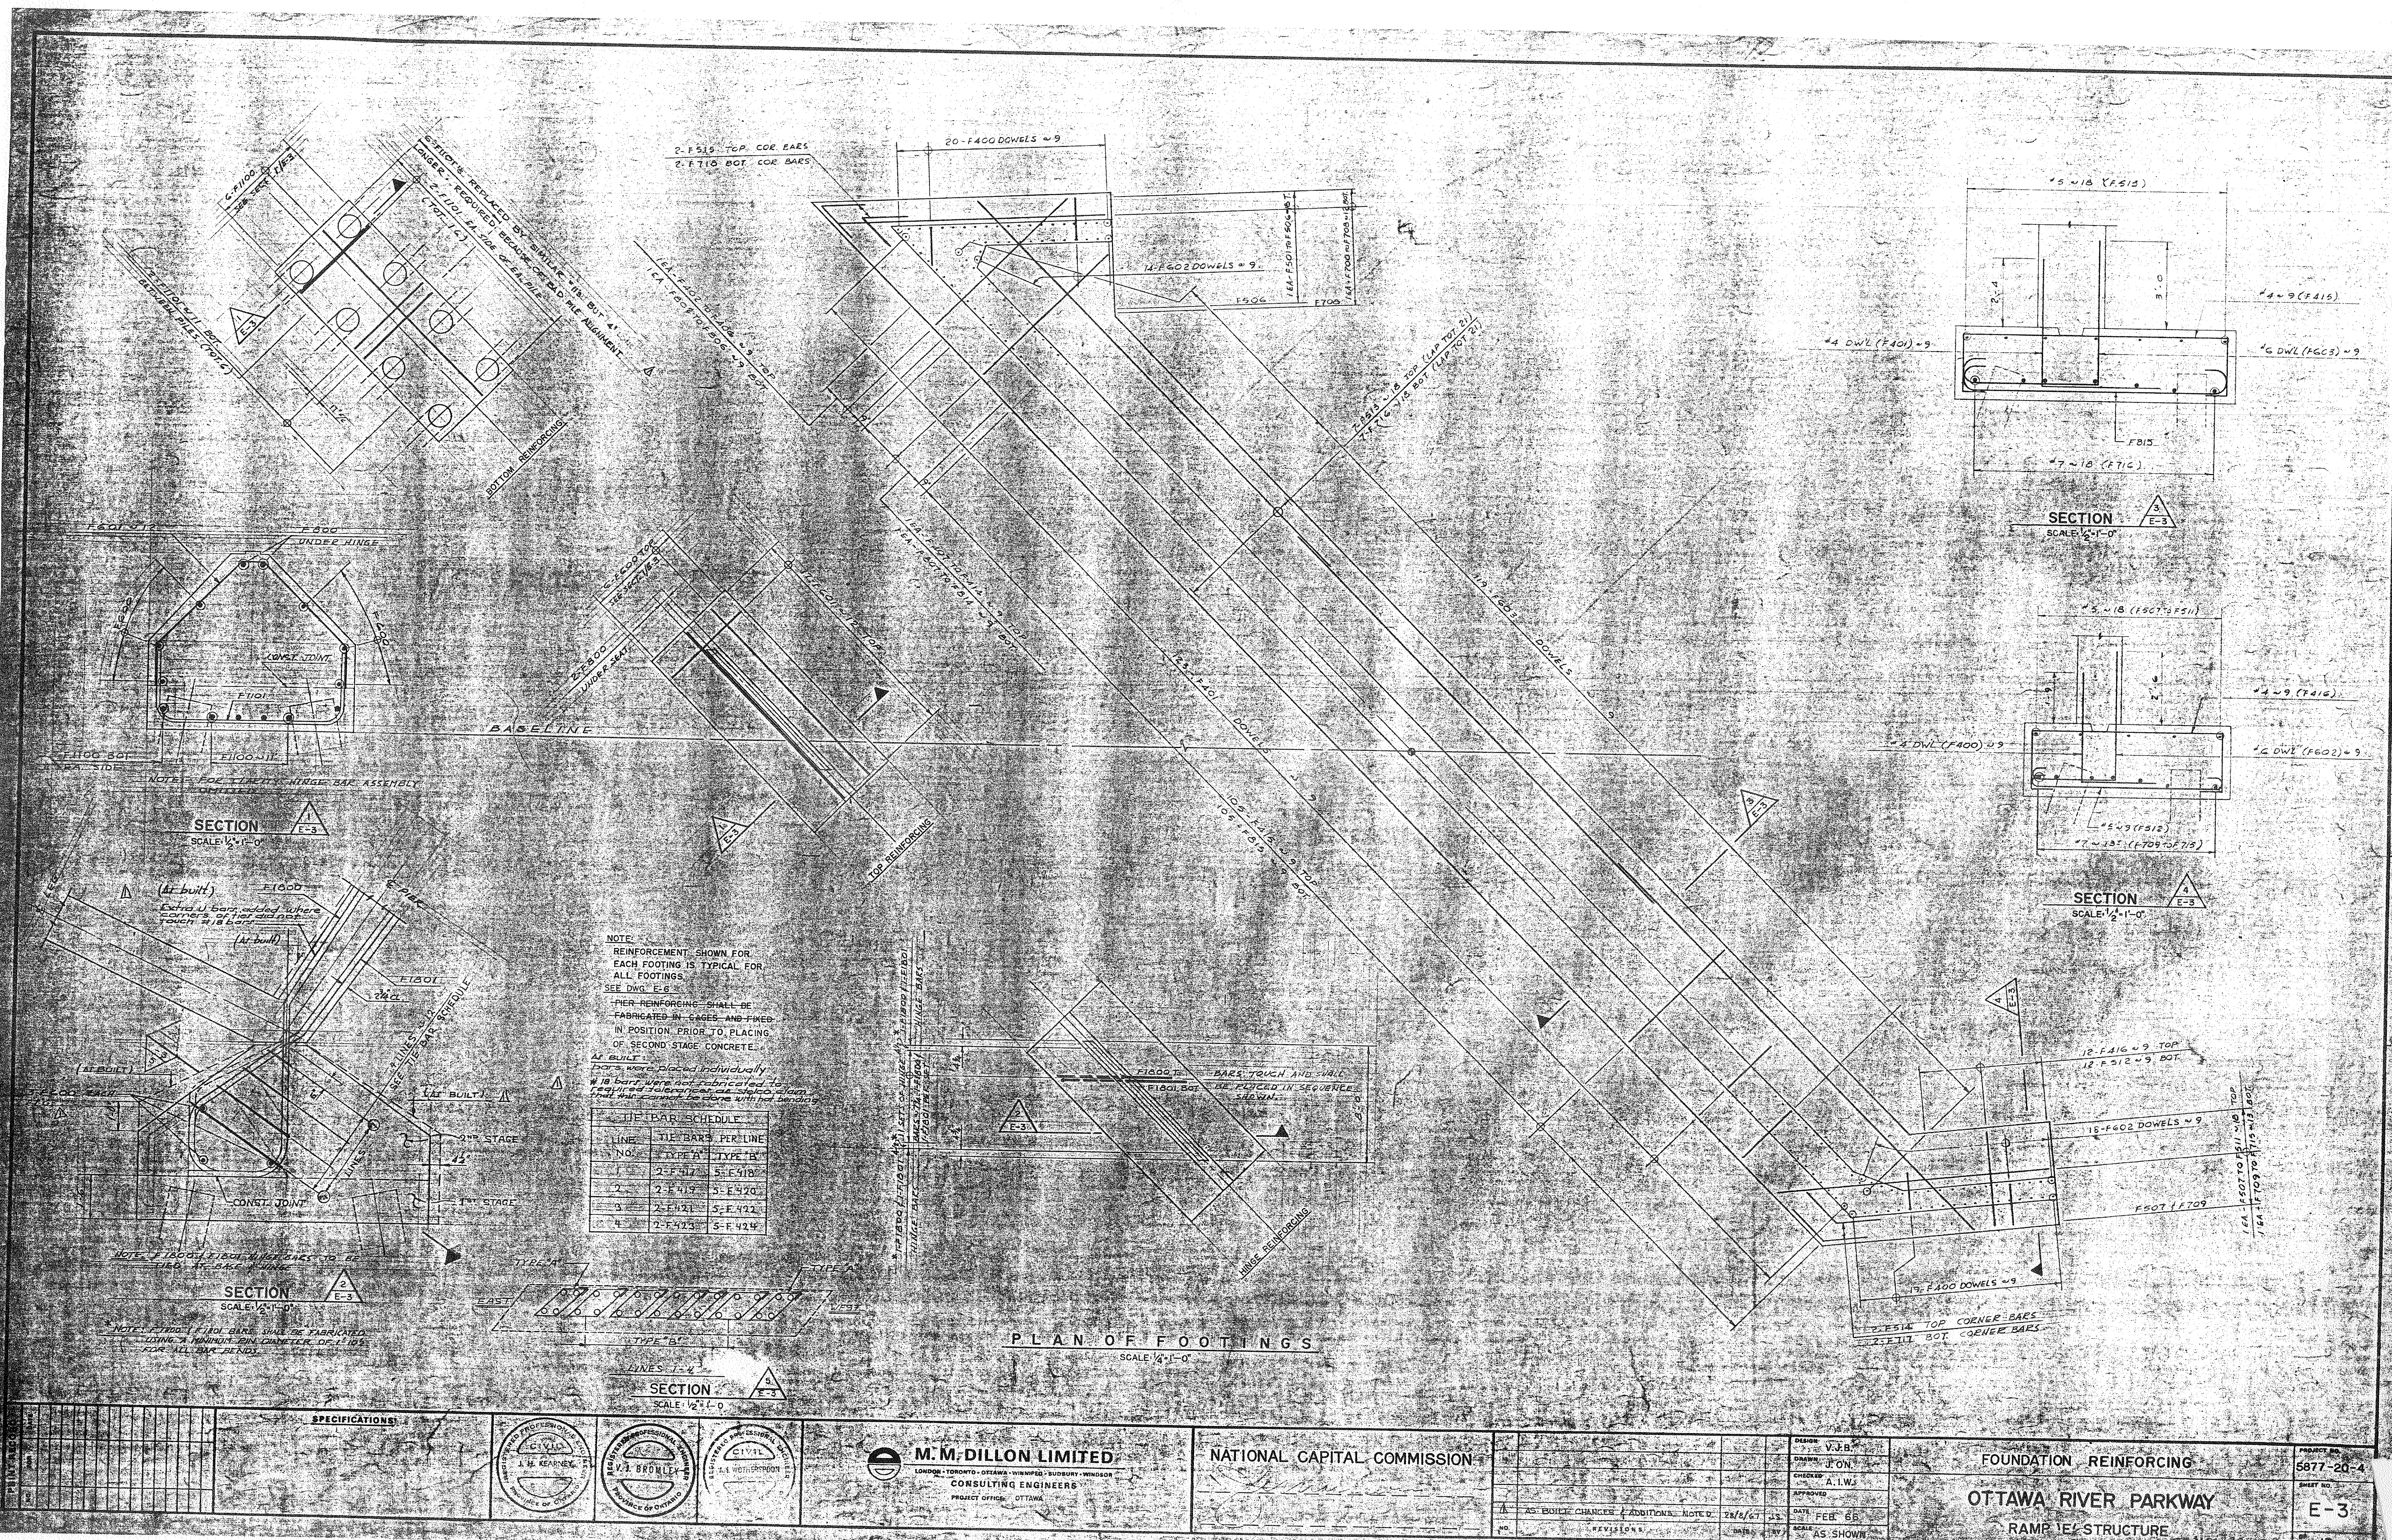


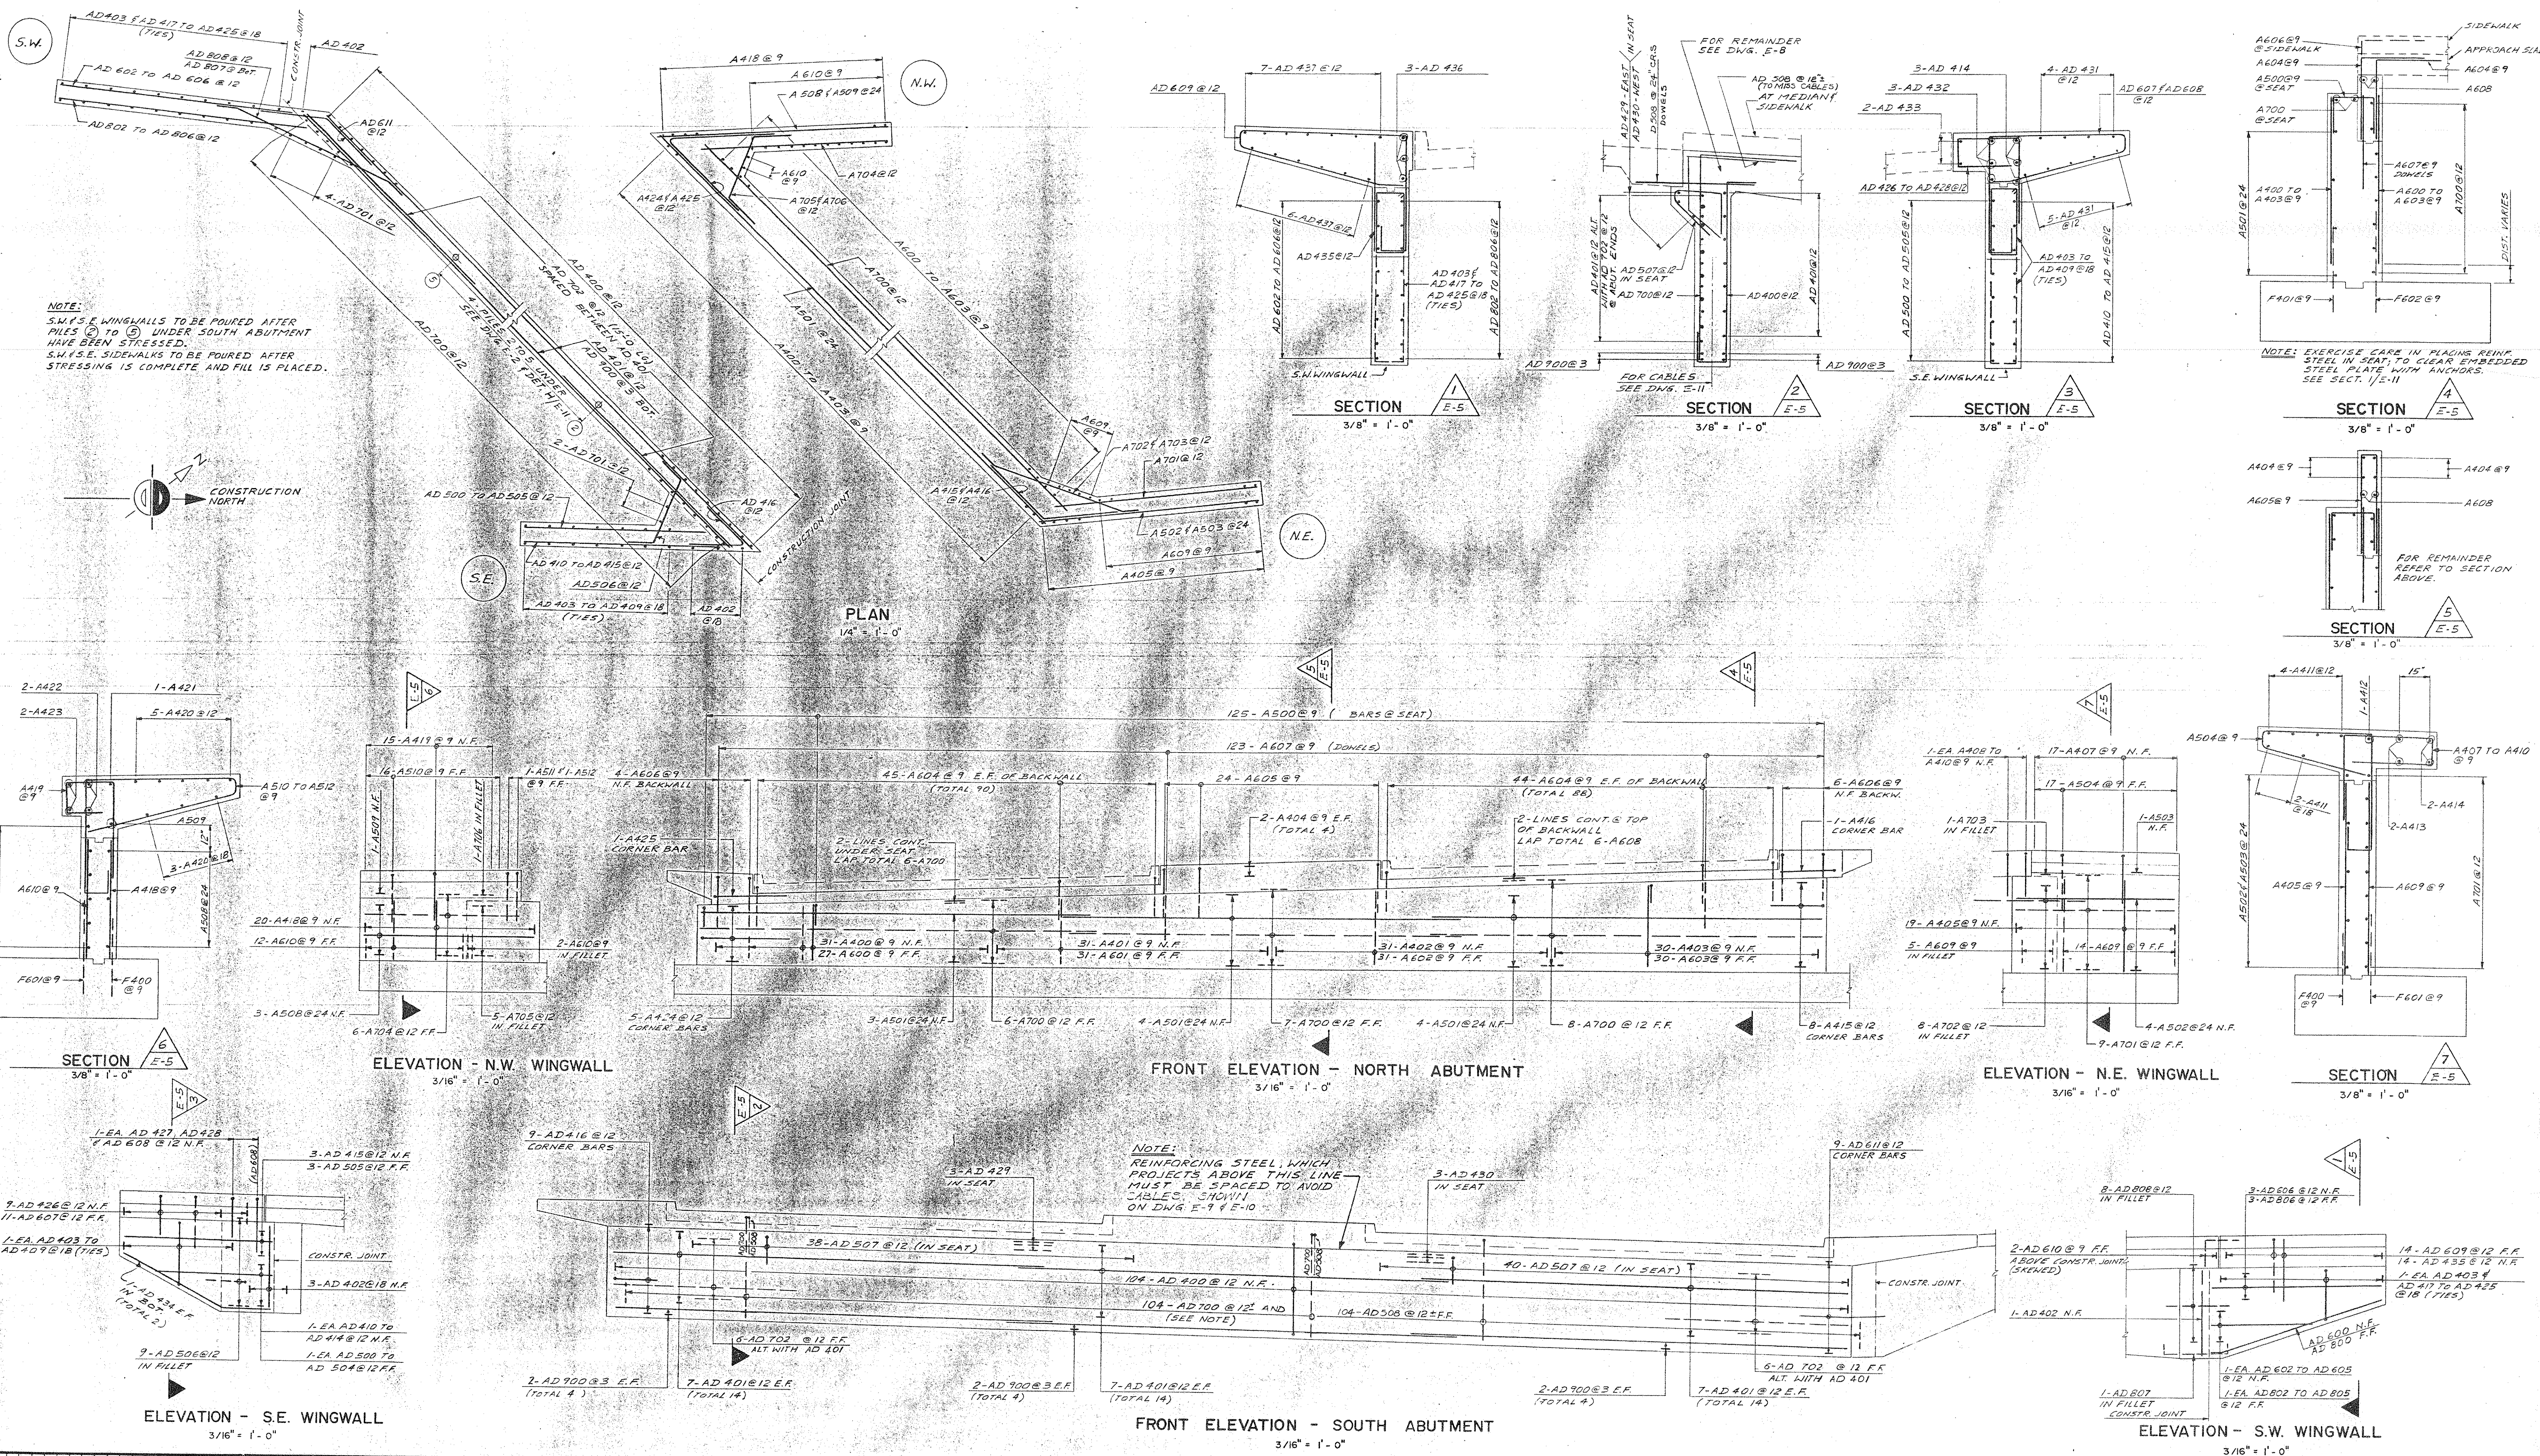


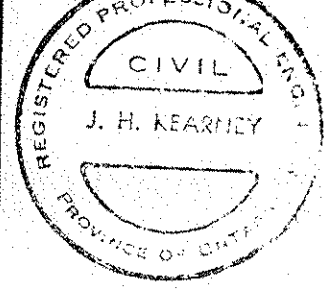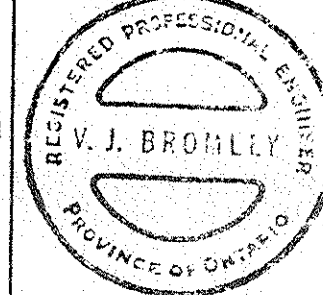PRINT RECORD FOR NO.	SPECIFICATIONS	 	 M.M. DILLON LIMITED LONDON • TORONTO • OTTAWA • WINNIPEG • SUDBURY • WINDSOR CONSULTING ENGINEERS PROJECT OFFICE: OTTAWA	NATIONAL CAPITAL COMMISSION	DESIGN V.J.B. DRAWN A.F. CHECKED A.I.W. APPROVED DATE FEB. 66. SCALE AS NOTED	ABUTMENT AND WINGWALL REINFORCING OTTAWA RIVER PARKWAY RAMP 'E' STRUCTURE	PROJECT NO. 5877-20-4 SHEET NO. E-5 OF 15
----------------------------	----------------	---	--	------------------------------------	--	---	--



<div>PRINT RECORD</div> <div>NO. DATE</div>	<div>SPECIFICATIONS</div>	<div>M.M. DILLON LIMITED</div> <div>LONDON • TORONTO • OTTAWA • WINNIPEG • SUDBURY • WINDSOR</div> <div>CONSULTING ENGINEERS</div> <div>PROJECT OFFICE: OTTAWA</div>	<div>NATIONAL CAPITAL COMMISSION</div>	<div>DESIGN V.J.B.</div> <div>DRAWN J.O.N.</div> <div>CHECKED A.I.W. V.J.B.</div> <div>APPROVED</div> <div>DATE FEB 1966</div> <div>SCALE AS NOTED</div>	<div>PROJECT NO. 5877-20-4</div> <div>SHEET NO. E-6</div> <div>PIER AND LEG LAYOUT AND REINFORCING</div> <div>OTTAWA RIVER PARKWAY</div> <div>RAMP 'E' STRUCTURE</div>
---	---------------------------	--	--	--	--

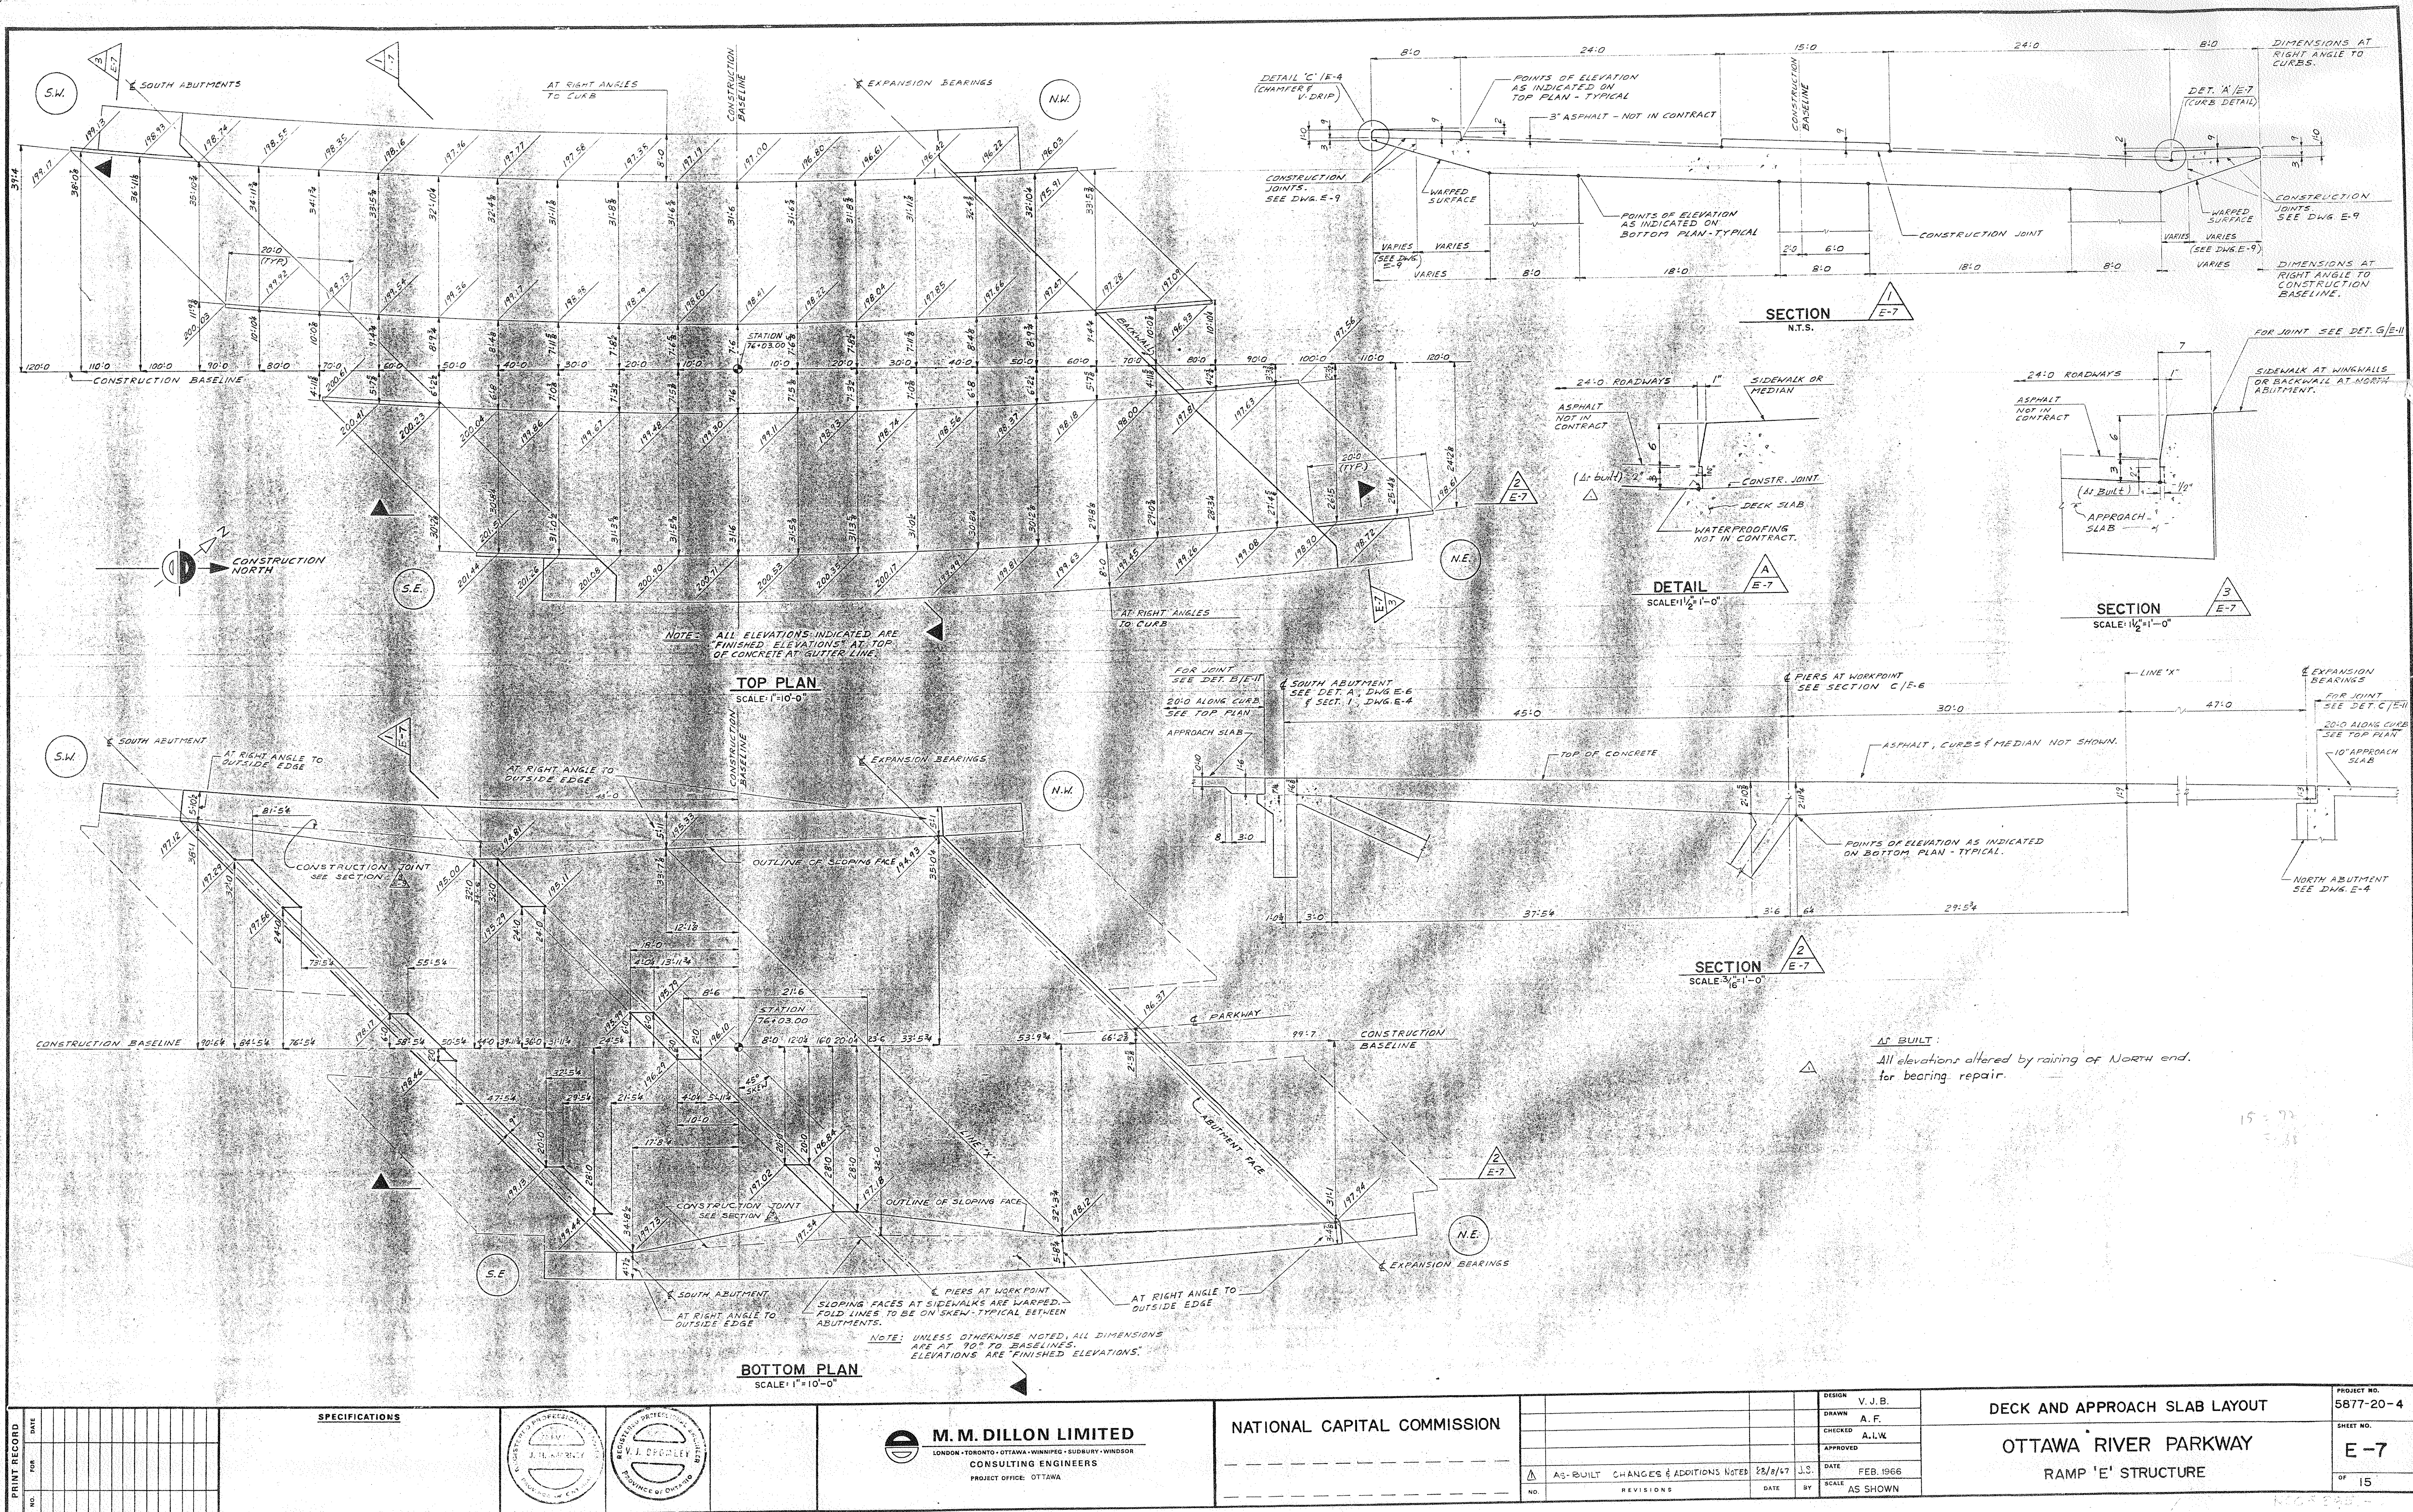

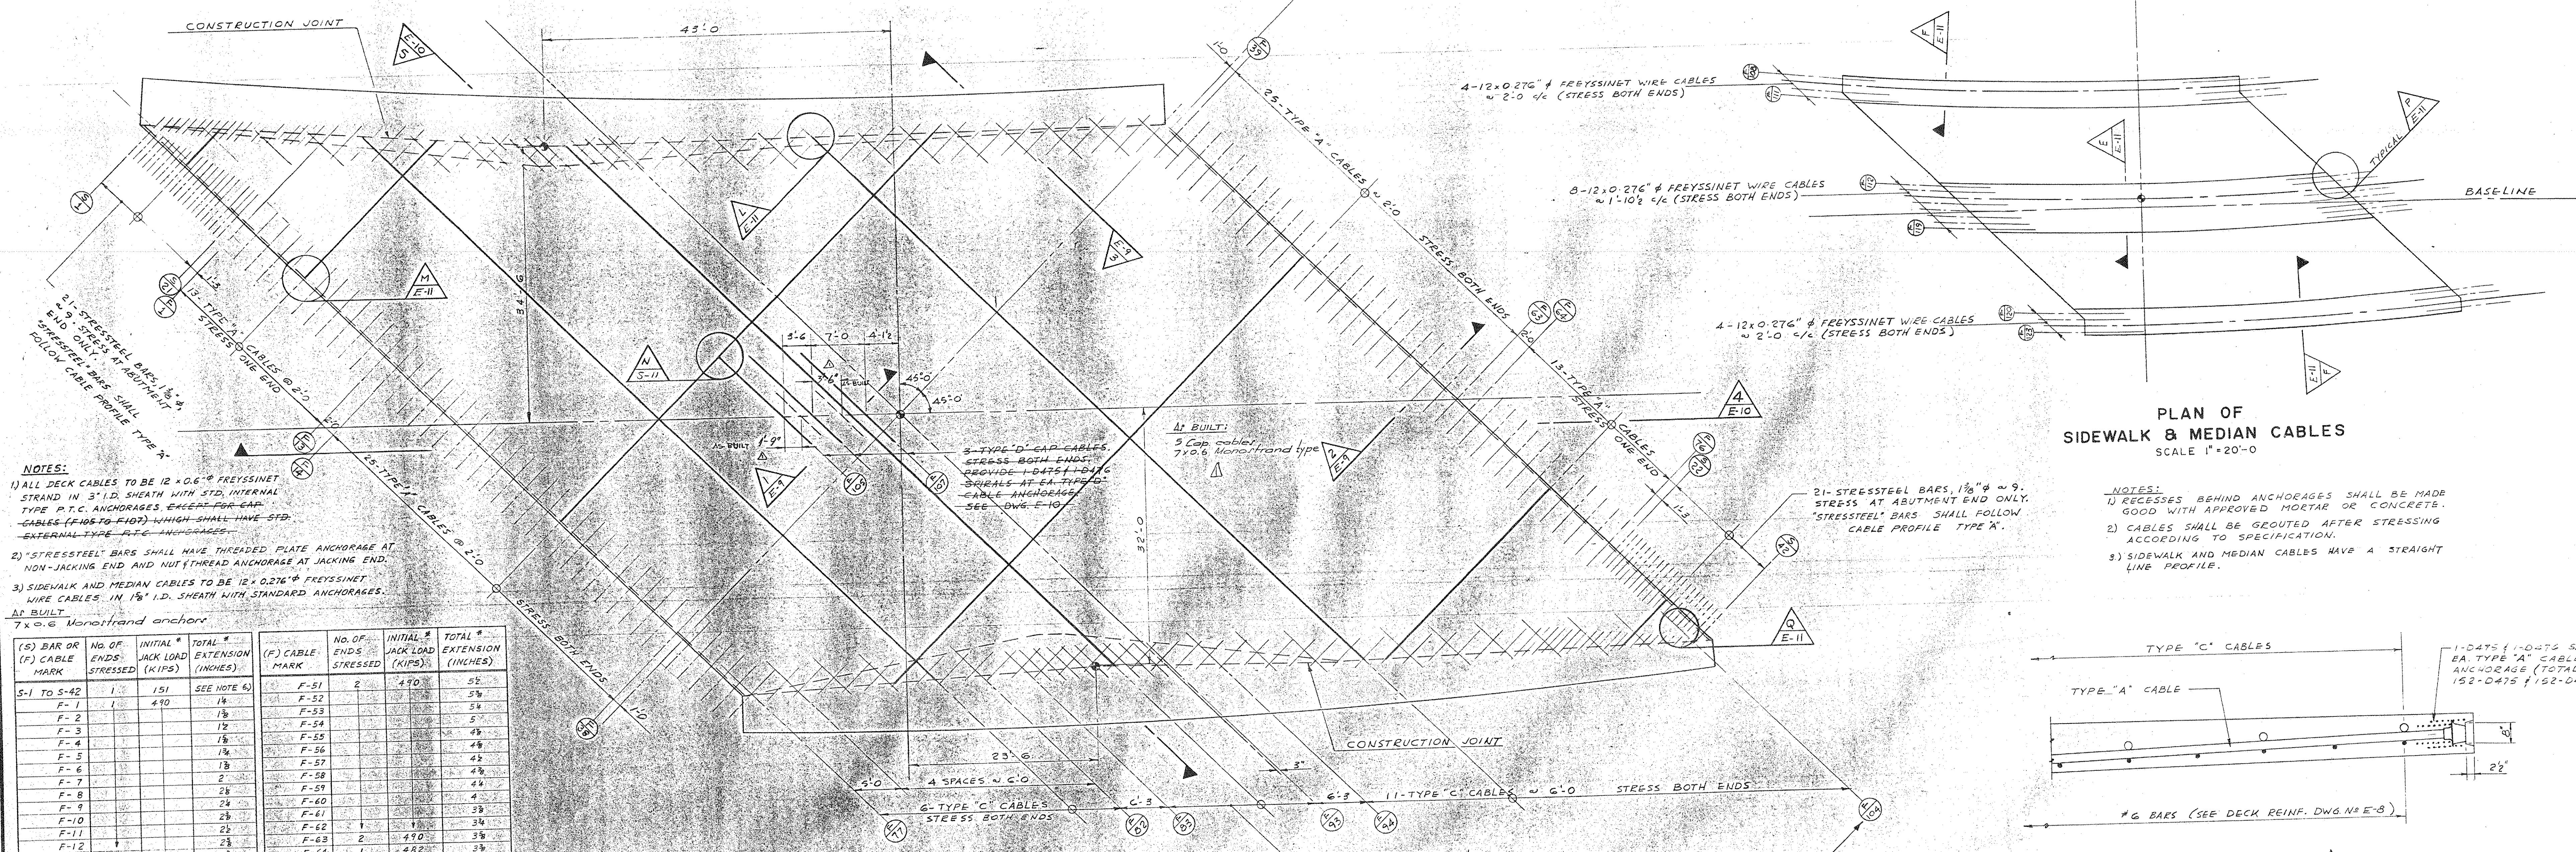


- NOTES:**
- 1) ALL DECK CABLES TO BE 12 x 0.6" FREYSSINET STRAND IN 3" I.D. SHEATH WITH STD. INTERNAL TYPE P.T.C. ANCHORAGES, EXCEPT FOR CAP CABLES (F-105 TO F-107) WHICH SHALL HAVE STD. EXTERNAL TYPE P.T.C. ANCHORAGES.
 - 2) "STRESS-STEEL" BARS SHALL HAVE THREADED PLATE ANCHORAGE AT NON-JACKING END AND NUT/THREAD ANCHORAGE AT JACKING END.
 - 3) SIDEWALK AND MEDIAN CABLES TO BE 12 x 0.276" FREYSSINET WIRE CABLES IN 1 1/2" I.D. SHEATH WITH STANDARD ANCHORAGES.
- AS BUILT
- 7 x 0.6 Monostrand anchors

(S) BAR OR (F) CABLE MARK	NO. OF ENDS STRESSED	INITIAL JACK LOAD (KIPS)	TOTAL EXTENSION (INCHES)	(F) CABLE MARK	NO. OF ENDS STRESSED	INITIAL JACK LOAD (KIPS)	TOTAL EXTENSION (INCHES)
S-1 TO S-42	1	151	SEE NOTE 5)	F-51	2	490	55
F-1	1	490		F-52			54
F-2				F-53			54
F-3				F-54			54
F-4				F-55			48
F-5				F-56			48
F-6				F-57			48
F-7				F-58			44
F-8				F-59			44
F-9				F-60			44
F-10				F-61			34
F-11				F-62			34
F-12				F-63	2	490	34
F-13				F-64	1	482	34
F-14	2			F-65			34
F-15				F-66			34
F-16				F-67			28
F-17				F-68			28
F-18				F-69			28
F-19				F-70			28
F-20				F-71			28
F-21				F-72			28
F-22				F-73			28
F-23				F-74			18
F-24				F-75			18
F-25				F-76	1	490	12
F-26				F-77	2	473	18
F-27				F-78			18
F-28				F-79			18
F-29				F-80			18
F-30				F-81			18
F-31				F-82			18
F-32				F-83			18
F-33				F-84			18
F-34				F-85			18
F-35				F-86			18
F-36				F-87			18
F-37				F-88			18
F-38				F-89			18
F-39				F-90			18
F-40				F-91			18
F-41				F-92			18
F-42				F-93			18
F-43				F-94			18
F-44				F-95			18
F-45				F-96			18
F-46				F-97			18
F-47				F-98			18
F-48				F-99			18
F-49				F-100			18
F-50				F-101			18

- NOTES:**
- 4) INITIAL JACKING LOAD AND TOTAL EXTENSION INCLUDES ALLOWANCE FOR ANCHORAGE "DRAW IN" AT JACKING END(S) AS FOLLOWS: a) FOR 12 x 7/8" STRAND CABLE FOR ONE ANCHORAGE = 7/8" b) FOR 12 x 0.276" WIRE CABLE FOR ONE ANCHORAGE = 1/4" EXCEPT AS NOTED IN 5)
 - 5) NO "DRAW IN" HAS BEEN ALLOWED FOR THE FOLLOWING: a) FOR CAP CABLES WITH EXTERNAL ANCHORAGES. b) FOR "STRESS-STEEL" BARS.
 - 6) "STRESS-STEEL" BAR EXTENSIONS NOT GIVEN; DIMENSIONER SHALL BE USED WHEN JACKING. (AS BUILT)

STRAND SPECIFICATIONS

TYPE	UNCOATED	COATED
3/8" dia. strand (Freyssinet)	Ultimate tensile strength 235,000 P.S.I. Gross sectional area 0.215 sq.in. Min. load at 1% elongation 43,350 lbs.	210,000 P.S.I. 0.215 sq.in. 39,000 lbs.
0.276" dia. wire (Freyssinet)	Ultimate tensile strength 235,000 P.S.I. Gross sectional area 0.0598 sq.in. Min. load at 1% elongation 11,230 lbs.	
1 1/2" dia. bar (Stress-steel)	Ultimate tensile strength 145,000 P.S.I. Gross sectional area 1.405 sq.in. Min. load at 0.7% extension 103,000 lbs.	

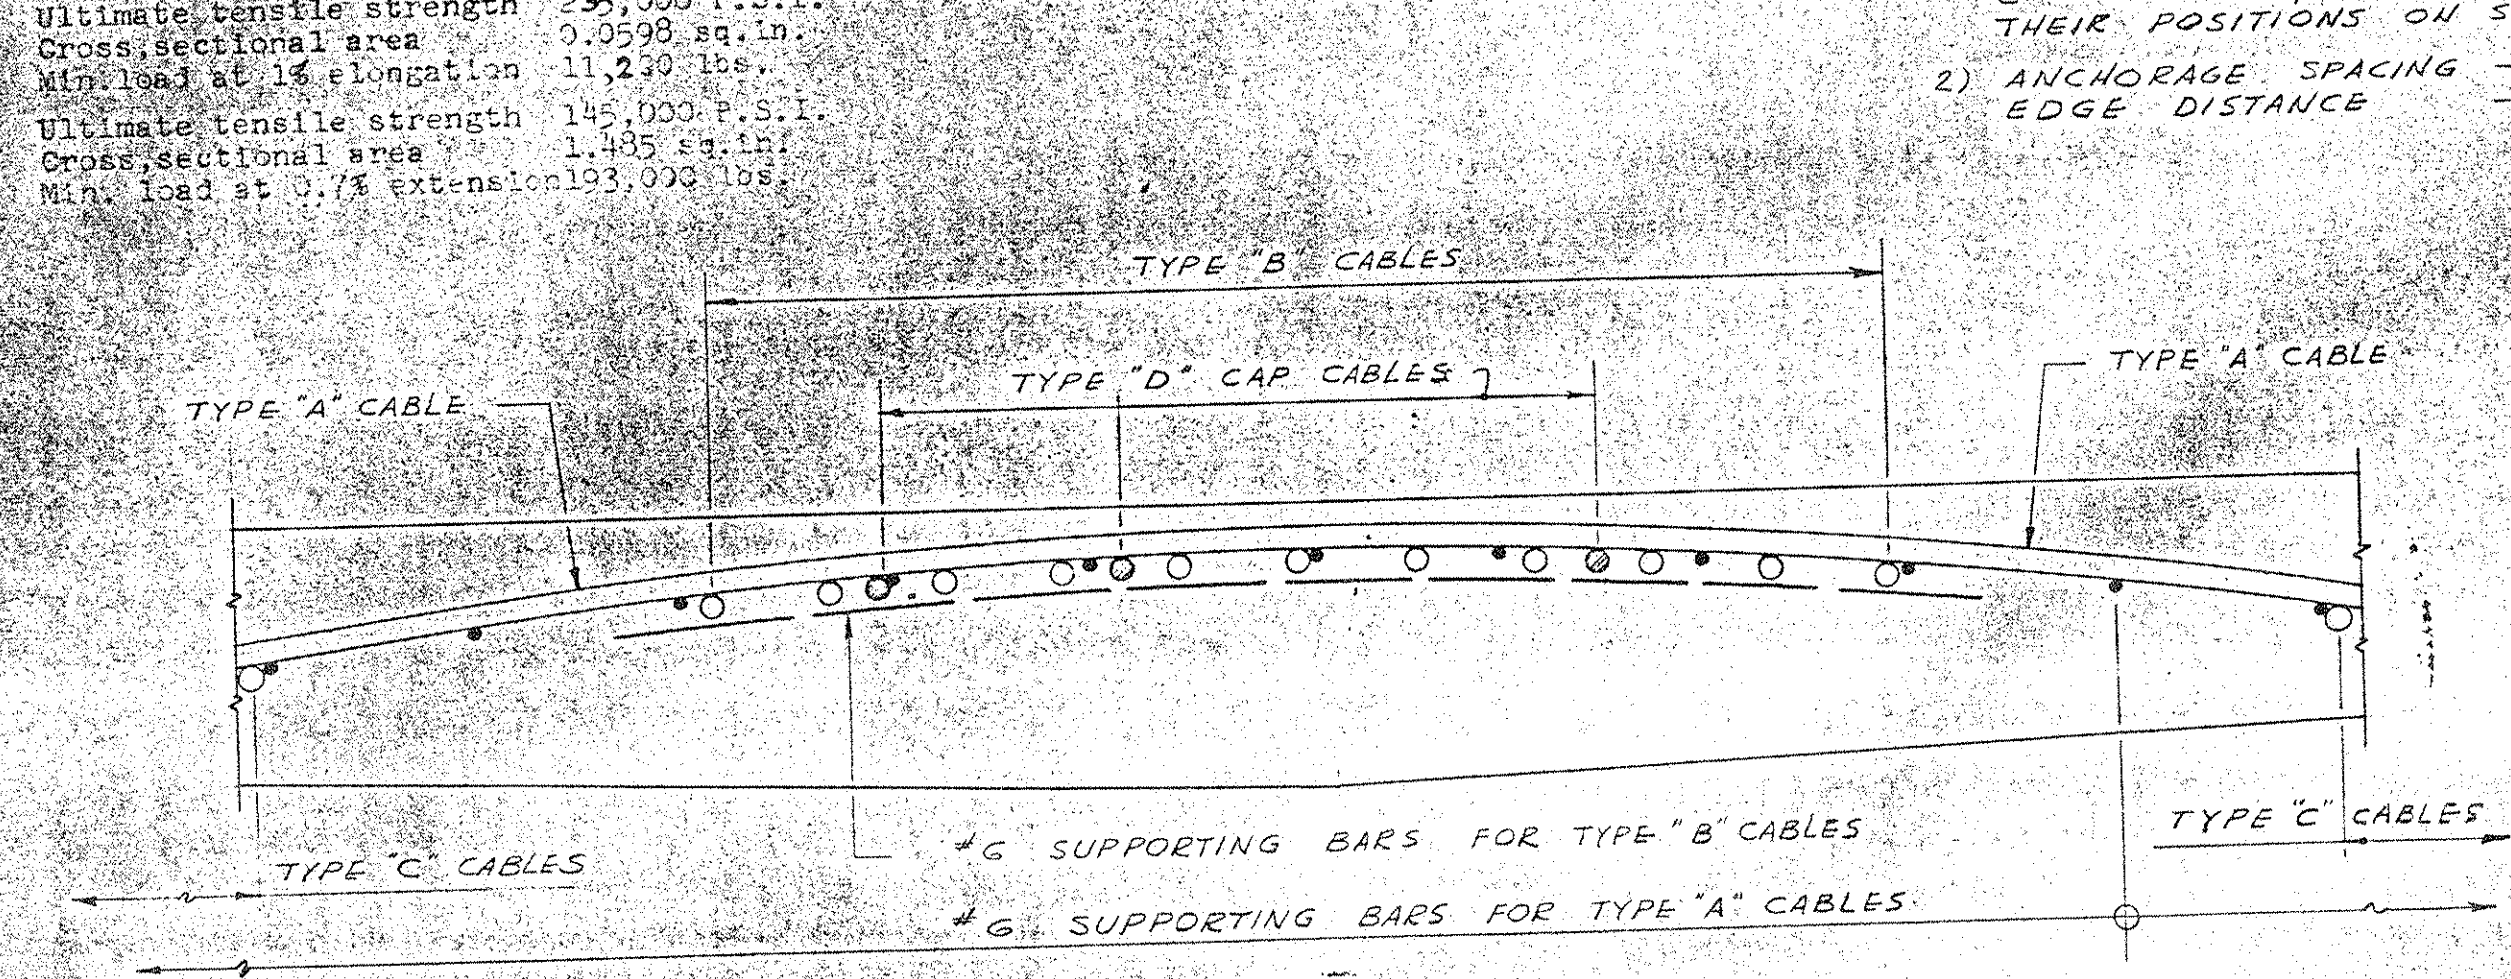


SECTION 1/E-9
SCALE 1/2" = 1'-0"

- STRESSING SEQUENCE**
1. P77 to P104
 2. P105 to P107
 3. P35 to P37
 4. P38 to P50
 5. P51 to P53
 6. P54 to P56
 7. P57 to P59
 8. P60 to P62
 9. P63 to P65
 10. P66 to P68
 11. P69 to P71
 12. P72 to P74
 13. P75 to P77
 14. P78 to P80
 15. P81 to P83
 16. P84 to P86
 17. P87 to P89
 18. P90 to P92
 19. P93 to P95
 20. P96 to P98
 21. P99 to P101
 22. P102 to P104


* Cables shall be stressed in ascending or descending order as noted.

PLAN OF SIDEWALK & MEDIAN CABLES
SCALE 1" = 20'-0"

- NOTES:**
- 1) RECESSES BEHIND ANCHORAGES SHALL BE MADE GOOD WITH APPROVED MORTAR OR CONCRETE.
 - 2) CABLES SHALL BE GROUTED AFTER STRESSING ACCORDING TO SPECIFICATION.
 - 3) SIDEWALK AND MEDIAN CABLES HAVE A STRAIGHT LINE PROFILE.

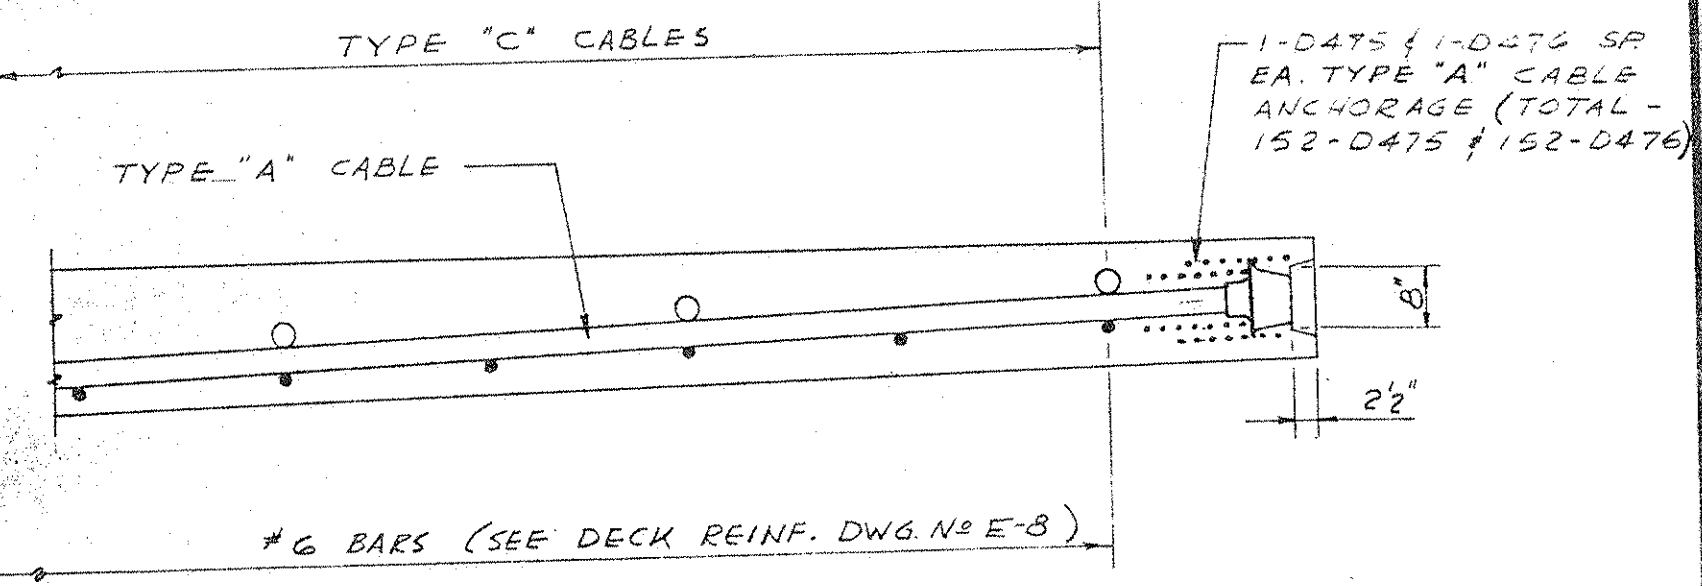


SECTION 2/E-9
SCALE 1/2" = 1'-0"

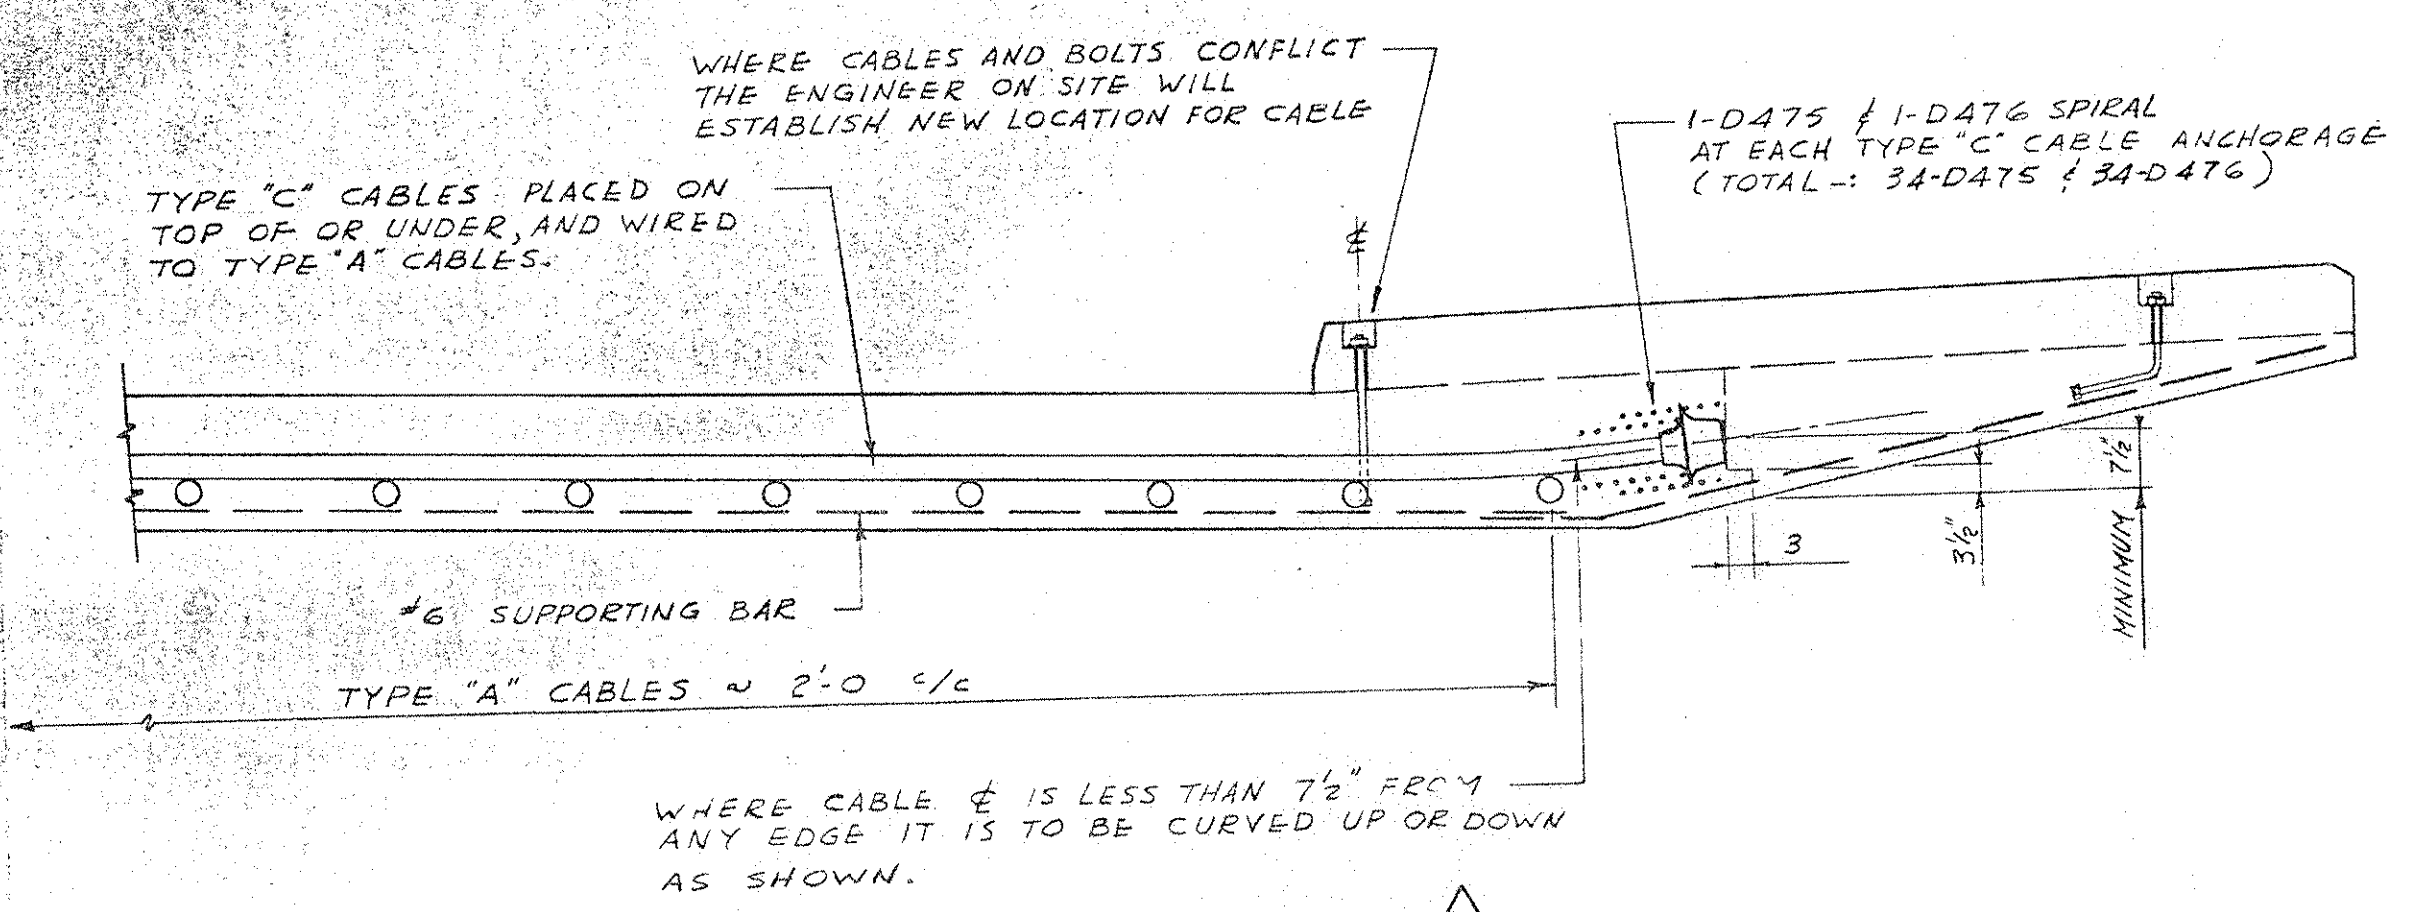


SECTION 3/E-9
SCALE 1/2" = 1'-0"


PRINT RECORD NO. DATE FOR	SPECIFICATIONS CIVIL J. M. KIRBY J. BRADLEY J. BRADLEY		M. M. DILLON LIMITED LONDON • TORONTO • OTTAWA • WINNIPEG • SUDBURY • WINDSOR CONSULTING ENGINEERS PROJECT OFFICE: OTTAWA		NATIONAL CAPITAL COMMISSION		DESIGN V.J.B. DRAWN J.O.N. CHECKED A.I.W. APPROVED AS BUILT CHANGES & ADDITIONS NOTED 28/8/67 J.B. DATE FEB. 1966 SCALE AS NOTED		DECK CABLE LAYOUT OTTAWA RIVER PARKWAY RAMP 'E' STRUCTURE		PROJECT NO. 5877-20-4 SHEET NO. E-9 OF 15

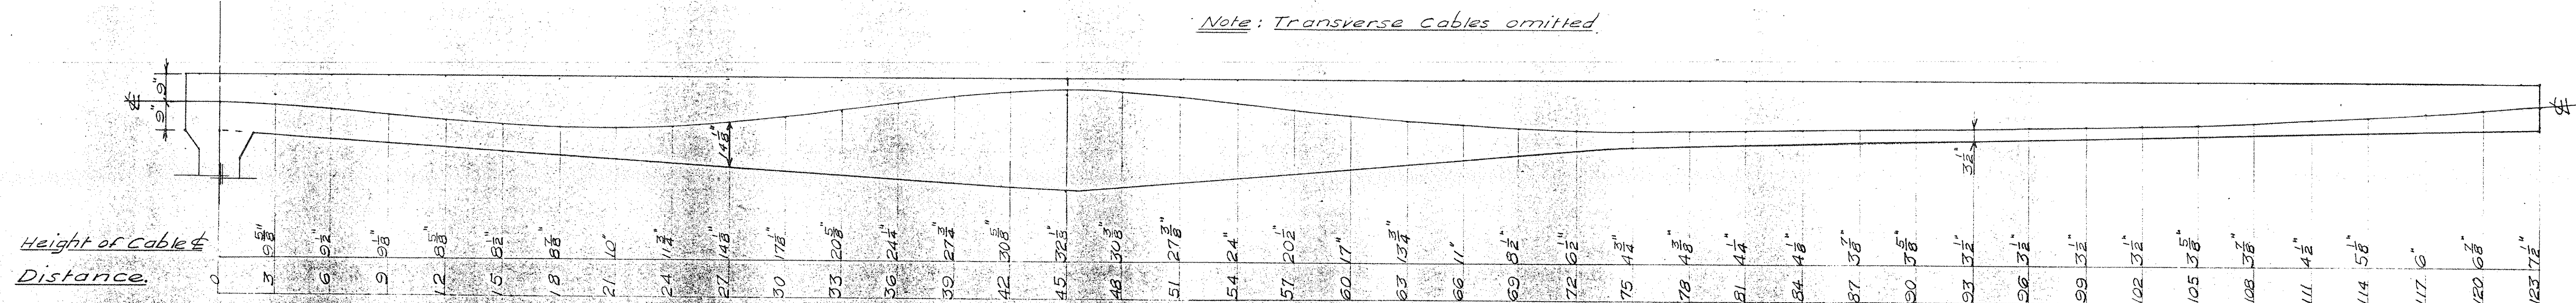

SECTION E-9
LONGITUDINAL CABLE PROFILE — TYPE A
SCALE: HORIZ. 1/4" = 1'-0"
VERT. 1/2" = 1'-0"

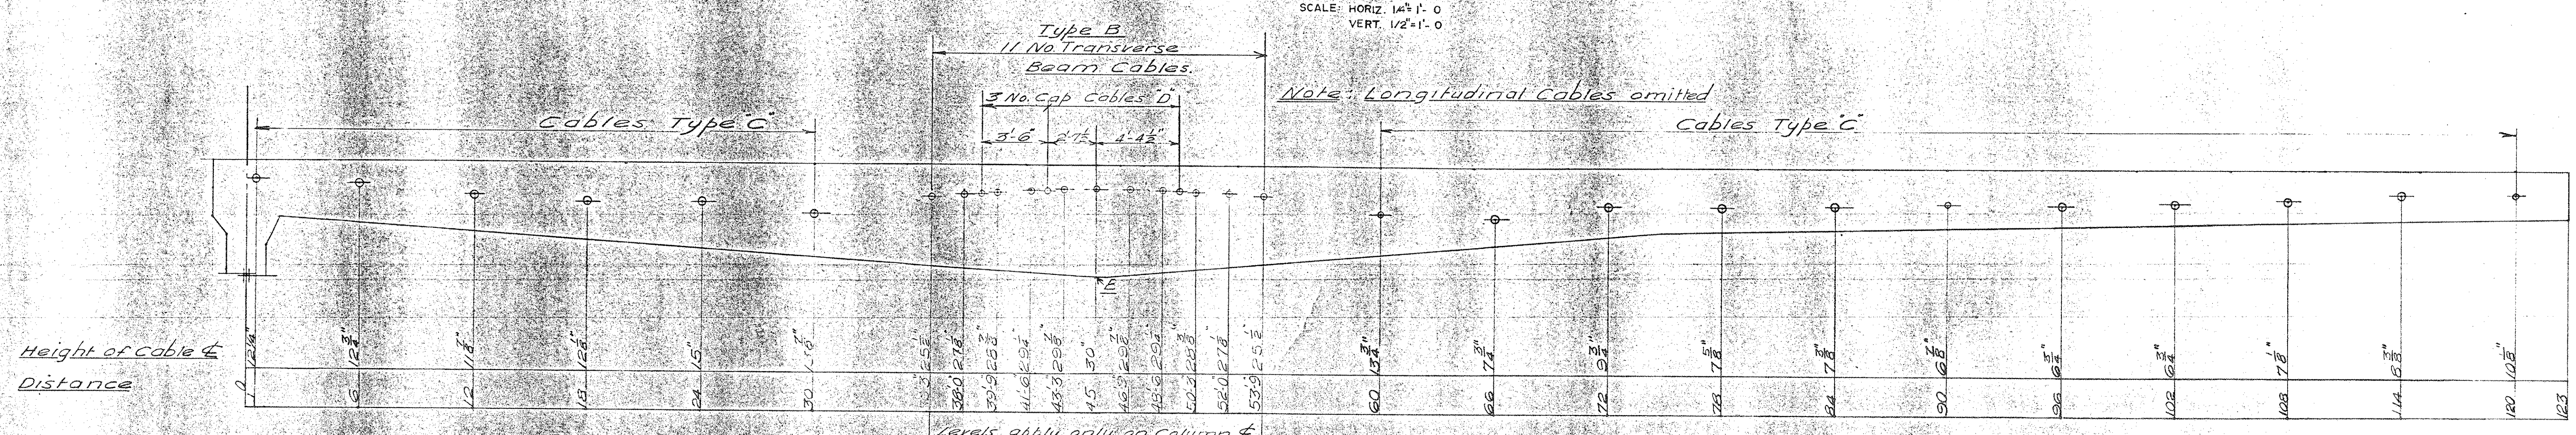

SECTION E-9
TRANSVERSE CABLE POSITIONS
SCALE: HORIZ. 1/4" = 1'-0"
VERT. 1/2" = 1'-0"

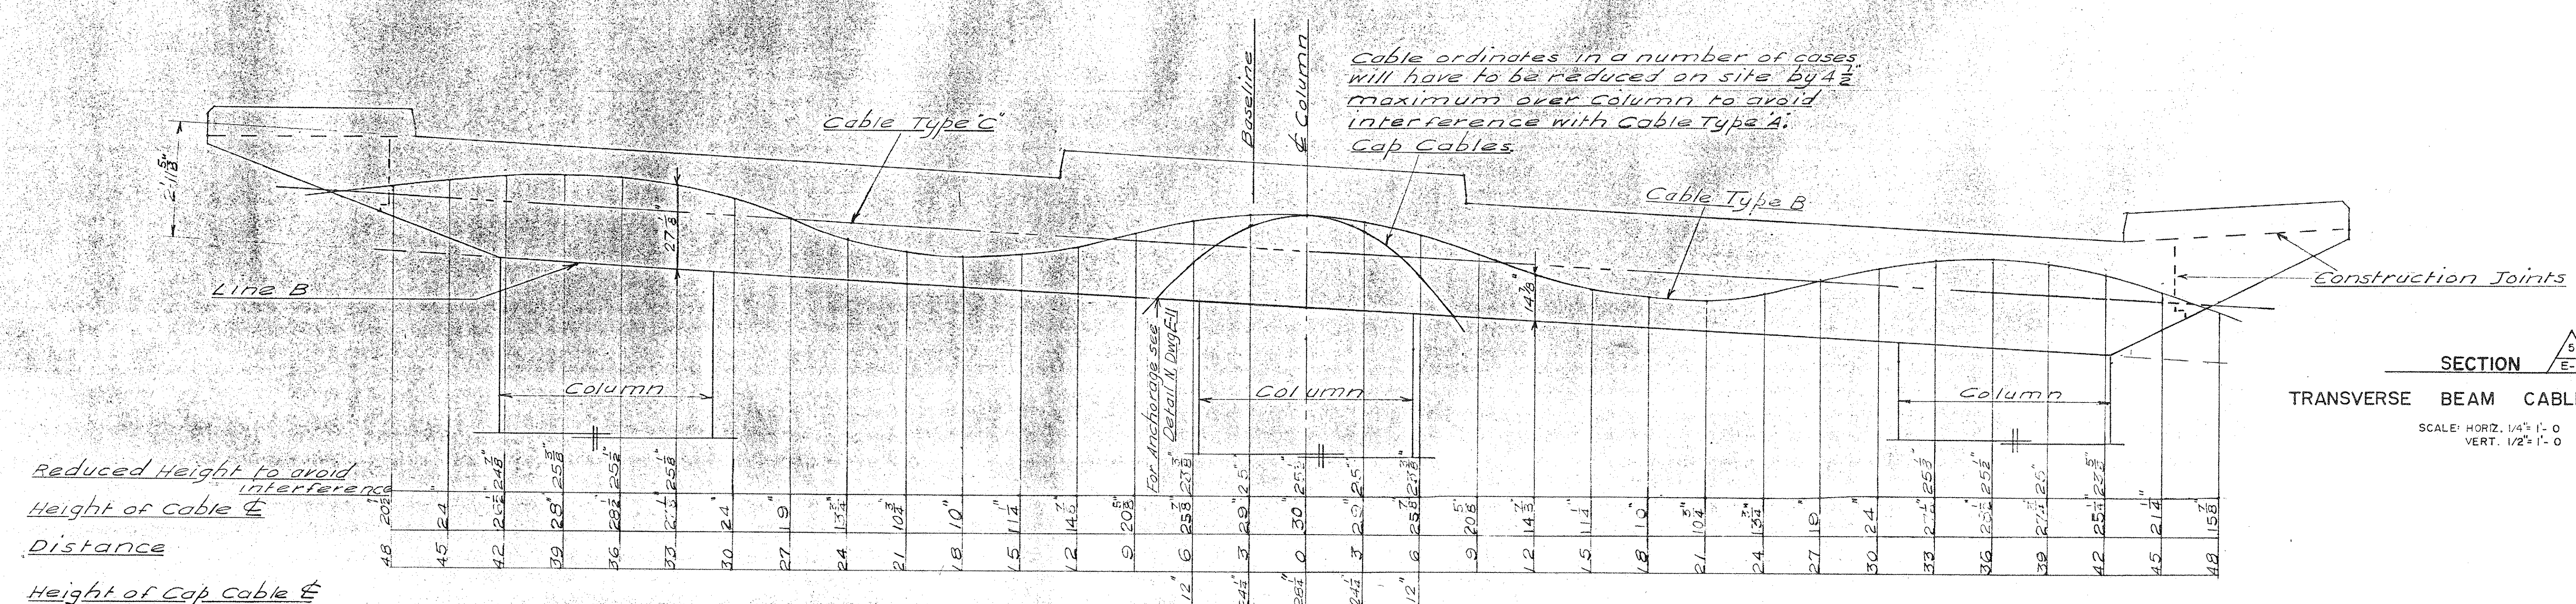

SECTION E-9
TRANSVERSE BEAM CABLE PROFILE
SCALE: HORIZ. 1/4" = 1'-0"
VERT. 1/2" = 1'-0"

MARK	NO. BARS	SIZE	LENGTH	TYPE	A	B	C	D	E	F	G	H	J	K	L	R	SHAPE	WEIGHT	LOCATION
FOUNDATION PILES																			
INTER. A15-64	FP-400	32	#4	5'-2"	T3														
	FP-401	4	#4																
	FP-500	32	#5	3'-0"	STR														
	FP-501	144	#5	2'-6"	STR														
PIER-LEG FOOTINGS																			
	F 417	6	#4	4'-8"	T3	6"	11"	11"	11"	11"	6"	7 1/2"	8"						
	F 418	15	#4	5'-4"	T3	6"	11"	11"	11"	11"	6"	7 1/2"	8"						
	F 419	6	#4	6'-10"	T3	6"	11"	2'-0"	11"	2'-0"	6"	1'-6 1/2"	1'-3 1/2"						
	F 420	15	#4	7'-6"	T3	6"	11"	2'-0"	11"	2'-0"	6"	1'-6 1/2"	1'-3 1/2"						
	F 421	6	#4	8'-10"	T3	6"	11"	3'-0"	11"	3'-0"	6"	2'-4 1/2"	1'-9 1/2"						
	F 422	15	#4	9'-6"	T3	6"	11"	3'-0"	11"	3'-0"	6"	2'-4 1/2"	1'-9 1/2"						
	F 423	6	#4	10'-4"	T3	6"	11"	3'-9"	11"	3'-9"	6"	3'-0"	2'-2 1/2"						
	F 424	15	#4	11'-0"	T3	6"	11"	3'-9"	11"	3'-9"	6"	3'-0"	2'-2 1/2"						
	F 600	27	#6	15'-6"	STR														
	F 601	51	#6	11'-4"	STR	1'-3"	4'-0"	10'	4'-0"	1'-3"			2'-10"	6'-6"					
	F 602	6	#8	16'-6"	STR														
	F 1101	18	#11	15'-6"	STR														
	F 1101	66	#11	11'-0"	STR	2'-3"	6'-6"				2'-3"	2'-8"							
NORTH ABUTMENT FOOTING																			
INTER. A15-64	F 400	39	#4	6'-6"	2	4'-0"	2'-0"												
	F 401	128		5'-7"	2	4'-7"	4'-0"												
	F 402	1		12'-8"	56	8	2'-0"	10'-0"											
	F 403	1		13'-5"	56	8	2'-0"	10'-9"											
	F 404	1		14'-5"	56	8	2'-0"	11'-9"											
	F 405	1		15'-5"	56	8	2'-0"	12'-9"											
	F 406	1		16'-2"	56	8	2'-0"	13'-6"											
	F 407	1		17'-11"	56	8	2'-0"	14'-3"											
	F 408	1		18'-2"	56	8	2'-0"	15'-6"											
	F 409	1		19'-5"	56	8	2'-0"	16'-3"											
	F 410	1		20'-11"	56	8	2'-0"	17'-3"											
	F 411	1		21'-5"	56	8	2'-0"	18'-9"											
	F 412	1		22'-9"	56	8	2'-0"	19'-10"											
	F 413	1		23'-2"	56	8	2'-0"	20'-6"											
	F 414	1		24'-5"	56	8	2'-0"	21'-9"											
	F 415	108		14'-4"	56	8	2'-0"	19'-10"	2'-0"										
	F 416	12	1	11'-10"	56	8	2'-0"	16'-6"	2'-0"										
	F 501	1	#5	19'-3"	STR														
	F 502	1		18'-0"	STR														
	F 503	1		16'-6"	STR														
	F 504	1		15'-9"	STR														
	F 505	1		13'-9"	STR														
	F 506	1		12'-5"	STR														
	F 507	1		15'-9"	STR														
	F 508	1		17'-0"	STR														
	F 509	1		18'-6"	STR														
	F 510	1		19'-9"	STR														
	F 511	1		21'-0"	STR														
	F 512	12	7'-8"	1	7'	6'-6"													
	F 513	21		24'-6"	STR														
	F 514	2		21'-0"	19	3'-0"	3'-0"						2'-4"	1'-11"	4'-11"				
	F 515	2	1	24'-0"	X-2	3'-0"	3'-0"						2'-3"	2'-0"					


REINFORCING
GRADE
ASTM
INTER. A15-64

MARK	NO. BARS	SIZE	LENGTH	TYPE	A	B	C	D	E	F	G	H	J	K	L	R	SHAPE	WEIGHT	LOCATION
NORTH ABUTMENT FOOTING (CONTD.)																			
INTER. A15-64	F 602	32	#6	8'-3"	21	8'	2'-10"	4'-9"											
	F 603	119	#6	10'-6"	21	8'	4'-7"	5'-3"											
	F 700	1	#7	19'-3"	STR														
	F 701	1		18'-9"															
	F 702	1		17'-6"															
	F 703	1		16'-9"															
	F 704	1		16'-0"															
	F 705	1		15'-3"															
	F 706	1		14'-3"															
	F 707	1		13'-3"															
	F 708	1		12'-3"															
	F 709	1		15'-9"															
	F 710	1		16'-9"															
	F 711	1		17'-3"															
	F 712	1		18'-0"															
	F 713	1		18'-9"															
	F 714	1		19'-3"															
	F 715	1		21'-0"															
	F 716	21		24'-6"	1														
	F 717	2		26'-0"	19	3'-0"	3'-0"					2'-4"	1'-11"	4'-11"					
	F 718	2	1	26'-0"	X-2	3'-0"	3'-0"					2'-3"	2'-0"						
	F 802	1	#8	12'-2"	1	1'-1"	10'-0"												
	F 803	1		12'-11"	1	1'-1"	10'-9"												
	F 804	1		13'-11"	1	1'-1"	11'-9"												
	F 805	1		14'-8"	1	1'-1"	12'-6"												
	F 806	1		15'-8"	1	1'-1"	13'-6"												
	F 807	1		16'-5"	1	1'-1"	14'-3"												
	F 808	1		16'-8"	1	1'-1"	15'-6"												
	F 809	1		16'-2"	1	1'-1"	15'-0"												
	F 810	1		14'-5"	1	1'-1"	12'-3"												
	F 811	1		13'-11"	1	1'-1"	11'-9"												
	F 812	1		19'-2"	1	1'-1"	11'-0"												
	F 813	1		12'-8"	1	1'-1"	10'-6"												
	F 814	1		11'-11"	1	1'-1"	9'-9"												
	F 815	105	1	11'-2"	1	1'-1"	9'-0"												

REINFORCING GRADE	ASTM	MARK	NO. BARS	SIZE	LENGTH	TYPE	A	B	C	D	E	F	G	H	J	K	L	R	SHAPE	WEIGHT	LOCATION
PIER AND LEG																					
INTER.	A15-64	P 300	57	* 3	3'-2"	X-11	1'-0"	1'-2"					1'-0"								
		P 301	2103	* 3	3'-5"	X-11	1'-0"	1'-5"					1'-0"								
		P 400	222	* 4	13'-2"	X-12	1'-1"	11'-0"					1'-1"	1'-0 1/2"	0'-4 1/2"						
		P 401	222	* 4	13'-6"	X-12	1'-4"	11'-0"					1'-4"	1'-5"	0'-5 1/2"						
		P 402	6		13'-2"	X-12	1'-1"	11'-0"					1'-1"	0'-10 1/2"	0'-7 1/2"						
		P 403	6		5'-6"	X-13	0'-6"	0'-11"	1'-4"	0'-11"	1'-4"		0'-6"	1'-0"	0'-10 1/2"						
		P 404	15		0'-2"	X-13	0'-6"	1'-3"	1'-4"	1'-3"	1'-4"		0'-6"	1'-0"	0'-10 1/2"						
		P 405	18		13'-6"	X-12	1'-4"	11'-0"					1'-4"	1'-1"	0'-9"						
		P 406	18		0'-2"	X-13	0'-6"	0'-11"	1'-7"	0'-11"	1'-7"		0'-6"	1'-2 1/2"	1'-0 1/2"						
		P 407	45		0'-8"	X-13	0'-6"	1'-5"	1'-7"	1'-3"	1'-7"		0'-6"	1'-2 1/2"	1'-0 1/2"						
		P 408	18		13'-10"	X-12	1'-5"	11'-0"					1'-5"	1'-2"	0'-9 1/4"						
		P 409	18		0'-2"	X-13	0'-6"	0'-11"	1'-8"	0'-11"	1'-8"		0'-6"	1'-3"	1'-1 1/2"						
		P 410	45		0'-10"	X-13	0'-6"	1'-5"	1'-8"	1'-3"	1'-8"		0'-6"	1'-3"	1'-1 1/2"						
		P 411	12		14'-0"	X-12	1'-6"	11'-0"					1'-6"	1'-3"	0'-10 1/2"						
		P 412	6		0'-4"	X-13	0'-6"	0'-11"	1'-9"	0'-11"	1'-9"		0'-6"	1'-4"	1'-1 1/2"						
		P 413	30		7'-0"	X-13	0'-6"	1'-3"	1'-9"	1'-3"	1'-9"		0'-6"	1'-4"	1'-1 1/2"						
		P 414	3		4'-6"	X-13	0'-6"	0'-11"	0'-10"	0'-11"	0'-10"		0'-6"	0'-7"	0'-7 1/2"						
		P 415	3		5'-2"	X-13	0'-6"	0'-11"	1'-2"	0'-11"	1'-2"		0'-6"	1'-0"	0'-7 1/2"						
		P 416	3		4'-4"	X-13	0'-6"	0'-11"	0'-9"	0'-11"	0'-9"		0'-6"	0'-10 1/2"	0'-5"						
		P 417	3		5'-4"	X-13	0'-6"	0'-11"	1'-5"	0'-11"	1'-5"		0'-6"	0'-11"	0'-10 1/2"						
		P 418	6		14'-2"	X-12	1'-7"	11'-0"					1'-7"	1'-3 1/2"	0'-11"						
		P 419	15		1'-2"	X-13	0'-6"	1'-3"	1'-10"	1'-3"	1'-10"		0'-6"	1'-5"	1'-1 1/2"						
		P 420	3		4'-0"	X-13	0'-6"	0'-11"	0'-11"	0'-11"	0'-11"		0'-6"	0'-7 1/2"	0'-8"						
		P 421	3		5'-2"	X-13	0'-6"	0'-11"	1'-2"	0'-11"	1'-2"		0'-6"	1'-0"	0'-7 1/2"						
		P 422	3		4'-4"	X-13	0'-6"	0'-11"	0'-9"	0'-11"	0'-9"		0'-6"	0'-7 1/2"	0'-5"						
		P 423	3		5'-2"	X-13	0'-6"	0'-11"	1'-3"	0'-11"	1'-3"		0'-6"	1'-0 1/2"	0'-11 1/2"						
		P 424	12		14'-4"	X-12	1'-8"	11'-0"					1'-8"	1'-4 1/2"	0'-11 1/2"						
		P 425	30		7'-4"	X-13	0'-6"	1'-5"	1'-11"	1'-5"	1'-11"		0'-6"	1'-6"	1'-2 1/2"						
		P 426	6		4'-8"	X-13	0'-6"	0'-11"	0'-11"	0'-11"	0'-11"		0'-6"	0'-7 1/2"	0'-8"						
		P 427	6		5'-4"	X-13	0'-6"	0'-11"	1'-3"	0'-11"	1'-3"		0'-6"	1'-0 1/2"	0'-6"						
		P 428	6		4'-4"	X-13	0'-6"	0'-11"	0'-9"	0'-11"	0'-9"		0'-6"	0'-7 1/2"	0'-5"						
		P 429	6		5'-6"	X-13	0'-6"	0'-11"	1'-5"	0'-11"	1'-5"		0'-6"	1'-0 1/2"	2'-11 1/2"						
		P 430	6		14'-6"	X-12	1'-9"	11'-0"					1'-9"	1'-5"	1'-0"						
		P 431	15		7'-6"	X-13	0'-6"	1'-9"	2'-0"	1'-9"	2'-0"		0'-6"	1'-6"	1'-3"						
		P 432	6		4'-0"	X-13	0'-6"	0'-11"	0'-11"	0'-11"	0'-11"		0'-6"	0'-7 1/2"	0'-6"						
		P 433	6		4'-6"	X-13	0'-6"	0'-11"	0'-10"	0'-11"	0'-10"		0'-6"	0'-8 1/2"	0'-5 1/2"						
		P 434	12		14'-8"	X-12	1'-10"	11'-0"					1'-10"	1'-6 1/2"	1'-0 1/2"						
		P 435	30		7'-8"	X-13	0'-6"	1'-5"	2'-1"	1'-5"	2'-1"		0'-6"	1'-7 1/2"	1'-5 1/2"						
		P 436	12		4'-10"	X-13	0'-6"	0'-11"	1'-0"	0'-11"	1'-0"		0'-6"	0'-8 1/2"	0'-8 1/2"						
		P 437	12		4'-6"	X-13	0'-6"	0'-11"	0'-10"	0'-11"	0'-10"		0'-6"	0'-8 1/2"	0'-5 1/2"						
		P 438	6		14'-10"	X-12	1'-11"	11'-0"					1'-11"	1'-7"	1'-1 1/2"						
		P 439	15		7'-10"	X-13	0'-6"	1'-9"	2'-2"	1'-9"	2'-2"		0'-6"	1'-6 1/2"	1'-4"						
		P 440	6		4'-8"	X-13	0'-6"	0'-11"	1'-0"	0'-11"	1'-0"		0'-6"	0'-8 1/2"	0'-5 1/2"						
		P 441	6		4'-6"	X-13	0'-6"	0'-11"	0'-10"	0'-11"	0'-10"		0'-6"	0'-8 1/2"	0'-5 1/2"						
		P 442	12		15'-0"	X-12	2'-0"	11'-0"					2'-0"	1'-7 1/2"	1'-1 1/2"						
		P 443	30		0'-0"	X-13	0'-6"	0'-5"	2'-3"	1'-3"	2'-3"		0'-6"	1'-9"	1'-5"						
		P 444	12		4'-10"	X-13	0'-6"	0'-11"	1'-0"	0'-11"	1'-0"		0'-6"	0'-8 1/2"	0'-8 1/2"						
		P 445	12		4'-8"	X-13	0'-6"	0'-11"	0'-11"	0'-11"	0'-11"		0'-6"	0'-9 1/2"	0'-6"						
		P 446	6		15'-2"	X-12	2'-1"	11'-0"					2'-1"	1'-8 1/2"	1'-2"						
		P 447	15		0'-2"	X-13	0'-6"	1'-3"	2'-4"	1'-3"	2'-4"		0'-6"	1'-10"	1'-5 1/2"						
		P 448	6		4'-10"	X-13	0'-6"	0'-11"	1'-0"	0'-11"	1'-0"		0'-6"	0'-8 1/2"	0'-8 1/2"						
		P 449	6		4'-6"	X-13	0'-6"	0'-11"	0'-11"	0'-11"	0'-11"		0'-6"	0'-9 1/2"	0'-6 1/2"						
		P 450	6		10'-2"	X-12	2'-7"	11'-0"					2'-7"	1'-10"	1'-10"						
		P 451	15		0'-2"	X-13	0'-6"	1'-3"	2'-10"	1'-3"	2'-10"		0'-6"	1'-10 1/2"	2'-11 1/2"						
		P 452	6		5'-4"	X-13	0'-6"	0'-11"	1'-3"	0'-11"	1'-3"		0'-6"	0'-9"	1'-0"						
		P 453	6		5'-0"	X-13	0'-6"	0'-11"	1'-1"	0'-11"	1'-1"		0'-6"	0'-9"	0'-9"						

* A.S.T.M. A 432
60,000 P.S.I. MIN.
YIELD STRENGTH
DEFORMED BARS
AND SHALL BE COLD
BENT ROUND PER
DIAMETER 1'-10" MIN.

REINFORCING GRADE	ASTM	MARK	NO. BARS	SIZE	LENGTH	TYPE	A	B	C	D	E	F	G	H	J	K	L	R	SHAPE	WEIGHT	LOCATION
PIER AND LEG (CONT'D)																					
INTER.	A15-64	P 600	6	* 6	11'-0"	S(2)															
		P 900	57	* 9	40'-11"	X-14	36'-3"	1'-8"	5'-0"				0'-8 1/2"	2'-11 1/2"	1'-6"						
		P 901	57	* 9	9'-0"	X-2	5'-0"	6'-0"					2'-8 1/2"	1'-4 1/2"							
		P 1000	57	* 10	38'-3"	X-5			35'-3"	5'-0"			2'-11 1/2"	35'-9 1/2"	0'-6 1/2"						
		P 1001	57		11'-5"	X-1	9'-0"	3'-2"	5'-3"				1'-10"	2'-1"							
		P 1002	57		7'-9"	X-1	9'-0"	1'-9"	3'-0"				1'-2"	2'-10"							
		P 1503	12	* 15	19'-5"	X-2	6'-0"	13'-3"					5'-1"	3'-2"							
		P 1504	12	* 15	16'-3"	X-6	6'-0"	10'-3"					5'-1"	3'-3 1/2"							
* THESE BARS SHALL BE SUPPLIED AND BENT BY STEEL CO. OF CANADA LTD. OR EQUAL																					

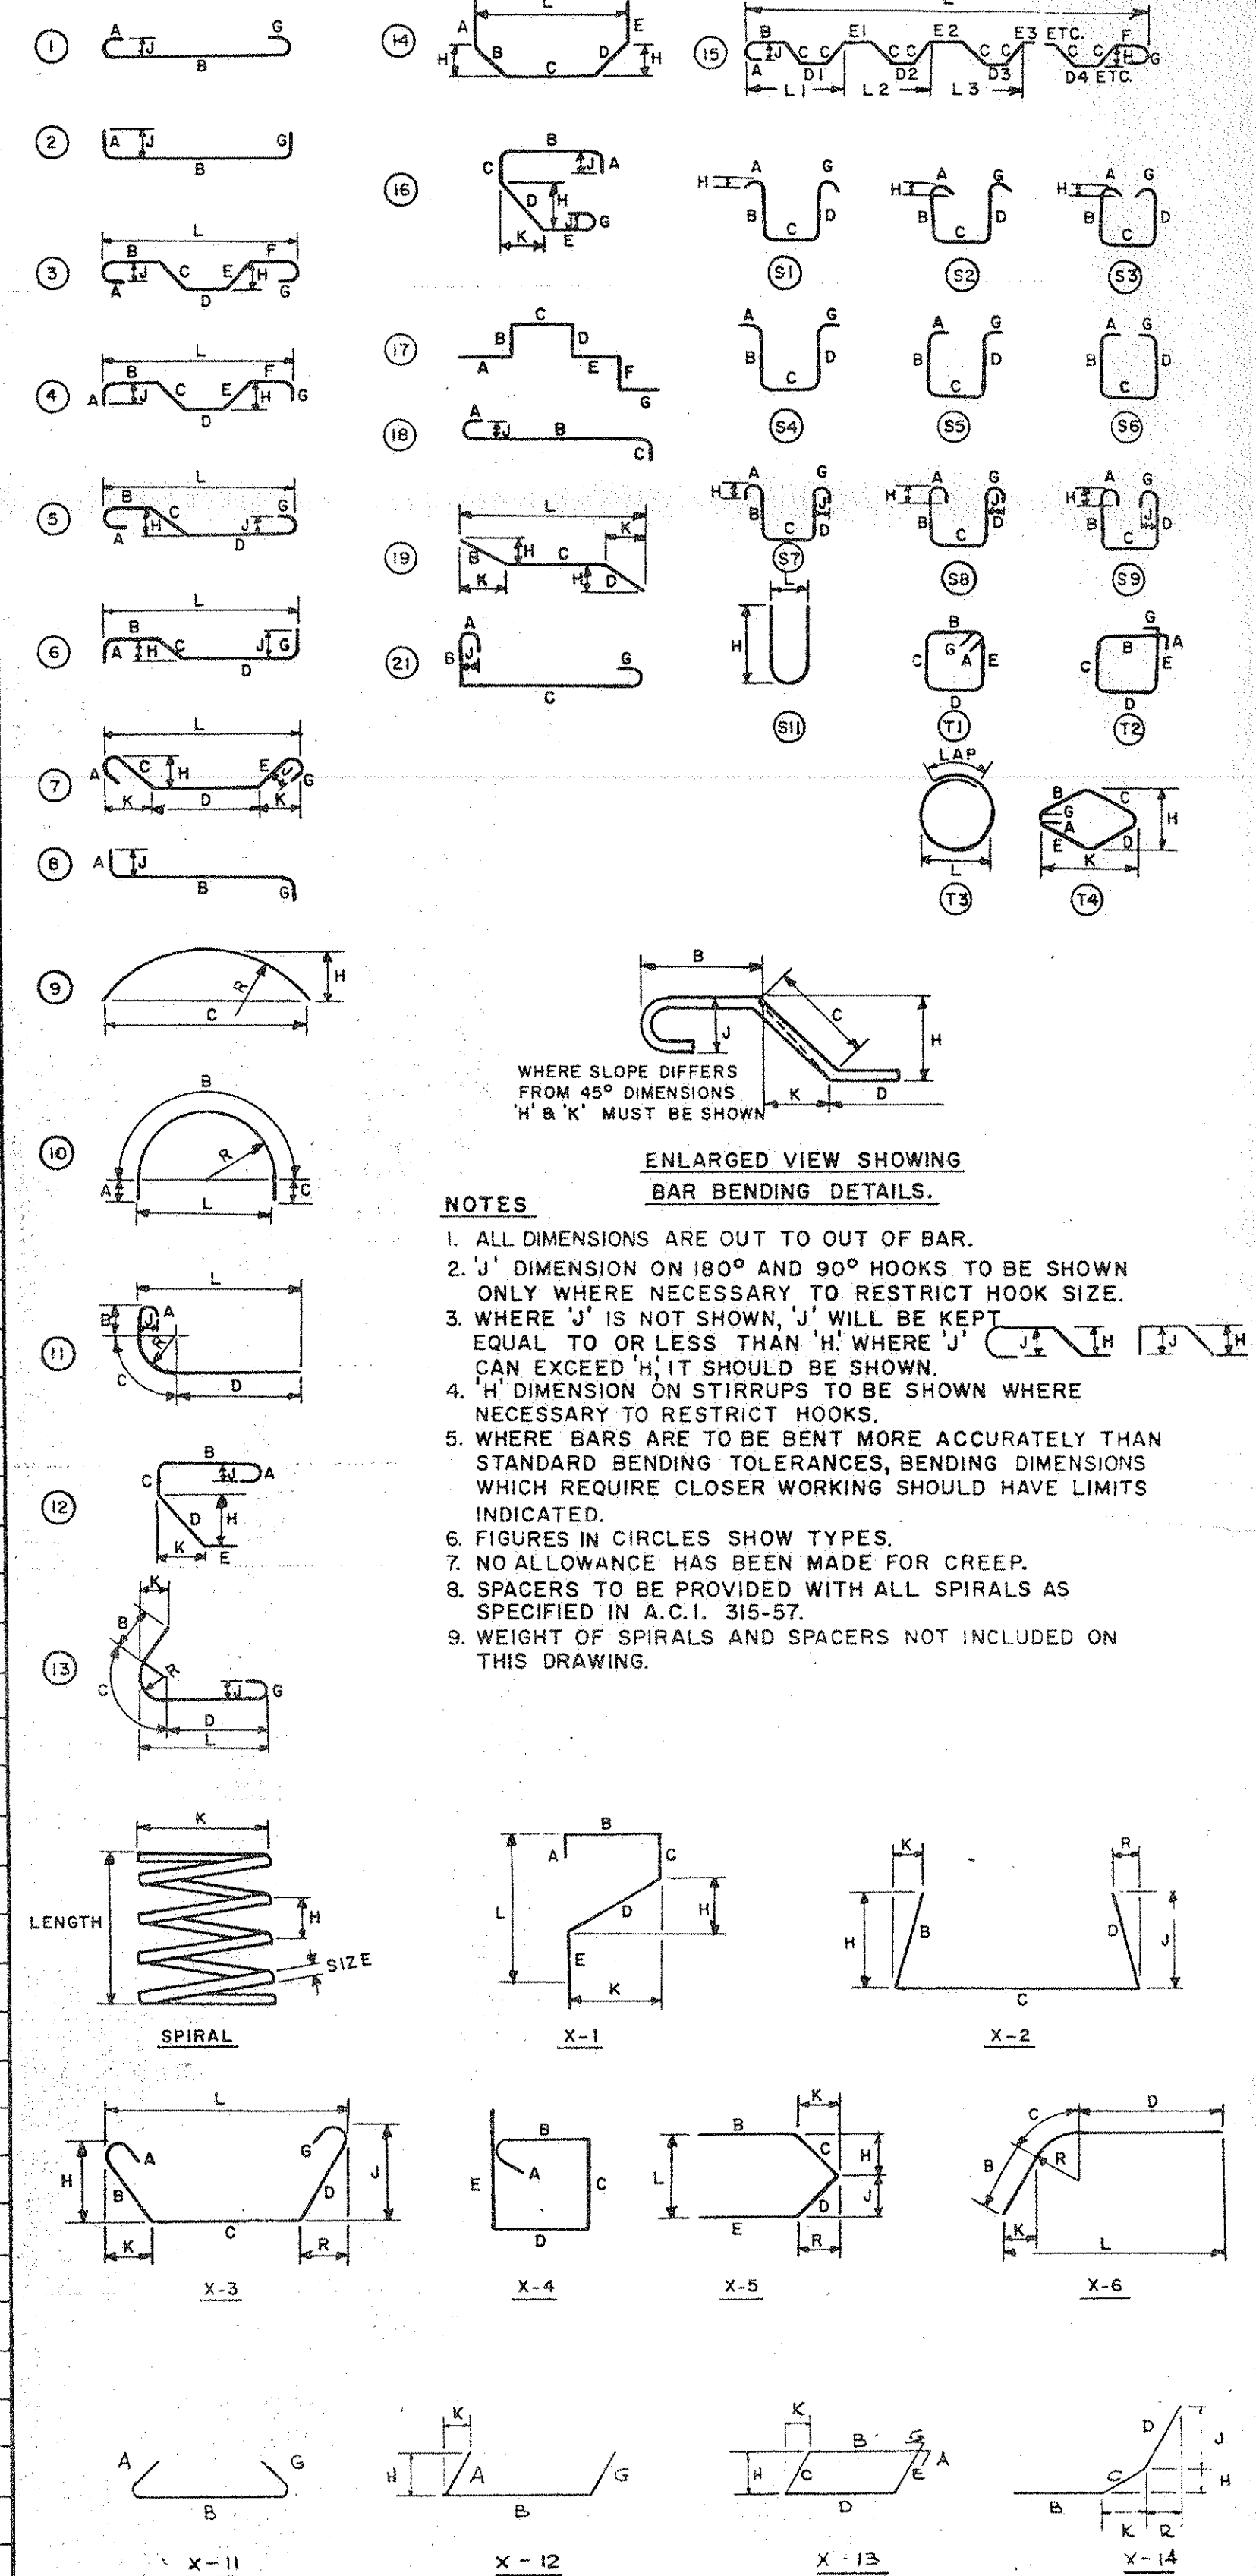

ENLARGED VIEW SHOWING BAR BENDING DETAILS.


- NOTES
1. ALL DIMENSIONS ARE OUT TO OUT OF BAR.
 2. J DIMENSION ON 180° AND 90° HOOKS TO BE SHOWN ONLY WHERE NECESSARY TO RESTRICT HOOK SIZE.
 3. WHERE 'J' IS NOT SHOWN, 'J' WILL BE KEPT EQUAL TO OR LESS THAN 'H' WHERE 'J' CAN EXCEED 'H' IT SHOULD BE SHOWN.
 4. 'H' DIMENSION ON STIRRUPS TO BE SHOWN WHERE NECESSARY TO RESTRICT HOOKS.
 5. WHERE BARS ARE TO BE BENT MORE ACCURATELY THAN STANDARD BENDING TOLERANCES, BENDING DIMENSIONS WHICH REQUIRE CLOSER WORKING SHOULD HAVE LIMITS INDICATED.
 6. FIGURES IN CIRCLES SHOW TYPES.
 7. NO ALLOWANCE HAS BEEN MADE FOR CREEP.
 8. SPACERS TO BE PROVIDED WITH ALL SPIRALS AS SPECIFIED IN A.C.I. 315-57.
 9. WEIGHT OF SPIRALS AND SPACERS NOT INCLUDED ON THIS DRAWING.

ALL FABRICATION MUST BE
IN ACCORDANCE WITH A.C.I. 315-65

HARD GRADE BARS SHALL CONFORM WITH A.S.T.M. A432-64 SPECIFICATIONS AND AS NOTED. ALL INTERMEDIATE GRADE BARS SHALL CONFORM TO A.S.T.M. A15-64 AND A408-64 SPECIFICATIONS AS NOTED.

NO.		REVISIONS		DATE		BY	
<p>M. M. DILLON LIMITED CONSULTING ENGINEERS PROJECT OFFICE: OTTAWA</p>							
<p>OTTAWA RIVER PARKWAY RAMP 'E' STRUCTURE REINFORCING STEEL SCHEDULE</p>							
<p>LOCATION: PIER AND LEGS</p>							
<p>REFER TO DRAWING NO.:</p>							
DRAWN		J.O.N.		PROJECT NO.		SB77-20-4	
CHECKED		M.F.R.		SHEET NO.		E-13	
APPROVED				COMMISSION		OF 15	
DATE		FEB 1966					

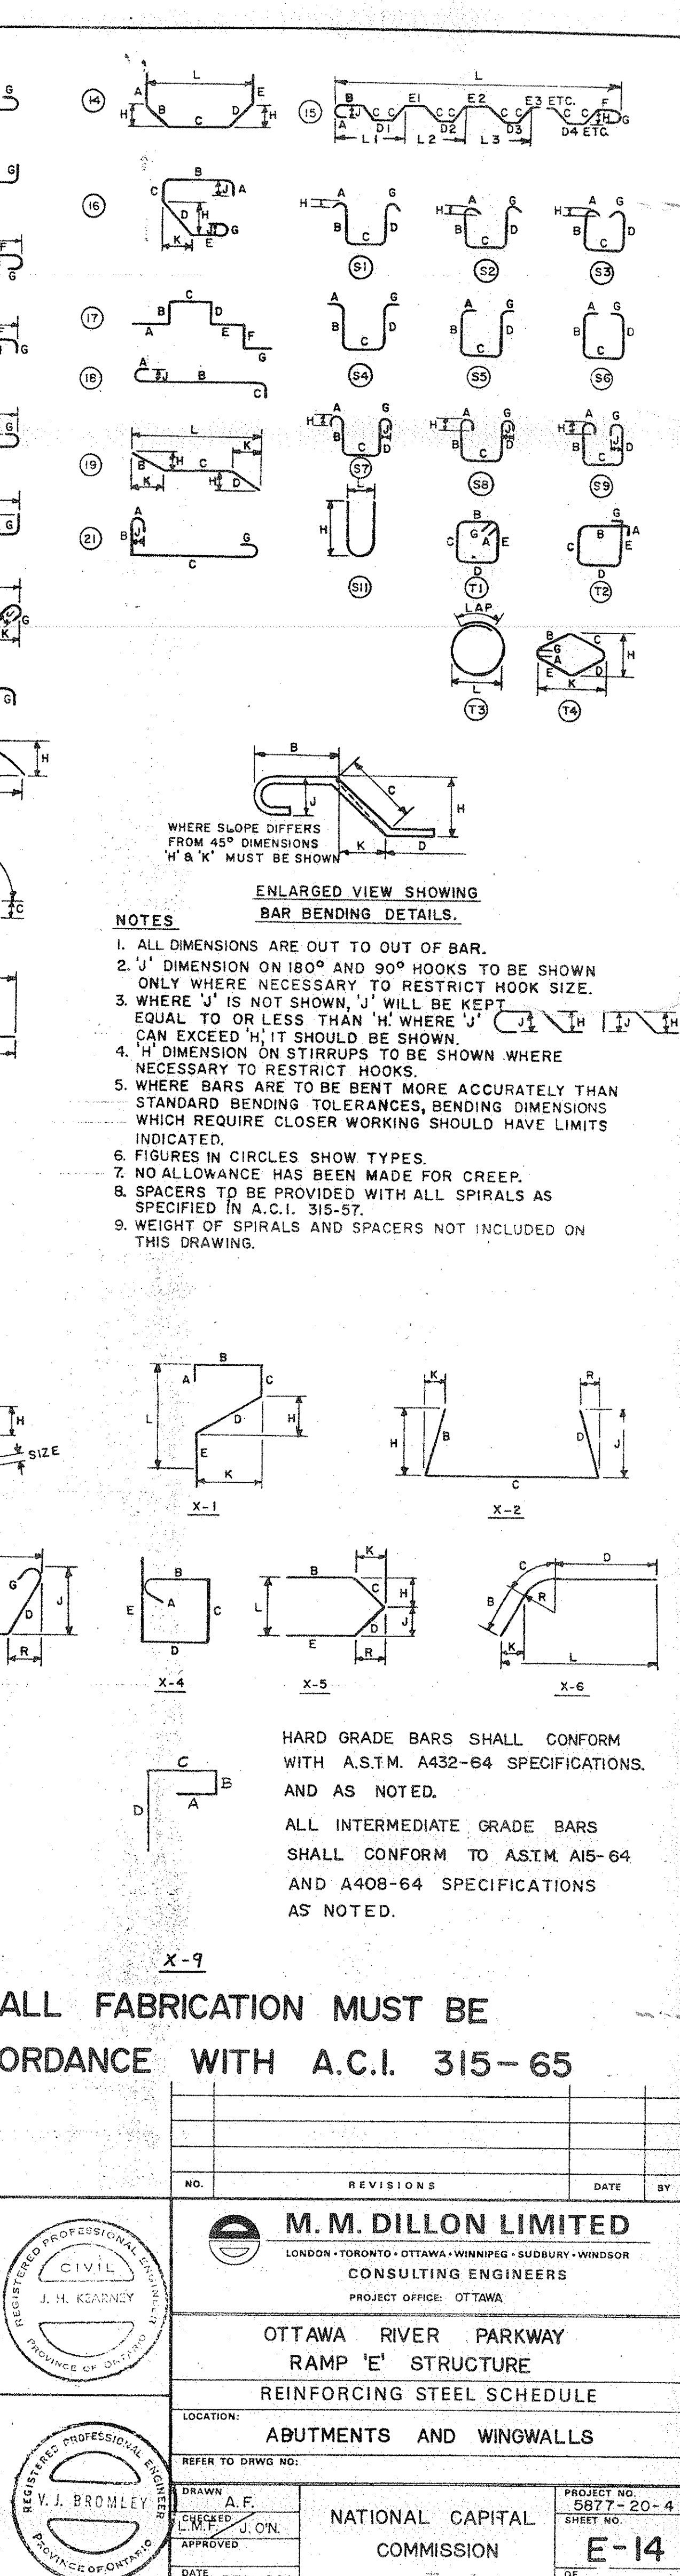


REINFORCING	
GRADE	ASTM
INTER.	A 15-64



ALL FABRICATION MUST BE
IN ACCORDANCE WITH A.C.I. 315-65

HARD GRADE BARS SHALL CONFORM
WITH A.S.T.M. A432-64 SPECIFICATIONS.
AND AS NOTED.

ALL INTERMEDIATE GRADE BARS
SHALL CONFORM TO A.S.T.M. A15-64
AND A408-64 SPECIFICATIONS
AS NOTED.

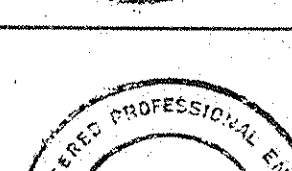		M. M. DILLON LIMITED LONDON · TORONTO · OTTAWA · WINNIPEG · SUDBURY · WINDSOR CONSULTING ENGINEERS PROJECT OFFICE: OTTAWA		DATE _____ BY _____
		OTTAWA RIVER PARKWAY RAMP 'E' STRUCTURE REINFORCING STEEL SCHEDULE		PROJECT NO. 0677-20-4 SHEET NO. _____
LOCATION: _____		ABUTMENTS AND WINGWALLS		PROJECT NO. 0677-20-4 SHEET NO. _____
	REFER TO DRAWG NO: _____		PROJECT NO. 0677-20-4 SHEET NO. _____	
	DRAWN BY A.F. CHECKED BY C.W. ON. APPROVED _____ DATE _____		NATIONAL CAPITAL COMMISSION DE _____	

