







TRENT CANAL

Section No. 3.

SIMCOE-BALSAM LAKE DIVISION.

Lock No. 2. Lift 14 feet.

Scale - 8 feet to the Inch.
- AS BUILT -

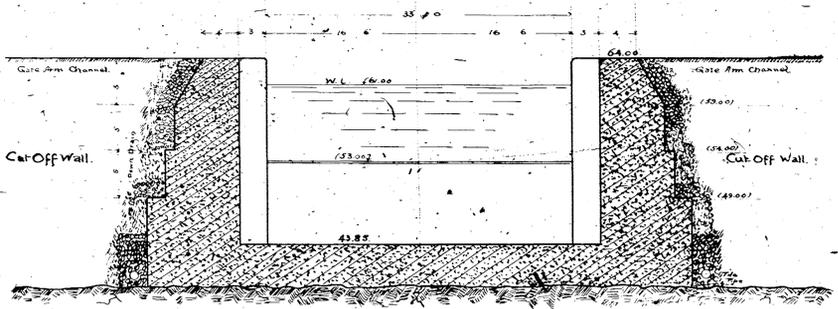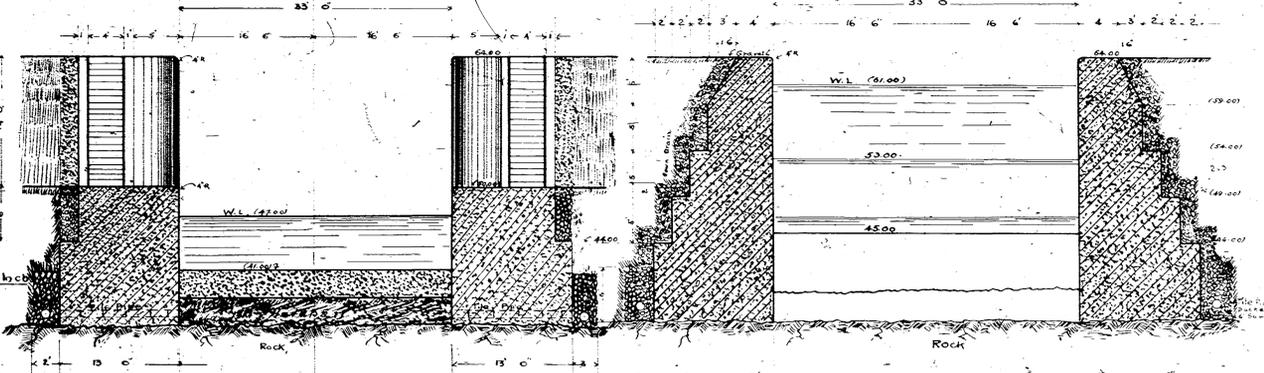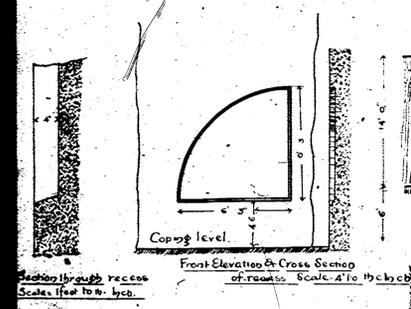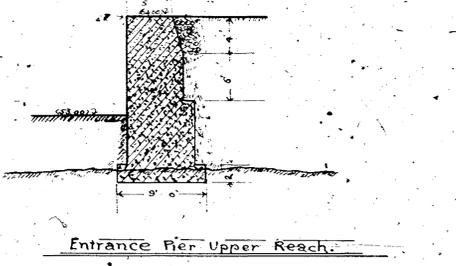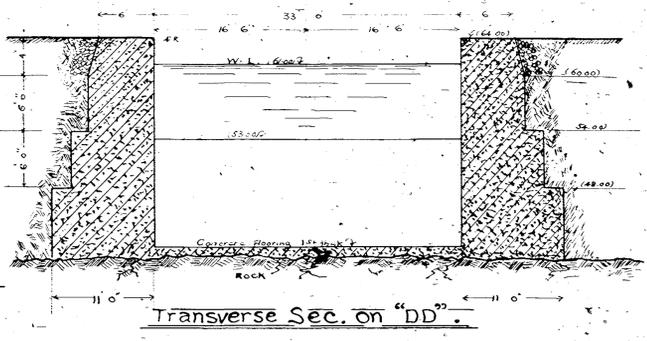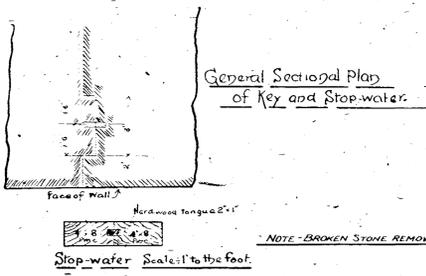


Final Estimate Plan.
I Certify that this Plan is a true drawing of the Structure as built.

William Davy Divisional Engineer
Peterborough May 21 1908

Superintending Engineer

Peterborough Ont.

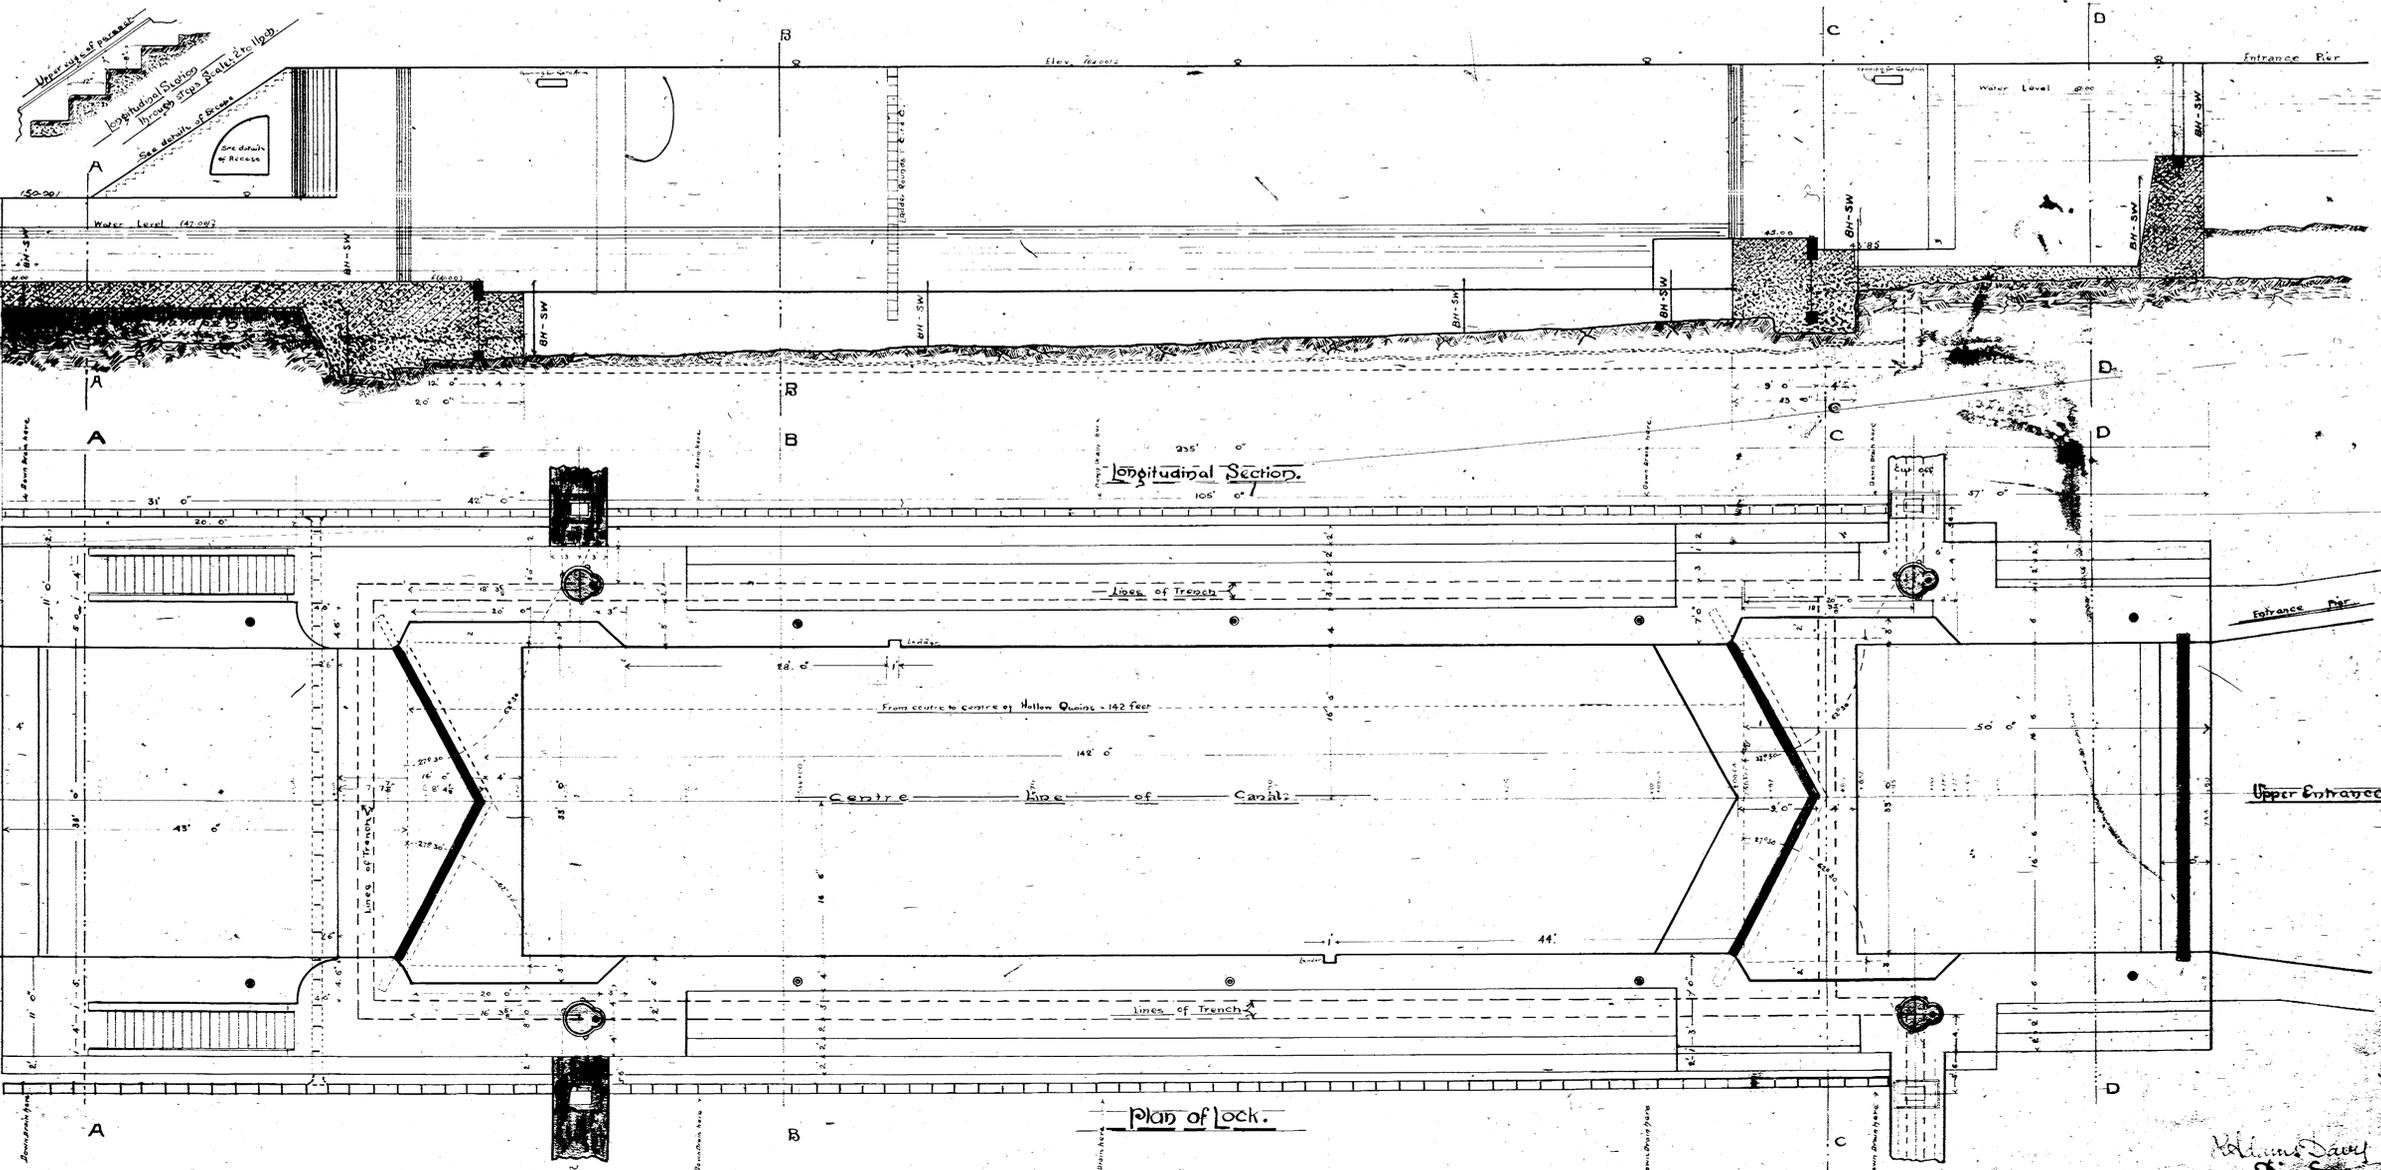

William Davy
Div. Engr.