

no.	date	description	drawn by	app'd by

revision / révision
A Detail no.
B Drawing no.-where detail required
C Drawing no.-where detailed

Public Works Canada	Travaux Publics Canada
Architecture and Engineering	Architecture et Génie
for Environment Canada	pour l'Environnement Canada

AS-BUILT

project title/titre du projet



**LOCK CONTROL BUILDING
LOCK NO. 38 TALBOT**

TRENT SEVERN WATERWAY - ONTARIO

drawing title/titre du dessin

ELECTRICAL LAYOUT

designed by/conception par	DA	approved by/approuvé par	AS
drawn by/tracé par	MC	date/date	NOVEMBER, 1990
checked by/vérifié par	LG	scale/échelle	AS NOTED
project asset number/numéro du projet d'immobilisation	9153364-17	sheet no./feuille no.	E1
reference/drawing number/numéro de référence/dessin	COTSTL 90/R24		

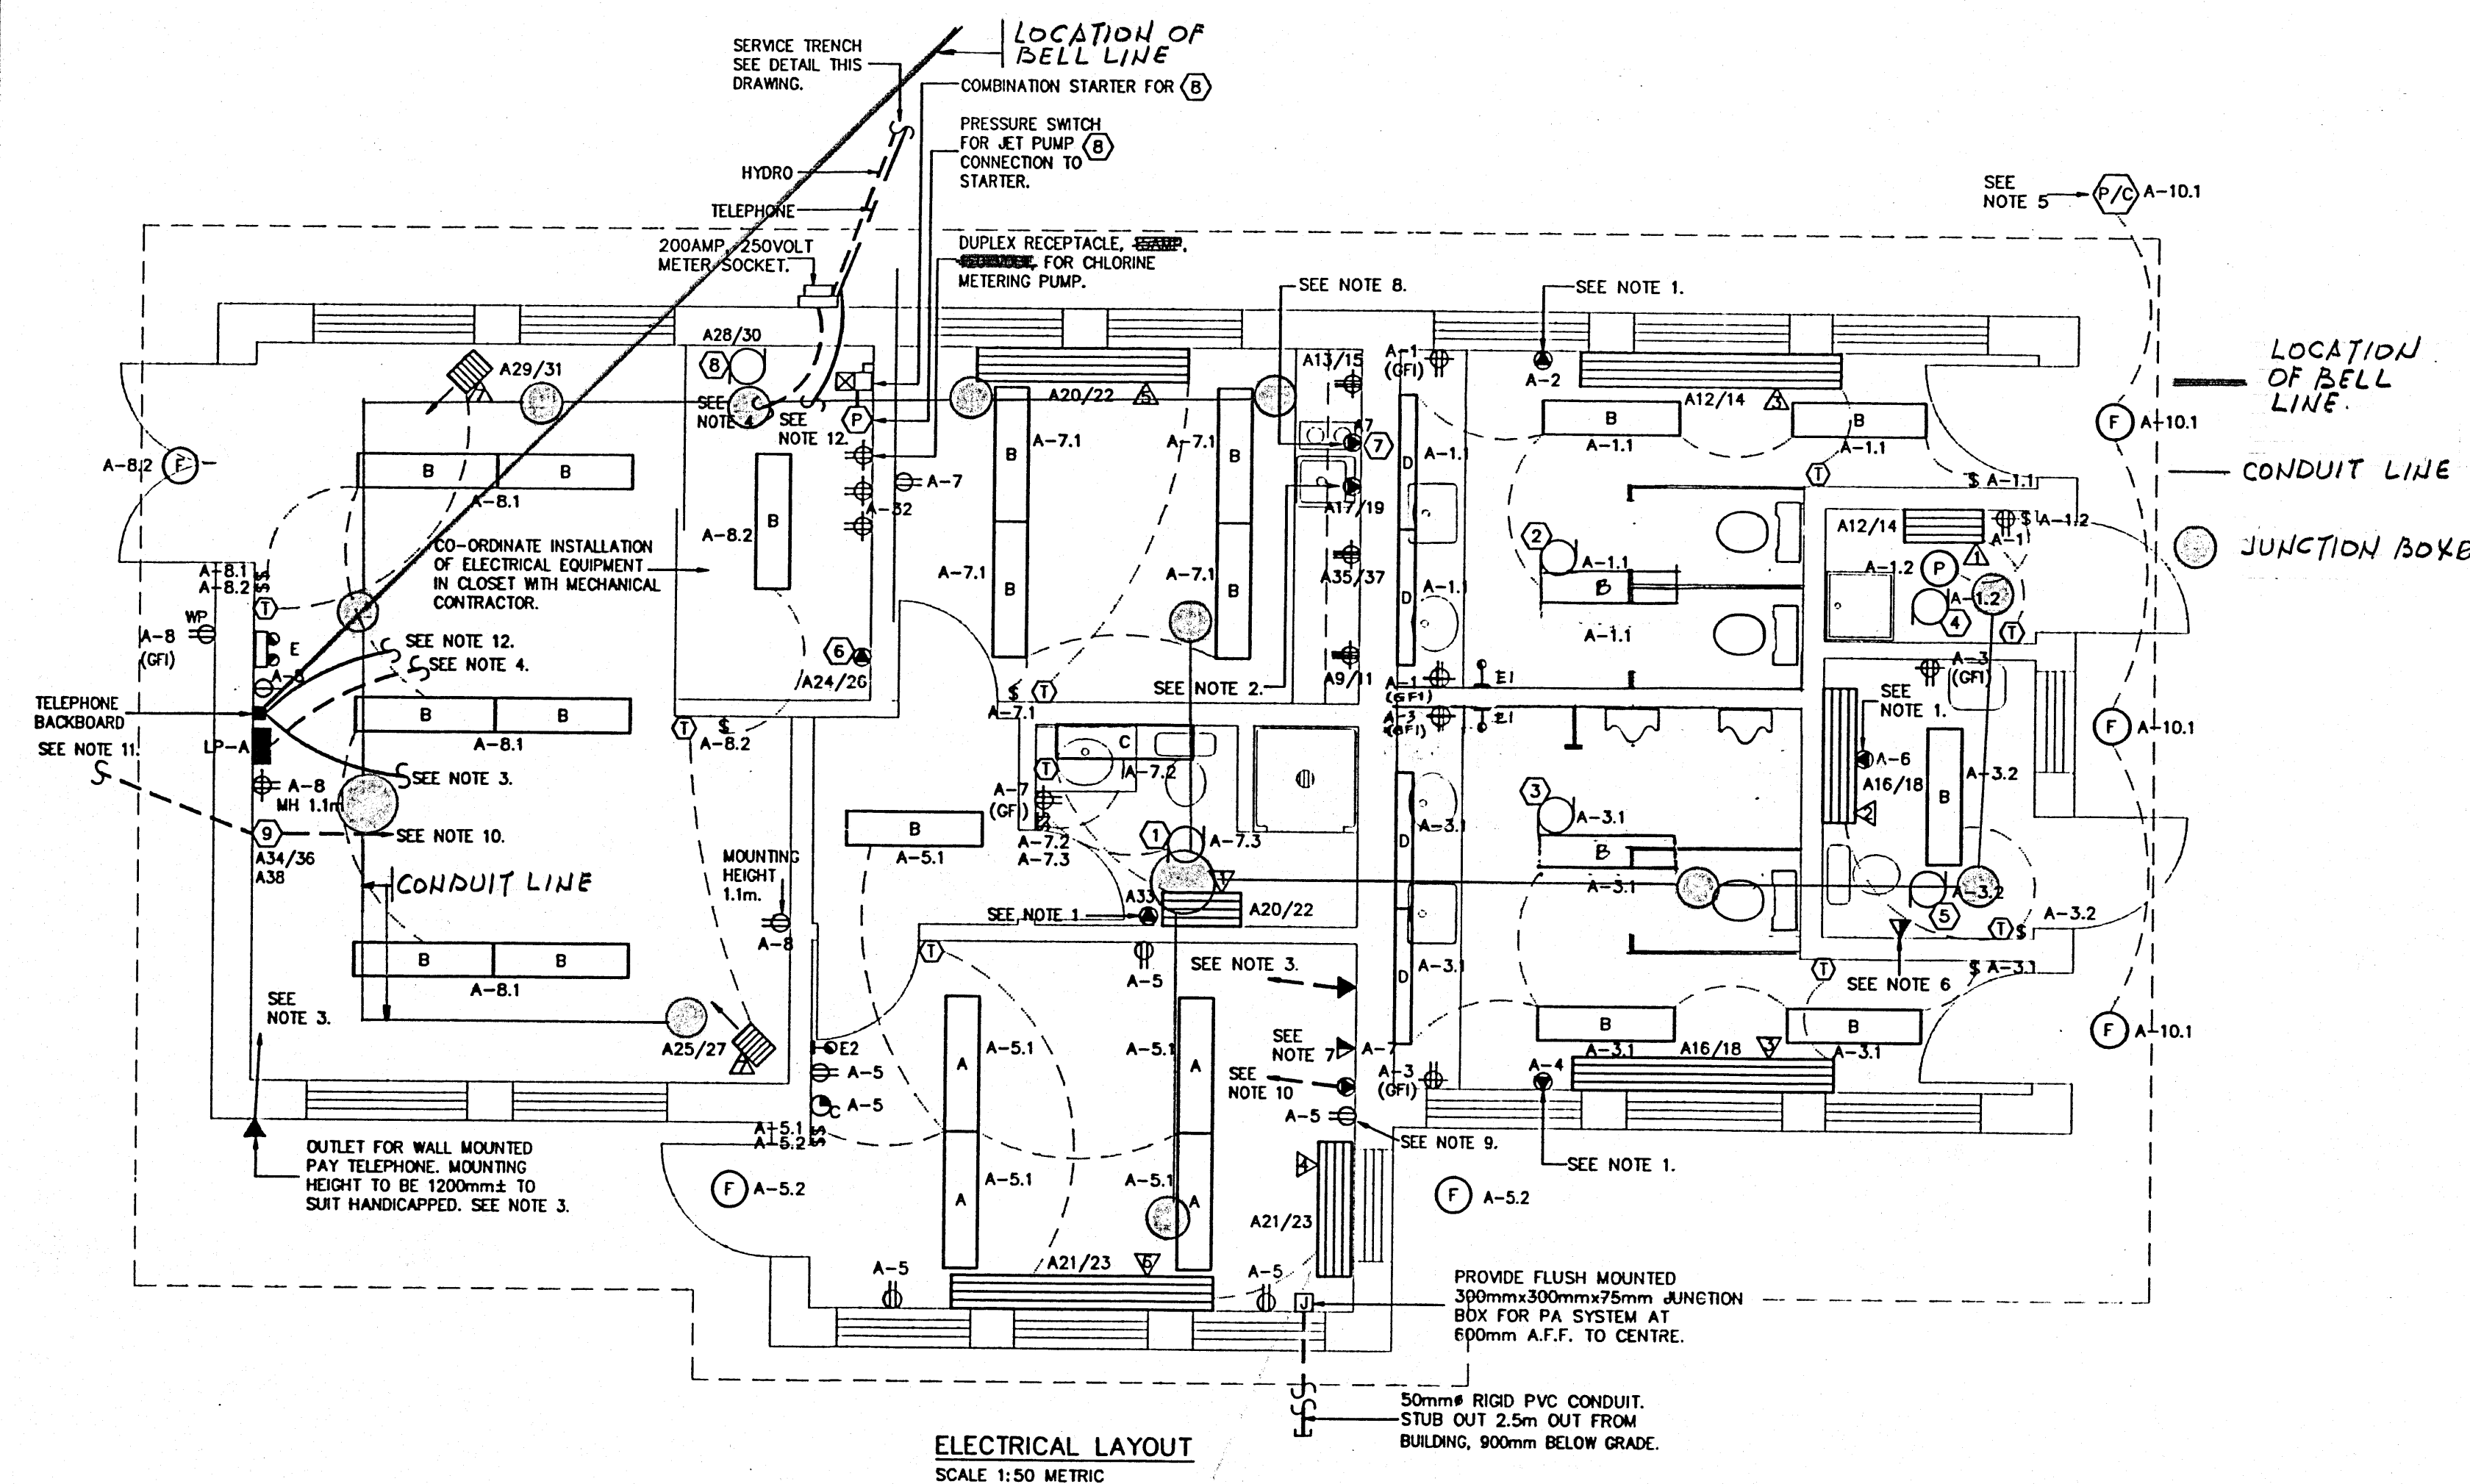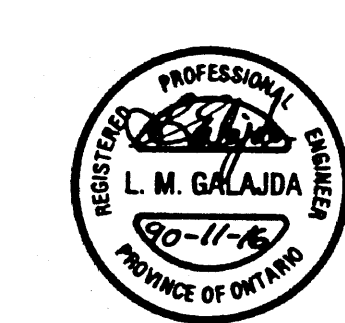

- NOTES:**
1. FLUSH MOUNT 100mm SQUARE OUTLET BOX IN WALL, 1200mm A.F.F. FOR HAND DRYER. HAND DRYER SUPPLIED BY GENERAL CONTRACTOR.
 2. PROVIDE FLUSH MOUNTED 30AMP, 240VOLT, 1PHASE, 4WIRE 3 POLE GROUNDED RECEPTACLE IN WALL, 400mm A.F.F. FOR COMBINATION RANGE/REFRIGERATOR/KITCHEN UNIT. UNIT SUPPLIED BY GENERAL CONTRACTOR.
 3. INSTALL A 19mm PVC CONDUIT FROM THE TELEPHONE OUTLET TO THE TELEPHONE SERVICE ENTRANCE. LOCATION IN THE STORAGE ROOM. INSTALL THE PVC CONDUIT BELOW THE FLOOR SLAB.
 4. INSTALL 3-3/0 COPPER, XLPE, RW90 CABLES IN 50mm RIGID PVC CONDUIT BELOW FLOOR SLAB FROM METER SOCKET TO LP-A.
 5. PROVIDE PHOTOCONTROL MOUNTED ON UNDERSIDE OF EAVE, FACING NORTH SKY, TO CONTROL SOFFIT LIGHTS IN FRONT OF PUBLIC WASHROOMS.
 6. PROVIDE EMERGENCY PULL CORD SWITCH FLUSH MOUNTED 900mm A.F.F. WIRED TO BUZZER IN MAIN OFFICE. LABEL "PULL TO CALL FOR ASSISTANCE". SWITCH SHOULD BE LATCHING STYLE. PULL TO UNLATCH, 24 VAC OPERATION. (LABEL TO BE BILINGUAL) SEE DETAIL AT RIGHT.
 7. PROVIDE 24VAC DIXIE BUZZER AND 120VAC - 24VAC TRANSFORMER FOR "ASSISTANCE REQUIRED" IN BARRIER-FREE ACCESS PUBLIC WASHROOM.
 8. PROVIDE DIRECT CONNECTION TO RANGE HOOD / FAN UNIT (7) MOUNTED 1800mm A.F.F. UNIT SUPPLIED BY MECHANICAL CONTRACTOR.
 9. LOCATE EFFLUENT PUMP ALARM IN MAIN OFFICE. CONNECT EFFLUENT PUMP ALARM TO CONTROL PANEL ALARM SUPPLIED BY GENERAL CONTRACTOR.
 10. PROVIDE 19mm PVC CONDUIT BELOW FLOOR SLAB FROM EFFLUENT PUMP CONTROL PANEL IN STORAGE ROOM TO ALARM OUTLET IN OFFICE.
 11. INSTALL 2-25mm PVC CONDUITS FROM THE EFFLUENT CONTROL PANEL AND TERMINATE EACH CONDUIT IN SEPARATE SUITABLY SIZED WEATHER PROOF UNDERGROUND JUNCTION BOXES LOCATED NEAR THE PUMPING CHAMBER. ONE JUNCTION BOX SHALL BE USED FOR THE SPlicing OF CONTROL CIRCUITS AND THE OTHER JUNCTION BOX SHALL BE USED FOR THE SPlicing OF POWER SUPPLY CIRCUITS. INSTALL A 50mm RIGID PVC CONDUIT FROM EACH JUNCTION BOX TO THE PUMPING CHAMBER. INSTALL POWER SUPPLY AND CONTROL WIRING IN THE CONDUITS.
 12. EXTEND THE 50mm RIGID PVC DUCT BELOW THE FLOOR SLAB FROM THE MAIN SERVICE TRENCH TO THE TELEPHONE BACKBOARD IN THE STORAGE ROOM. PROVIDE 2'x2' PAINTED PLYWOOD BACKBOARD FOR TELEPHONE AUTHORITY USE.



TSW 6029-G 7/8