




Project No./No. du projet	R.089425.001	Sheet/Feuille	E100	Revision No./ Le Révision no.	1
<p>Project Name/Titre du projet SANDSPIT, B.C. TRANSPORT CANADA SANDSPIT AIRPORT LIGHTING UPGRADE</p>					
<p>Client/Client TRANSPORT CANADA</p>					
<p>SEAL:</p>					
<p>1 ISSUED FOR ADDENDUM 1 2018/11/06</p> <p>2 ISSUED FOR TENDER 2018/09/27</p> <p>3 Description/Description Date/Date</p>					

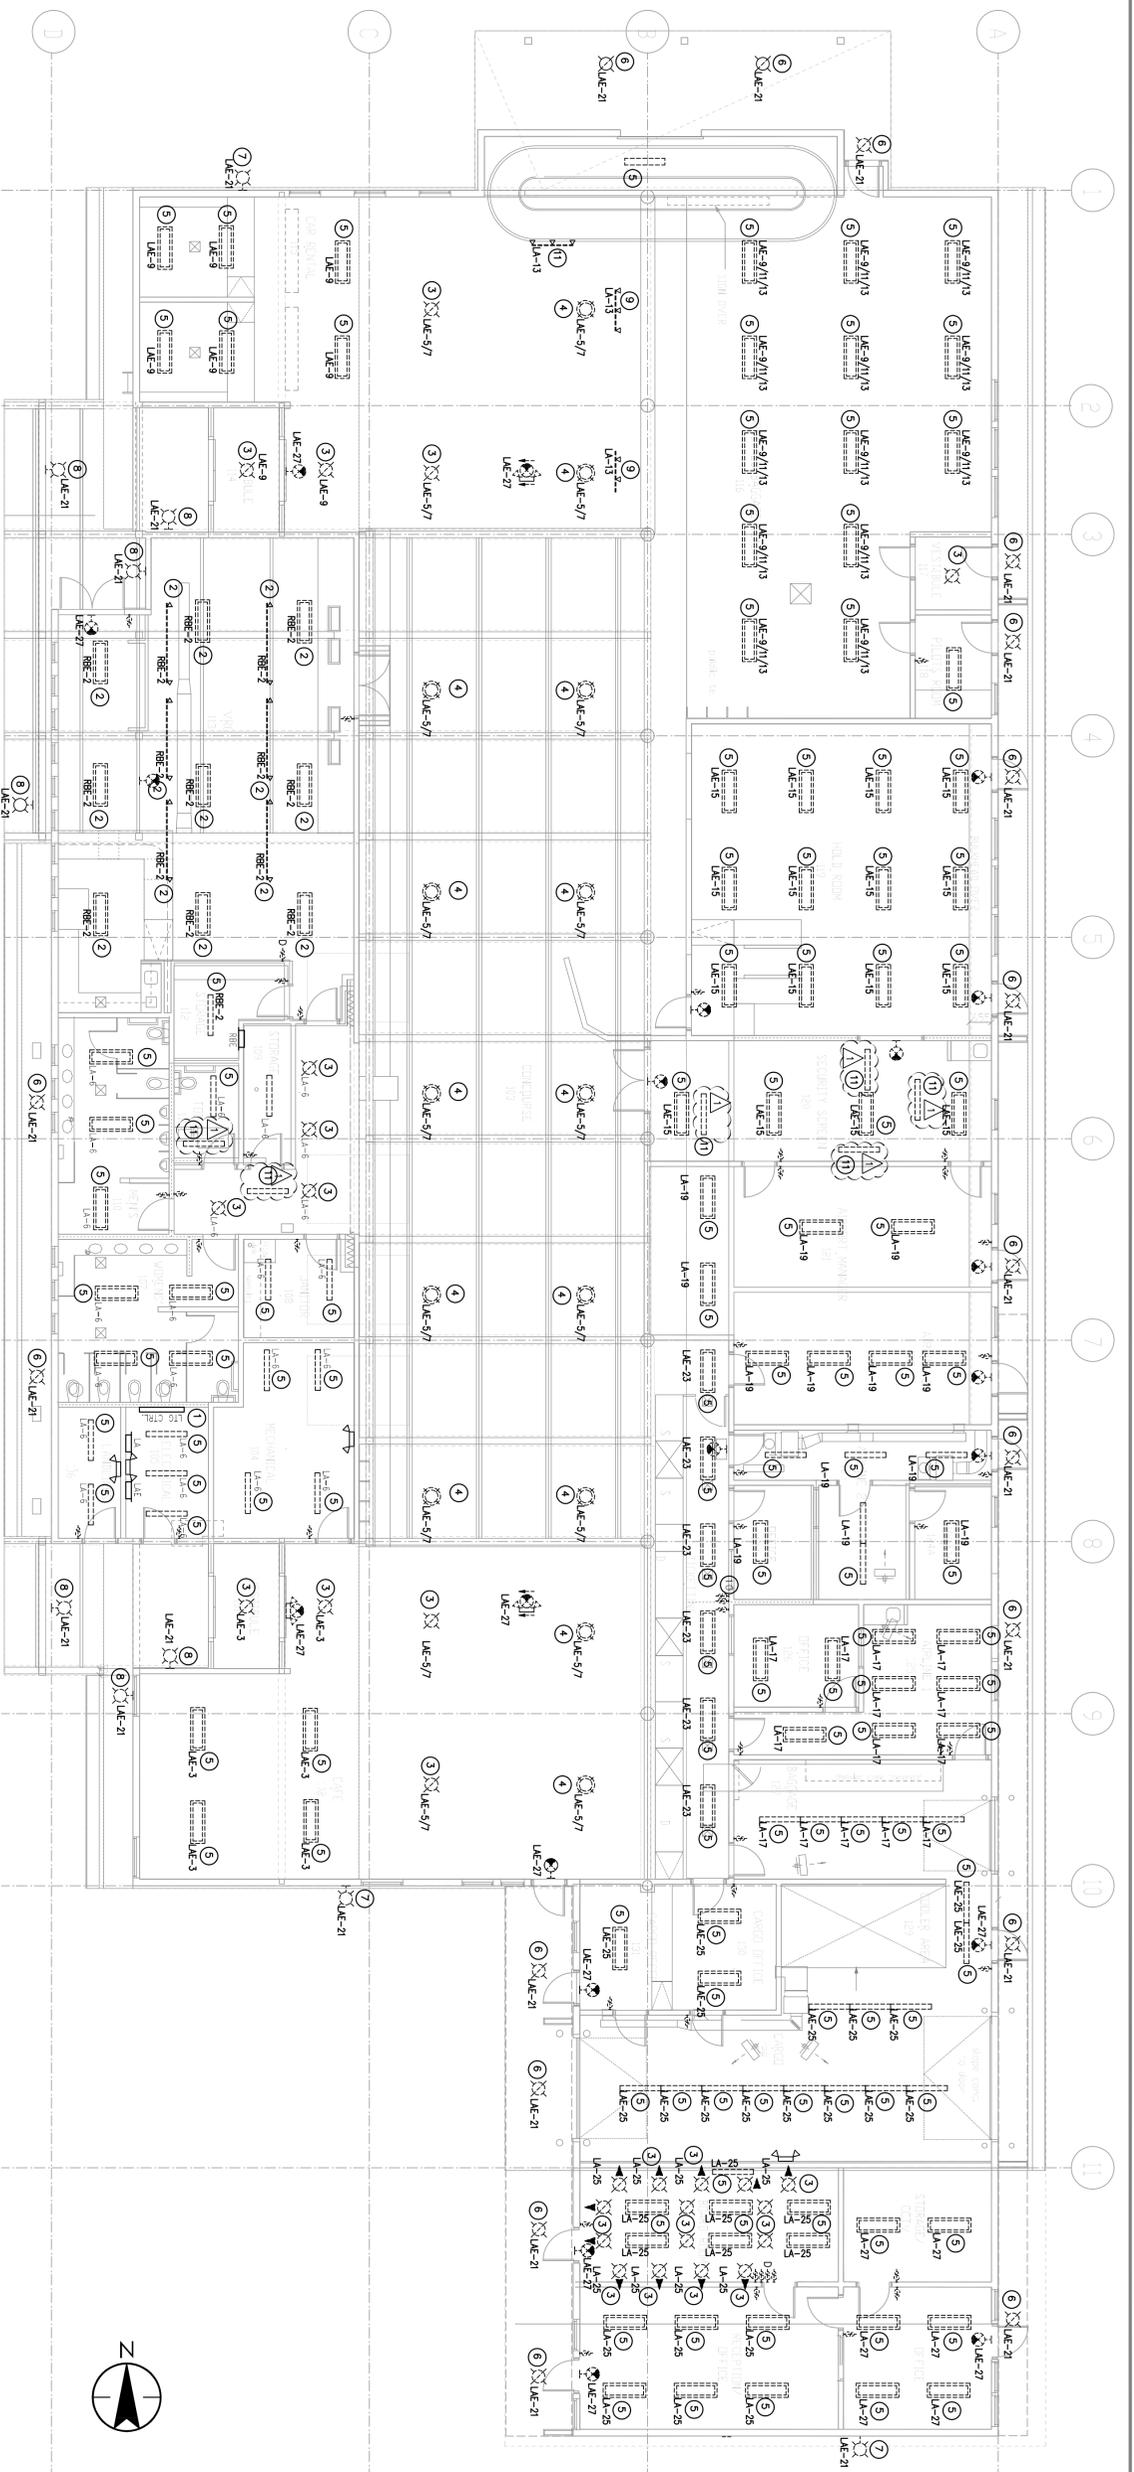

1 AIR TERMINAL BUILDING – EXISTING LIGHTING / DEMOLITION
E100
1:100

GENERAL NOTES – LIGHTING DEMOLITION – AIR

1. ALL EXISTING LUMINAIRES SHOWN ON DEMOLITION PLAN ARE TO BE REMOVED UNLESS OTHERWISE NOTED. ALL EXISTING ELECTRICAL SYMBOLS ARE TO BE REMOVED UNLESS OTHERWISE NOTED. RE-USE WITH NEW LUMINAIRE SHOWN ON LIGHTING RENOVATION DRAWING E101.
2. ALL CIRCUIT INFO SHOWN IS TO DEMONSTRATE INTENT ONLY AND IS BASED ON UNVERIFIED INFORMATION PROVIDED BY OTHERS. WHERE MULTIPLE CIRCUITS ARE INDICATED ON EXISTING PANEL SCHEDULES, EXISTING DOCUMENTATION IS NOT CLEAR WHICH LUMINAIRE ARE ON WHICH CIRCUITS. ELECTRICAL CONTRACTOR TO CONFIRM ALL CIRCUITS SHOWN PRIOR TO COMMENCING WORK. RECORD ALL FINAL CIRCUITS ON AS-BUILT DRAWINGS.
3. CONTRACTOR TO CONFIRM QUANTITY AND LOCATION OF EMERGENCY LIGHTING. CONTRACTOR TO CONFIRM LOCATION OF BATTERY PACKS AND REMOVE HEADS PRIOR TO COMMENCING WORK. RECORD ALL INFORMATION ON RECORD AS-BUILT DRAWINGS.
4. APPROX. AND BUILDING SYSTEMS ARE TO REMAIN FULLY OPERATIONAL DURING NORMAL HOURS OF OPERATION DURING CONSTRUCTION. REFER TO WORK SUMMARY SPECIFICATION SECTION 01 11 00.

KEY NOTES

- 1 EXISTING LIGHTING CONTROL RELAY CABINETS TO BE REMOVED. WIRING TO BE RETAINED AND LABELED FOR RE-USE WITH NEW RELAY PANEL RP-ATB-1, EXISTING TIME CLOCK, AND ALL OTHER COMPONENTS NO LONGER REQUIRED, INCLUDING RELAY CABINETS TO BE REMOVED.
- 2 EXISTING UNSTRUT LIGHTING SUPPORT SYSTEM TO BE RETAINED FOR RE-USE WITH NEW TRACK LIGHTS. REMOVE ALL LINEAR FLUORESCENT AND TRACK LIGHTING. RETAIN CIRCUIT FOR RE-USE AND REMOVE ALL CONDUIT AND WIRING NOT TO BE RE-USED FOR NEW LIGHTING.
- 3 EXISTING RECESSED DOWNLIGHT TO BE REMOVED. HOUSING TO BE RETAINED FOR RE-USE WITH LED RETROFIT LUMINAIRE.
- 4 EXISTING SUSPENDED LUMINAIRE TO BE REMOVED. RETAIN EXISTING WIRING TO CEILING MOUNTING POINT, AS WELL AS MOUNTING HOOK/HARDWARE. EXISTING LUMINAIRE AND SILENCE/SUSPENSION SYSTEM TO BE REMOVED.
- 5 EXISTING SURFACE MOUNT FIXTURE ON DRYWALL CEILING TO BE REMOVED AND REPLACED WITH FIXTURE OF EQUIVALENT OF LARGER SIZE. RETAIN EXISTING WIRING AND BACK BOX FOR RE-USE.
- 6 EXISTING SOFFIT LIGHT TO BE REMOVED. CLEAN AND PREPARE SOFFIT RECESS FOR NEW RECESSED LUMINAIRE.
- 7 EXISTING WALL PACK TO BE REPLACED WITH NEW. RETAIN WIRING AND BACKBOX FOR RE-USE.
- 8 EXISTING WALL PACK TO BE REMOVED AND NOT REPLACED WITH NEW. RETAIN EXISTING BACK BOX AND WIRING FOR CIRCUIT EXTENSION TO NEW LUMINAIRE IN NEW LOCATION.
- 9 EXISTING TRACK LIGHTING TO BE REMOVED. RETAIN BACK BOX AND WIRING FOR POWER CONNECTIONS TO NEW LUMINAIRE.
- 10 EXISTING LIGHTING CONTROL MASTERS SWITCHES AND TRIP SWITCHES TO BE REMOVED AND REPLACED WITH NEW LOW VOLTAGE SWITCHES AND DIMMING CONTROLLER. REFER TO DETAIL 4 ON DRAWING 600 FOR EXISTING CONFIGURATION TO BE REMOVED.
- 11 EXISTING LUMINAIRE TO BE REMOVED AND NOT REPLACED WITH NEW. ALLOW FOR COVER PLATES AND DRYWALL PAINT/REPAIR AS REQUIRED TO MAKE CEILING FINISH GOOD.

