




PILE SCHEDULE							
MK. No.	SHAFT DIA.	BELL DIA.	VERT. REINFORCING	TIES	DWLS %	LENGTH "L"	CUT-OFF ELEV. 1/10
P1	406	—	4-15M	10M	2-20M	6000	AS NOTED
P2	406	—	4-15M	10M	2-20M	7500	—
P3	406	—	4-15M	10M	2-20M	9500	—
P4	508	—	4-20M	10M	4-20M	9500	—
P5	762	—	6-25M	10M	4-20M	9500	—
P6	406	—	4-25M	10M	4-25M	7500	DWLS x 2600 LG PROJ. 1100
P7	508	—	4-25M	10M	4-25M	9500	DWLS x 2600 LG PROJ. 1100

NOTE: 1) ALLOWABLE SKIN FRICTION VALUE = 25.0 kPa  
 2) STEEL CASINGS MAYBE REQUIRED.  
 3) REFER TO GEOTECH. REPORT FOR SOIL TEST HOLE LOCATIONS.  
 4) PROVIDE 4-15M VERT. & 10M TIES (AS PER PILE DETAIL) FOR "FLAG POLE PILE"

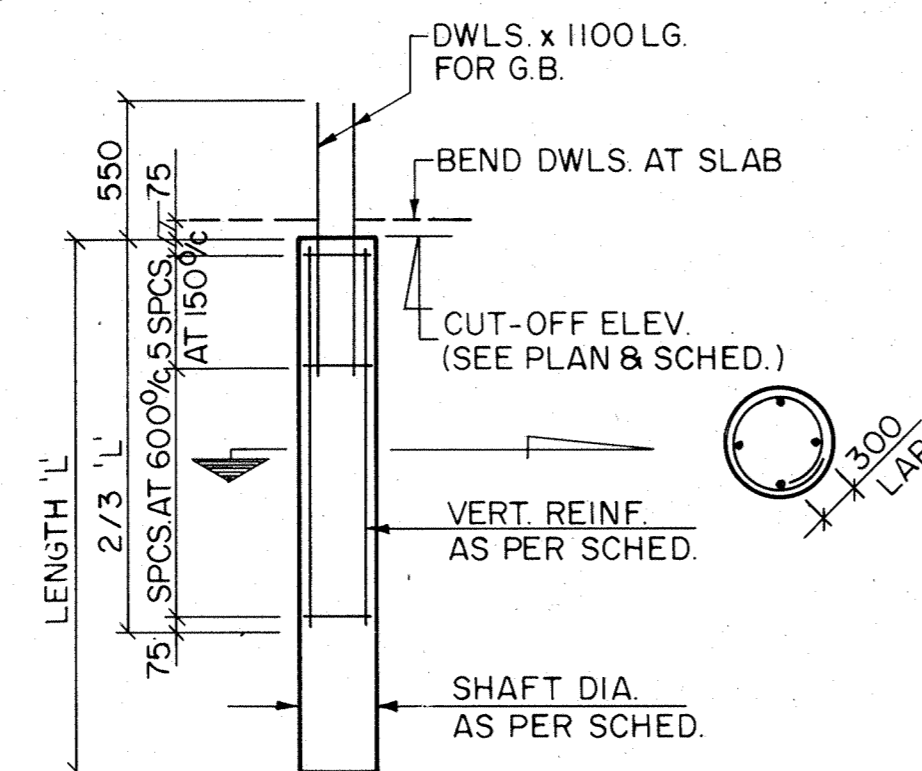


SKIN FRICTION PILE DETAIL  
N.T.S.


LEGEND

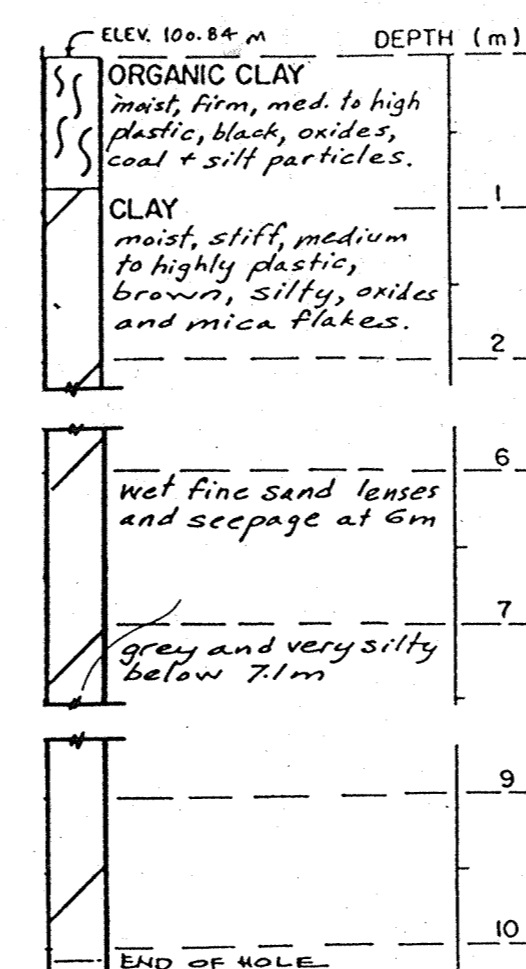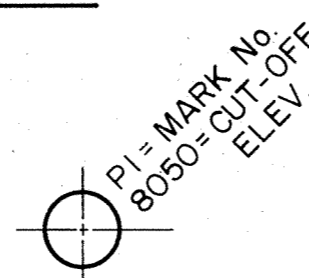

TEST HOLE 1

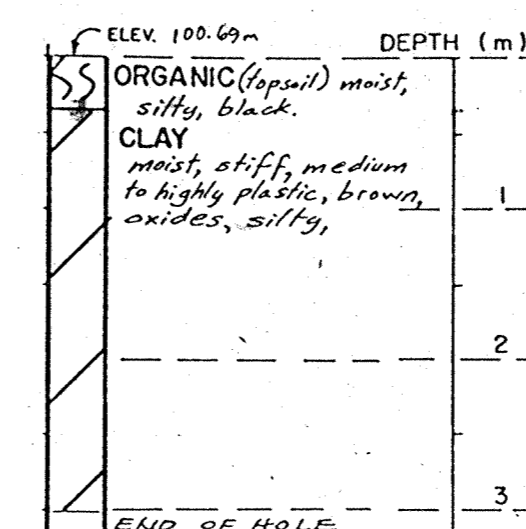


TEST HOLE 2

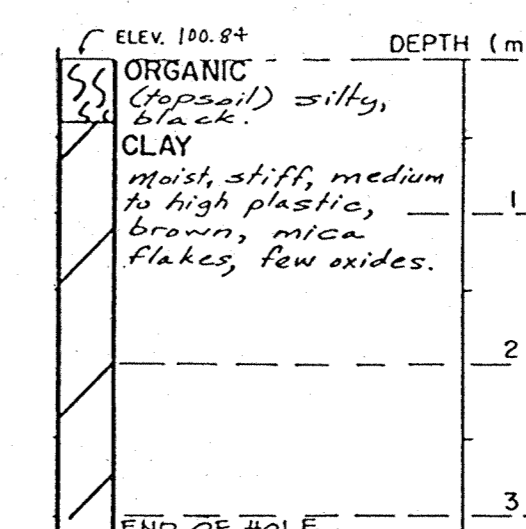


TEST HOLE 3

Any information pertaining to soils and all bore-hole logs are furnished by the architect or engineer as a matter of general information only and bore-hole descriptions or logs are not to be interpreted as descriptive of conditions at locations other than those described by the bore-holes themselves.

For more soil information see report prepared by BBT Geotechnical Consultants Ltd. Project No. S82-1376 March 31, 1982

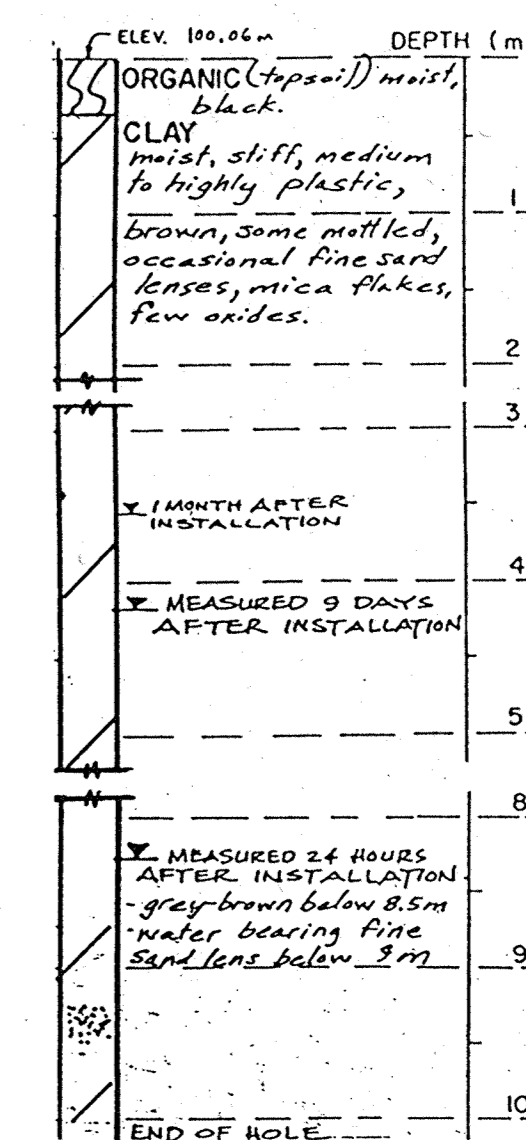

TEST HOLE 4

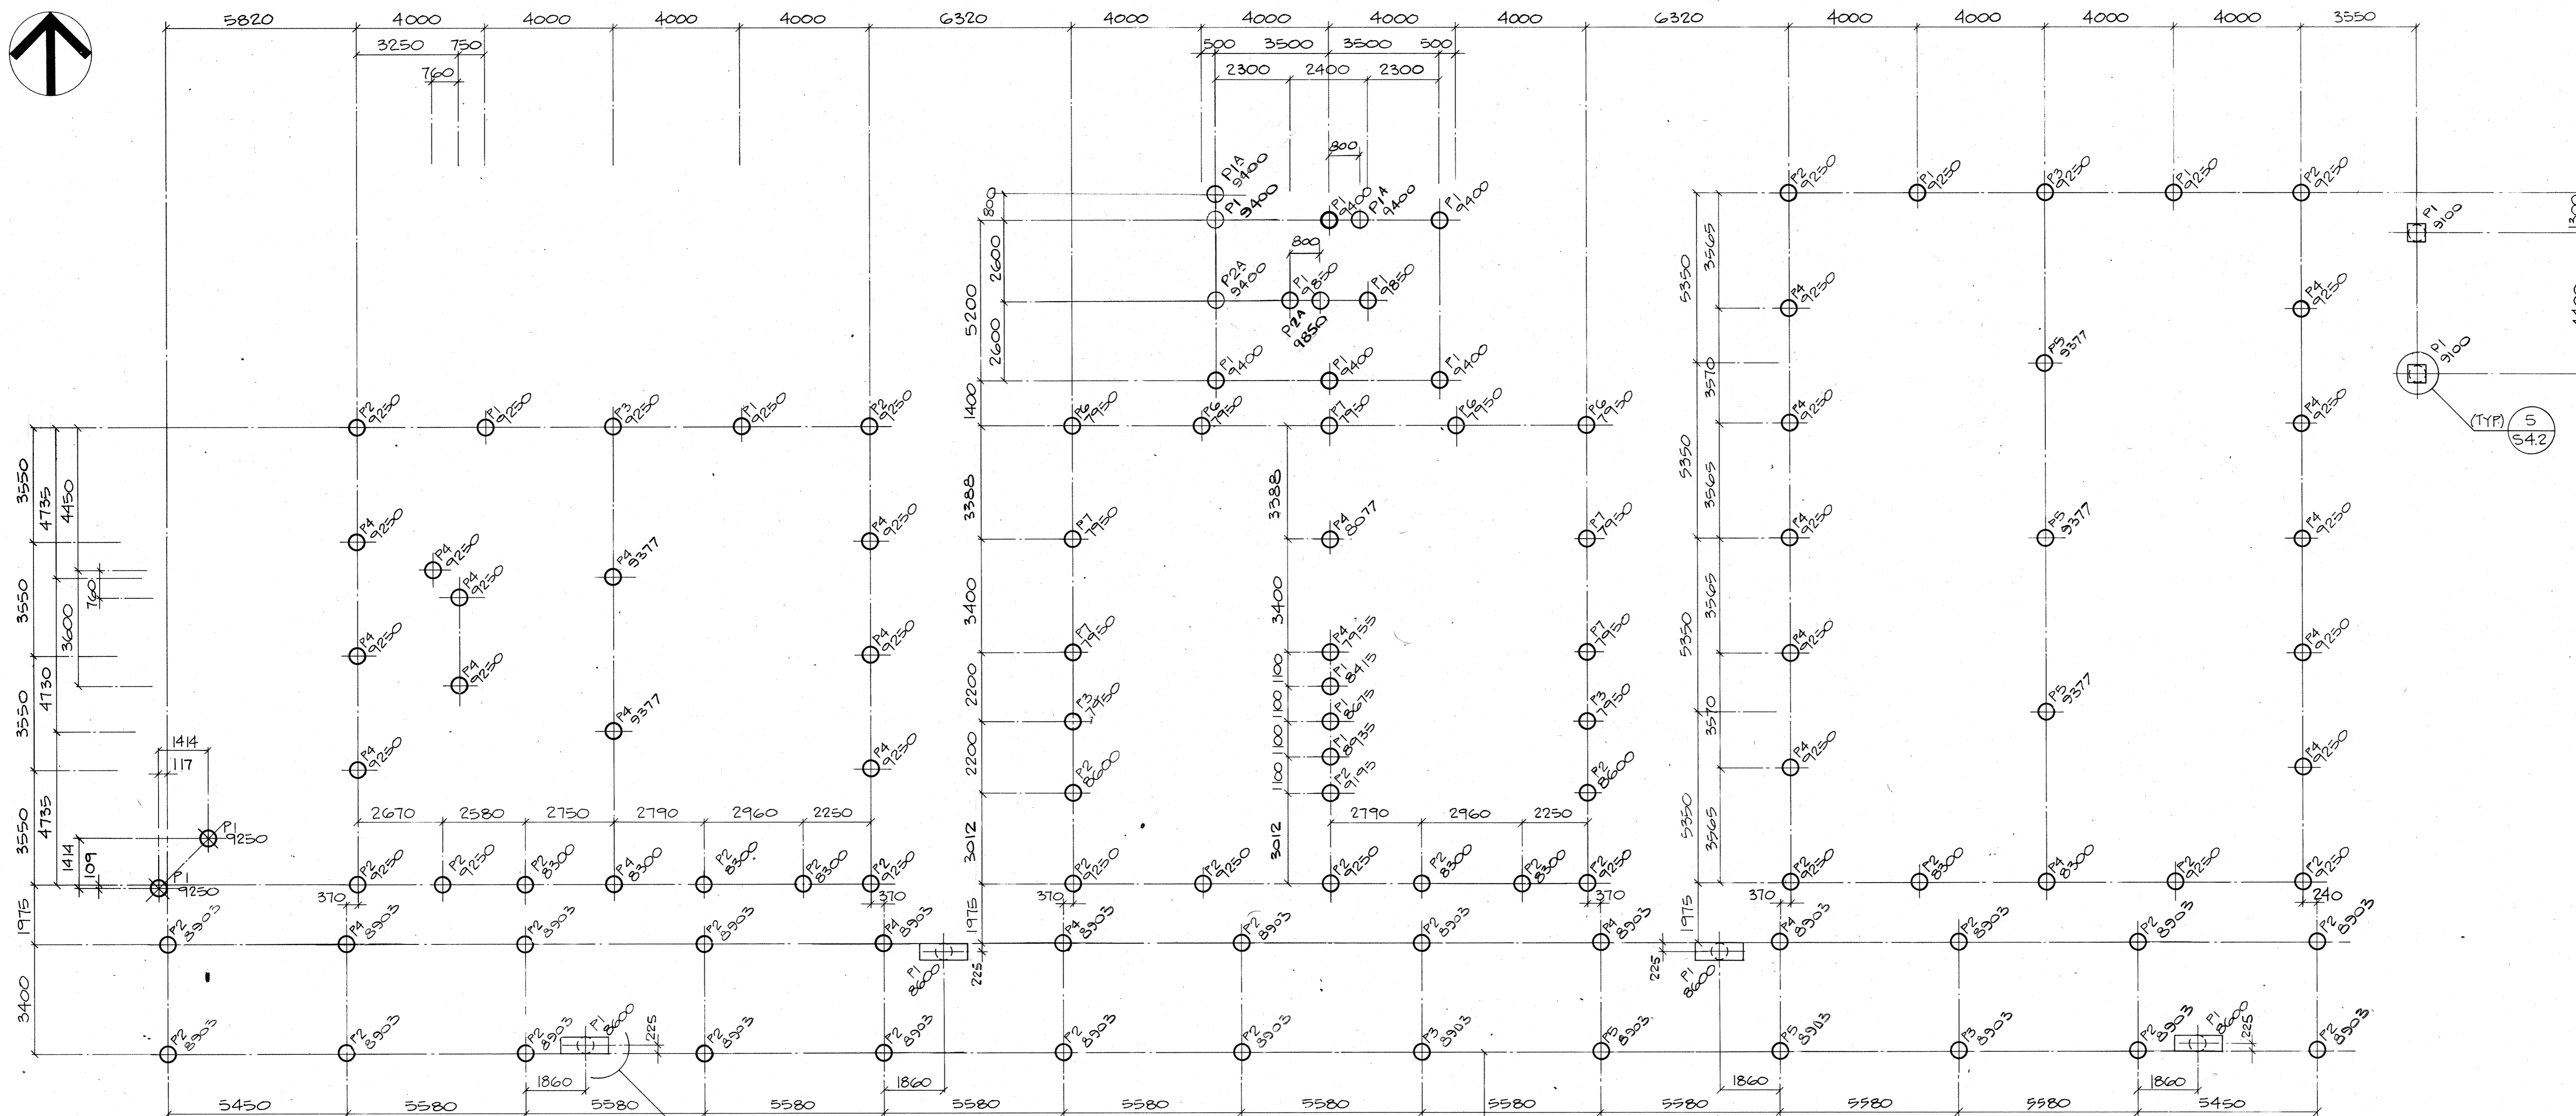

PILE LAYOUT  
0 1 2 3 4 M

THESE RECORD DRAWINGS HAVE BEEN PREPARED, IN PART, ON THE BASIS OF INFORMATION COMPILED AND FURNISHED BY OTHERS. THE ENGINEER WILL NOT BE RESPONSIBLE FOR ANY ERRORS OR OMISSIONS WHICH HAVE BEEN INCORPORATED INTO THIS DOCUMENT AS A RESULT.

DATE	PROJECT RECORD DRAWING	J.S.	app'd
no	date	description	drawn by
			trace par
			app'd
			app'd
revision / révision			

CONSULTANTS

**IKOY**  
ARCHITECTS  
IKOY FILE - 82-204  
**Reid Crowther**  
Reid Crowther & Partners Ltd.  
Engineers/Architects  
R.C.P.L. NO. 52076  
CERT. OF QUAL. REG. 133



**Parks Canada**  
Engineering and Architecture  
**Parcs Canada**  
Génie et architecture

project title / titre du projet

CONTEMPORARY FACILITIES  
BATOCHE NATIONAL HISTORIC SITE  
BATOCHE SASKATCHEWAN

drawing title / titre du dessin

PILE LAYOUT

designed by / conception par	approved by / approuvé par
D.K.K.	
drawn by / tracé par	date / date
R.R.	
checked by / vérifié par	scale / échelle
project asset number / numéro du projet d'immobilisation	sheet no. / feuille no.
reference / drawing number / numéro de référence / dessin	S2.1
HPBA 84/R4/E	

1	1	BLK
100	100	BLK
101	101	BLK

B.O.

NOTES:

- 1) FOR FLAG POLE DETAILS REFER TO ARCH DWGS.
- 2) FOR SUMP PUMP DETAILS, SLABS FOR MECH. UNITS AND CONG. ENCASED DUCTS REFER TO MECH DWGS.
- 3) FOR SEWAGE TREATMENT TANK LOCATION REFER TO MECH. DWGS.
- 4) REFER TO ARCH. ABZ. FOR OVERHEAD DOOR CONNECTIONS TO SLAB AND GRADE BEAM.
- 5) REFER TO ARCH. DWGS. FOR GEODETIC ELEVATION = FLOOR ELEVATION.

THESE RECORD DRAWINGS HAVE BEEN PREPARED, IN PART, ON THE BASIS OF INFORMATION COMPILED AND FURNISHED BY OTHERS. THE ENGINEER WILL NOT BE RESPONSIBLE FOR ANY ERRORS OR OMISSIONS WHICH HAVE BEEN INCORPORATED INTO THIS DOCUMENT AS A RESULT.

1	OCT 30/06	PROJECT RECORD DRAWING	J.S.	<i>[Signature]</i>
no.	date	description	drawn by trace par	app d by appr par
revision / révision				

## CONSULTANTS

**IKOY**  
ARCHITECTS  
IKOY FILE - 82-204

**Reid  
Crowther**  
Reid Crowther & Partners Ltd.  
Engineers-Planners-Scientists  
R.C.P.L. NO. 52076  
CERT. OF AUTH. NO. 103



 Parks Canada  
Engineering and Architecture

project title / titre du projet

CONTEMPORARY FACILITIES  
BATOCHÉ NATIONAL HISTORIC SITE  
BATOCHÉ SASKATCHEWAN

drawing title / titre du dessin

## MAIN FLOOR PLAN

designed by / conception par

DKK

drawn by / tracé par

checked by / vérifié par

© 2004 Blackwell Publishing Ltd *Journal of Internal Medicine* 255: 105–112

project asset number / number


\_\_\_\_\_

HBPA 8

sheet no. / feuille no.

● ● ●

## S2.2

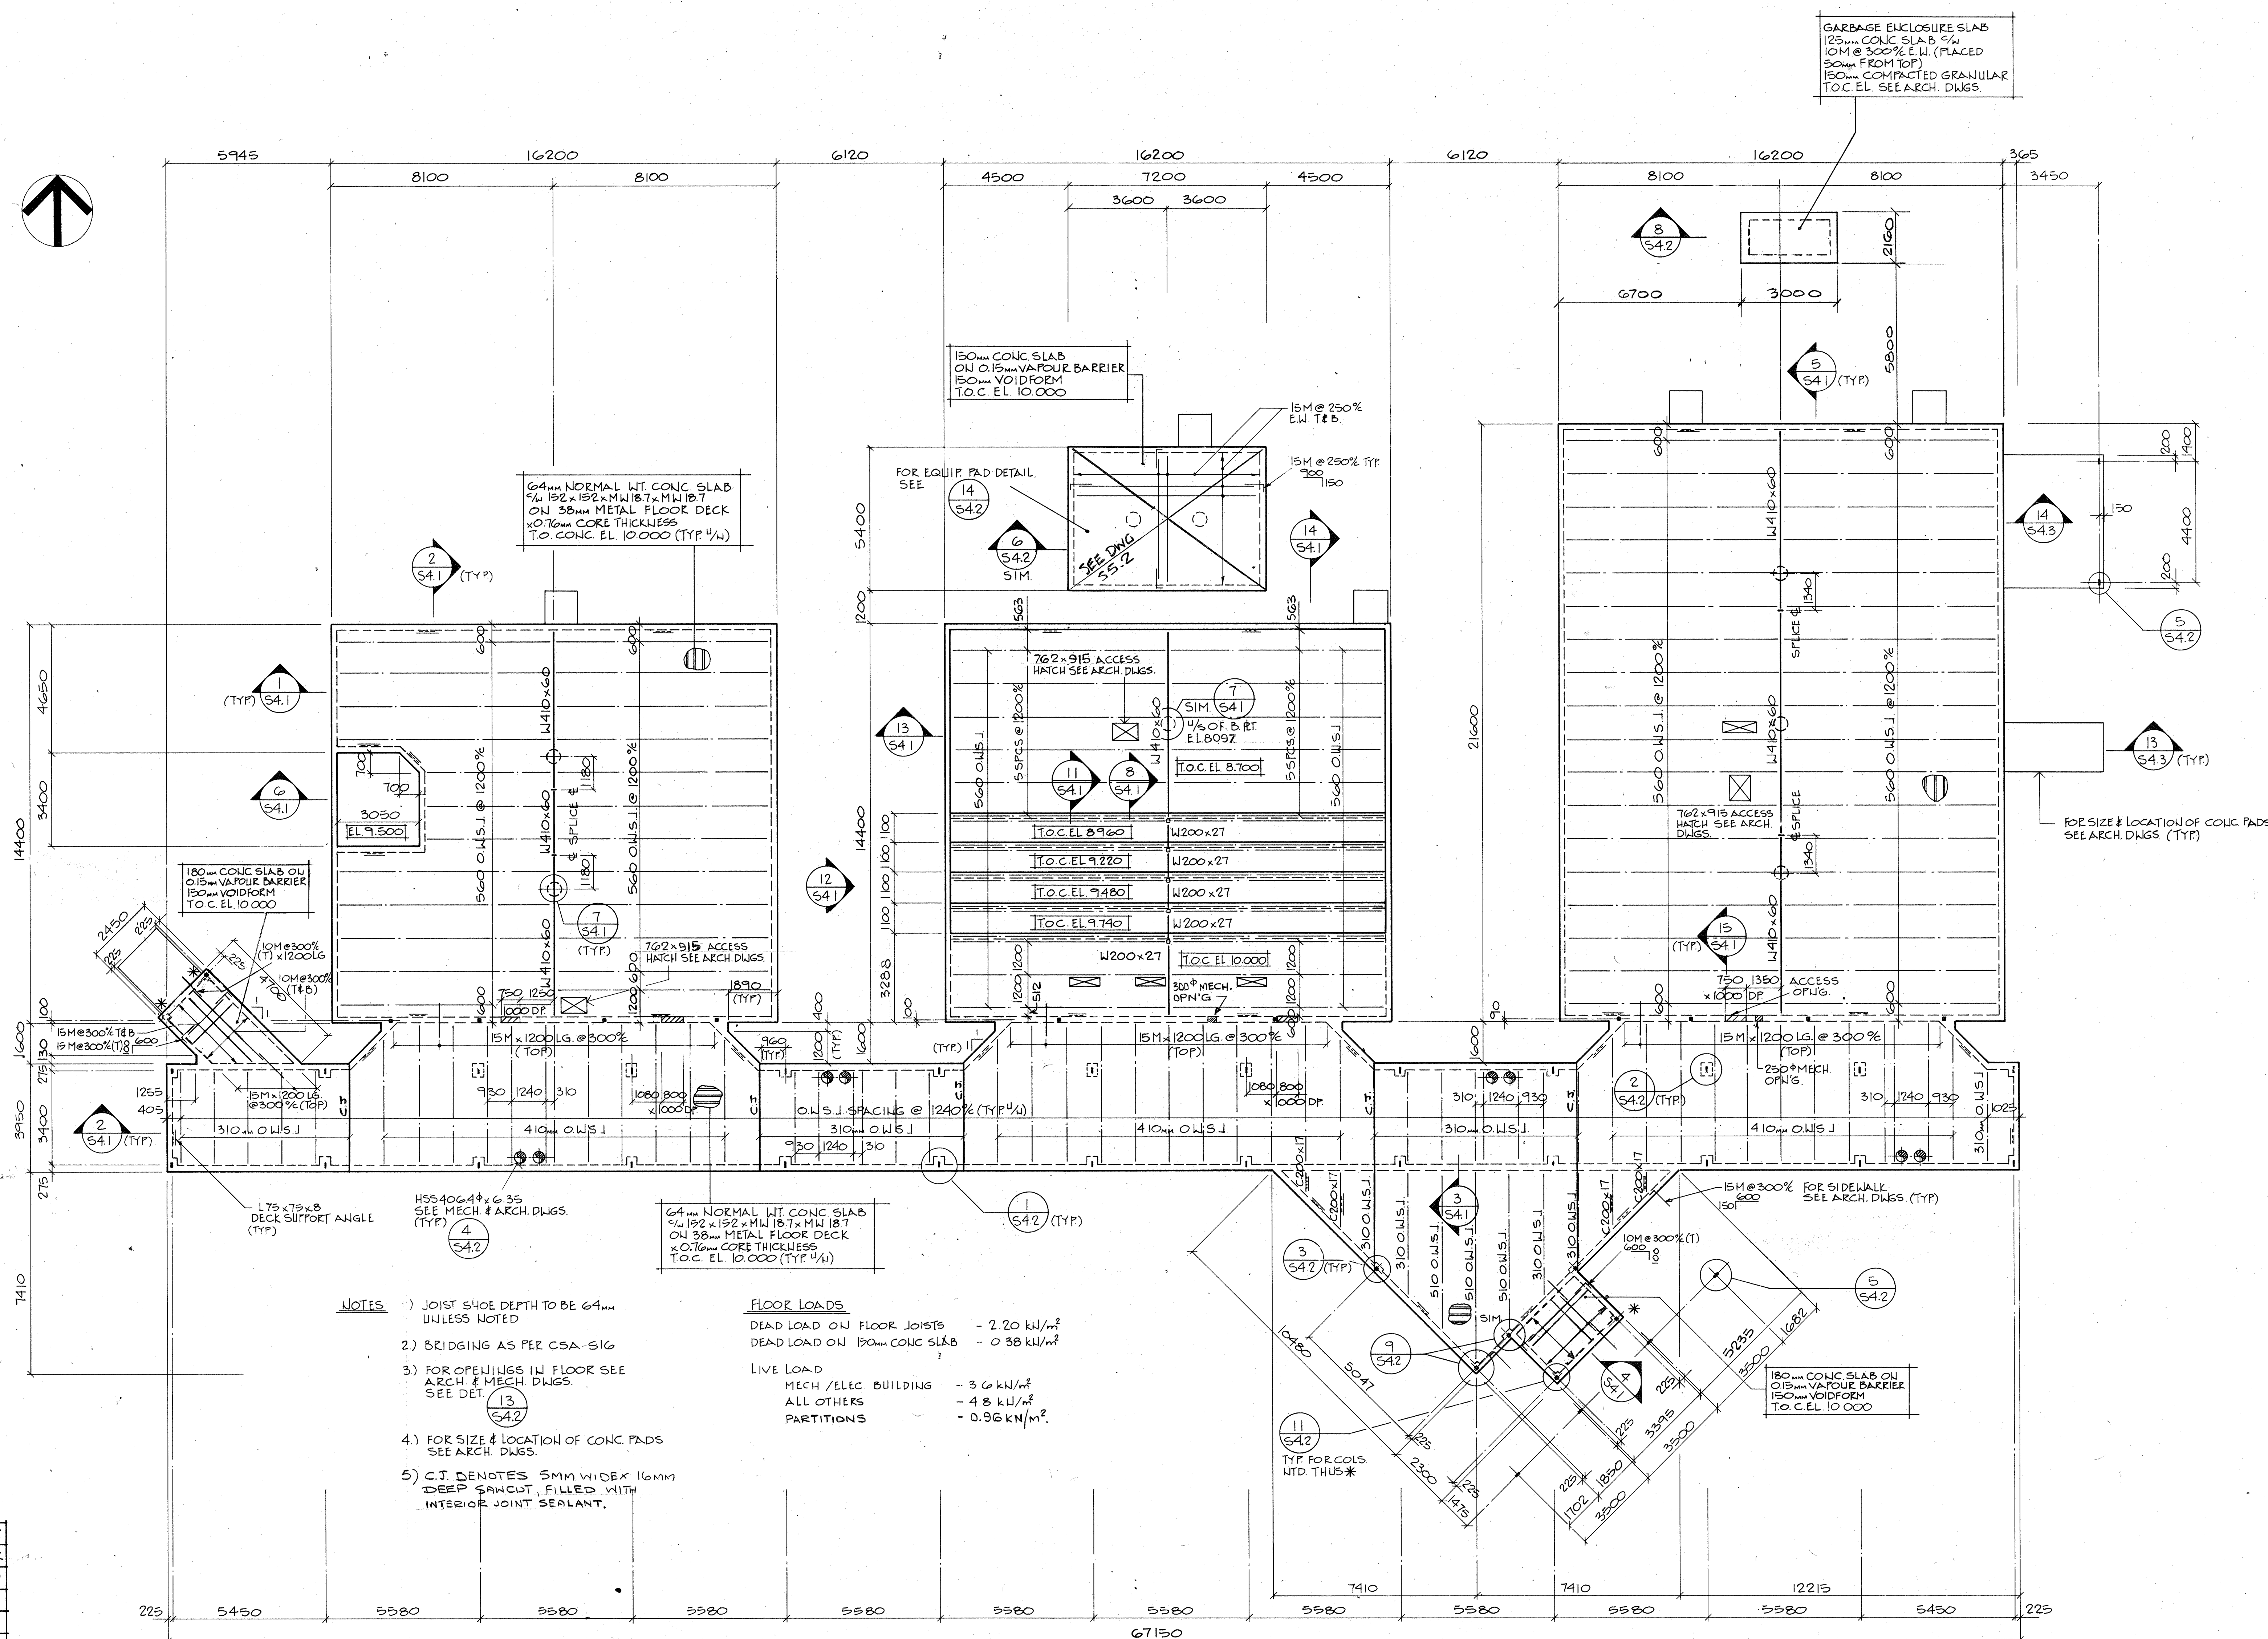

### MAIN FLOOR PLAN

0 1 2 3 4M

[illegible]


**B.O.**





THESE RECORD DRAWINGS HAVE BEEN PREPARED, IN PART, ON THE BASIS OF INFORMATION COMPILED AND FURNISHED BY OTHERS. THE ENGINEER WILL NOT BE RESPONSIBLE FOR ANY ERRORS OR OMISSIONS WHICH HAVE BEEN INCORPORATED INTO THIS DOCUMENT AS A RESULT.



 
	OCT. 30/86		PROJECT RECORD DRAWING	J.S.	<i>JS</i>
no.	date	description		drawn by trace par	app'd by appr. par
revision / revision					

## CONSULTANTS

**IKOY**  
ARCHITECTS  
IKOY FILE - 82-204

**Reid  
Crowther**  
Reid Crowther & Partners Ltd  
Engineers-Planners-Scientists  
R.C.P.L. NO. 52076  
CERT. OF AUTH. NO. 103



 Parks Canada  
Engineering and Architecture

project title / titre du projet

CONTEMPORARY FACILITIES  
BATOCHÉ NATIONAL HISTORIC SITE  
BATOCHÉ SASKATCHEWAN

drawing title / titre du dessin

**MAINTENANCE BUILDING &  
MATERIAL STORAGE BUILDING**

designed by / conception par DKK	approved by / approuvé par
drawn by / tracé par RR	date / date
checked by / vérifié par	scale / échelle AS SHOWN

project asset number / numéro du projet d'immobilisation

reference / drawing number / numéro de référence / dessin




HPBA 84/R4/E

sheet no. / feuille n°

S2.4

[illegible]



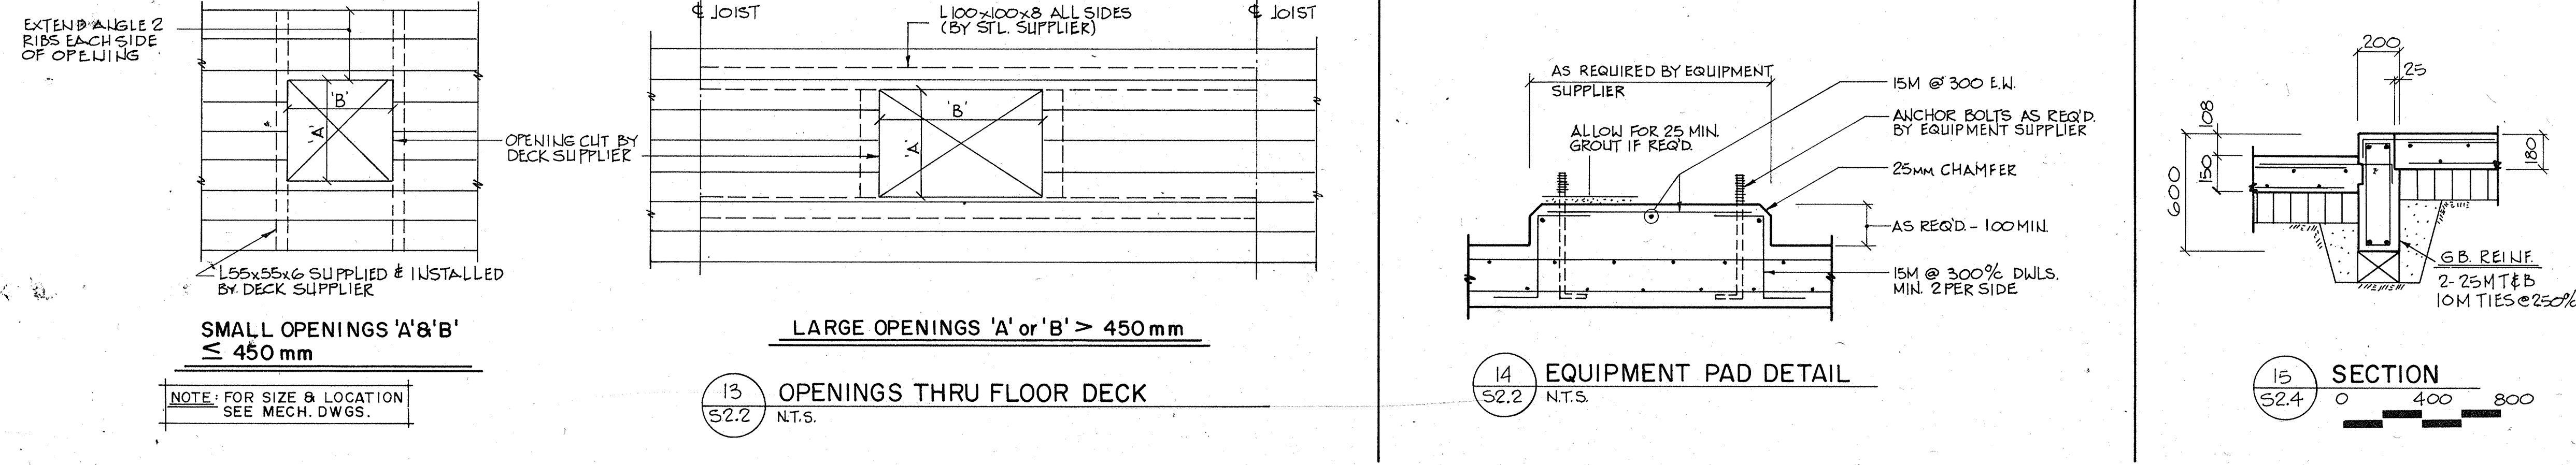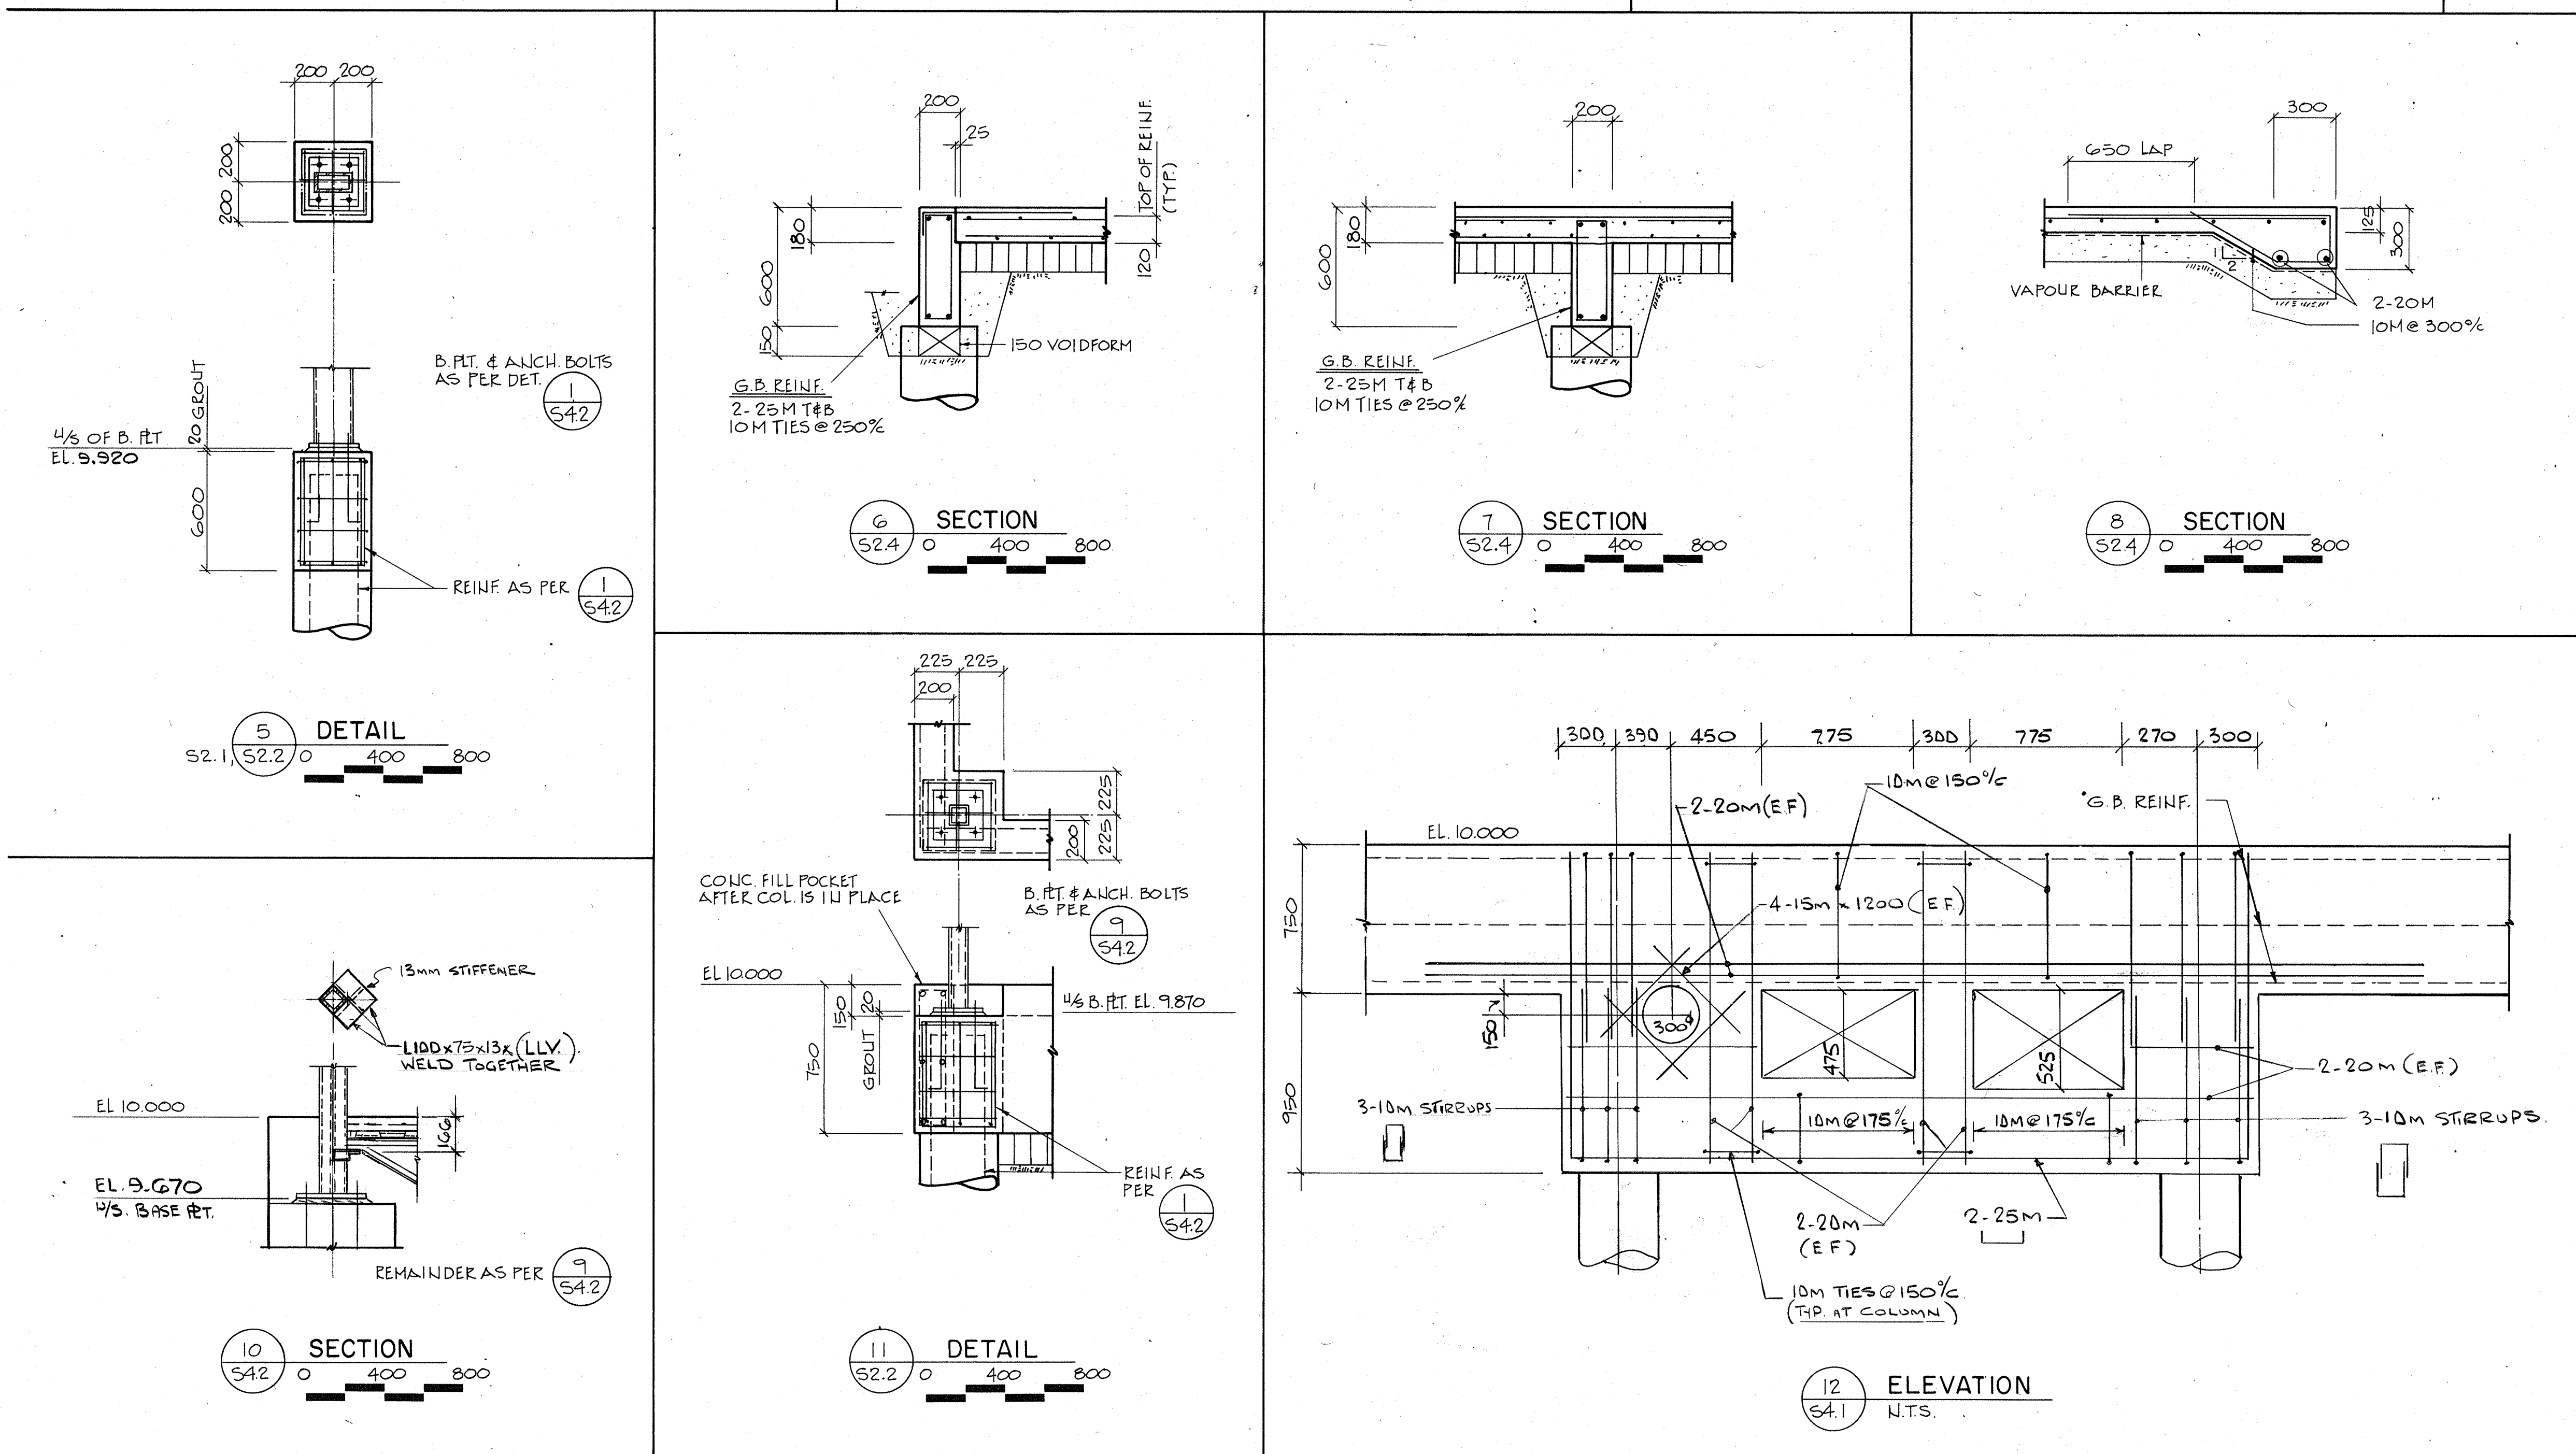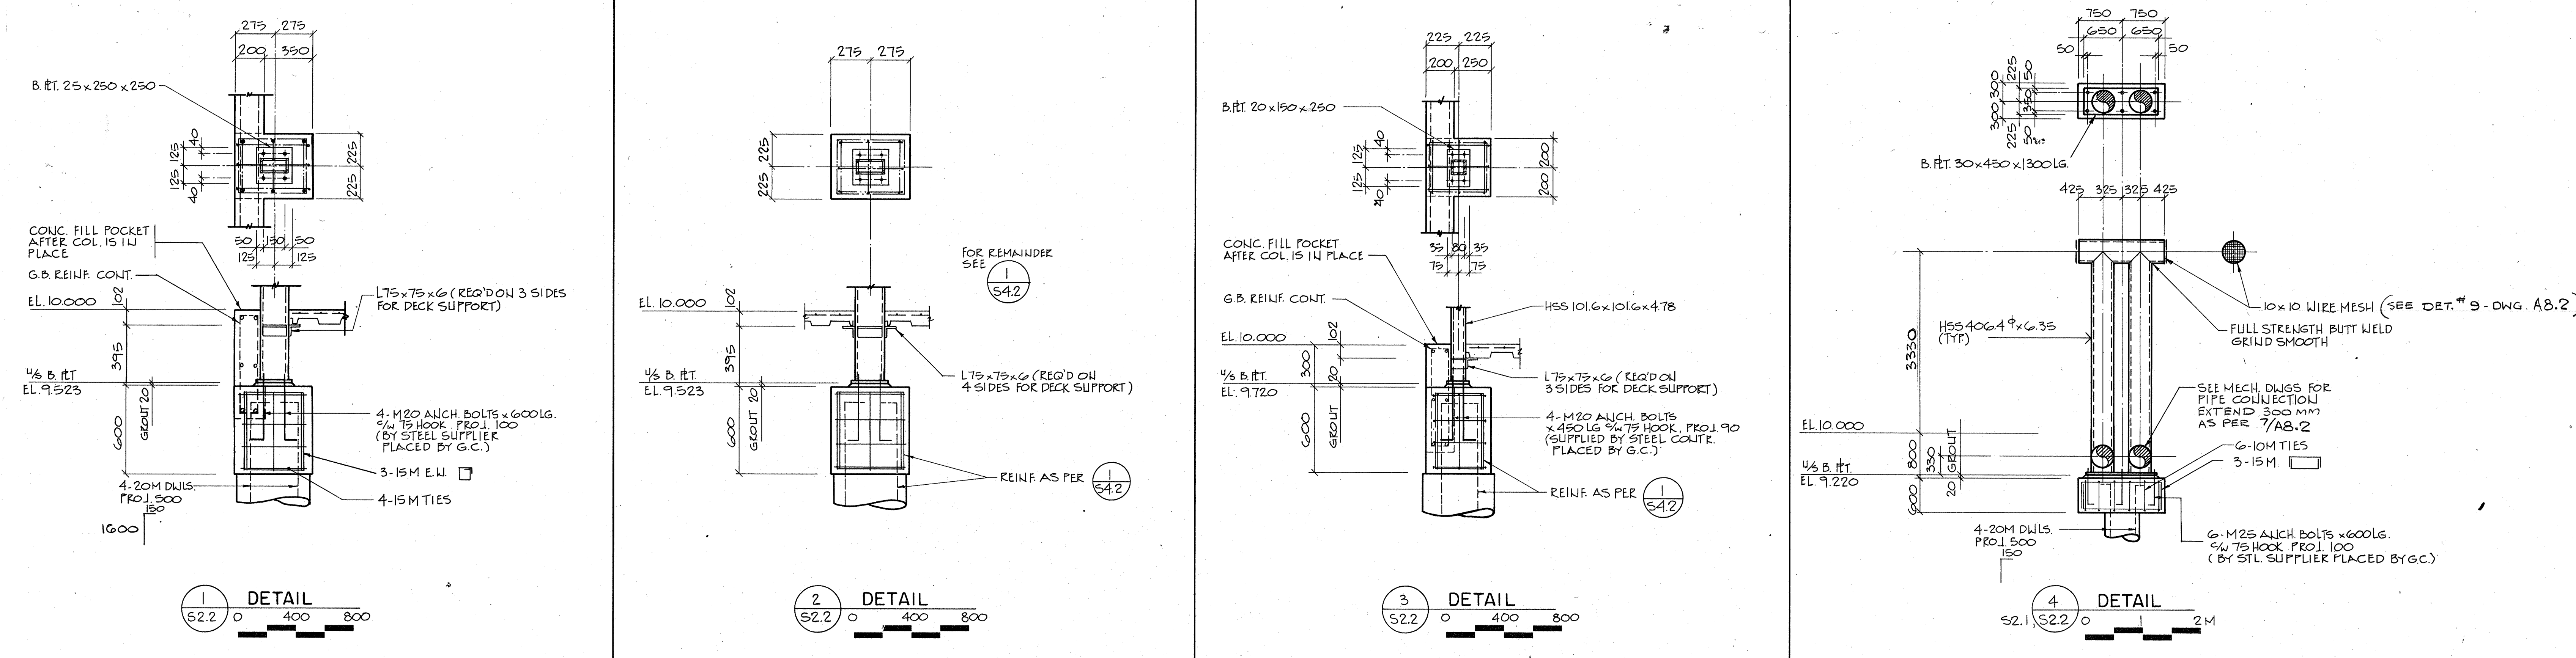

THESE RECORD DRAWINGS HAVE BEEN PREPARED, IN PART, ON THE BASIS OF INFORMATION COMPILED AND FURNISHED BY OTHERS. THE ENGINEER WILL NOT BE RESPONSIBLE FOR ANY ERRORS OR OMISSIONS WHICH HAVE BEEN INCORPORATED INTO THIS DOCUMENT AS A RESULT.

no.	date	description	drawn by tracé par	app'd by app. par
1	OCT. 30/86	PROJECT RECORD DRAWING.	J.S.	AKK
revision / révision				

CONSULTANTS

**IKOY**  
ARCHITECTS  
IKOY FILE - 82-204  
**Reid Crowther**  
Reid Crowther & Partners Ltd.  
Engineers-Porteurs-Scienctists  
R.C.P.L. NO. 52076  
CENT. OF AUTH. NO. 103



**Parks Canada**  
Engineering and Architecture  
**Parcs Canada**  
Génie et architecture


project title / titre du projet  
**CONTEMPORARY FACILITIES  
BATOCHE NATIONAL HISTORIC SITE  
BATOCHE SASKATCHEWAN**

drawing title / titre du dessin  
**SECTIONS & DETAILS**


designed by / conception par <b>DKK</b>	approved by / approuvé par
drawn by / tracé par <b>R.R.</b>	date / date
checked by / vérifié par	scale / échelle <b>AS SHOWN</b>
project asset number / numéro du projet d'immobilisation	sheet no. / feuille no. <b>S4.2</b>
reference / drawing number / numéro de référence / dessin <b>HPBA 84/R4/E</b>	

SECTION


0 400 800

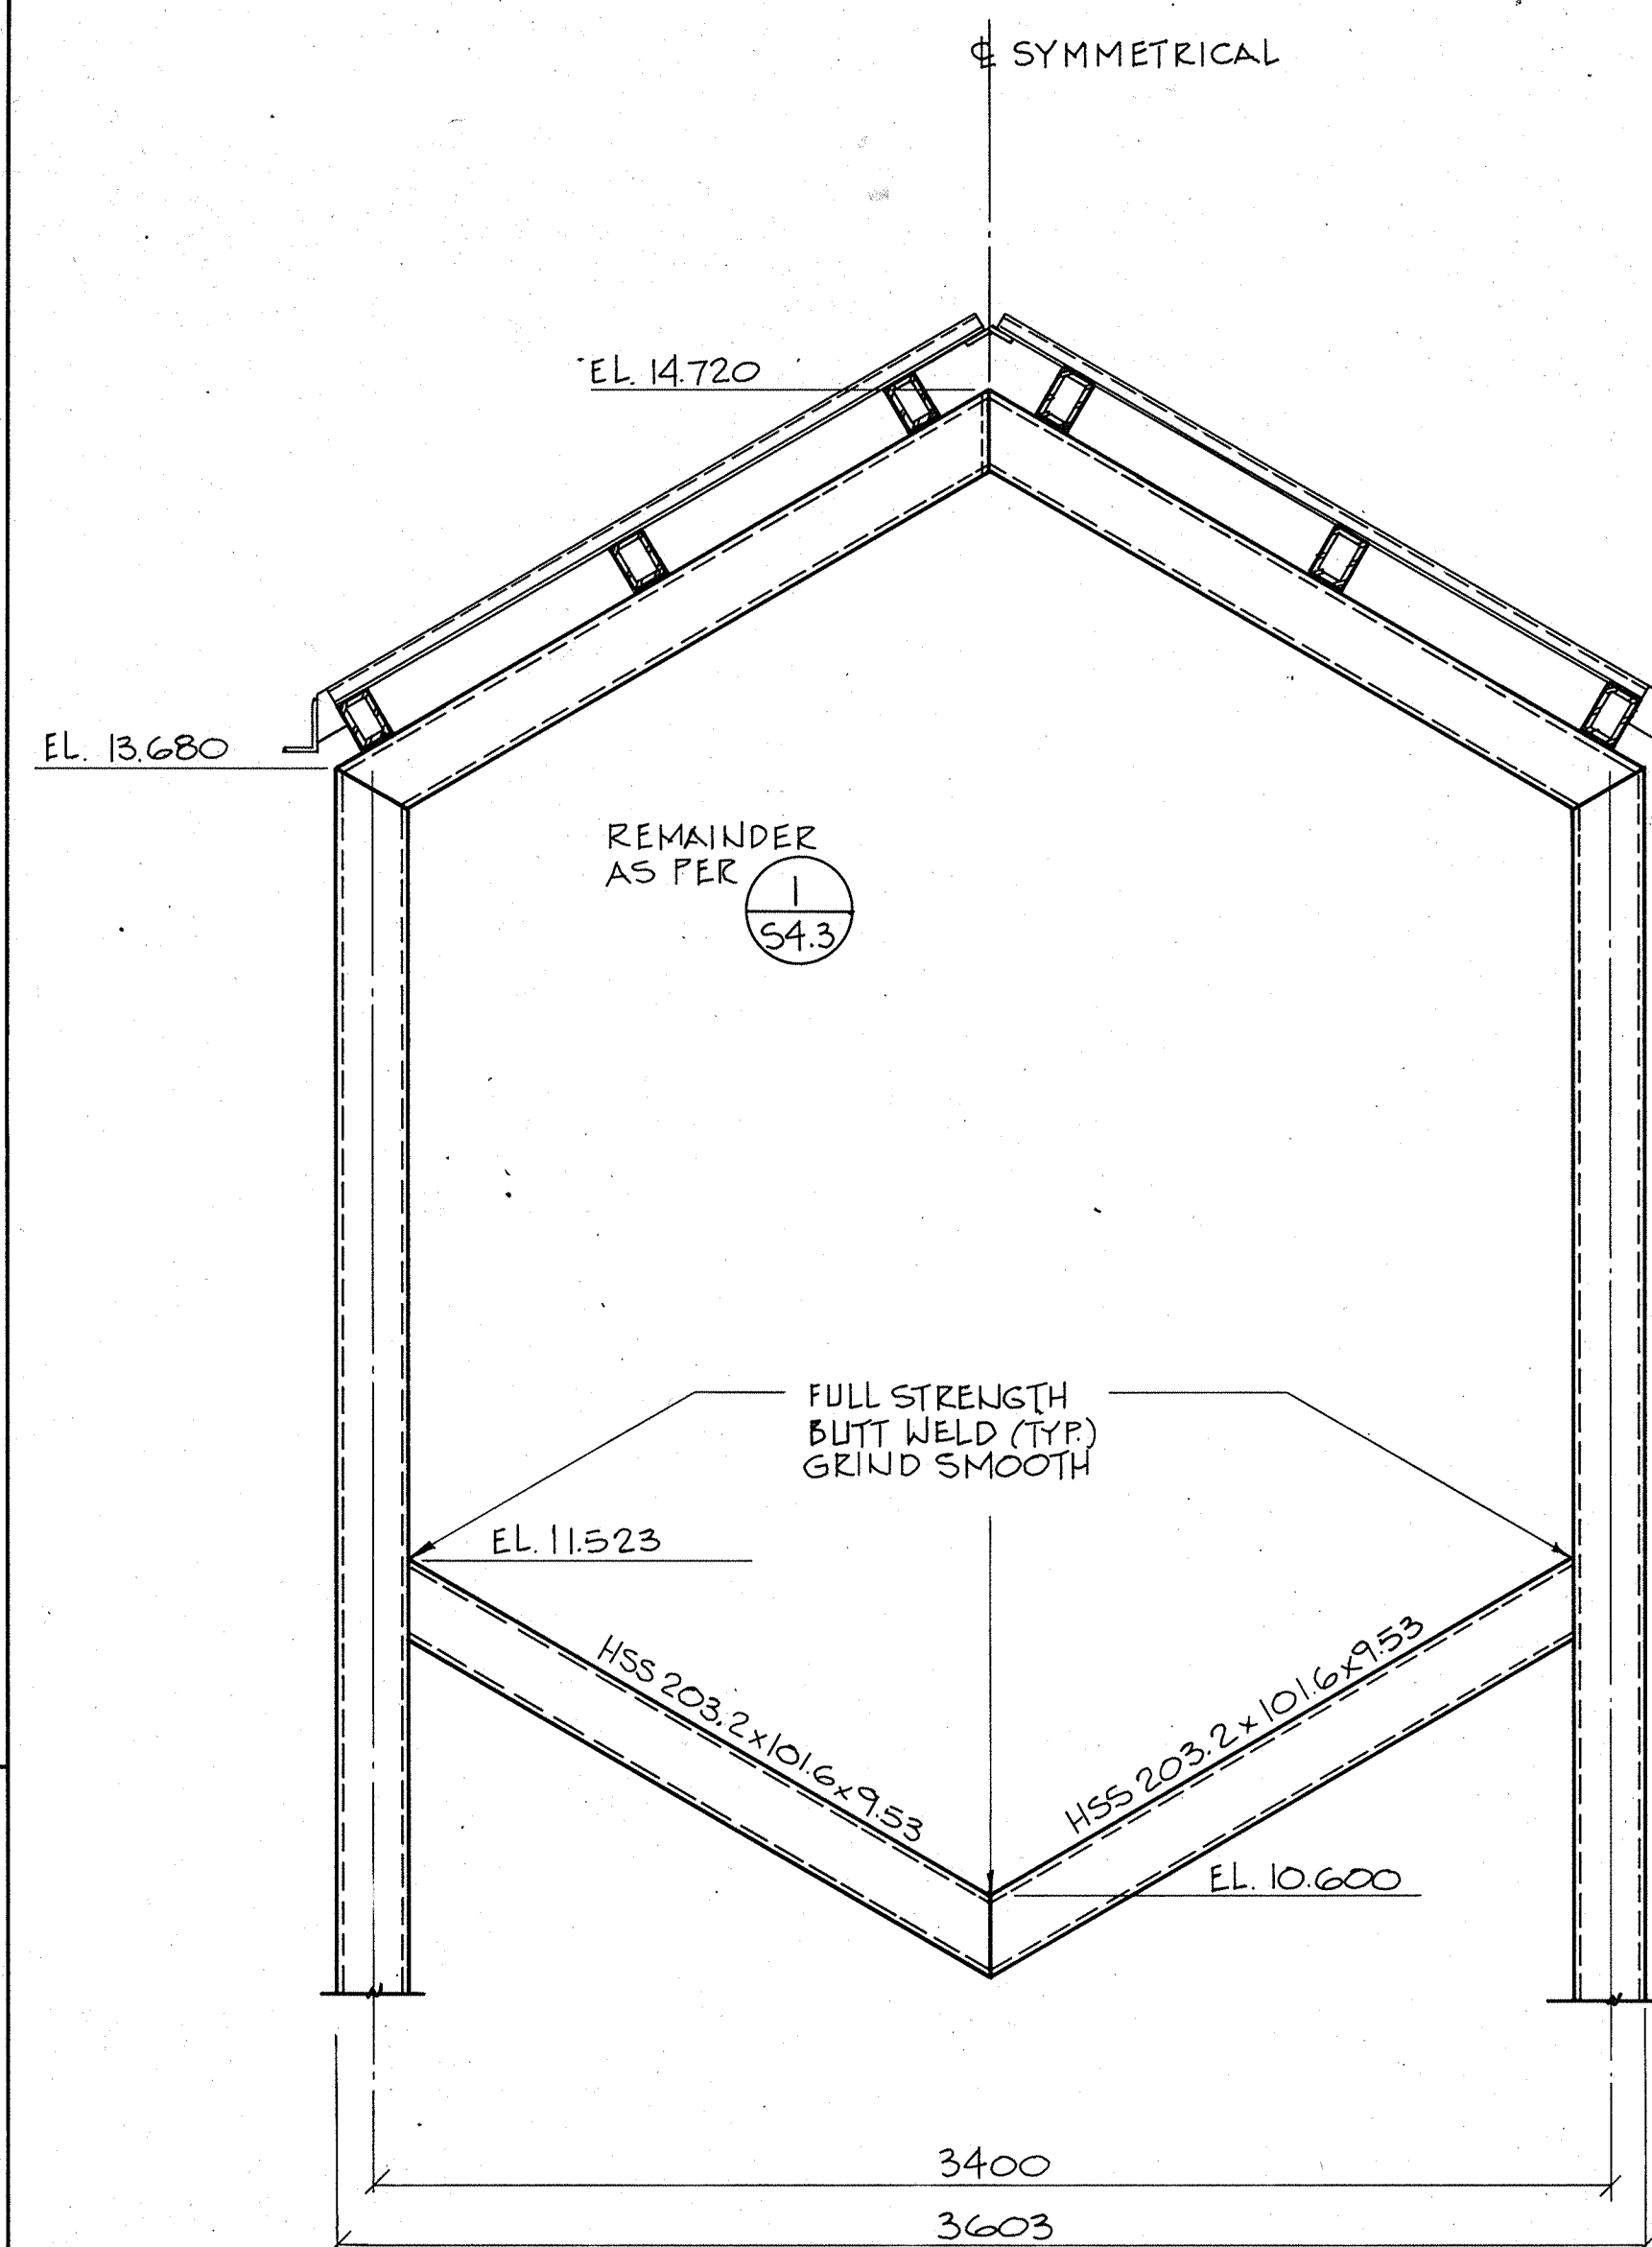

2 SECTION  
52.3 0 400 800

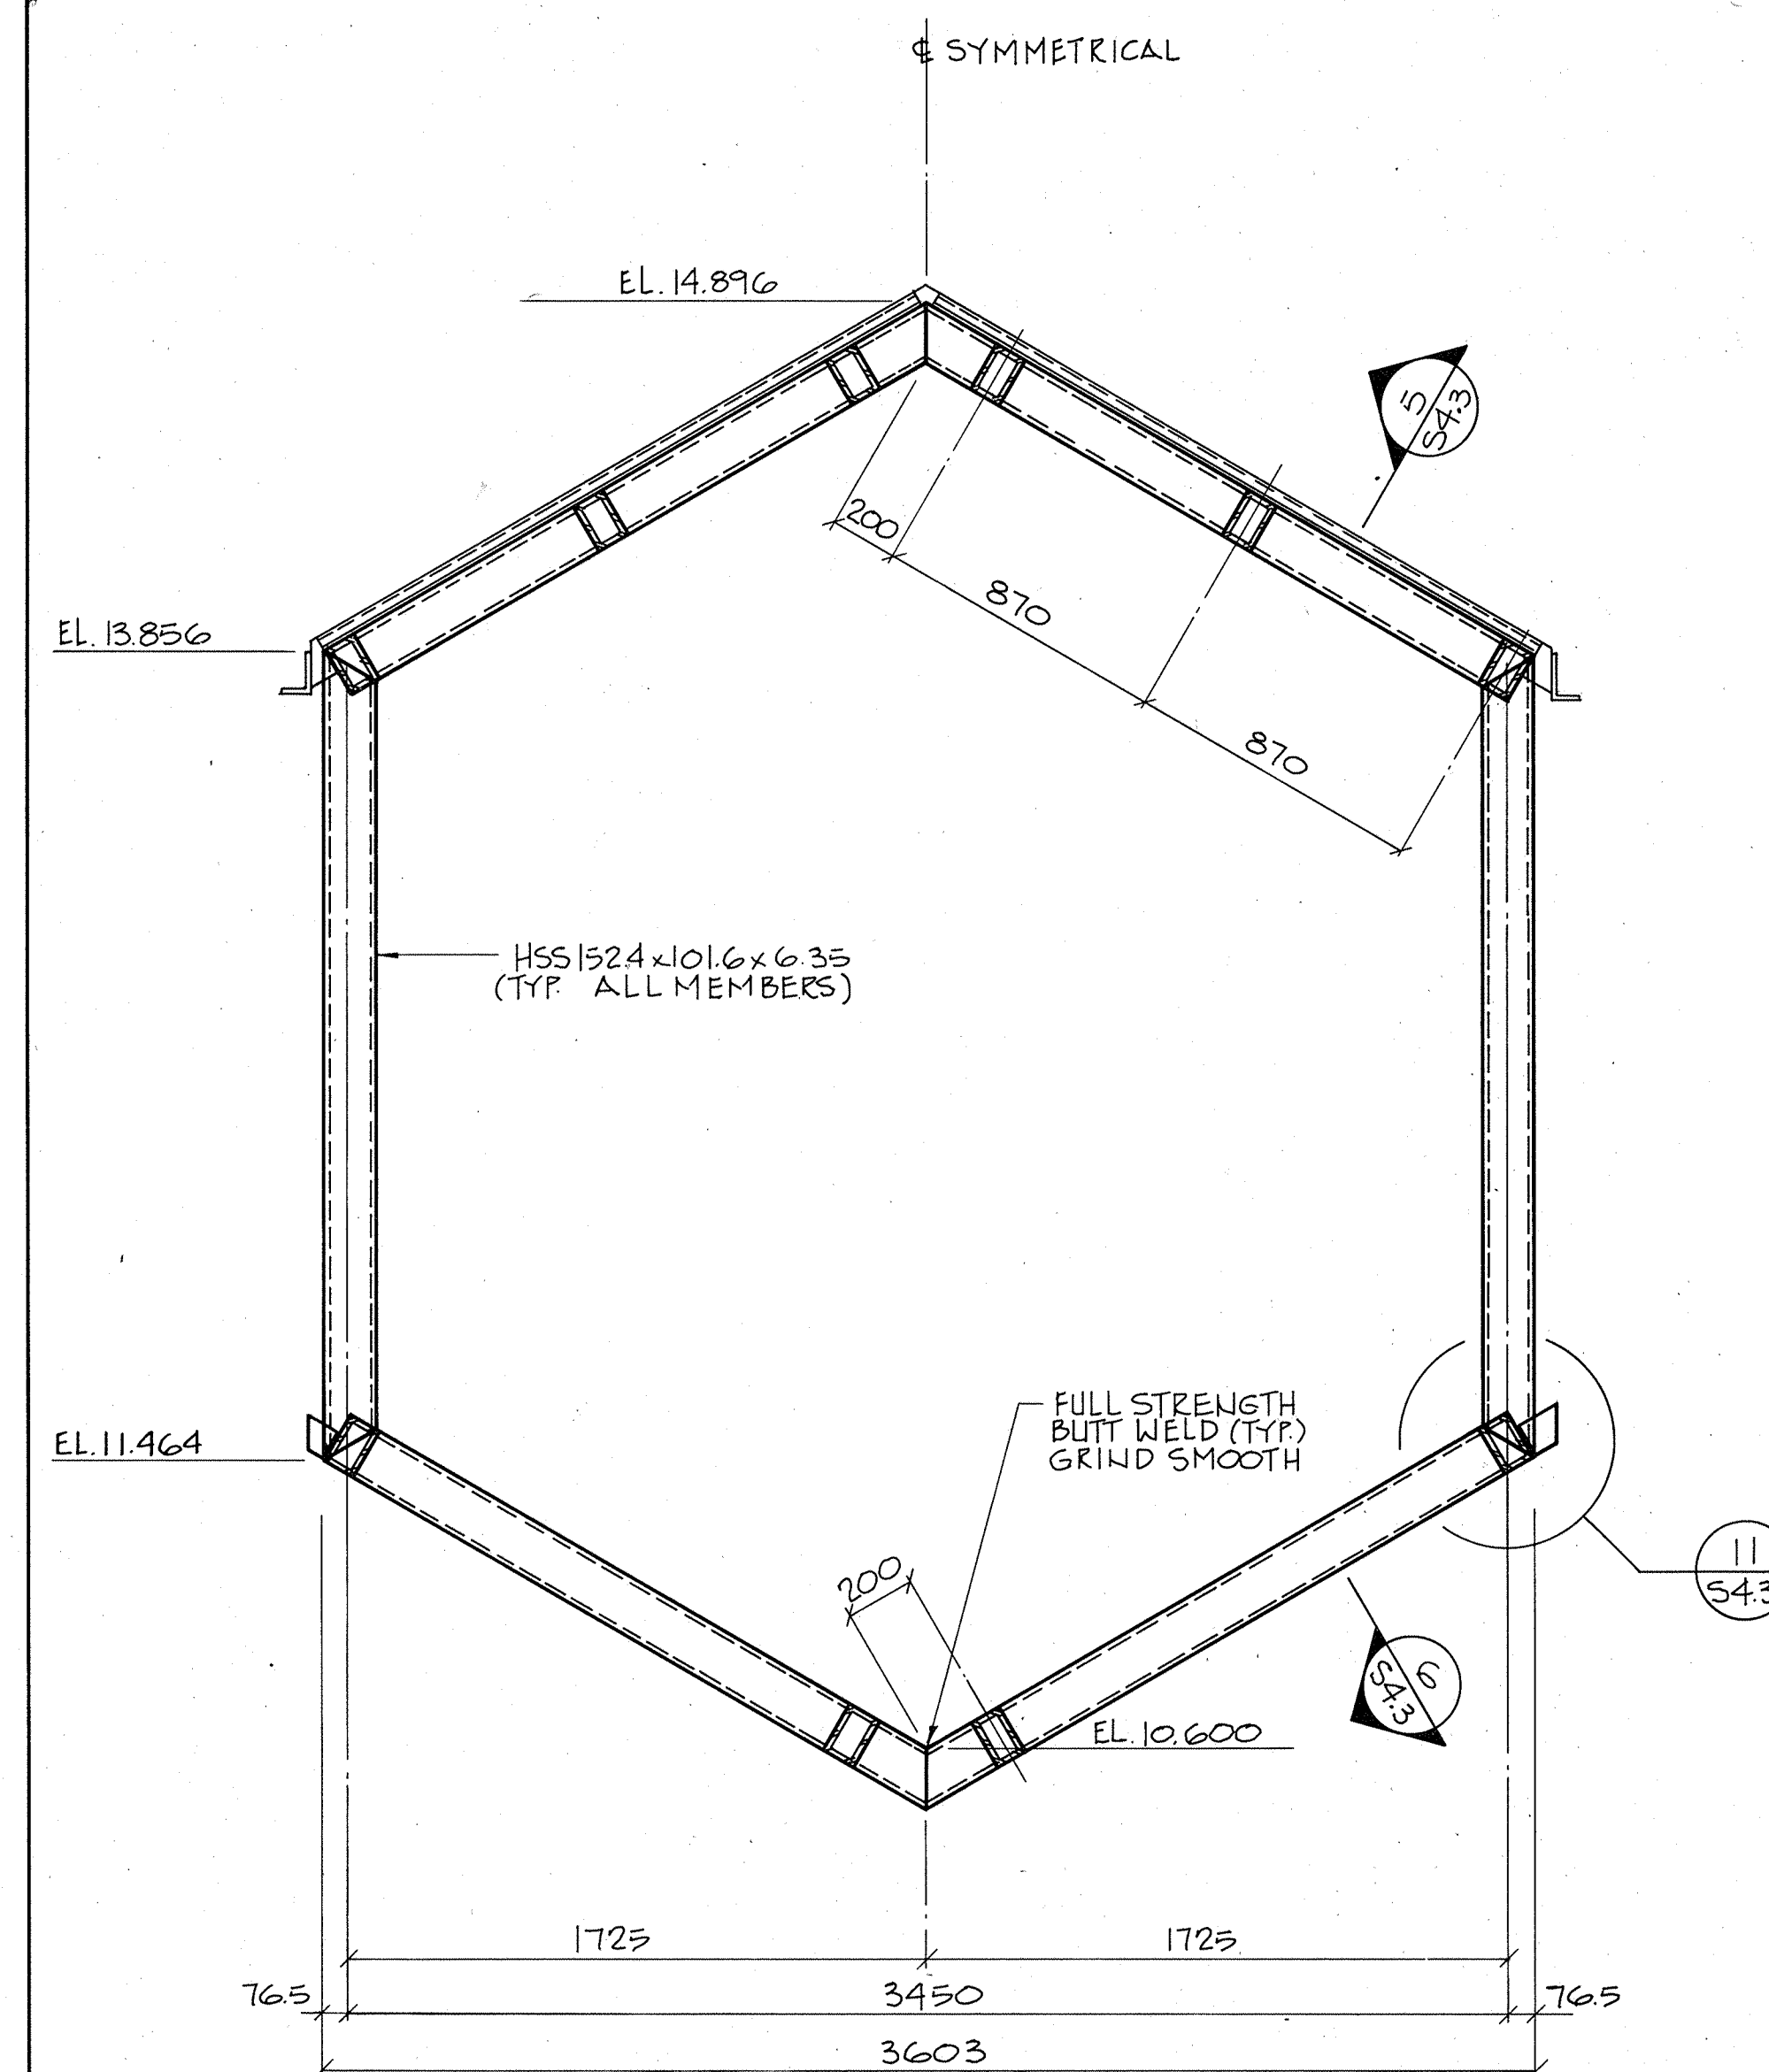


3 SECTION  
S2.3 0 400 800

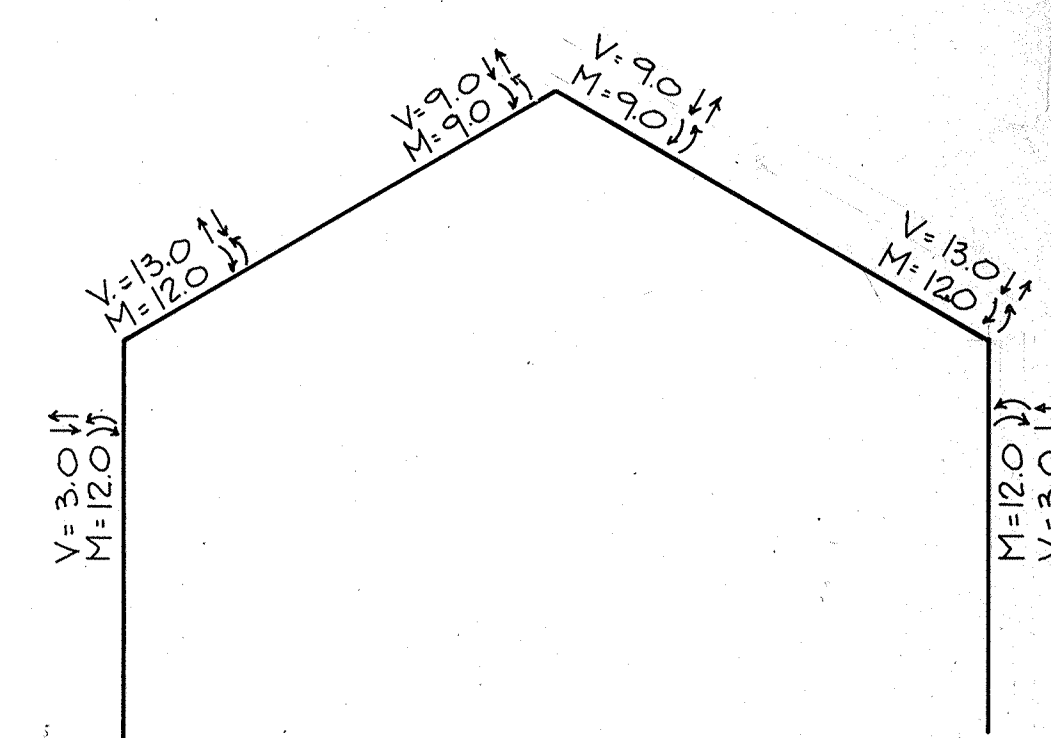

ALL FORCES IN kN.  
ALL MOMENTS IN kN.m

THESE RECORD DRAWINGS HAVE BEEN PREPARED, IN PART, ON THE BASIS OF INFORMATION COMPILED AND FURNISHED BY OTHERS. THE ENGINEER WILL NOT BE RESPONSIBLE FOR ANY ERRORS OR OMISSIONS WHICH HAVE BEEN INCORPORATED INTO THIS DOCUMENT AS A RESULT.

 	OCT. 30/86	PROJECT RECORD DRAWING	J.S.	<i>JS</i>
no.	date	description	drawn by trace par	app'd by appr. par
revision / révision				

## CONSULTANTS

**IKOY**  
ARCHITECTS  
IKOY FILE - 82-204

**Reid Crowther**  
Reid Crowther & Partners  
Engineers-Planners-Scientists  
R.C.P.L. NO. 52076  
CERT. OF AUTH. NO. 103



Engineering and Architecture      Génie et architecture

project title / titre du projet


CONTEMPORARY FACILITIES  
BATOCHÉ NATIONAL HISTORIC SITE

BATOCHÉ SASKATCHEWAN

drawing title / titre du dessin

## SECTIONS & DETAILS


designed by / conception par DKK	approved by / approuvé par
drawn by / tracé par R R	date / date
checked by / vérifié par	scale / échelle AS SHOWN
project asset number / numéro du projet d'immobilisation	
reference / drawing number / numéro de référence / dessin HPBA 84/R4/E	sheet no. / feuille S4.3

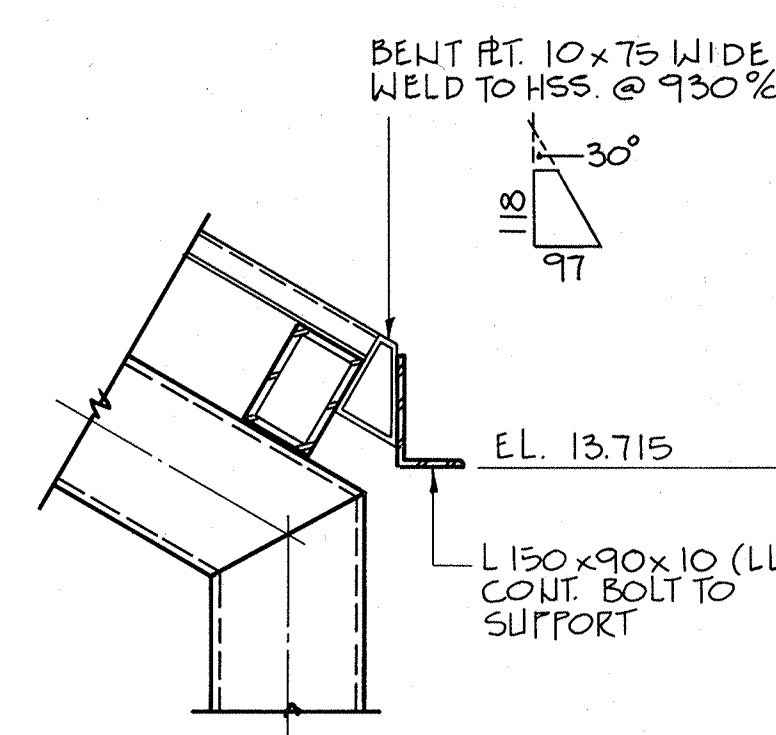


4  
54.3

DETAIL


0 200 400

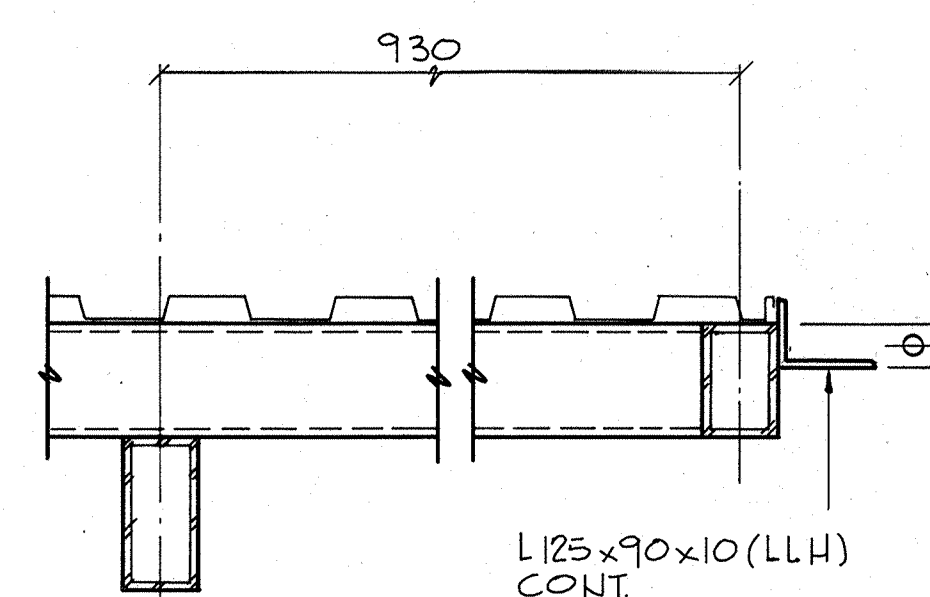


5 SECTION

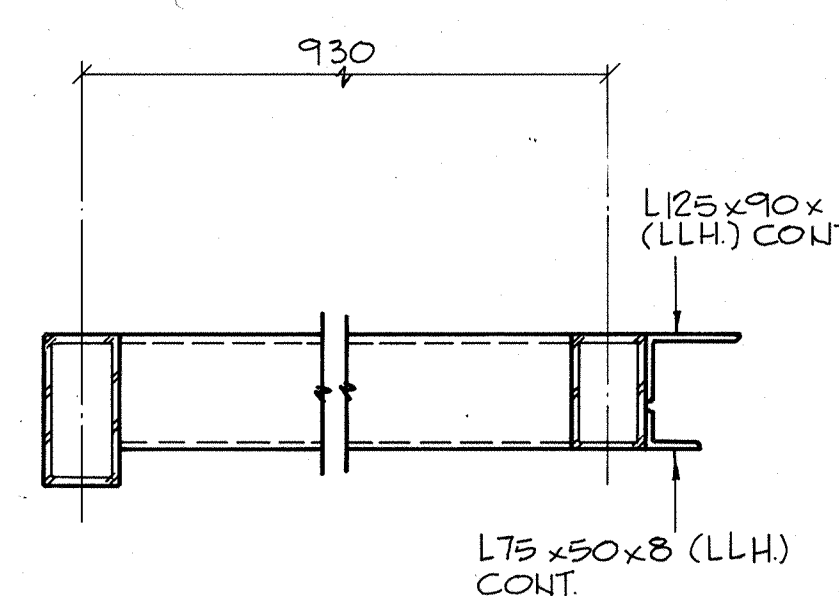

6 SECTION

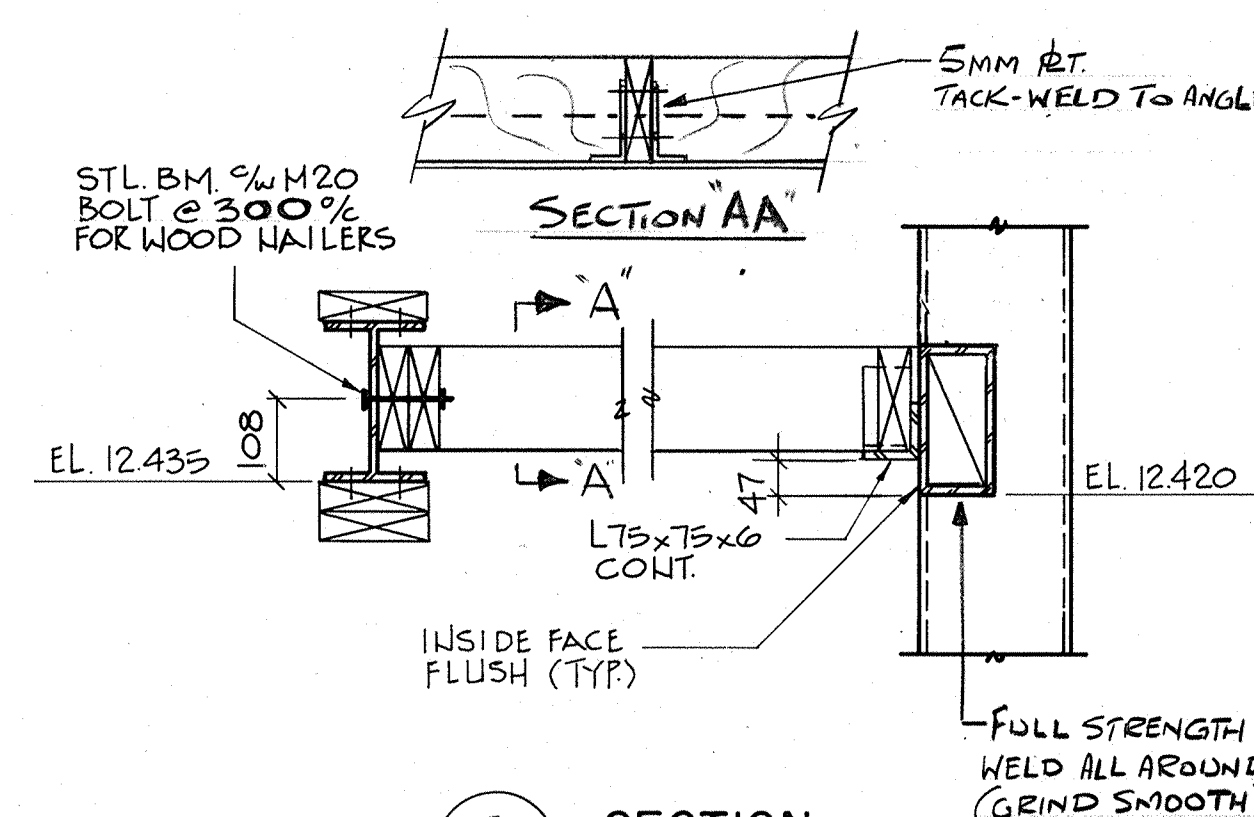


7 SECTION

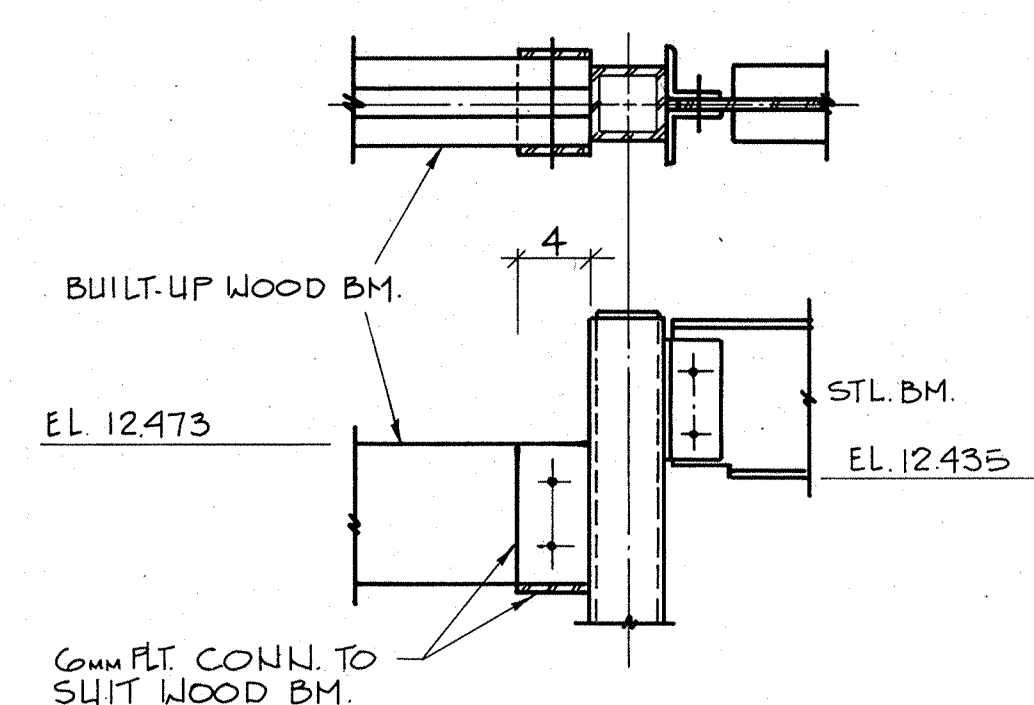


8  
52.3

DETAIL


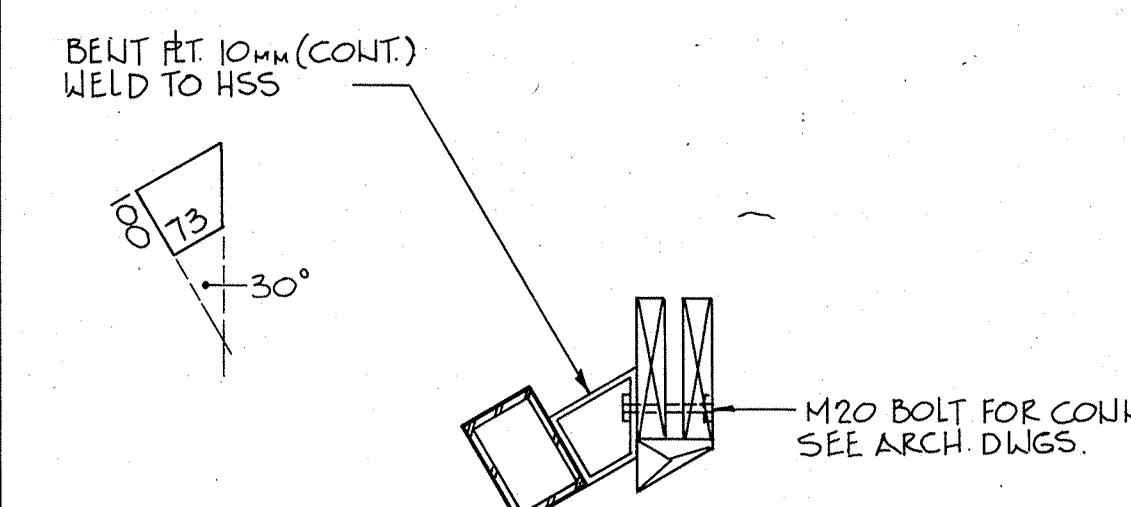
0 200 400

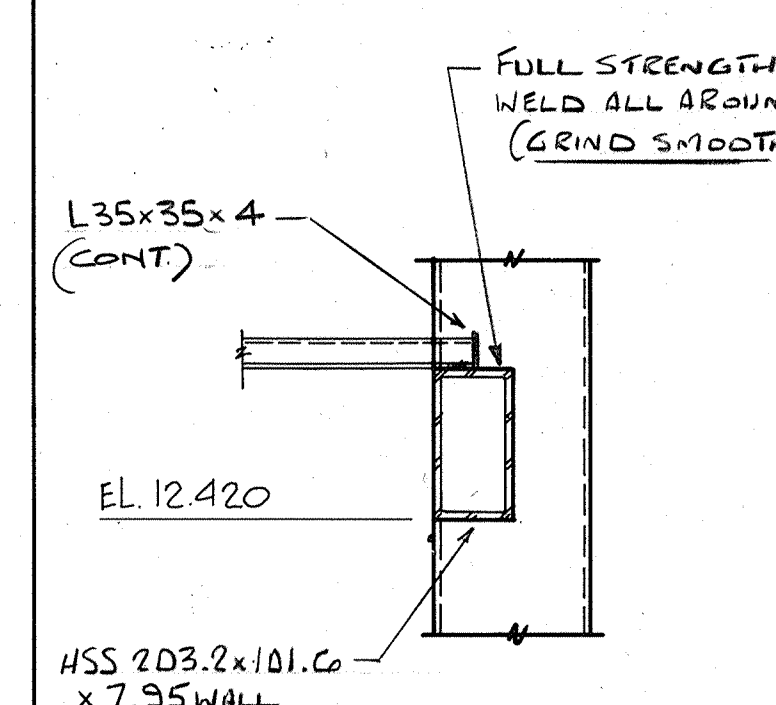

9 SECTION  
52.3 0 200 400

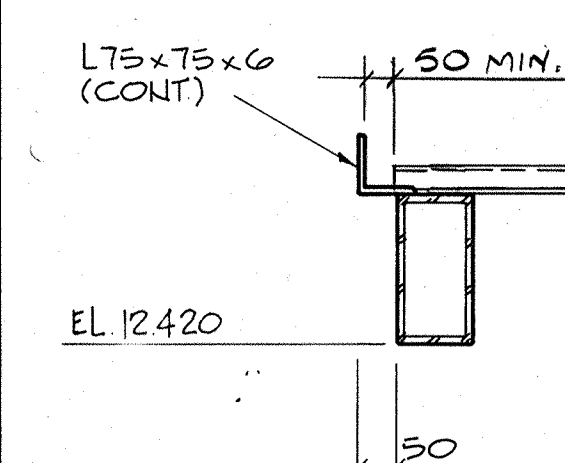


10 SECTION



DETAIL

54.3


0 200 400

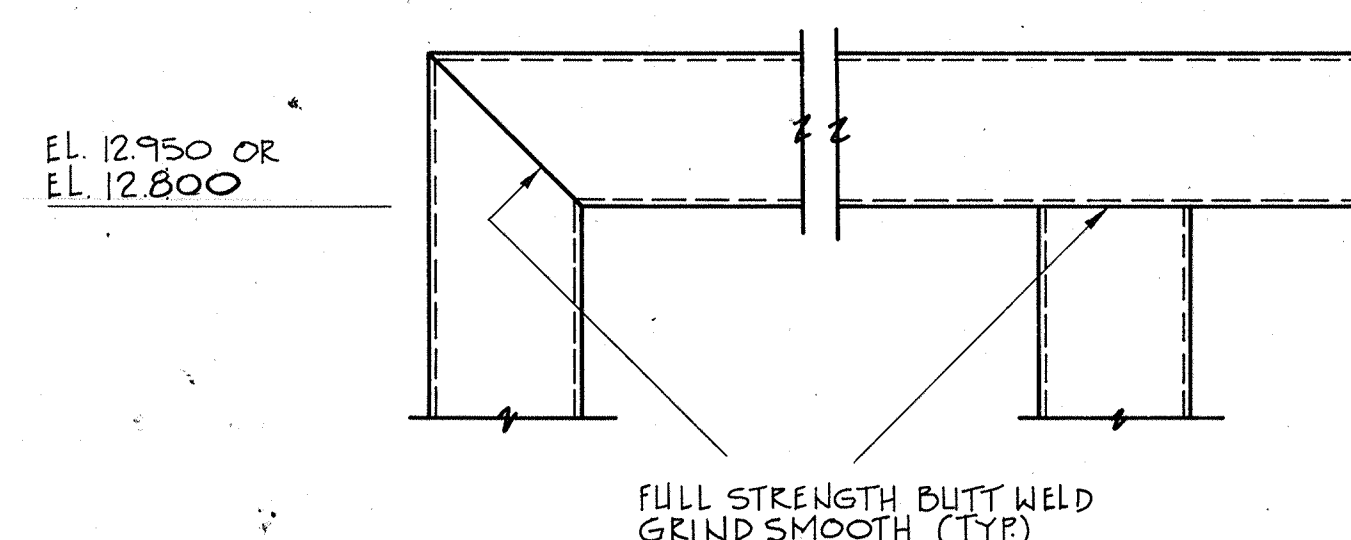


12  
52.3

DETAIL

0 200 400

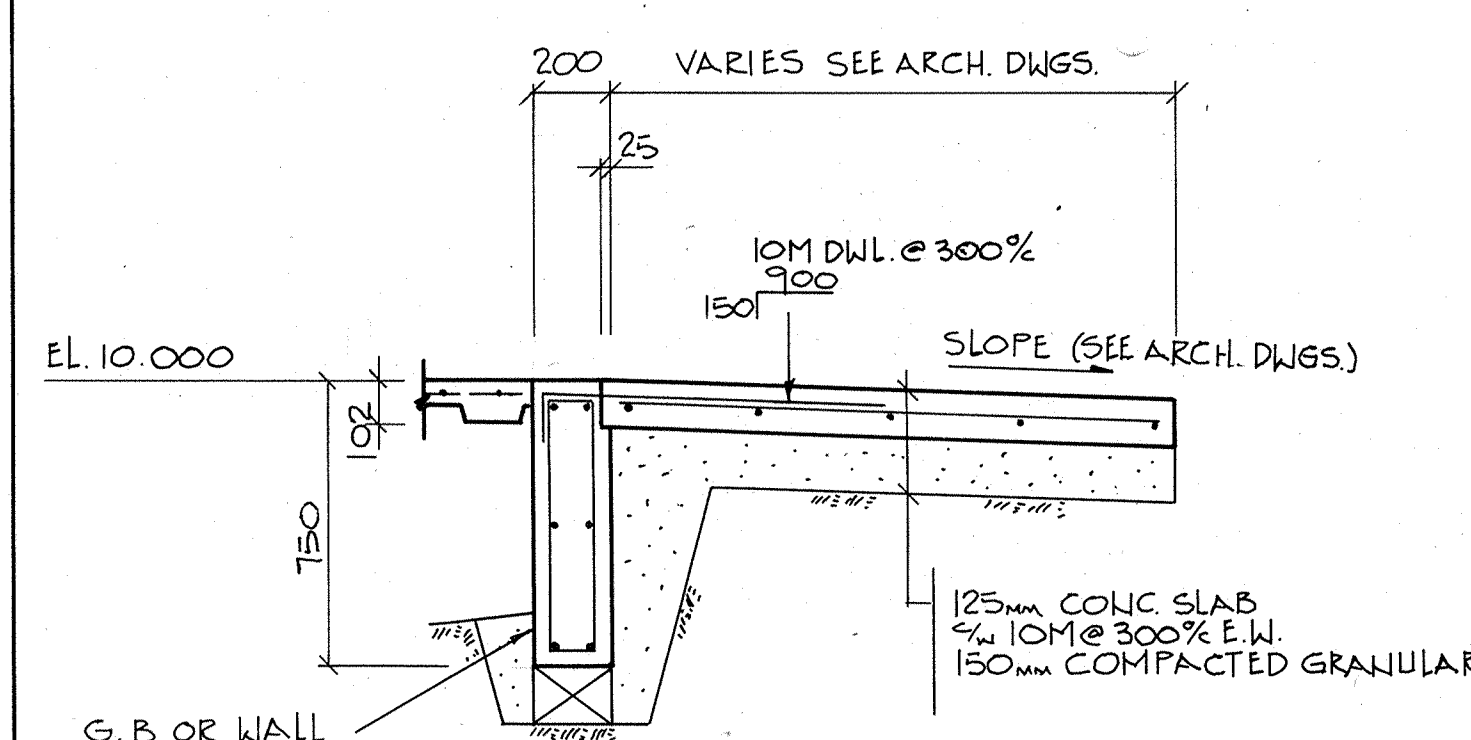


13 SECTION  
52.2 0 400 800

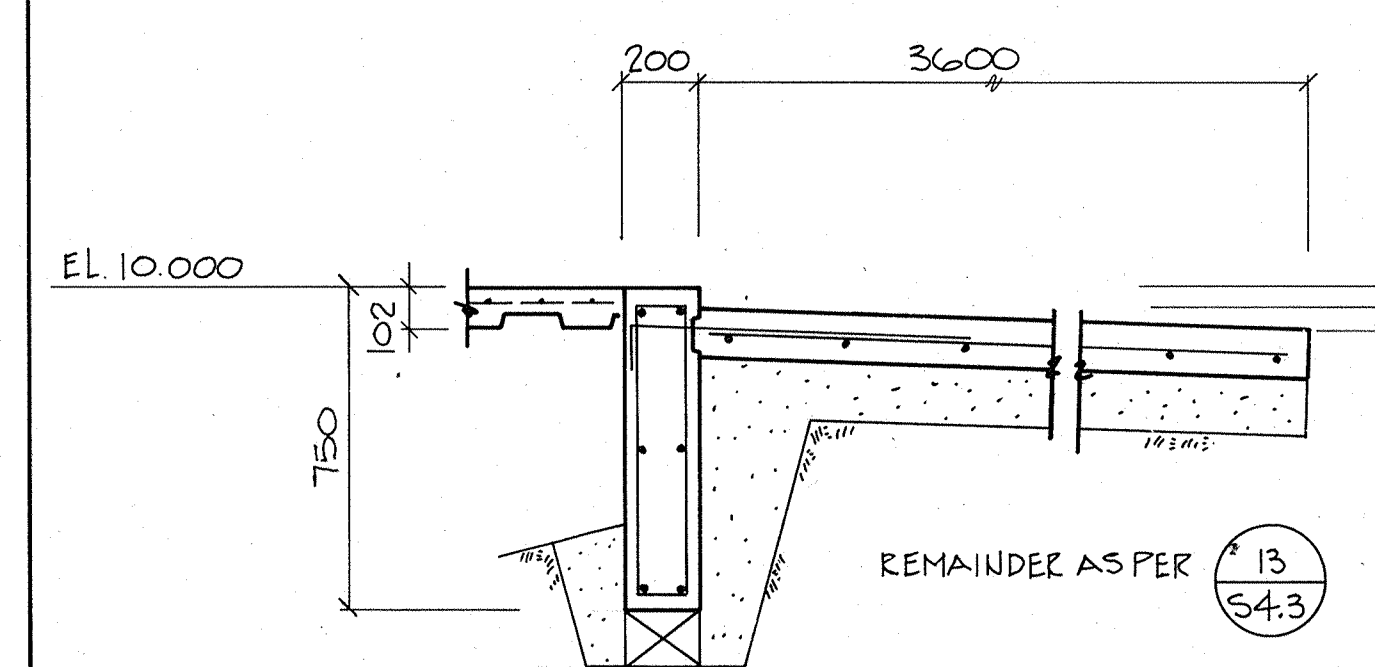

14 SECTION  
52.2 0 400 800

[illegible]



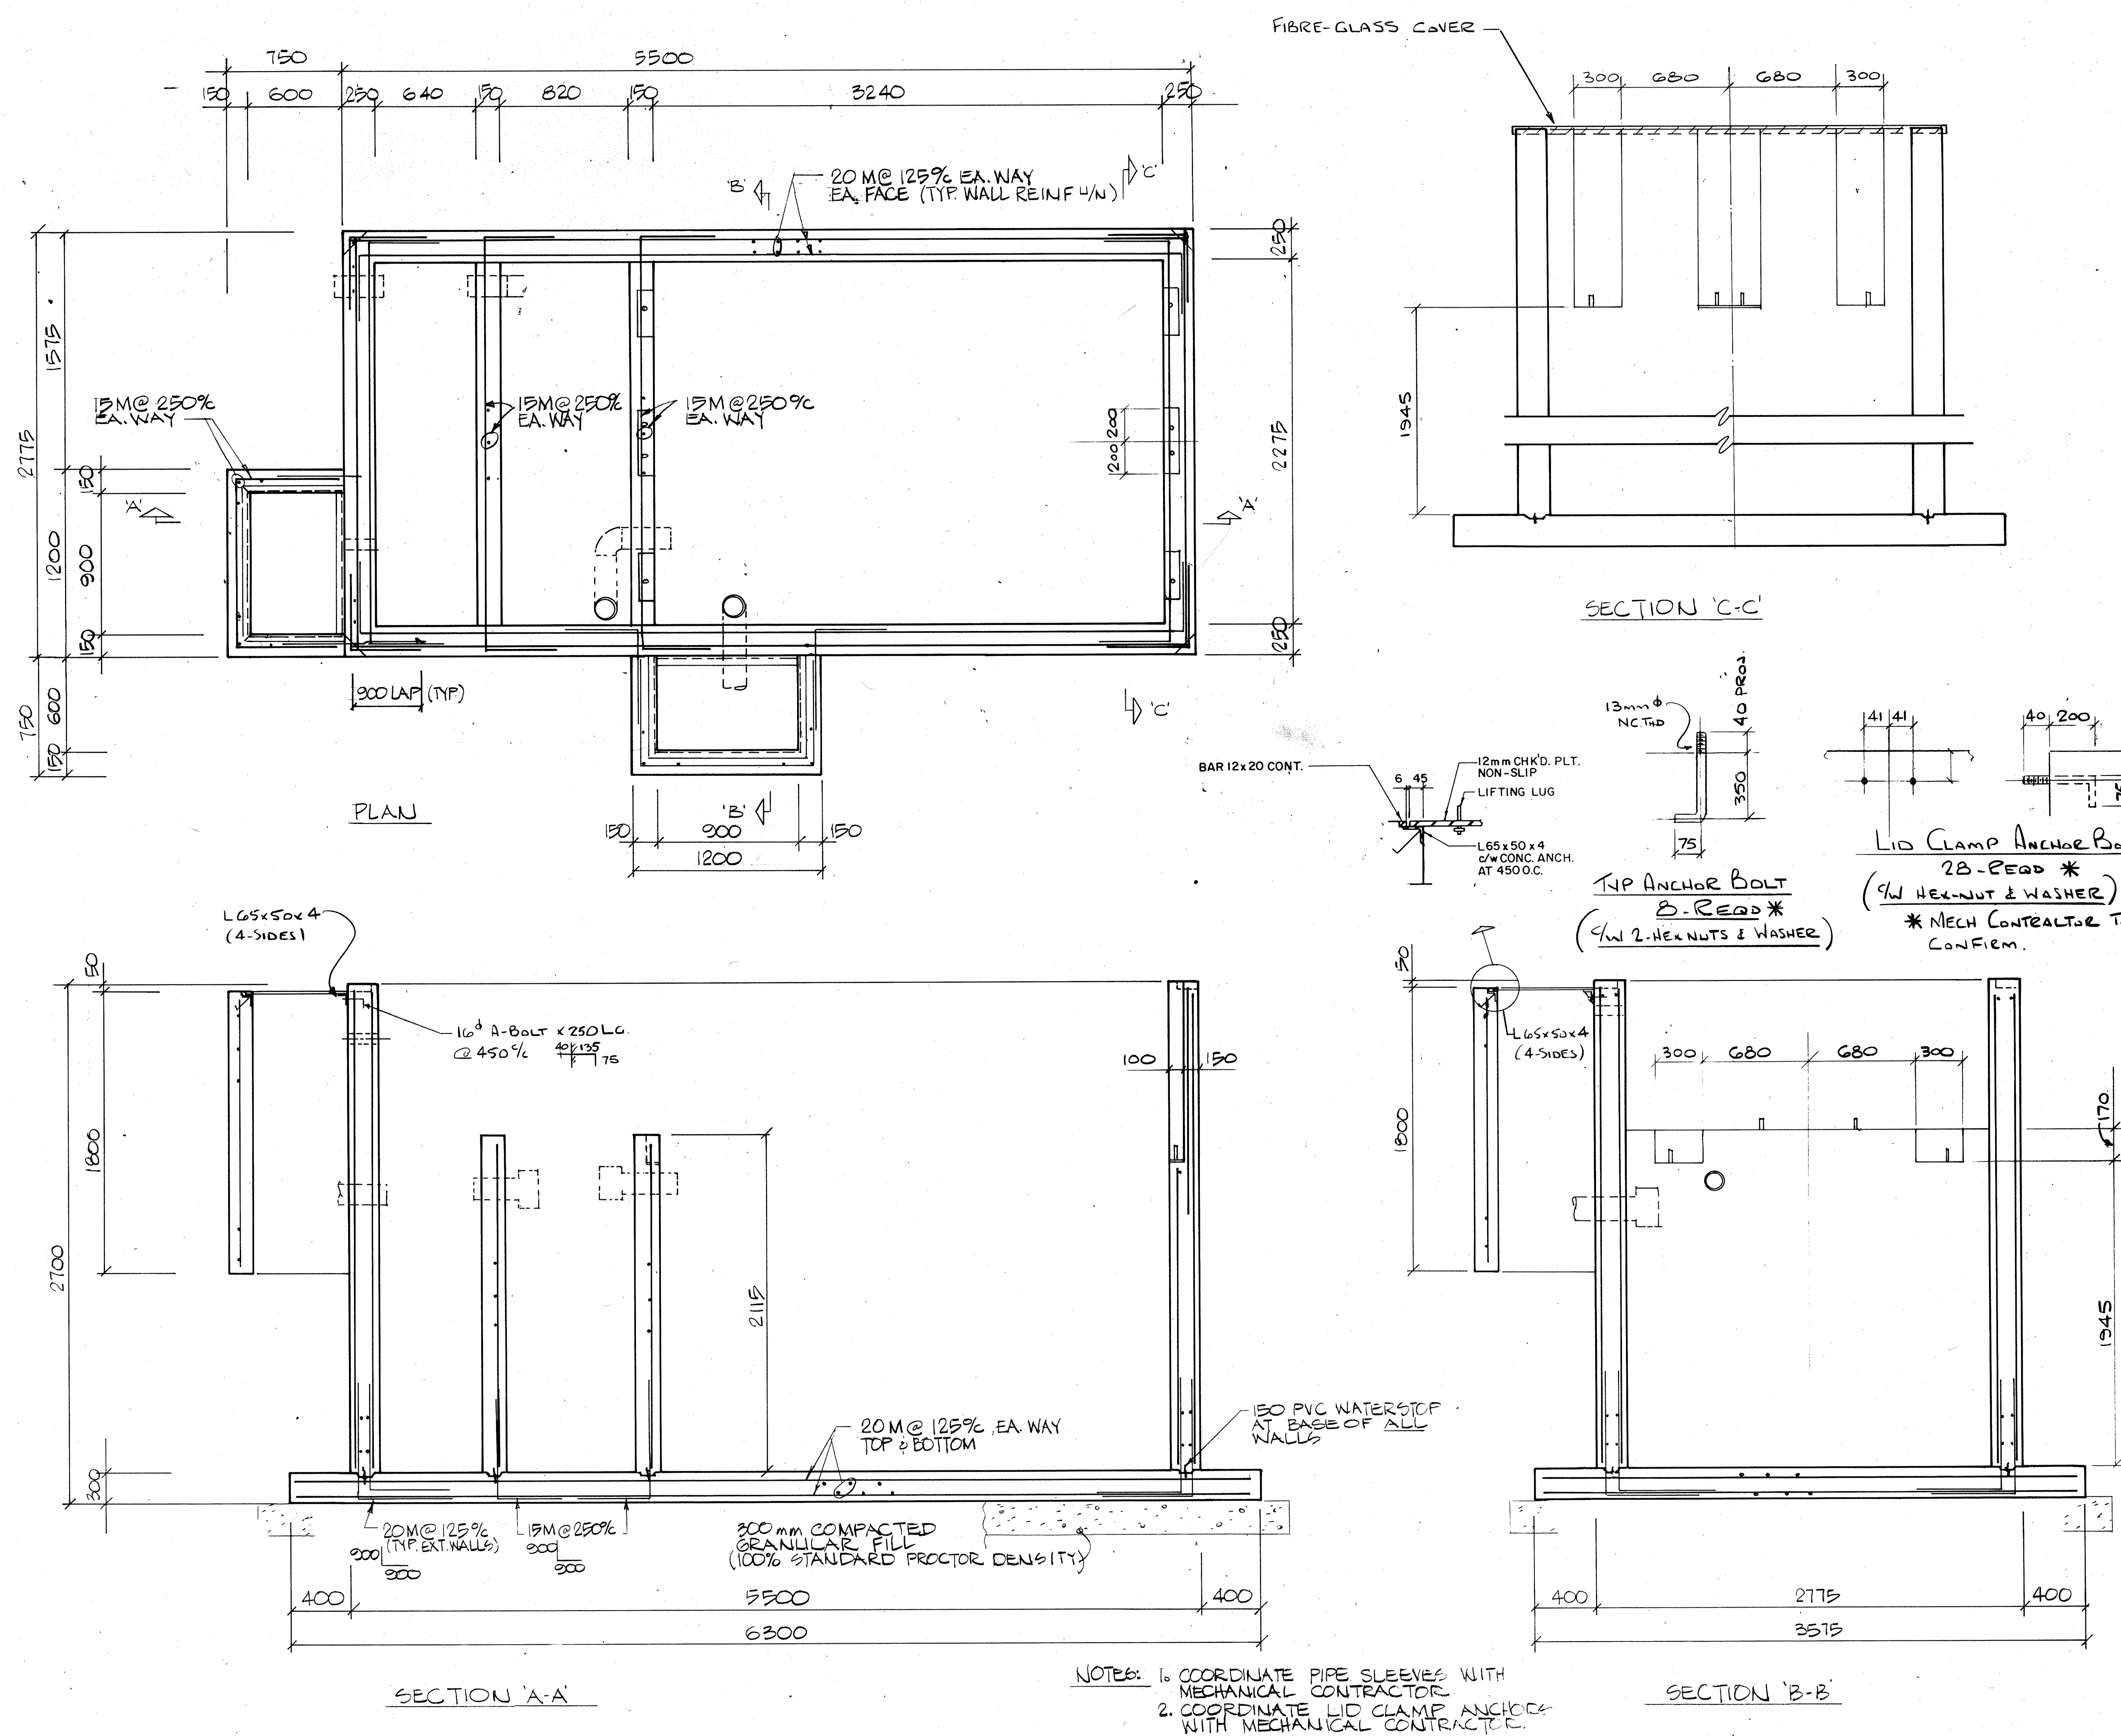


NOTES :-

1. FOR LOCATION OF TANK REFER TO MECHANICAL DRAWINGS M1.1 & M4.2


THESE RECORD DRAWINGS HAVE BEEN PREPARED, IN PART, ON THE BASIS OF INFORMATION COMPILED AND FURNISHED BY OTHERS. THE ENGINEER WILL NOT BE RESPONSIBLE FOR ANY ERRORS OR OMISSIONS WHICH HAVE BEEN INCORPORATED INTO THIS DOCUMENT AS A RESULT.



RESULT.				
	OCT. 30/86	PROJECT RECORD DRAWING	J.S.	<i>JS</i>
no.	date	description	drawn by trace par	app'd by appr. par
revision / révision				

## CONSULTANTS

 **IKOY**  
ARCHITECTS  
IKOY FILE - 82-204

**Reid Crowther**  
Reid Crowther & Partners Ltd.  
Engineers-Planners-Scientists  
RCPL NO. 52076  
CERT. OF AUTH. NO. 103

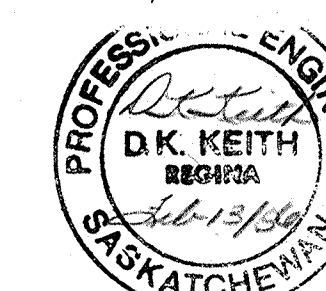

 Parks Canada       Parcs Canada  
Engineering and Architecture      Génie et architecture

project title / titre du projet

CONTEMPORARY FACILITIES  
BATOCHÉ NATIONAL HISTORIC SITE  
BATOCHÉ SASKATCHEWAN

drawing title / titre du dessin

SEWAGE TREATMENT TANK

designed by / conception par DKK.	approved by / approuvé par
drawn by / tracé par WAH.	date / date
checked by / vérifié par	scale / échelle AS SHOWN

project asset number / numéro du projet d'immobilisation	
--	--

HPBA 84/R4/E

### S 5.1

[illegible]

B.O.

[illegible]