




COMBUSTION AIR SUPPLY

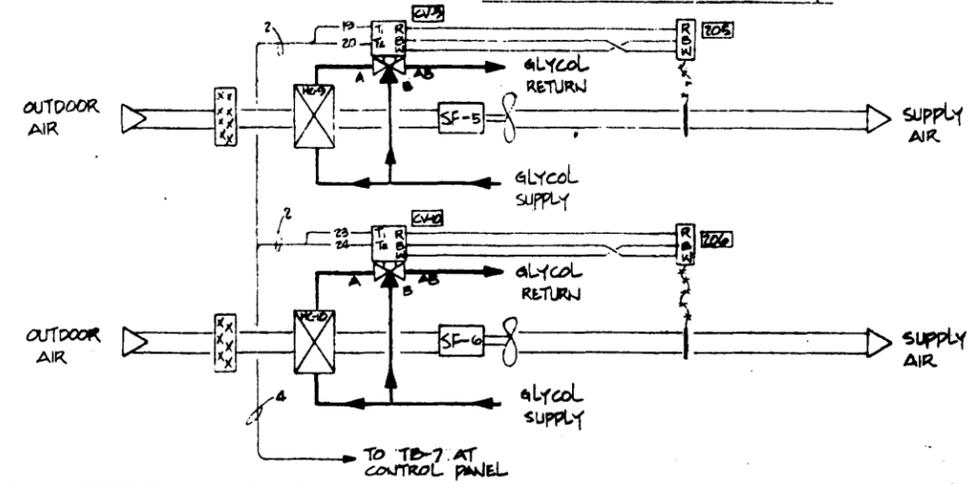


ENGINE ROOM VENTILATION

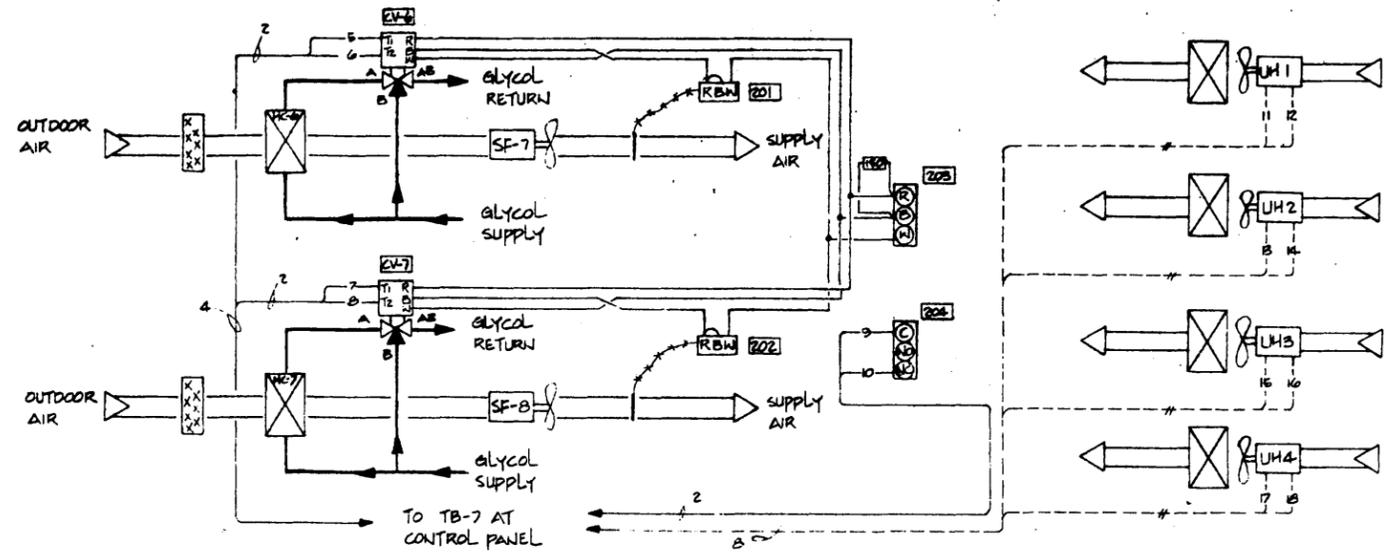

PANEL #2

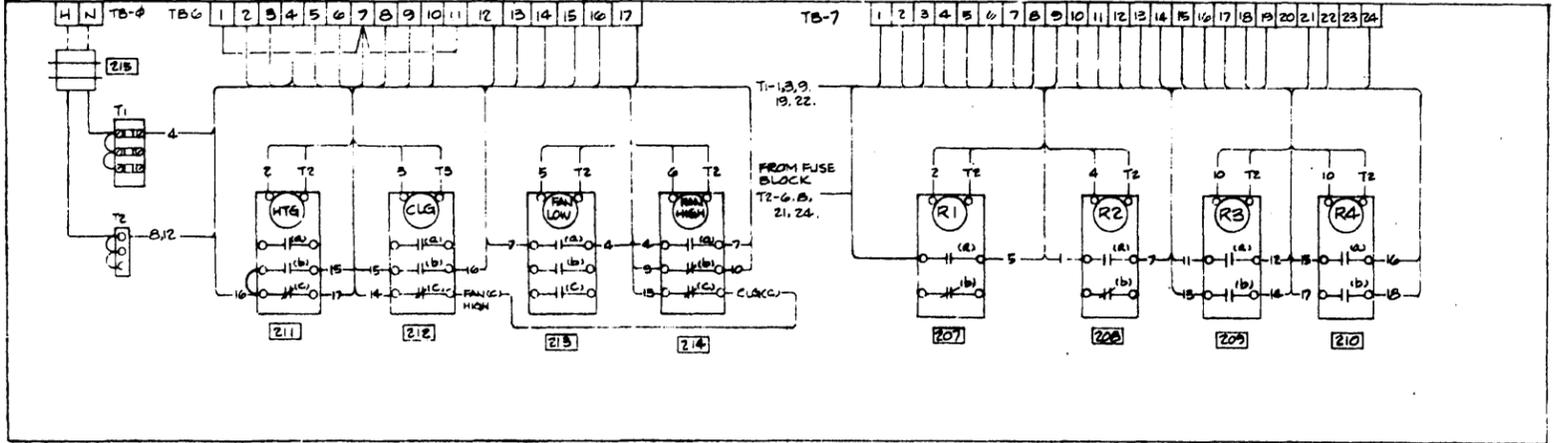

WIRING DETAIL

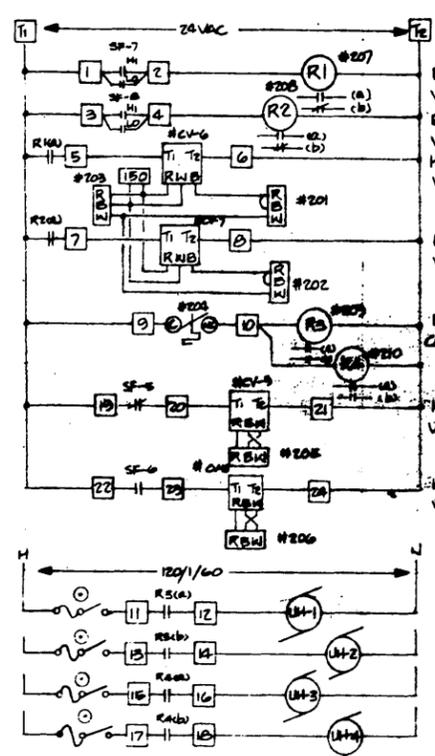

BILL OF MATERIALS

ITEM	QTY	OS. NUMBER	DESCRIPTION
CV-6 AC-7	2	VE05B1003	2 1/2" FLG. 3-W VALVE CV6S
C/W	2	661BA1032	LINKAGE
C/W	2	M958CA000	MODULATING MOTOR SPE. RTN.
CV-6 CV-10	2	VE05B1007	1 1/2" LPT. 3-W VALVE CV6
C/W	2	661BA1032	LINKAGE
C/W	2	M958CA000	MODULATING MOTOR SPE. RTN.
201A102	2	T991A1707	DISCHARGE CONTROLLER
C/W	2	B124A10	BULB HOLDER
205	1	T991A1814	SPACE THERMOSTAT
206	1	T991A1817	SPOT SPACE THERMOSTAT
207A102	2	T991A1707	DISCHARGE LIMIT CONTROLLER
207TO214	2	L124A102	TPOT RELAY
215	1	8206	2 1/2" X 1 1/2" X 1 1/2" X 1 1/2"

<p>Drawn: R. SABORIO</p> <p>Checked: G. FOMBI</p> <p>Date: 26 NOV 64</p>	<p>Approved: N.T.S.</p> <p>Approved: G. FOMBI</p>	<p>Company: Honeywell</p> <p>Part No: C.C.G. TYPE 1050 NAVARIS VESSEL</p> <p>Part No: 51-0784-D-C-3/8 D</p>
--	---	---

D	AS BUILT	2/6/65	R.S.
C	NEW HSD FOR CORN	1/30/65	R.S.
B	REVISE FAN WBS	1/16/65	R.S.
A	ISS'D FOR APPR.	1/15/65	R.S.