




## **Appendix F**

### **Existing Tower Details**

LEG SIZE	152 x 152 x 19mm L			A	B	C	B	
DIAGONAL SIZE	51 x 51 x 8mm L			E	F	E	G	H
HORIZONTAL SIZE	51 x 51 x 8mm L			E	F	E	G	H
MODEL #	MTG36KD							
SECTION NUMBER	1	2	3	4	5	6	7	8
COLOUR	ORANGE	WHITE	ORANGE	WHITE	ORANGE	WHITE	ORANGE	

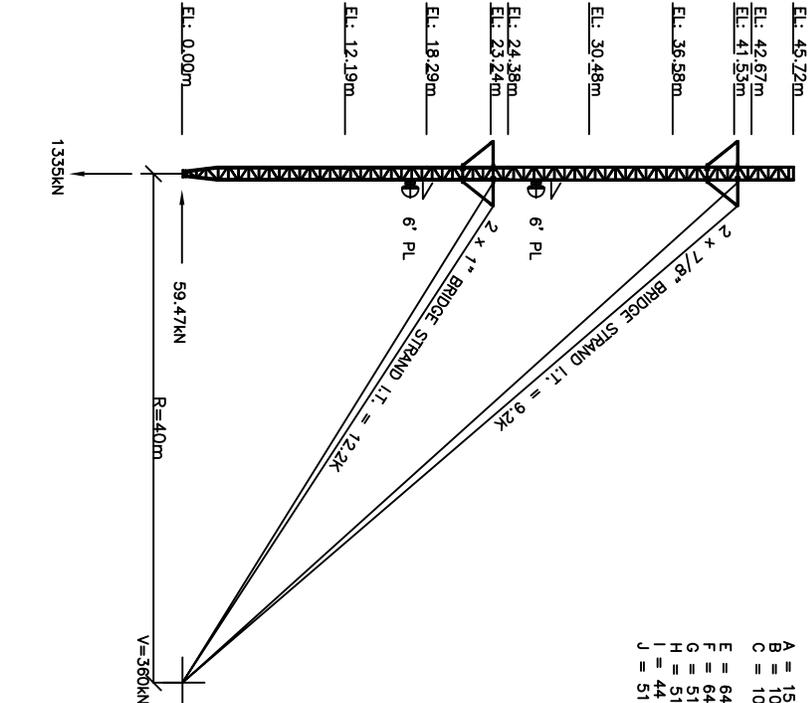

- A = 152 x 152 x 19mm L
- B = 102 x 102 x 13mm L
- C = 102 x 102 x 16mm L
- E = 64 x 64 x 6mm L
- F = 64 x 64 x 10mm L
- G = 51 x 51 x 6mm L
- H = 51 x 51 x 8mm L
- I = 44 x 44 x 5mm L
- J = 51 x 51 x 5mm L

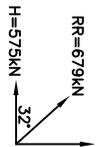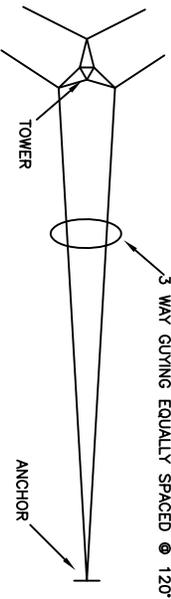

NOTE: LOADS SHOWN ARE ACTUAL  
LOADS, NOT FACTORED

FOR ANCHOR DROPS REFER TO  
PLOT PLAN PFC061

AS BUILT JULY 2002

<p>Fisheries and Oceans Coast Guard</p> <p>Pêches et Océans Garde côtière</p>	drawing title—dessin titre		TOWER PROFILE FOR 45.72m MTG361KD TOWER M2007 - 1/4	drawing no.—no du dessin 01N0501000501	sheet—feuille 1/25
	date—date 03/04/02	scale—échelle NTS			
CANADIAN COAST GUARD PEARCE PEAK, N.F.L.D.		draw—dessin R. DERKS		checked—vérifié approved for tender—approuvé pour l'offre	