

Project North

GENERAL NOTES:

1. PROVIDE SOUND MASKING THROUGHOUT AREA OF WORK, REFER TO SPECIFICATIONS. INDICATE LOCATIONS ON AS-BUILT DRAWINGS. CONFIRM ACTUAL POWER REQUIREMENTS WITH SOUNDMASKING VENDOR, PROVIDE CIRCUITS TO SUIT IN LOCAL ELECTRICAL PANEL WHICH SERVES THE AREA.


DRAWING NOTES:

- ① INSTALL DEVICE WITHIN MILLWORK.
- ② CONNECT EXHAUST FAN TO LOCAL CO2 SENSOR. COORDINATE WITH MECHANICAL CONTRACTOR.

REVISE DRAWING NOTES

[illegible][illegible]

Contractor to verify all dimensions & conditions on site and immediately notify the engineer of all discrepancies.

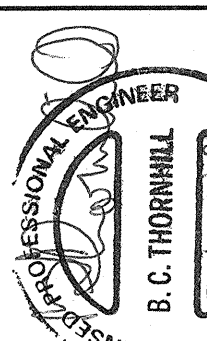


project project
Generic Swing Space
at LEL West Tower

300 Laurier West, Ottawa, ON

ELECTRICAL:
21ST FLOOR - POWER AND
SYSTEMS

Designed by C.J.	Drawn By C.J.	Date 2019-02-09	Reviewed By B.T.	Date 2019-02-09	Approved By B.T.	Date 2019-02-09	Conçu par (aaaa/mm/aa)	Dessiné par (aaaa/mm/aa)	Date (aaaa/mm/aa)	Examiné par (aaaa/mm/aa)	Date (aaaa/mm/aa)	Approuvé par (aaaa/mm/aa)	Date (aaaa/mm/aa)	Submitted Soumission	Project Manager Administrateur des projets	Project no. N° du projet	Drawing no. N° du dessin
R.088901.013																	

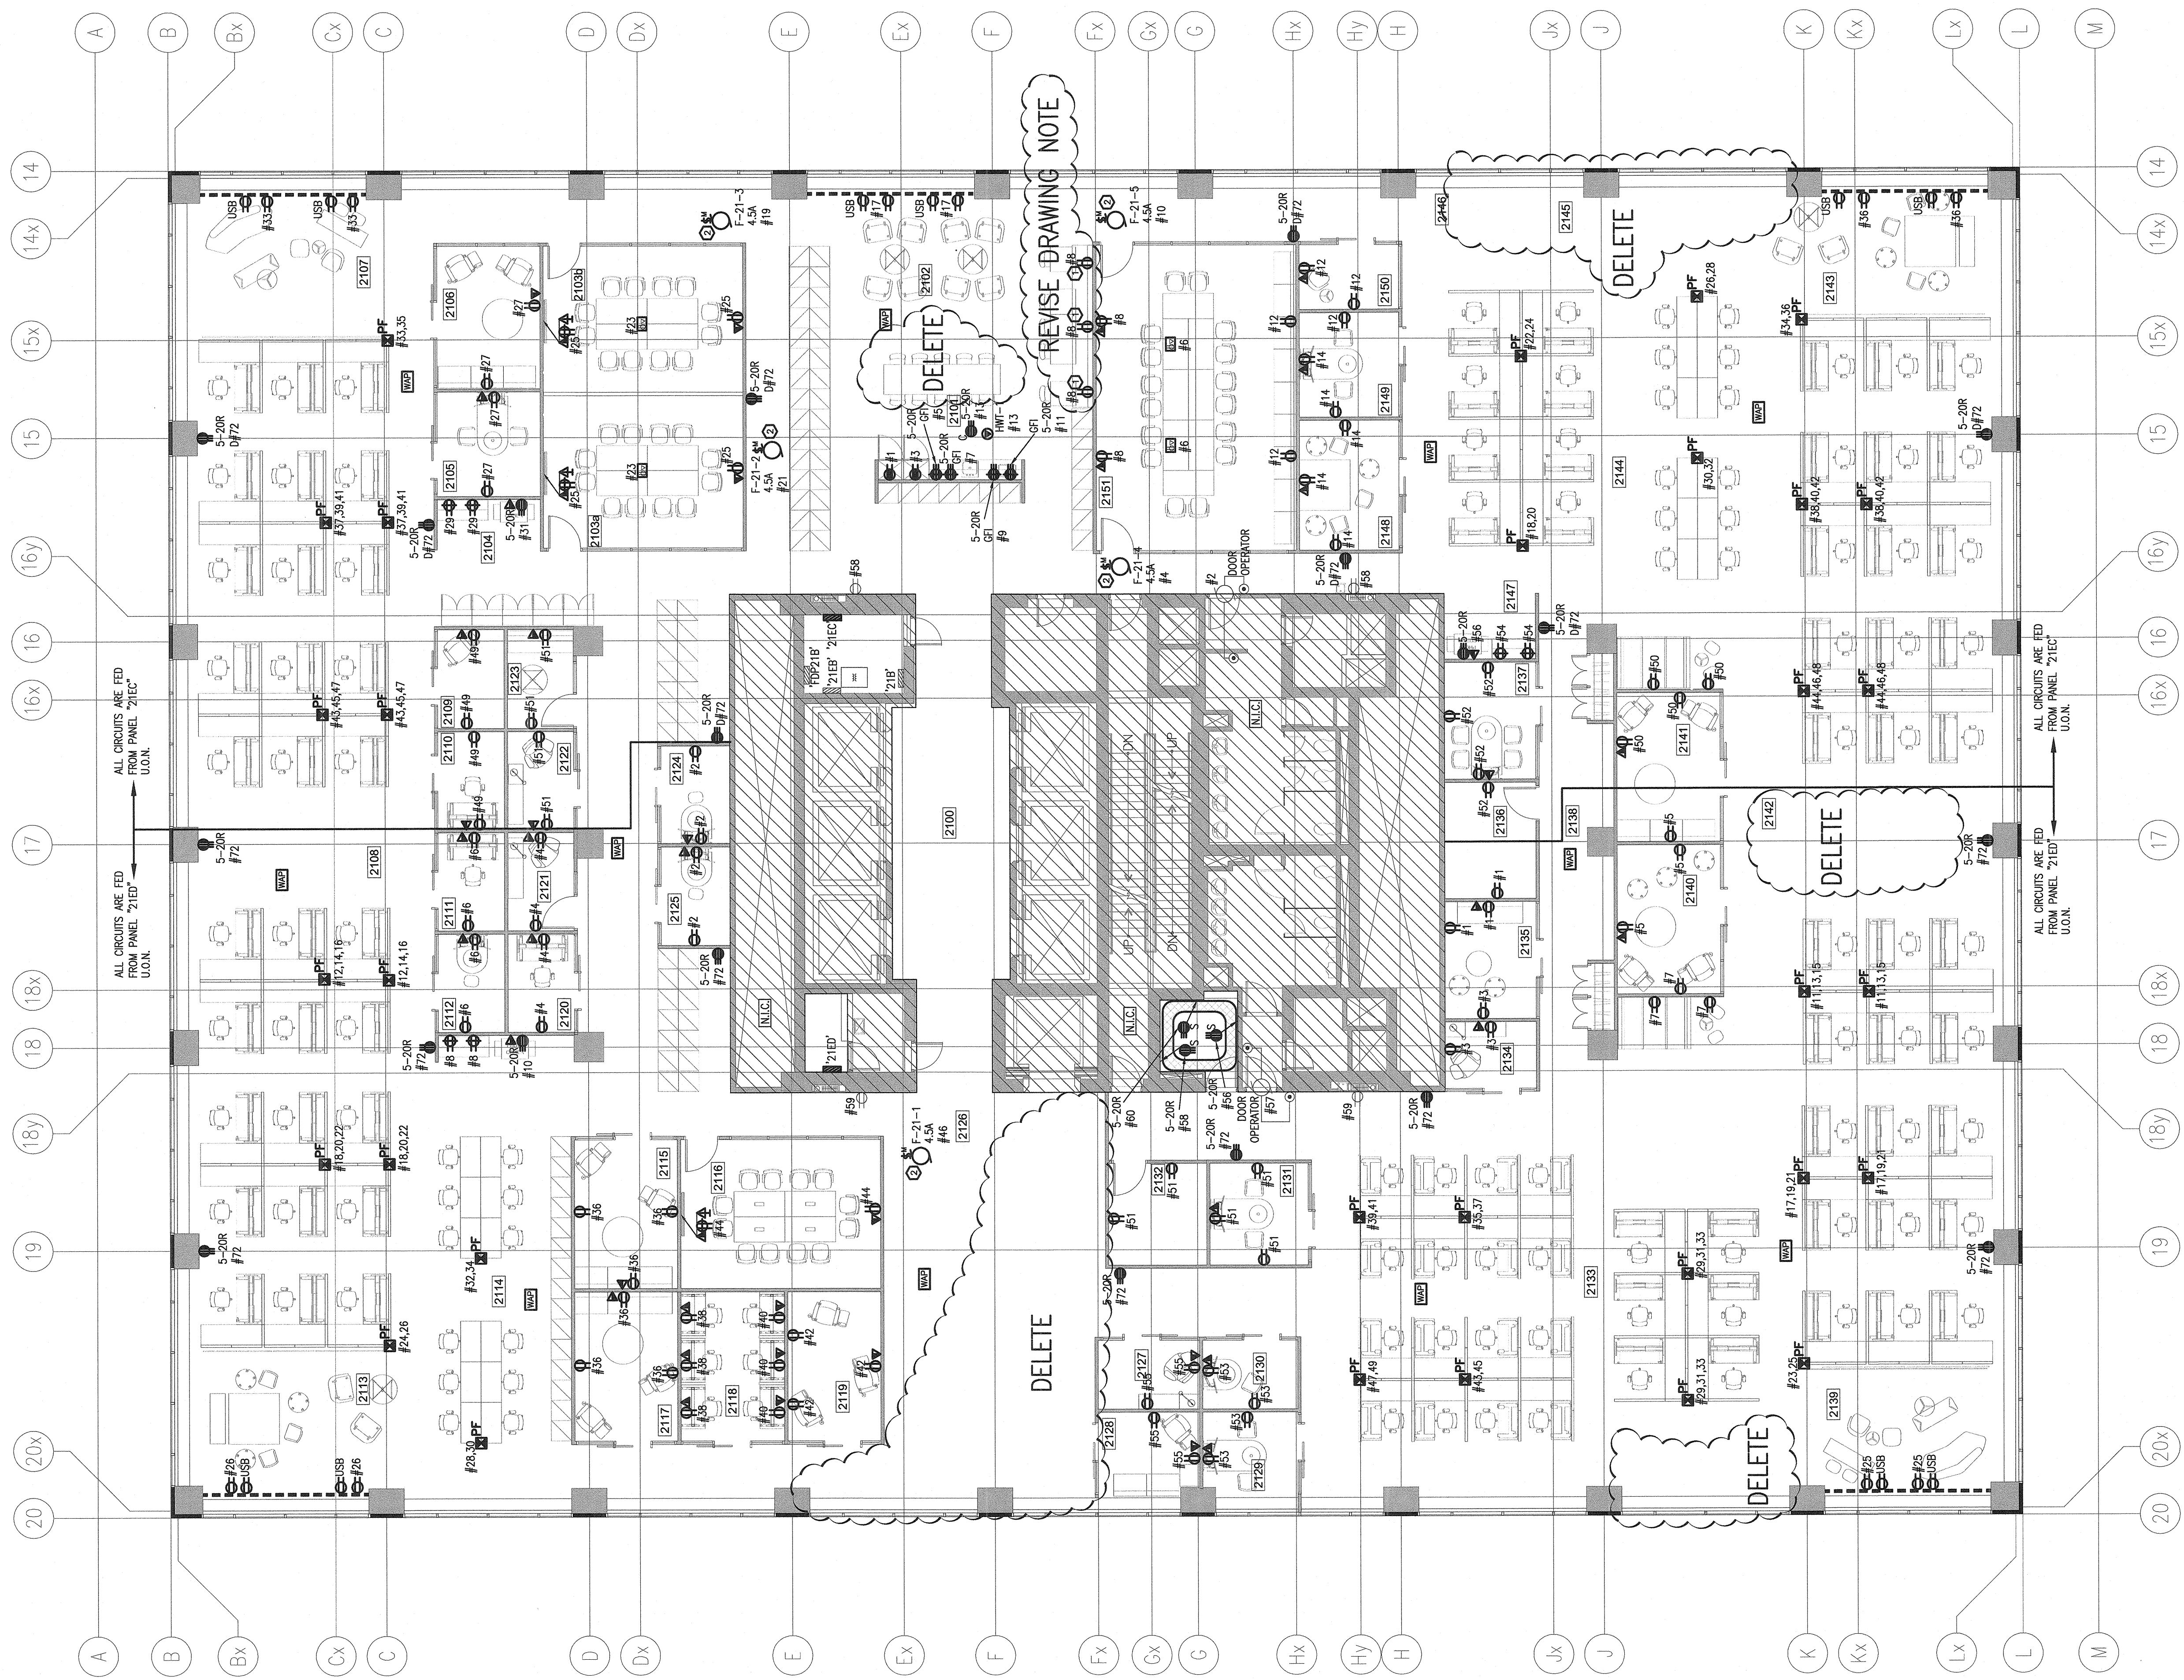

1 21ST FLOOR – POWER AND SYSTEMS

9-