


THIS DRAWING FURNISHED FOR ENGINEERING INFORMATION AND REFERENCE ONLY AND DOES NOT CONVEY ANY REPRODUCTION OR MANUFACTURING RIGHT

NOTES: 1. DO NOT SCALE THIS PRINT
 2. BREAK SHARP CORNERS
 3. TOLERANCE ON DIMENSIONS NOT OTHERWISE SPECIFIED

DECIMAL
 FRACTIONAL $\pm \frac{1}{32}$
 ANGULAR

NOTE: -

STAMP SERIAL NO. ADJACENT TO PORT

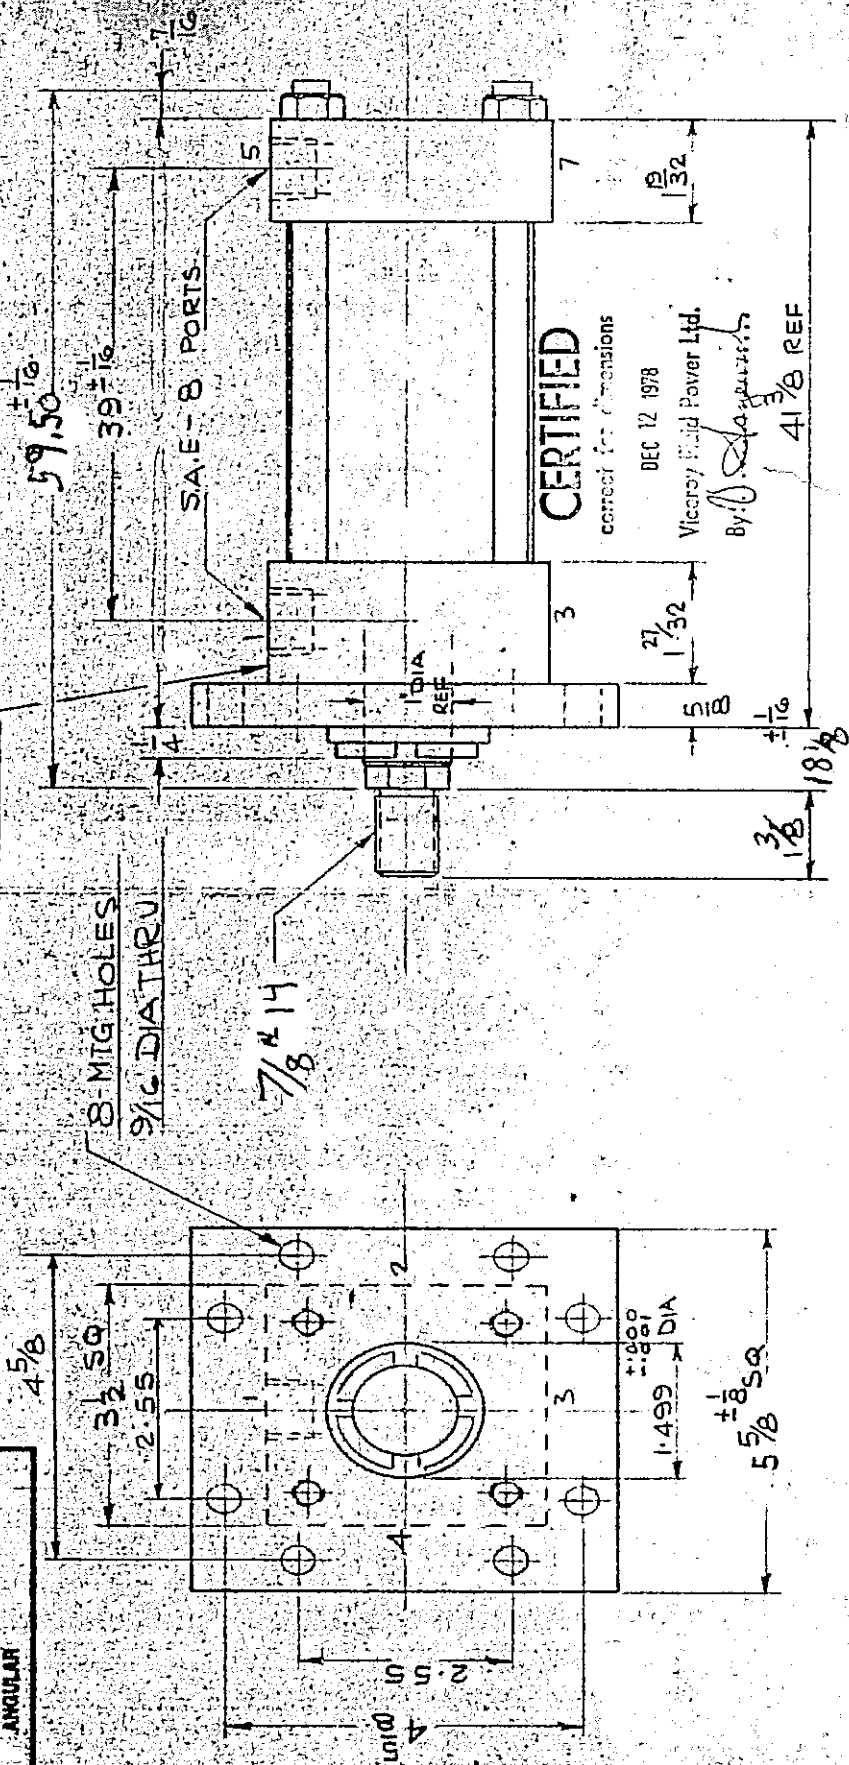

CUSTOMER: JOHN-T. HEPBURN (4915-9-G1729) V.F.P.L. NO. 26575
 MODEL NO.: 2 1/2-2TH 8B 36CC AKY BORE: 2 1/2" STROKE: 3 5/8" ROD: 1" DIA
 PRESSURE: 2500 PSI TEMP: 200°F MAX. MEDIUM: HYD-OIL
 PORTS: 1 & 5 ADJUSTING SCR 2 & 6 BALL CHECK 4 & 8

DEC 12 1978

"TRIPLE SLING"	
VICEROY CYLINDER	
2TH SERIES	
2 1/2 BORE	
DR. BY A.G.	DATE 3 MAY 77
VICEROY FLUID POWER LIMITED	
RESIDALE	ONTARIO CANADA
SCALE N.T.S.	DWG. NO. S-4409

2	7 APR 78	AS BUILT
Δ	July 7/77	CERTIFIED FOR MANUFACTURE
ISSUE	DATE	DESCRIPTION

STAINLESS STL CHROME PLATED ROD
 AND 1 3/4" EXTENSION