

NOTES:

1. PIPING SHOWN IS BASED ON GENERIC SUPPLIER INFORMATION OR IS INDICATIVE OF THE SIZE REQUIRED TO MEET THE SPECIFIED PERFORMANCE - SHIPYARD TO ADJUST TO SUIT FINAL EQUIPMENT.

NOTES:

1. LA TUYAUTERIE ILLUSTRÉE EST BASÉE DE L'INFORMATION GÉNÉRIQUE DU FOURNISSEUR OU EST INDICATIVE DES DIMENSIONS REQUISES AFIN D'ATTEINDRE LE RENDEMENT SPÉCIFIÉ. LE CHANTIER NAVAL DEVRA AUSTER LE PLAN D'APRÈS L'ÉQUIPEMENT SÉLECTIONNÉ.


©CE PLAN EST BASÉ SUR LE PLAN NO. 209-028. IL A ÉTÉ DÉVELOPPÉ UNIQUEMENT PAR MERIDIEN MARITIME À DES FINS DE PRODUCTION AVEC LA PERMISSION ÉCRITE DE ROBERT ALLAN LTÉE. ROBERT ALLAN LTÉE N'ASSUME AUCUNE RESPONSABILITÉ QUELLE QU'ELLE SOIT POUR CE PLAN MODIFIÉ. LA PROPRIÉTÉ INTELLECTUELLE DU PLAN CI-DÉCRIT APPARTIENT UNIQUEMENT À ROBERT ALLAN LTÉE ET AU CANADA. IL EST DÉFENDU DE REPRODUIRE LES PLANS ET LES DEVIS, CI-INCLUS, EN ENTIER OU EN PARTIE, OU DE LES PARTAGER AVEC UN TIERS SANS LA PERMISSION ÉCRITE DES PROPRIÉTAIRES.




COMPANY :
MÉRIDIEN MARITIME
RÉPARATION


TITLE :
SEA WATER SERVICE
CROSS CONNECTION

© THIS DRAWING IS BASED ON ROBERT ALLAN LTD. DESIGN NO. 209-028 AND HAS BEEN DEVELOPED BY MERIDIEN MARITIME FOR PRODUCTION PURPOSES ONLY, WITH THE WRITTEN CONSENT OF ROBERT ALLAN LTD. ROBERT ALLAN LTD. ASSUME NO RESPONSIBILITY WHATSOEVER FOR THIS ALTERED DRAWING. THE INTELLECTUAL PROPERTY RIGHTS TO THE DESIGN DESCRIBED HEREIN BELONG EXCLUSIVELY TO ROBERT ALLAN LTD. AND CANADA. THE DRAWINGS AND SPECIFICATIONS CONTAINED HEREIN SHALL NOT BE REPRODUCED IN WHOLE OR IN PART, NOR SHALL THEY BE GIVEN TO ANY THIRD PARTIES WITHOUT WRITTEN PERMISSION FROM THE OWNERS (POUR LA TRADUCTION FRANÇAISE, VOIR LA PREMIÈRE PAGE)

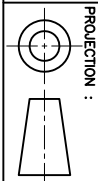


5	AS CONSTRUCTED	MV	JUNE 2012
4	MODIF DIAMETER OF THE 2 COOLING LINES FOR STEERING GEAR & STERN TUBE. PORT & STBD. FROM DN20 TO DN32	AD	OCT. 2010
3	ADD 2 COOLING LINES (DN20) FOR STEERING GEAR & STERN TUBE. PORT & STBD	AD	AUGUST 2010
REV.	REVISIONS	BY	DATE
<div><div>PROJECT TITLE : Garde côtière canadienne Canadian Coast Guard</div></div>			
NAVIRE 22M VESSEL COQUE # / HULL # 009-010			

PROJECT # : MR09-1113	DRAWING FILE : ISV22-7351DRMMS.dwg	DATE : JUNE 2012
DRAWN BY : MV	DRAWING # : 73510	REV : 5
		SHEET : 1 OF 2

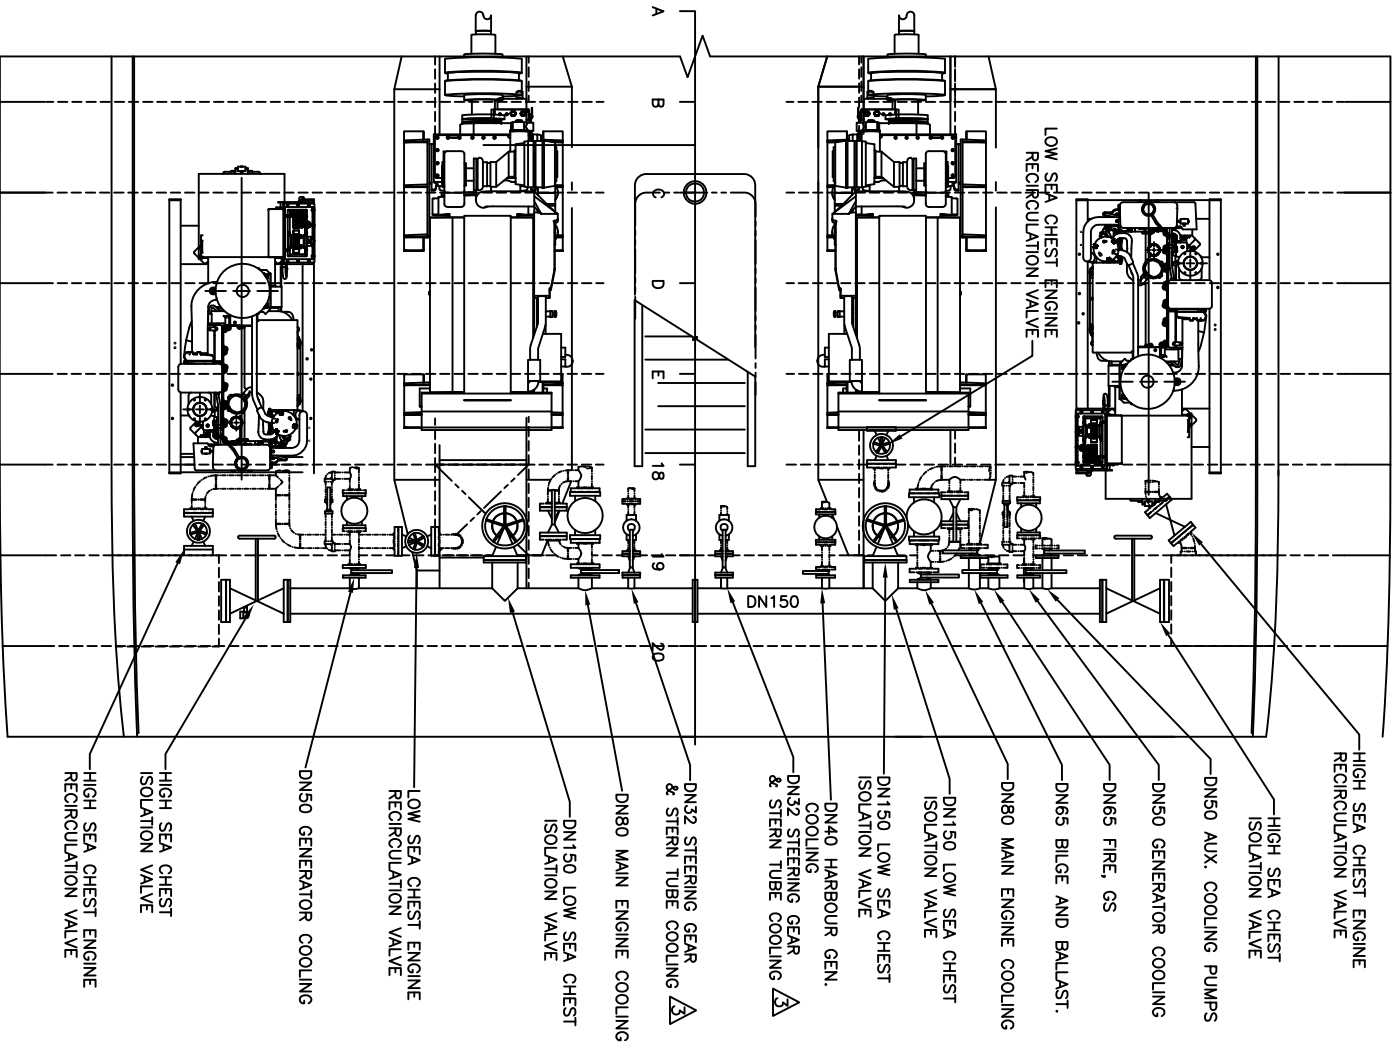

PARTIAL PLAN

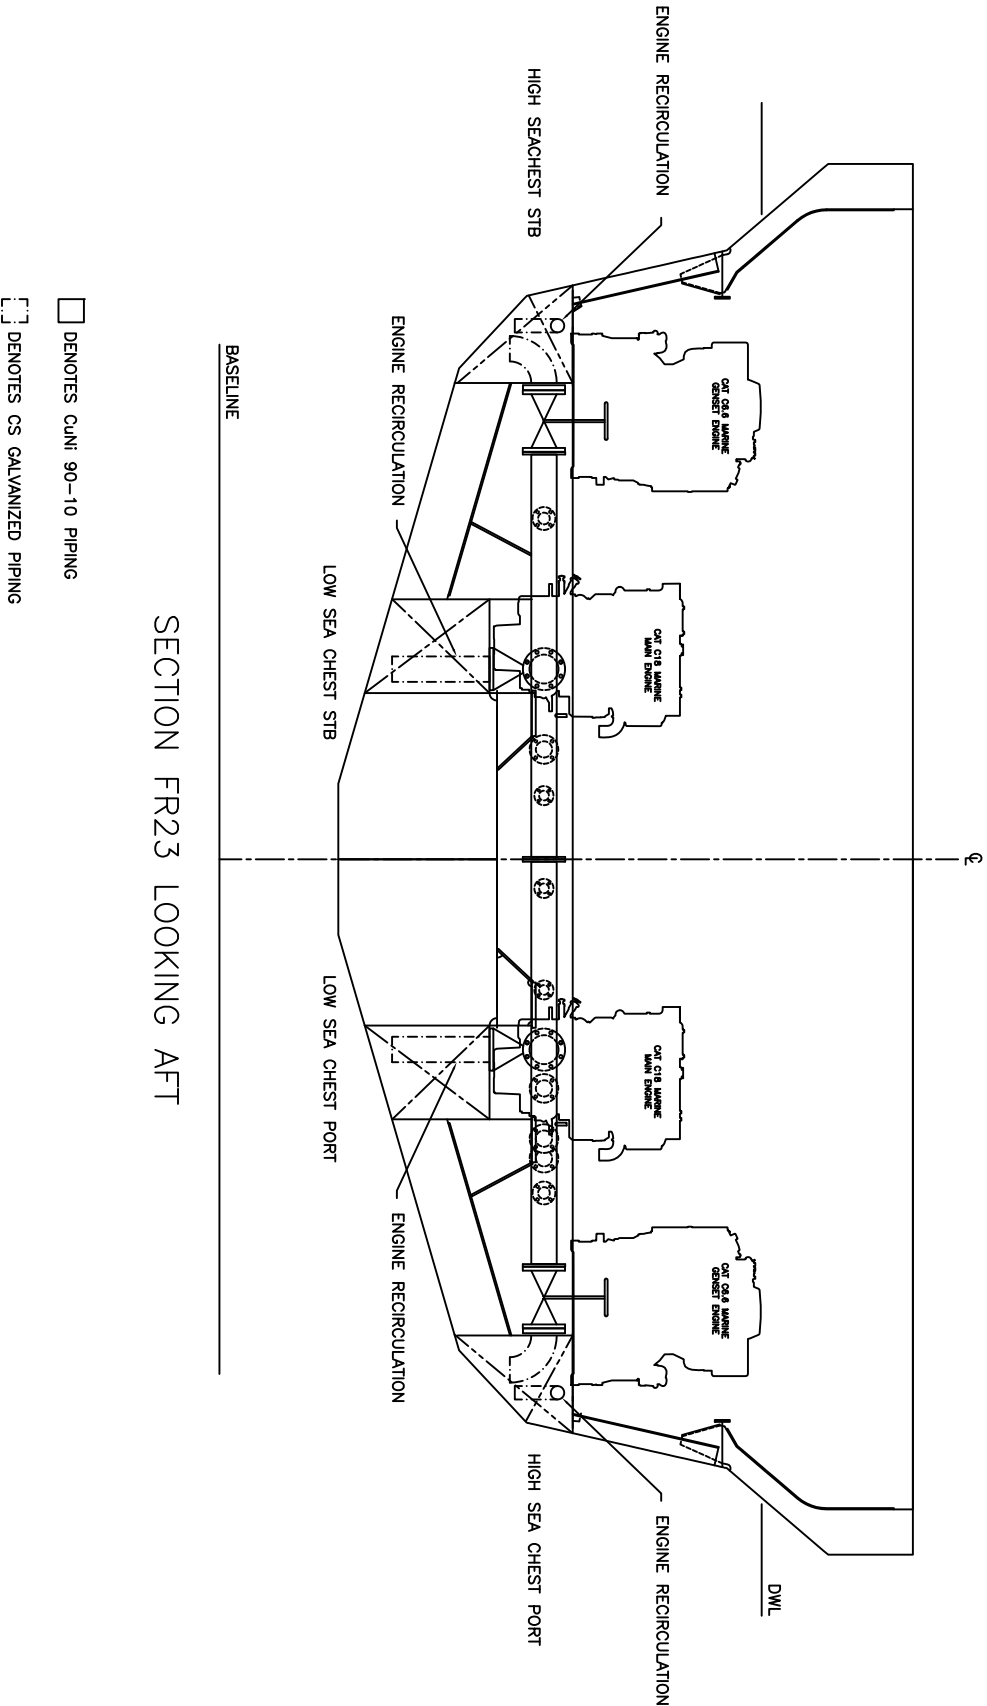


SECTION FR23 LOOKING AFT



COMPANY :
MÉRIDIEN MARITIME
RÉPARATION

TITLE :
SEA WATER SERVICE
CROSS CONNECTION

© THIS DRAWING IS BASED ON ROBERT ALAIN LTD. DESIGN NO. 209-028 AND HAS BEEN DEVELOPED BY MÉRIDIEN MARITIME FOR PRODUCTION PURPOSES ONLY, WITH THE WRITTEN CONSENT OF ROBERT ALAIN LTD. ROBERT ALAIN LTD. ASSUME NO RESPONSIBILITY WHATSOEVER FOR THIS ALTERED DRAWING. THE INTELLECTUAL PROPERTY RIGHTS TO THE DESIGN DESCRIBED HEREIN BELONG EXCLUSIVELY TO ROBERT ALAIN LTD. AND CANADA. THE DRAWINGS AND SPECIFICATIONS CONTAINED HEREIN SHALL NOT BE REPRODUCED IN WHOLE OR IN PART, NOR SHALL THEY BE GIVEN TO ANY THIRD PARTIES WITHOUT WRITTEN PERMISSION FROM THE OWNERS. (POUR LA TRADUCTION FRANÇAISE, VOIR LA PREMIÈRE PAGE)

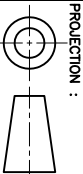

PROJECT # :
MR09-1113
DRAWN BY :
MV

DRAWING FILE :
ISV22-73510RMM+.dwg
DRAWING # :
73510
REV :
5

DATE :
JUNE 2012
SHEET :
2 OF 2



Garde côtière canadienne
Canadian Coast Guard

PROJECT TITLE :
Navire semi-hauturier de recherche halieutique
Near Shore Fisheries Research Vessels