

NOTES:

1. PIPING SHOWN IS BASED ON GENERIC SUPPLIER INFORMATION OR IS INDICATIVE OF THE SIZE REQUIRED TO MEET THE SPECIFIED PERFORMANCE – SHIPYARD TO ADJUST TO SUIT FINAL EQUIPMENT.

NOTES:

1. LA TUYAUTERIE ILLUSTRÉE EST BASÉE DE L'INFORMATION GÉNÉRIQUE DU FOURNISSEUR OU EST INDICATIVE DES DIMENSIONS REQUISES AFIN D'ATTEINDRE LE RENDEMENT SPÉCIFIÉ. LE CHANTIER NAVAL DEVRA AJUSTER LE PLAN D'APRÈS L'ÉQUIPEMENT SÉLECTIONNÉ.


© CE PLAN EST BASÉ SUR LE PLAN NO. 209-028. IL A ÉTÉ DÉVELOPPÉ UNIQUEMENT PAR MERIDIEN MARITIME À DES FINS DE PRODUCTION AVEC LA PERMISSION ÉCRITE DE ROBERT ALLAN LTÉE. ROBERT ALLAN LTÉE N'ASSUME AUCUNE RESPONSABILITÉ QUELLE QU'ELLE SOIT POUR CE PLAN MODIFIÉ. LA PROPRIÉTÉ INTELLECTUELLE DU PLAN CI-DÉCRIT APPARTIENT UNIQUEMENT À ROBERT ALLAN LTÉE ET AU CANADA. IL EST DÉFENDU DE REPRODUIRE LES PLANS ET LES DEVIS, CI-INCLUS, EN ENTIER OU EN PARTIE, OU DE LES PARTAGER AVEC UN TIERS SANS LA PERMISSION ÉCRITE DES PROPRIÉTAIRES.





COMPANY :
MÉRIDIEN MARITIME
RÉPARATION


TITLE :
SEA WATER SERVICE CROSS
CONNECTION ARRANGEMENT

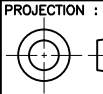© THIS DRAWING IS BASED ON ROBERT ALLAN Ltd. DESIGN NO. 209-028 AND HAS BEEN DEVELOPED BY MERIDIEN MARITIME FOR PRODUCTION PURPOSES ONLY, WITH THE WRITTEN CONSENT OF ROBERT ALLAN LTD. ROBERT ALLAN LTD ASSUME NO RESPONSIBILITY WHATSOEVER FOR THIS ALTERED DRAWING. THE INTELLECTUAL PROPERTY RIGHTS TO THE DESIGN DESCRIBED HEREIN BELONG EXCLUSIVELY TO ROBERT ALLAN LTD. AND CANADA. THE DRAWINGS AND SPECIFICATIONS CONTAINED HEREIN SHALL NOT BE REPRODUCED IN WHOLE OR IN PART, NOR SHALL THEY BE GIVEN TO ANY THIRD PARTIES WITHOUT WRITTEN PERMISSION FROM THE OWNERS (POUR LA TRADUCTION FRANCAISE, VOIR LA PREMIÈRE PAGE)





PROJECTION :

| | | | |
|---|---------------------|--|----------|
| 3 | AS CONSTRUCTED | MM | DEC 2010 |
| REV. | REVISIONS | BY | DATE |
|  | | Garde côtière canadienne Canadian Coast Guard | |
| NAVIRE 25M VESSEL COQUE # / HULL # 008 | | PROJECT TITLE : Navire semi-hauturier de recherche halieutique Near Shore Fisheries Research Vessels | |
| PROJECT # : | DRAWING FILE : | DATE : | |
| MRO9-1113 | ISV25-73510RMM3.DWG | DEC 2010 | |
| DRAWN BY : | DRAWING # : | REV : | SHEET : |
| MV | 73510 |  3 | 1 OF 2 |

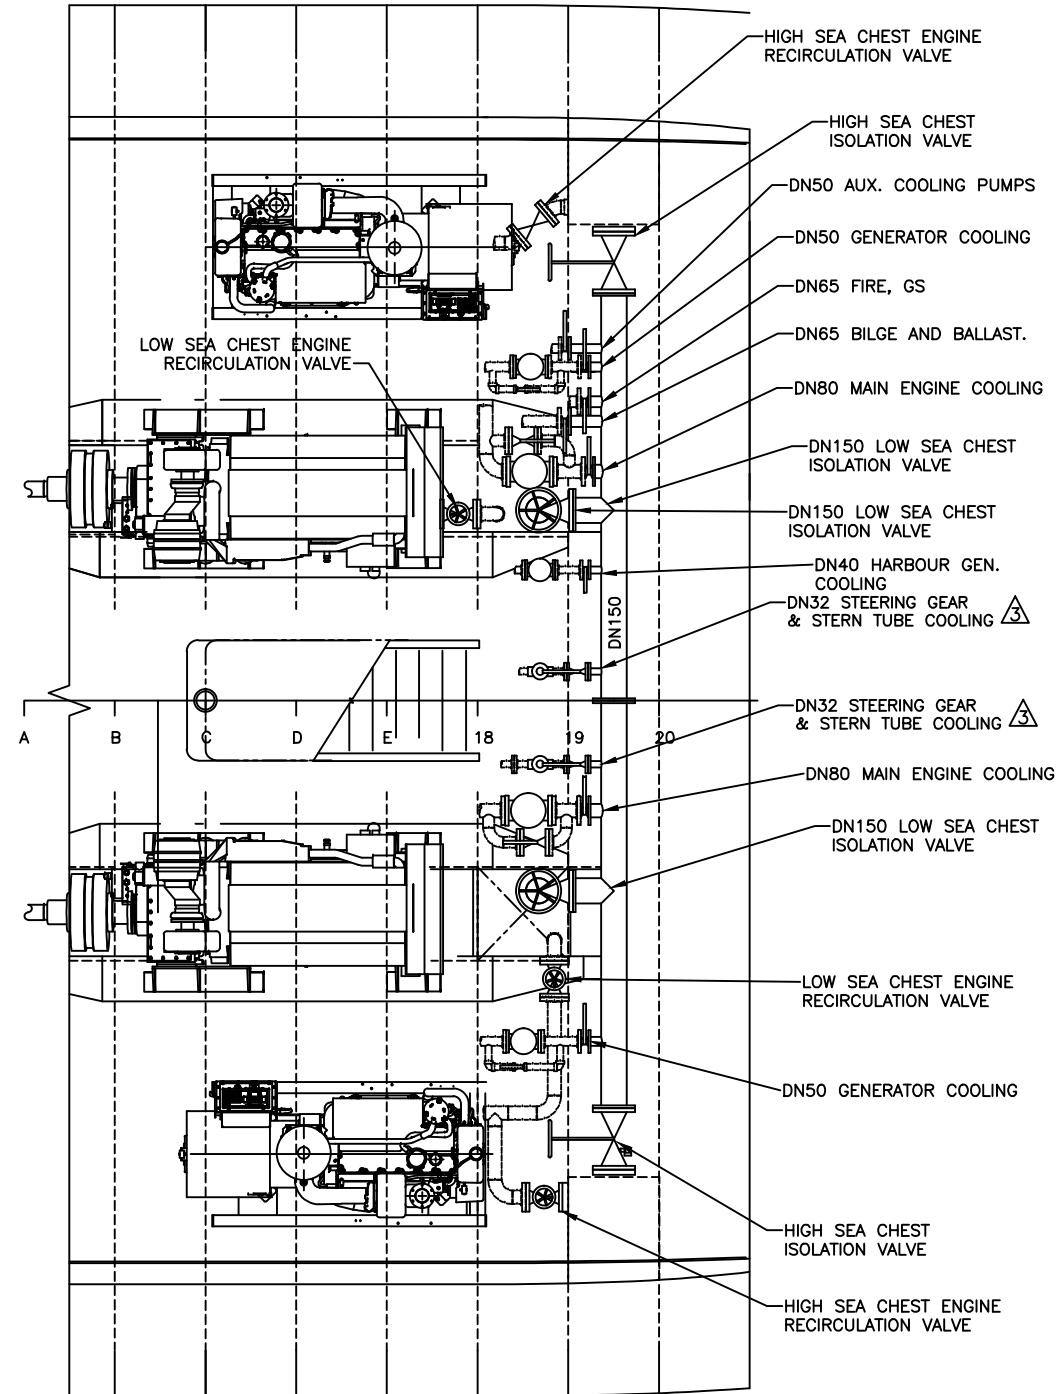

PARTIAL PLAN

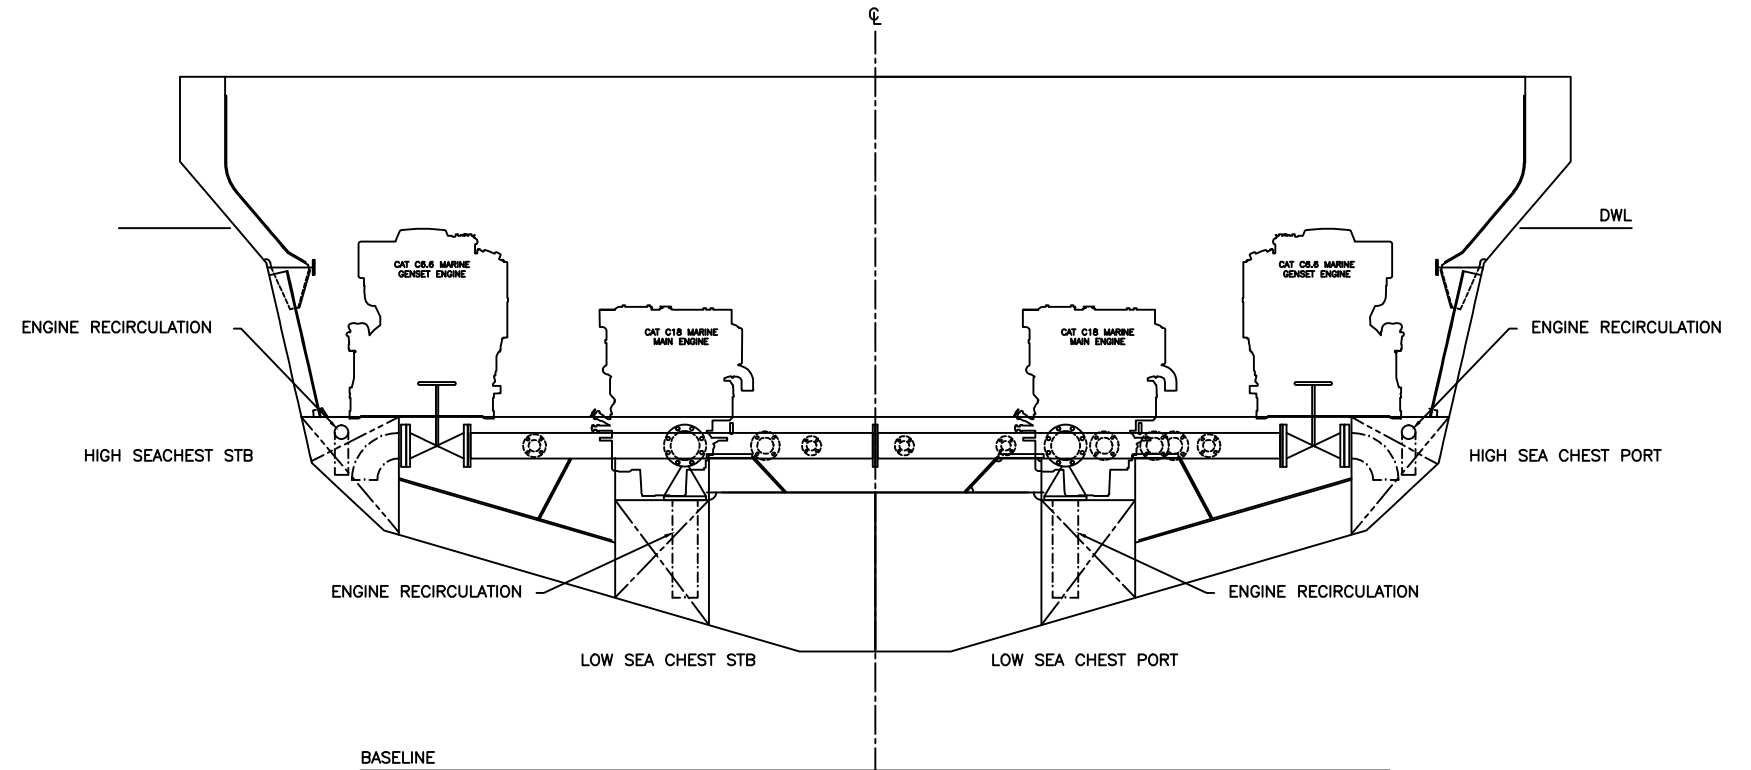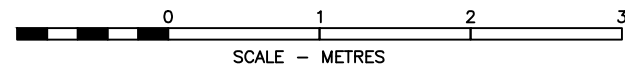

SECTION FR20 LOOKING AFT


- DENOTES CuNi 90-10 PIPING
 □ DENOTES CS GALVANIZED PIPING



COMPANY :
MÉRIDIEN MARITIME
RÉPARATION

TITLE :
**SEA WATER SERVICE CROSS
 CONNECTION ARRANGEMENT**

© THIS DRAWING IS BASED ON ROBERT ALLAN LTD. DESIGN NO. 209-028 AND HAS BEEN DEVELOPED BY MERIDIEN MARITIME FOR PRODUCTION PURPOSES ONLY, WITH THE WRITTEN CONSENT OF ROBERT ALLAN LTD. ROBERT ALLAN LTD ASSUME NO RESPONSIBILITY WHATSOEVER FOR THIS ALTERED DRAWING. THE INTELLECTUAL PROPERTY RIGHTS TO THE DESIGN DESCRIBED HEREIN BELONG EXCLUSIVELY TO ROBERT ALLAN LTD. AND CANADA. THE DRAWINGS AND SPECIFICATIONS CONTAINED HEREIN SHALL NOT BE REPRODUCED IN WHOLE OR IN PART, NOR SHALL THEY BE GIVEN TO ANY THIRD PARTIES WITHOUT WRITTEN PERMISSION FROM THE OWNERS (POUR LA TRADUCTION FRANCAISE, VOIR LA PREMIERE PAGE)

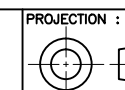

PROJECTION :

NAVIRE 25M VESSEL
 COQUE # / HULL #
 008

Garde côtière canadienne
 Canadian Coast Guard

PROJECT TITLE :
 Navire semi-hauturier de recherche halieutique
 Near Shore Fisheries Research Vessels

PROJECT # :
 MR09-1113

DRAWING FILE :
 ISV25-73510RMM3.DWG

DRAWN BY :
 MV

DATE :
 DEC 2010

SHEET :
 2 OF 2