



9	AS CONSTRUCTED	MM	JAN 2012
REV.	REVISIONS	BY	DATE
		Garde côtière canadienne Canadian Coast Guard	
NAVIRE 25M VESSEL COQUE # / HULL # 008		PROJECT TITLE : Navire semi-hauturier de recherche halieutique Near Shore Fisheries Research Vessels	
PROJECT # : MR09-1113	DRAWING FILE : ISV25-30000RMM9.DWG	DATE : 31/01/2012	
DRAWN BY :	DRAWING # : 30000	REV : 	SHEET : 1 OF 6

CE PLAN EST BASÉ SUR LE PLAN NO. 209-028. IL A ÉTÉ DÉVELOPPÉ UNIQUEMENT PAR MERIDIEN MARITIME À DES FINS DE PRODUCTION AVEC LA PERMISSION ÉCRITE DE ROBERT ALLAN LTÉE. ROBERT ALLAN LTÉE N'ASSUME AUCUNE RESPONSABILITÉ QUELLE QU'ELLE SOIT POUR CE PLAN MODIFIÉ. LA PROPRIÉTÉ INTELLECTUELLE DU PLAN CI-DÉCRIT APPARTIENT UNIQUEMENT À ROBERT ALLAN LTÉE ET AU CANADA. IL EST DÉFENDU DE REPRODUIRE LES PLANS ET LES DEVIS, CI-INCLUS, EN ENTIER OU EN PARTIE, OU DE LES PARTAGER AVEC UN TIERS SANS LA PERMISSION ÉCRITE DES PROPRIÉTAIRES.




COMPANY :

MÉRIDIEN MARITIME  
RÉPARATION

TITLE :


GENERAL ARRANGEMENT  
25M


© THIS DRAWING IS BASED ON ROBERT ALLAN Ltd. DESIGN NO. 209-028 AND HAS BEEN DEVELOPED BY MERIDIEN MARITIME FOR PRODUCTION PURPOSES ONLY, WITH THE WRITTEN CONSENT OF ROBERT ALLAN LTD. ROBERT ALLAN LTD ASSUME NO RESPONSIBILITY WHATSOEVER FOR THIS ALTERED DRAWING. THE INTELLECTUAL PROPERTY RIGHTS TO THE DESIGN DESCRIBED HEREIN BELONG EXCLUSIVELY TO ROBERT ALLAN LTD. AND CANADA. THE DRAWINGS AND SPECIFICATIONS CONTAINED HEREIN SHALL NOT BE REPRODUCED IN WHOLE OR IN PART, NOR SHALL THEY BE GIVEN TO ANY THIRD PARTIES WITHOUT WRITTEN PERMISSION FROM THE OWNERS (POUR LA TRADUCTION FRANCAISE, VOIR LA PREMIERE PAGE)

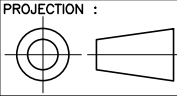

GENERAL PARTICULARS

LENGHT OVERALL	25.00 m
LENGHT DWL	23.50 m
BEAM, MOULDED	9.20 m
DEPTH, MOULDED	3.80 m
HULL DRAFT, NOMINAL	3.60 m
LIGHTSHIP WEIGHT	259,583 T
POWER	714 KW

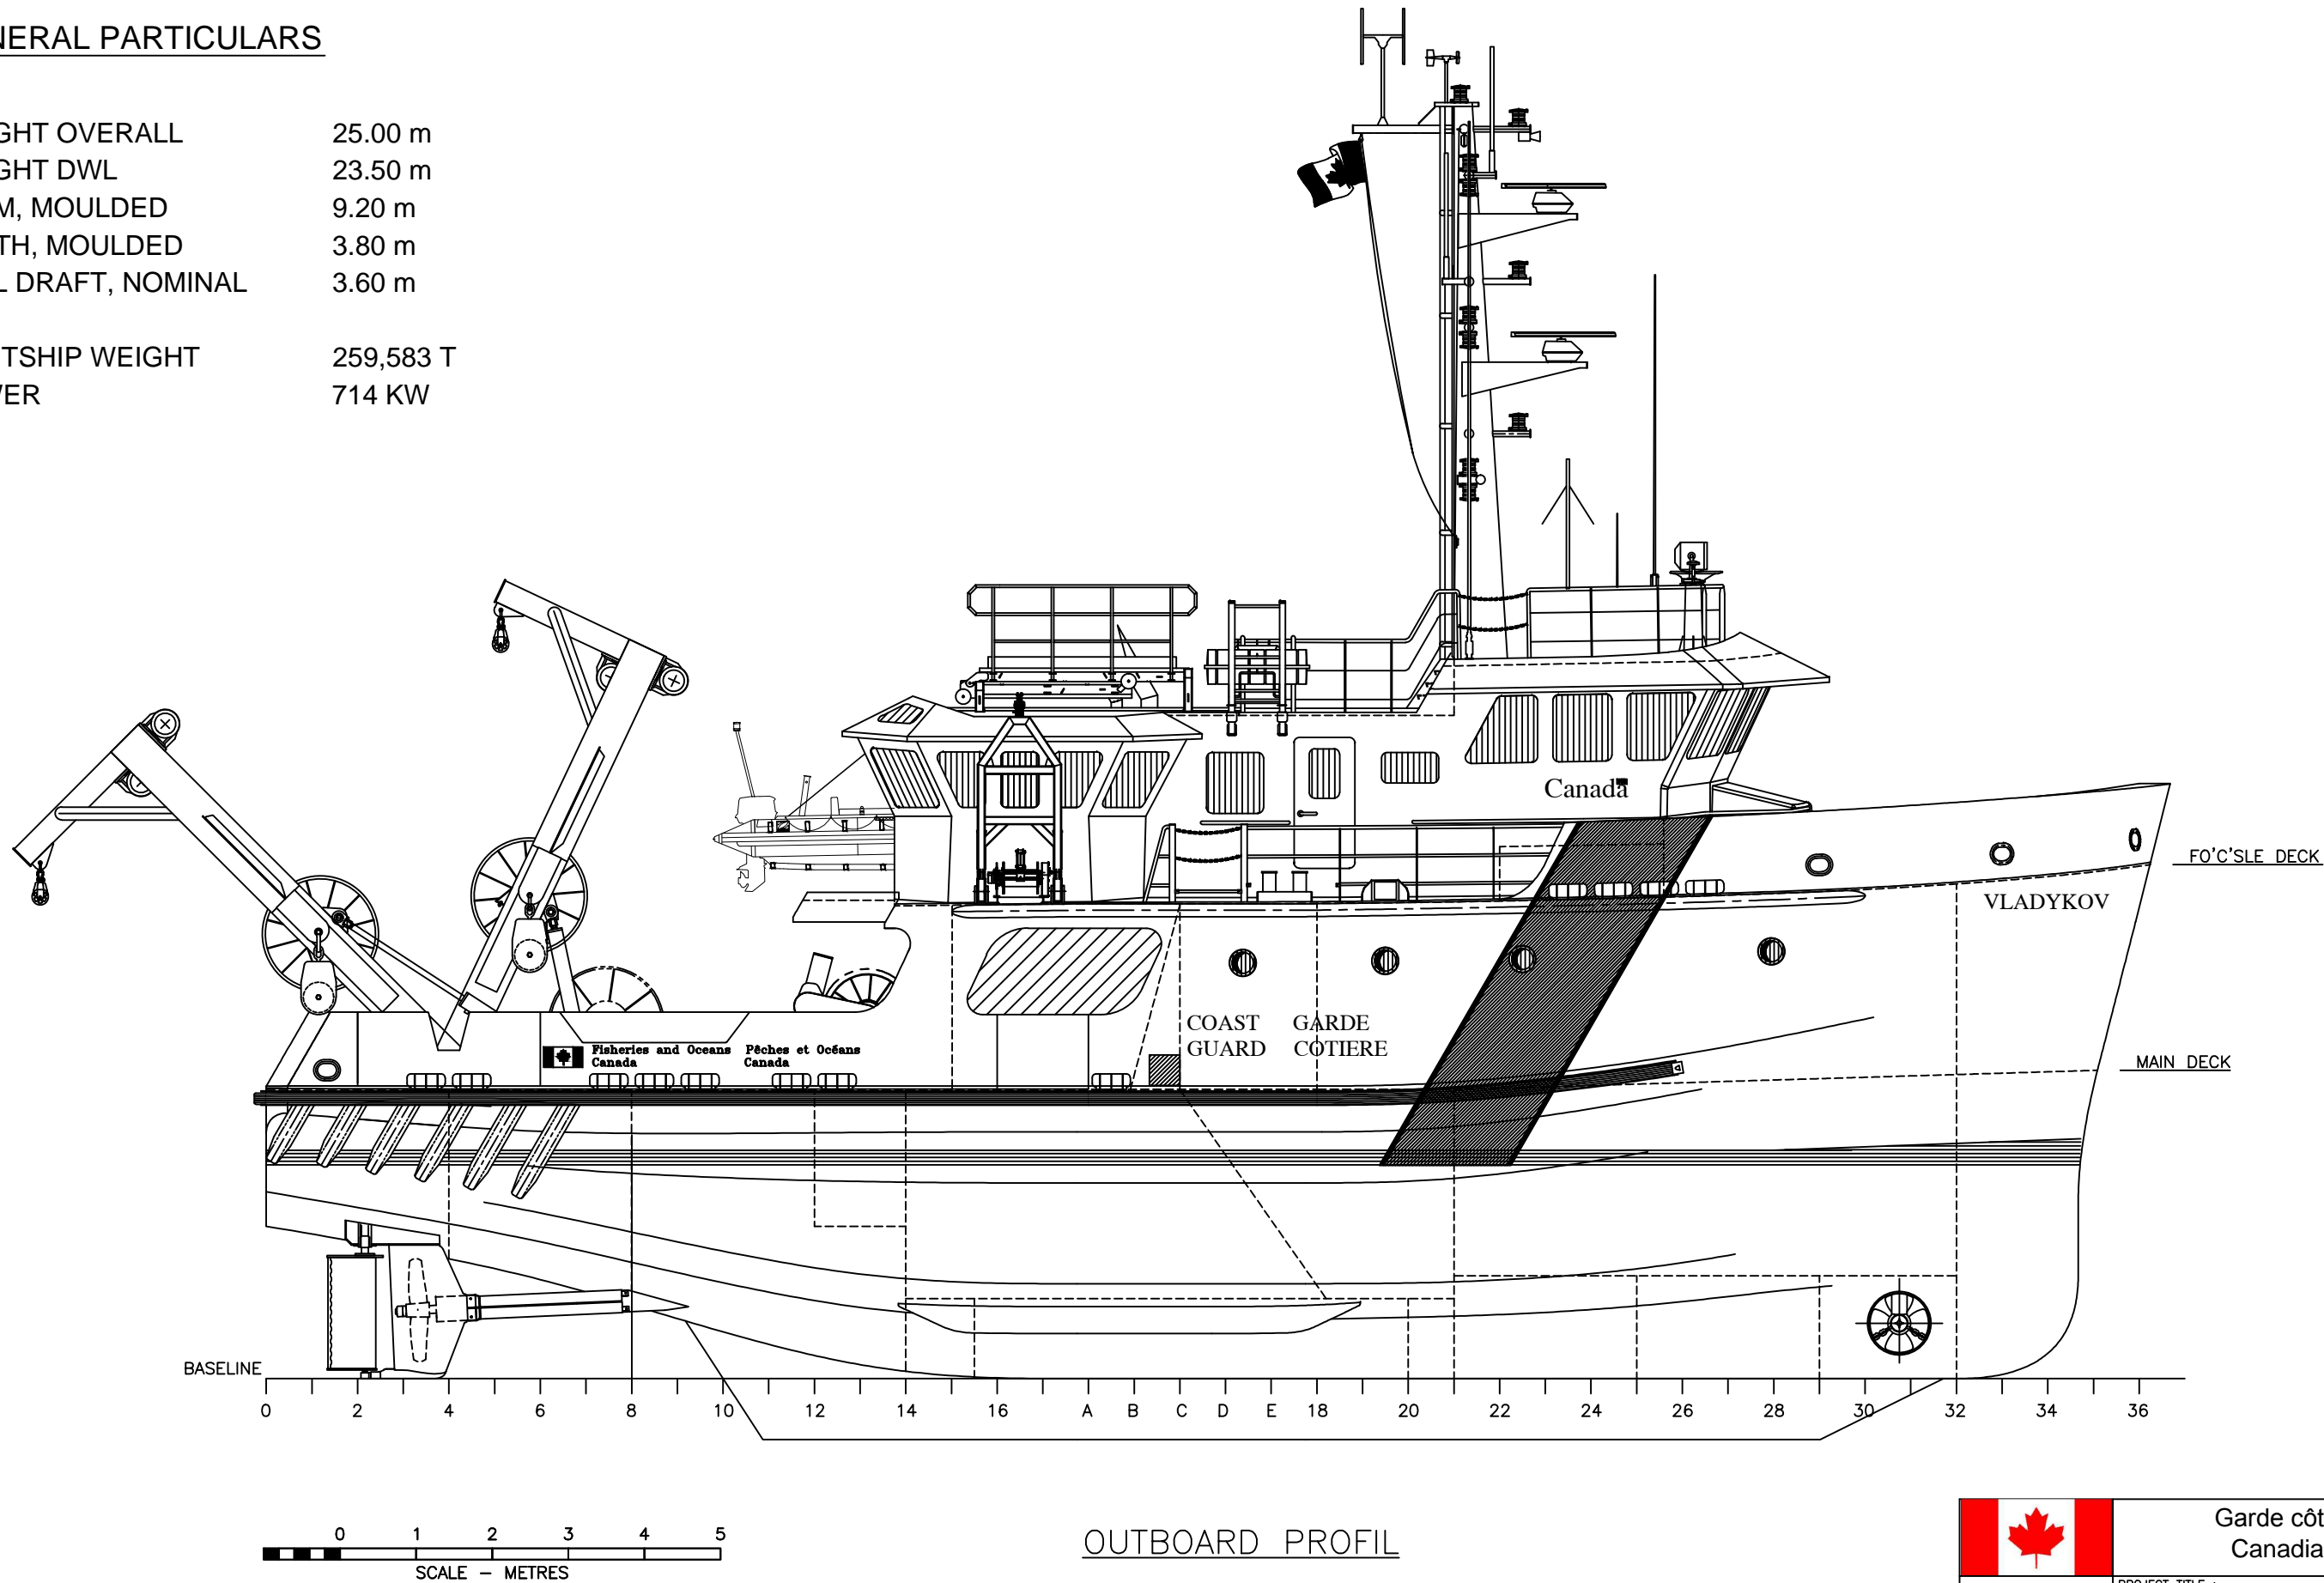


		Garde ctire canadienne Canadian Coast Guard	
NAVIRE 25M VESSEL COQUE # / HULL # 008		PROJECT TITLE : Navire semi-hauturier de recherche halieutique Near Shore Fisheries Research Vessels	
PROJECT # : MR09-1113	DRAWING FILE : ISV25-30000RMM9.DWG	DATE : 31/01/2012	
DRAWN BY :	DRAWING # : 30000	REV : 9	SHEET : 2 OF 6




COMPANY :  
**MRIDIEEN MARITIME  
RPARATION**

TITLE :  
**GENERAL ARRANGEMENT  
25M**

 THIS DRAWING IS BASED ON ROBERT ALLAN Ltd. DESIGN NO. 209-028 AND HAS BEEN DEVELOPED BY MERIDIEN MARITIME FOR PRODUCTION PURPOSES ONLY, WITH THE WRITTEN CONSENT OF ROBERT ALLAN LTD. ROBERT ALLAN LTD ASSUME NO RESPONSIBILITY WHATSOEVER FOR THIS ALTERED DRAWING.  
THE INTELLECTUAL PROPERTY RIGHTS TO THE DESIGN DESCRIBED HEREIN BELONG EXCLUSIVELY TO ROBERT ALLAN LTD. AND CANADA. THE DRAWINGS AND SPECIFICATIONS CONTAINED HEREIN SHALL NOT BE REPRODUCED IN WHOLE OR IN PART, NOR SHALL THEY BE GIVEN TO ANY THIRD PARTIES WITHOUT WRITTEN PERMISSION FROM THE OWNERS (POUR LA TRADUCTION FRANCAISE, VOIR LA PREMIERE PAGE)

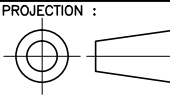

PROJECTION :

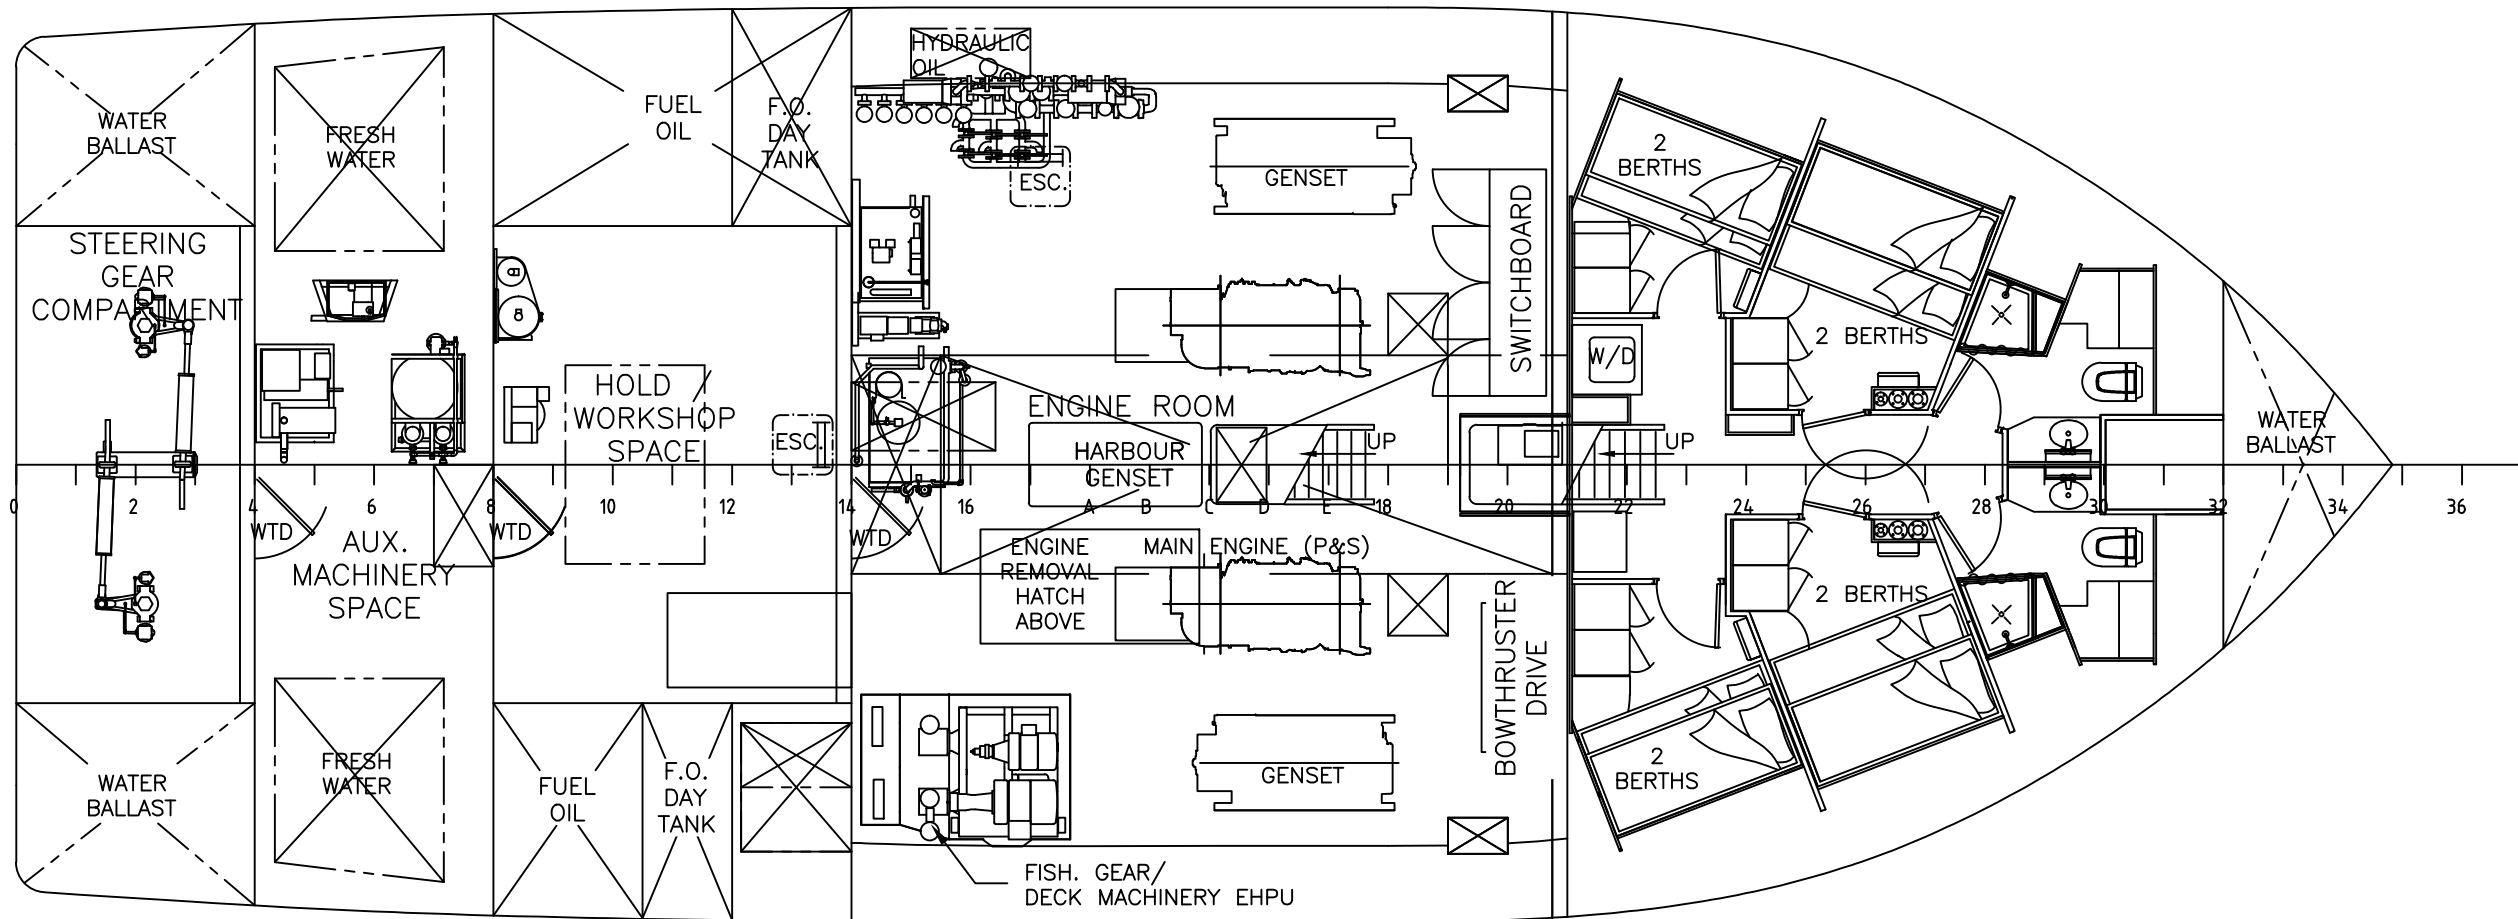

LOWER ACCOMMODATION


CE PLAN EST BASÉ SUR LE PLAN NO. 209-028. IL A ÉTÉ DÉVELOPPÉ UNIQUEMENT PAR MERIDIEN MARITIME À DES FINS DE PRODUCTION AVEC LA PERMISSION ÉCRITE DE ROBERT ALLAN LTÉE. ROBERT ALLAN LTÉE N'ASSUME AUCUNE RESPONSABILITÉ QUELLE QU'ELLE SOIT POUR CE PLAN MODIFIÉ. LA PROPRIÉTÉ INTELLECTUELLE DU PLAN CI-DESCRIT APPARTIENT UNIQUEMENT À ROBERT ALLAN LTÉE ET AU CANADA. IL EST DÉFENDU DE REPRODUIRE LES PLANS ET LES DEVIS, CI-INCLUS, EN ENTIER OU EN PARTIE, OU DE LES PARTAGER AVEC UN TIERS SANS LA PERMISSION ÉCRITE DES PROPRIÉTAIRES.



COMPANY :  
**MÉRIDIEN MARITIME**  
**RÉPARATION**

TITLE :  
**GENERAL ARRANGEMENT**  
**25M**

© THIS DRAWING IS BASED ON ROBERT ALLAN Ltd. DESIGN NO. 209-028 AND HAS BEEN DEVELOPED BY MERIDIEN MARITIME FOR PRODUCTION PURPOSES ONLY, WITH THE WRITTEN CONSENT OF ROBERT ALLAN LTD. ROBERT ALLAN LTD ASSUME NO RESPONSIBILITY WHATSOEVER FOR THIS ALTERED DRAWING. THE INTELLECTUAL PROPERTY RIGHTS TO THE DESIGN DESCRIBED HEREIN BELONG EXCLUSIVELY TO ROBERT ALLAN LTD. AND CANADA. THE DRAWINGS AND SPECIFICATIONS CONTAINED HEREIN SHALL NOT BE REPRODUCED IN WHOLE OR IN PART, NOR SHALL THEY BE GIVEN TO ANY THIRD PARTIES WITHOUT WRITTEN PERMISSION FROM THE OWNERS (POUR LA TRADUCTION FRANCAISE, VOIR LA PREMIERE PAGE)

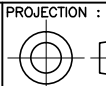


**Garde côtière canadienne**  
**Canadian Coast Guard**


PROJECT TITLE :  
**Navire semi-hauturier de recherche halieutique**  
**Near Shore Fisheries Research Vessels**

PROJECT # :  
**MR09-1113**  
DRAWN BY :

DRAWING FILE :  
**ISV25-30000RMM9.DWG**  
DATE :  
**31/01/2012**  
DRAWING # :  
**30000**  
REV :  
**9**  
SHEET :  
**3 OF 6**

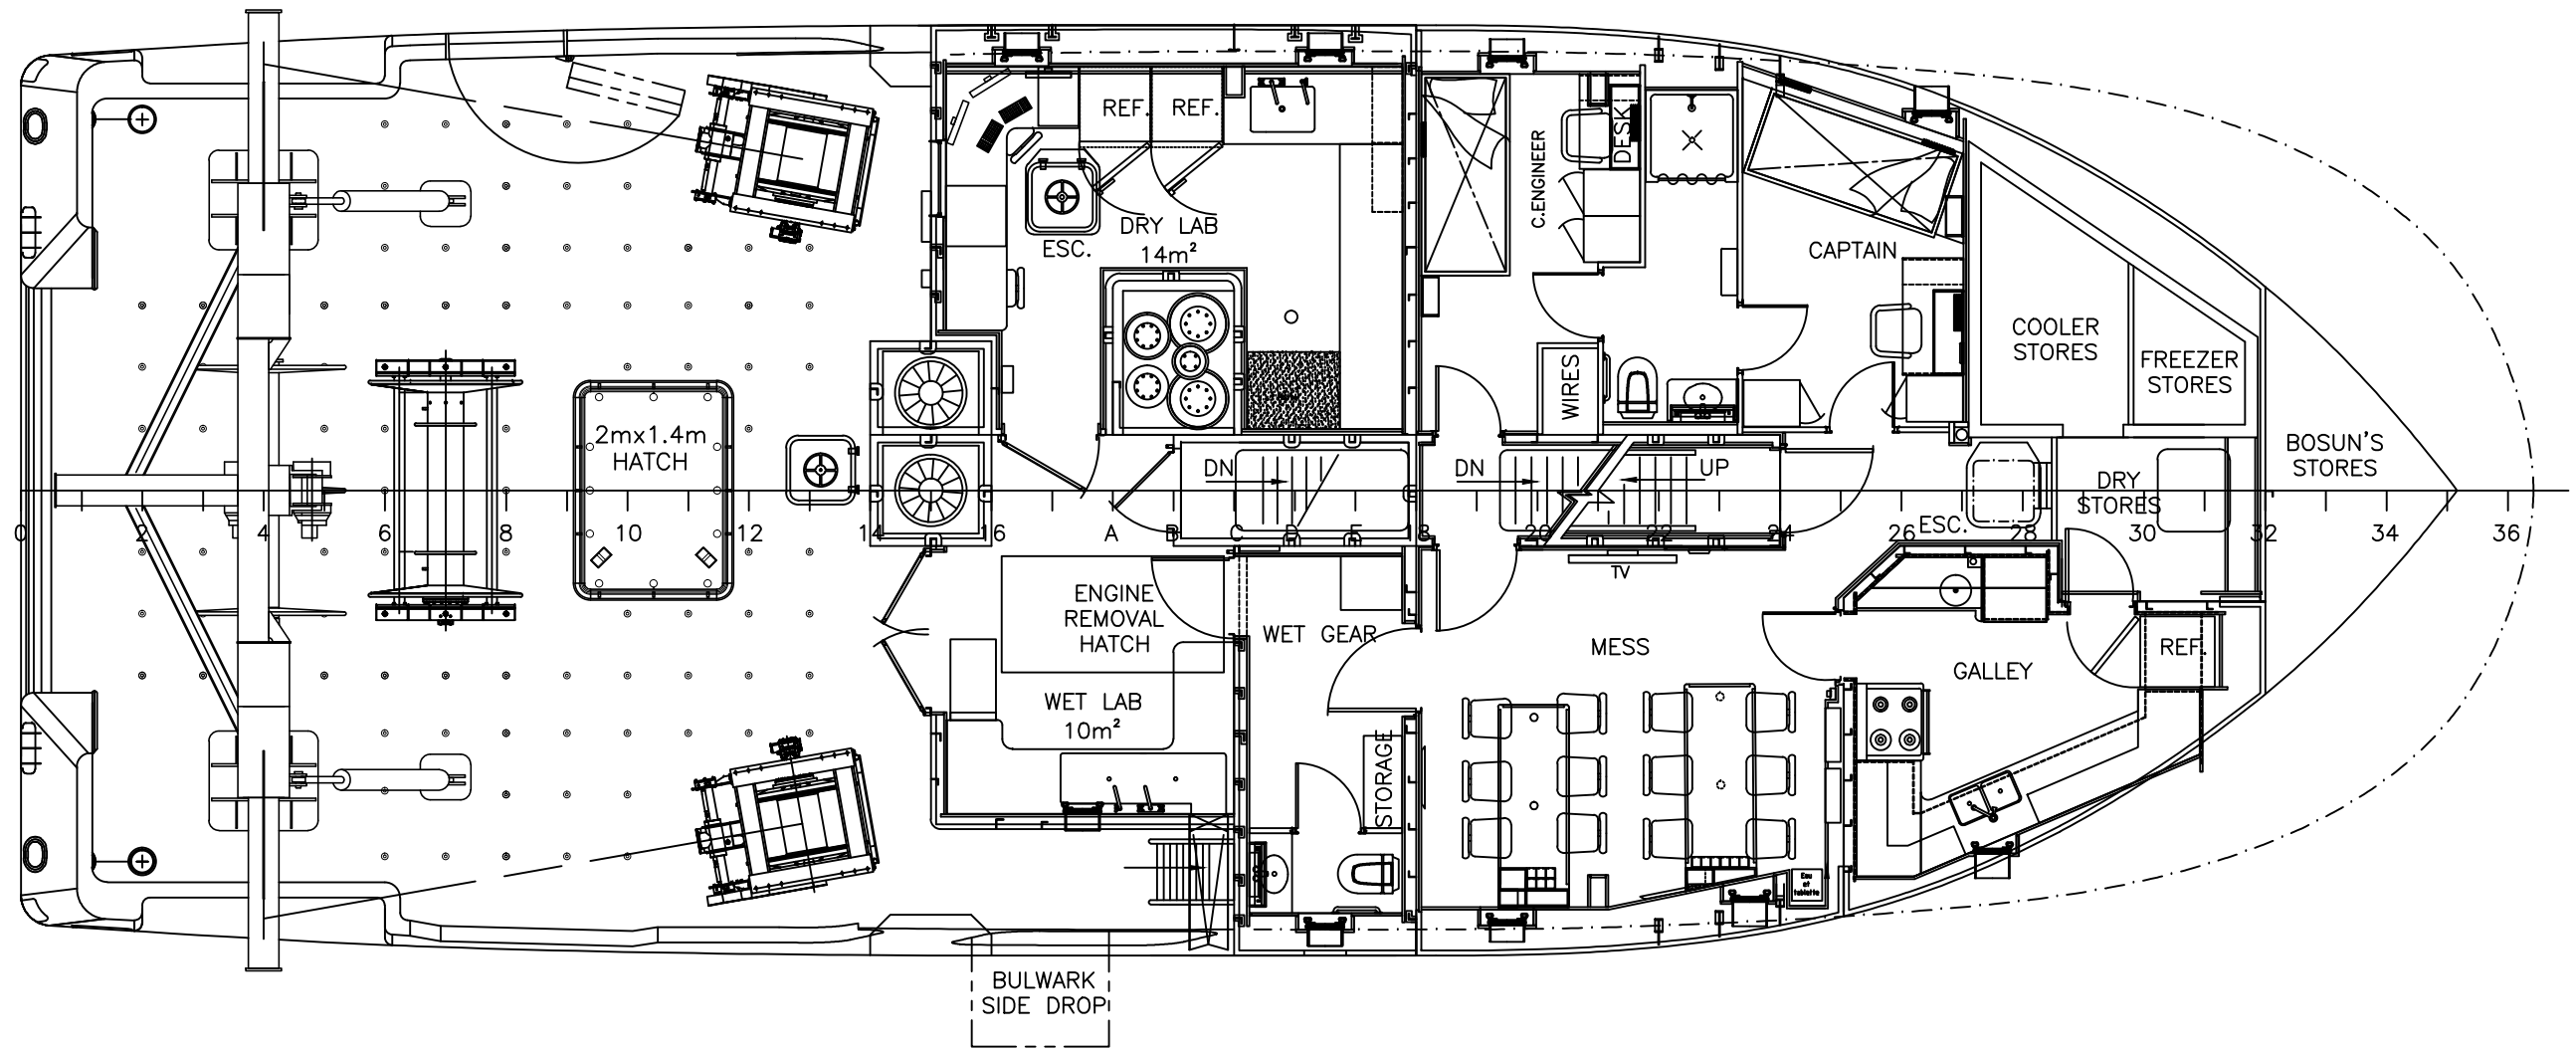

MAIN DECK PLAN


		<b>Garde côtière canadienne</b> <b>Canadian Coast Guard</b>	
NAVIRE 25M VESSEL COQUE # / HULL # 008		PROJECT TITLE : Navire semi-hauturier de recherche halieutique Near Shore Fisheries Research Vessels	
PROJECT # : MR09-1113	DRAWING FILE : ISV25-30000RMM9.DWG	DATE : 31/01/2012	
DRAWN BY :	DRAWING # : 30000	REV : 9	SHEET : 4 OF 6




COMPANY :  
**MÉRIDIEN MARITIME**  
**RÉPARATION**

TITLE :  
**GENERAL ARRANGEMENT**  
**25M**

© THIS DRAWING IS BASED ON ROBERT ALLAN Ltd. DESIGN NO. 209-028 AND HAS BEEN DEVELOPED BY MERIDIEN MARITIME FOR PRODUCTION PURPOSES ONLY, WITH THE WRITTEN CONSENT OF ROBERT ALLAN LTD. ROBERT ALLAN LTD ASSUME NO RESPONSIBILITY WHATSOEVER FOR THIS ALTERED DRAWING.  
THE INTELLECTUAL PROPERTY RIGHTS TO THE DESIGN DESCRIBED HEREIN BELONG EXCLUSIVELY TO ROBERT ALLAN LTD. AND CANADA. THE DRAWINGS AND SPECIFICATIONS CONTAINED HEREIN SHALL NOT BE REPRODUCED IN WHOLE OR IN PART, NOR SHALL THEY BE GIVEN TO ANY THIRD PARTIES WITHOUT WRITTEN PERMISSION FROM THE OWNERS (POUR LA TRADUCTION FRANCAISE, VOIR LA PREMIERE PAGE)

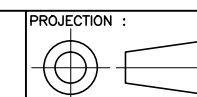

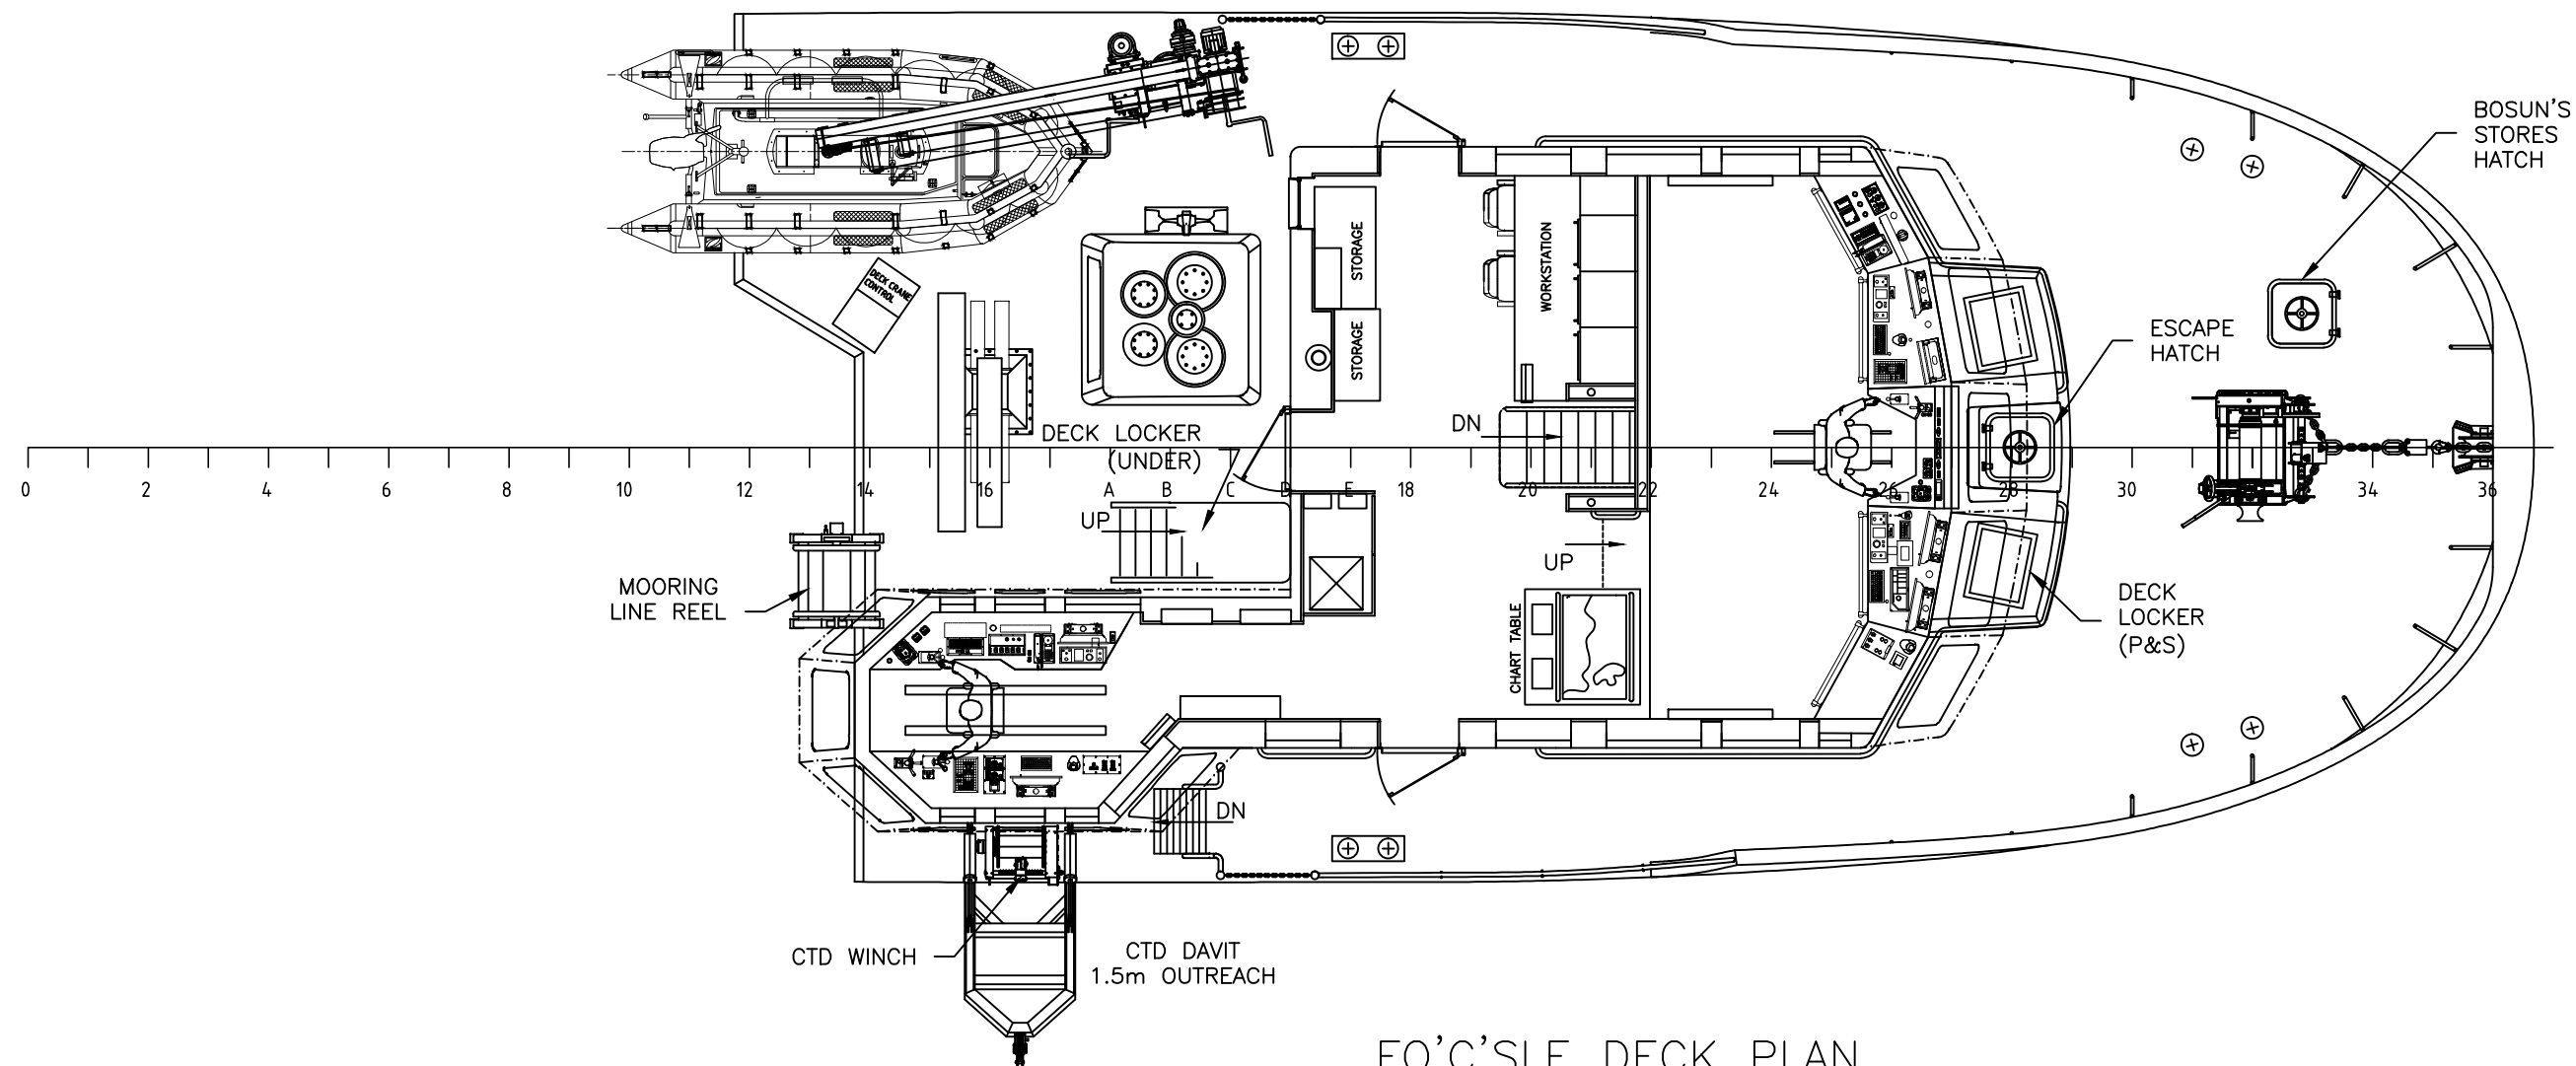


FO'C'SLE DECK PLAN



COMPANY :  
**MÉRIDIEN MARITIME  
RÉPARATION**

TITLE :  
**GENERAL ARRANGEMENT  
25M**

© THIS DRAWING IS BASED ON ROBERT ALLAN Ltd. DESIGN NO. 209-028 AND HAS BEEN DEVELOPED BY MERIDIEN MARITIME FOR PRODUCTION PURPOSES ONLY, WITH THE WRITTEN CONSENT OF ROBERT ALLAN LTD. ROBERT ALLAN LTD ASSUME NO RESPONSIBILITY WHATSOEVER FOR THIS ALTERED DRAWING.  
THE INTELLECTUAL PROPERTY RIGHTS TO THE DESIGN DESCRIBED HEREIN BELONG EXCLUSIVELY TO ROBERT ALLAN LTD. AND CANADA. THE DRAWINGS AND SPECIFICATIONS CONTAINED HEREIN SHALL NOT BE REPRODUCED IN WHOLE OR IN PART, NOR SHALL THEY BE GIVEN TO ANY THIRD PARTIES WITHOUT WRITTEN PERMISSION FROM THE OWNERS (POUR LA TRADUCTION FRANCAISE, VOIR LA PREMIERE PAGE)

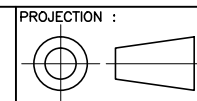

PROJECTION :



**Garde côtière canadienne  
Canadian Coast Guard**

NAVIRE 25M VESSEL  
COQUE # / HULL #  
008

PROJECT TITLE :  
Navire semi-hauturier de recherche halieutique  
Near Shore Fisheries Research Vessels

PROJECT # :  
MR09-1113

DRAWING FILE :  
ISV25-30000RMM9.DWG


DATE :  
31/01/2012

DRAWN BY :

DRAWING # :  
30000

REV :  
9

SHEET :  
5 OF 6

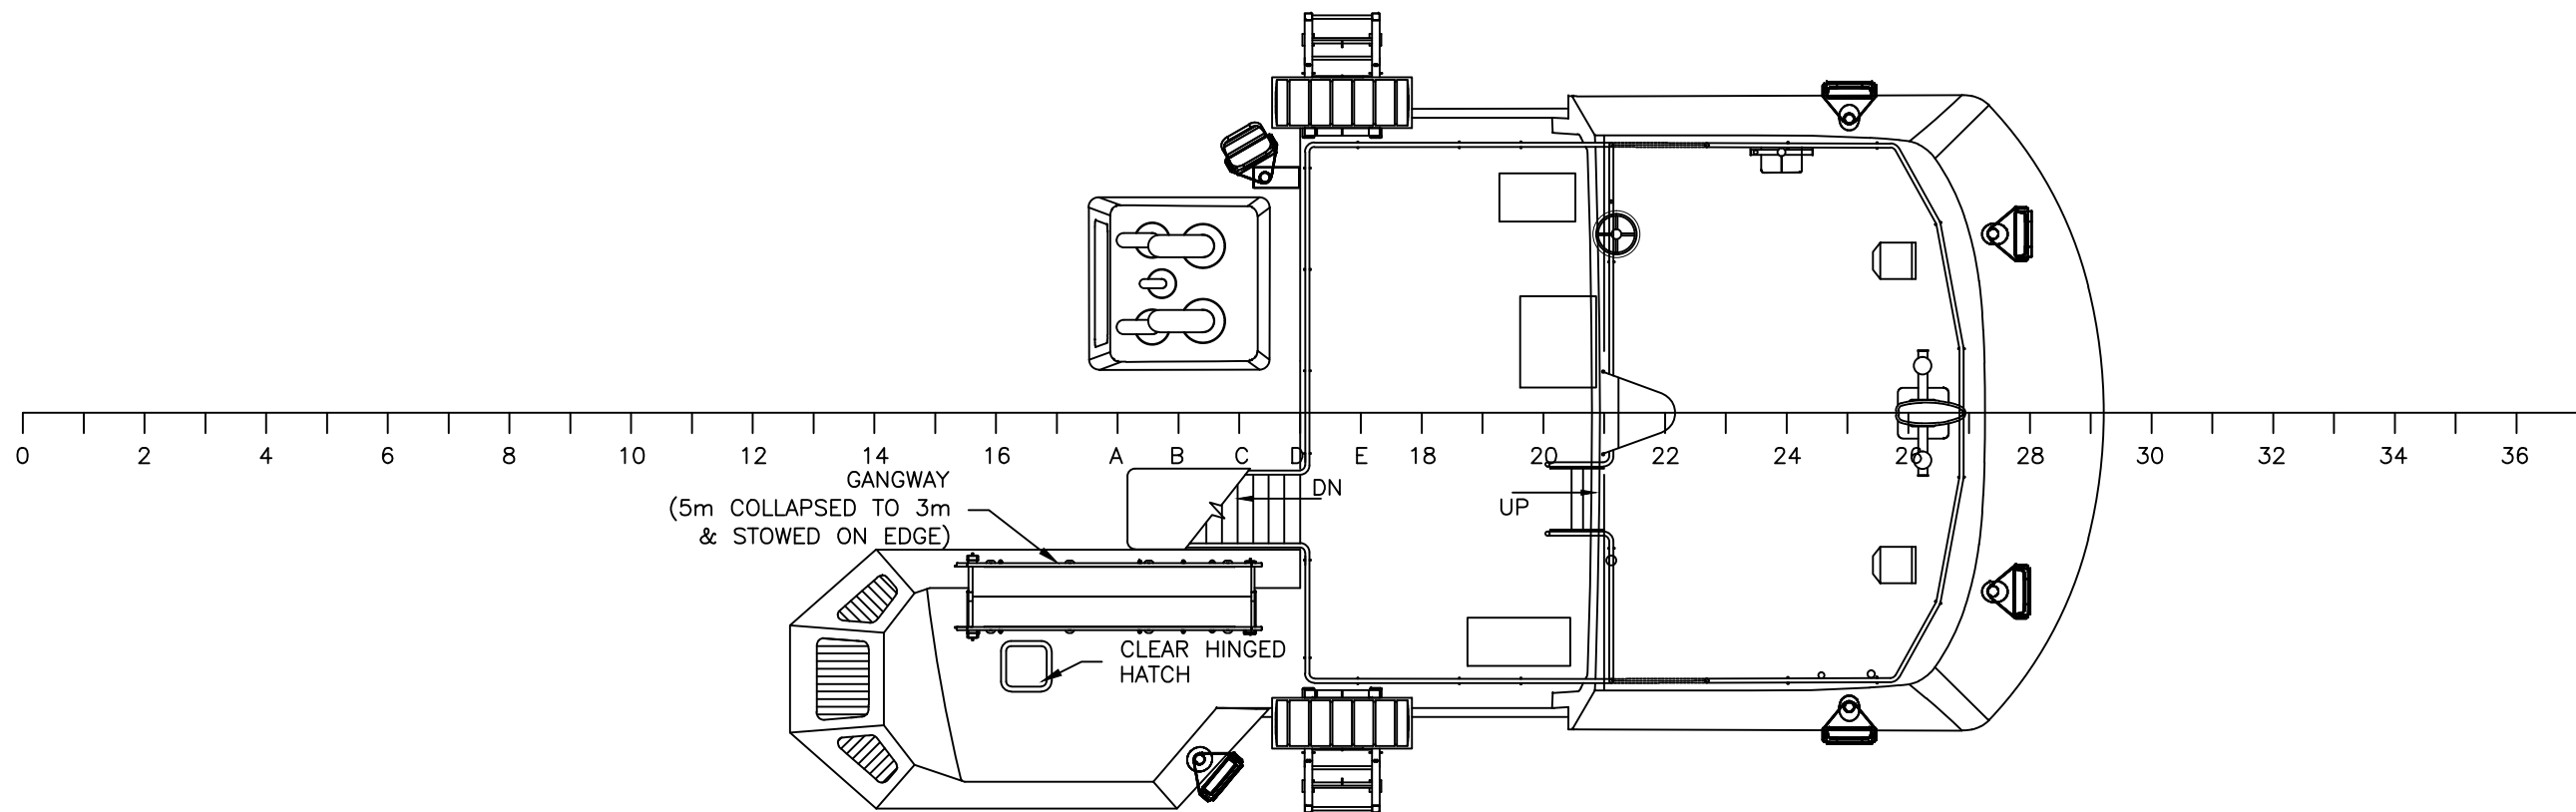

WHEELHOUSE TOP PLAN

