



THIS DRAWING FURNISHED FOR INFORMATION AND REFERENCE ONLY AND DOES NOT CONVEY ANY INFORMATION ON

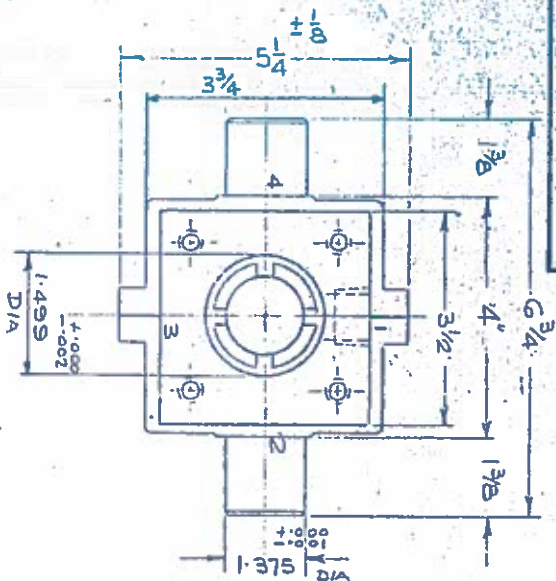

STAMP SER. NO. -
ADJACENT TO PORT
11 - 14

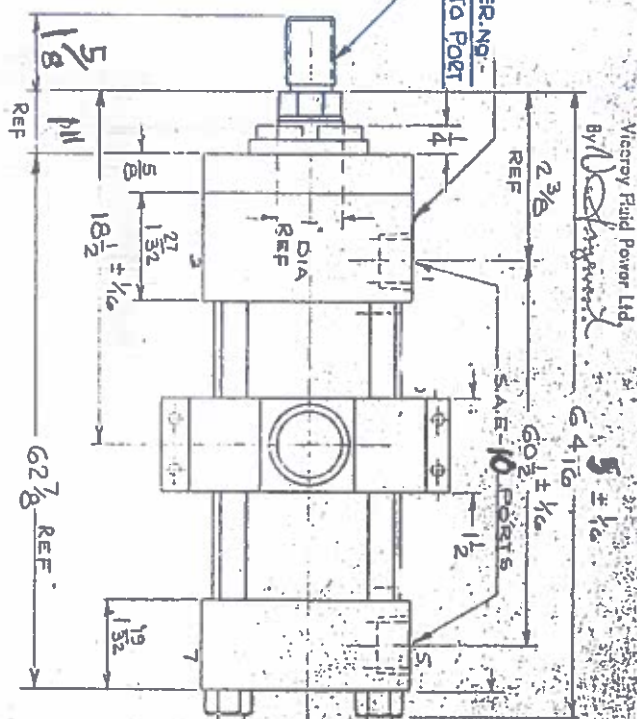

CERTIFIED
correct for dimensions

DEC 12 1978

Vicroy Fluid Power Ltd,
By Delegation

NOTE: CHEVRON PISTON PACKING

CUSTOMER - _____ V.F.P.L. NO. - 26575 CUST NO. - 4
MODEL NO. - 242TH ESTH CCAKY BORE - 2 1/2 STROKE - 5 1/2 ROD - 1 3/8
PRESSURE - 2500 PSI TEMP 200°F MAX MEDIUM HYD-OIL
PORTS - 1 & 5 ADJUSTING SCR 3 & 7 BALL CHECK 3 & 7

DEC 12 1978

ROD:- STAINLESS STL CHROME-

PLATED

| | | | | | | |
|------|---------|---------------------------|-------------|---------------|-----------|---|
| | | | | | | VICEROY FLUID POWER LIMITED REIDALE • ONTARIO • CANADA |
| QTY | 2 | 7 APR 76 | AS BUILT | S/S | DWG. NO. | 4410 |
| DATE | JULY 77 | CERTIFIED FOR MANUFACTURE | A.G. | DATE 3 MAY 77 | PART. NO. | 5 |
| DRW | | | DESCRIPTION | SCALE | N.T.S. | |