
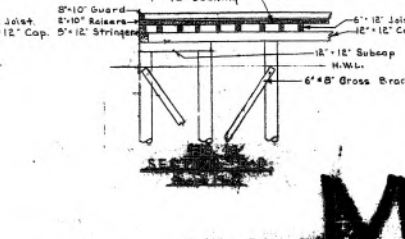
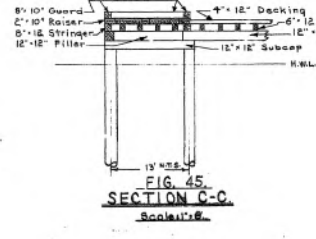
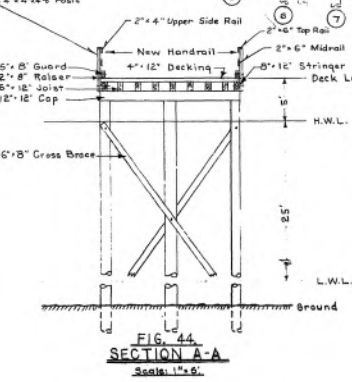


FOR REFERENCE ONLY

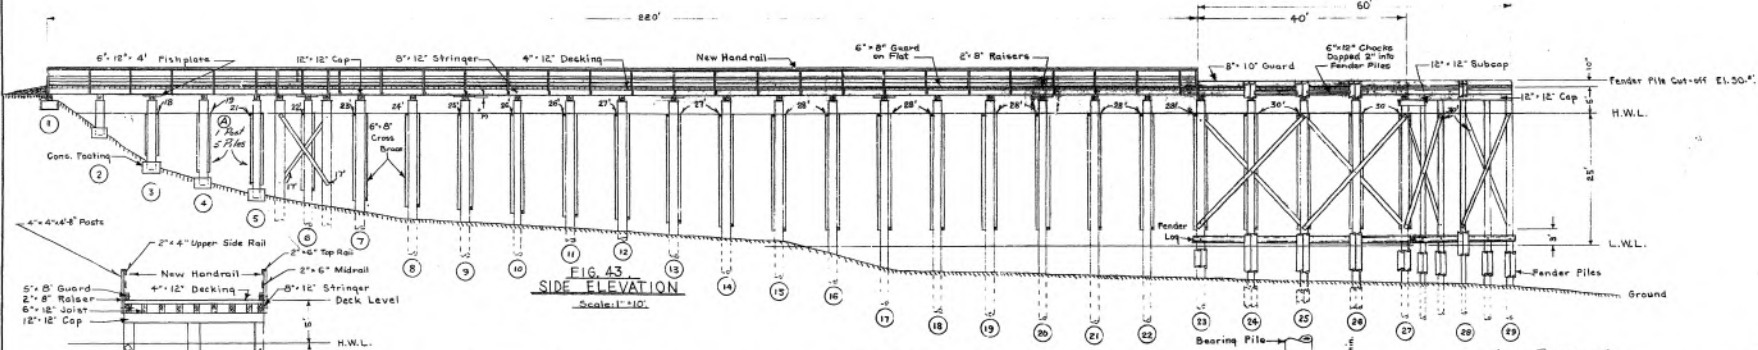

As BUILT Nov 30/63

PUBLIC WORKS OF CANADA

PRINCE RUPERT, B.C.

HARBOUR IMPROVEMENTS AND REPAIRS

SCALE AS NOTED (RUSHBROOK) SHEET 6 OF 9

DESIGNED BY *A. Bell* DRAWN BY H.S.G. EXAMINED BY *W. Miller* OTTAWA 4-1-1962

APPROVED BY *W. Miller* June 6th 1962

VERIFIED BY *C. Bell* CHIEF ENGINEER

CERTIFIED CORRECT Apr 12 1963

A. W. Kelly DISTRICT ENGINEER

PLAN No. D-310

M5-P95