





1
5
FIXED JOINT AT EAST & WEST
ABUTMENT (EXISTING) 1:20

2
5
FIXED JOINT AT EAST & WEST
ABUTMENT (REVISED) 1:20

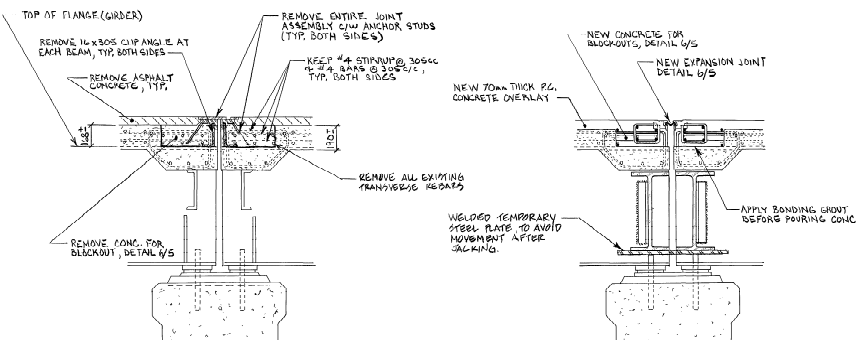


4
5
EXPANSION JOINT AT PIER
(EXISTING) 1:20


5
5
EXPANSION JOINT AT PIER
(REVISED) 1:20

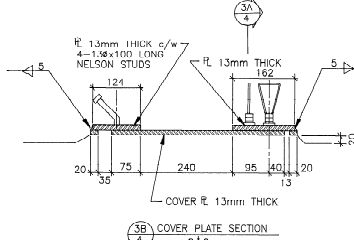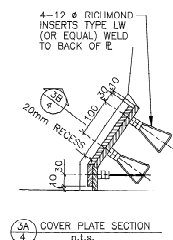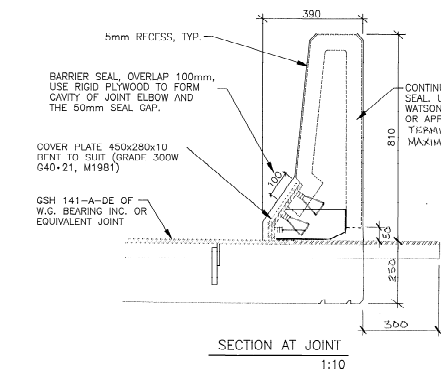


7
5
DECK JOINT COVER PLATE DETAILS

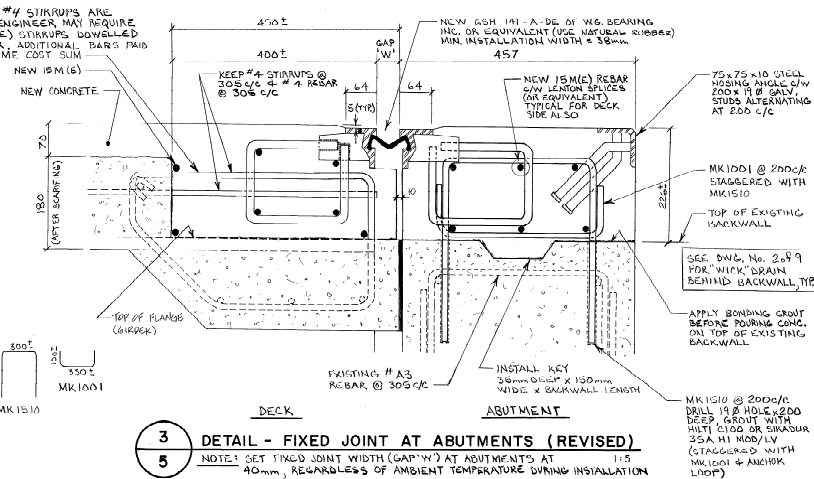

3
5
DETAIL - FIXED JOINT AT ABUTMENTS (REVISED)
NOTE: SET FIXED JOINT WIDTH (GAP 'W') AT ABUTMENTS AT 40mm, REGARDLESS OF AMBIENT TEMPERATURE DURING INSTALLATION 1:5

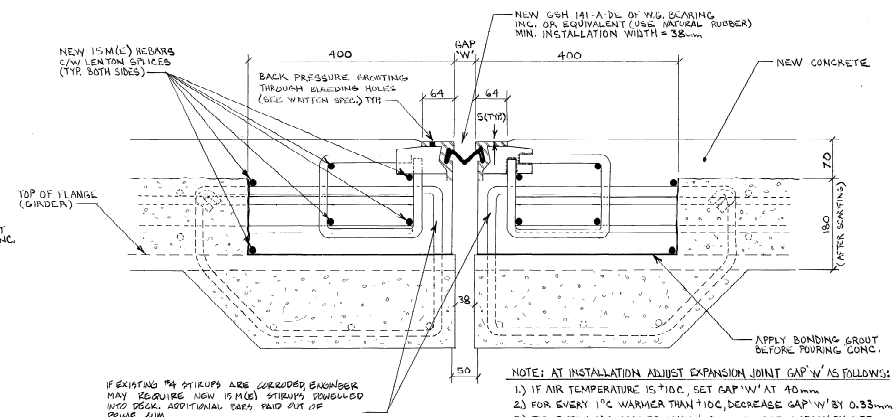

6
5
DETAIL - EXPANSION JOINT AT PIER (REVISED) 1:5

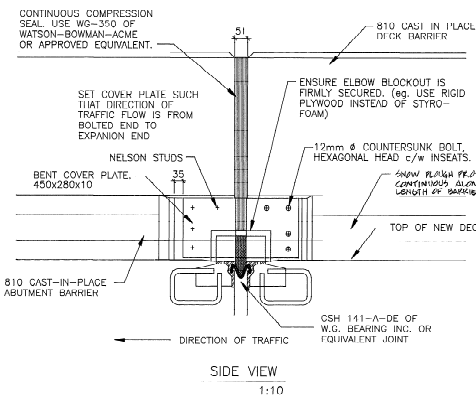

SIDE VIEW
1:10

NOTES: ALL DIMENSIONS ARE IN MILLIMETRES UNLESS INDICATED OTHERWISE.

CLIENT AUTHORIZATION/CONCURRENCE
ENVIRONMENT CANADA - CANADIAN PARKS SERVICE

revisions date

A detail no. for this detail
B location drawing no. for design no.
C drawing no. sheet no.

project
BEAVER RIVER BRIDGE
REHABILITATION
T.C.H. - km 9.8
Glacier National Park, B.C.

drawing
AS CONSTRUCTED
DECK JOINT
DETAILS

AA002164

designer: R. POOL
date: MARCH, 1990
drawn: J.M.C.
date: NOV. 1990
checked: [signature]
approved: [signature]
Tender: [signature]
Project Manager: [signature]
project number: 669097
drawing no.: 5 of 9