




1 LOCATION PLAN FOR DRAINAGE DETAILS
7 1:200

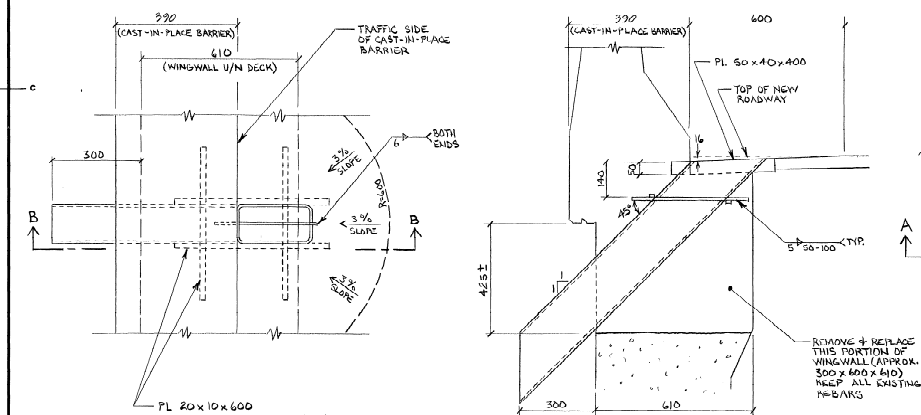


PLAN VIEW 2 NEW ABUTMENT DRAIN DETAILS SECTION B-B

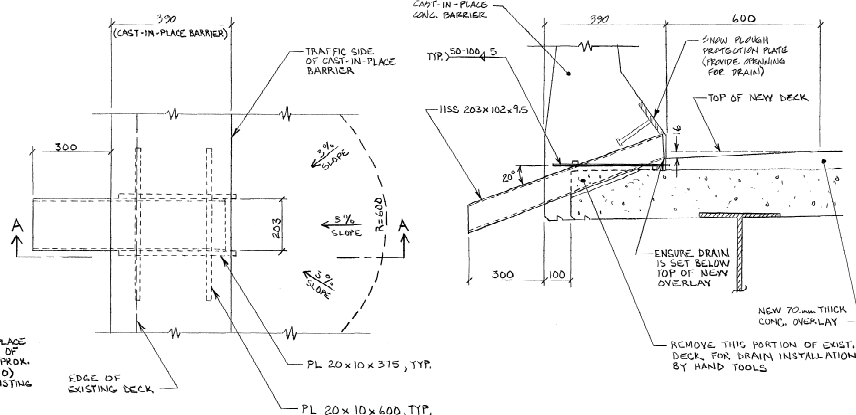


PLAN VIEW 3 NEW DECK DRAIN DETAILS SECTION A-A

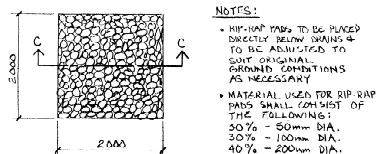

PLAN VIEW

 RIP-RAP PAD DETAILS

1:50

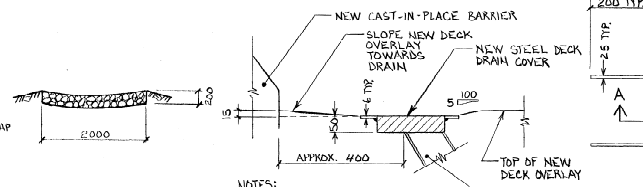

SECTION C-C

NOTES:
1) GALV. STEEL TO 640-21-M-1981 GRADE 300W


SECTION A-A

EXISTING REFINISHED DRAIN


2) PLACE COVER TRANSVERSE TO TRAFFIC AND ON TOP OF EXIST. DRAIN

5 NEW DECK DRAIN

7 COVER DETAIL N.T.S.

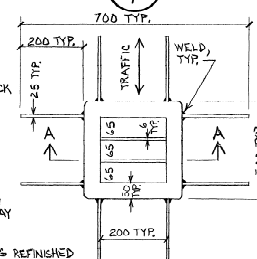

PLAN VIEW

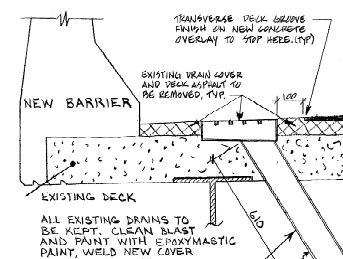

6 EXISTING DECK DRAIN
7 DETAILS

Public Works Canada / Travaux publics Canada

NOTE: ALL DIMENSIONS ARE IN MILLIMETRES UNLESS INDICATED OTHERWISE

CLIENT AUTHORIZATION / CONCURRENCE

ENVIRONMENT CANADA - CANADIAN PARKS SERVICE

revisions		
-----------	--	--

A detail no.
no. du détail

B location drawing no.
sur dessin no.

C drawing no.
dessin no.

project	proj
---------	------

BEAVER RIVER BRIDGE
REHABILITATION
T.C.H. — km 9.8
Glacier National Park, B.C.

drawing	dess
---------	------

AS CONSTRUCTED
DRAINAGE DETAILS

*AA002166

designed R. POON con

date MARCH 1990

drawn	J. M.C.	date
-------	---------	------

date NOV. 1990

reviewed	examined
----------	----------

date _____

approved *[Signature]* approved

date 1/9/2002

Yender *[Signature]* Soumial

PWC Project Manager	Administrateur de projets TI
---------------------	------------------------------

669097

drawing no. no. du dessin
3 of 3