

**CBSA – FRASER POE DEMOLITION OF EXISTING SLAB AND REPAVING**

The following changes in the tender documents are effective immediately. This addendum will form part of the contract documents.

---

**A. SPECIFICATIONS**

- .1 Section 00 00 10 Table of Contents  
DRAWING LIST  
ADD:  
ELECTRICAL  
**E010 ELECTRICAL SITE PLAN NEW CONDUITS FOR 2<sup>ND</sup> PIL BOOTH**

**B. ARCHITECTURAL DRAWING**

- .1 A-00 COVER SHEET (Total 1 page).  
ADD: Electrical consultant added to the Project Team.  
ADD: Drawing E010 added to the Drawing List.

**C. ELECTRICAL DRAWING**

- .1 ADD: Drawing E010 attached for the additional scope. (Total 1 page).

**END OF ADDENDUM No. 3**

---

**TABLE OF CONTENTS**

<b>SPECIFICATION DIVISION</b>		<b>SECTION</b>	<b>PAGES</b>
INDEX	00 01 07	Seal and Signature	1
	00 00 10	Table of Contents	2
DIVISION 01 GENERAL REQUIREMENTS	01 11 55	General Instructions	6
	01 14 00	Work Restrictions	2
	01 31 19	Project Meetings	2
	01 32 16.07	Construction Progress Schedule – Bar (GANTT) Chart	3
	01 33 00	Submittal Procedures	4
	01 35 00	Traffic Control	3
	01 35 33	Health and Safety Requirements	9
	01 35 43	Environmental Procedures	2
	01 45 00	Quality Control	2
	01 51 00	Temporary Utilities	1
	01 52 00	Construction Facilities	3
	01 56 00	Temporary Barriers and Enclosures	2
	01 61 00	Common Product Requirements	3
	01 73 00	Execution	2
	01 74 11	Cleaning	2
	01 74 19	Waste Management and Disposal	6
	01 77 00	Closeout Procedures	1
	01 78 00	Closeout Submittals	6
DIVISION 02 SITE CONSTRUCTION	02 41 13	Site Demolition	4
	02 41 99	Demolition for Minor Works	2
	02 81 01	Hazardous Materials	7
DIVISION 07 THERMAL & METAL PROTECTION	07 61 13	Standing Seam Sheet Metal Roofing	7
DIVISION 09 FINISHES	09 91 13	Exterior Painting	9
DIVISION 31 EARTHWORK	31 05 16	Aggregate Materials	4
DIVISION 32 EXTERIOR IMPROVEMENTS	32 10 01	Traffic Marking Paint and Special Markings	8
	32 12 16	Asphalt Paving	7
<b>APPENDICES</b>			
APPENDIX A		Site Photos	9
APPENDIX B		Geotechnical Report	29
APPENDIX C		Area Specific Designated Substances and Hazardous Materials Survey	49
APPENDIX D		Pre-Demolition Hazardous Materials Assessment	42

**DRAWING LIST**

ARCHITECTURAL

- A-00 COVER SHEET
- A-01 SITE PLANS (EXISTING AND NEW)
- A-02 TRAFFIC LINE PAINTING PLAN
- A-03 SECONDARY INSPECTION CANOPY DEMOLITION AND NEW WORK

CIVIL

- C100 EXISTING CONDITION AND REMOVAL PLAN
- C101 SITE GRADING & PAVEMENT MARKING


**ELECTRICAL**

- E010 ELECTRICAL SITE PLAN NEW CONDUITS FOR 2<sup>ND</sup> PIL BOOTH**

END OF SECTION 00 00 10

# FRASER PORT OF ENTRY: PHASE 2 EXISTING SLAB DEMOLITION AND REPAVING

KM 36.7 South Klondike Highway,  
Northern BC, Canada

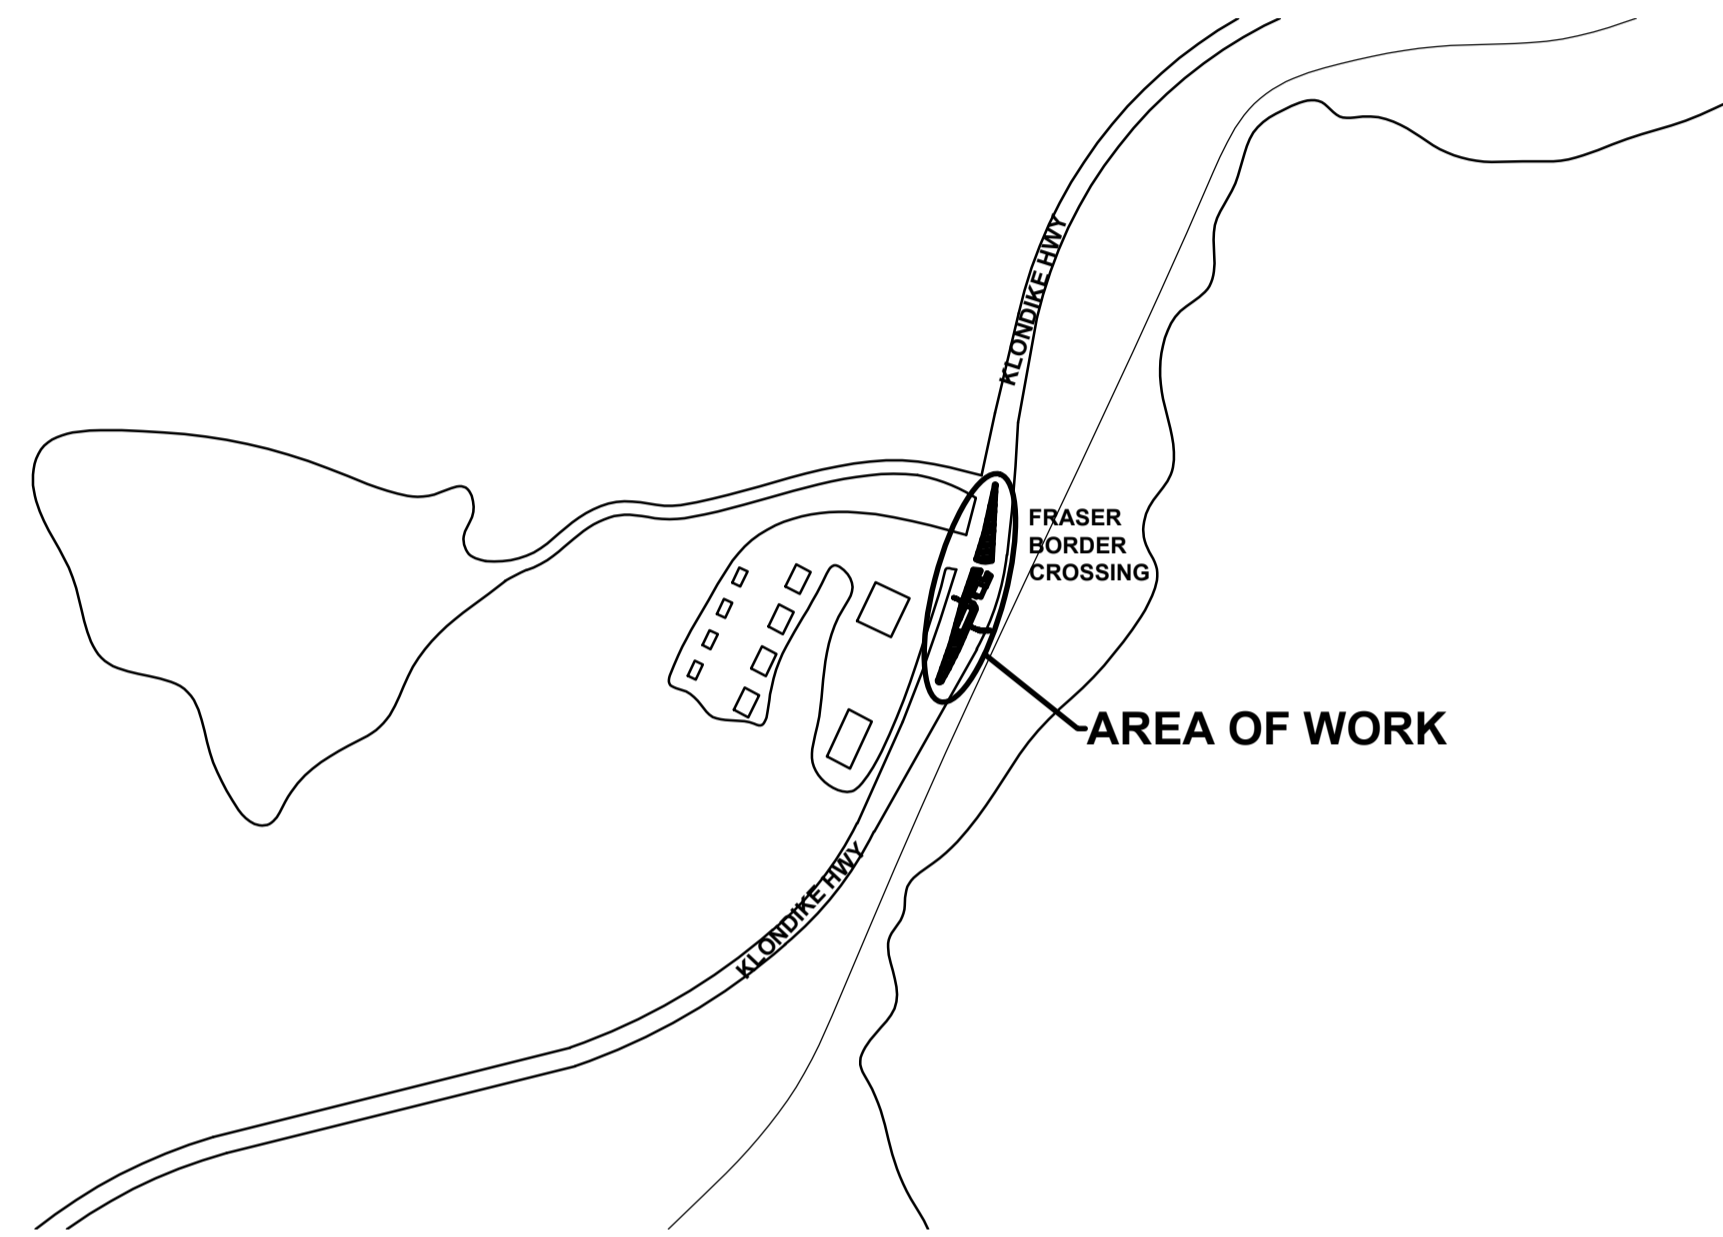

**SITE LOCATION PLAN** SCALE: NTS

## PROJECT TEAM

**OWNER** PUBLIC SERVICE AND PROCUREMENT CANADA  
PACIFIC REGION, GOVERNMENT OF CANADA

**ARCHITECT & PRIME CONSULTANT** CHERNOFF THOMPSON ARCHITECTS

**CIVIL** STANTEC ARCHITECTURE


**ELECTRICAL** STANTEC ELECTRICAL

## DRAWING LIST

**ARCHITECTURAL**  
A-00 COVER SHEET  
A-01 SITE PLANS (EXISTING AND NEW)  
A-02 TRAFFIC LINE PAINTING PLAN  
A-03 SECONDARY INSPECTION CANOPY / DEMOLITION AND NEW WORK

**CIVIL**  
C100 EXISTING CONDITION AND REMOVAL PLAN  
C101 SITE GRADING & PAVEMENT MARKING

**ELECTRICAL**  
E010 ELECTRICAL SITE PLAN - NEW CONDUITS FOR 2ND PIL BOOTH

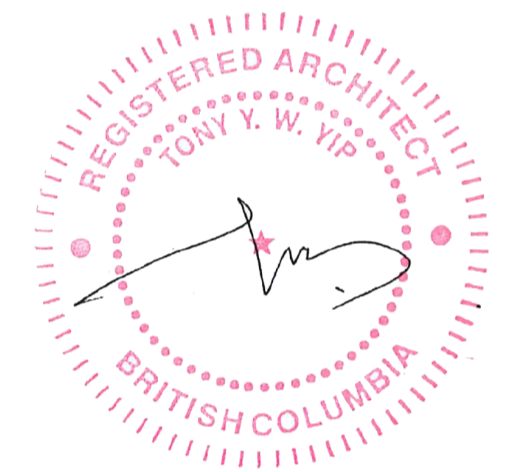

9th June 2021

Revision/	Description/Description	Date/Date
4	ISSUED FOR ADDENDUM NO. 3	210608
3	ISSUED FOR ADDENDUM NO. 1	210604
2	ISSUED FOR TENDER	210331
1	ISSUED FOR 99% REVIEW	210305
0	ISSUED FOR 50% REVIEW	200809

**Client/client**  
**CANADA BORDER SERVICES AGENCY**

**Project title/Titre du projet**  
km 36.5/mile 22.6 YUKON HIGHWAY 2  
(KLONDIKE HWY) FRASER BC

**FRASER PORT OF ENTRY  
DEMOLITION OF EXISTING  
SLAB AND REPAVING**

Consultant Signature Only

Designed by/Concept par  
TY

Drawn by/Dessiné par  
ET



PWGC Project Manager/Administrateur de Projets TPSGC  
JULIAN HO

Regional Manager, Architectural and Engineering Services  
Gestionnaire régionale, Services d'architecture et de génie, TPSGC  
PREETIPAL PAUL


Drawing title/Titre du dessin

**COVER SHEET**

Project No./No. du projet	Sheet/Feuille	Revision no./La Révision no.
R.106775.001	A-00 01 OF 04	4

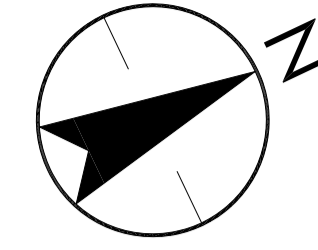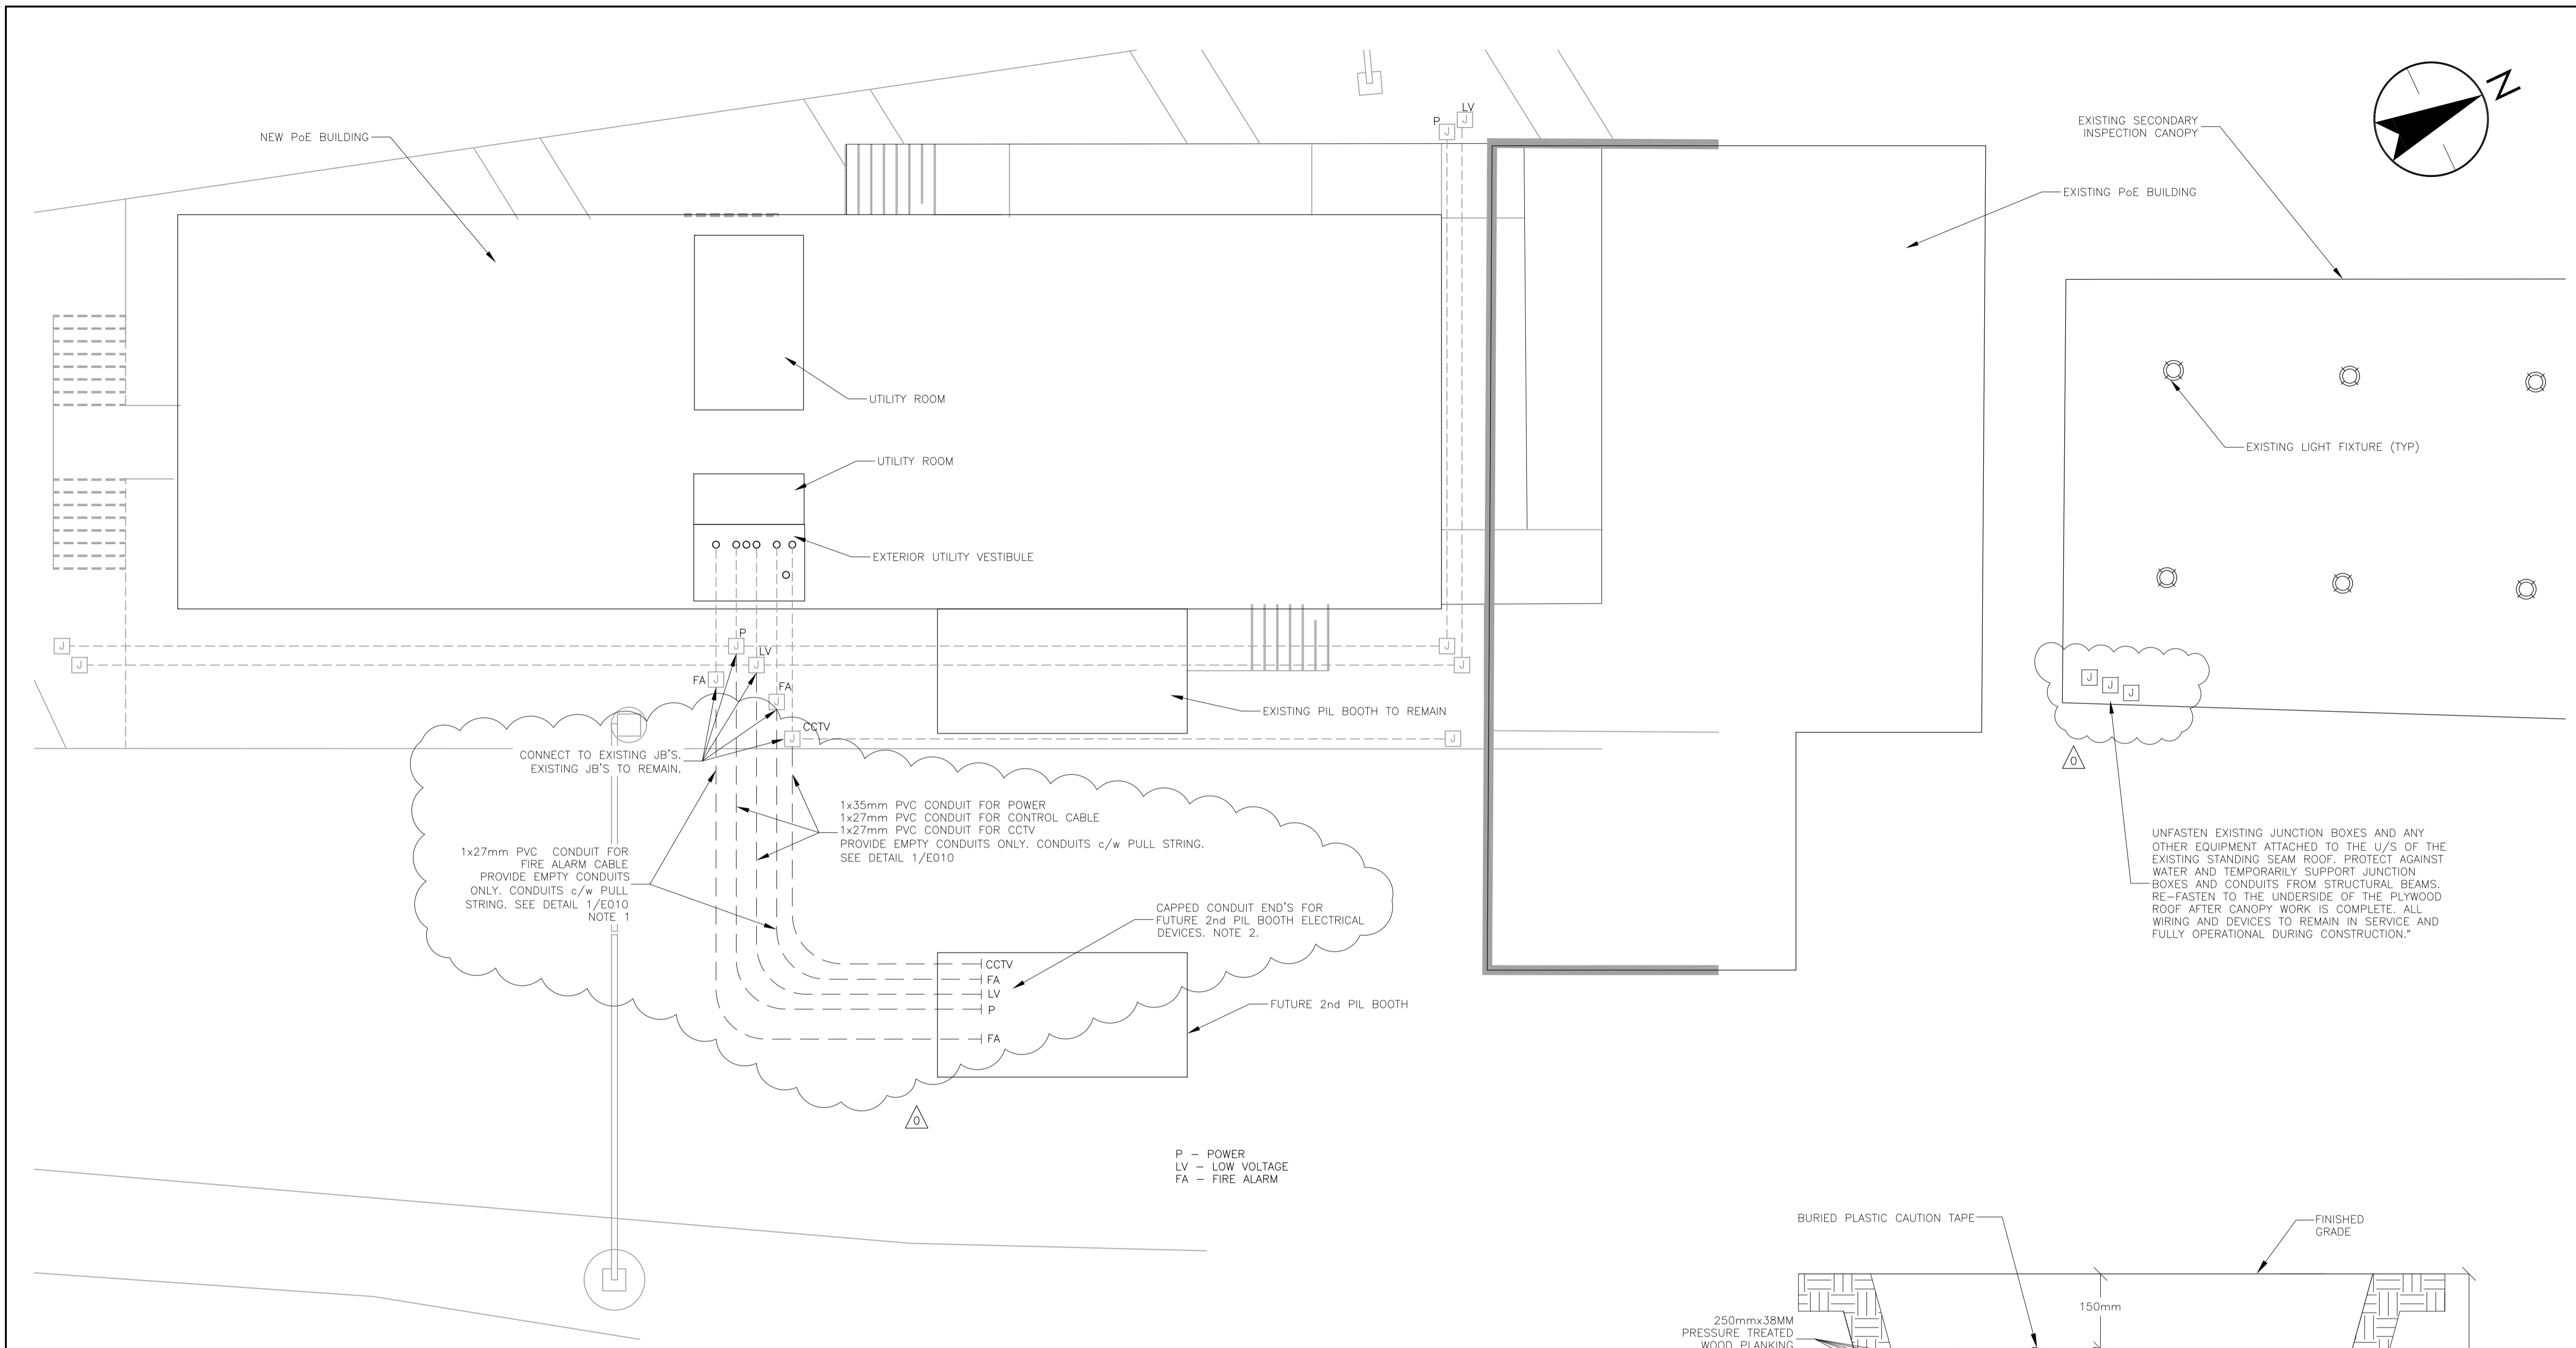

**NOTES:**  
 1. IDENTIFY EACH CONDUIT IN JUNCTION BOXES WITH LAMICOID TAG ATTACHED TO EACH CONDUIT.  
 2. CAP AND LEAVE EACH CONDUIT WITHIN THE FOOTPRINT OF THE FUTURE PIL BOOTH AND MARK EXACT LOCATION ON THE AS-BUILT DRAWINGS. IDENTIFY EACH CONDUIT WITH LAMICOID TAG ATTACHED TO EACH CONDUIT.

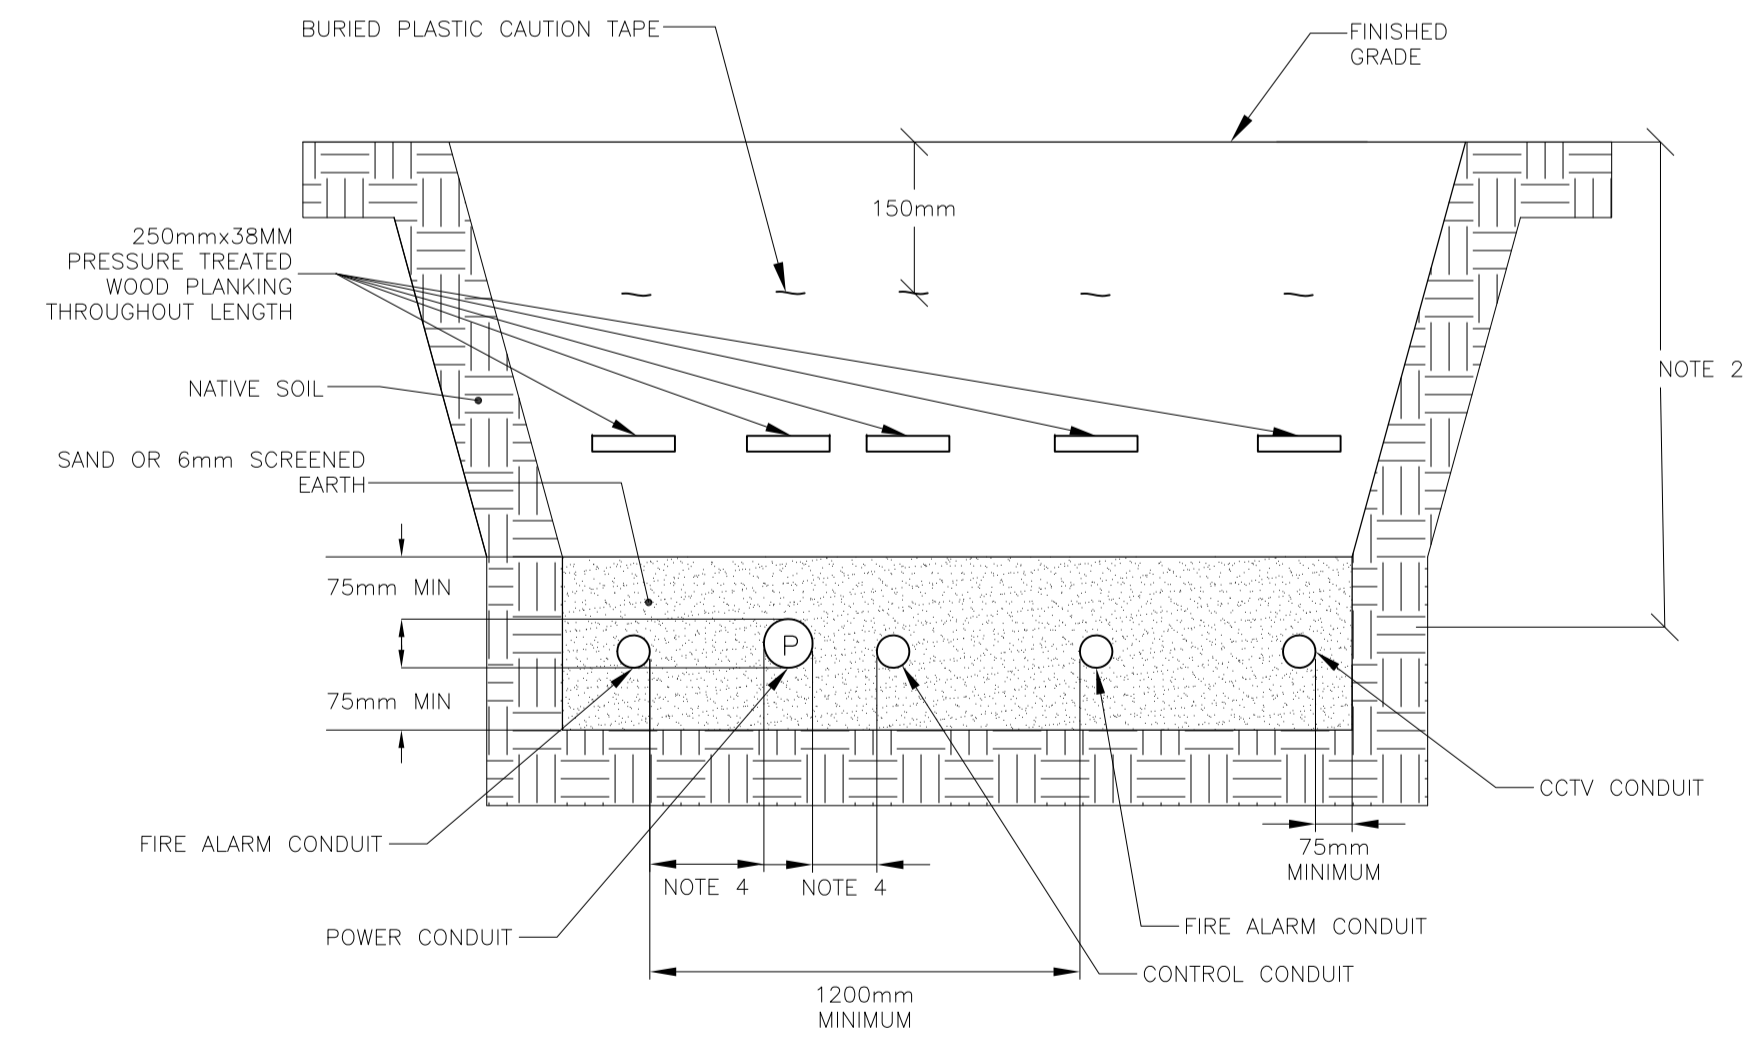

**NOTES:**  
 1. ALL UNDERGROUND CONDUIT TO BE BURIED ACCORDING TO THIS DETAIL EXCEPT WHERE OTHERWISE NOTED.  
 2. MINIMUM COVER TO BE IN ACCORDANCE WITH CEC RULES 12-012 AND 60-600. REDUCED MINIMUM COVER PER CEC IS ACCEPTABLE, WHERE MECHANICAL PROTECTION IS PROVIDED ACCORDINGLY.  
 3. MARKER TAPE TO BE APPROXIMATELY HALF WAY BETWEEN FINISHED GRADE AND CONDUIT OR CABLE.  
 4. SEPARATION BETWEEN POWER AND COMMUNICATION CABLES TO BE 300 MM MINIMUM FOR NON-METALLIC SHEATHED COMMUNICATION CABLES OR NON-METALLIC CONDUIT



0	ISSUED FOR ADDENDUM #3	10/06/21
Revision/	Description/Description	Date/Date
Client/client		

**CANADA BORDER SERVICES AGENCY**

Project title/Titre du projet  
**km 36.5/mile 22.6 YUKON HIGHWAY 2 (KLONDIKE HWY) FRASER BC**

**FRASER PORT OF ENTRY DEMOLITION OF EXISTING SLAB AND REPAVING**

Consultant Signature Only  
 Designed by/Concept par **JORDAN YOUNGS**  
 Drawn by/Dessine par **KONRAD GOLUCH**  
 PWGSC Project Manager/Administrateur de Projets TPSCG **JULIAN HO**  
 Regional Manager, Architectural and Engineering Services / Gestionnaire régionale, Services d'architectural et de génie, TPSCG **PREETIPAL PAUL**

**ELECTRICAL SITE PLAN NEW CONDUITS FOR 2ND PIL BOOTH**

Project No./No. du projet <b>R.106775.001</b>	Sheet/Feuille <b>E010</b> 1 OF 1	Revision no./La Révision no. <b>0</b>
--	--	--

**1 CONDUIT TRENCH DETAIL**  
E010 N.T.S.

