

**PARTICULARS**

LENGTH OA	68.9m
LENGTH WL	62.0m
BEAM MLD	14.0m
DEPTH MLD UPPER DECK	7.6m
DESIGN DRAFT	4.5m
SCANTLING DRAFT	4.9m


COMPLEMENT:  
 OFFICERS 24  
 CREW 16  
 CLASSIFICATION  
 LLOYDS + 100 A 1 ICE CLASS 1 + LMC UMS  
 DESCRIPTIVE NOTATION "SURVEY VESSEL"  
 CERTIFICATION:  
 NON PASSENGER HOME TRADE 1  
 ARCTIC TYPE "A"  
 FOREIGN GOING

ALL INFORMATION CONTAINED OR DISCLOSED IN THIS DRAWING IS CONFIDENTIAL AND PROPRIETARY. AND IS THE EXCLUSIVE PROPERTY OF 3GA MARINE. THIS DESIGN INFORMATION IS RESERVED FOR THE EXCLUSIVE USE OF THE CLIENT. ANY REPRODUCTION, COMMUNICATION OR DISTRIBUTION OF THIS INFORMATION IS PROHIBITED WITHOUT THE WRITTEN CONSENT OF 3GA MARINE LTD.

**3GA MARINE LTD.** 208 - 1497 Admirals Road  
 Victoria, BC  
 V9A 2P8  
 Canada

PROJECT  
**TULLY AS-BUILT DRAWINGS**  
 CLIENT  
**CANADIAN COAST GUARD**  
 TITLE  
**CCGS TULLY  
 GENERAL ARRANGEMENT AS-BUILT**

DRAWN BY FG	DATE DD MMM YY 01 JUN 2018	CHECKED BY DWM	DATE DD MMM YY 01 JUN 2018	PROJECT NO. 17-99A
SCALE 1:125	DRAWING NO. 17-99A-100-01	SHEET NO. 1 OF 3	REV 0	

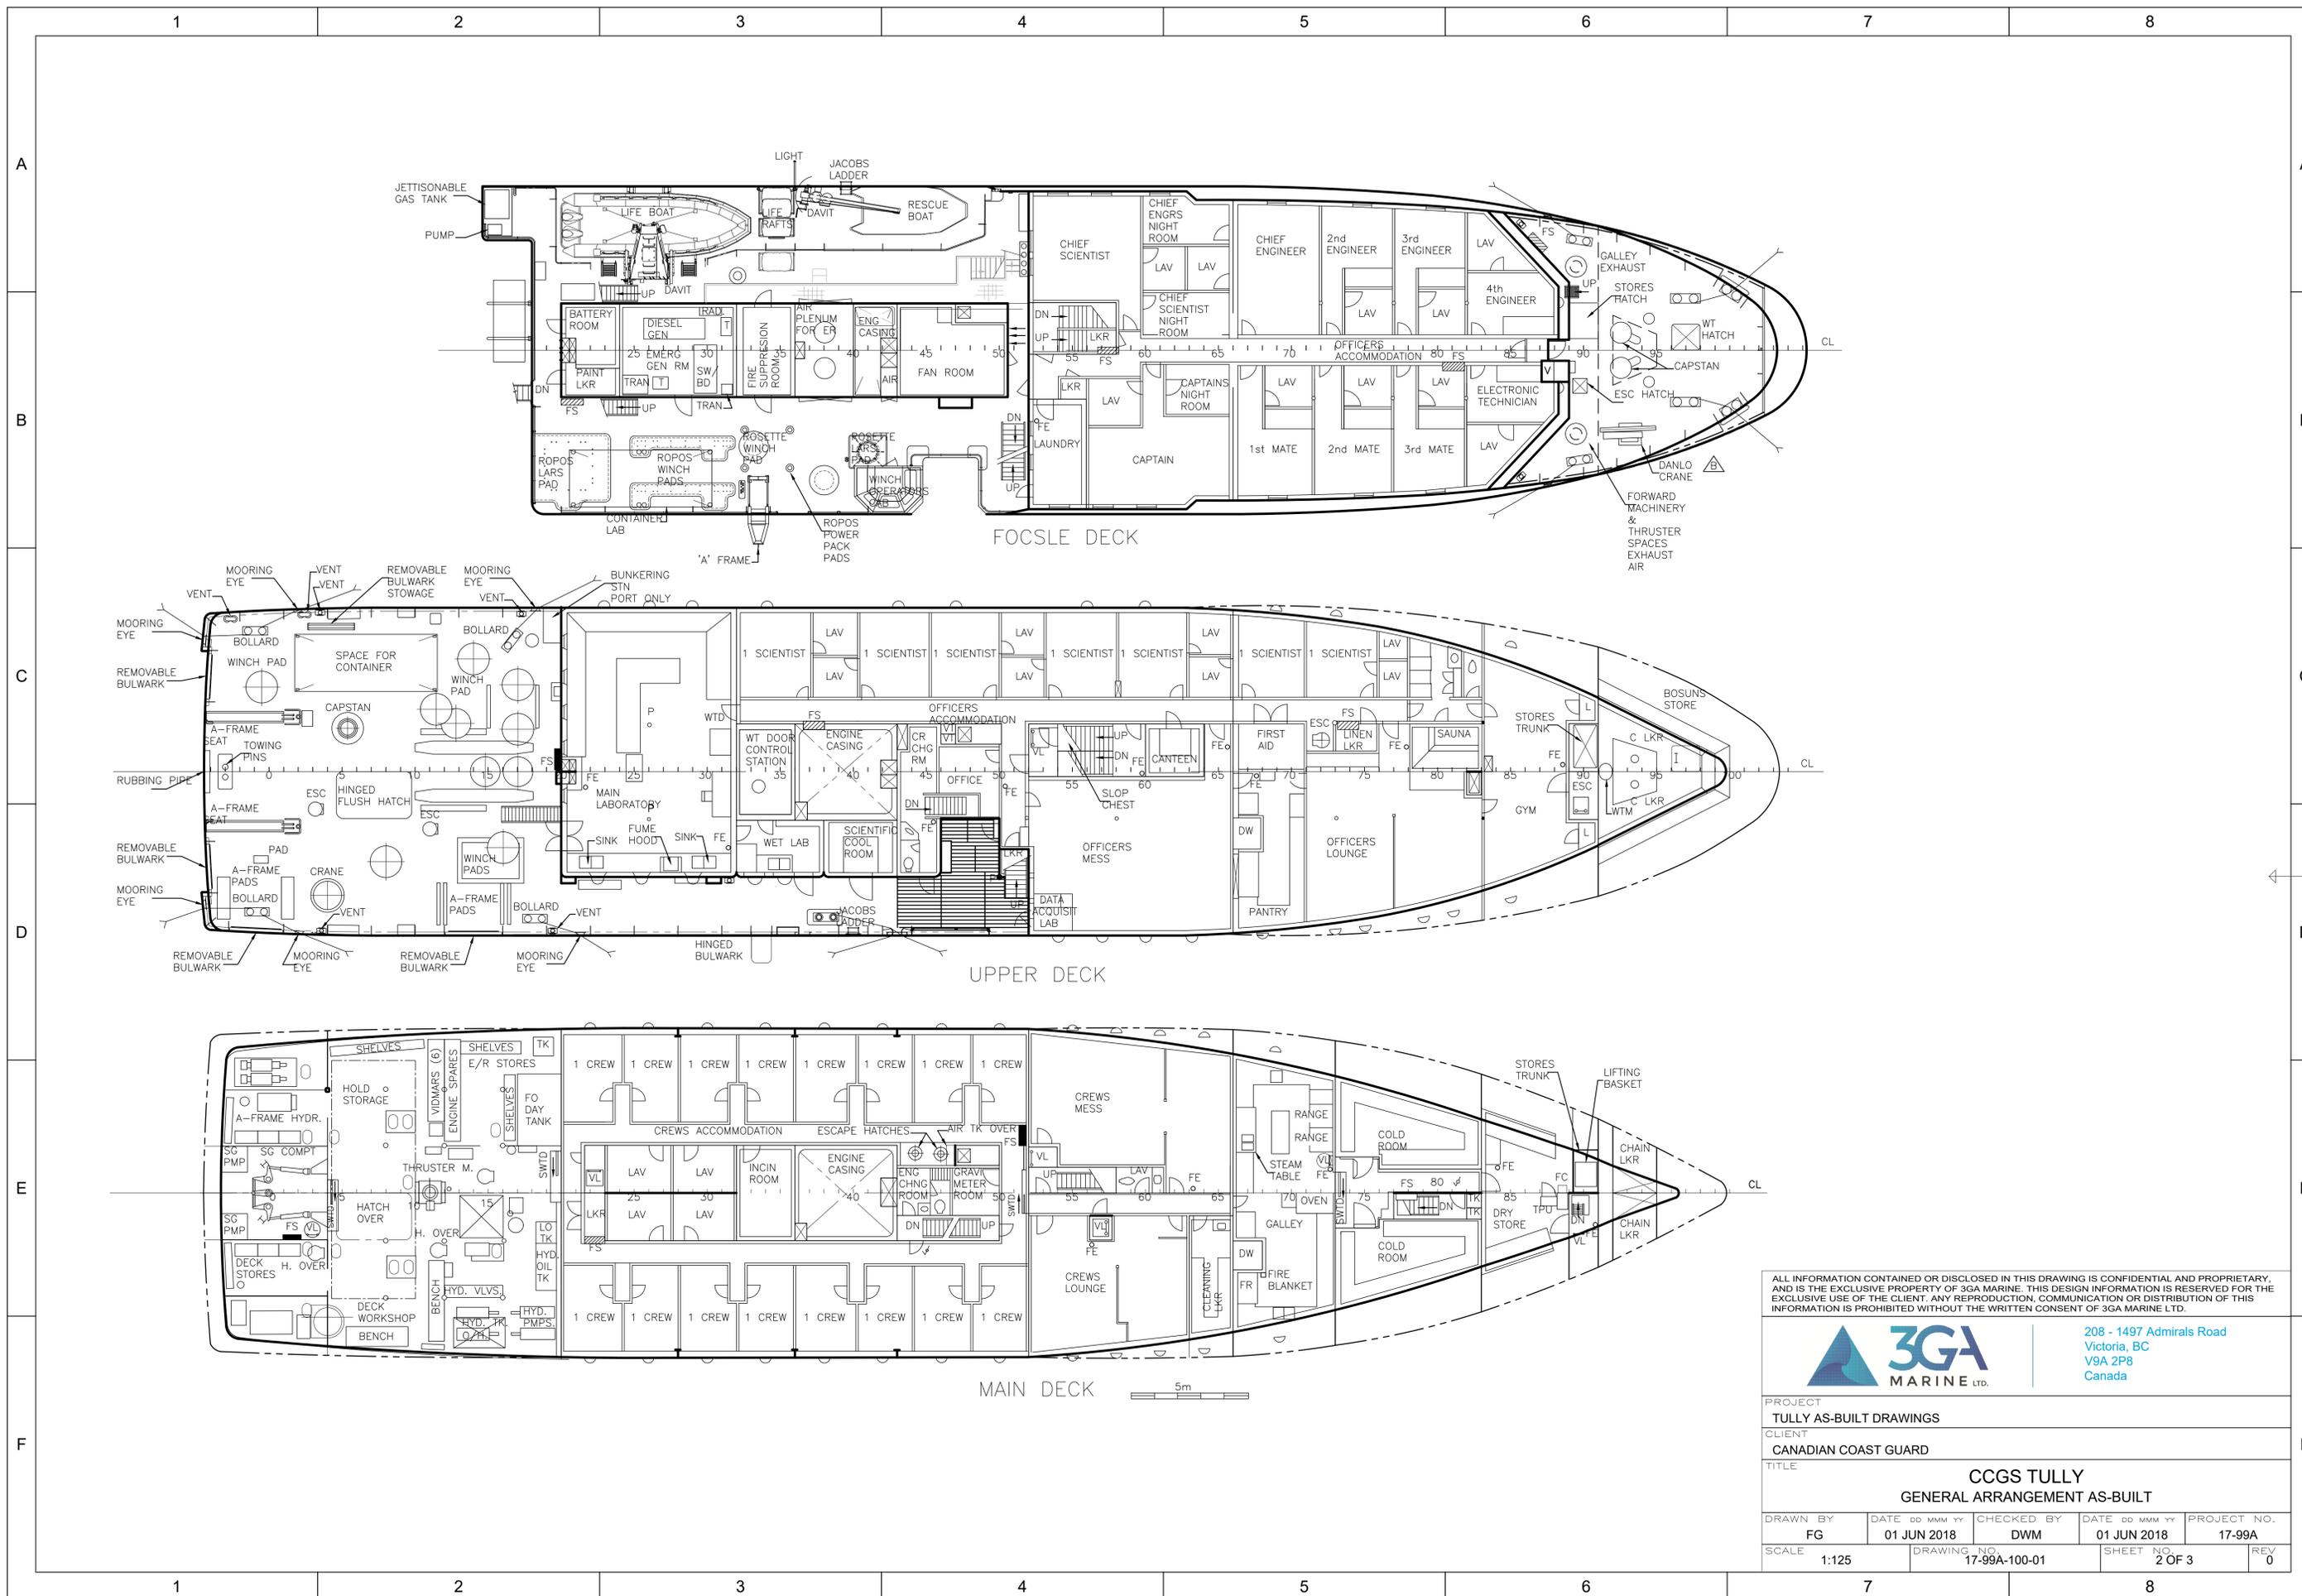

ALL INFORMATION CONTAINED OR DISCLOSED IN THIS DRAWING IS CONFIDENTIAL AND PROPRIETARY. AND IS THE EXCLUSIVE PROPERTY OF 3GA MARINE. THIS DESIGN INFORMATION IS RESERVED FOR THE EXCLUSIVE USE OF THE CLIENT. ANY REPRODUCTION, COMMUNICATION OR DISTRIBUTION OF THIS INFORMATION IS PROHIBITED WITHOUT THE WRITTEN CONSENT OF 3GA MARINE LTD.

**3GA MARINE LTD.**  
 208 - 1497 Admirals Road  
 Victoria, BC  
 V9A 2P8  
 Canada

PROJECT  
**TULLY AS-BUILT DRAWINGS**

CLIENT  
**CANADIAN COAST GUARD**

TITLE  
**CCGS TULLY  
 GENERAL ARRANGEMENT AS-BUILT**

DRAWN BY FG	DATE DD MMM YY 01 JUN 2018	CHECKED BY DWM	DATE DD MMM YY 01 JUN 2018	PROJECT NO. 17-99A
SCALE 1:125	DRAWING NO. 17-99A-100-01	SHEET NO. 2 OF 3	REV 0	

