

M 46932-D



Department of Public Works
Ministère des Travaux publics

MARQUIS, VANDRY & ASS.
"CONSULTING ENGINEERS"

RIMOUSKI: 471 CATHEDRAL AVE.
QUEBEC: 880 STE-FOY ROAD.

A detail no. _____
B location drawing no. _____
C drawing no. _____




project title
**HARBOUR DEVELOPMENT
AMENAGEMENT PORTUAIRE
"AS BUILT"**

Cap-aux-Meules, I.M. R. Que.
drawing title

**DREDGING - DRAGAGE
SOUNDINGS & BORINGS
SONDAGES & FORAGES**

designed by _____
date JANUARY 30th 1970
drawn by 2. LEVESQUE
date JANUARY 30th 1970
checked by _____
date _____
approved by _____
date _____
D.P.W. Project Manager _____
project number C-34-17
drawing no. 3/24

M.T.P. 121-45-1902

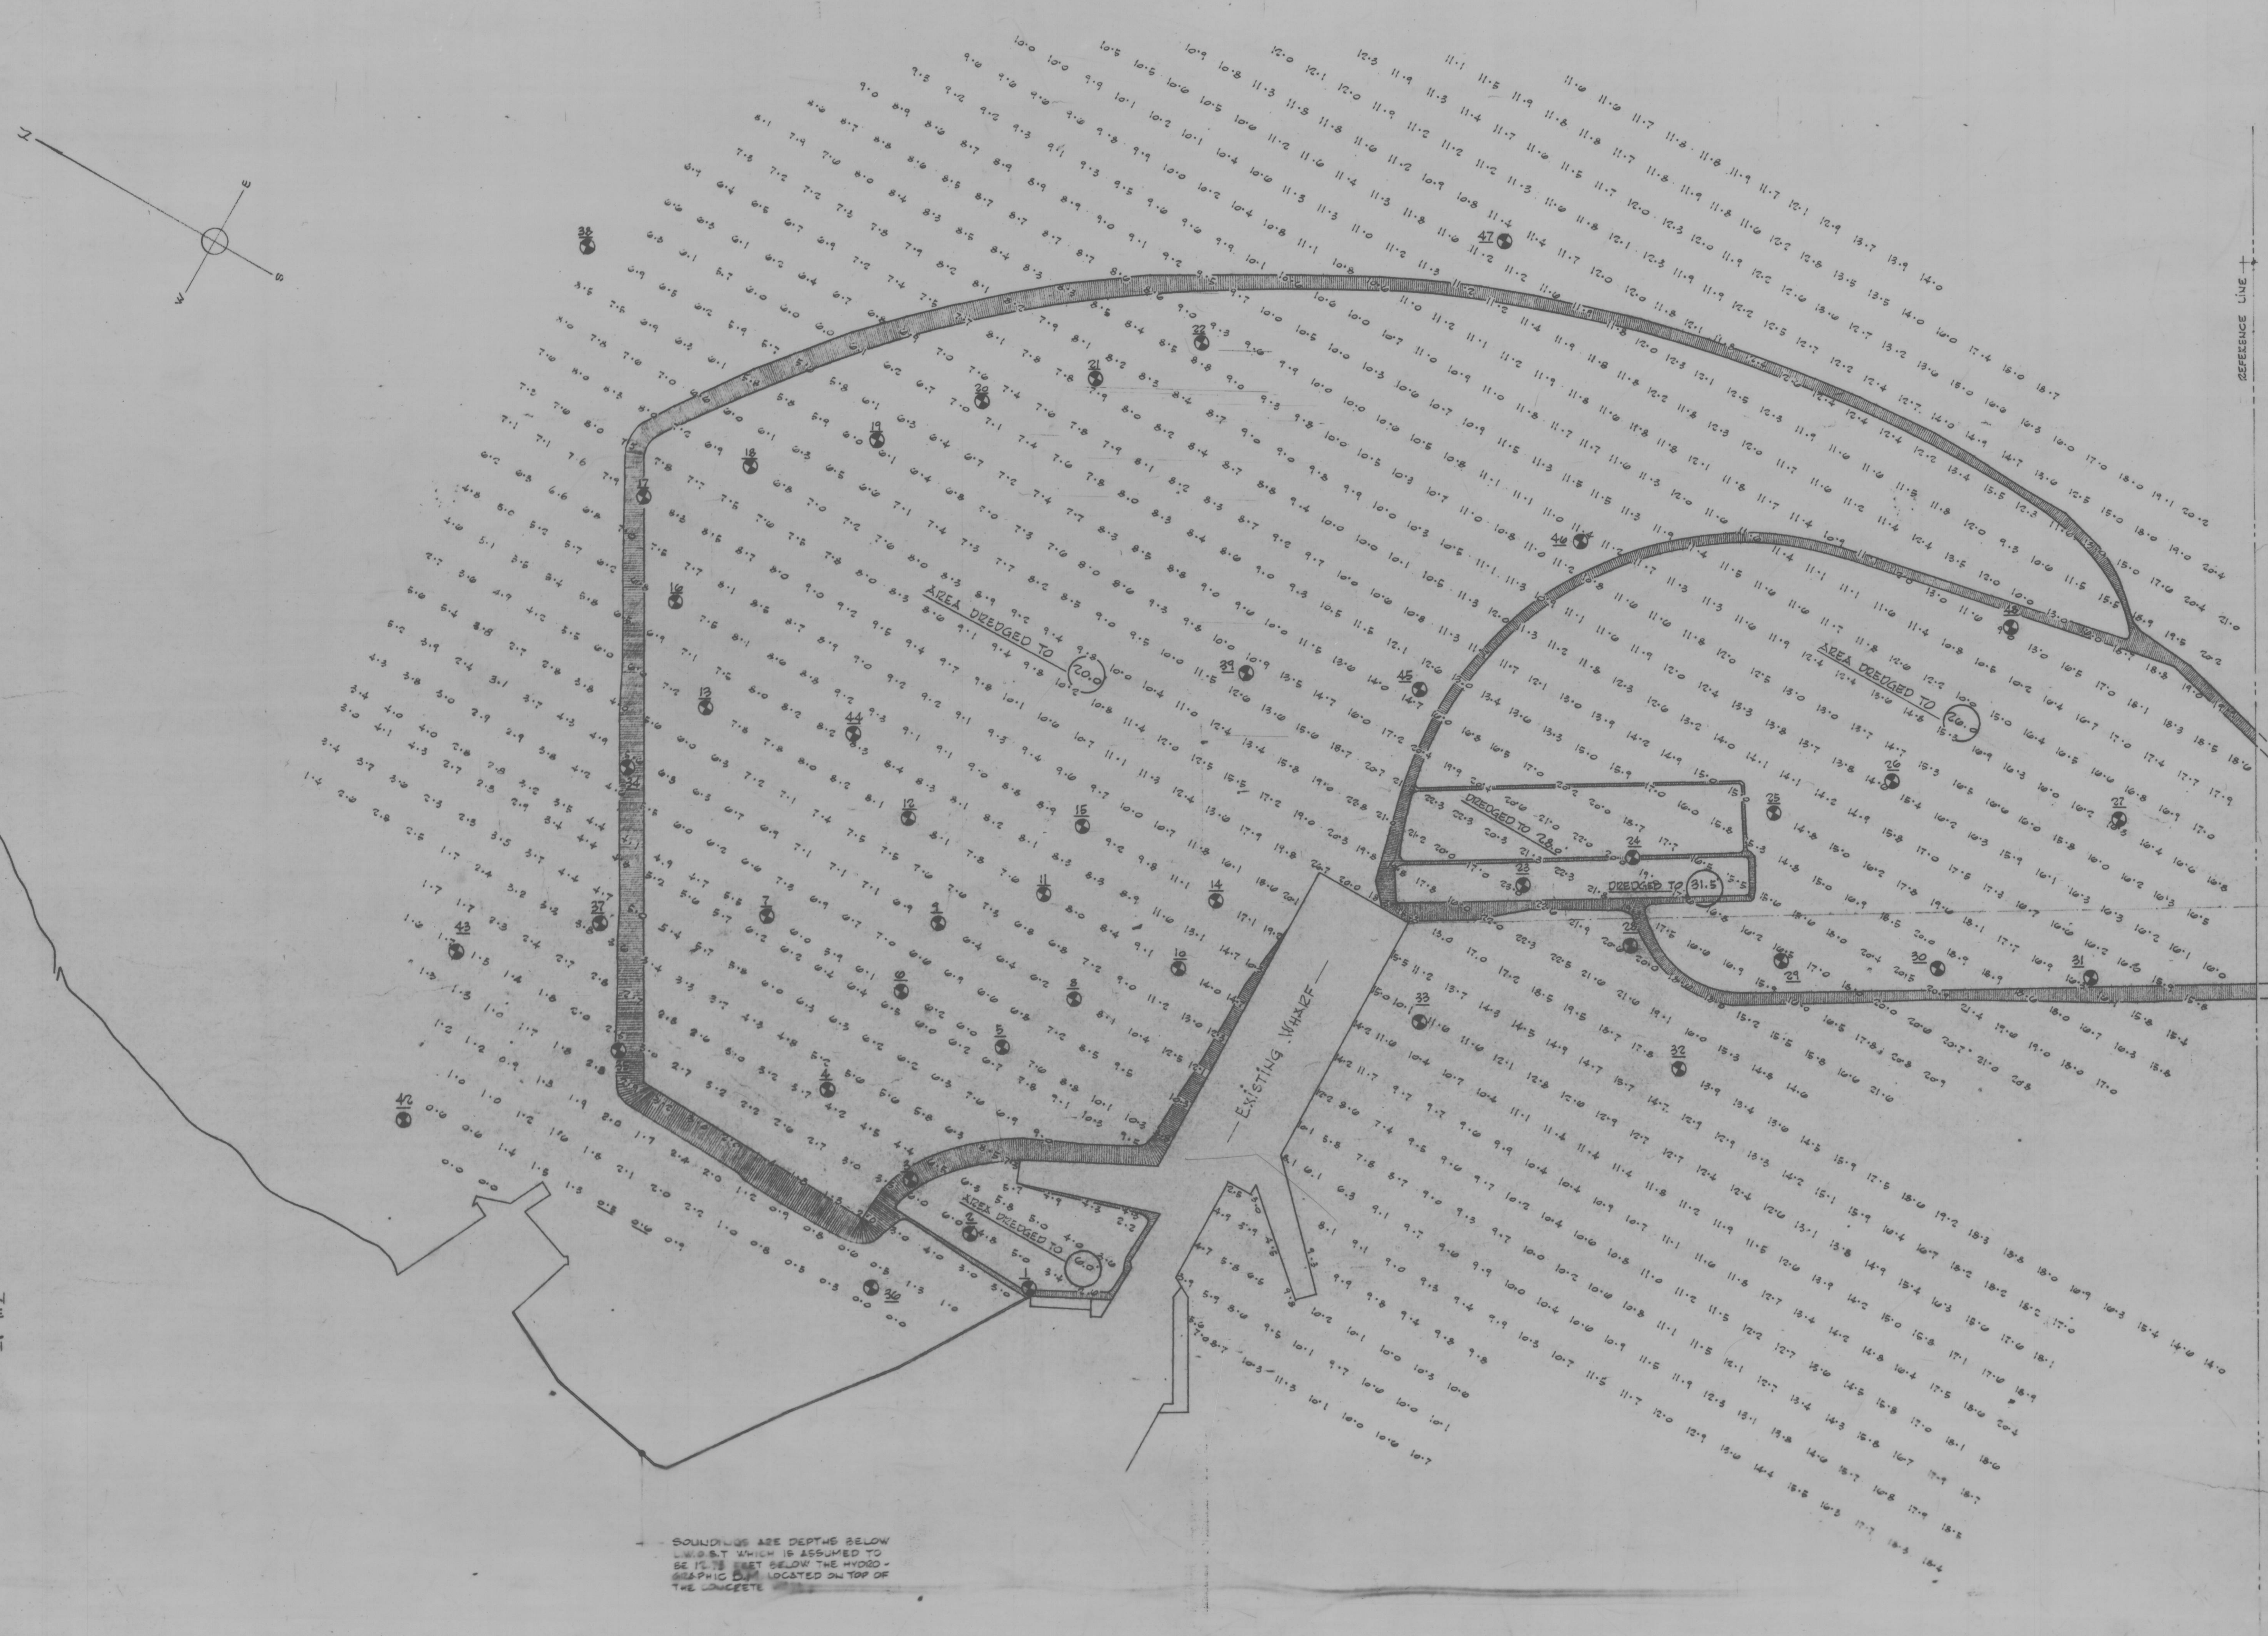

NOTE
DREDGING WILL BE LIMITED TO ROCK ELEVATION
WHenever IT MAY BE ENCOUNTERED ABOVE THE
DREDGING GRADES.
AUCUN DRAGAGE EST REQUIS DANS LE BAC QUI
POURRAIT ETRE RENCONTRE AU-DESSUS DES
LIGNES DE DRAGAGE.

SOUNDINGS ARE DEPTHS BELOW
LOWEST WHICH IS ASSUMED TO
BE 15.75 FEET BELOW THE HYDRO-
GRAPHIC DATUM LOCATED ON TOP OF
THE LANCELOT

SOUNDINGS AND BORINGS
SCALE 1"=100'

M 46932-D

DPW 700 P