
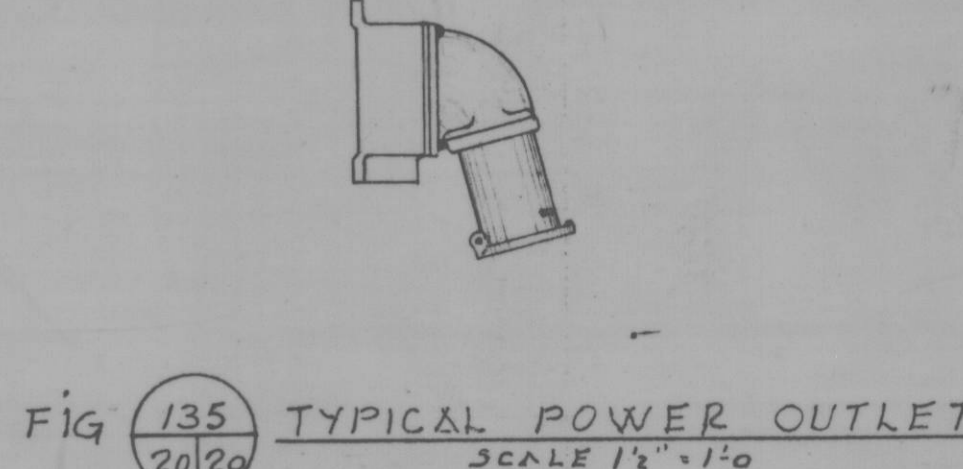
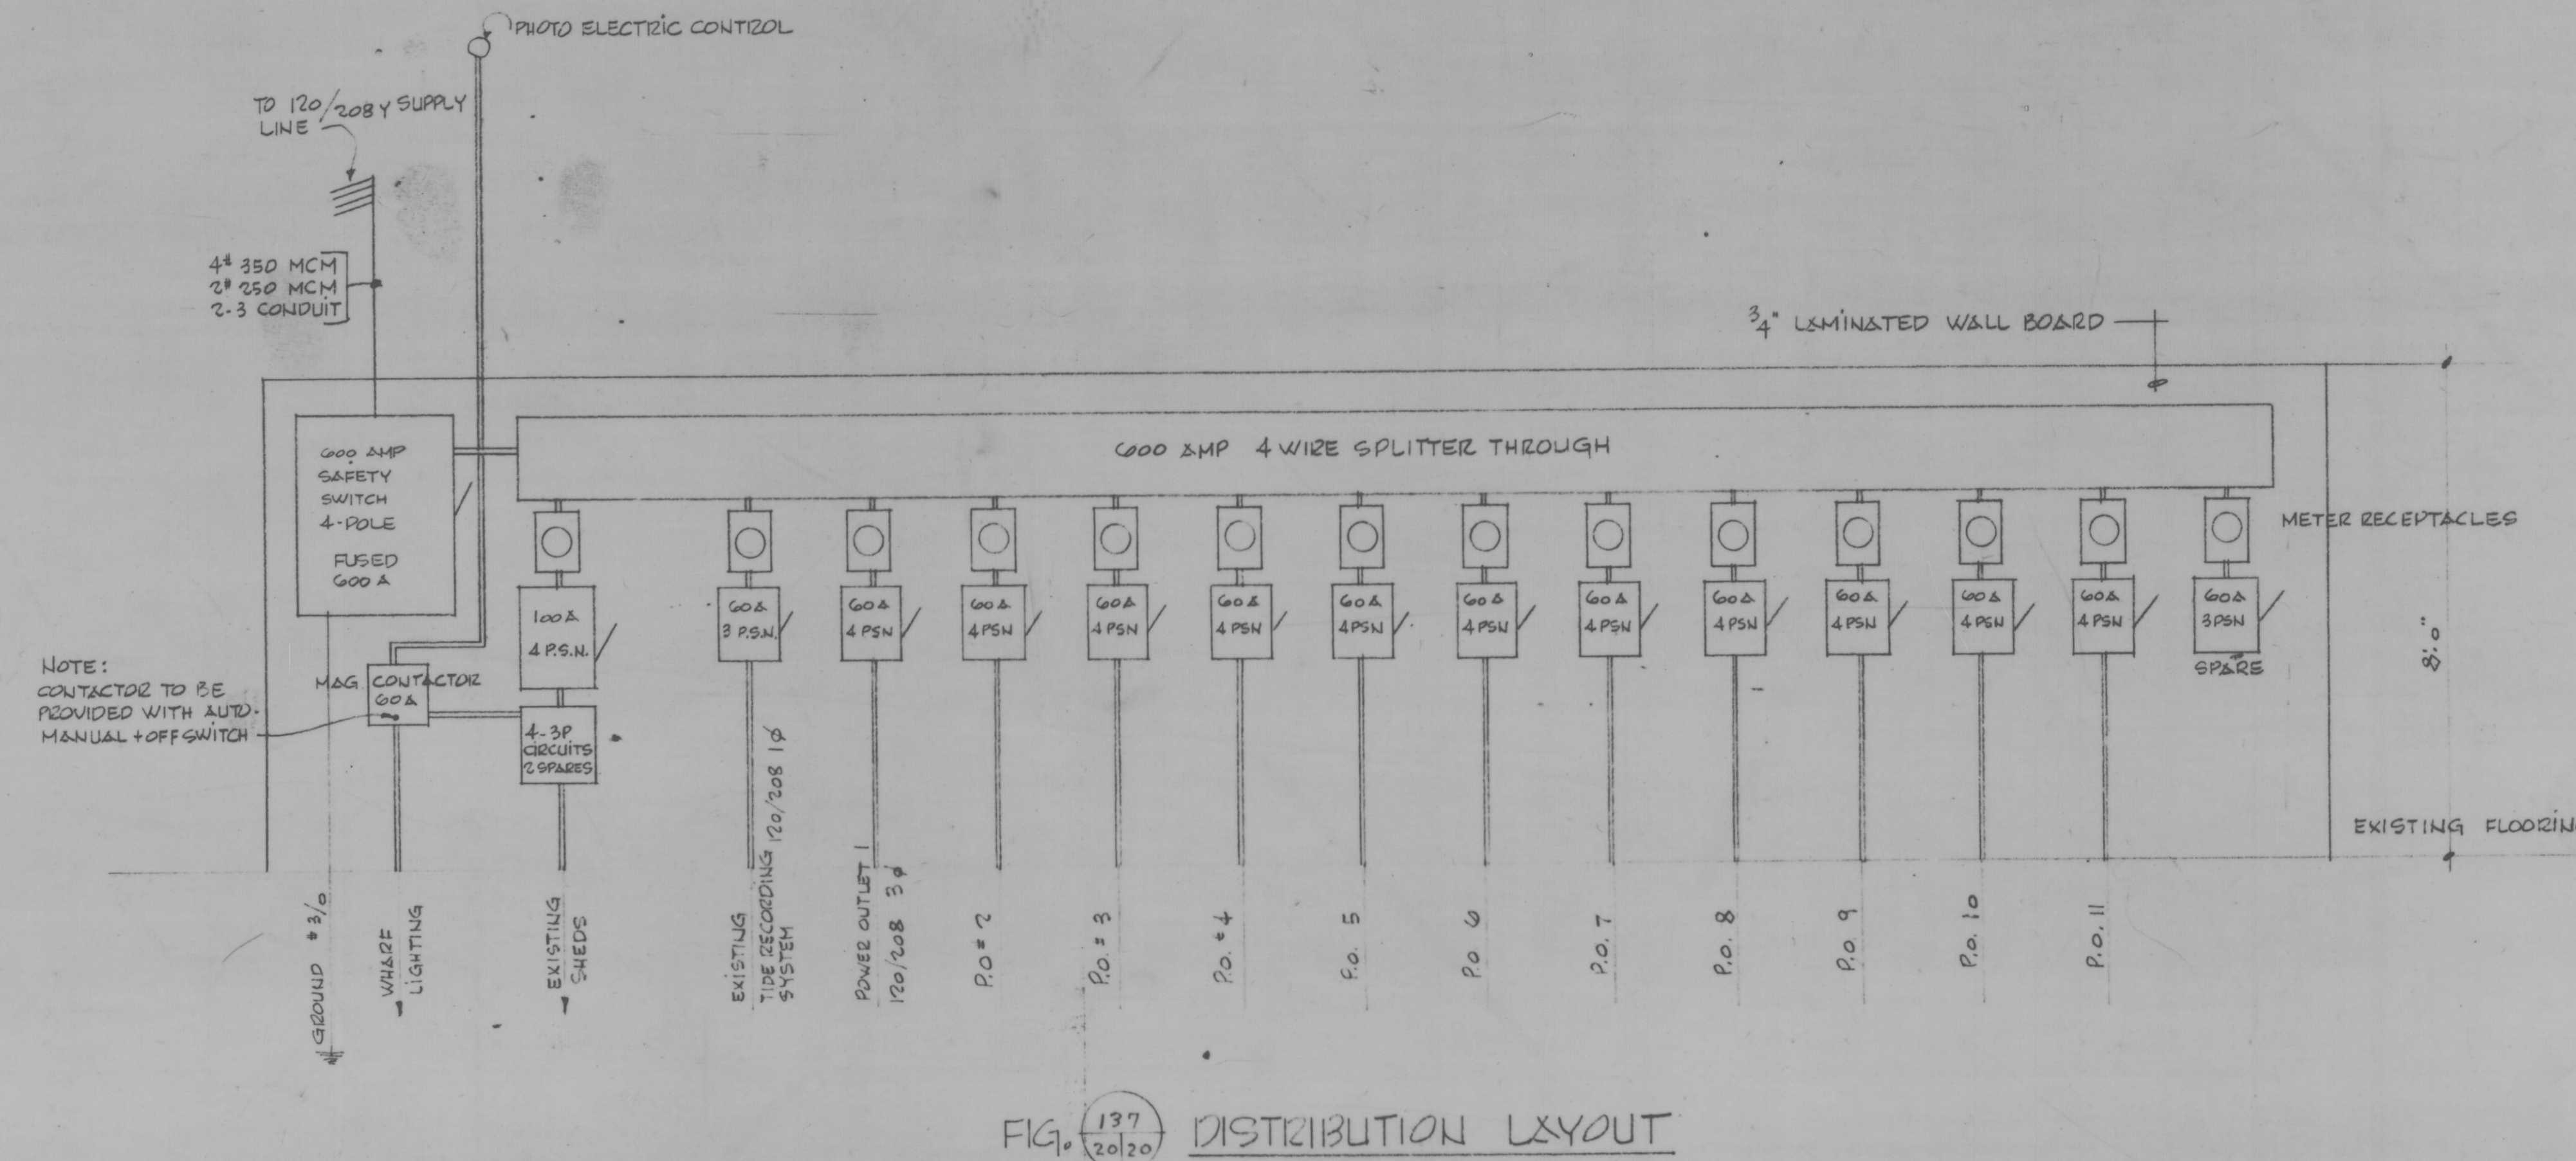
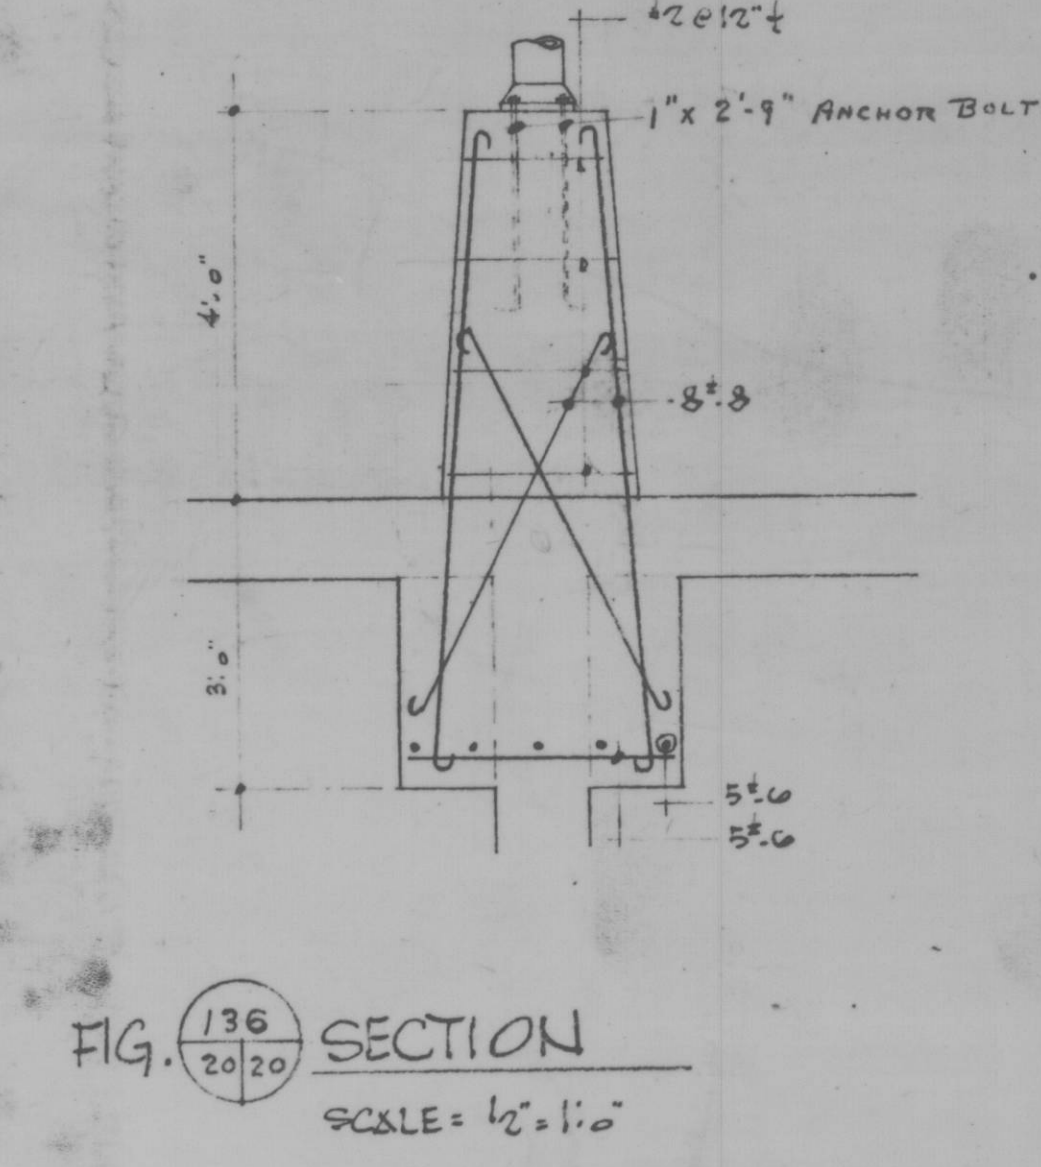
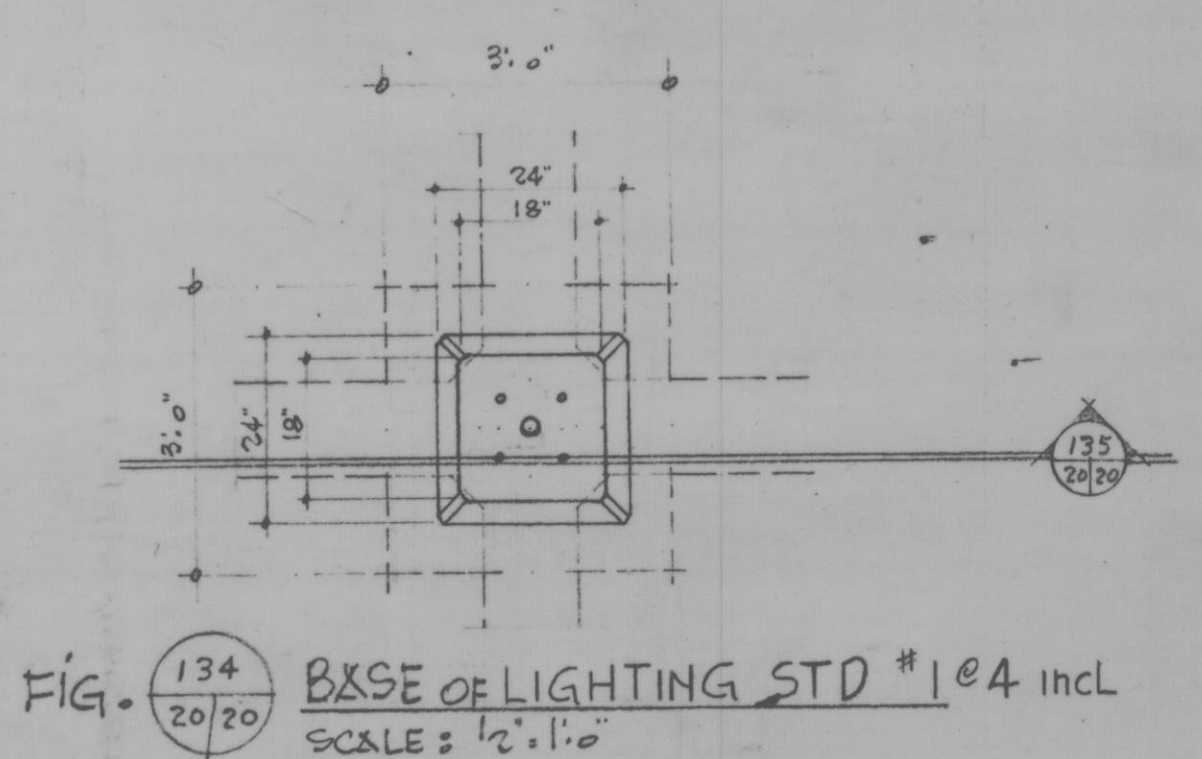


SCHEDULE OF WIRING

FROM	TO	NO. OF CONDUITS	GAUGE	TYPE	CONDUIT
SERVICE ROOM	PO. 1	4	2	R.W.U.	2"
"	PO. 2	4	2	R.W.U.	2"
"	PO. 3	4	1/0	R.W.U.	2"
"	PO. 4	4	1/0	R.W.U.	2"
"	PO. 5	4	2/0	R.W.U.	2 1/2"
"	PO. 6	4	3/0	R.W.U.	2 1/2"
"	PO. 7	4	3/0	R.W.U.	2 1/2"
"	PO. 8	4	3/0	R.W.U.	2 1/2"
"	PO. 9	4	4/0	R.W.U.	3"
"	PO. 10	4	4/0	R.W.U.	3"
"	PO. 11	4	4/0	R.W.U.	3 1/2"
"	P. 4	4	0	R.W.U.	1 1/2"
"	P. 5	4	4	R.W.U.	1 1/2"
P. 5	P. 17	4	0	R.W.U.	1 1/2"

FIG. 129

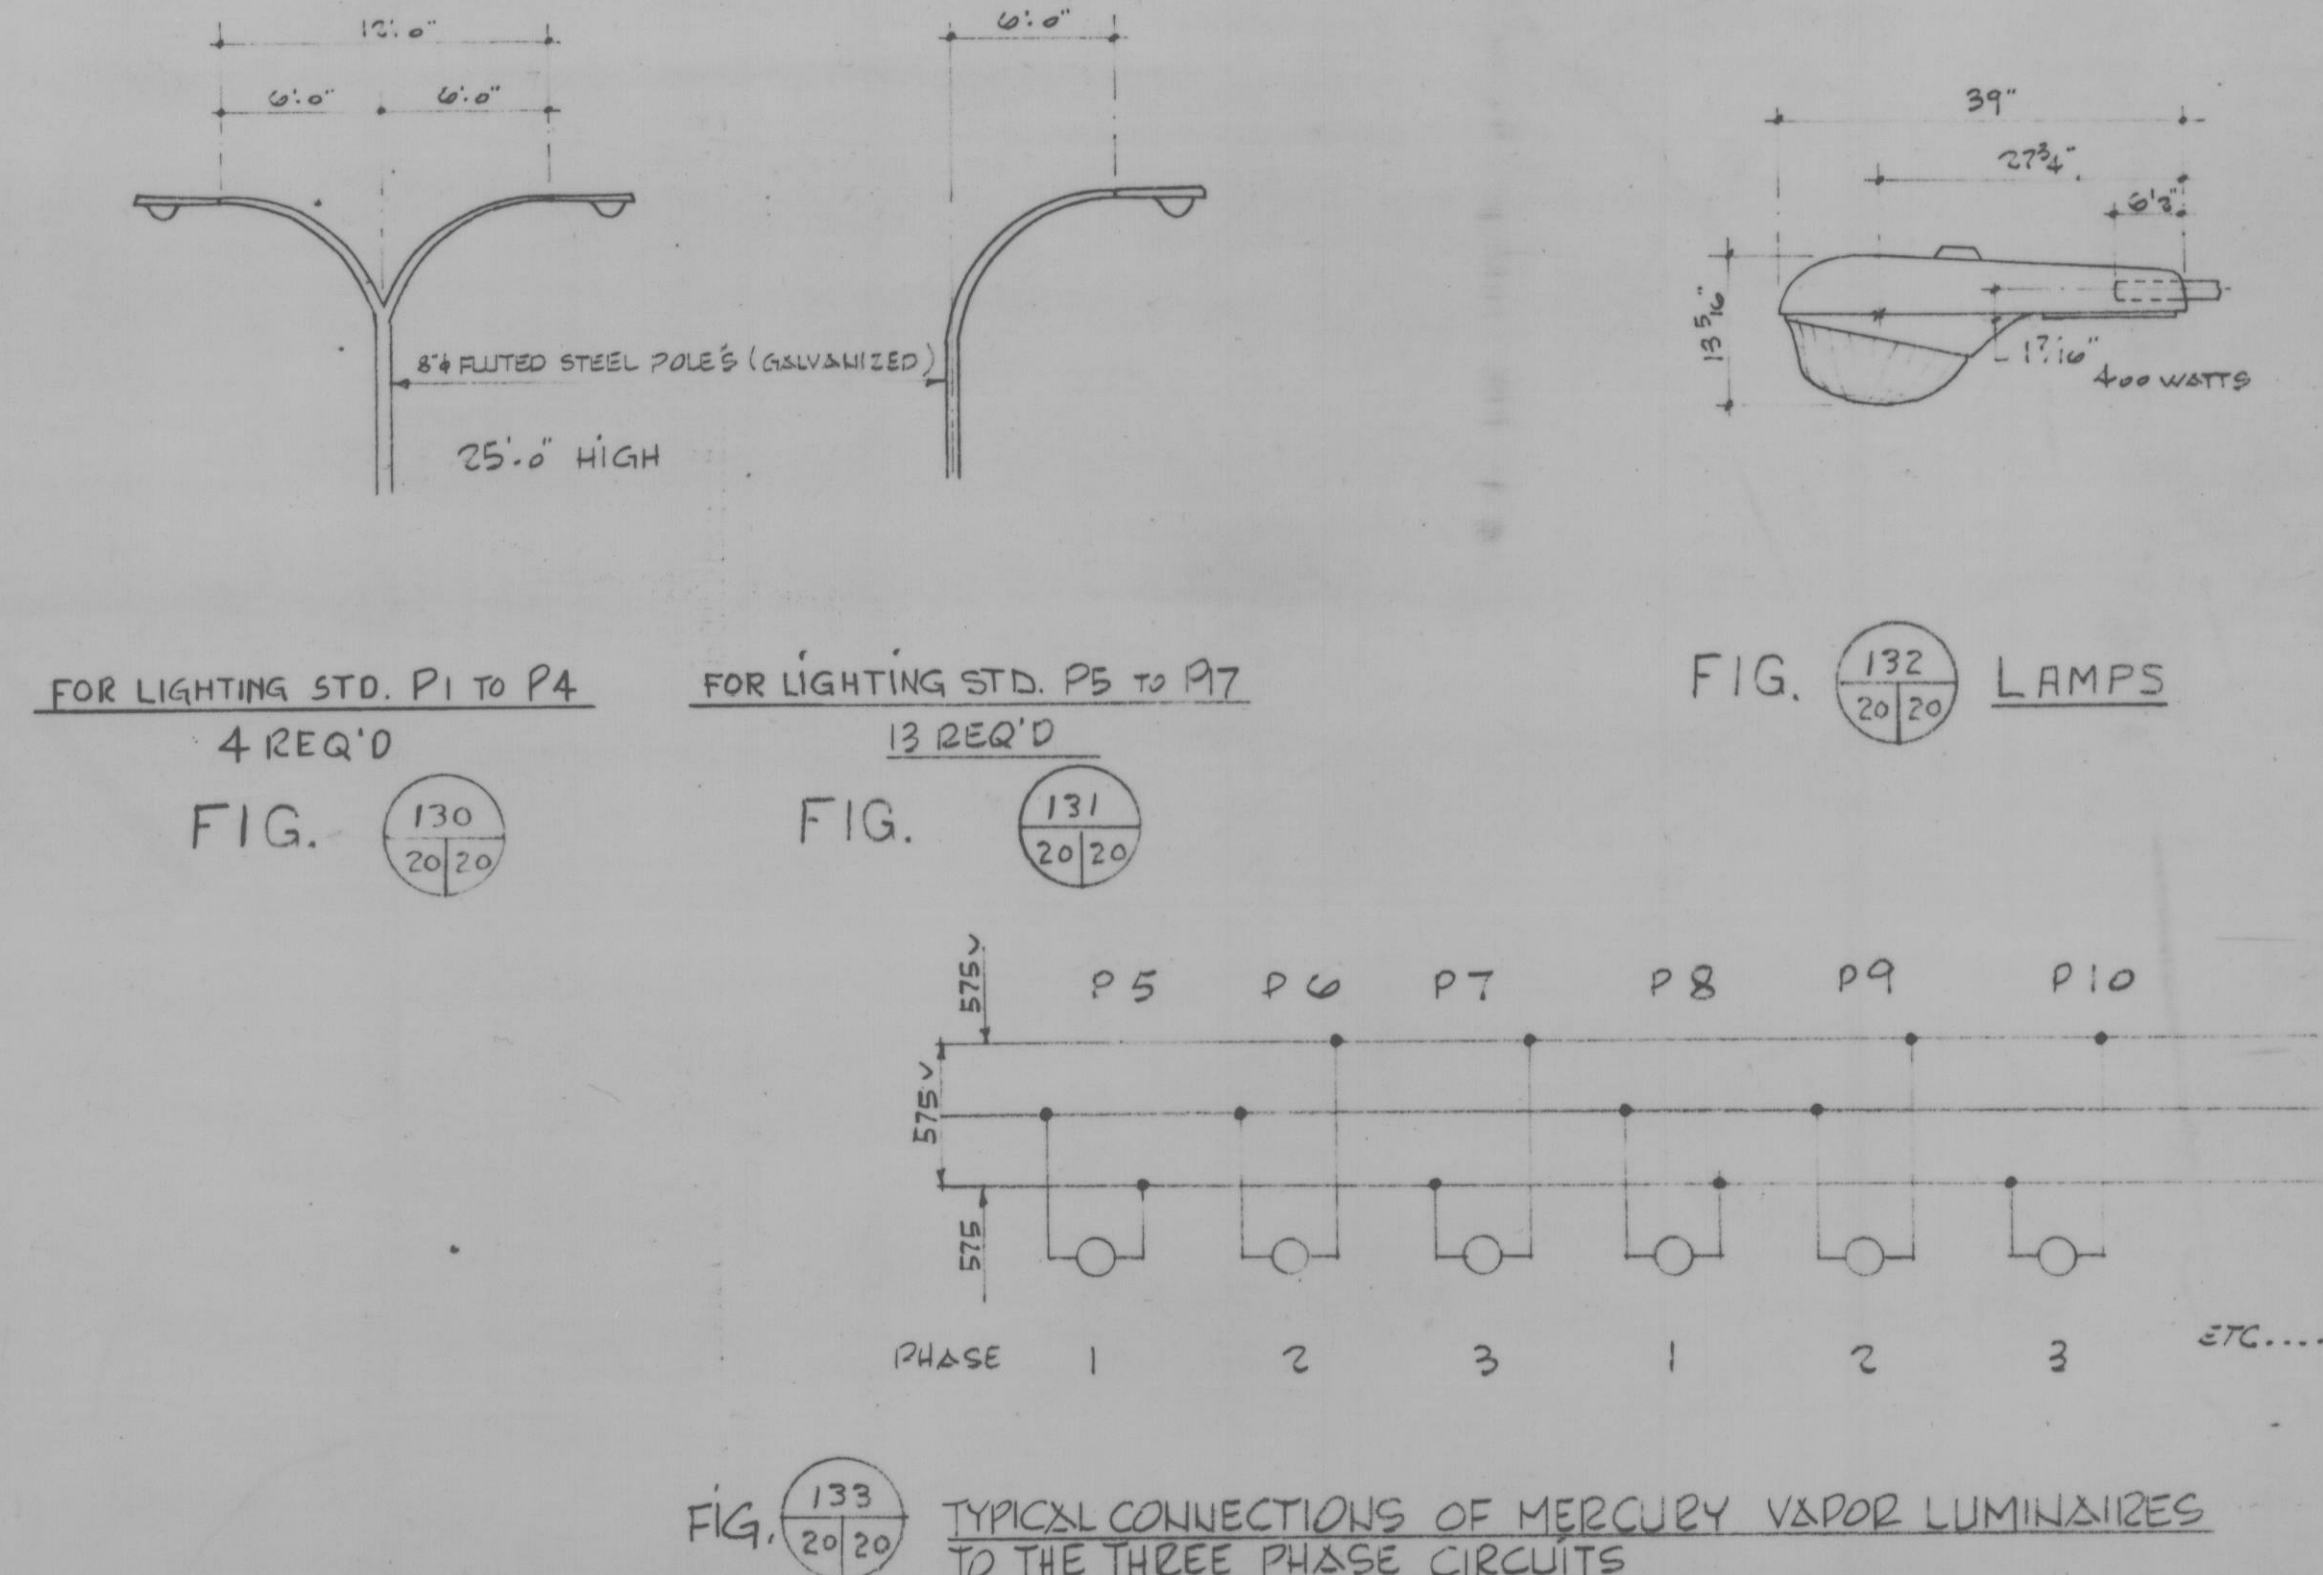

Department of Public Works
Ministère des Travaux publics

MARQUIS, VANDRY & ASS.
"CONSULTING ENGINEERS"

RIMOUSKI : 471 CATHEDRAL AVE.
QUEBEC : 880 STE-FOY ROAD.

A detail no. B location drawing no. C drawing no.

project title HARBOUR DEVELOPMENT AMENAGEMENT PORTUAIRE "AS BUILT"

Cap-aux-Meules, I.M. P. Que.

drawing title ELECTRICAL DETAILS DÉTAILS ÉLECTRIQUES

designed by A. ALBERT date JANUARY 30th 1970
drawn by P. LEVESQUE date JANUARY 30th 1970
checked by G. GAGNON date
approved by G. GAGNON date

Tender D.P.W. Project Manager Administrateur du projet M.T.P.
project number C-34-17
drawing no. 20/20

M.T.P. 121-45-190R

M4694-D

DPW 700 F

LD 0276